




FILE NAME = Y:\P\c\ess\ANY\X2\22425\CADD\MSTN\10b214_stock_wcdgn
 DATE/TIME = 3/17/2014
 USER = 4916

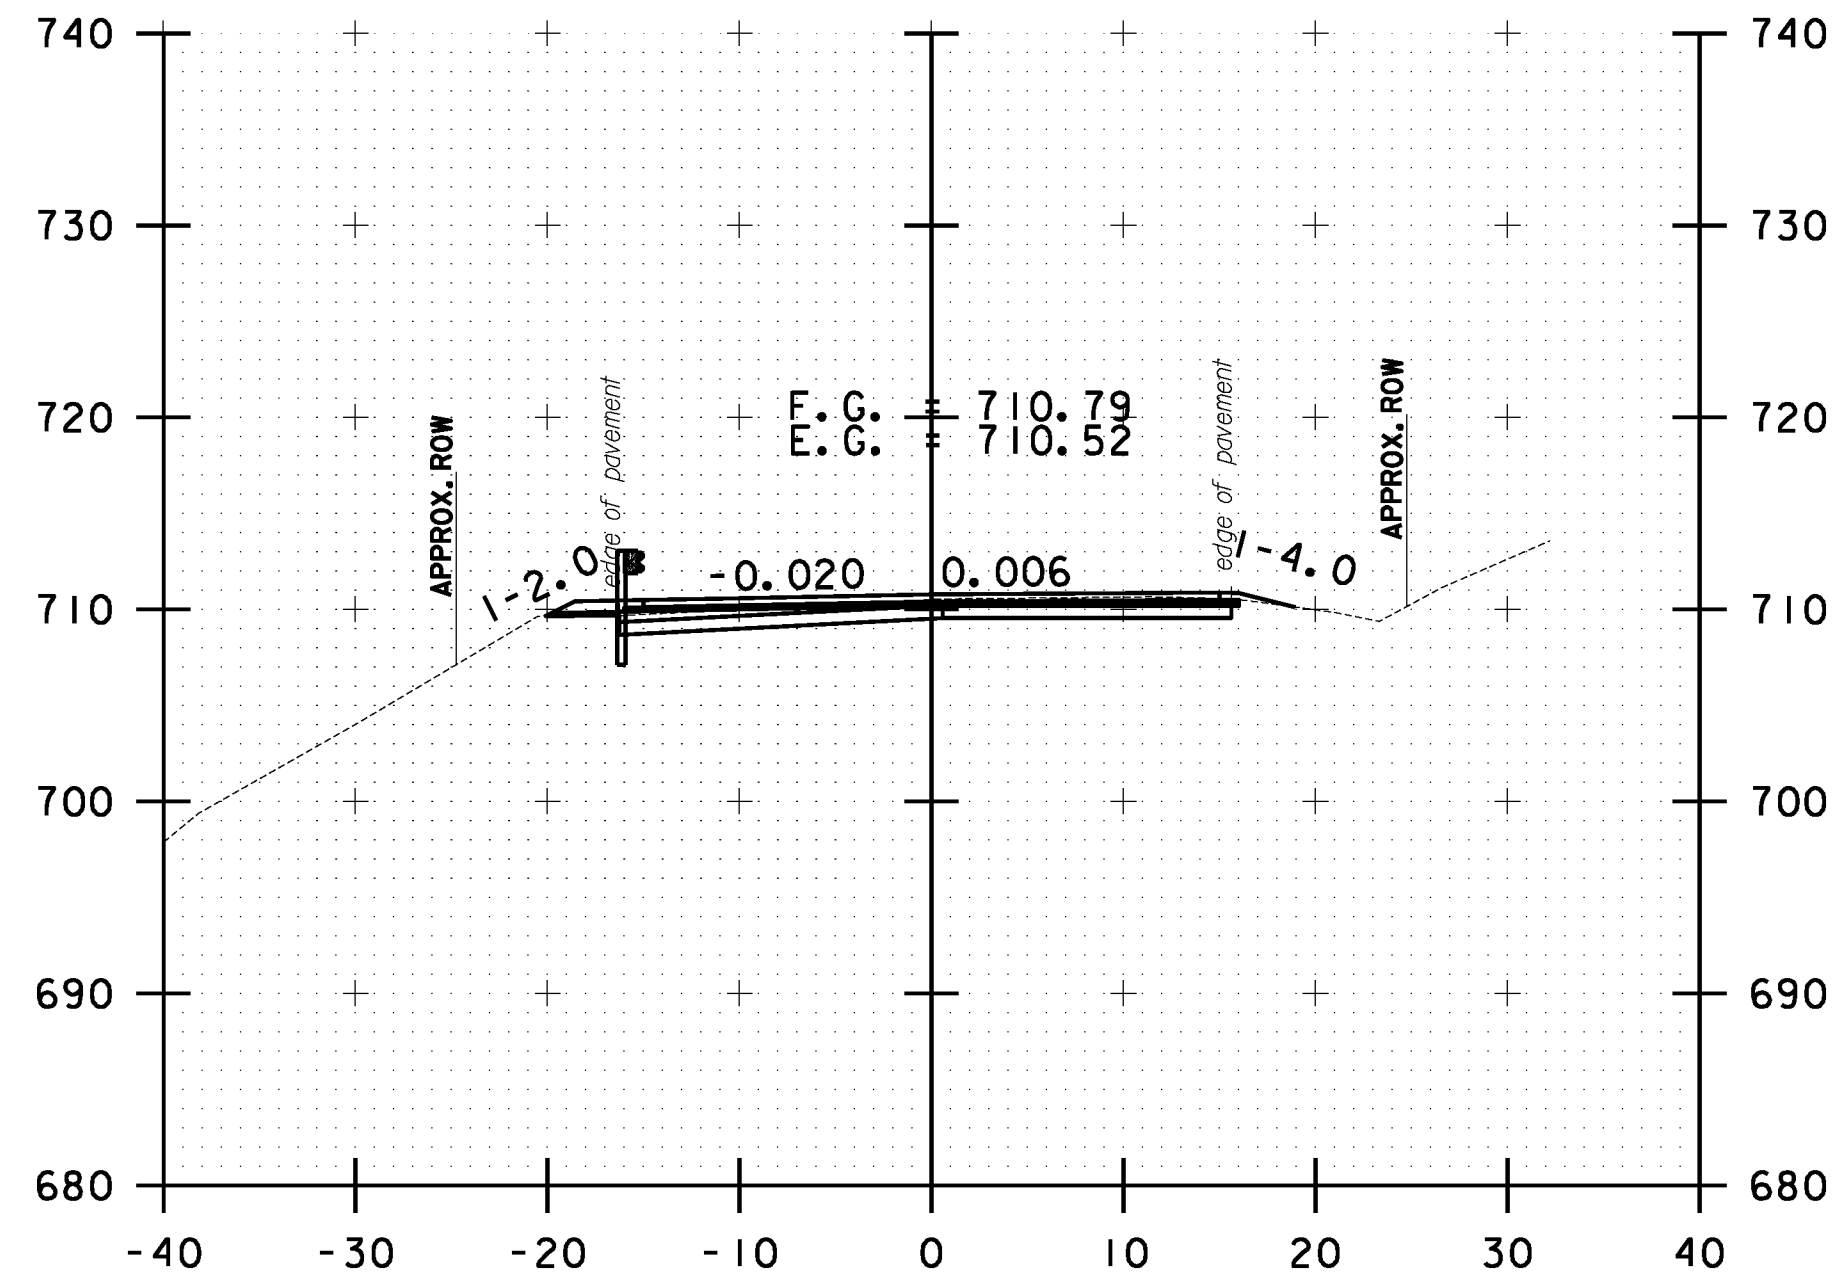


75+00.00

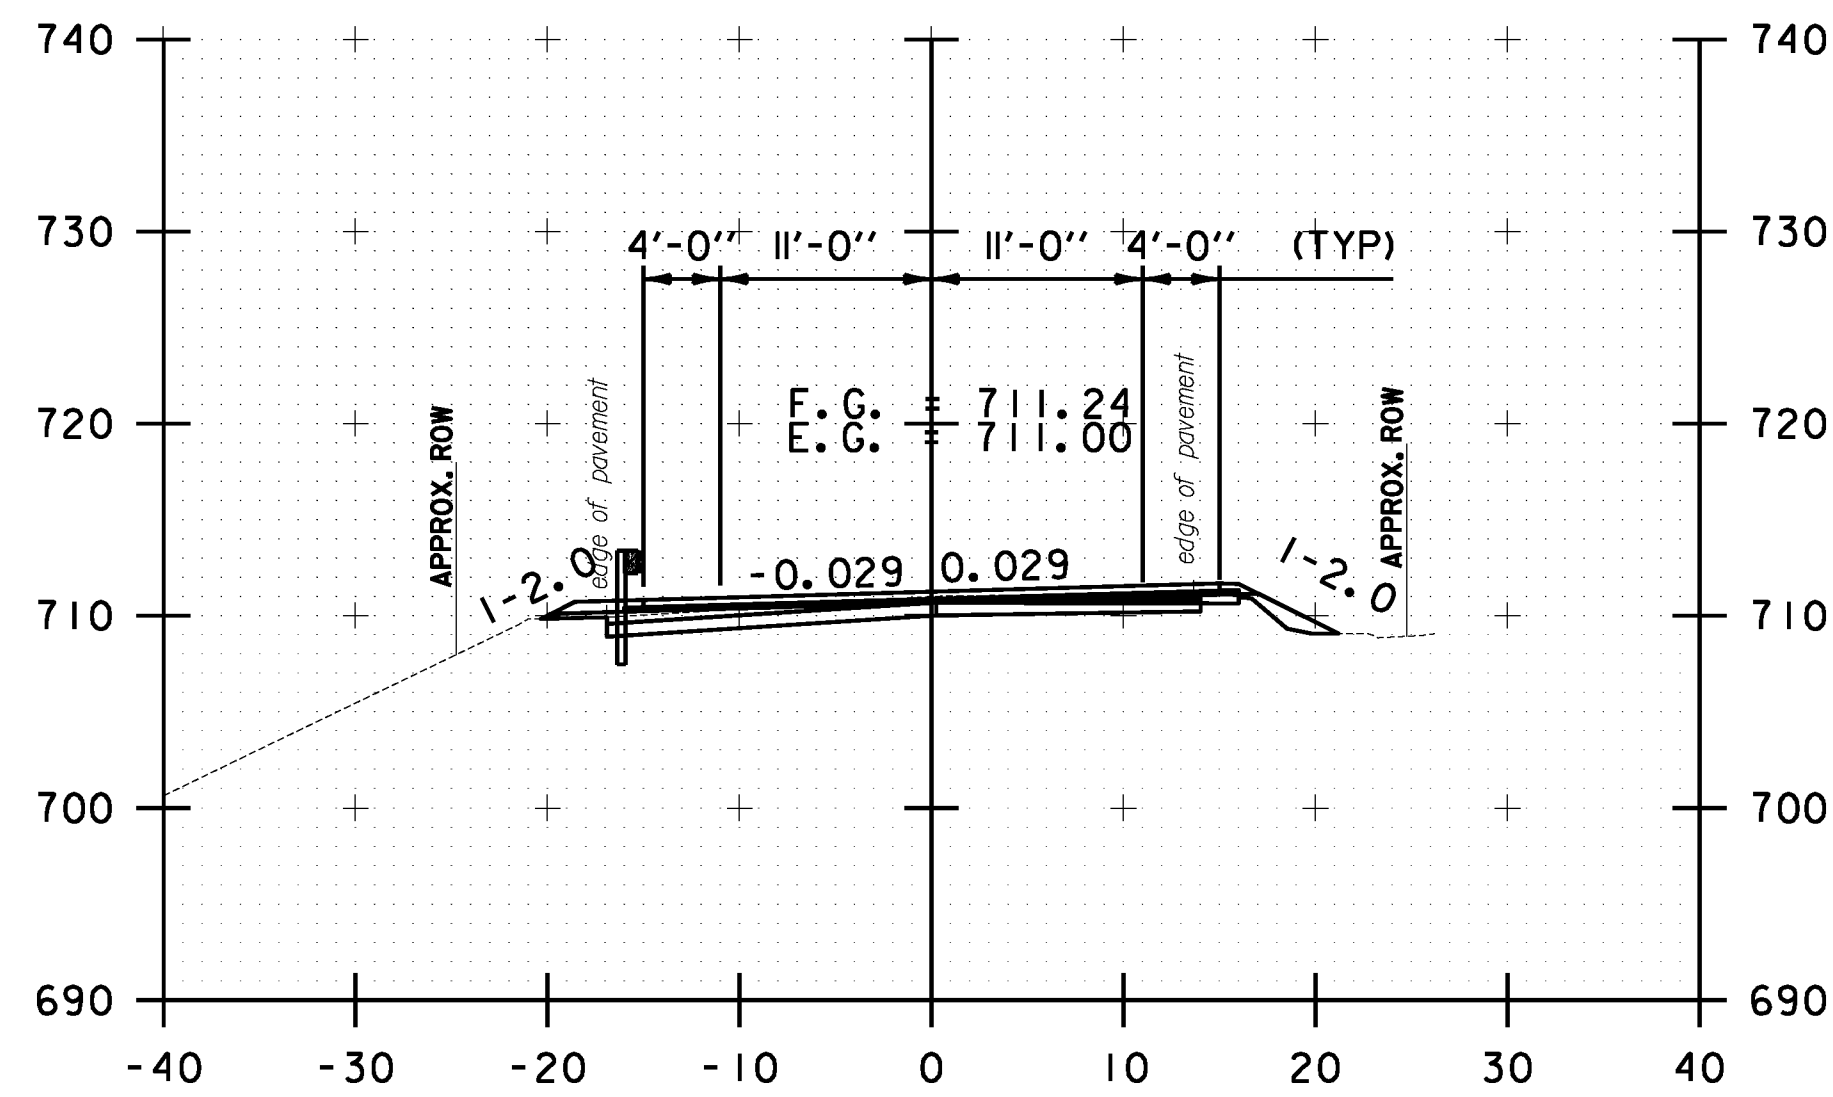


74+50.00

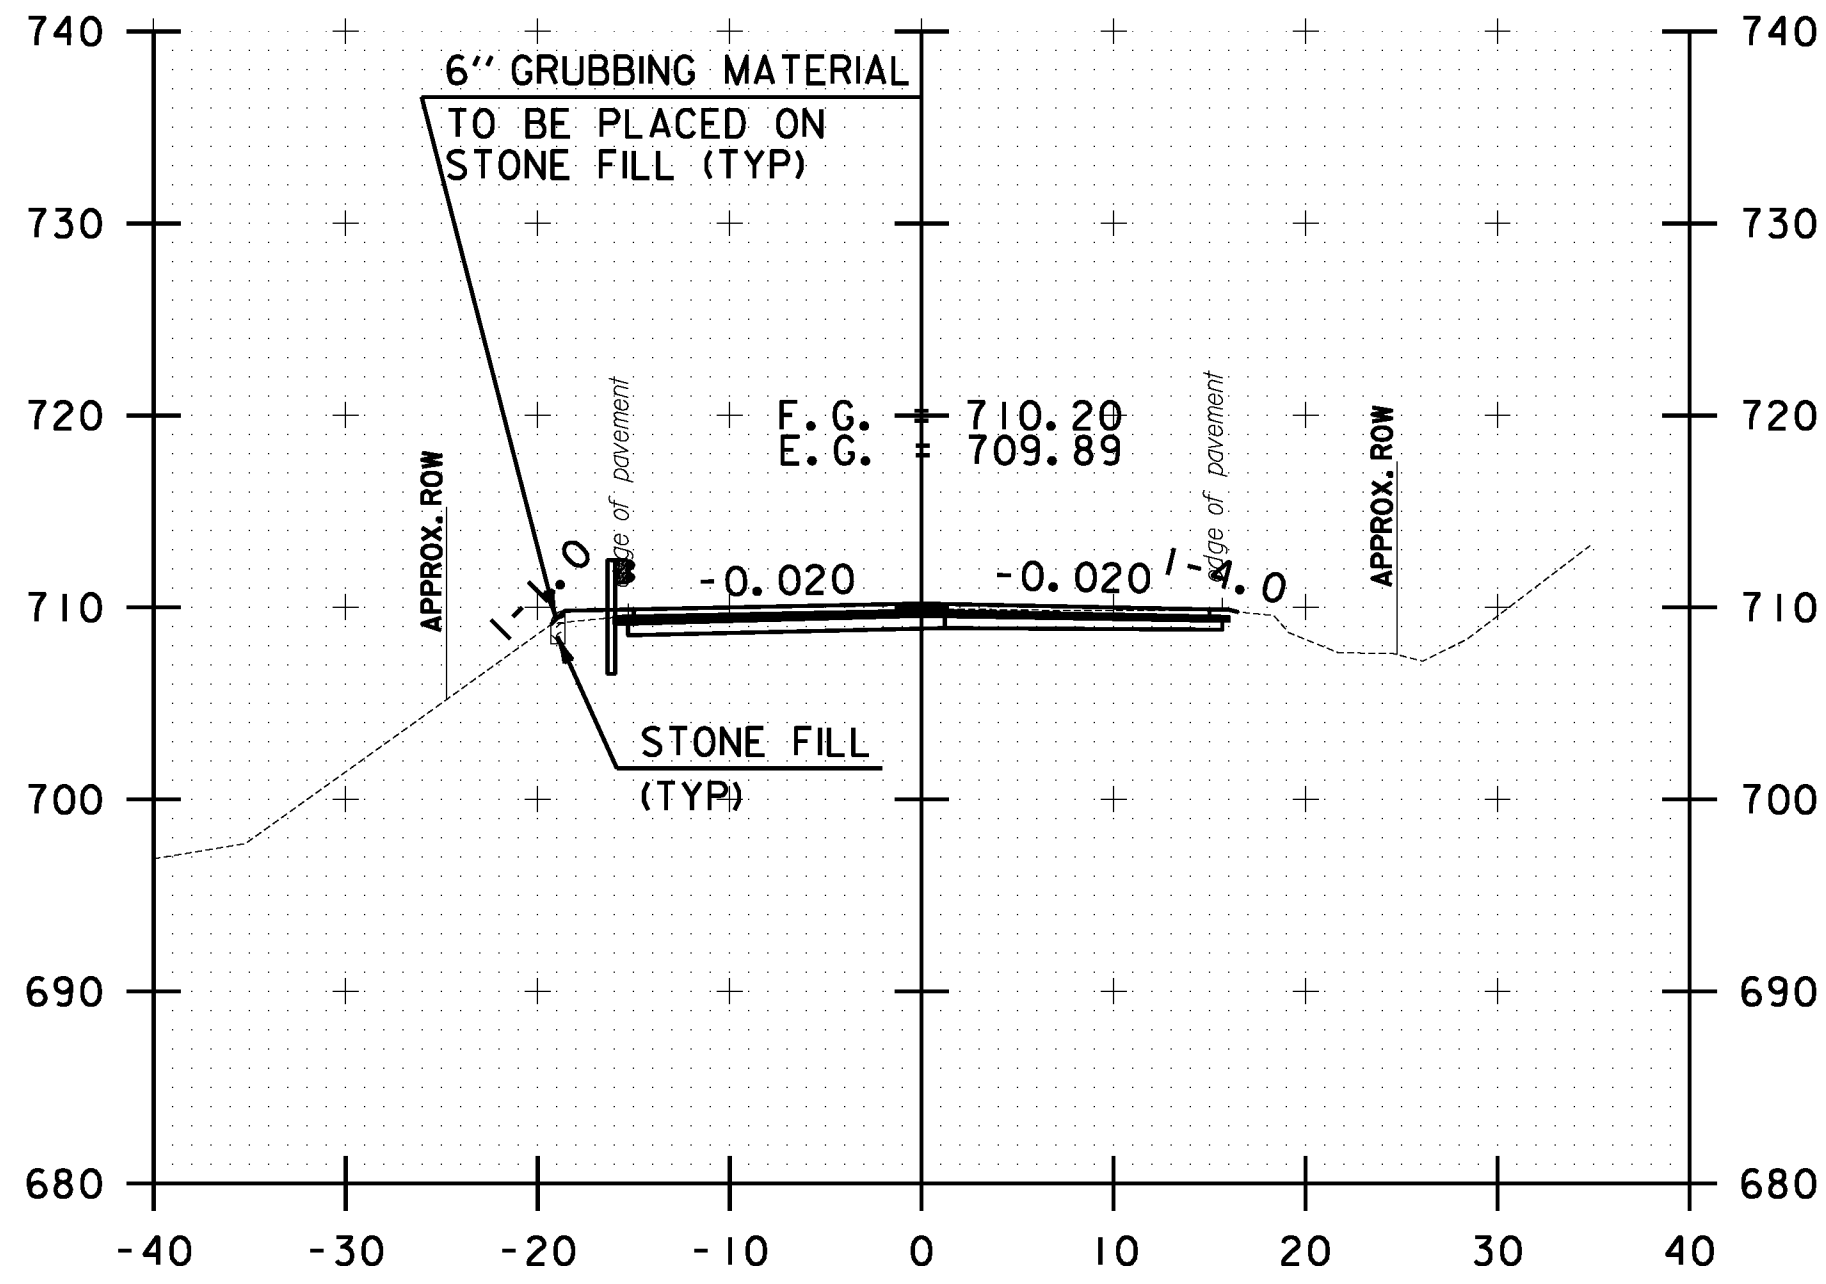


76+00.00

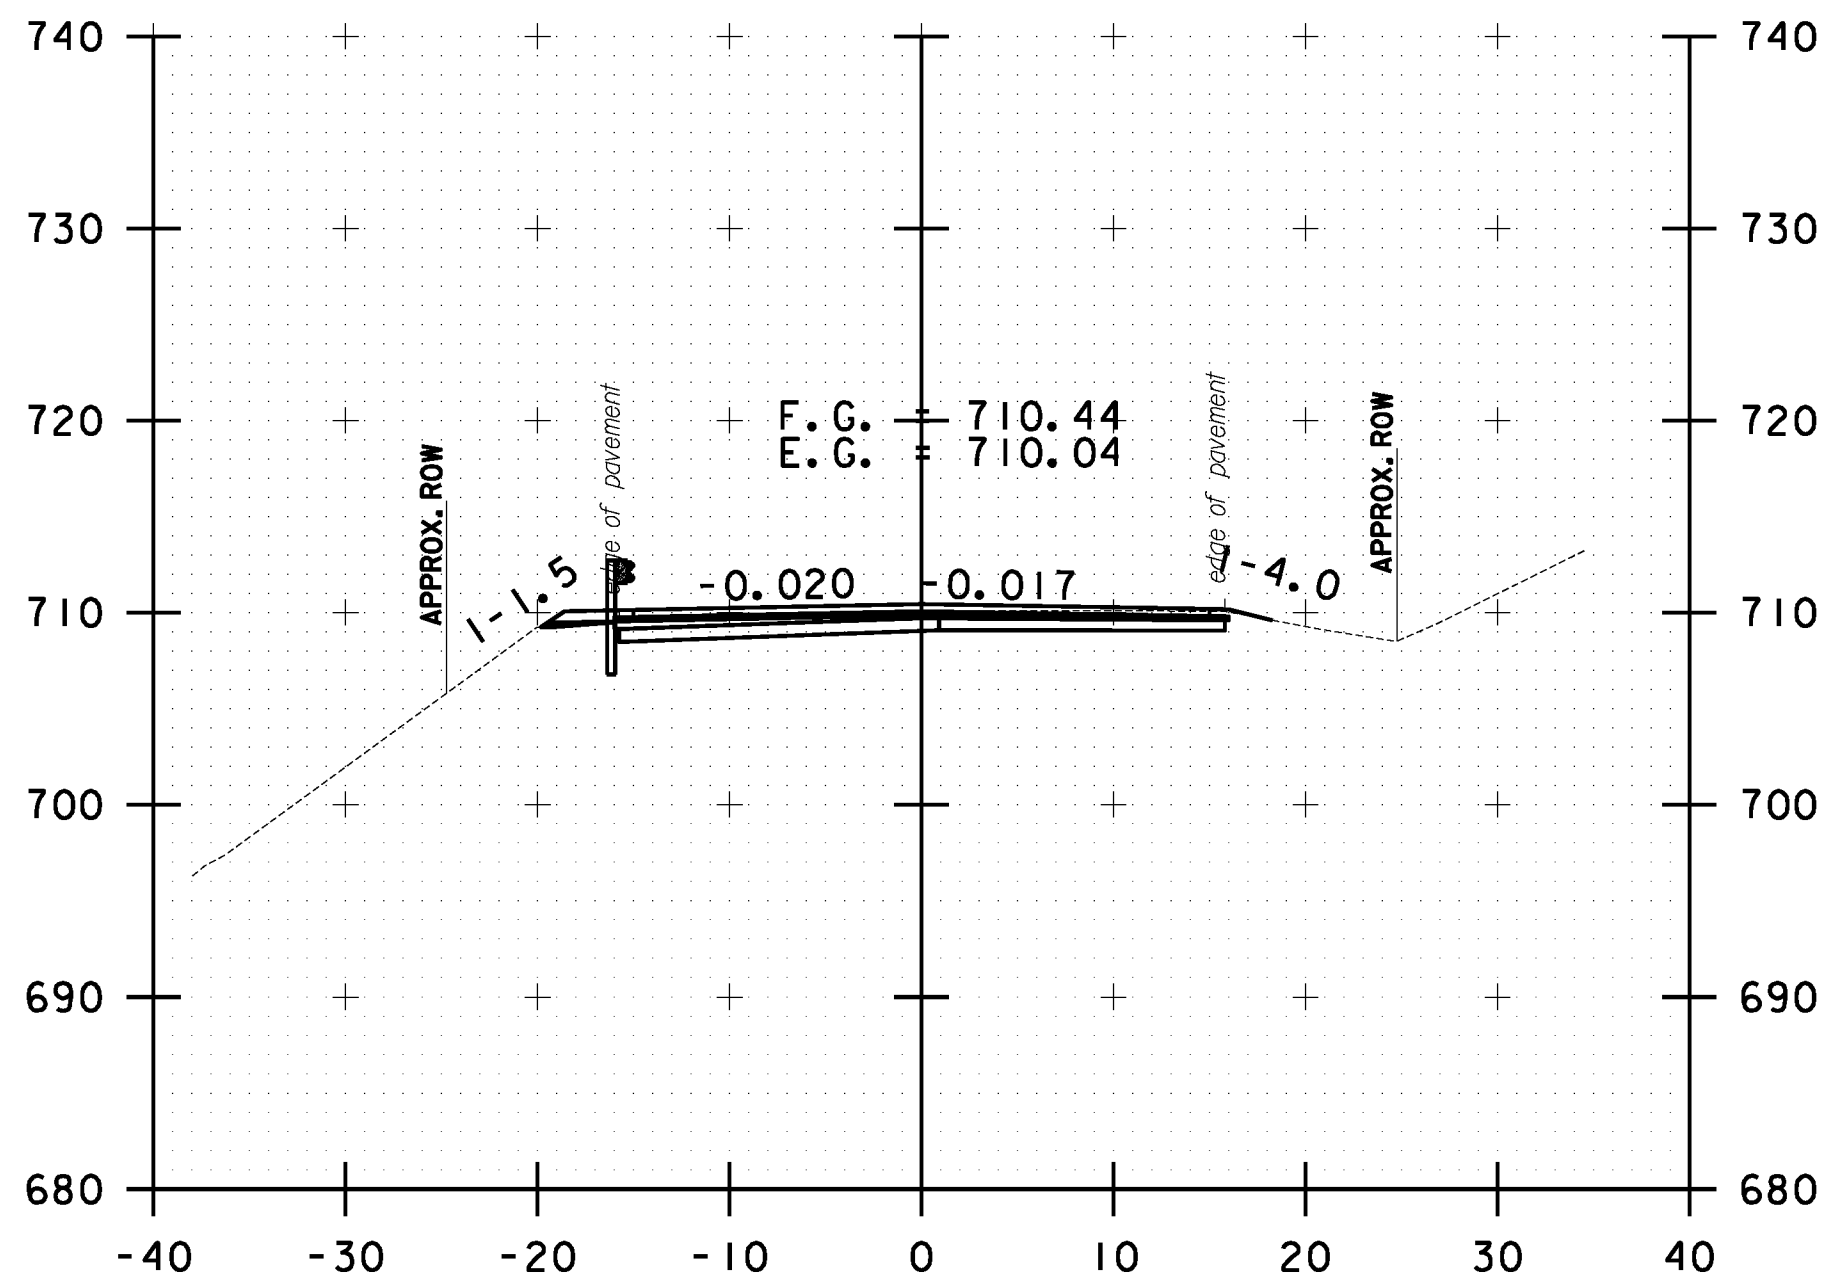


75+50.00

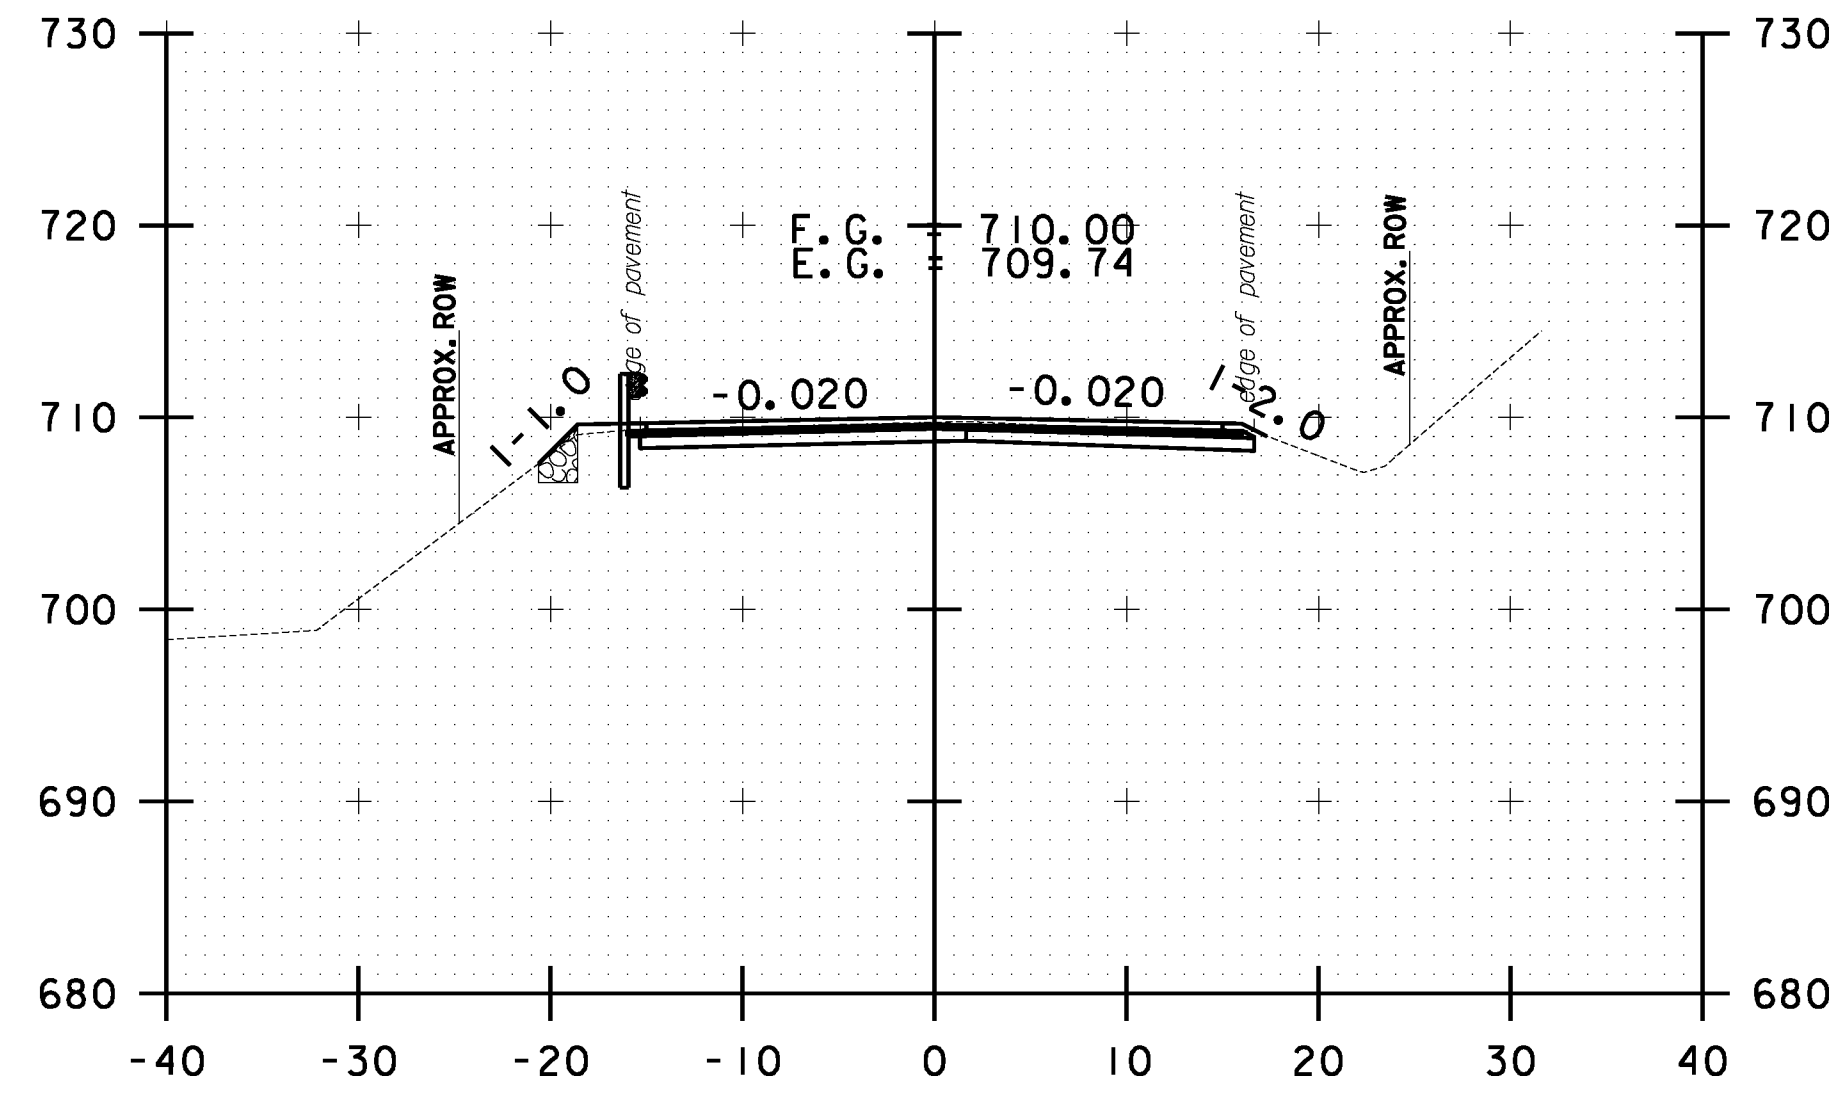

77+00.00

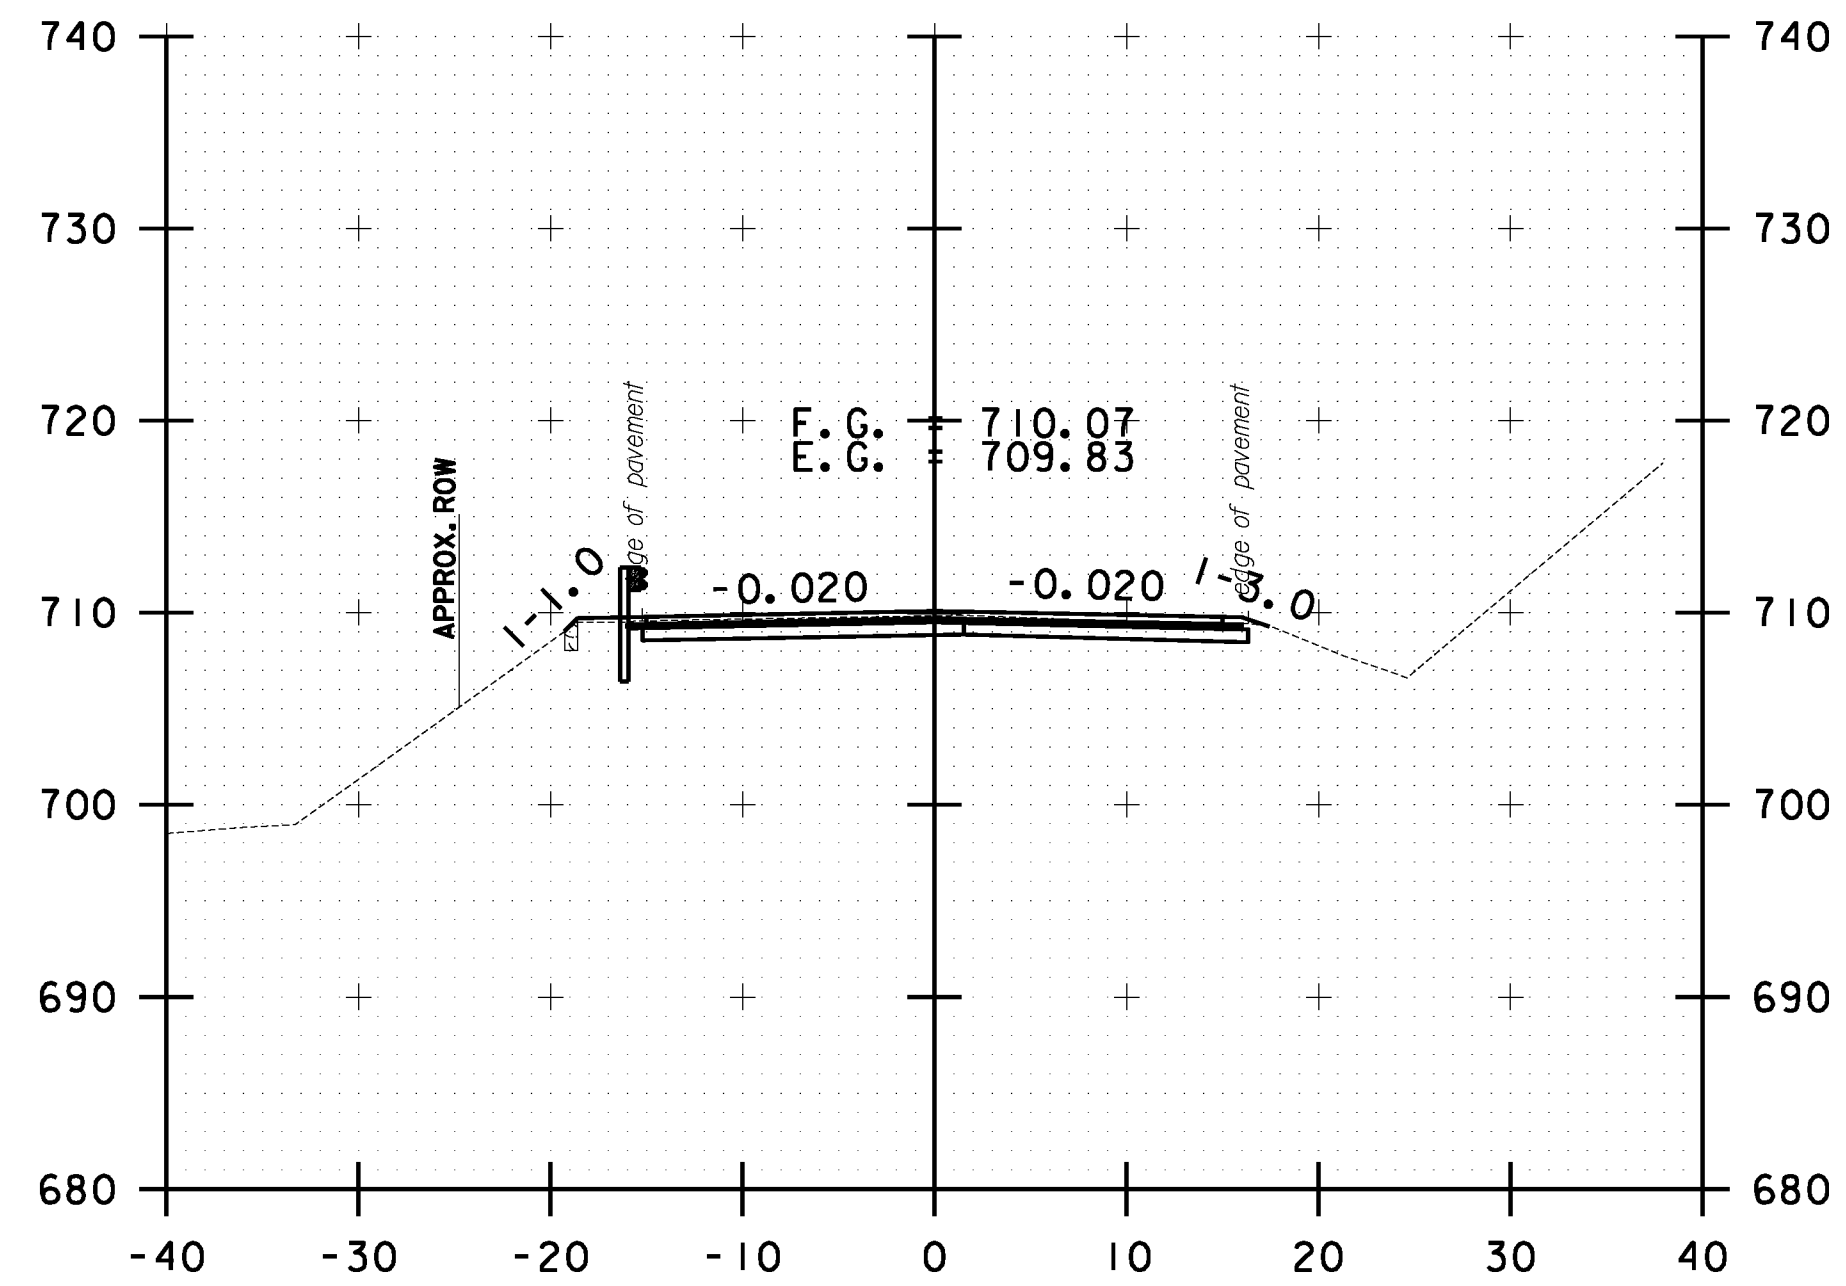

76+50.00

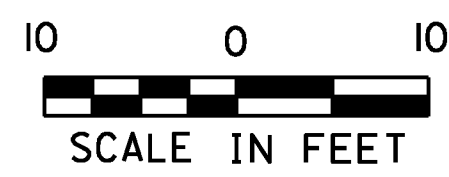

**STOCKBRIDGE
 CROSS SECTION
 SHEET #25**

PROJECT NAME: STOCKBRIDGE-BETHEL

PROJECT NUMBER: STP 2910(1)

FILE NAME: z10b214_stock_xc.dgn

PROJECT LEADER: D.E.G.

DESIGNED BY: L.M.B.

IPARM FILE: z10b214xs25.1

PLOT DATE: 3/17/2014

DRAWN BY: W.G.P.

CHECKED BY: J.P.S.

SHEET 238 OF 397