




FILE NAME = Y:\P\c\ass\ANY\K2\22425\CADD\MSTN\10b214_stock.nc.dgn
 DATE/TIME = 3/17/2014
 USER = 4916

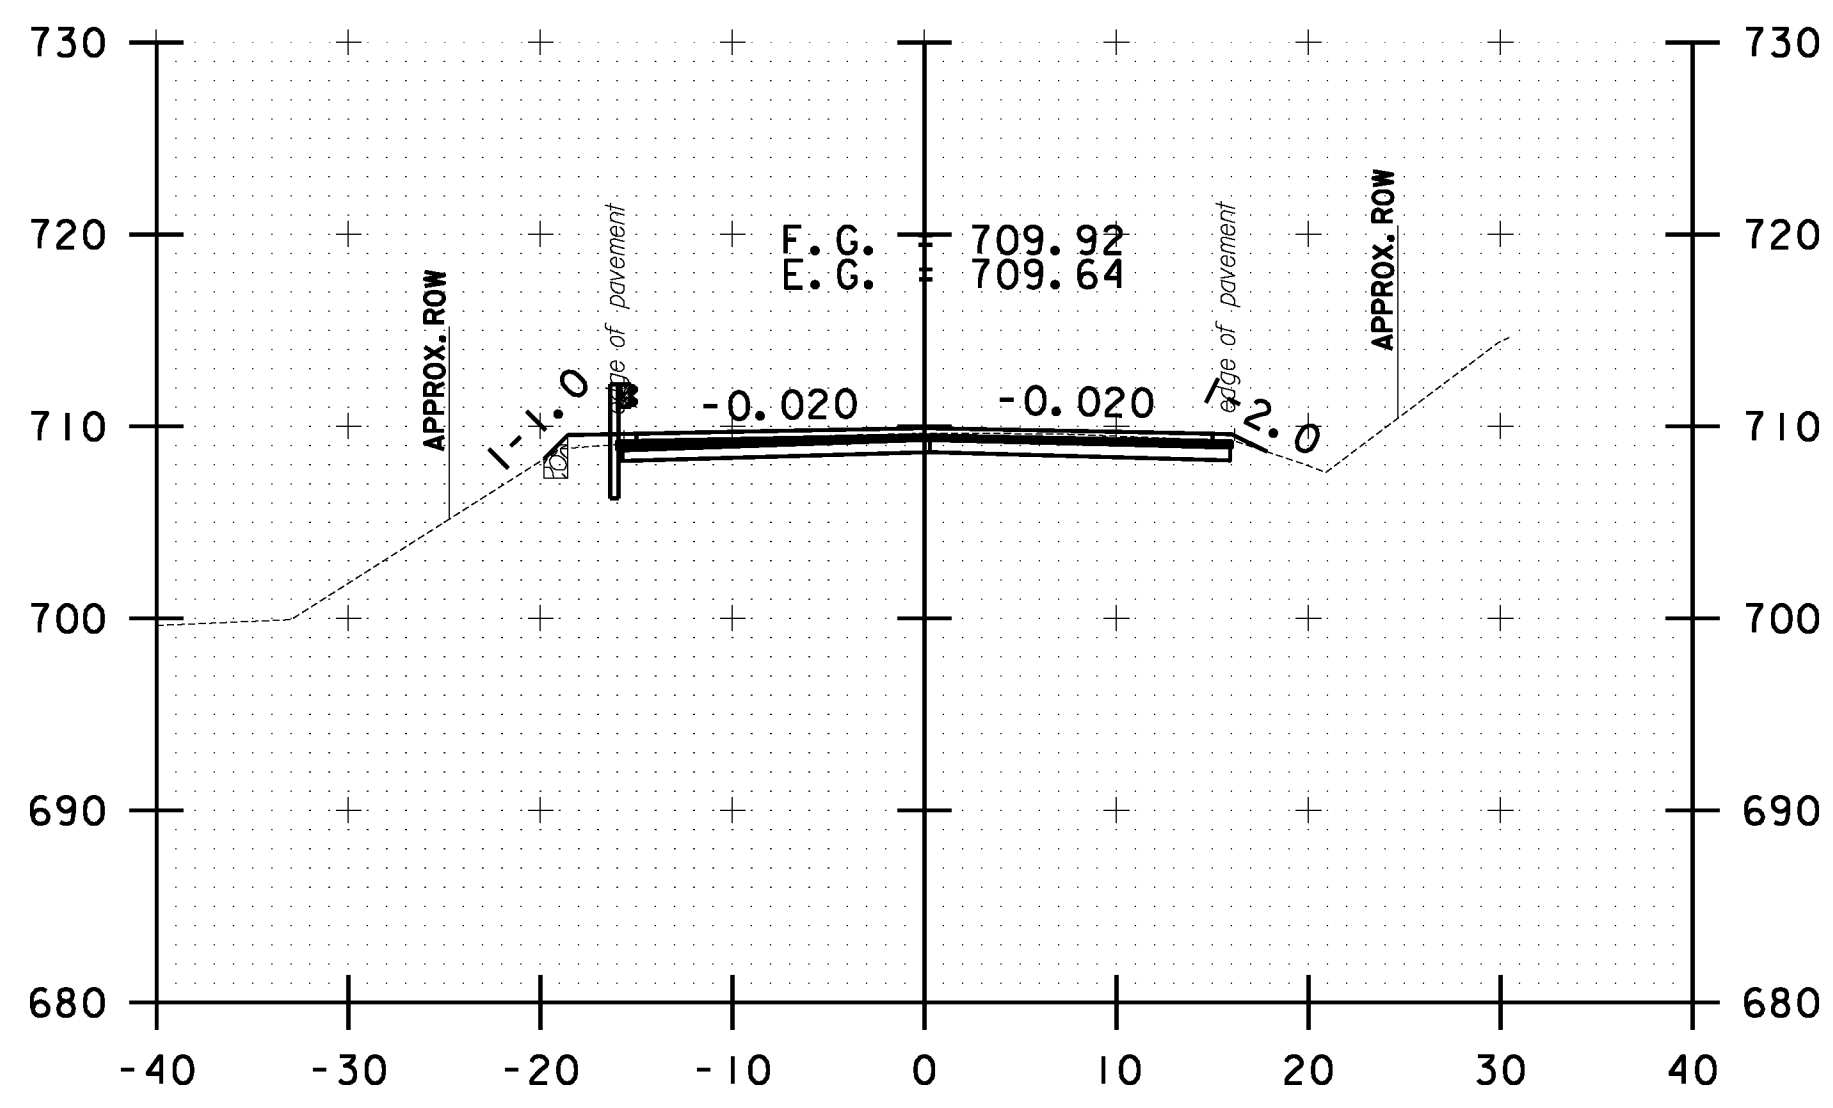


78+00.00

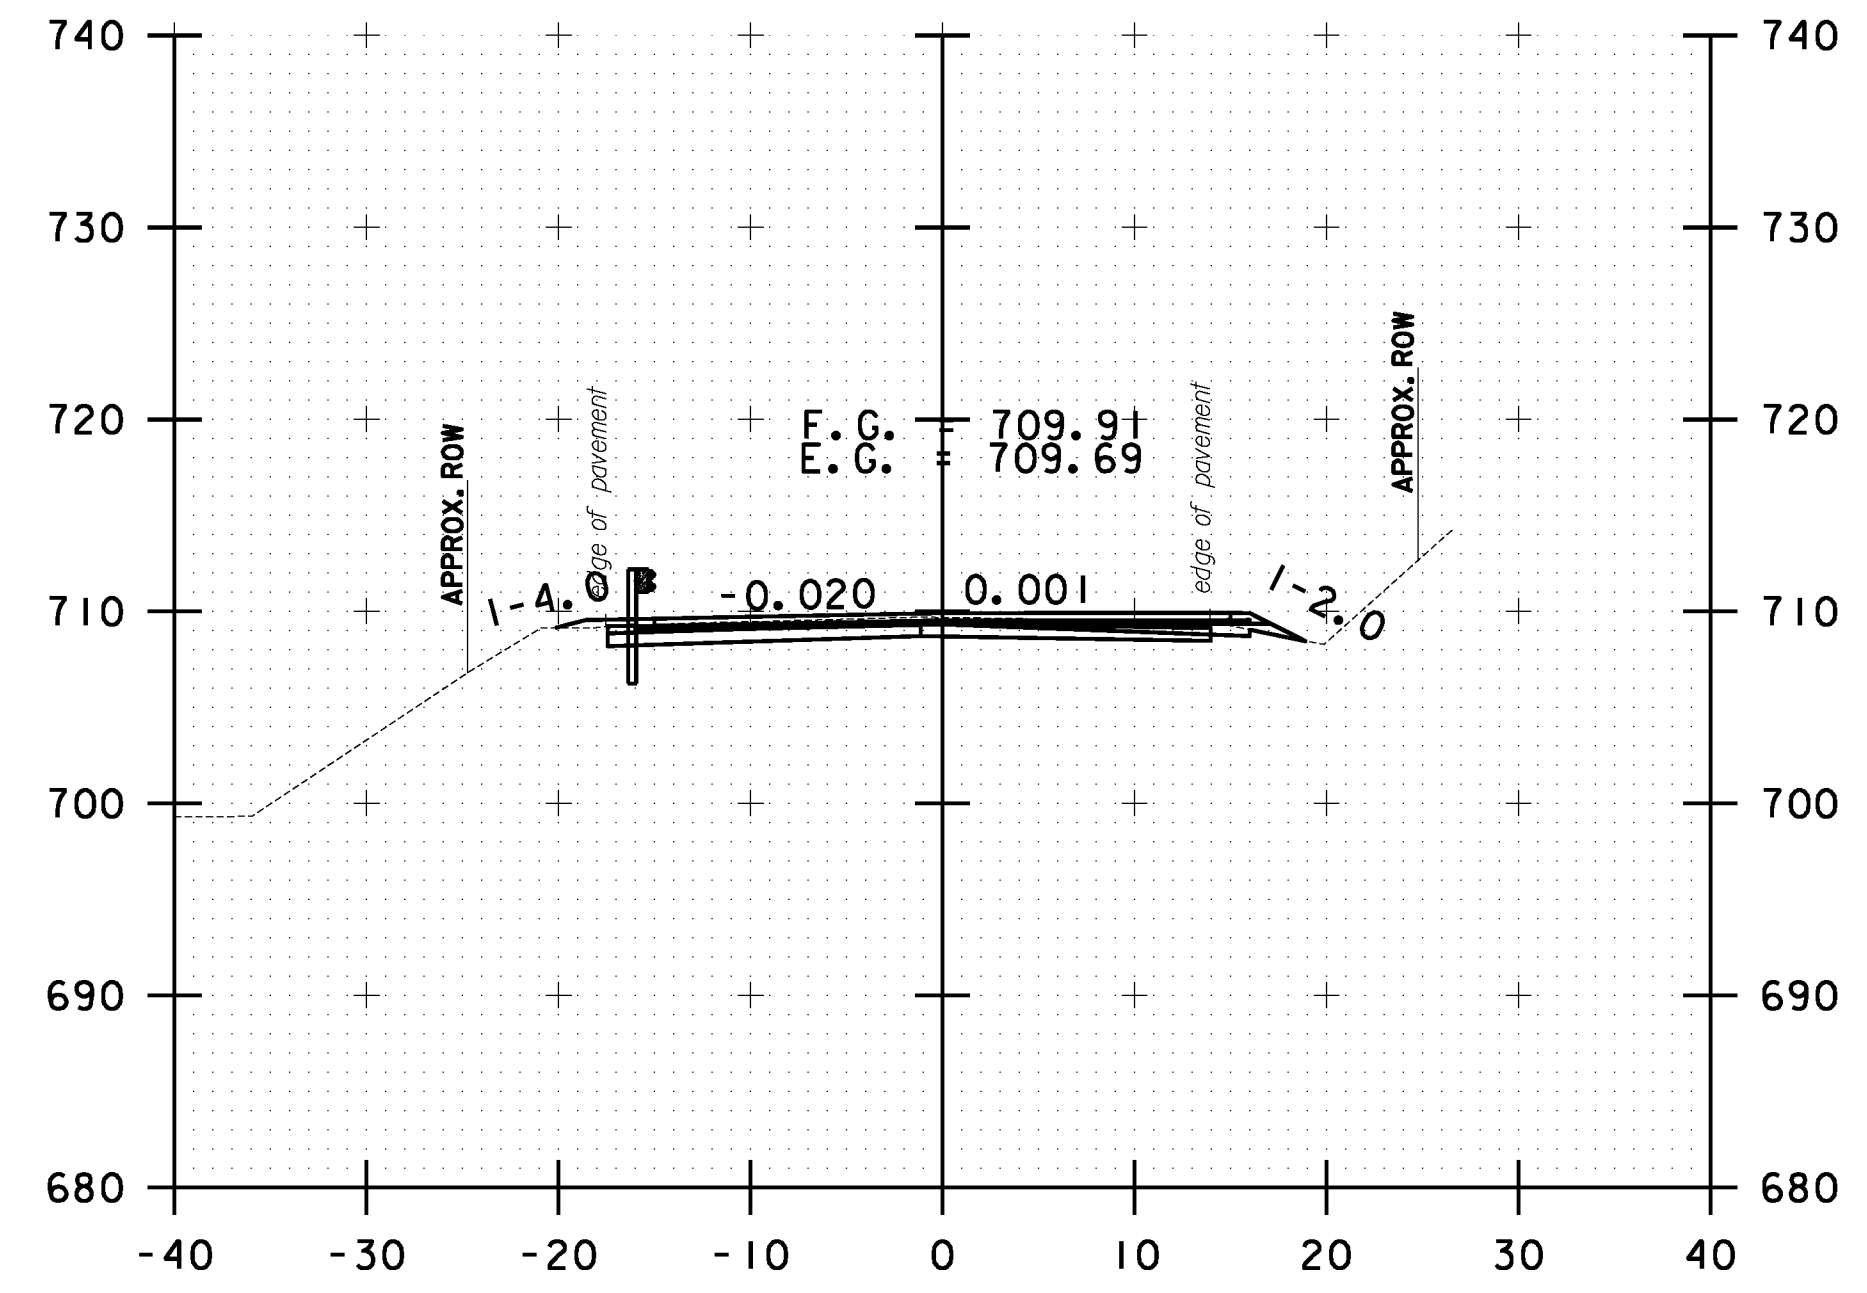


79+00.00

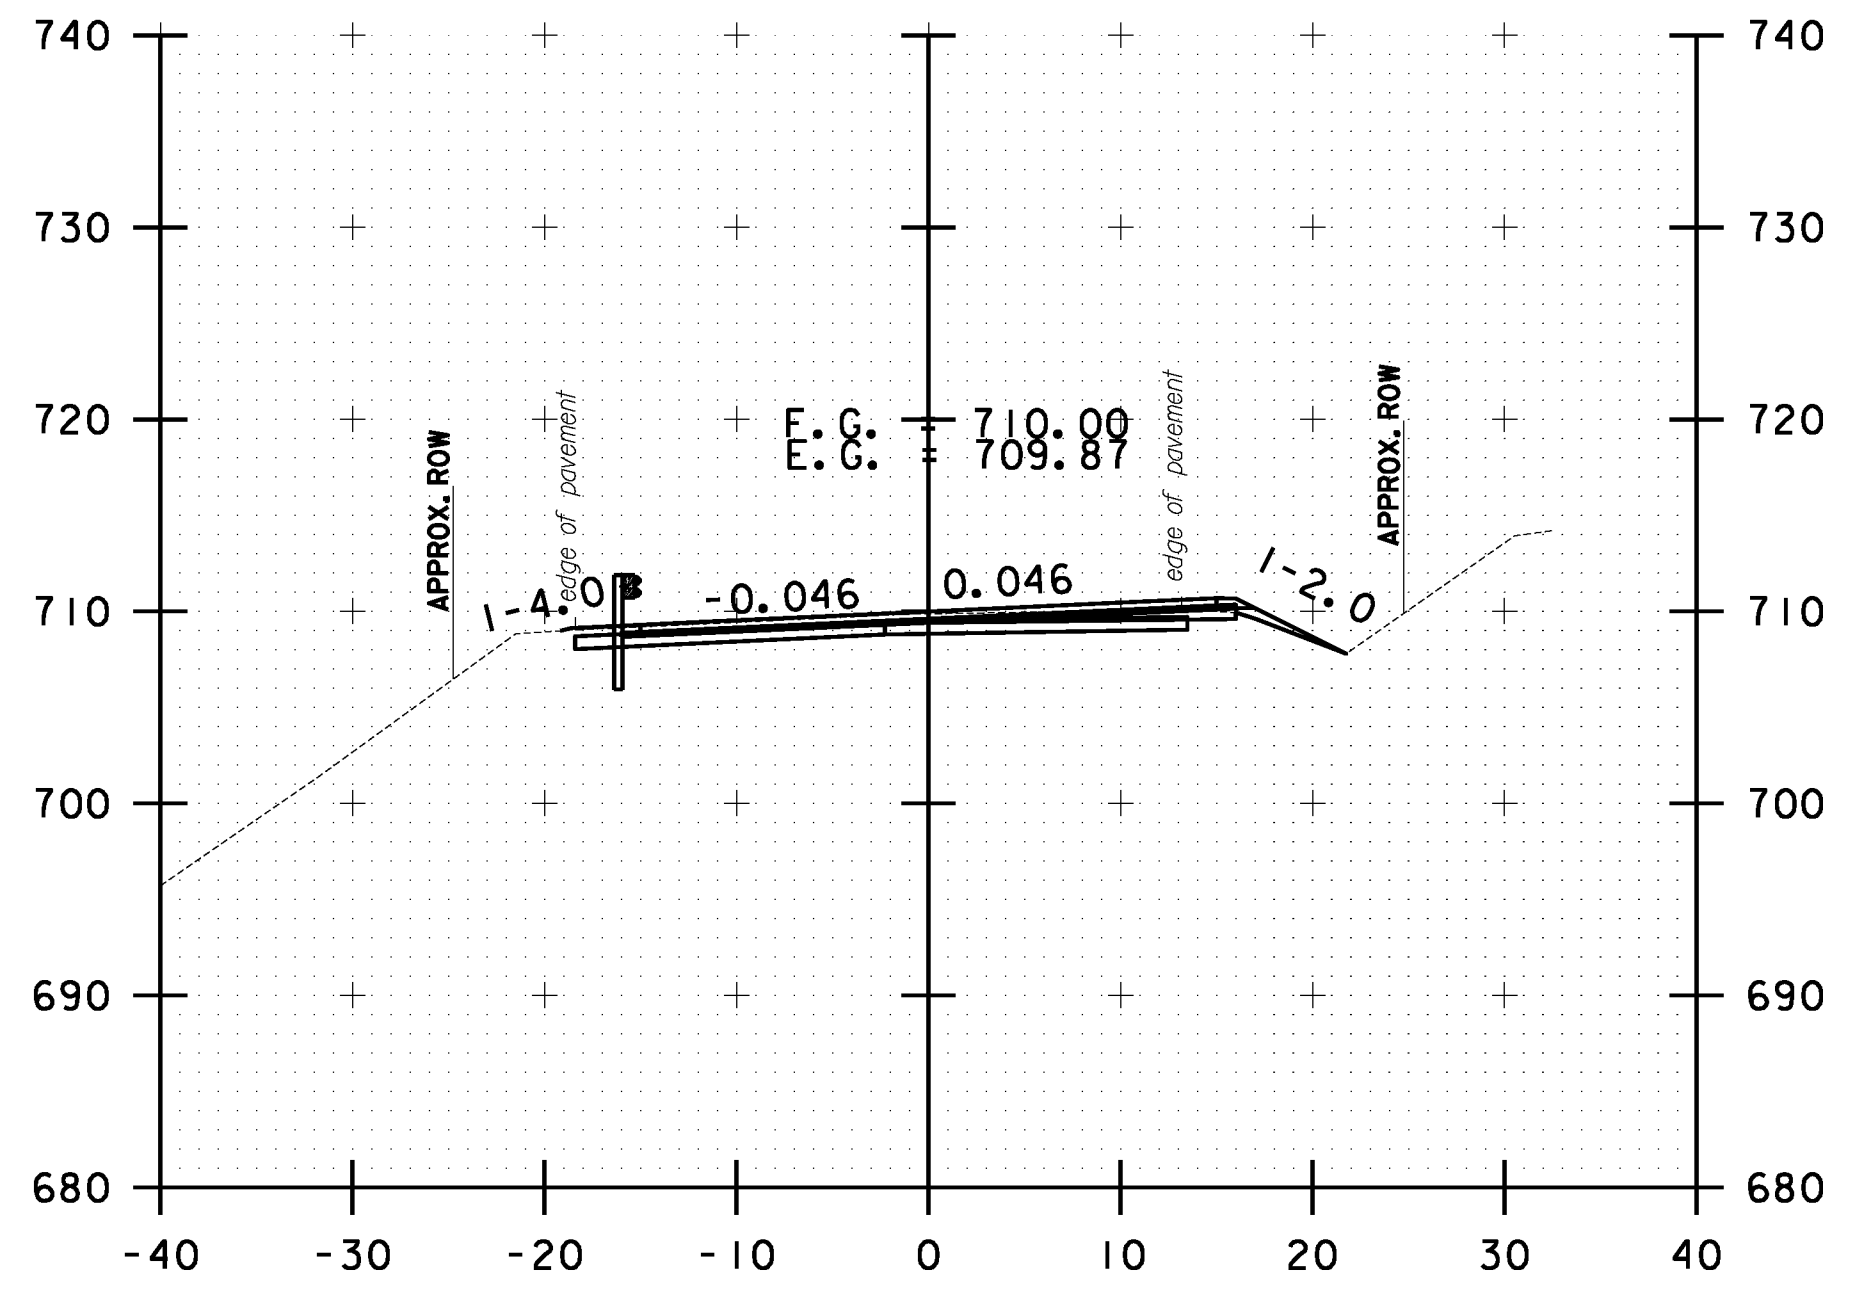


80+00.00

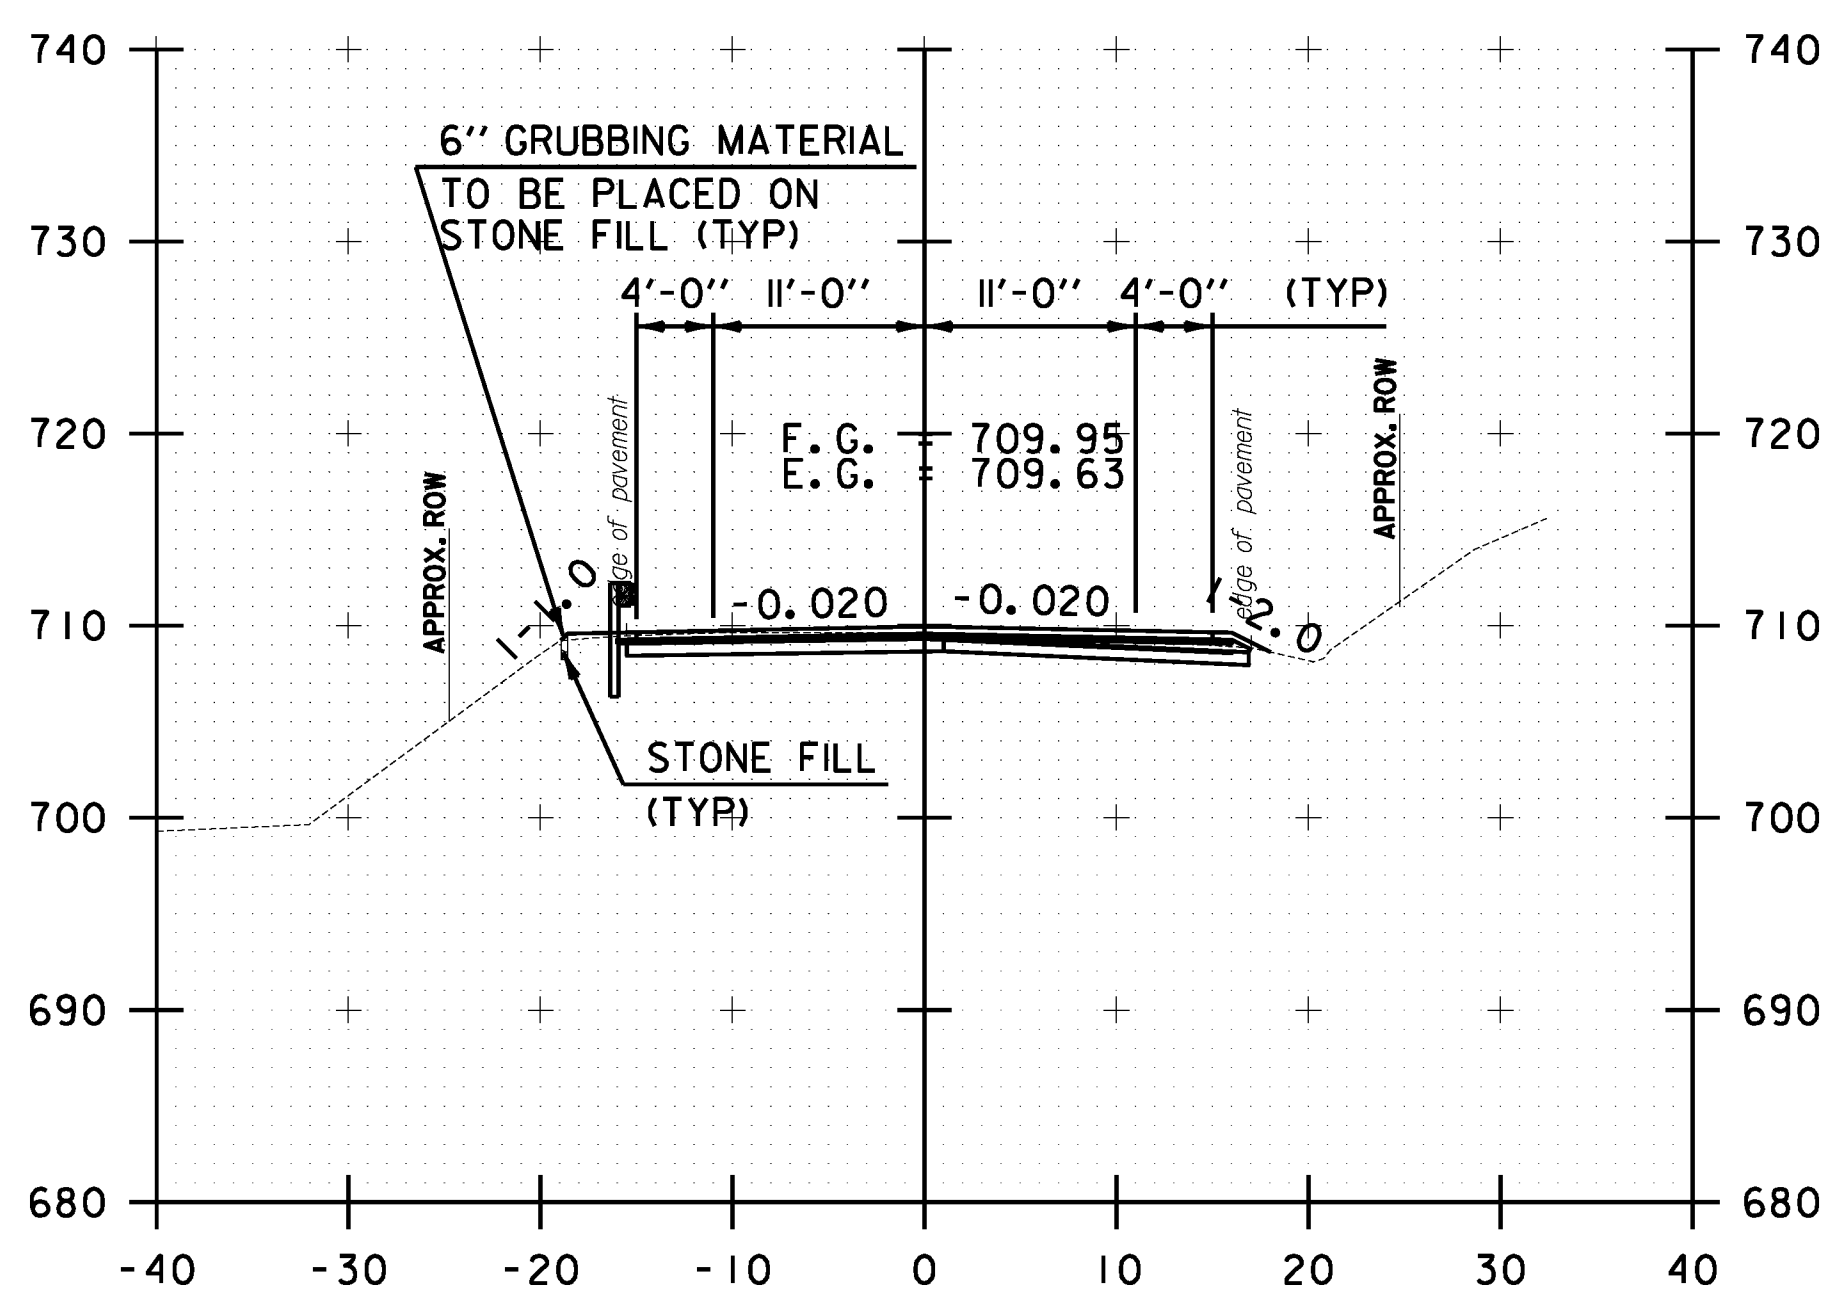


77+50.00

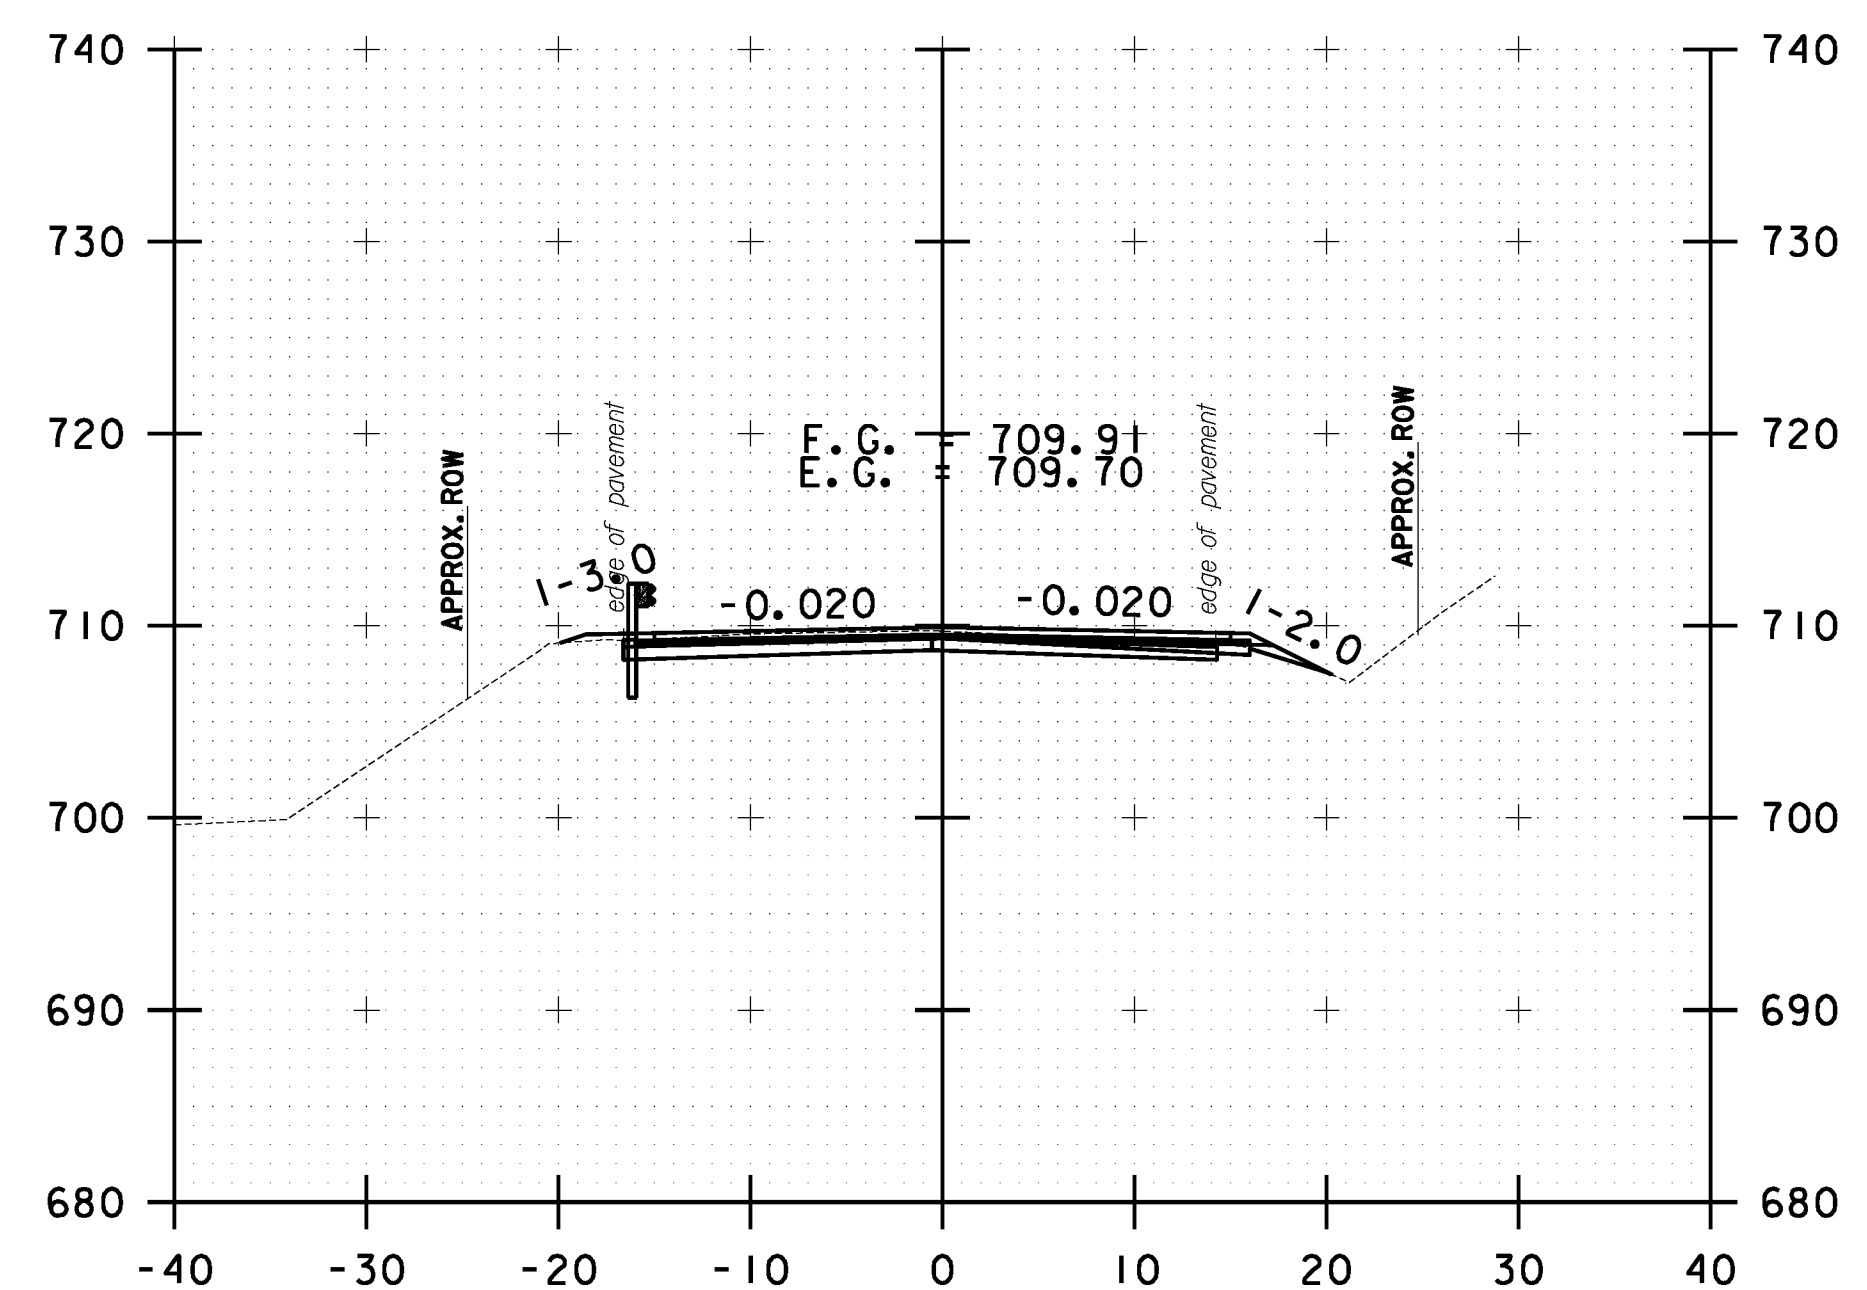

78+50.00

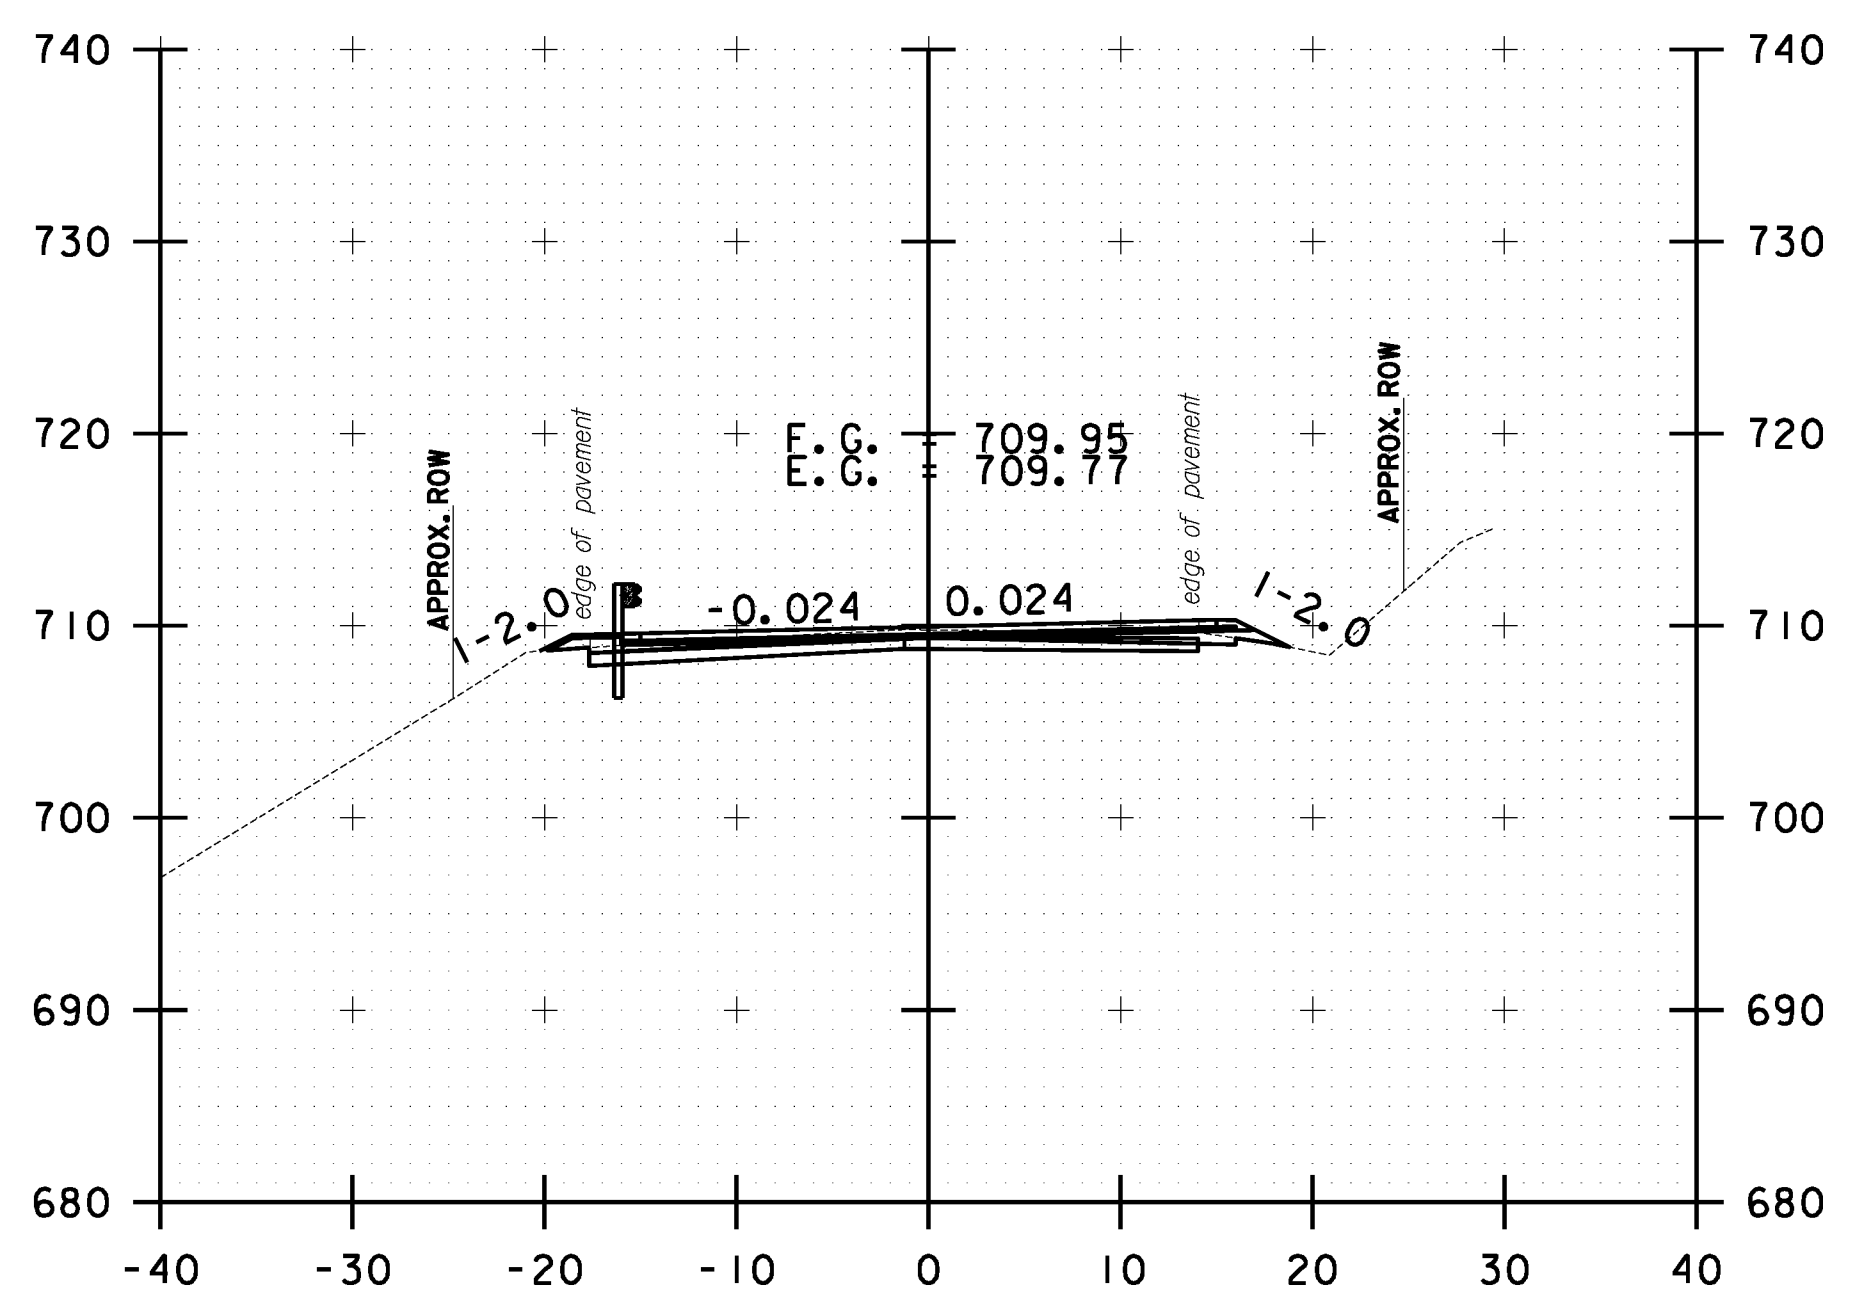

79+50.00

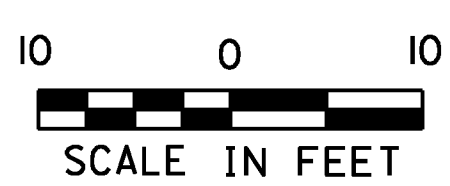

STOCKBRIDGE CROSS SECTION SHEET #26	PROJECT NAME: STOCKBRIDGE-BETHEL
	PROJECT NUMBER: STP 2910(1)
	FILE NAME: z10b214_stock.xc.dgn
	IPARM FILE: z10b214xs26.1
	PLOT DATE: 3/17/2014
	DRAWN BY: W.G.P.
	CHECKED BY: J.P.S.
	SHEET 239 OF 397