




FILE NAME = Y:\P\c\res\any\k2\22426\CADD\MSTN\10b214_stock.nc.dgn
 DATE/TIME = 3/17/2014
 USER = 4916

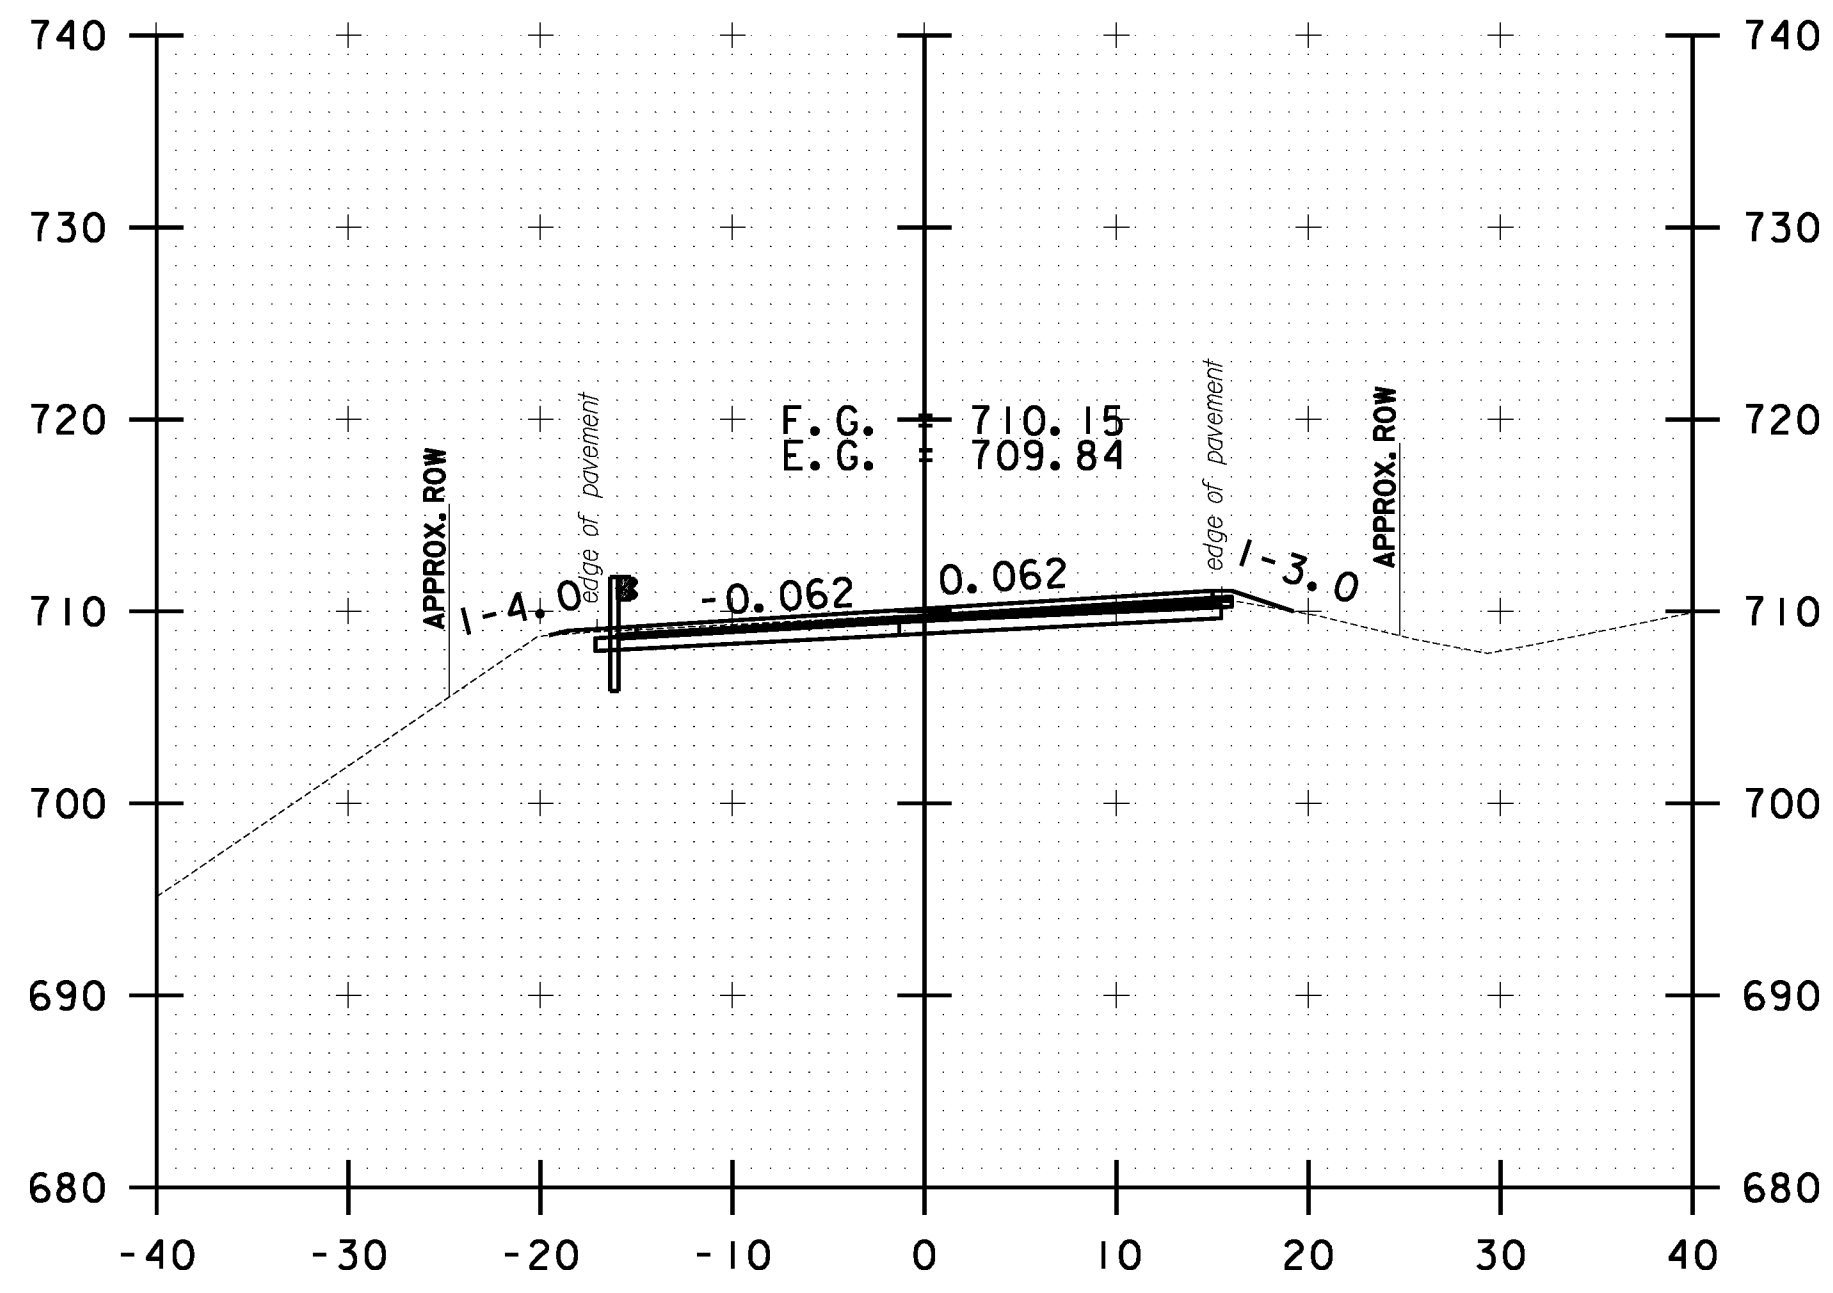


81+00.00

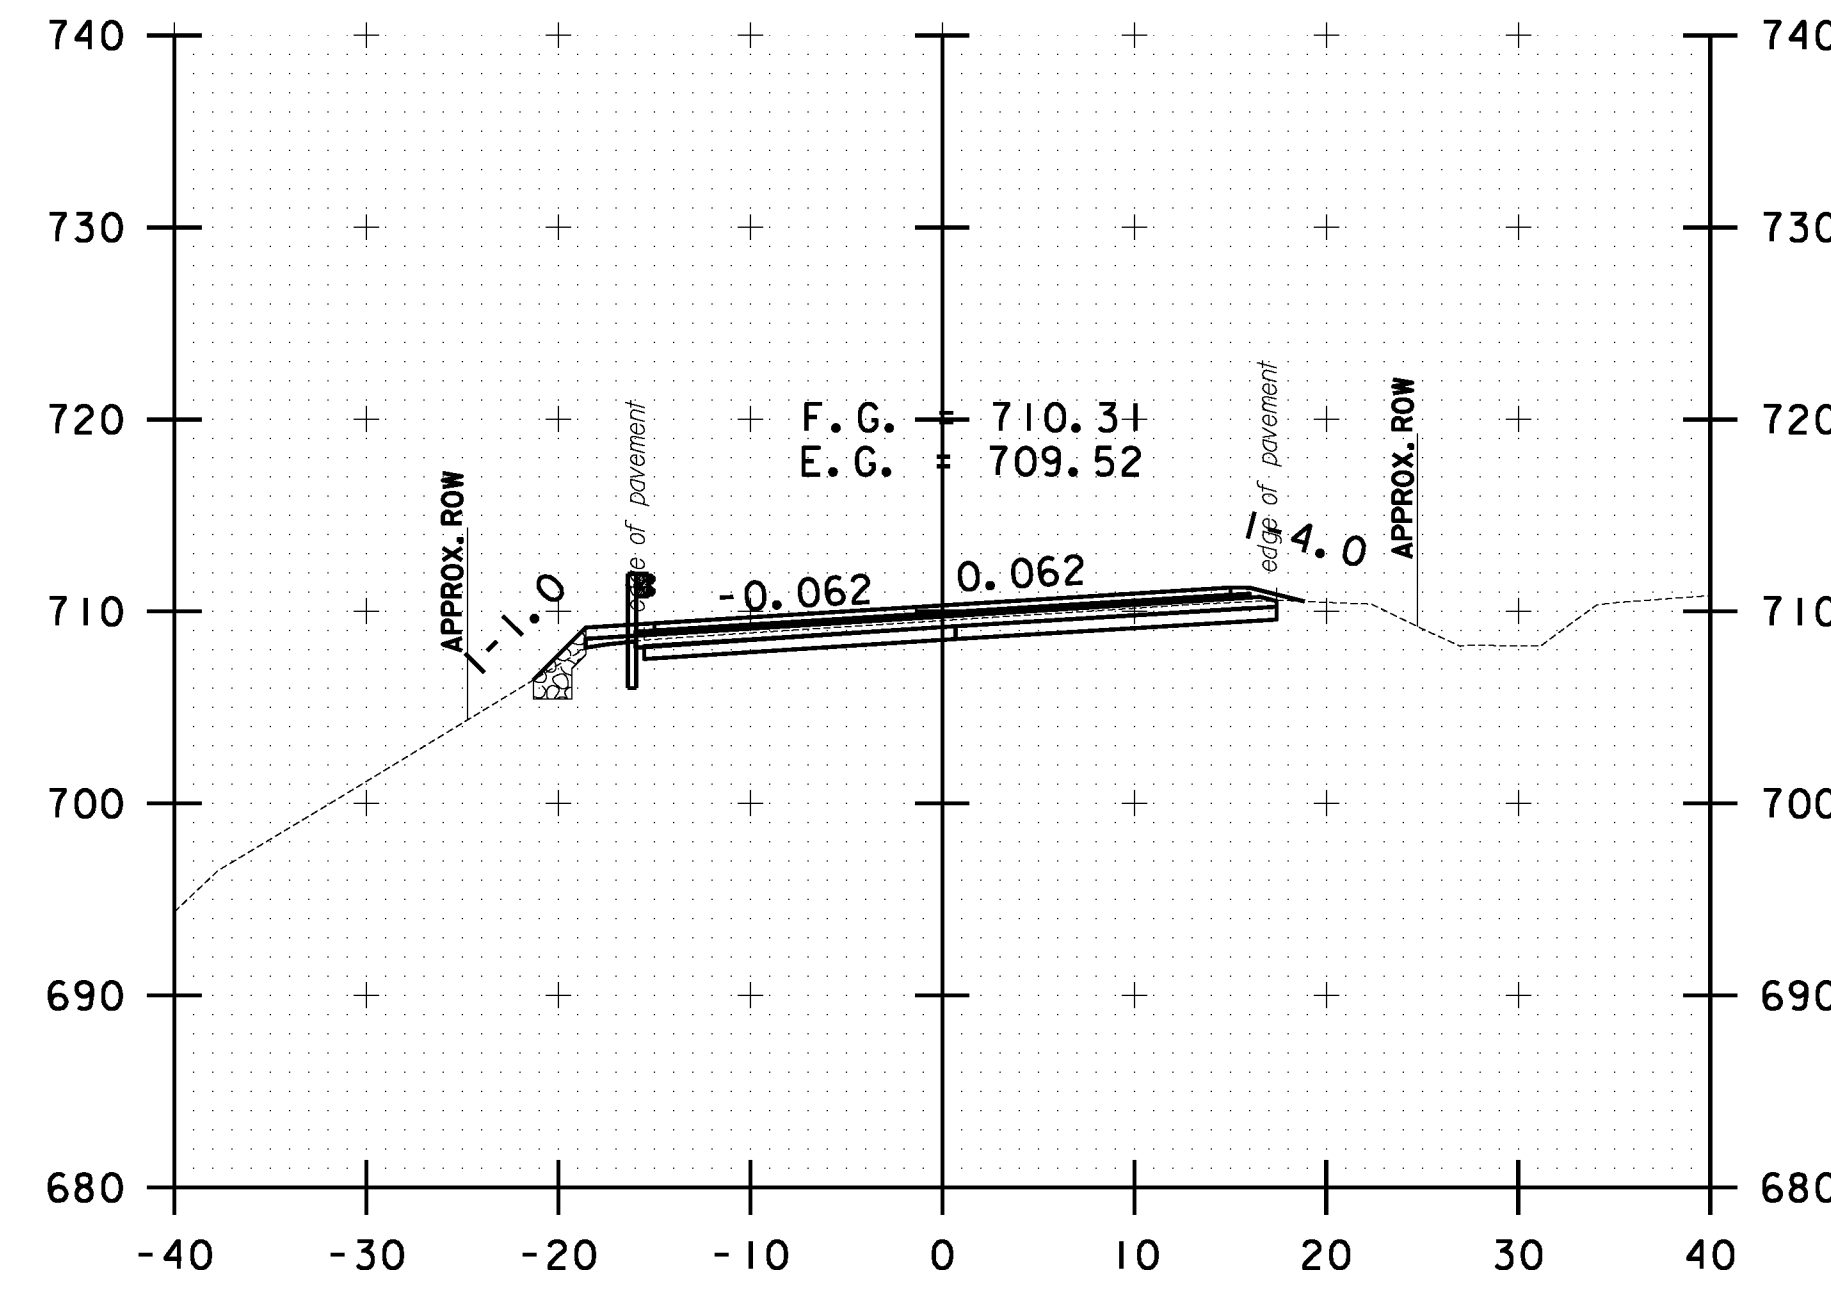


82+00.00

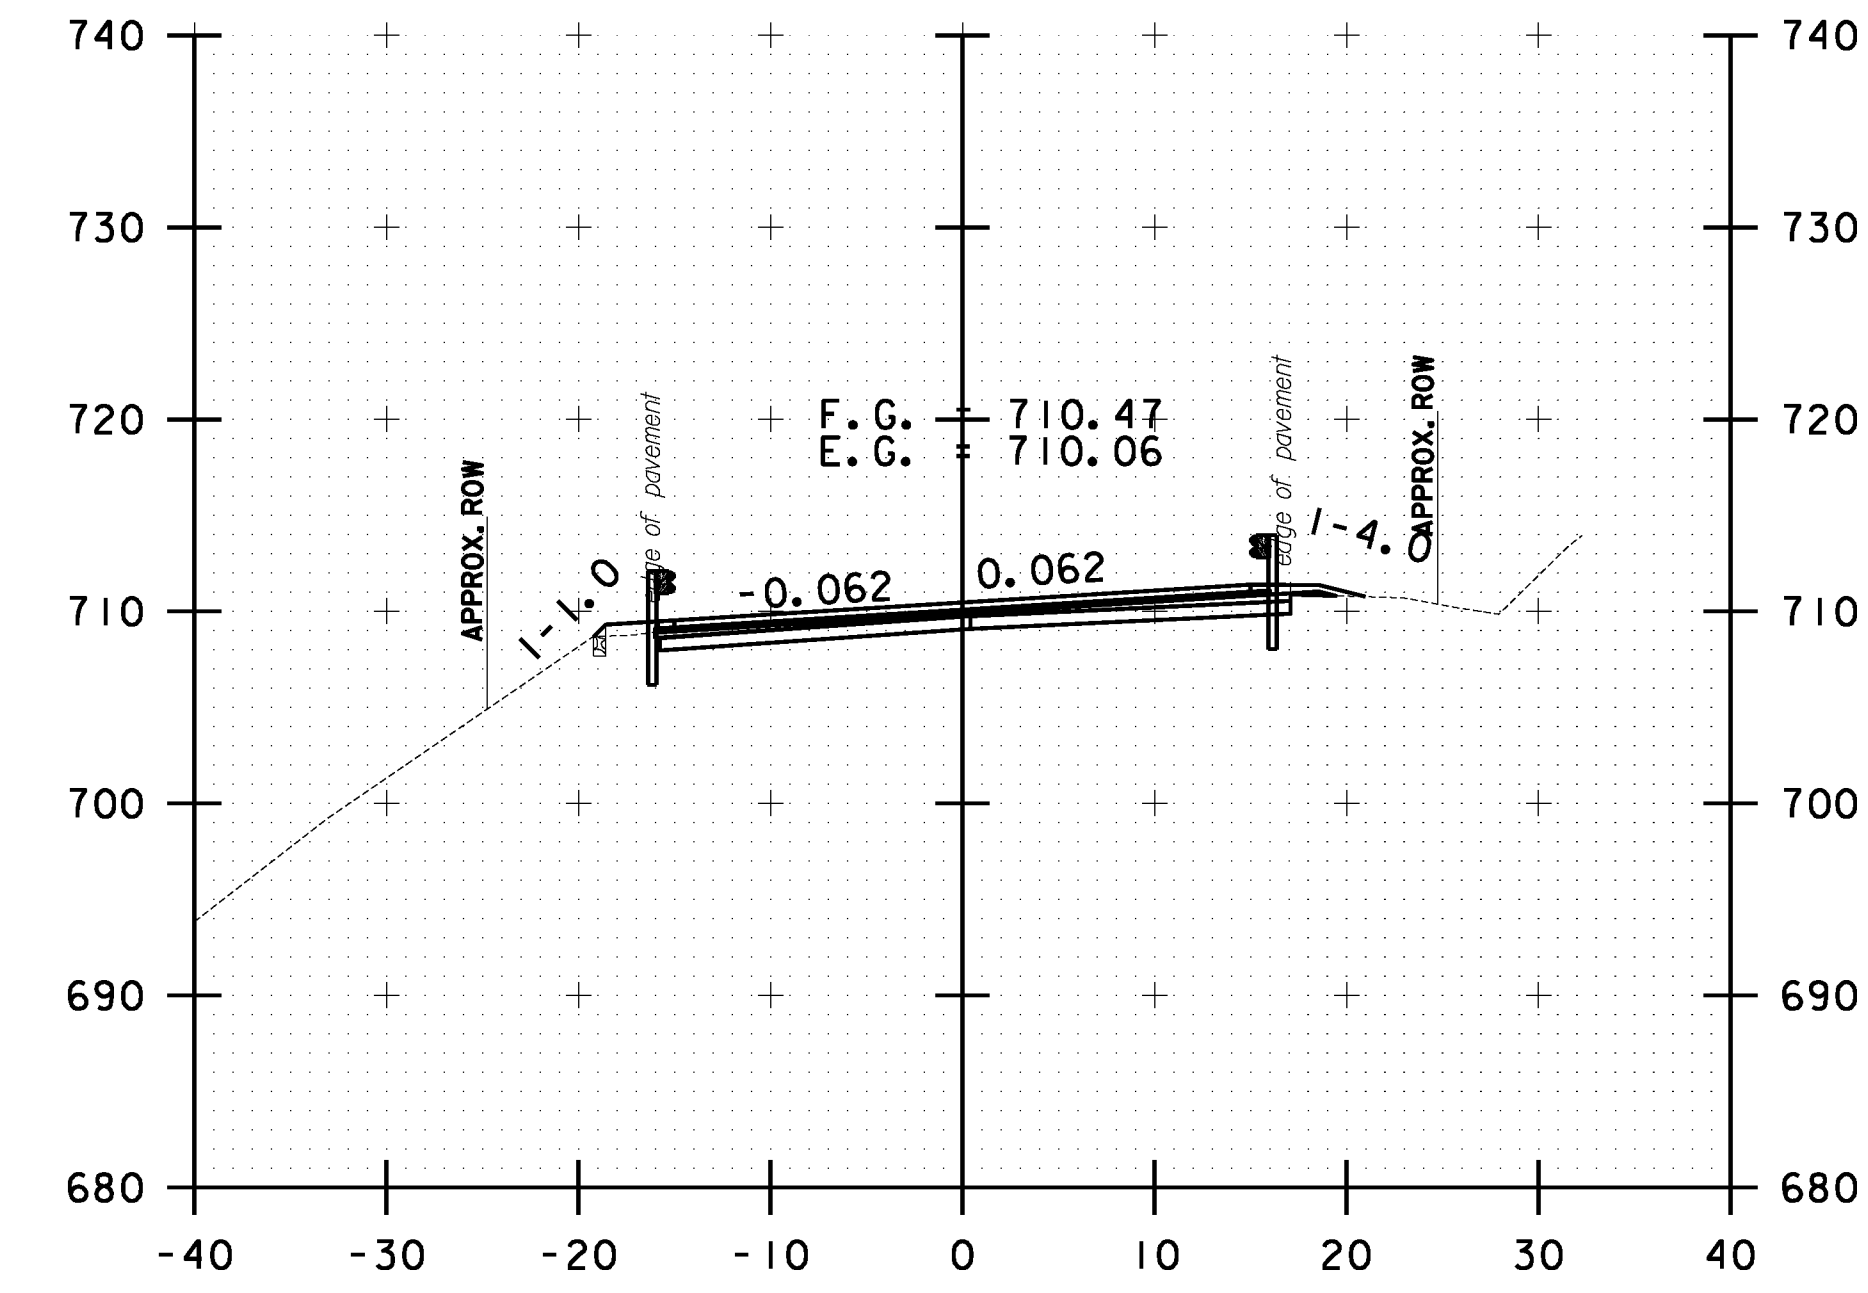


83+00.00

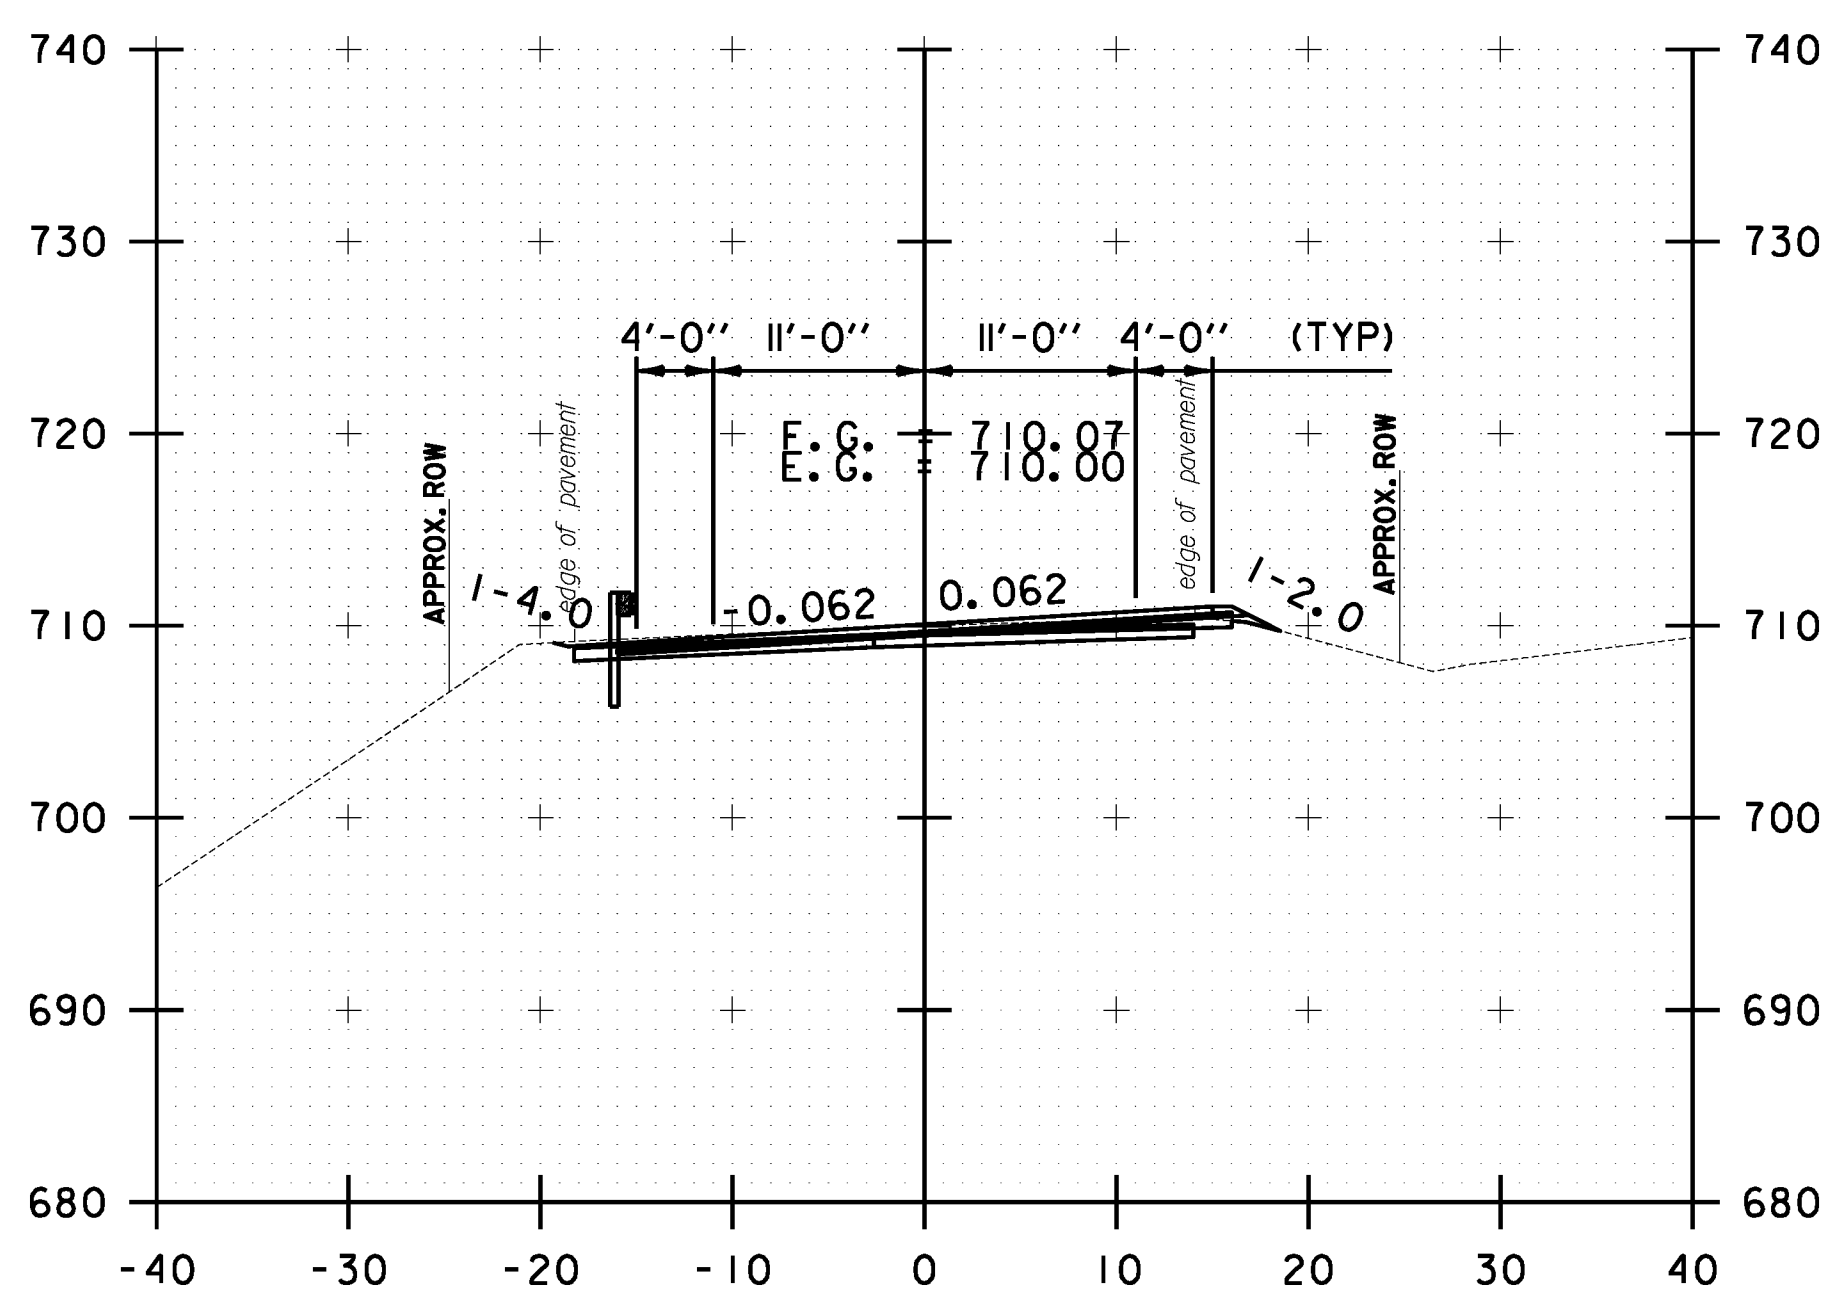


80+50.00

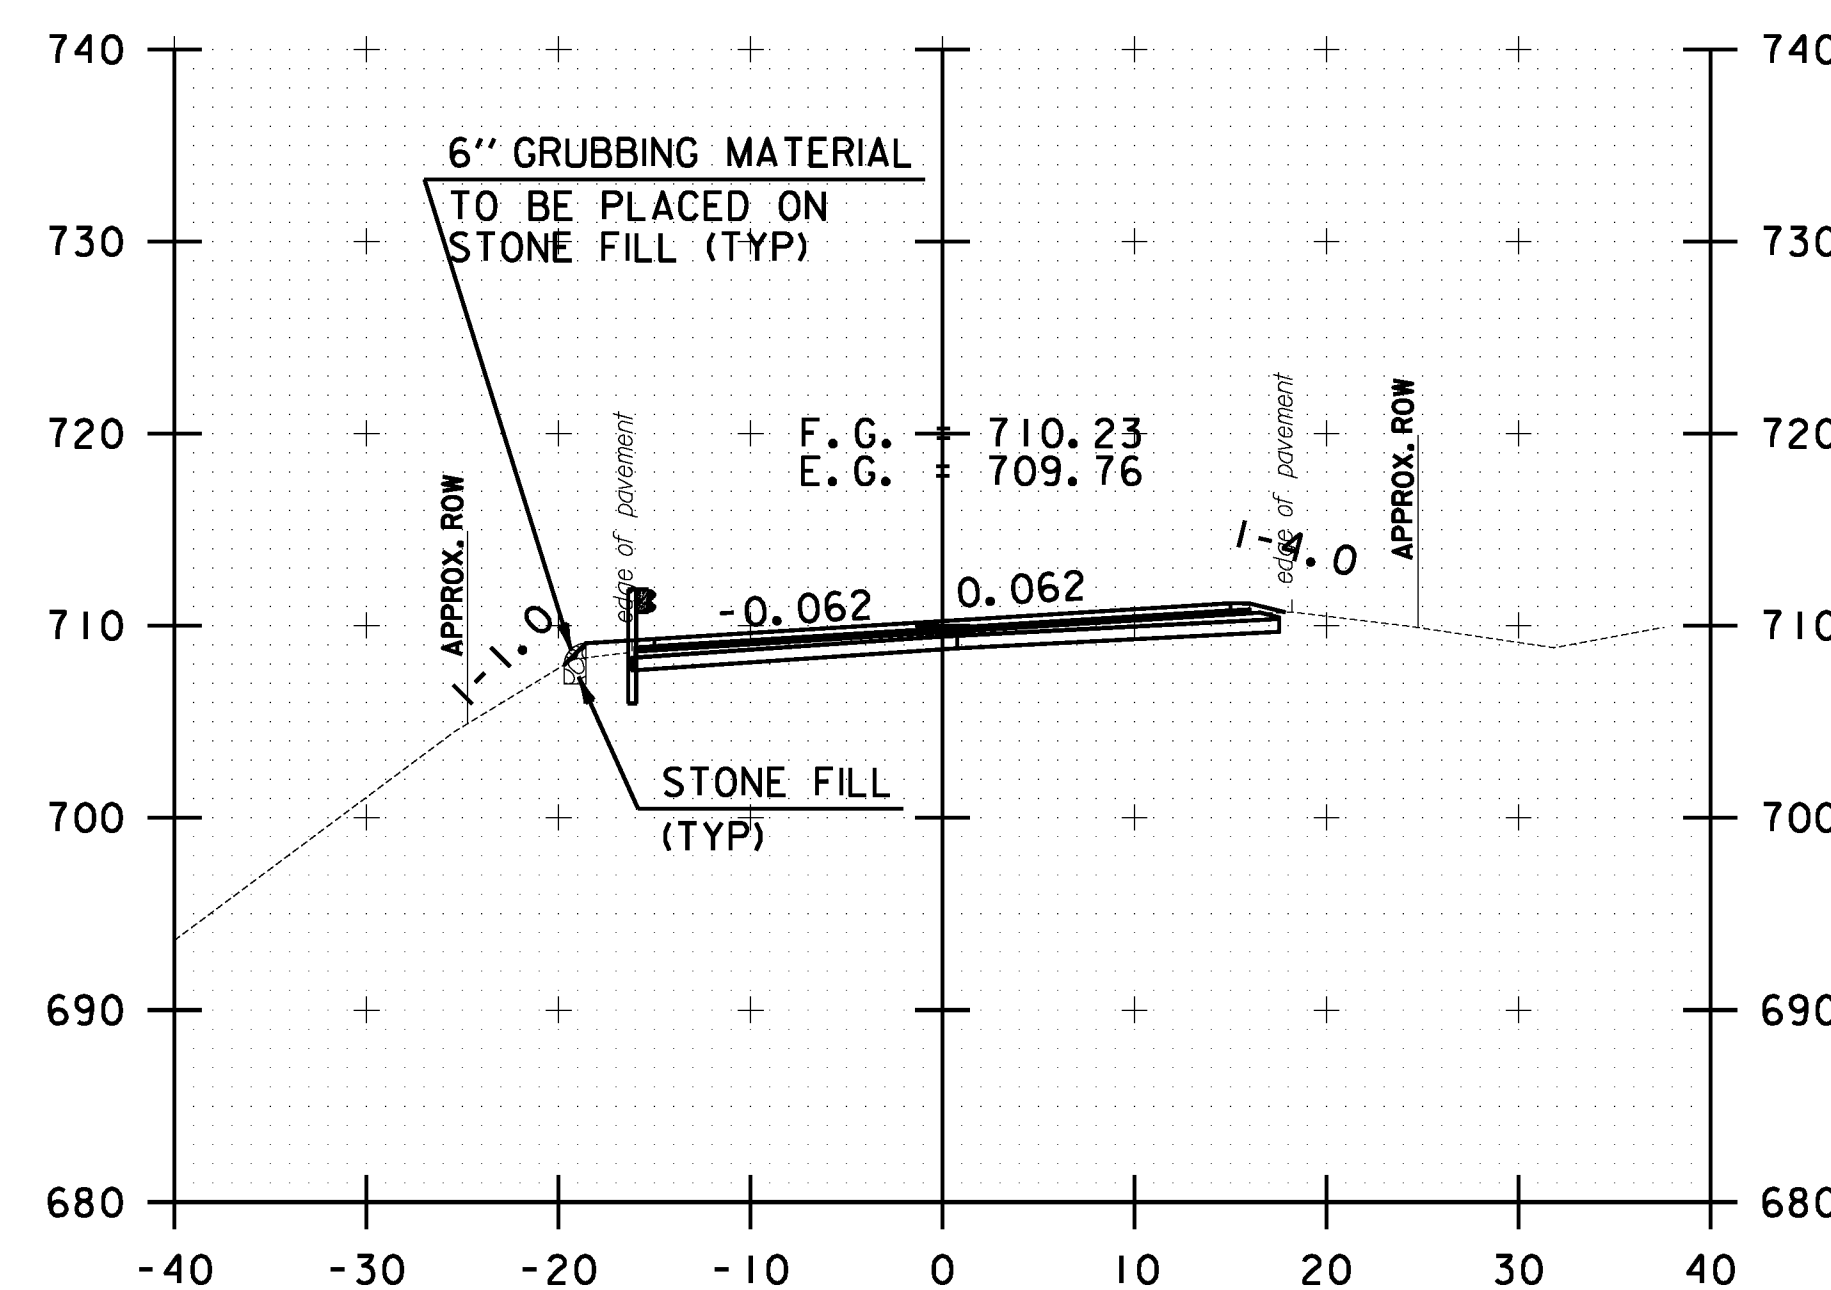

81+50.00

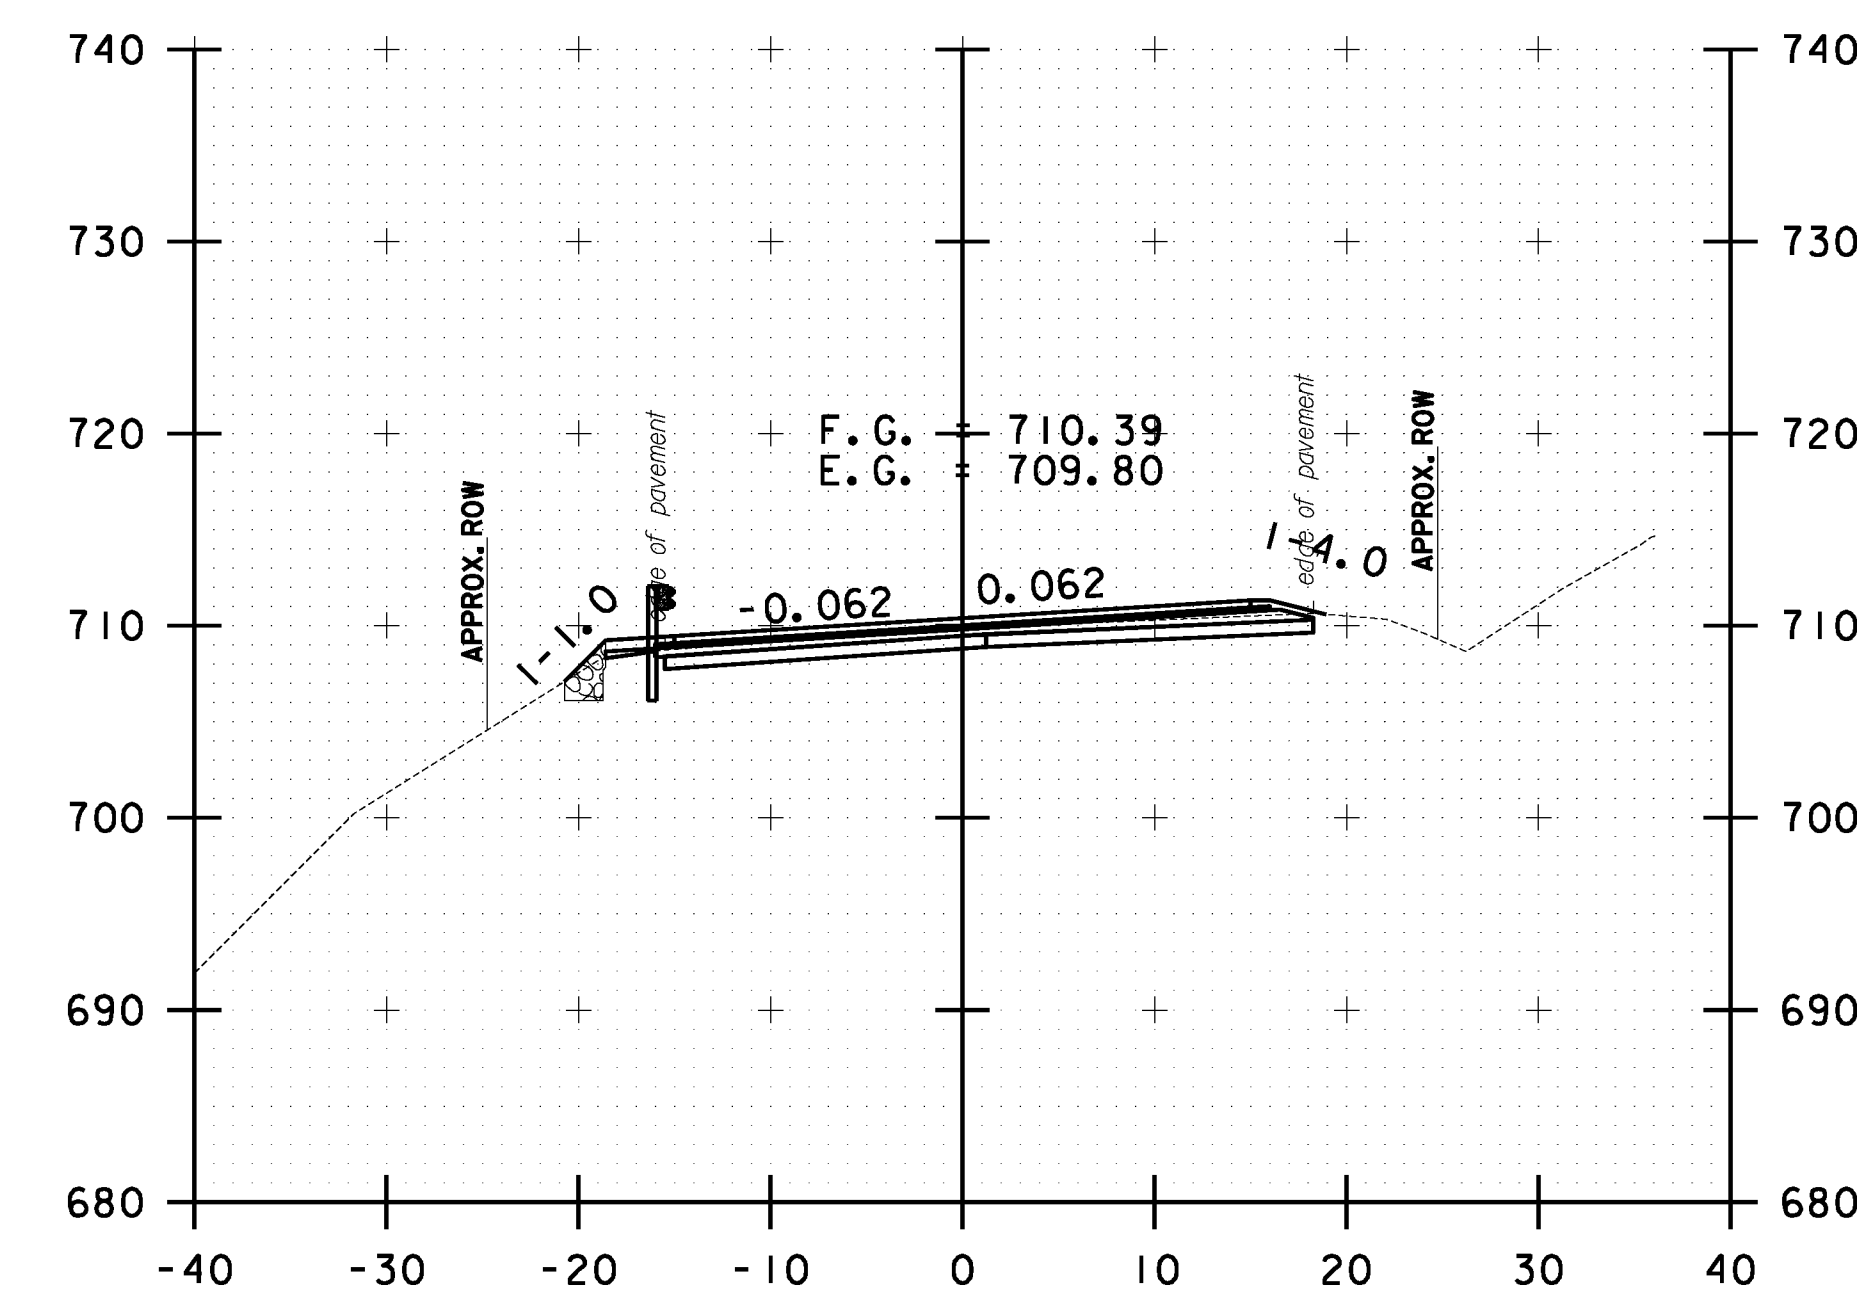

82+50.00

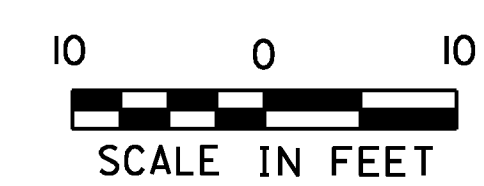

STOCKBRIDGE CROSS SECTION SHEET #27	PROJECT NAME: STOCKBRIDGE-BETHEL
	PROJECT NUMBER: STP 2910(1)
	FILE NAME: z10b214_stock.xc.dgn
	IPARM FILE: z10b214xs27.1
	PLOT DATE: 3/17/2014
	DRAWN BY: W.G.P.
	CHECKED BY: J.P.S.
	SHEET 240 OF 397