




FILE NAME = Y:\P\c\res\any\k2\22425\CADD\MSTN\10b214_stock.nc.dgn
 DATE/TIME = 3/17/2014
 USER = 4916

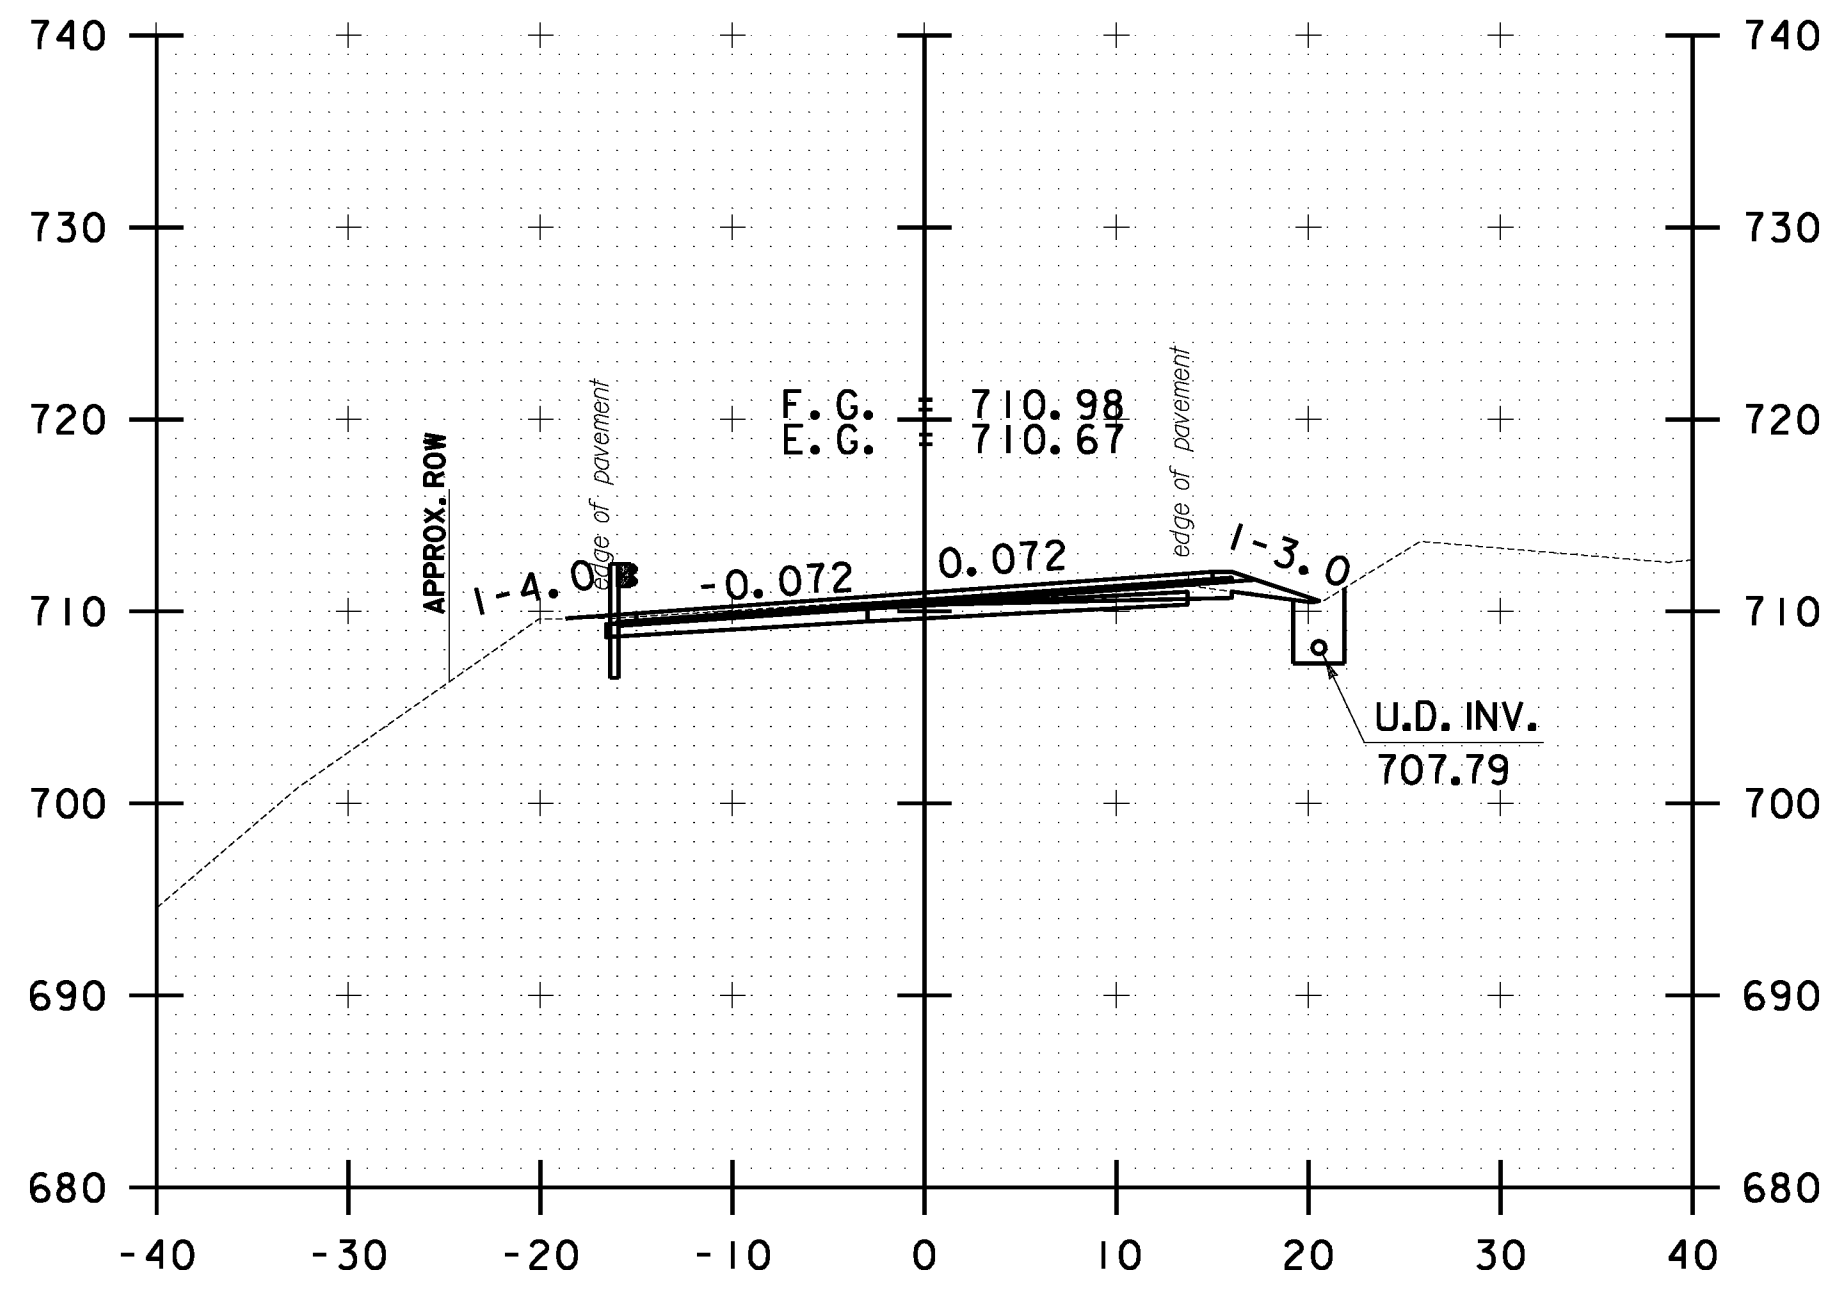


87+00.00

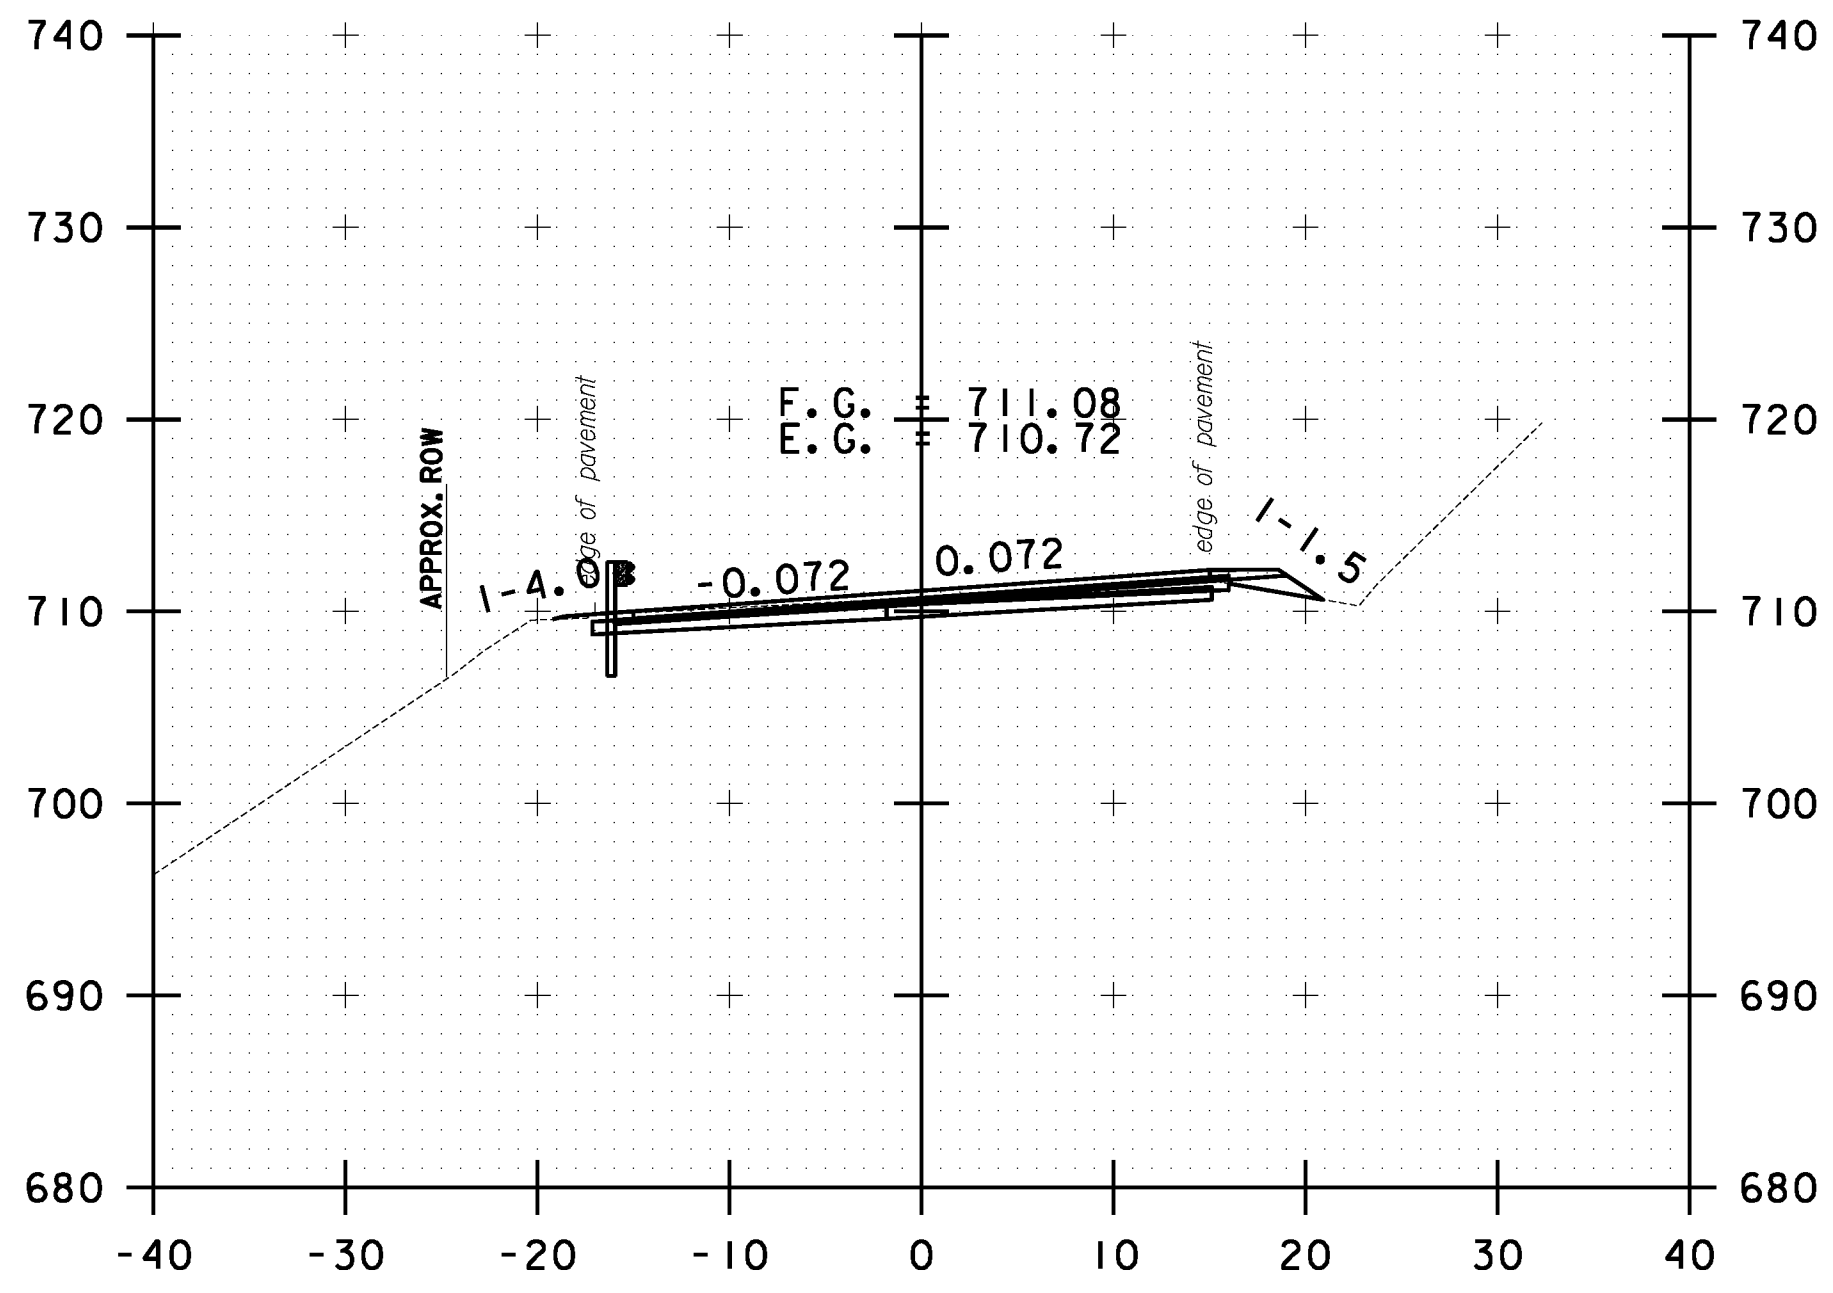


88+00.00

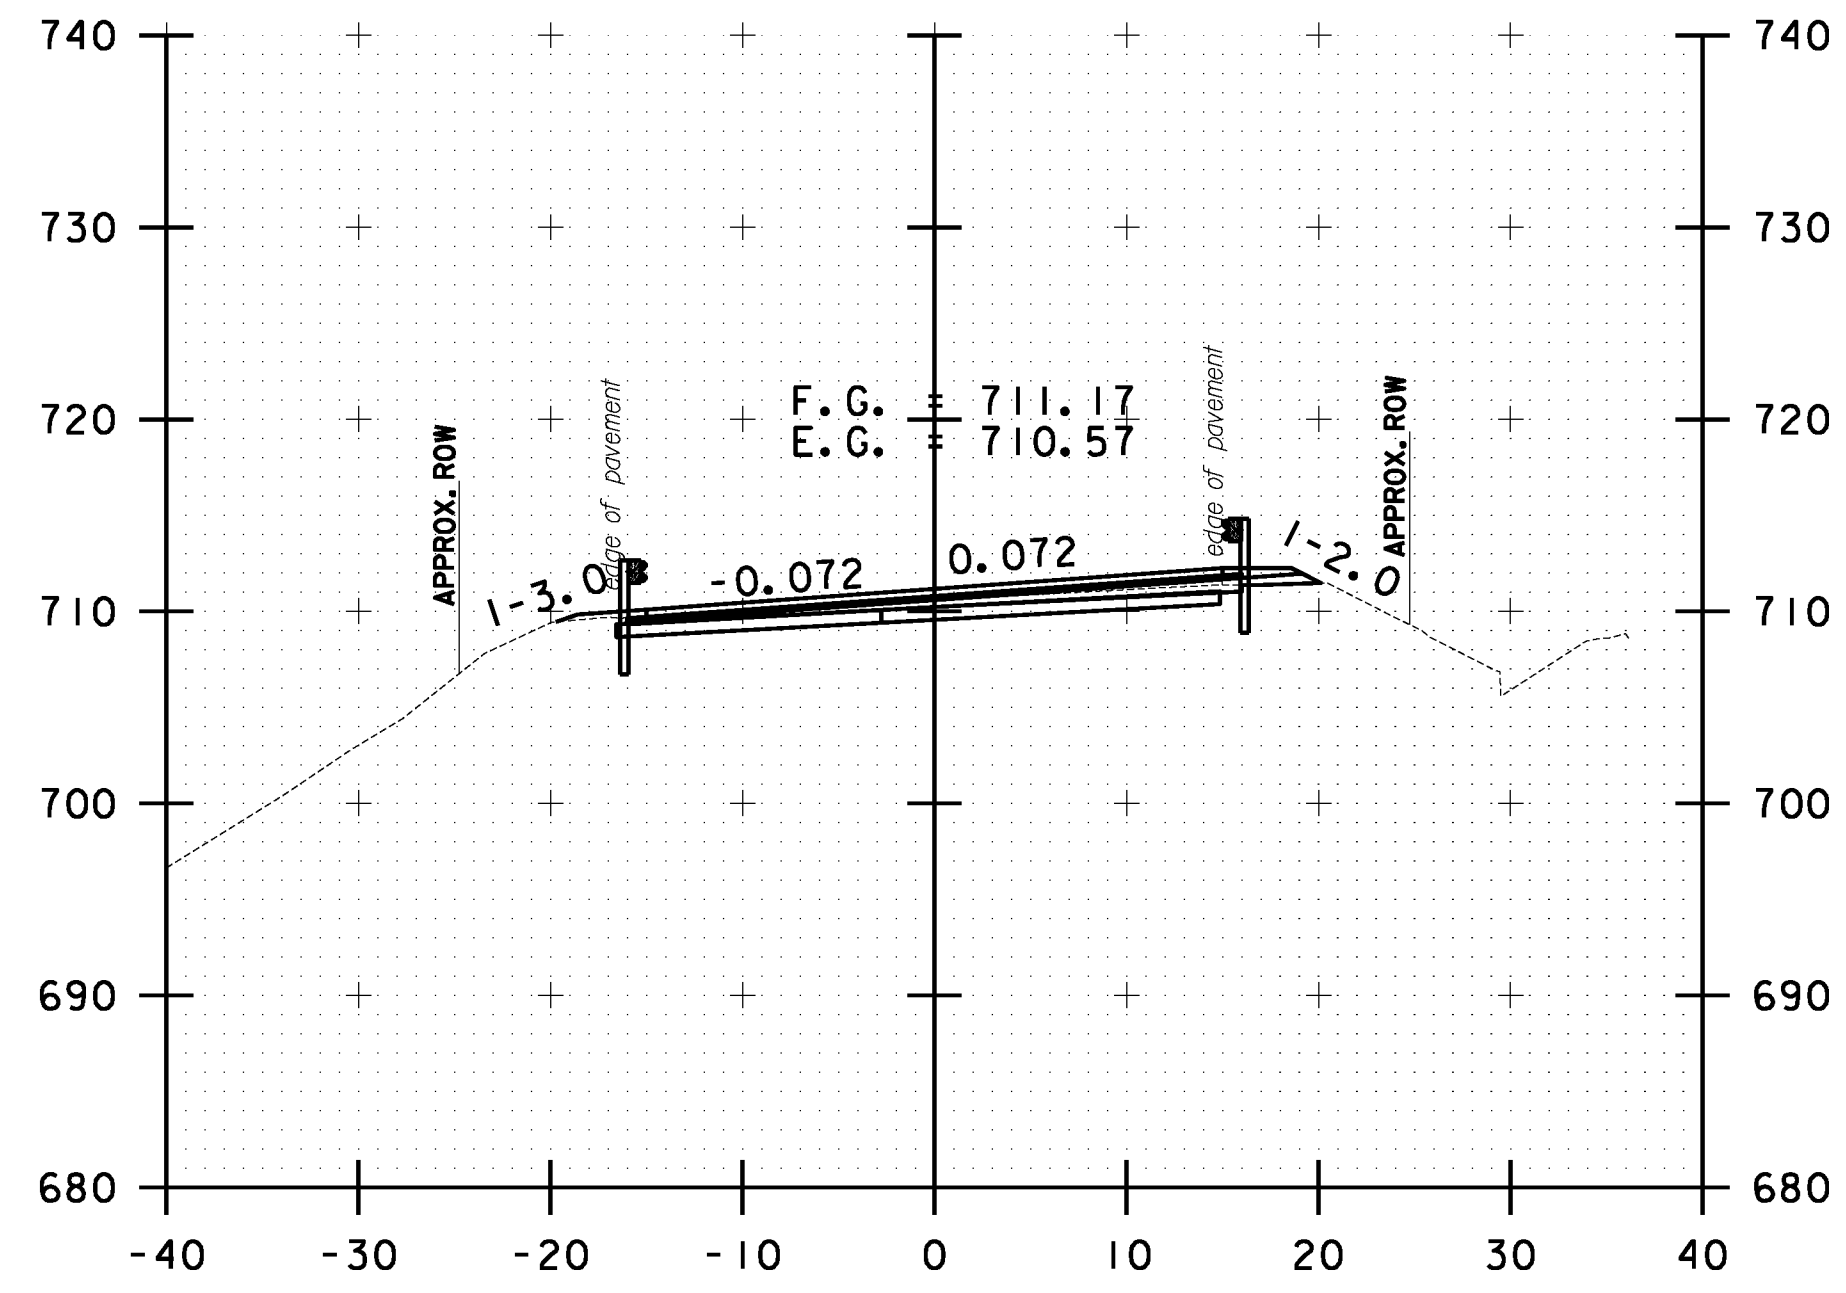


89+00.00

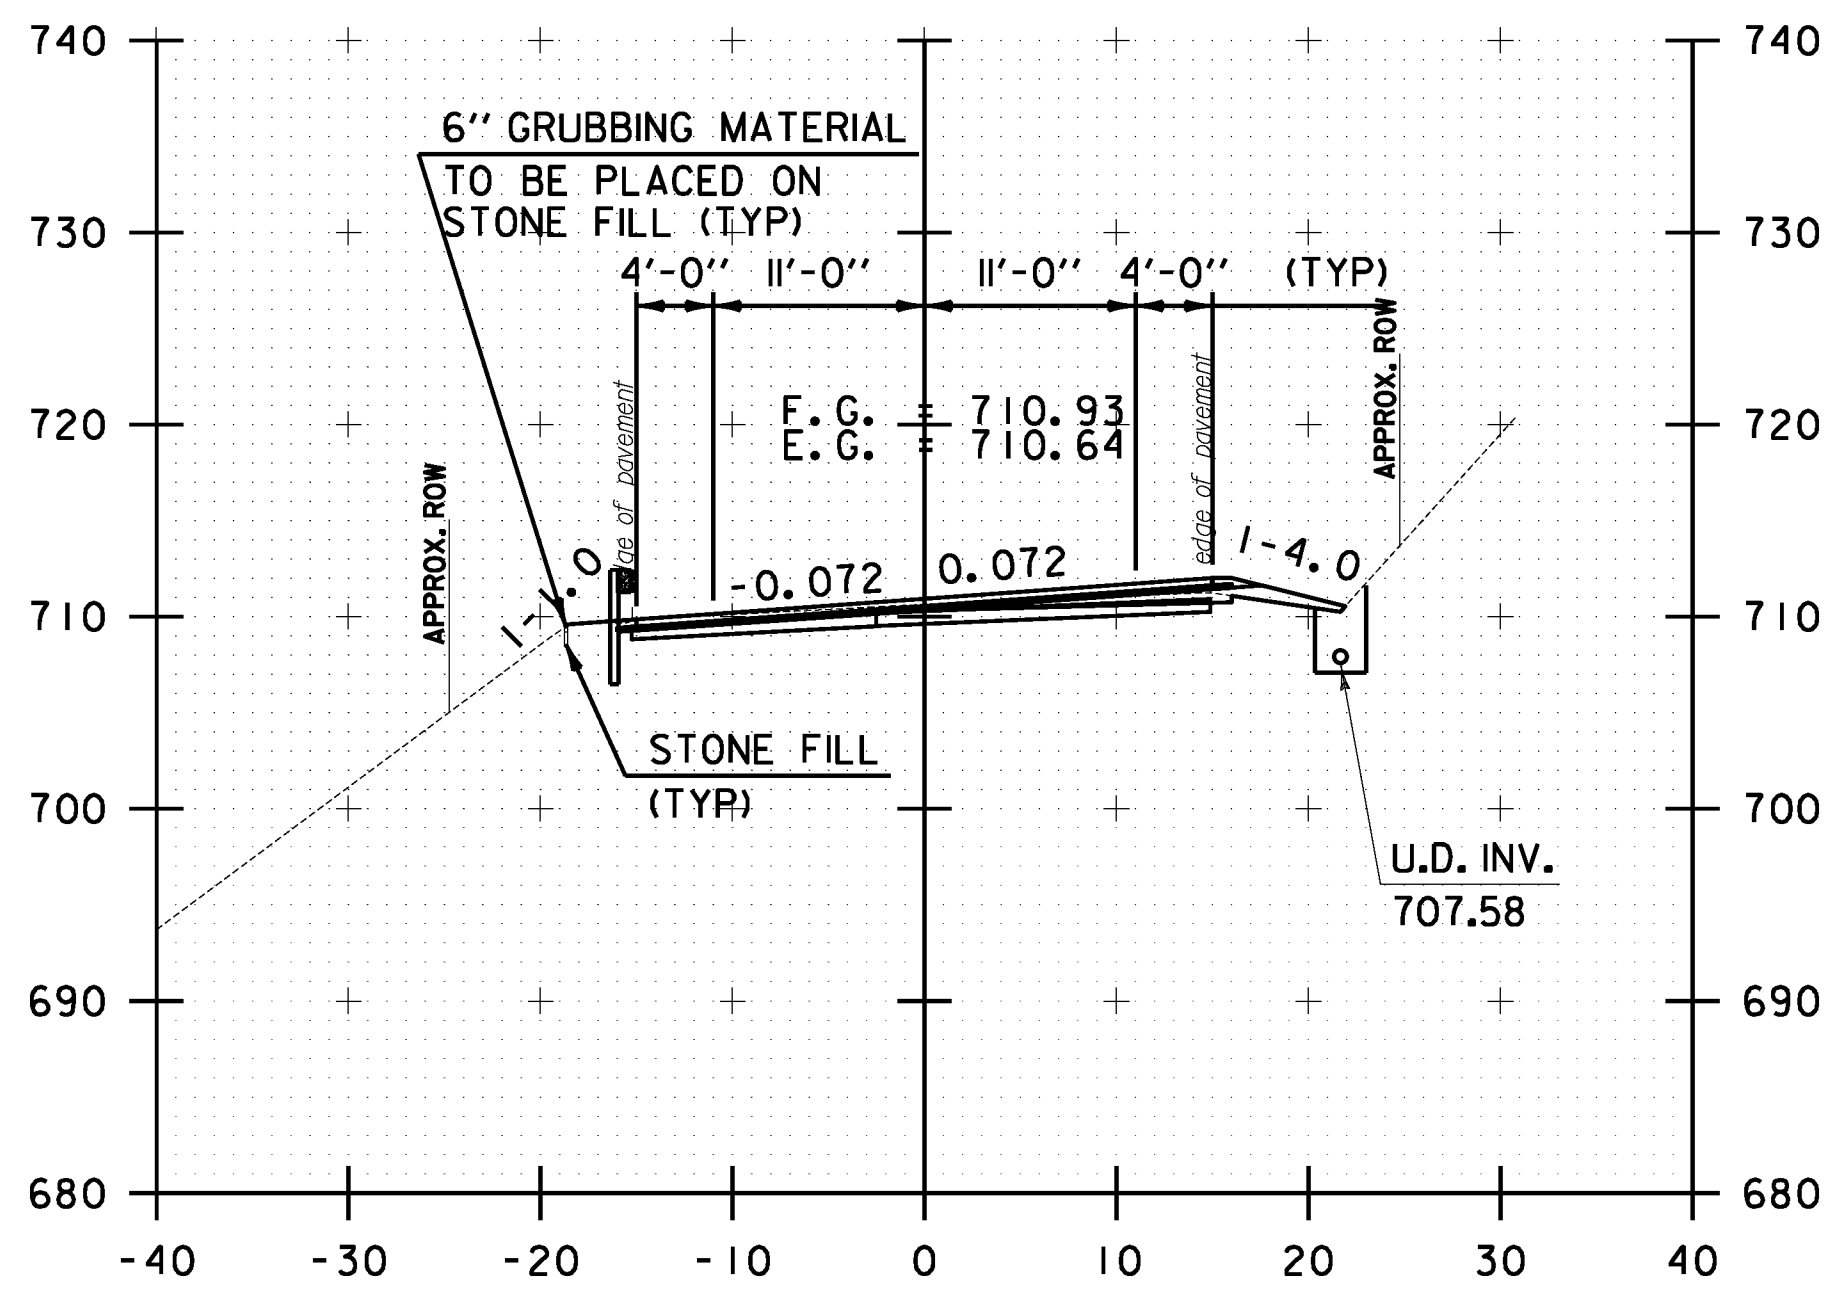

86+50.00

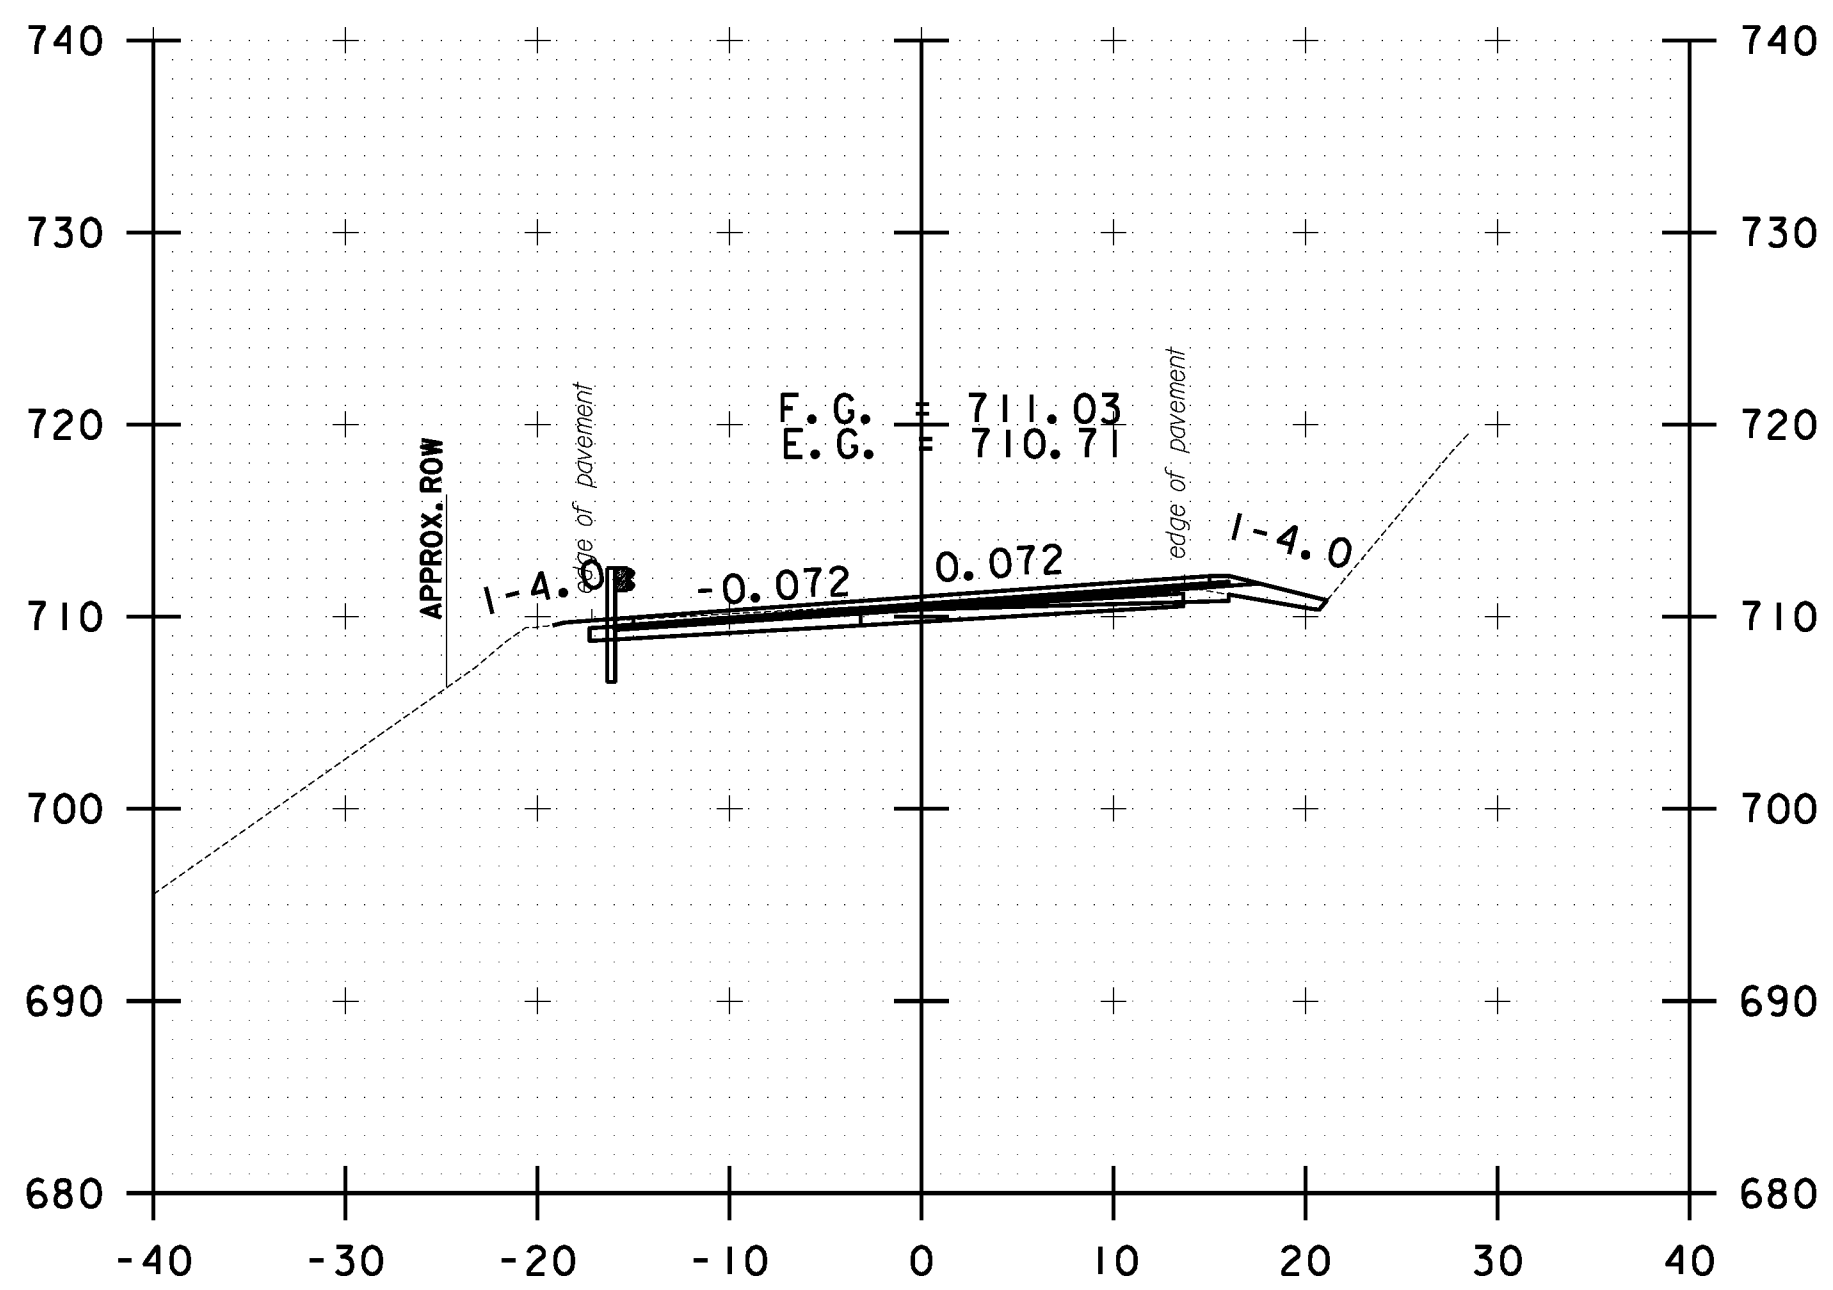

87+50.00

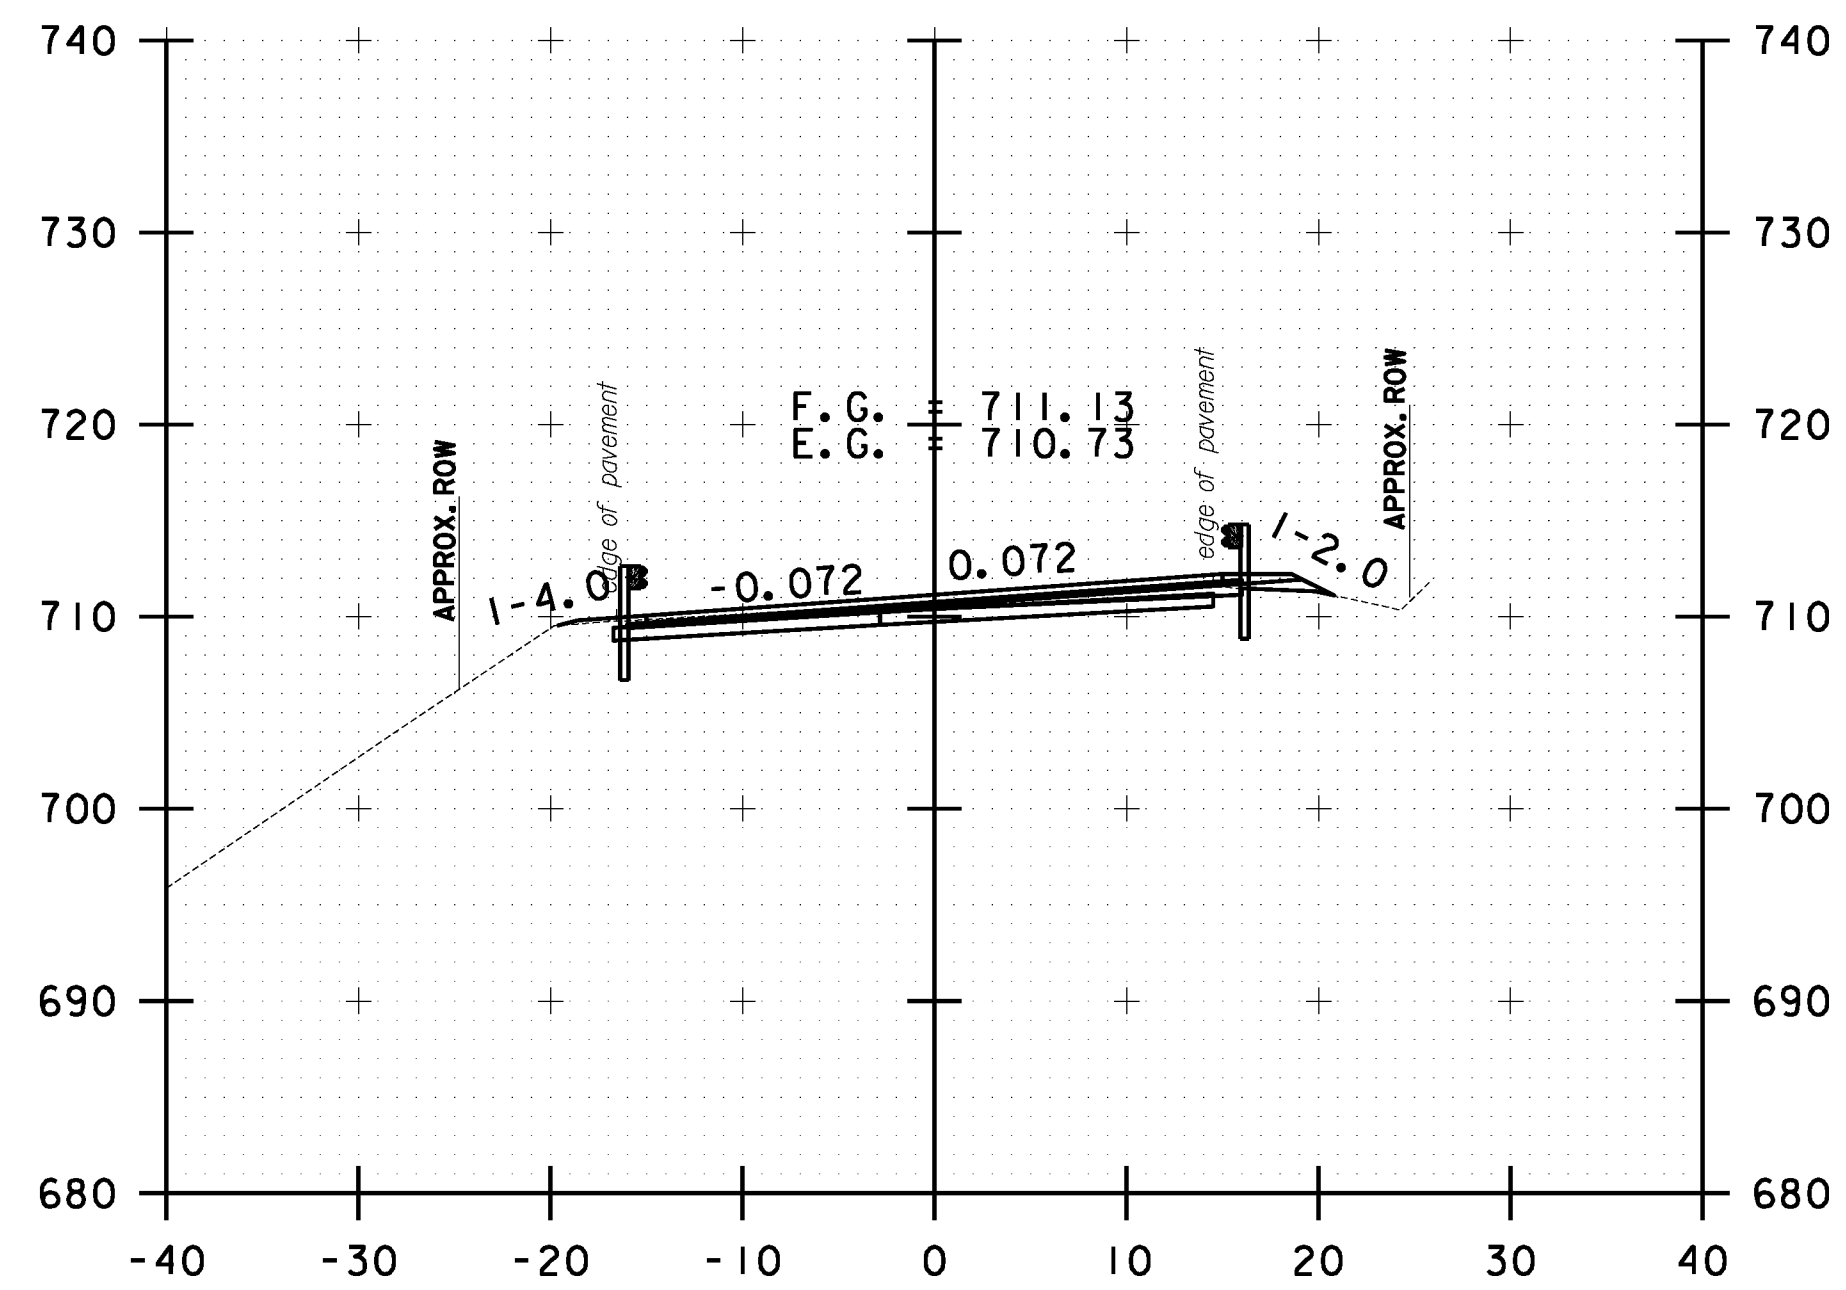

88+50.00



**STOCKBRIDGE
 CROSS SECTION
 SHEET #29**

PROJECT NAME: STOCKBRIDGE-BETHEL	
PROJECT NUMBER: STP 2910(1)	
FILE NAME: z10b214_stock.xc.dgn	PLOT DATE: 3/17/2014
PROJECT LEADER: D.E.G.	DRAWN BY: W.G.P.
DESIGNED BY: L.M.B.	CHECKED BY: J.P.S.
IPARM FILE: z10b214xs29.1	SHEET 242 OF 397