




FILE NAME = V:\P\c\cases\ANY\K2\22425\CA001\MSTN\10b214_stock.nc.dgn
 DATE/TIME = 3/17/2014
 USER = 4916

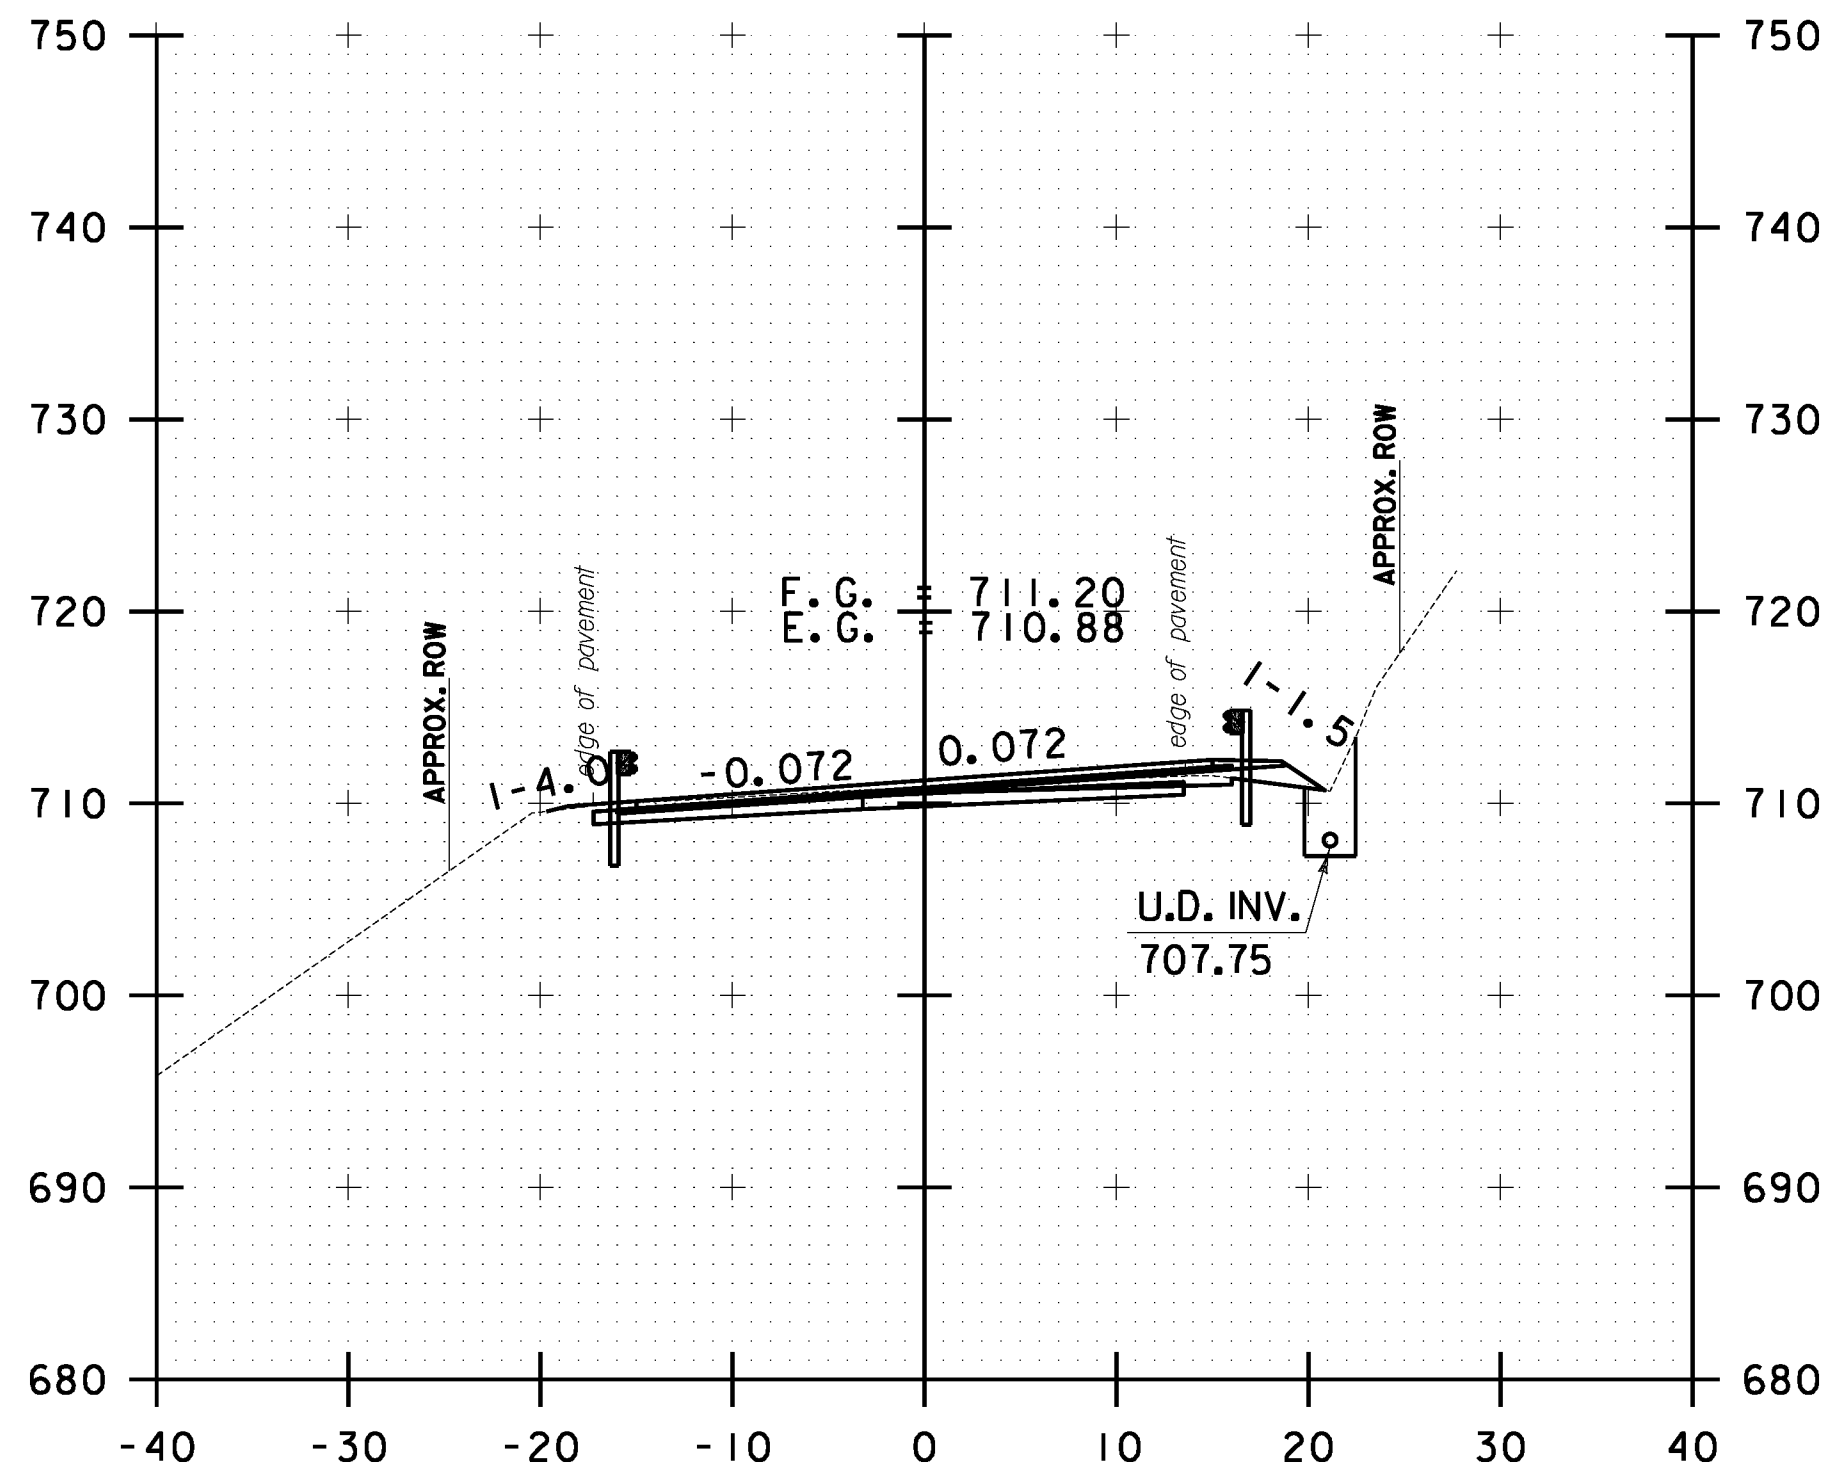


90+00.00

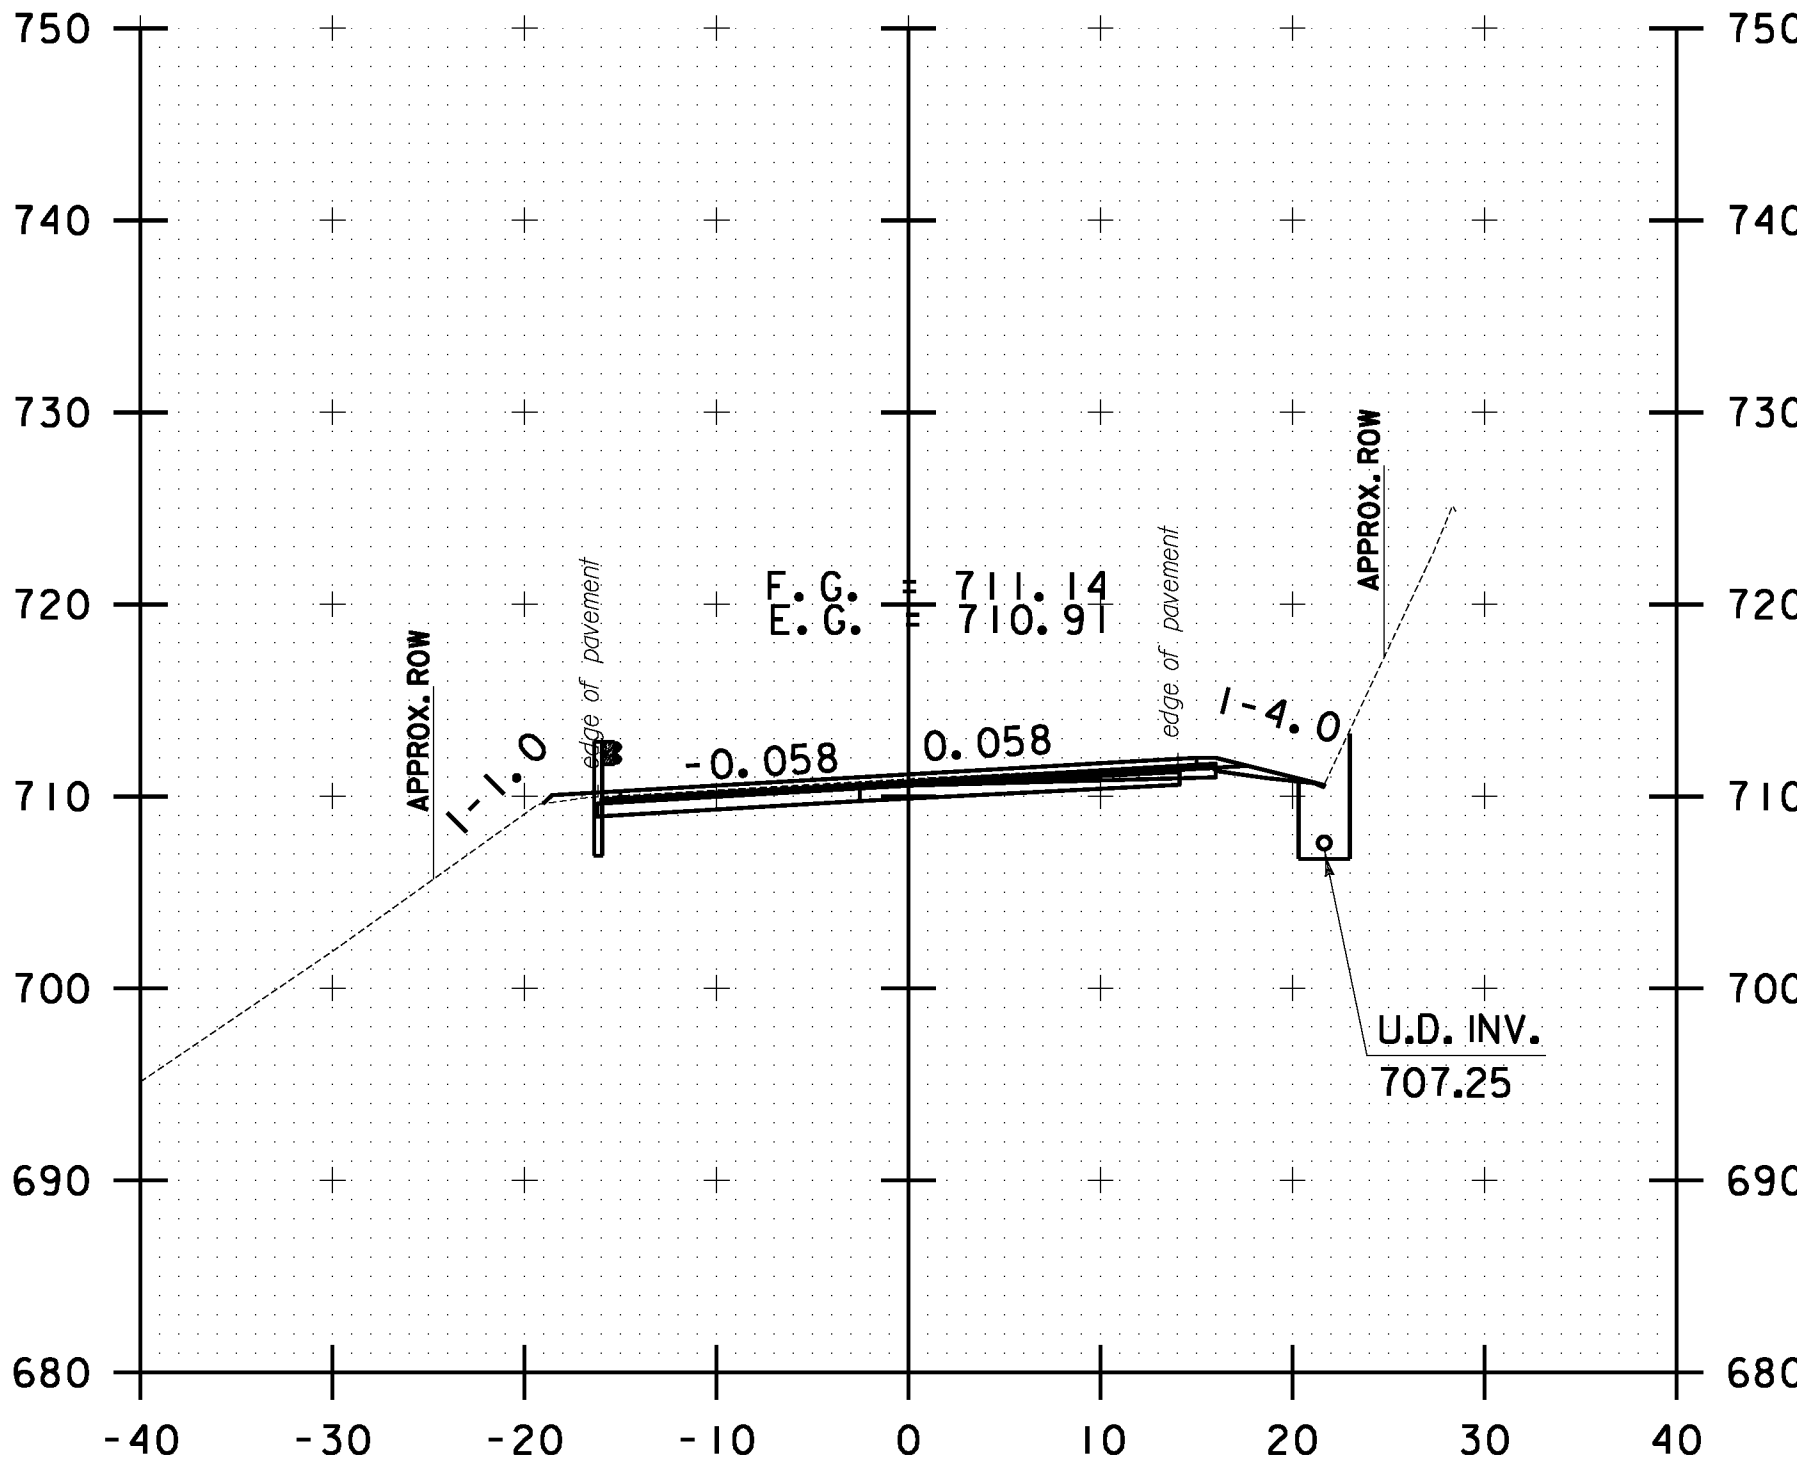


91+00.00

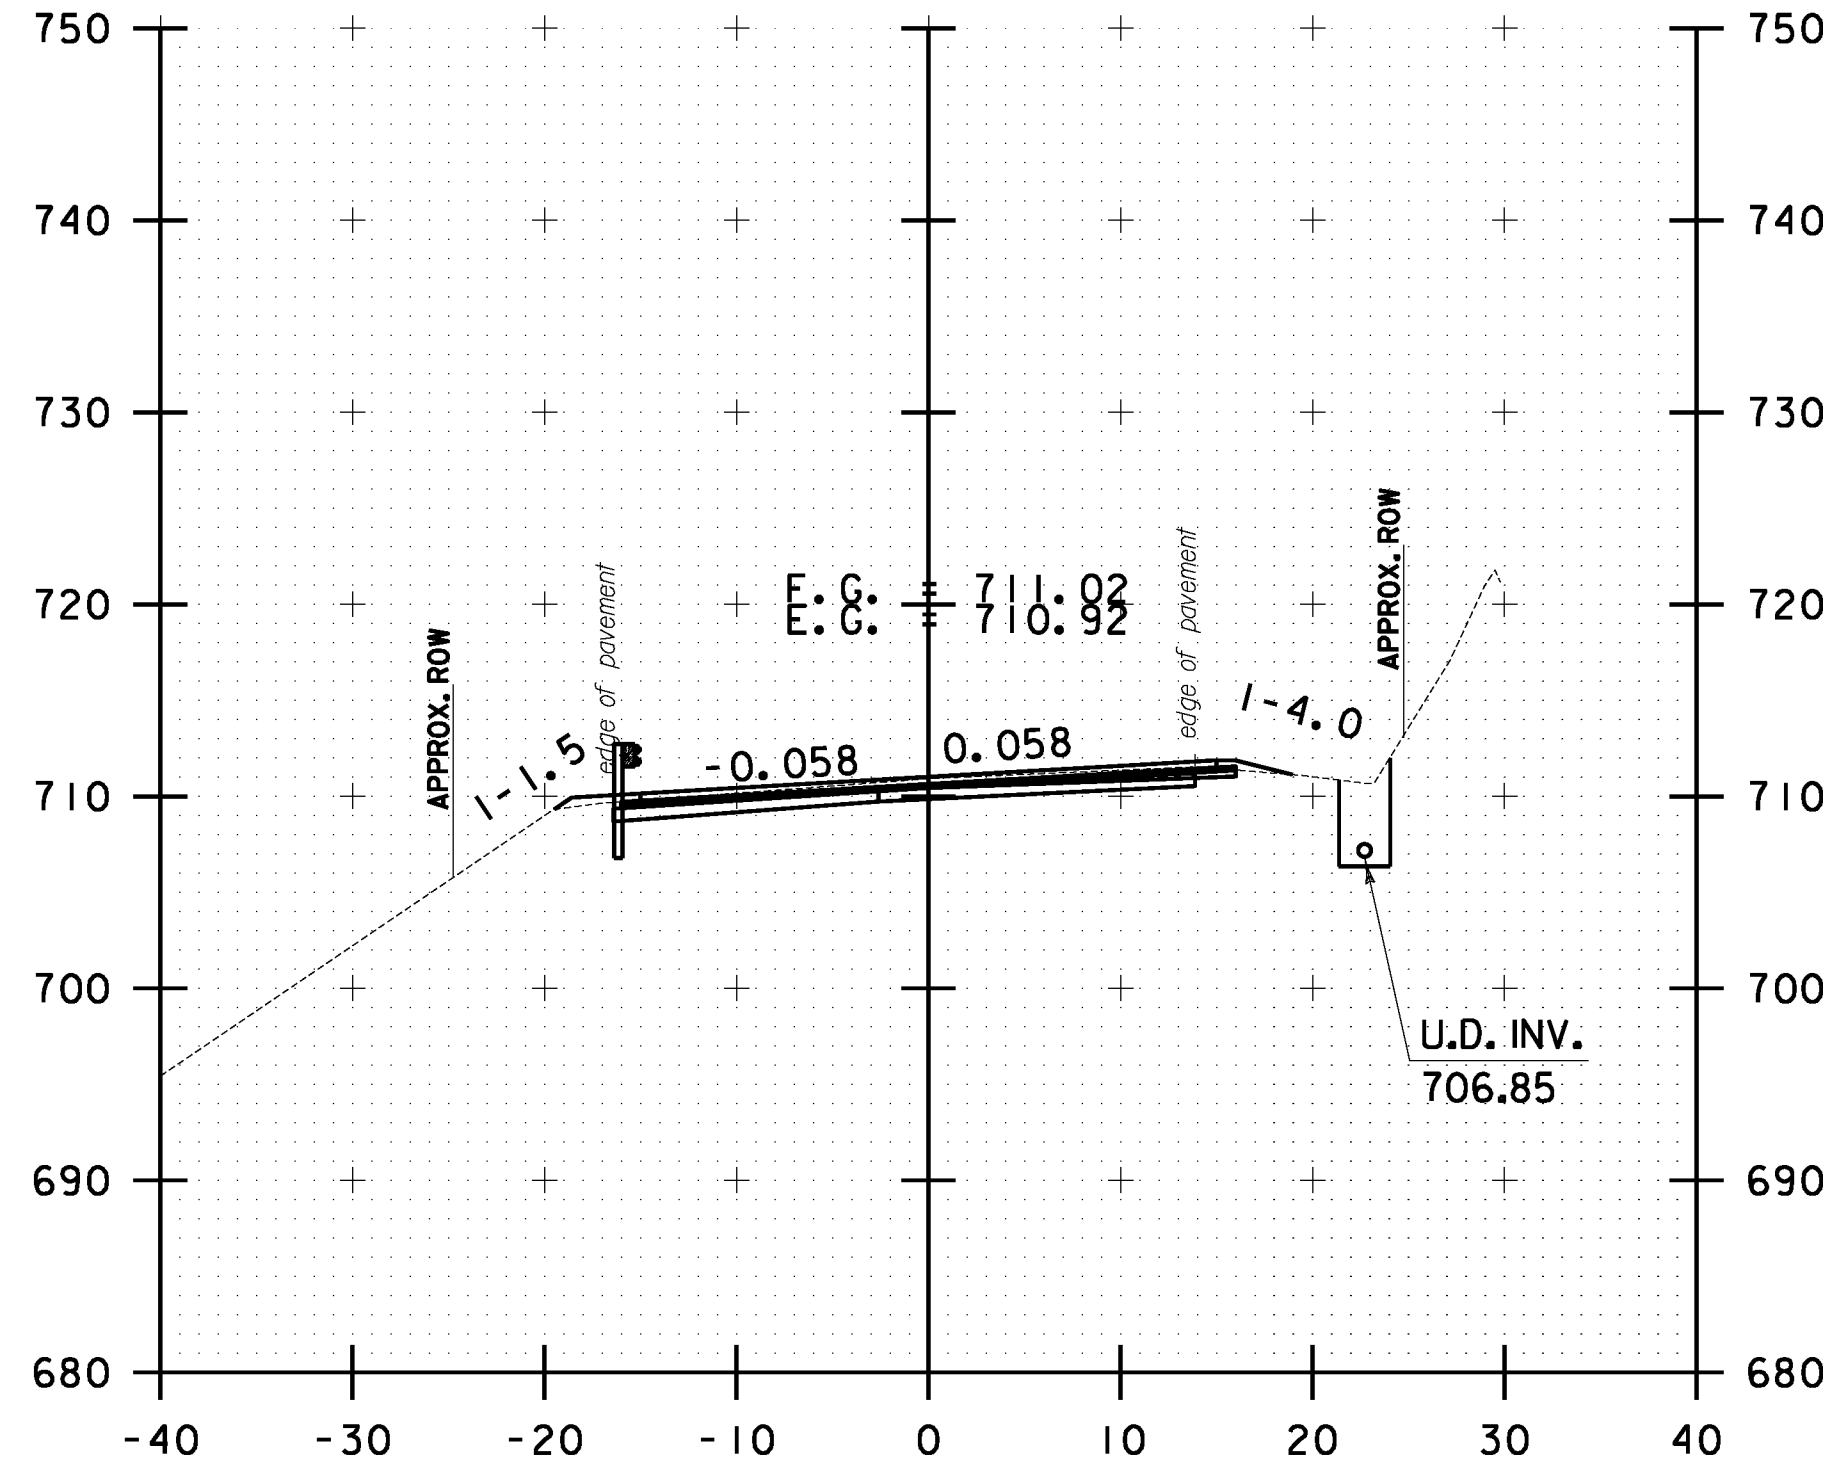


92+00.00

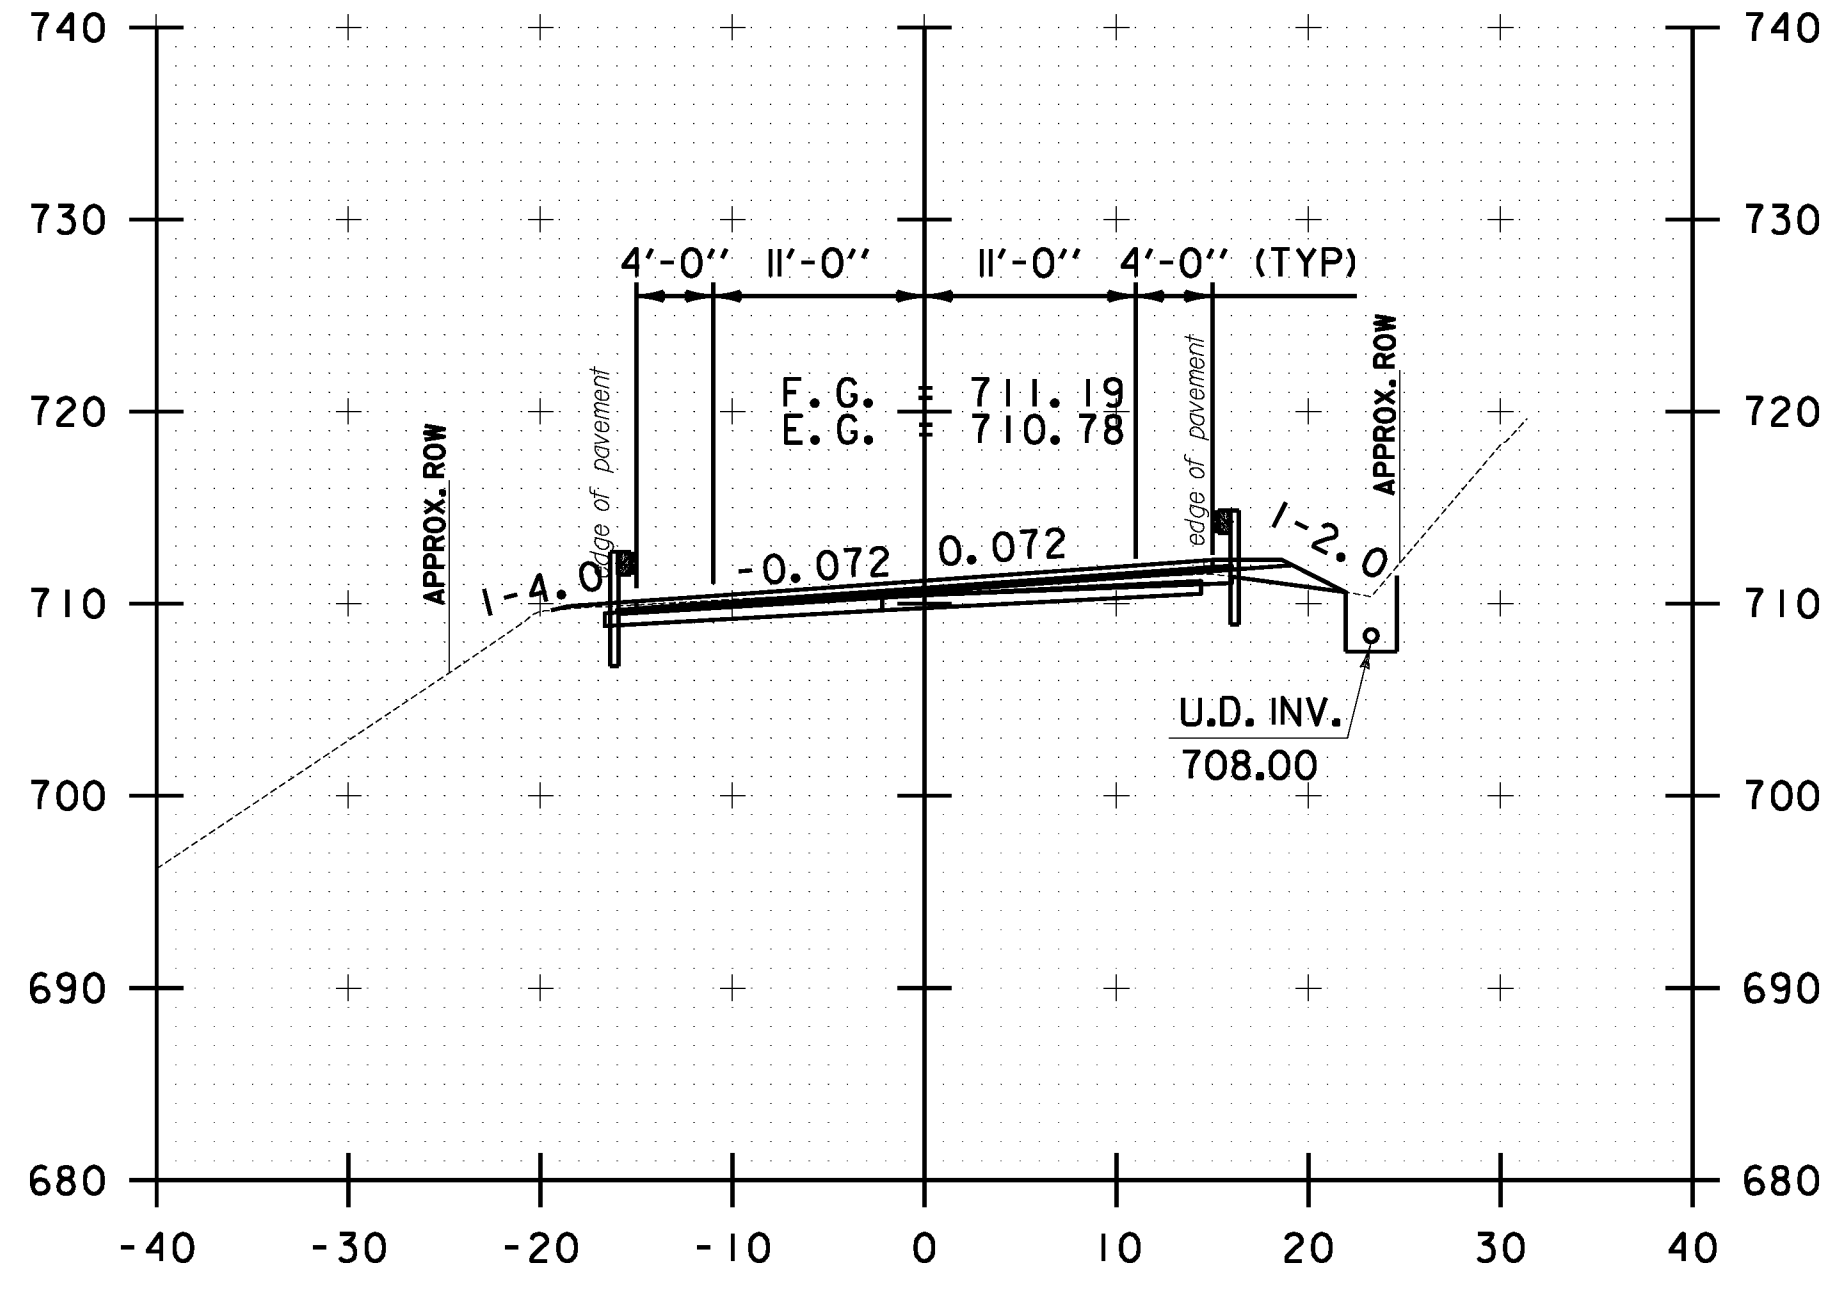


89+50.00

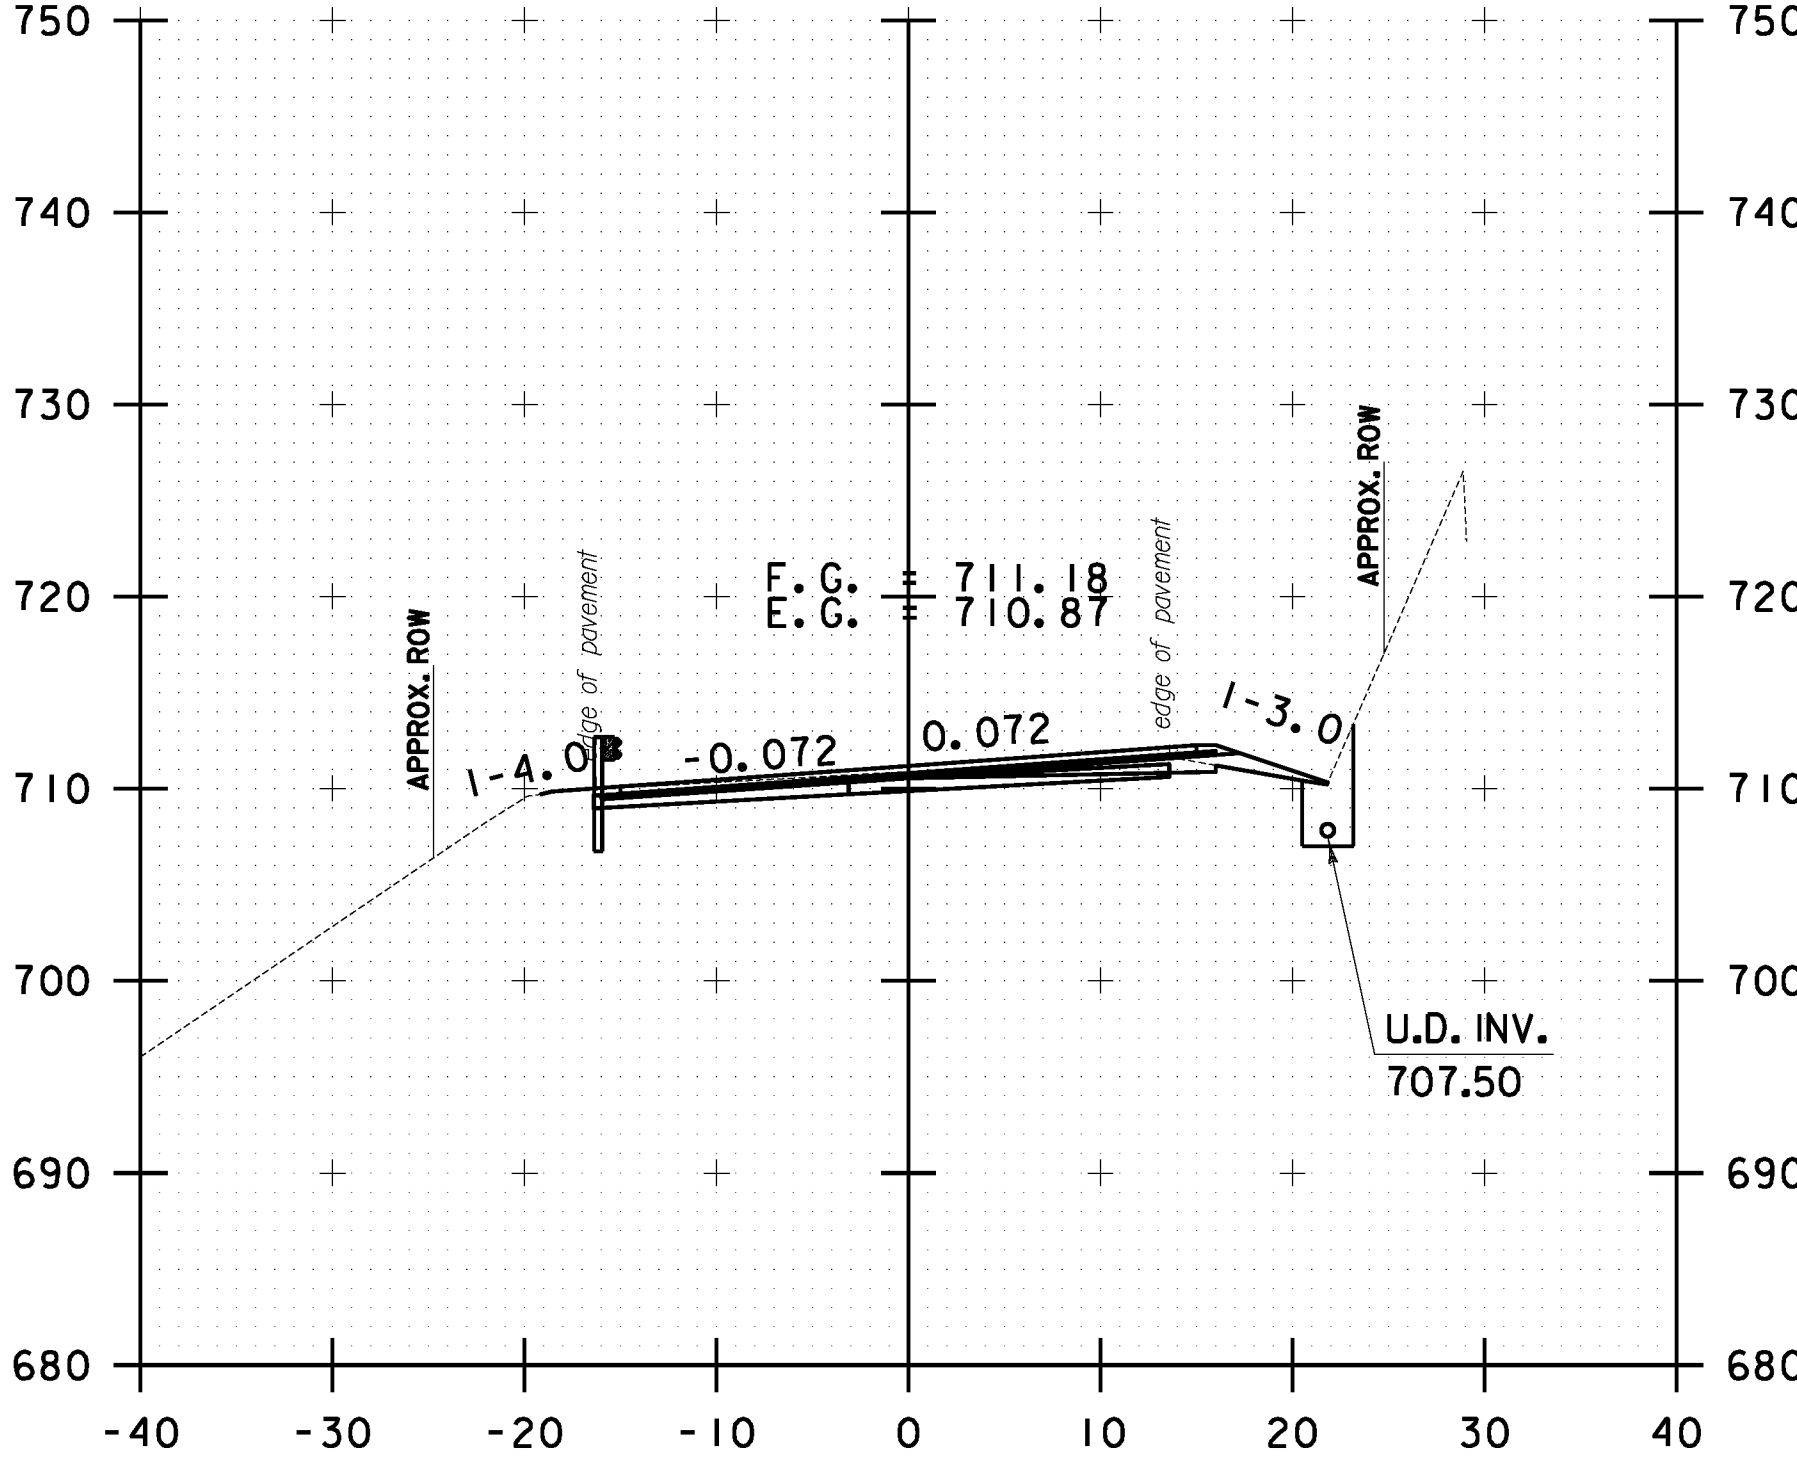

90+50.00

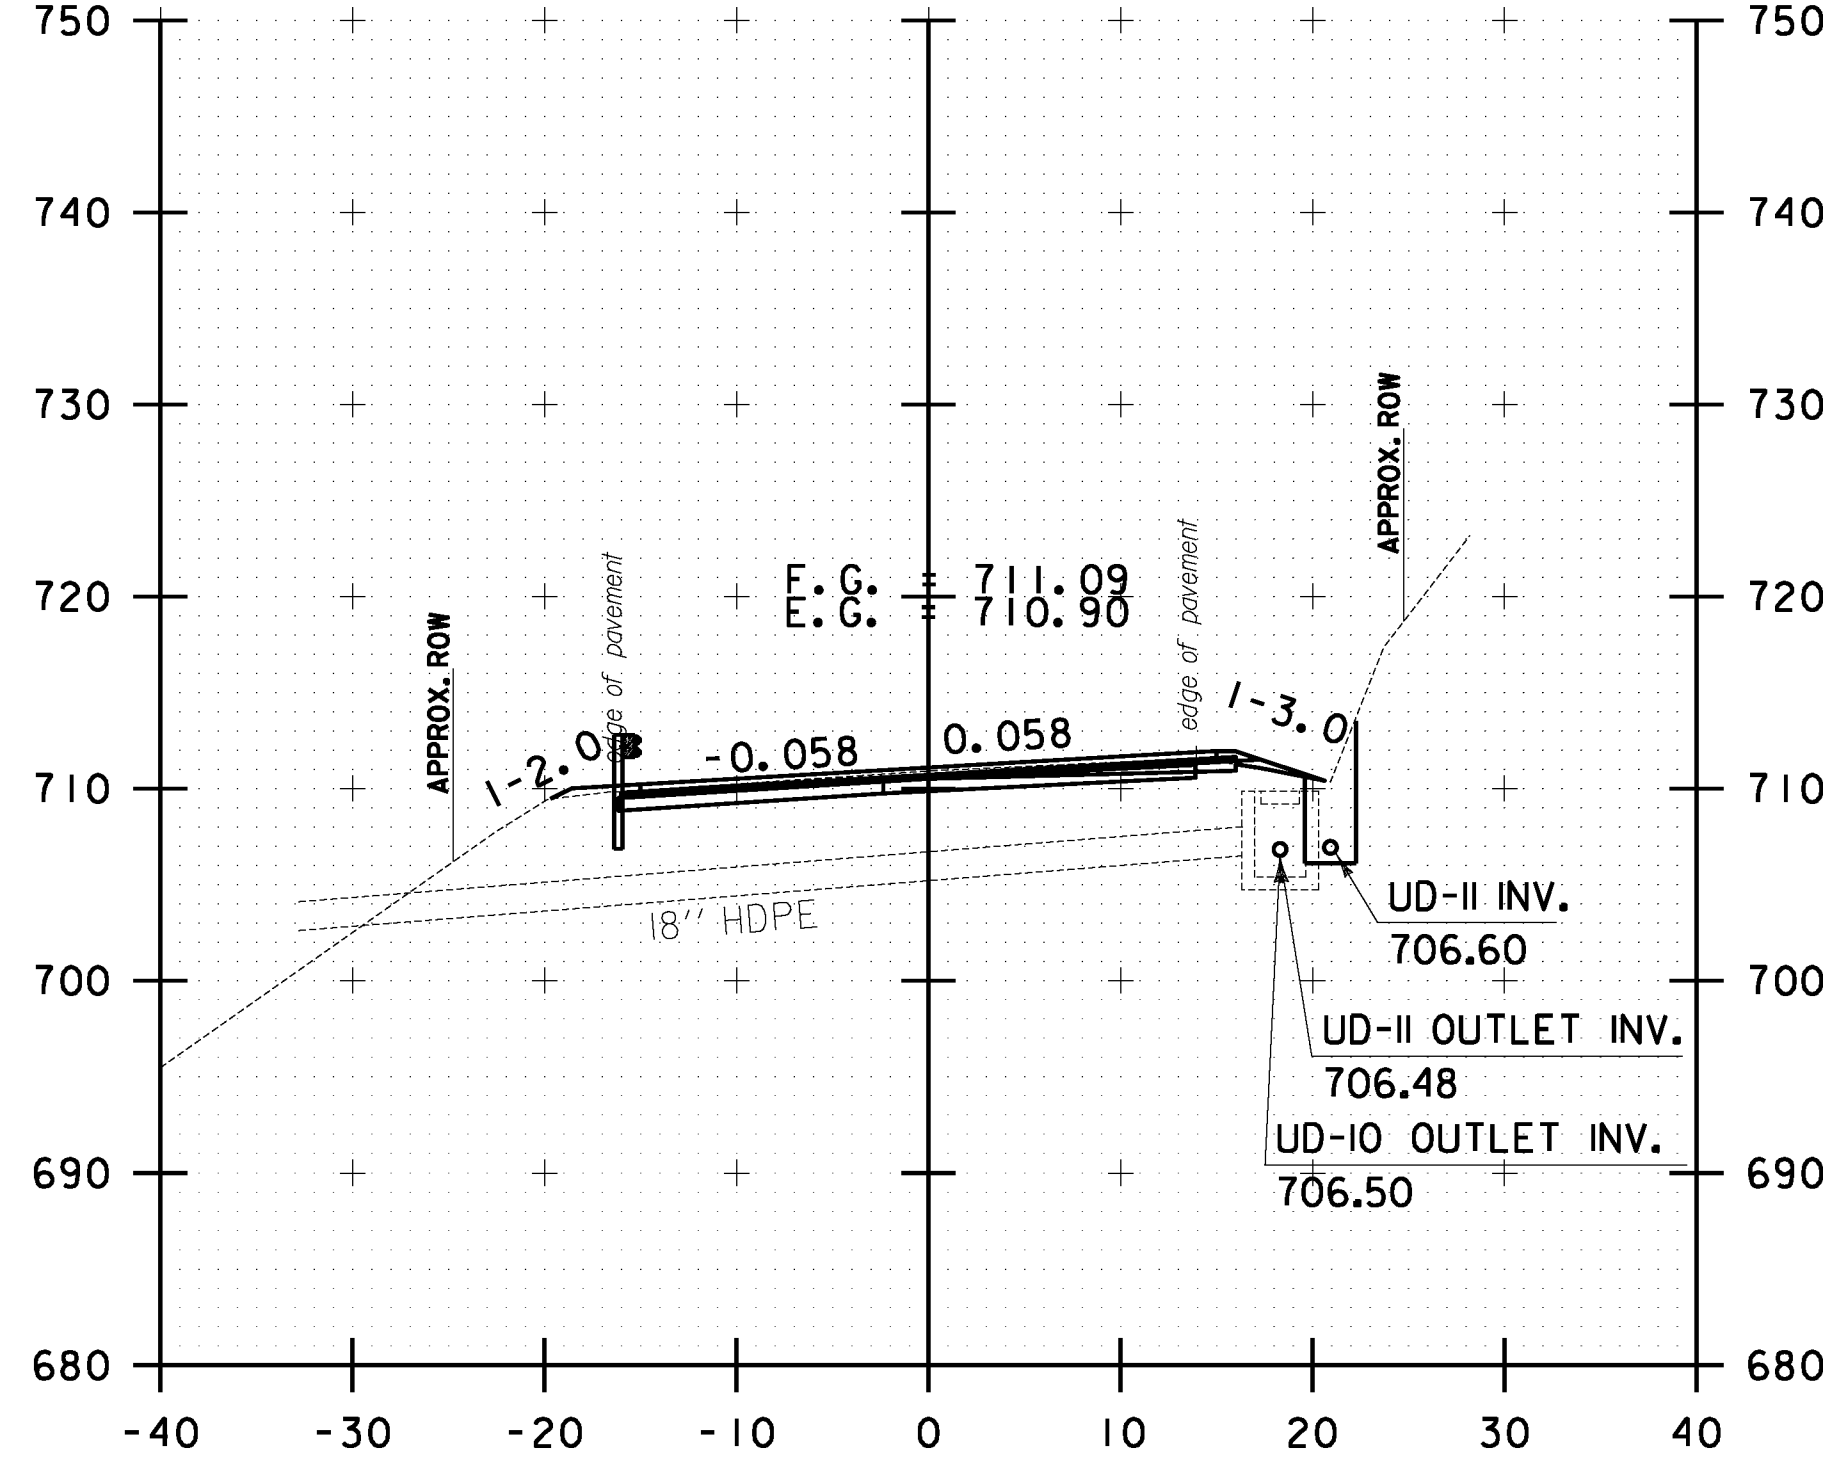

91+50.00

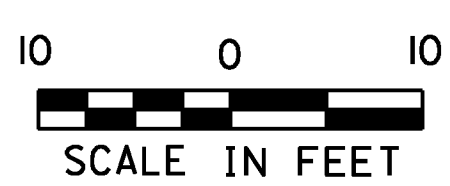

STOCKBRIDGE CROSS SECTION SHEET #30	PROJECT NAME: STOCKBRIDGE-BETHEL
	PROJECT NUMBER: STP 2910(1)
	FILE NAME: z10b214_stock.xc.dgn
	IPARM FILE: z10b214xs30.1
	PLOT DATE: 3/17/2014
	DRAWN BY: W.G.P.
	CHECKED BY: J.P.S.
	SHEET 243 OF 397