




93+00.00

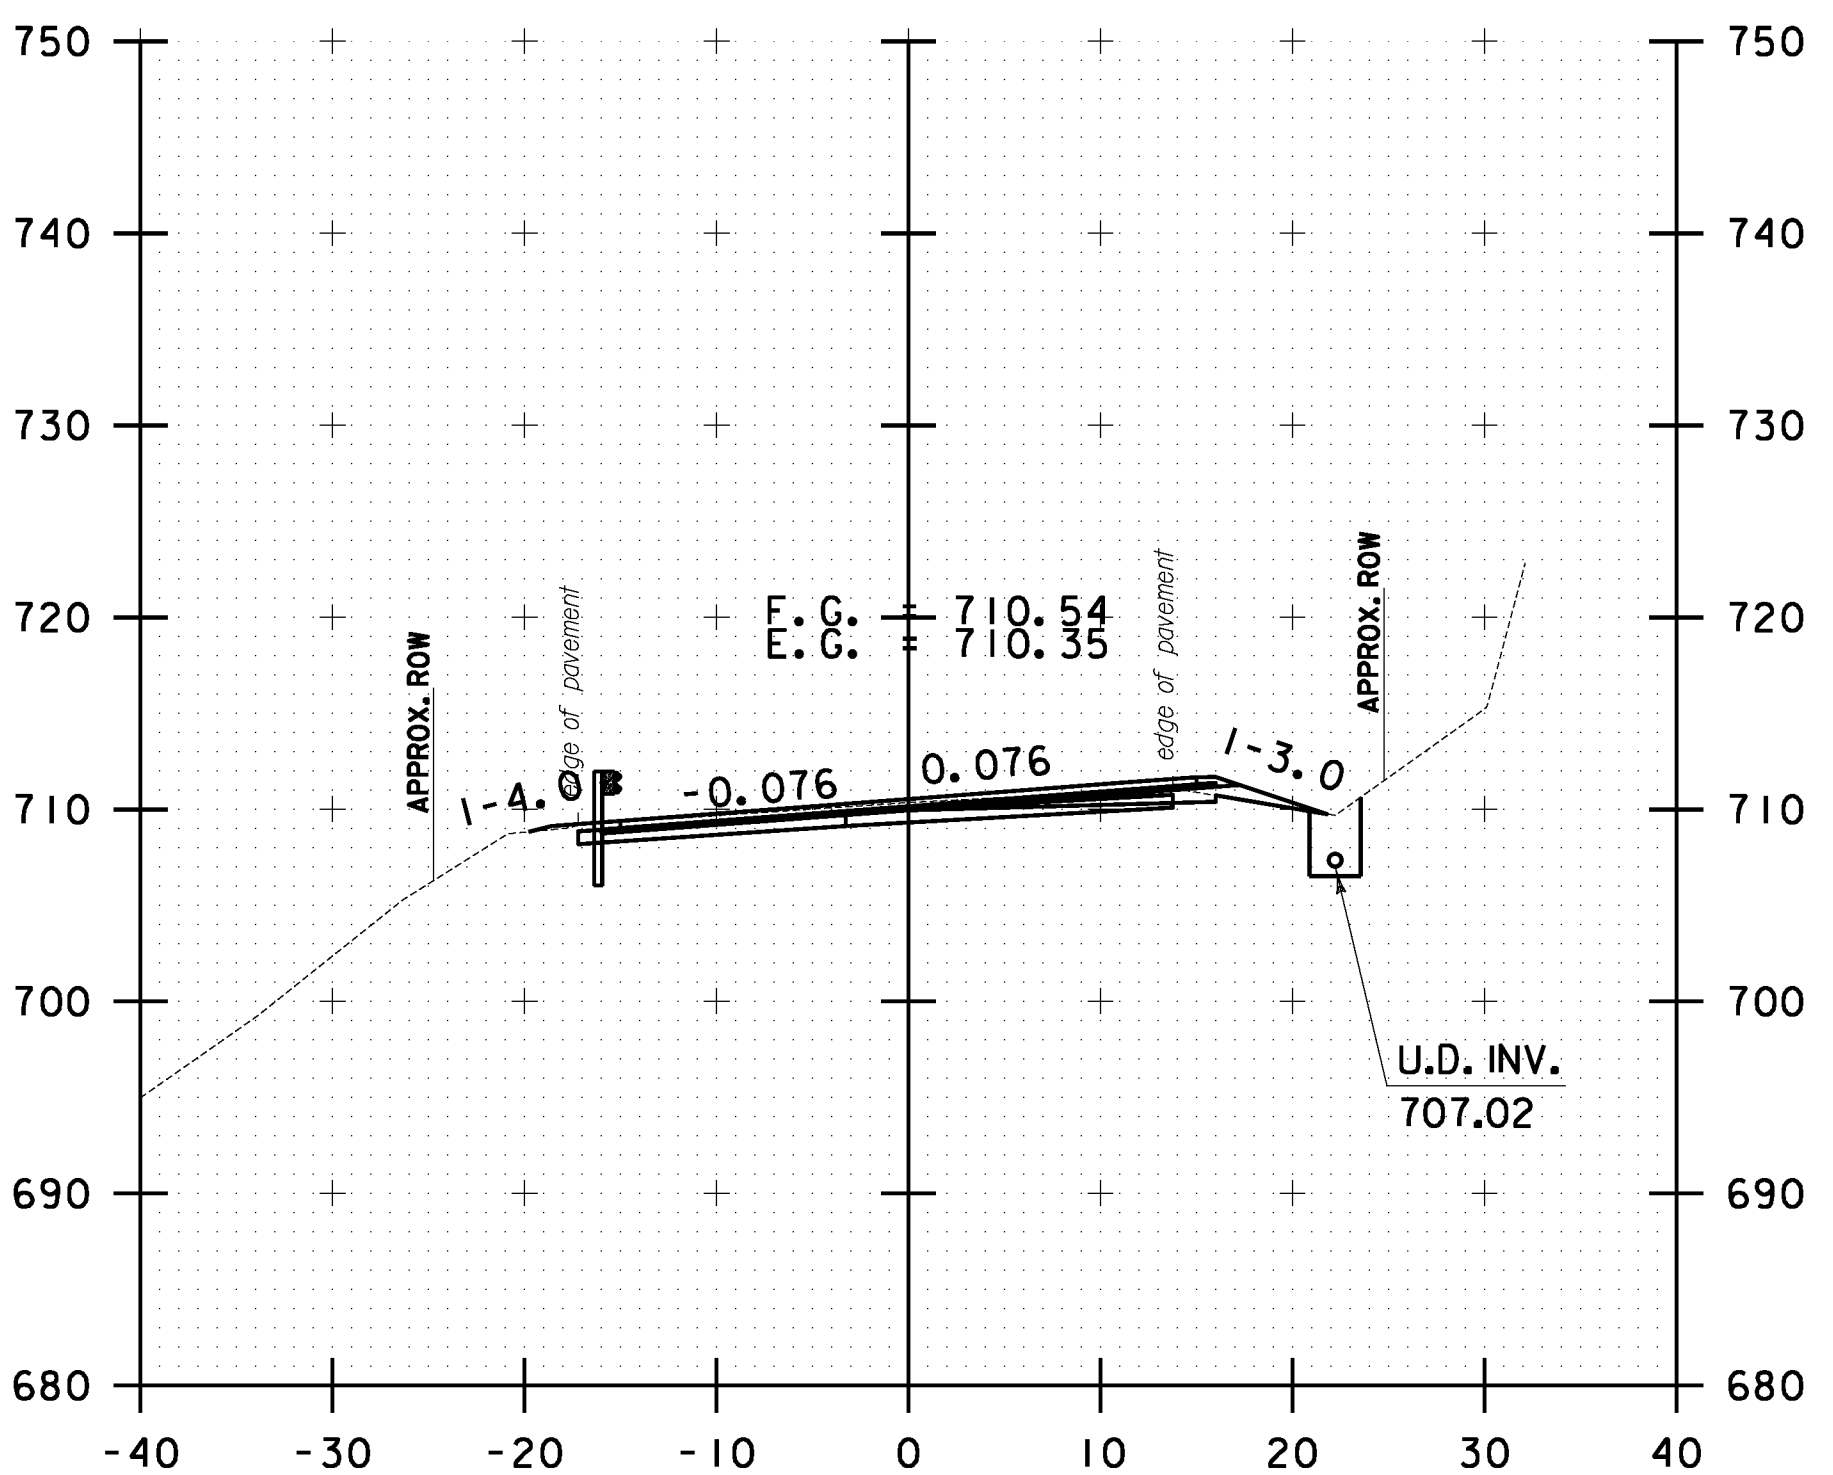


94+00.00

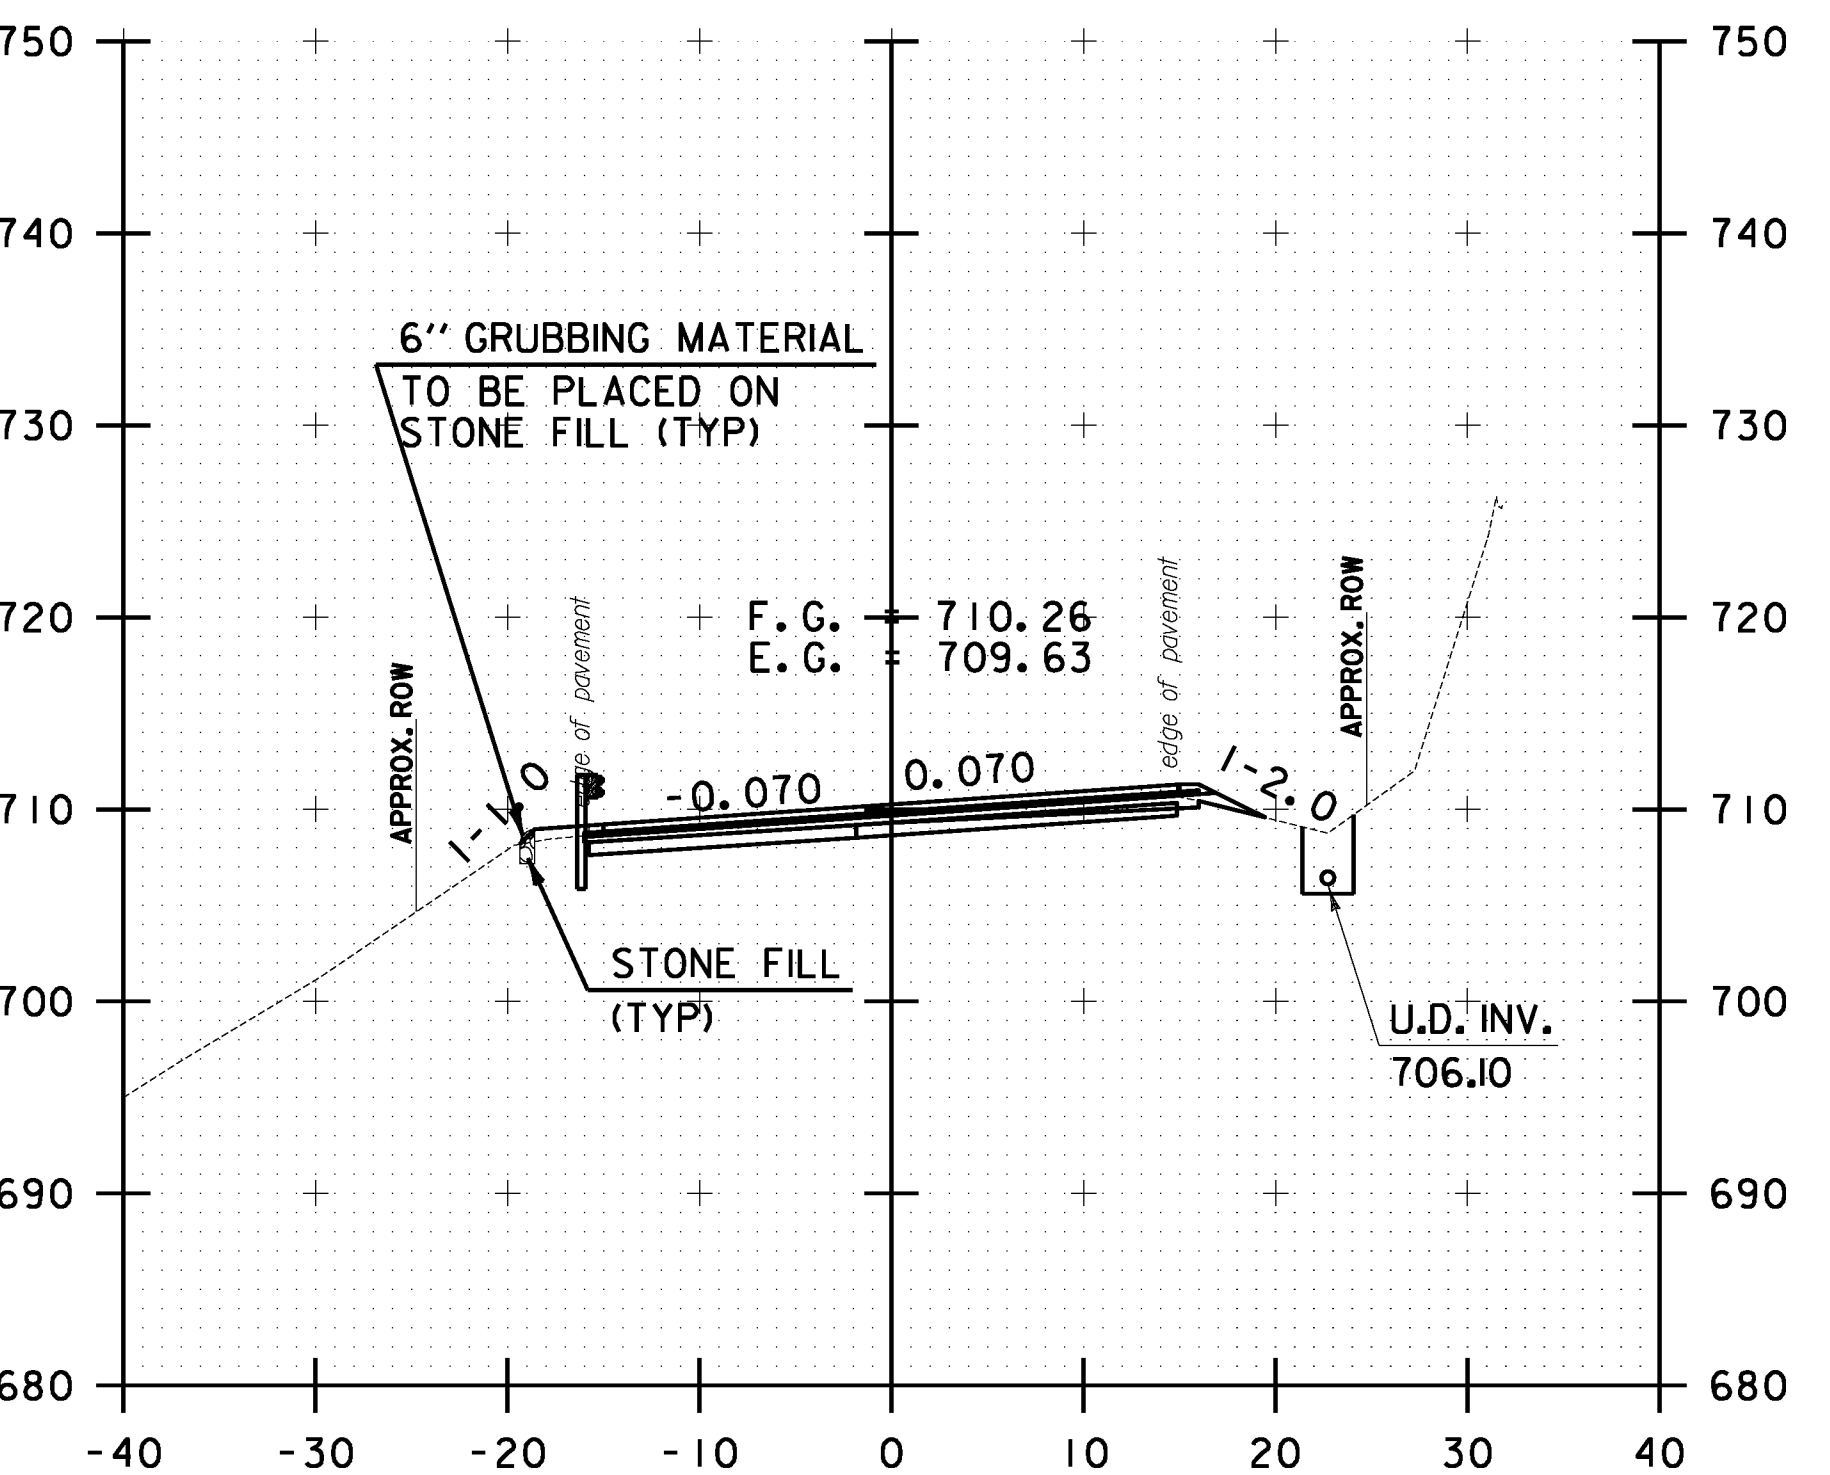


95+00.00

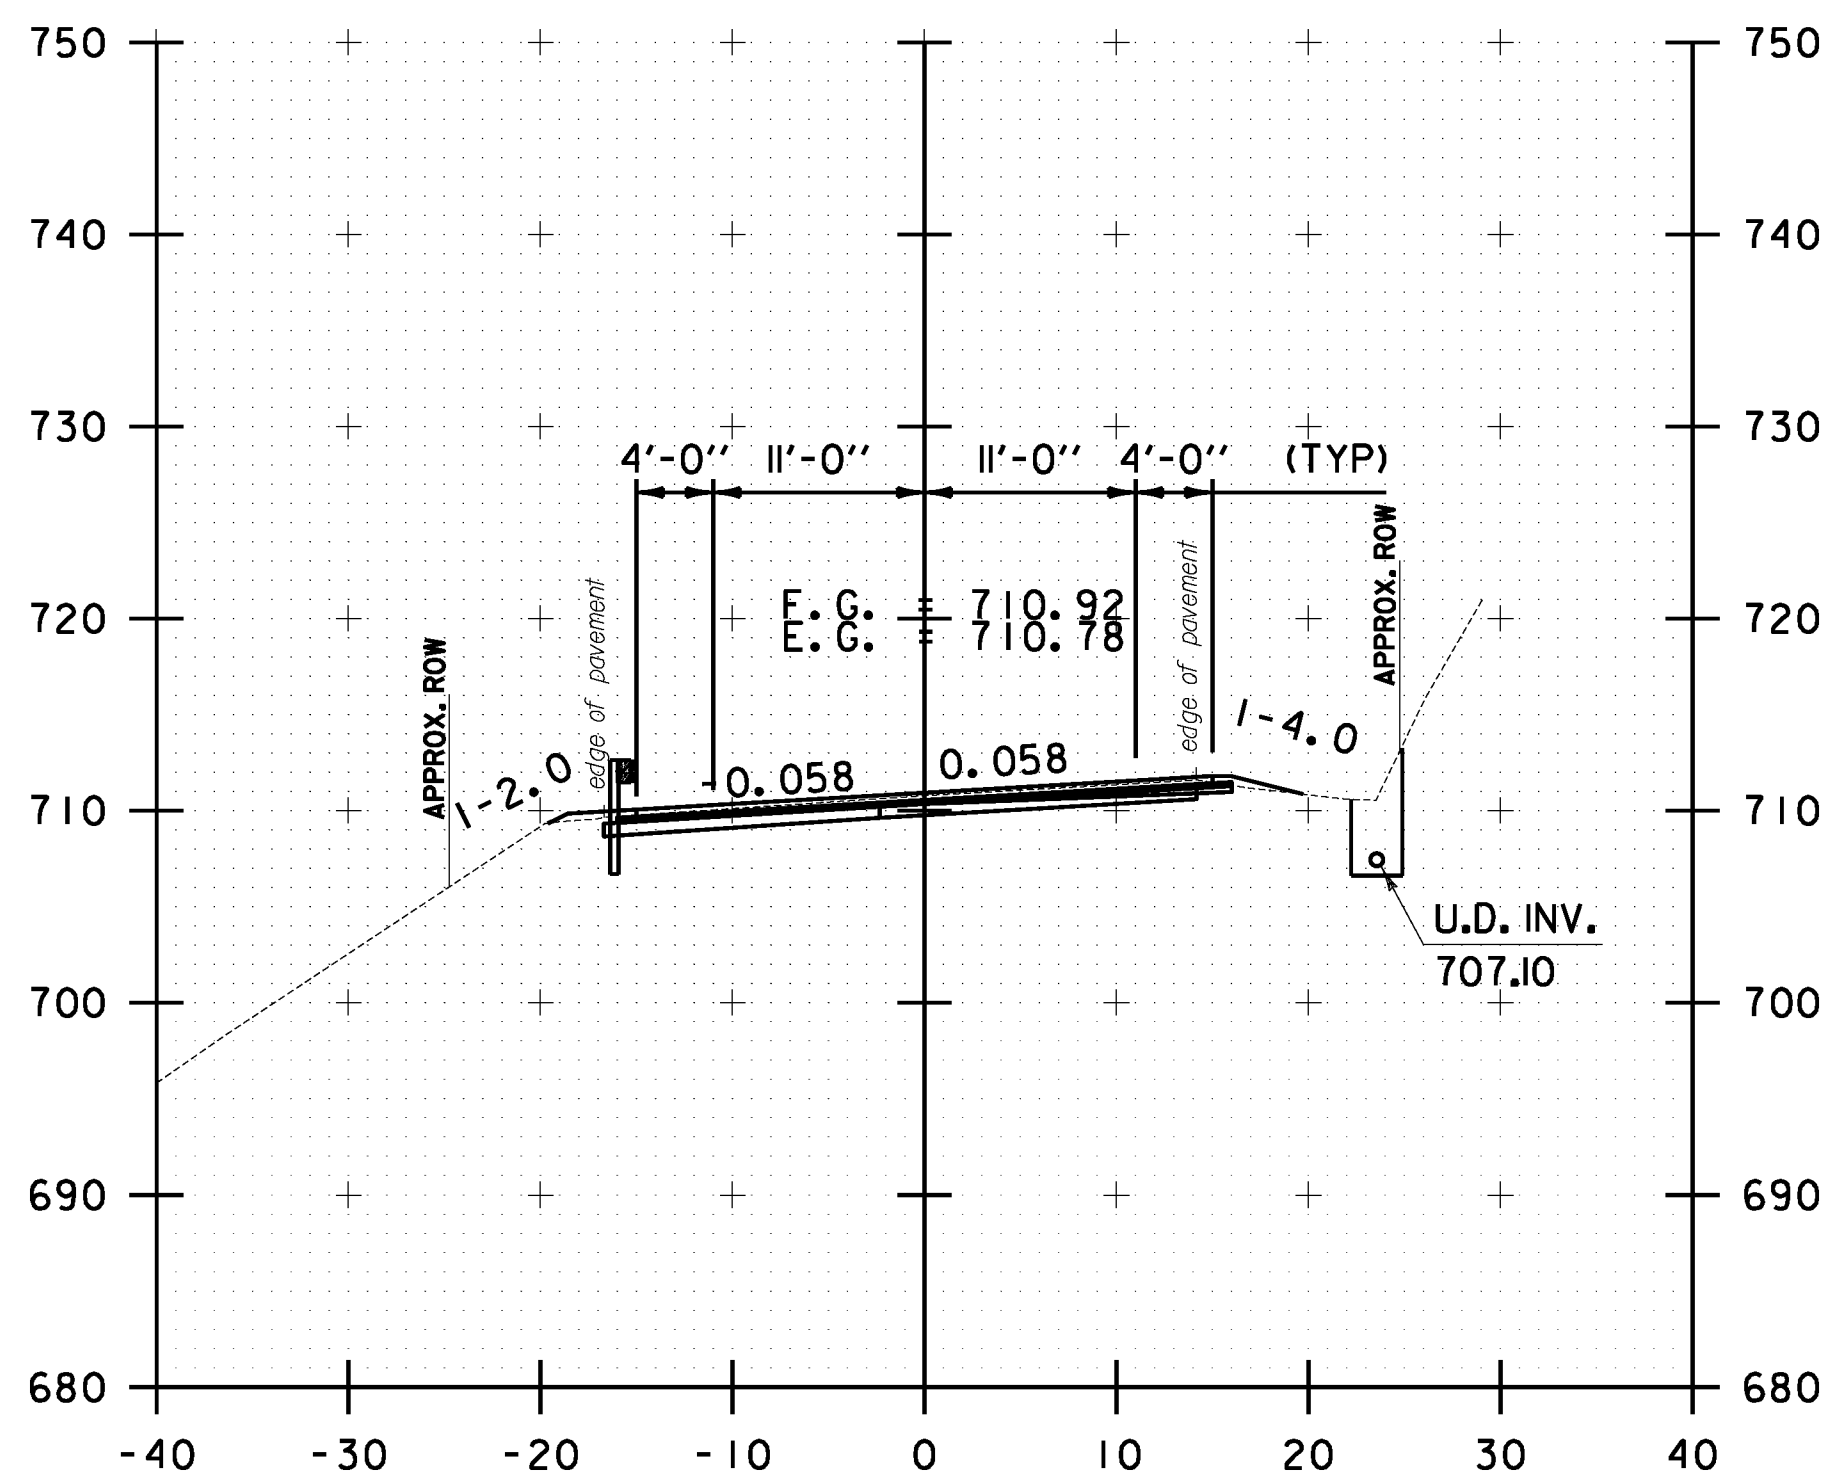

92+50.00

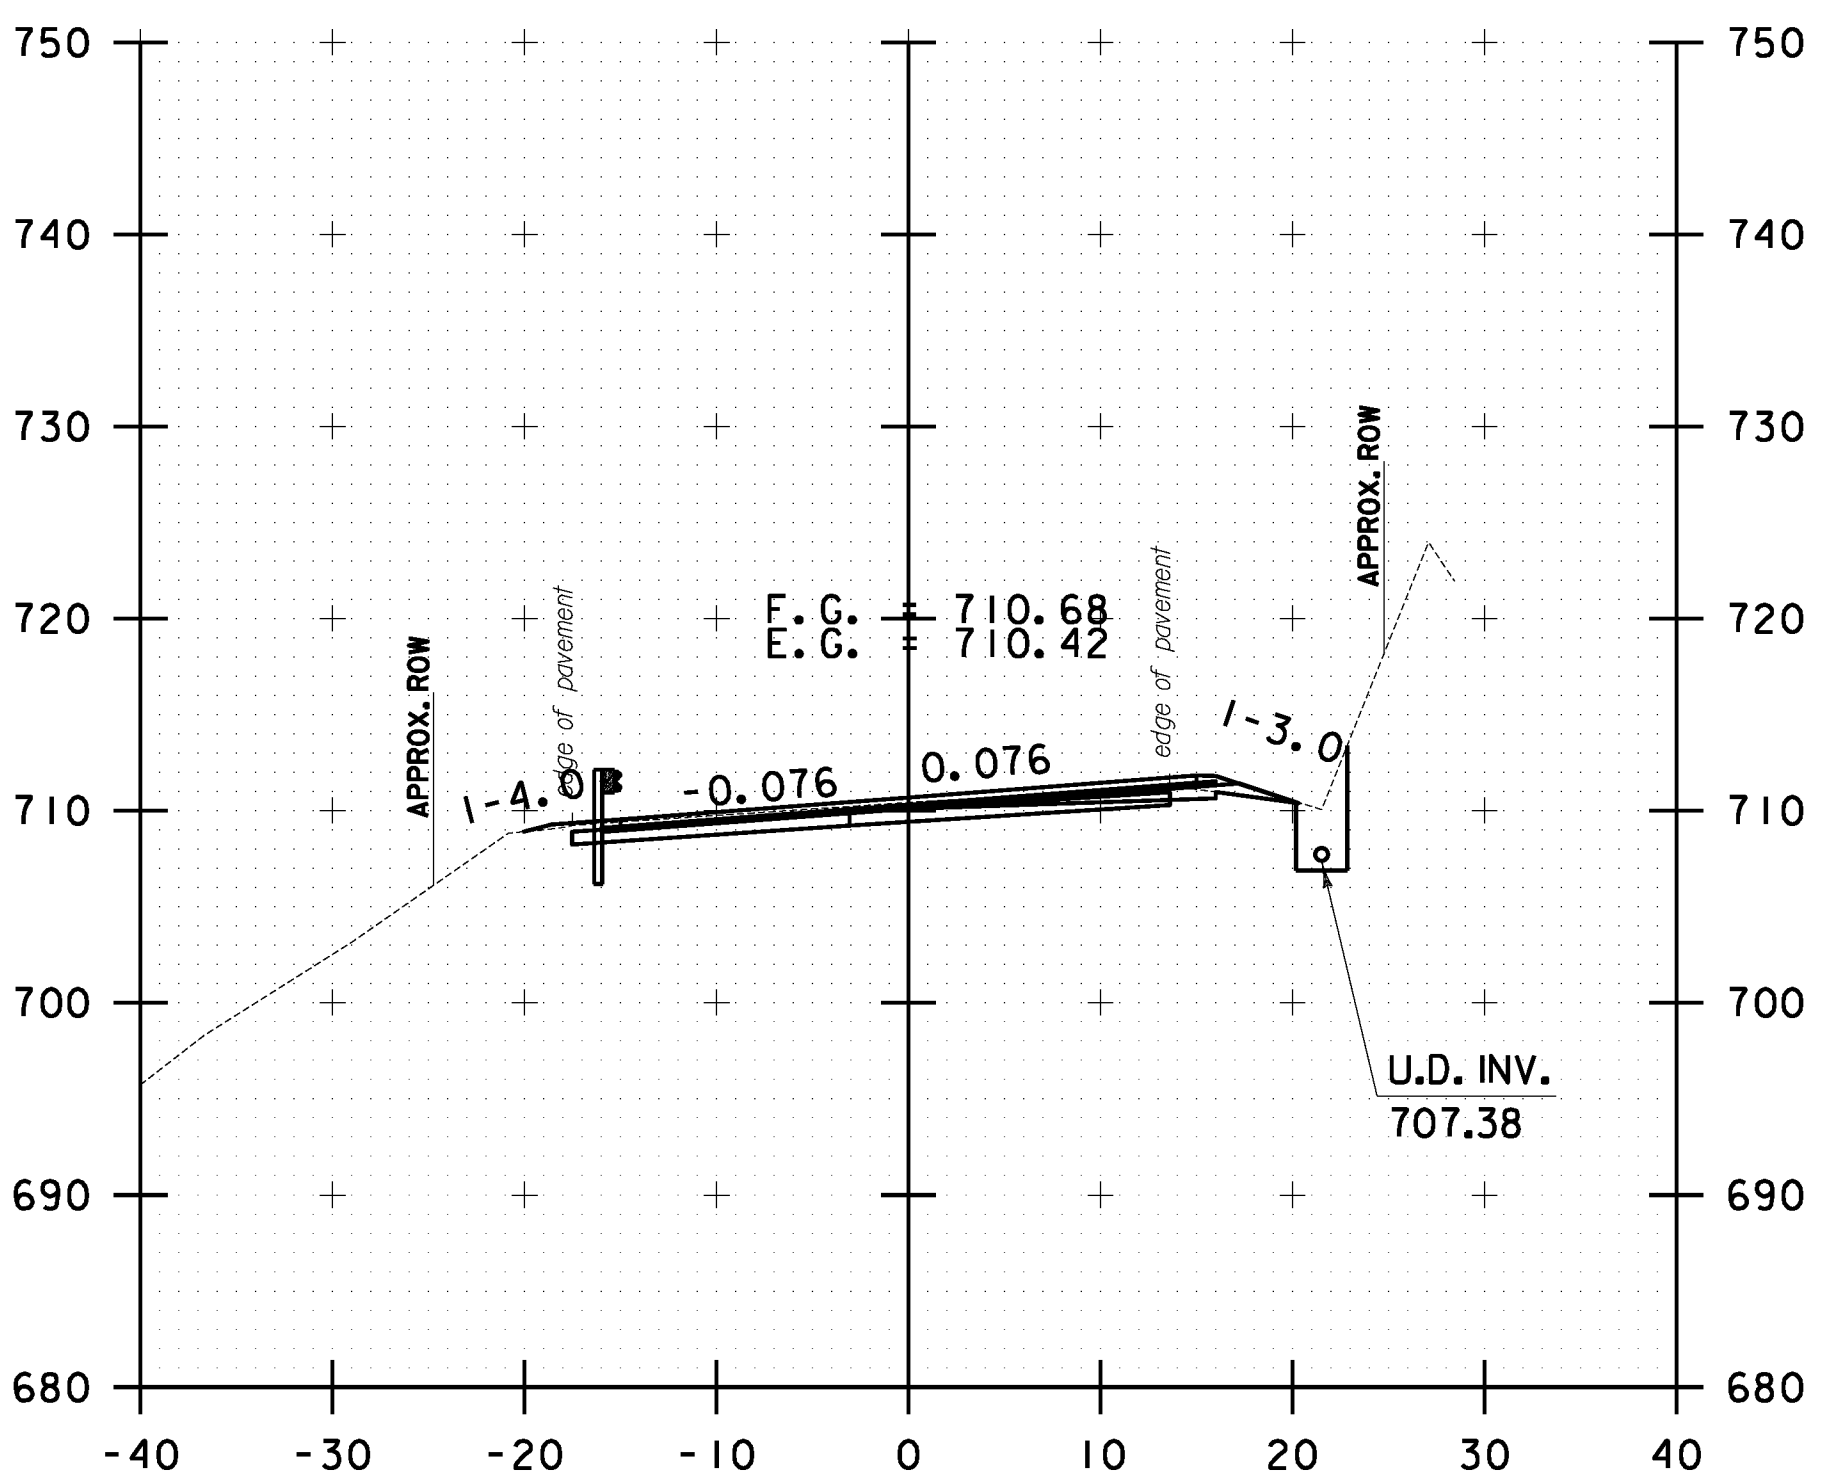


93+50.00

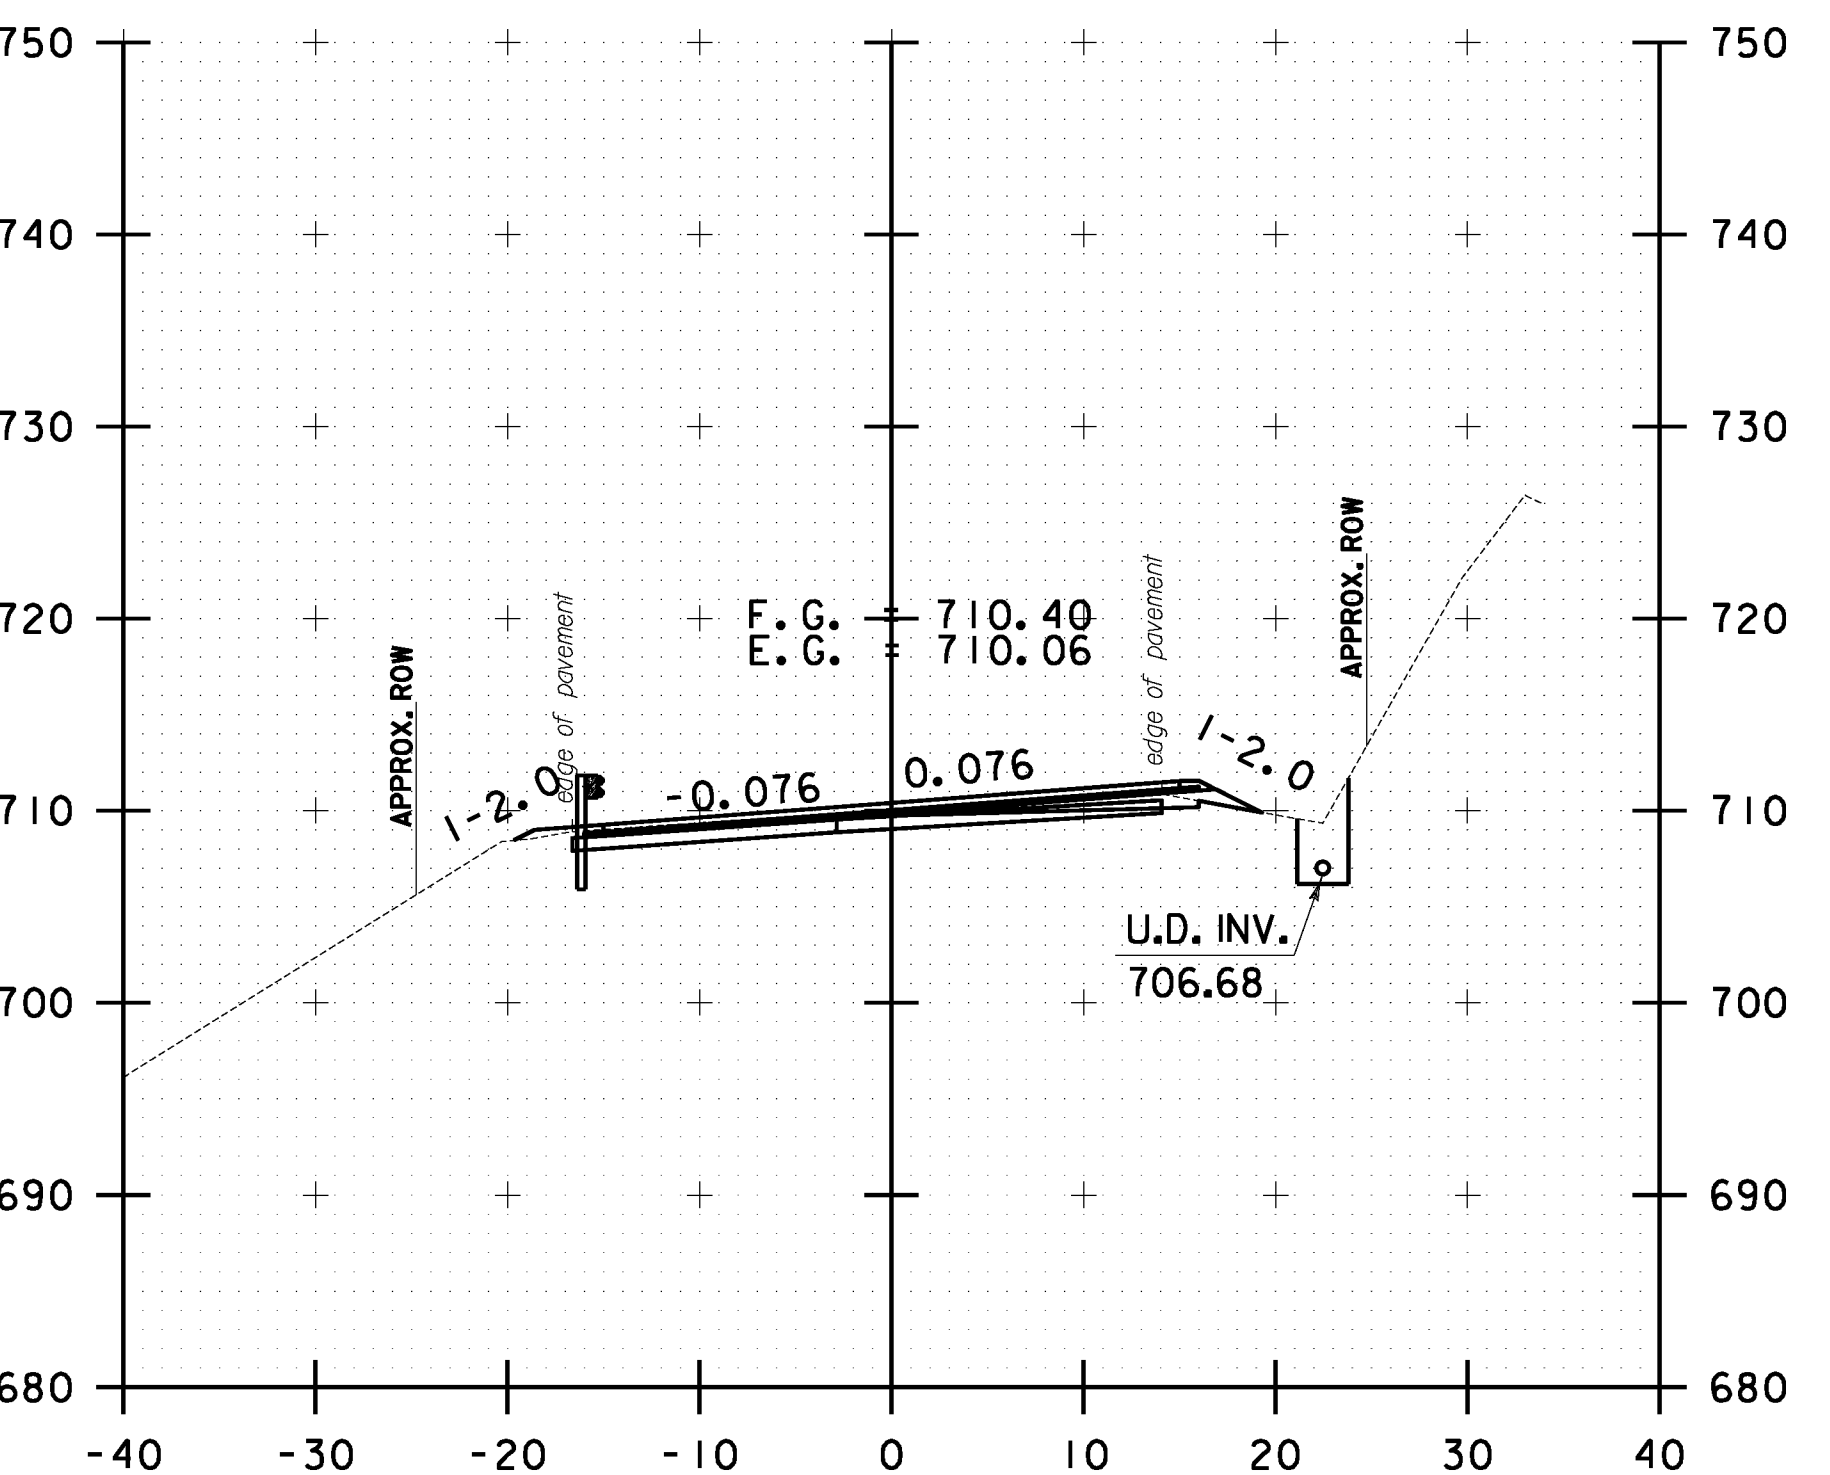

94+50.00

FILE NAME = V:\P\c\res\any\k2\22425\CA001\MSTN\10b214_stock.nc.dgn
 DATE/TIME = 3/17/2014
 USER = 4916

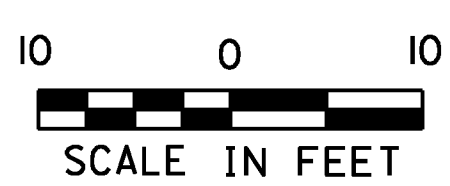

STOCKBRIDGE CROSS SECTION SHEET #31	PROJECT NAME: STOCKBRIDGE-BETHEL
	PROJECT NUMBER: STP 2910(1)
	FILE NAME: z10b214_stock.nc.dgn
DESIGNED BY: L.M.B.	PLOT DATE: 3/17/2014
IPARM FILE: z10b214xs31.1	DRAWN BY: W.G.P.
	CHECKED BY: J.P.S.
	SHEET 244 OF 397