




FILE NAME = V:\P\c\ass\ANY\K2\22425\CADD\MSTN\10b214\_stock.nc.dgn  
 DATE/TIME = 3/17/2014  
 USER = 4916

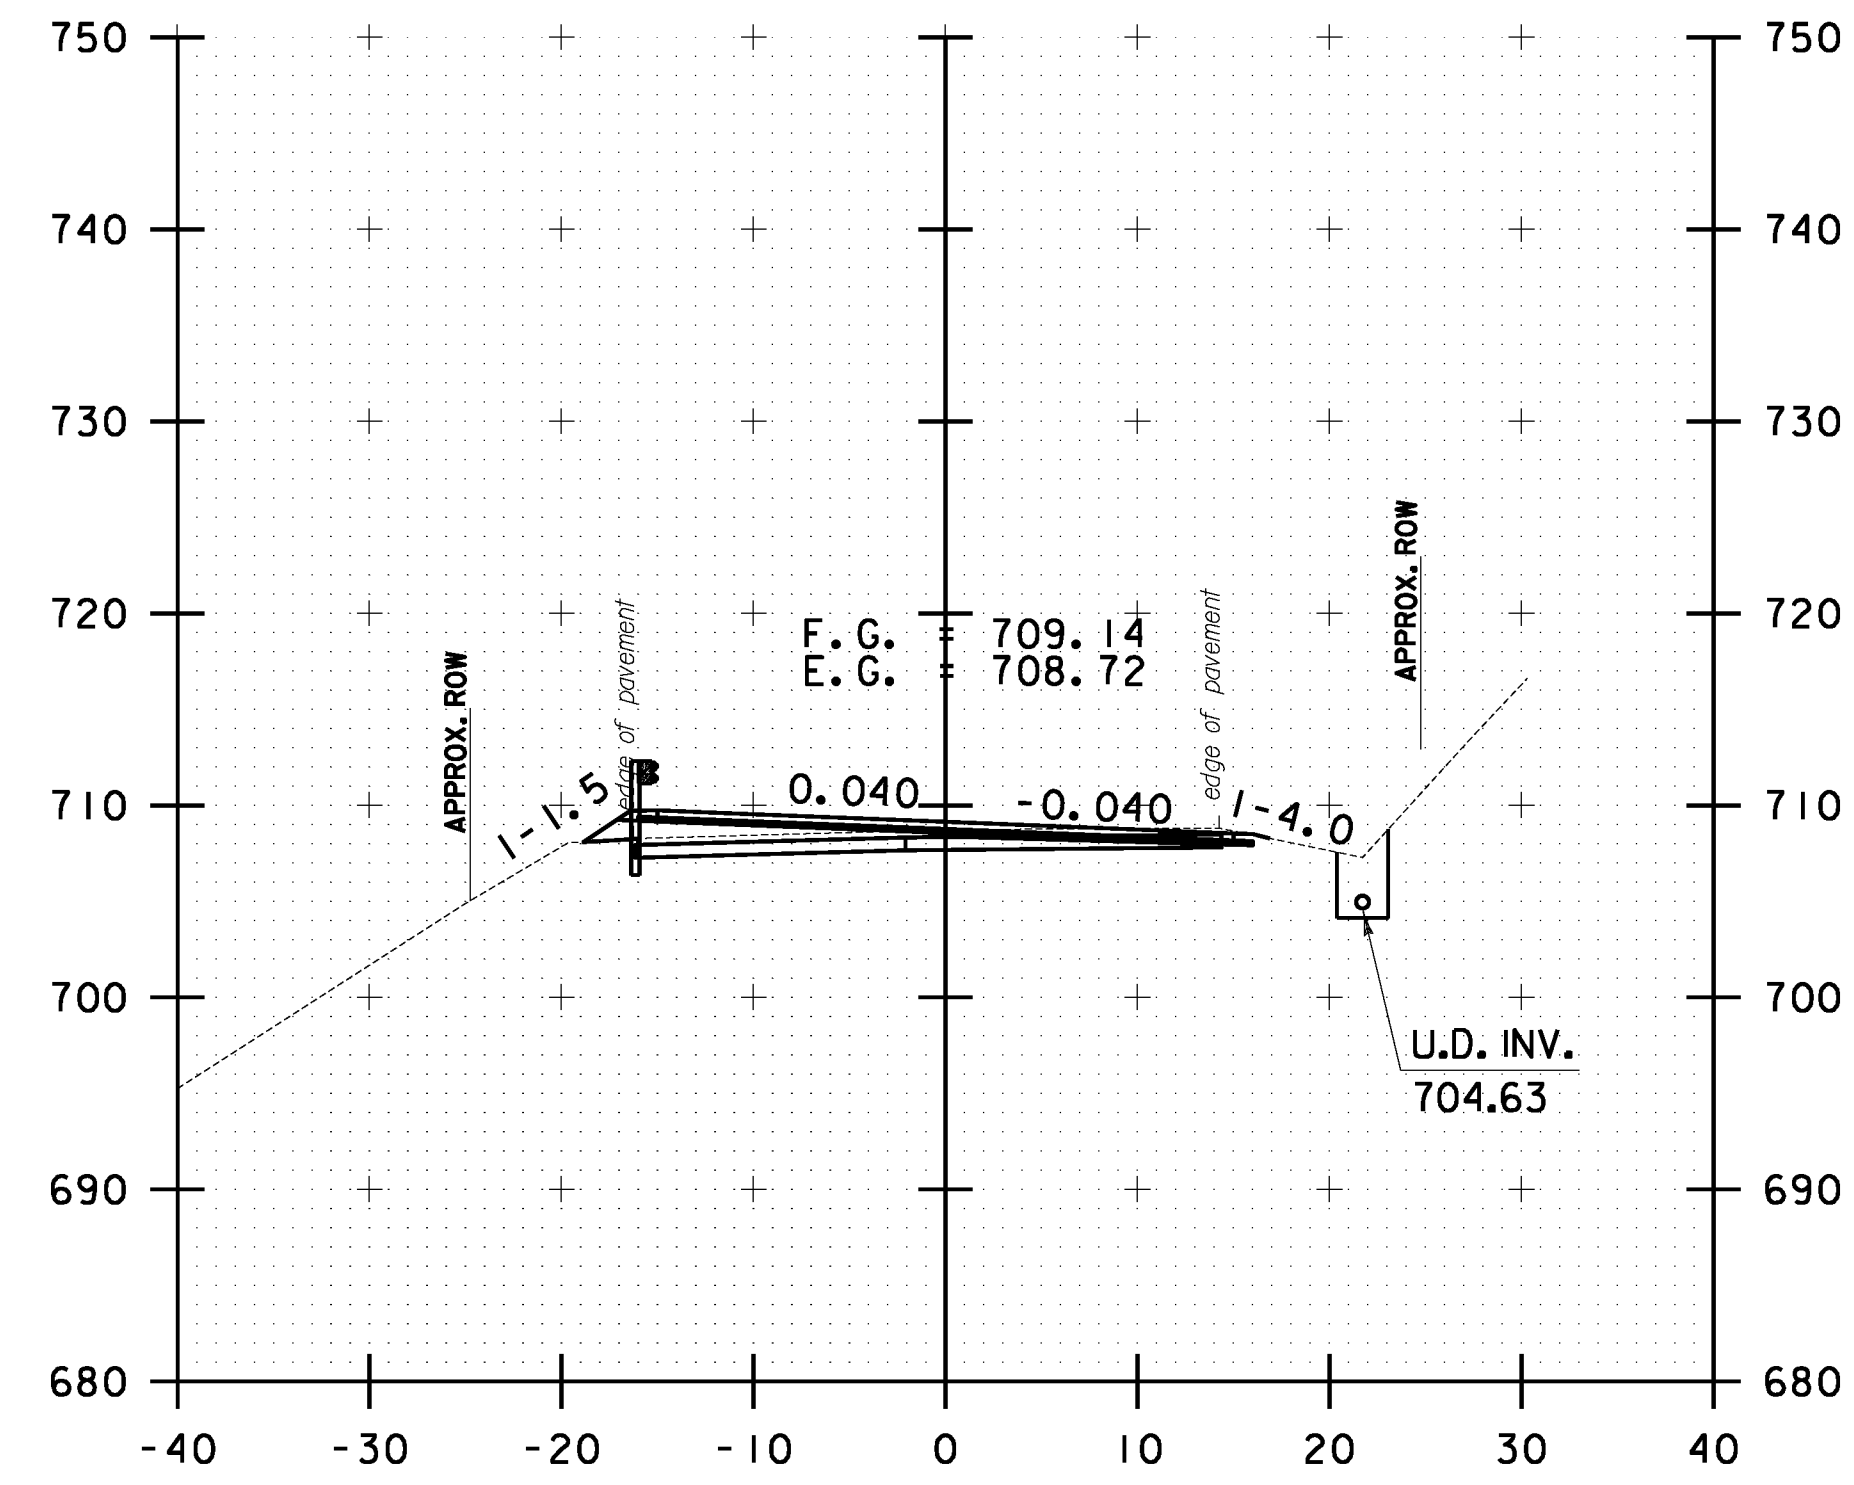


99+00.00

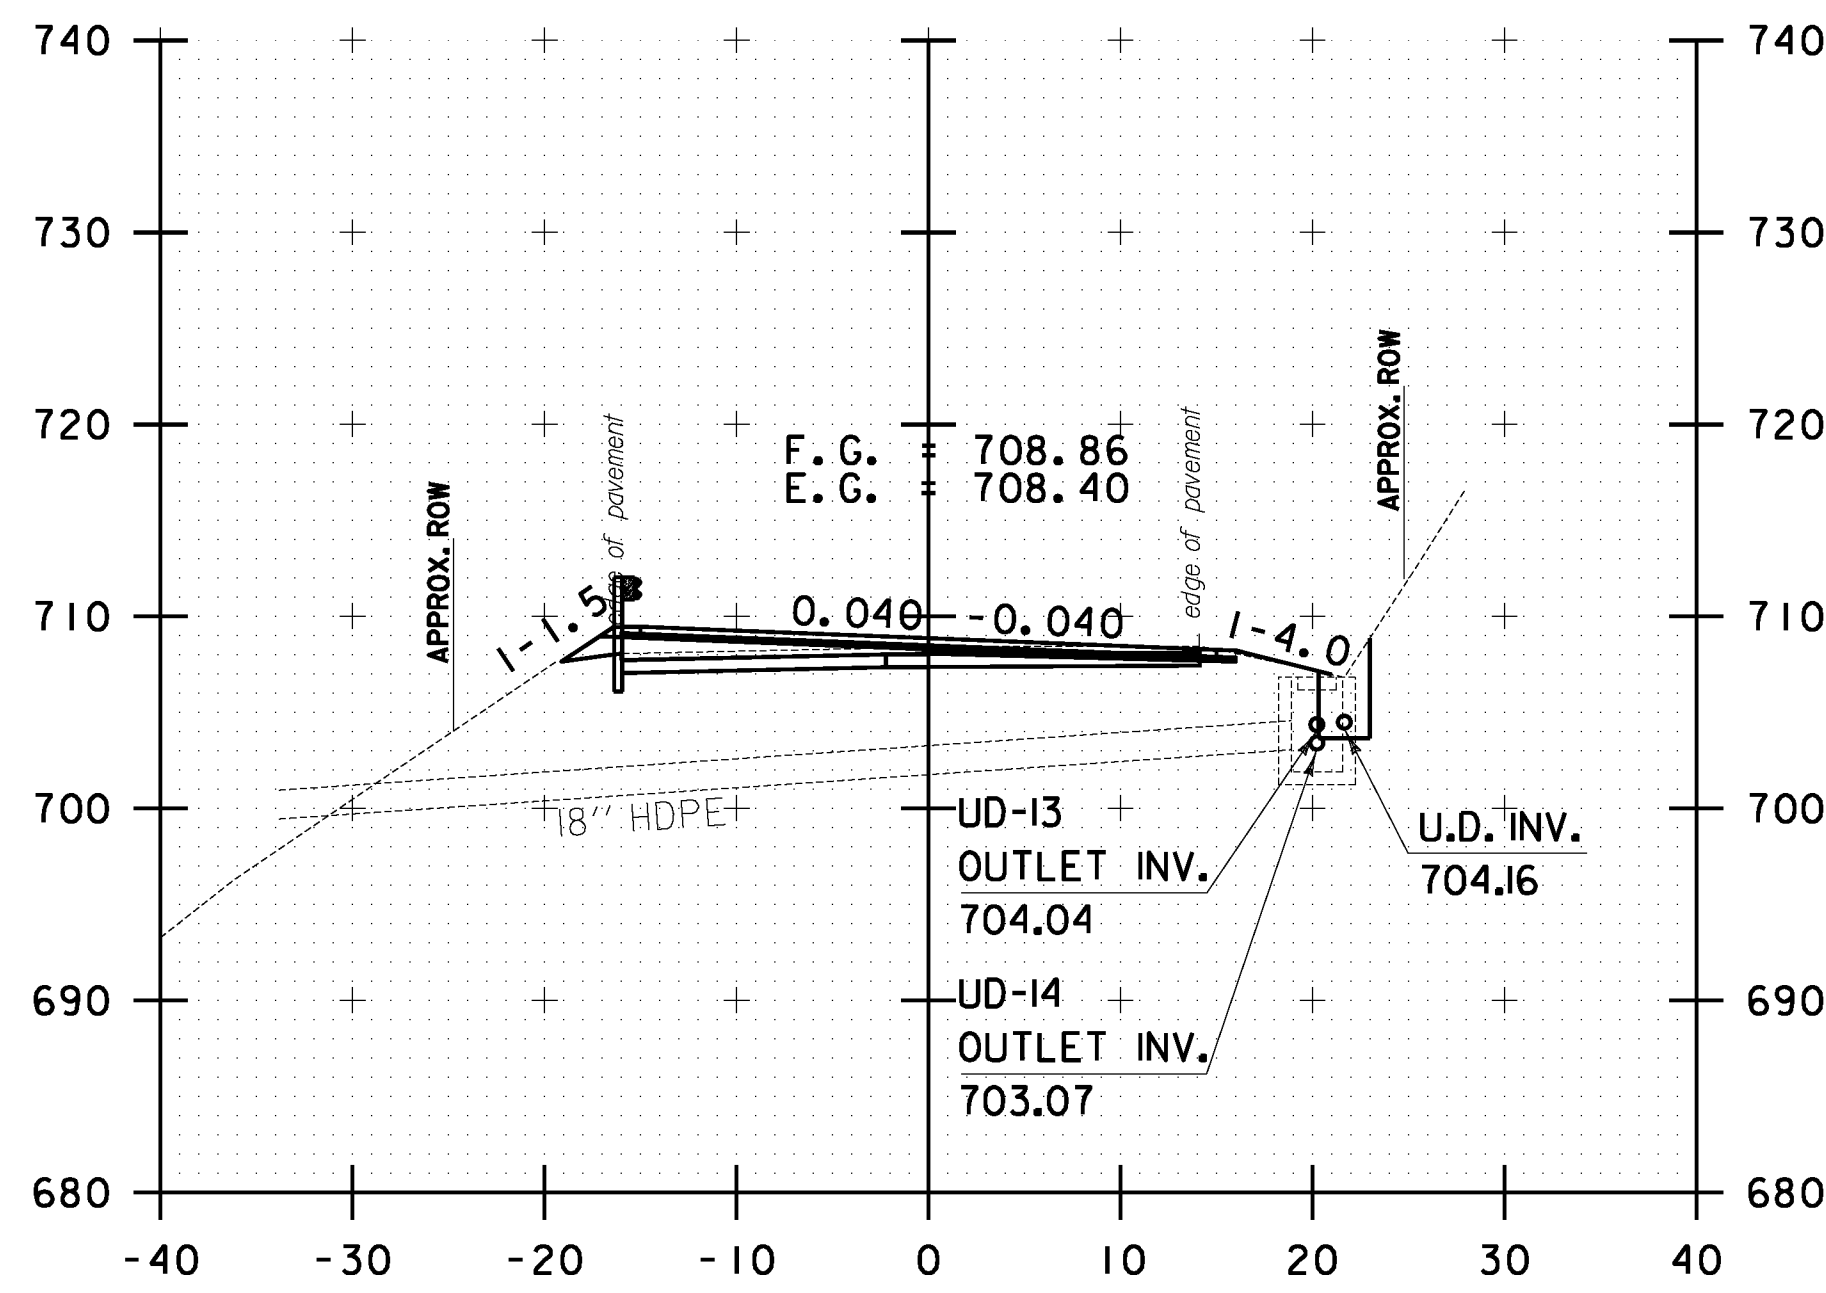


100+00.00

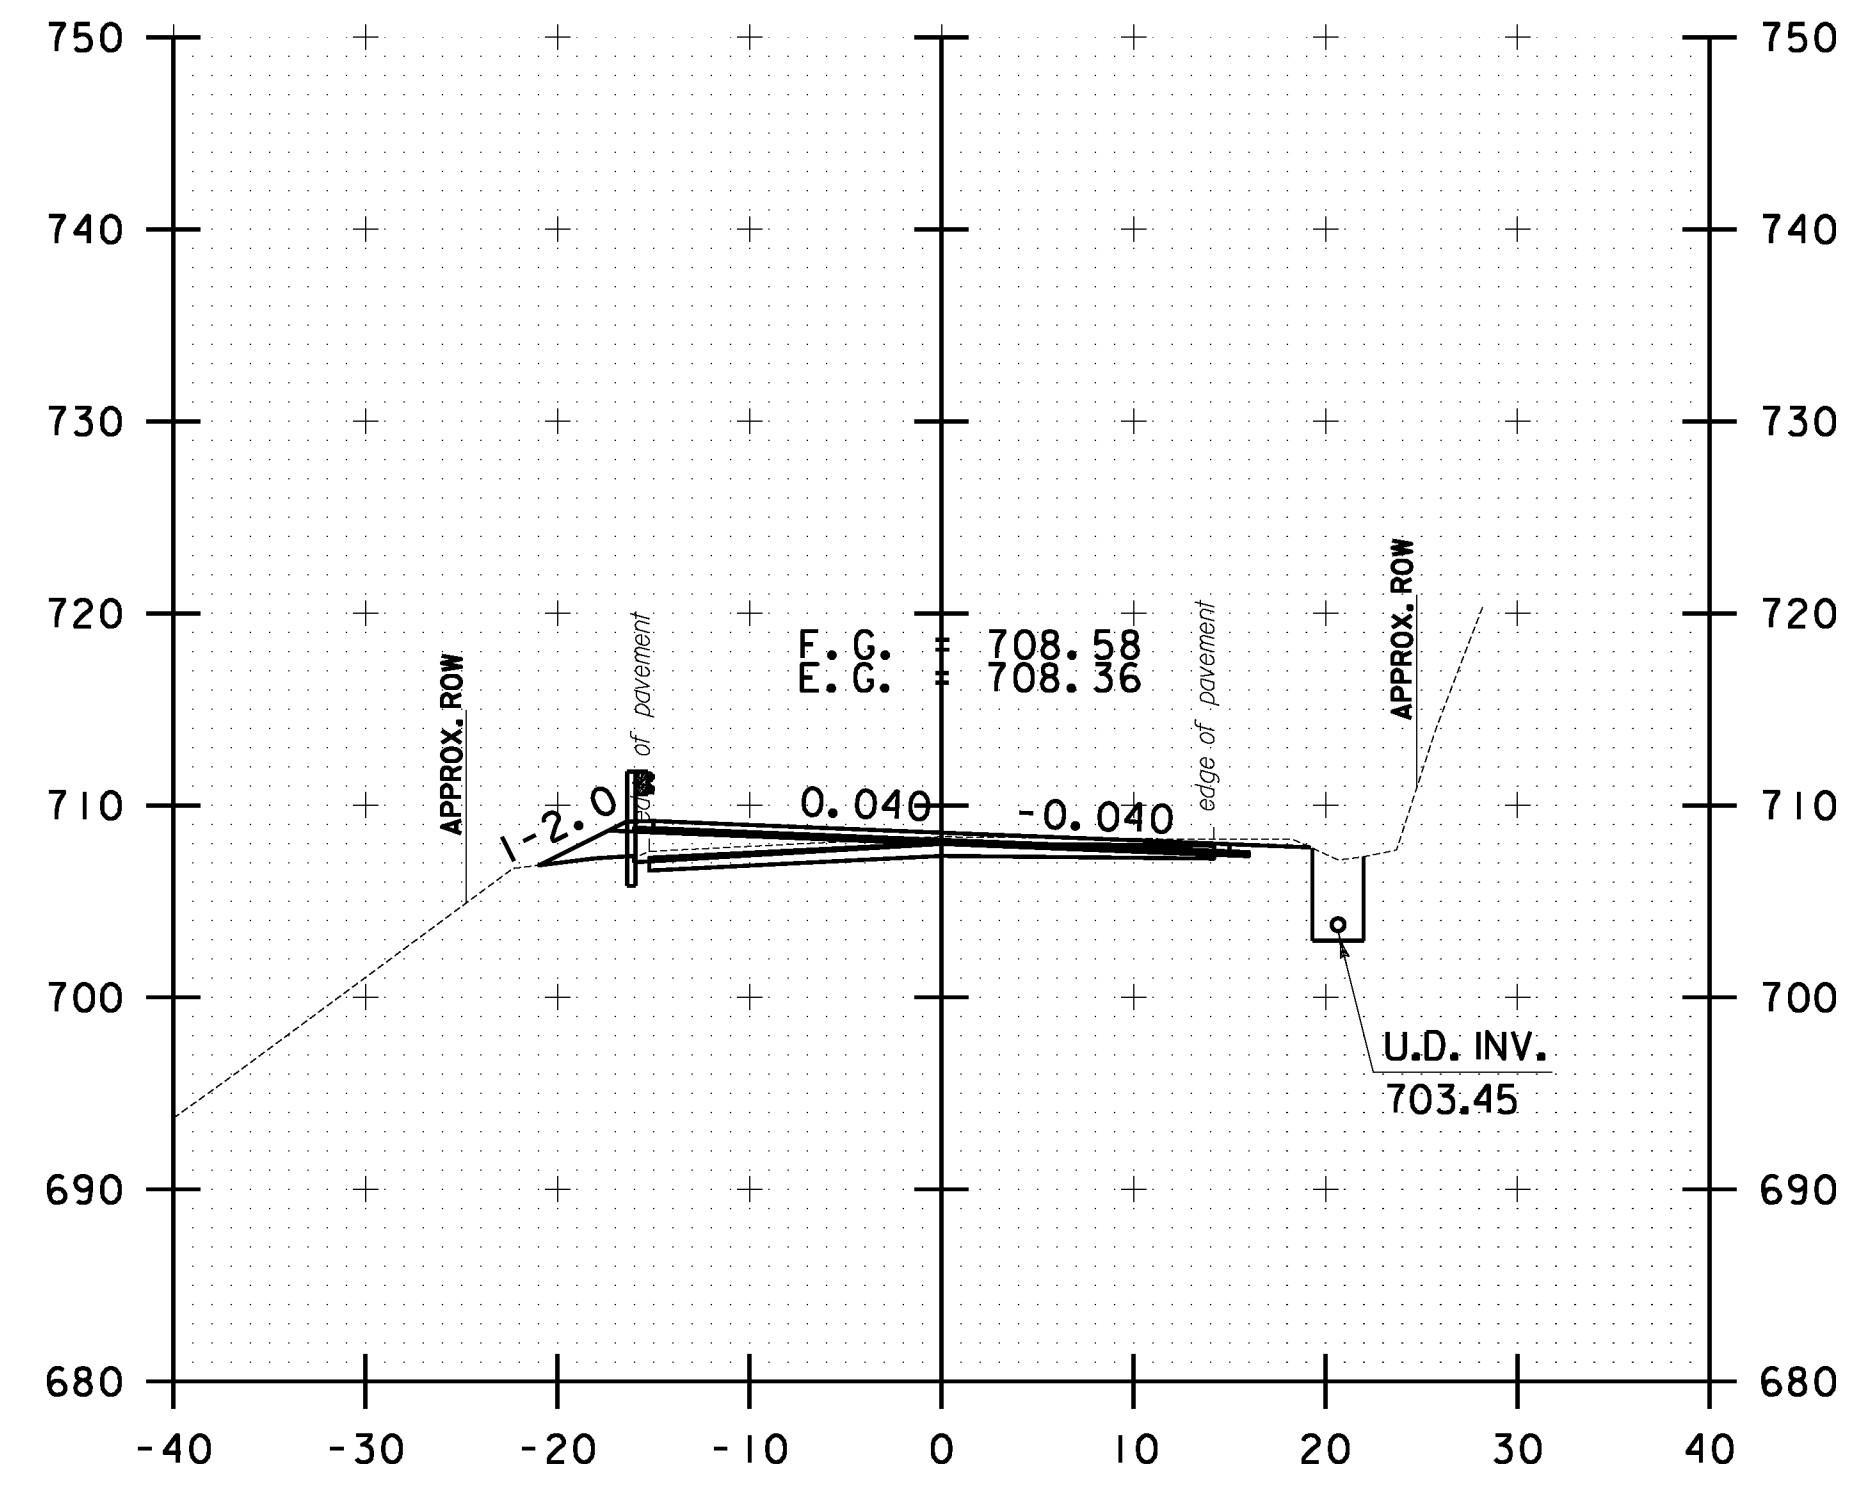


101+00.00

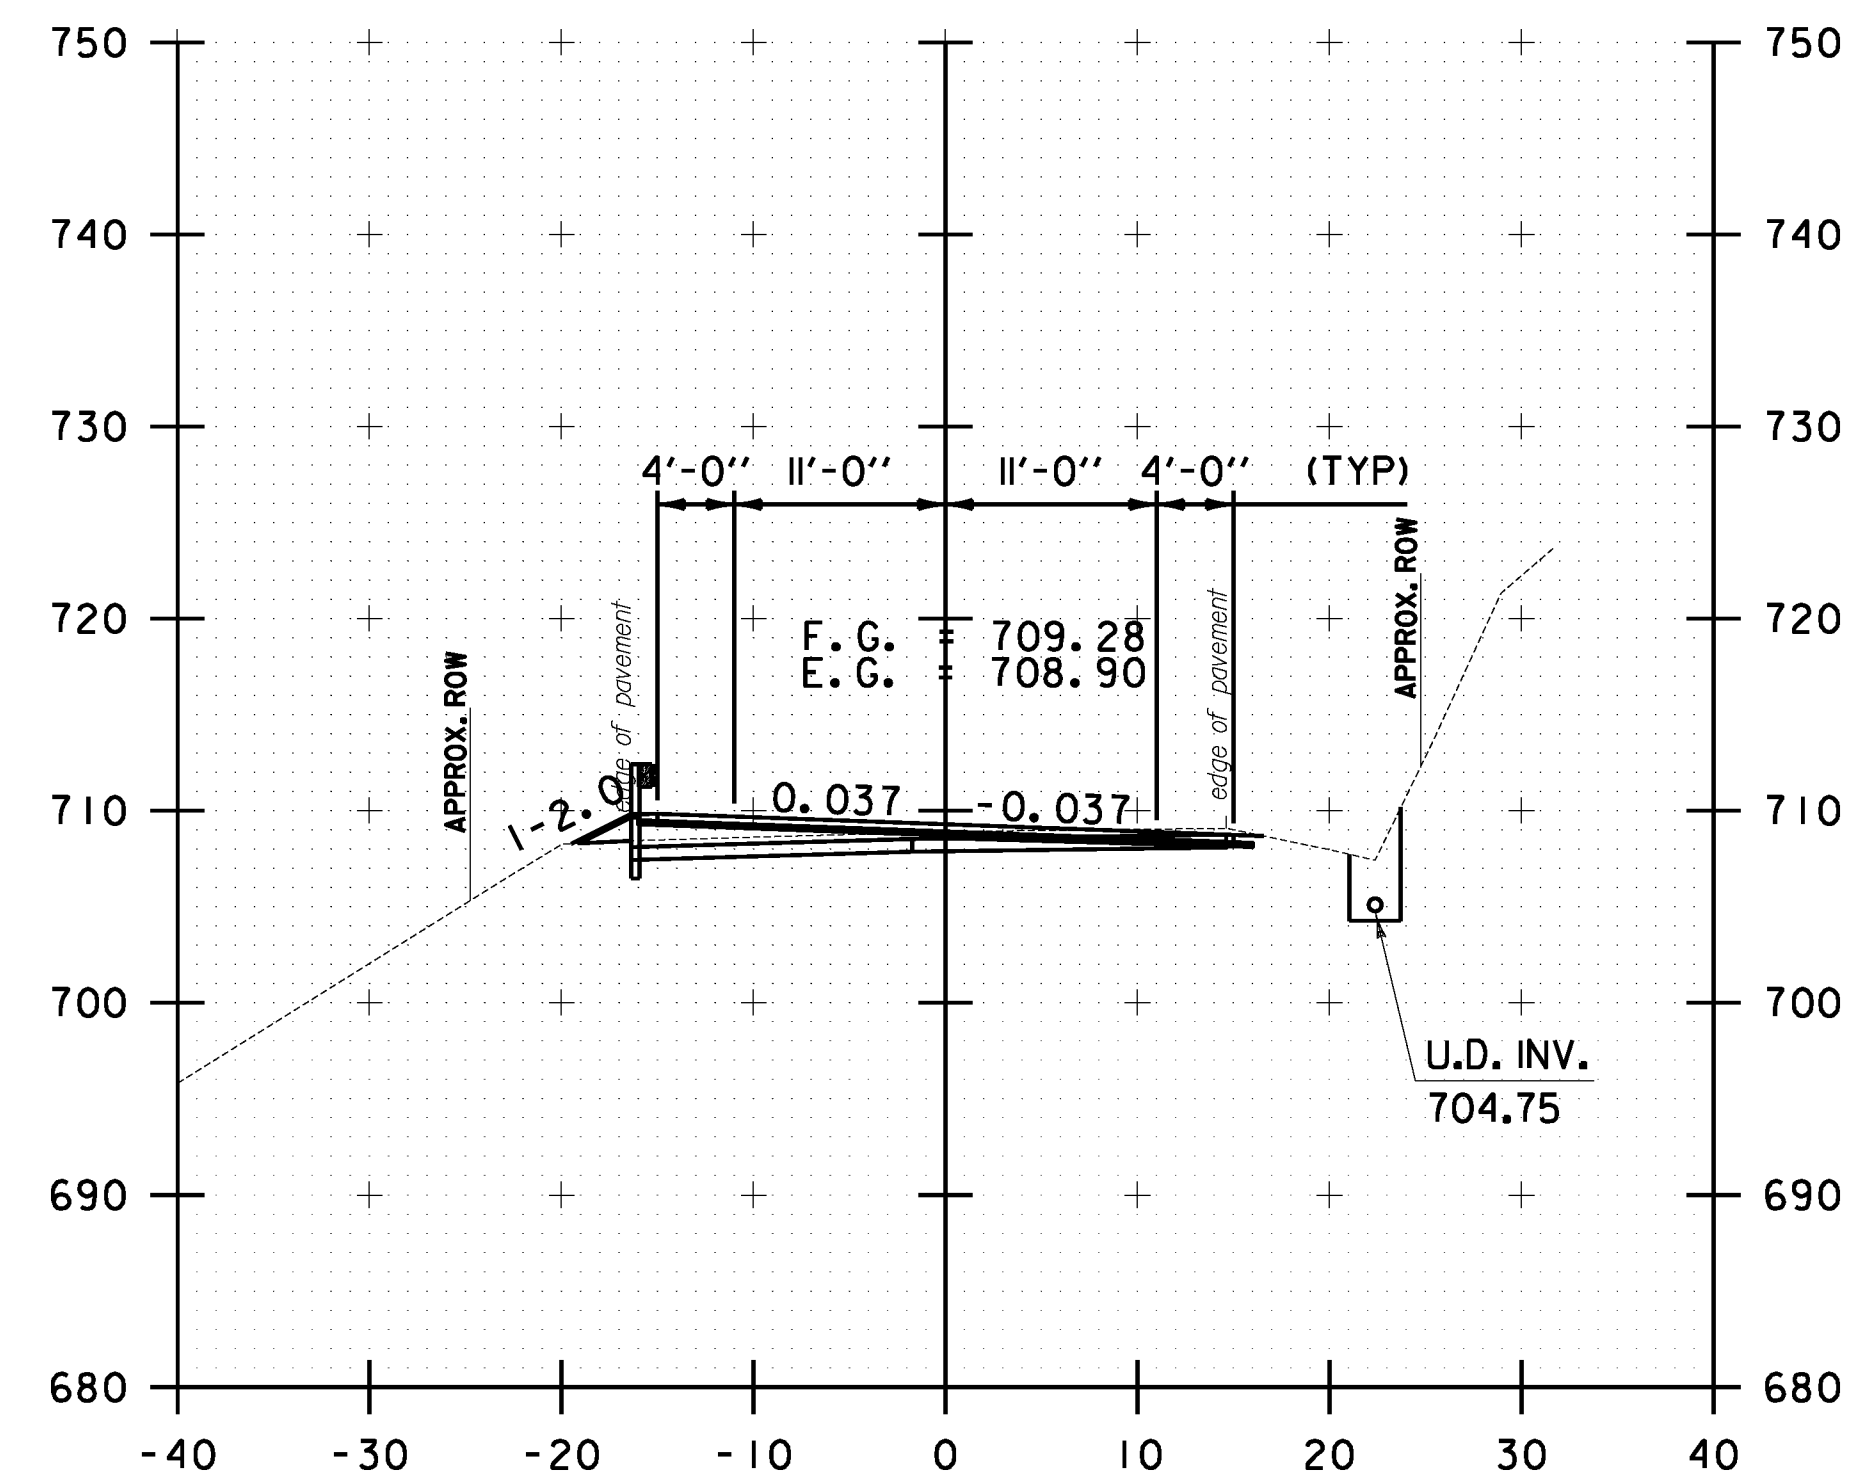

98+50.00

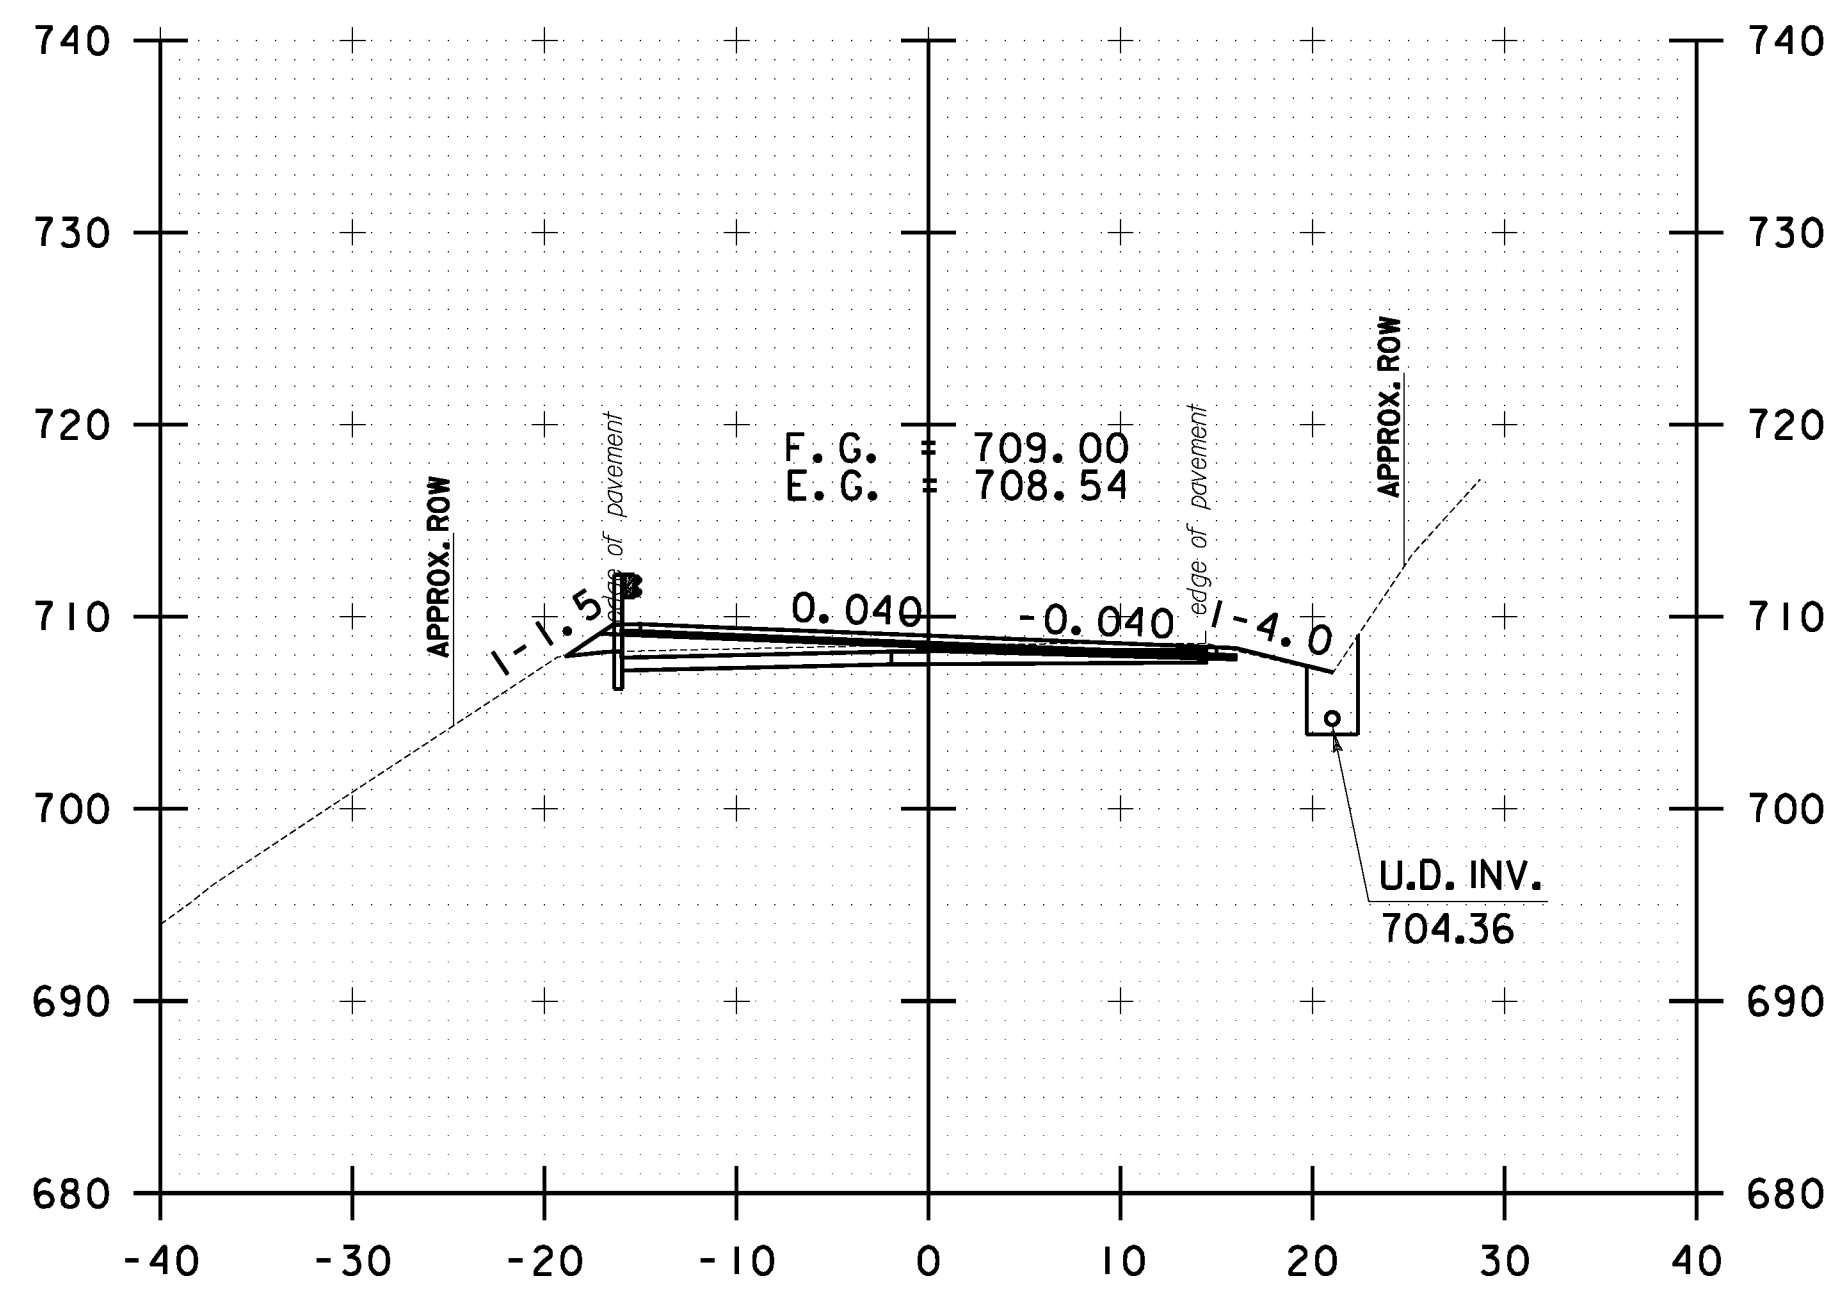

99+50.00

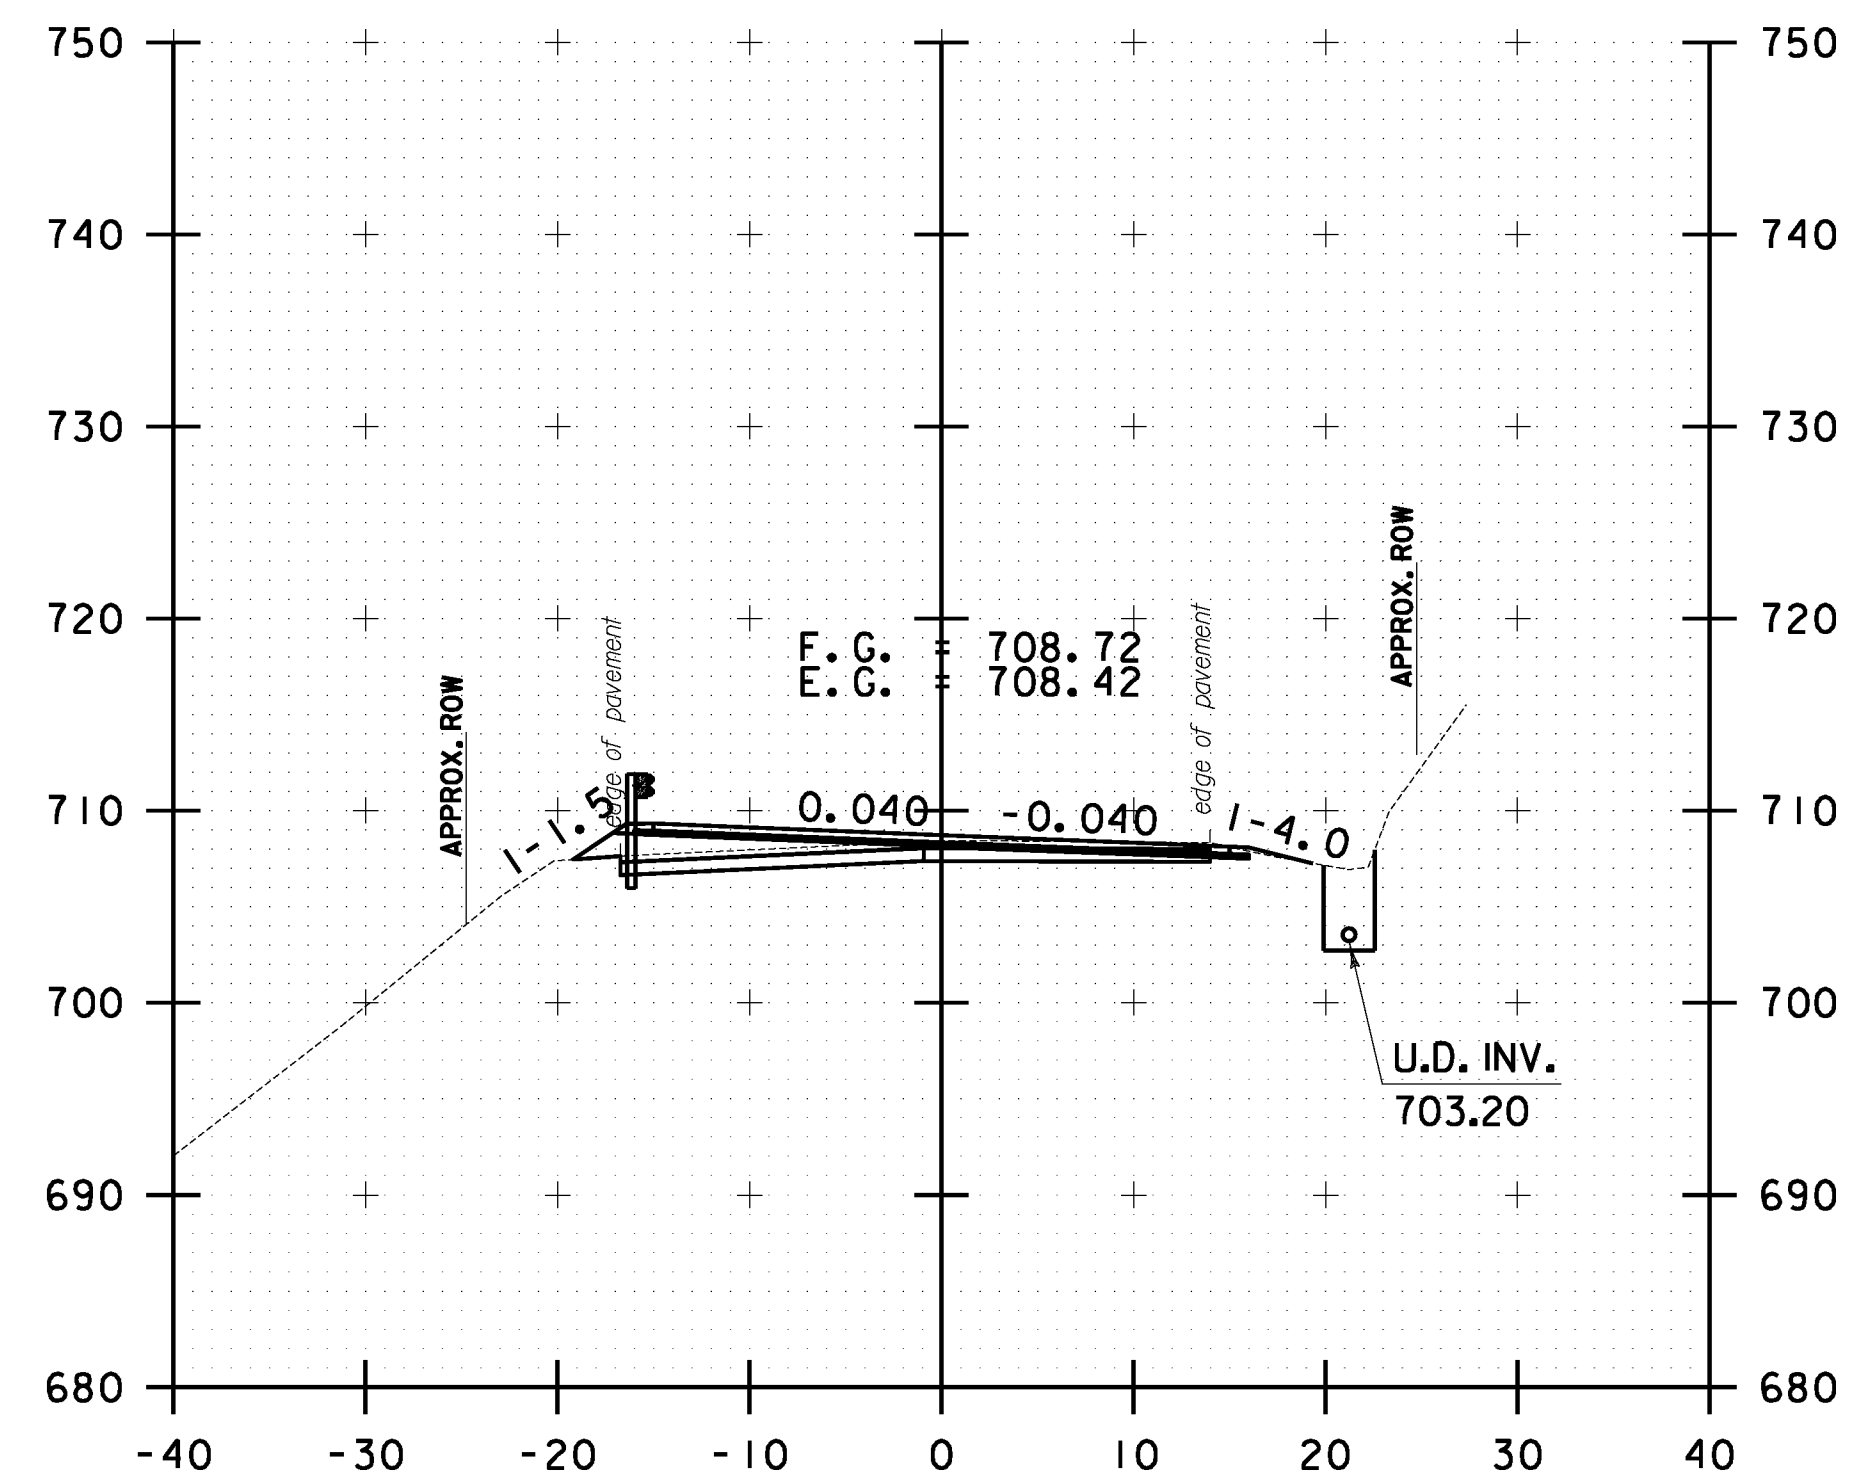

100+50.00



<b>STOCKBRIDGE CROSS SECTION SHEET #33</b>	PROJECT NAME: STOCKBRIDGE-BETHEL
	PROJECT NUMBER: STP 2910(1)
	FILE NAME: z10b214_stock.xc.dgn
	IPARM FILE: z10b214xs33.1
	PLOT DATE: 3/17/2014
	DRAWN BY: W.G.P.
	CHECKED BY: J.P.S.
	SHEET 246 OF 397