




FILE NAME = Y:\P\c\res\any\k2\22425\CADD\MSTN\10b214_stock.nc.dgn
 DATE/TIME = 3/17/2014
 USER = 4916

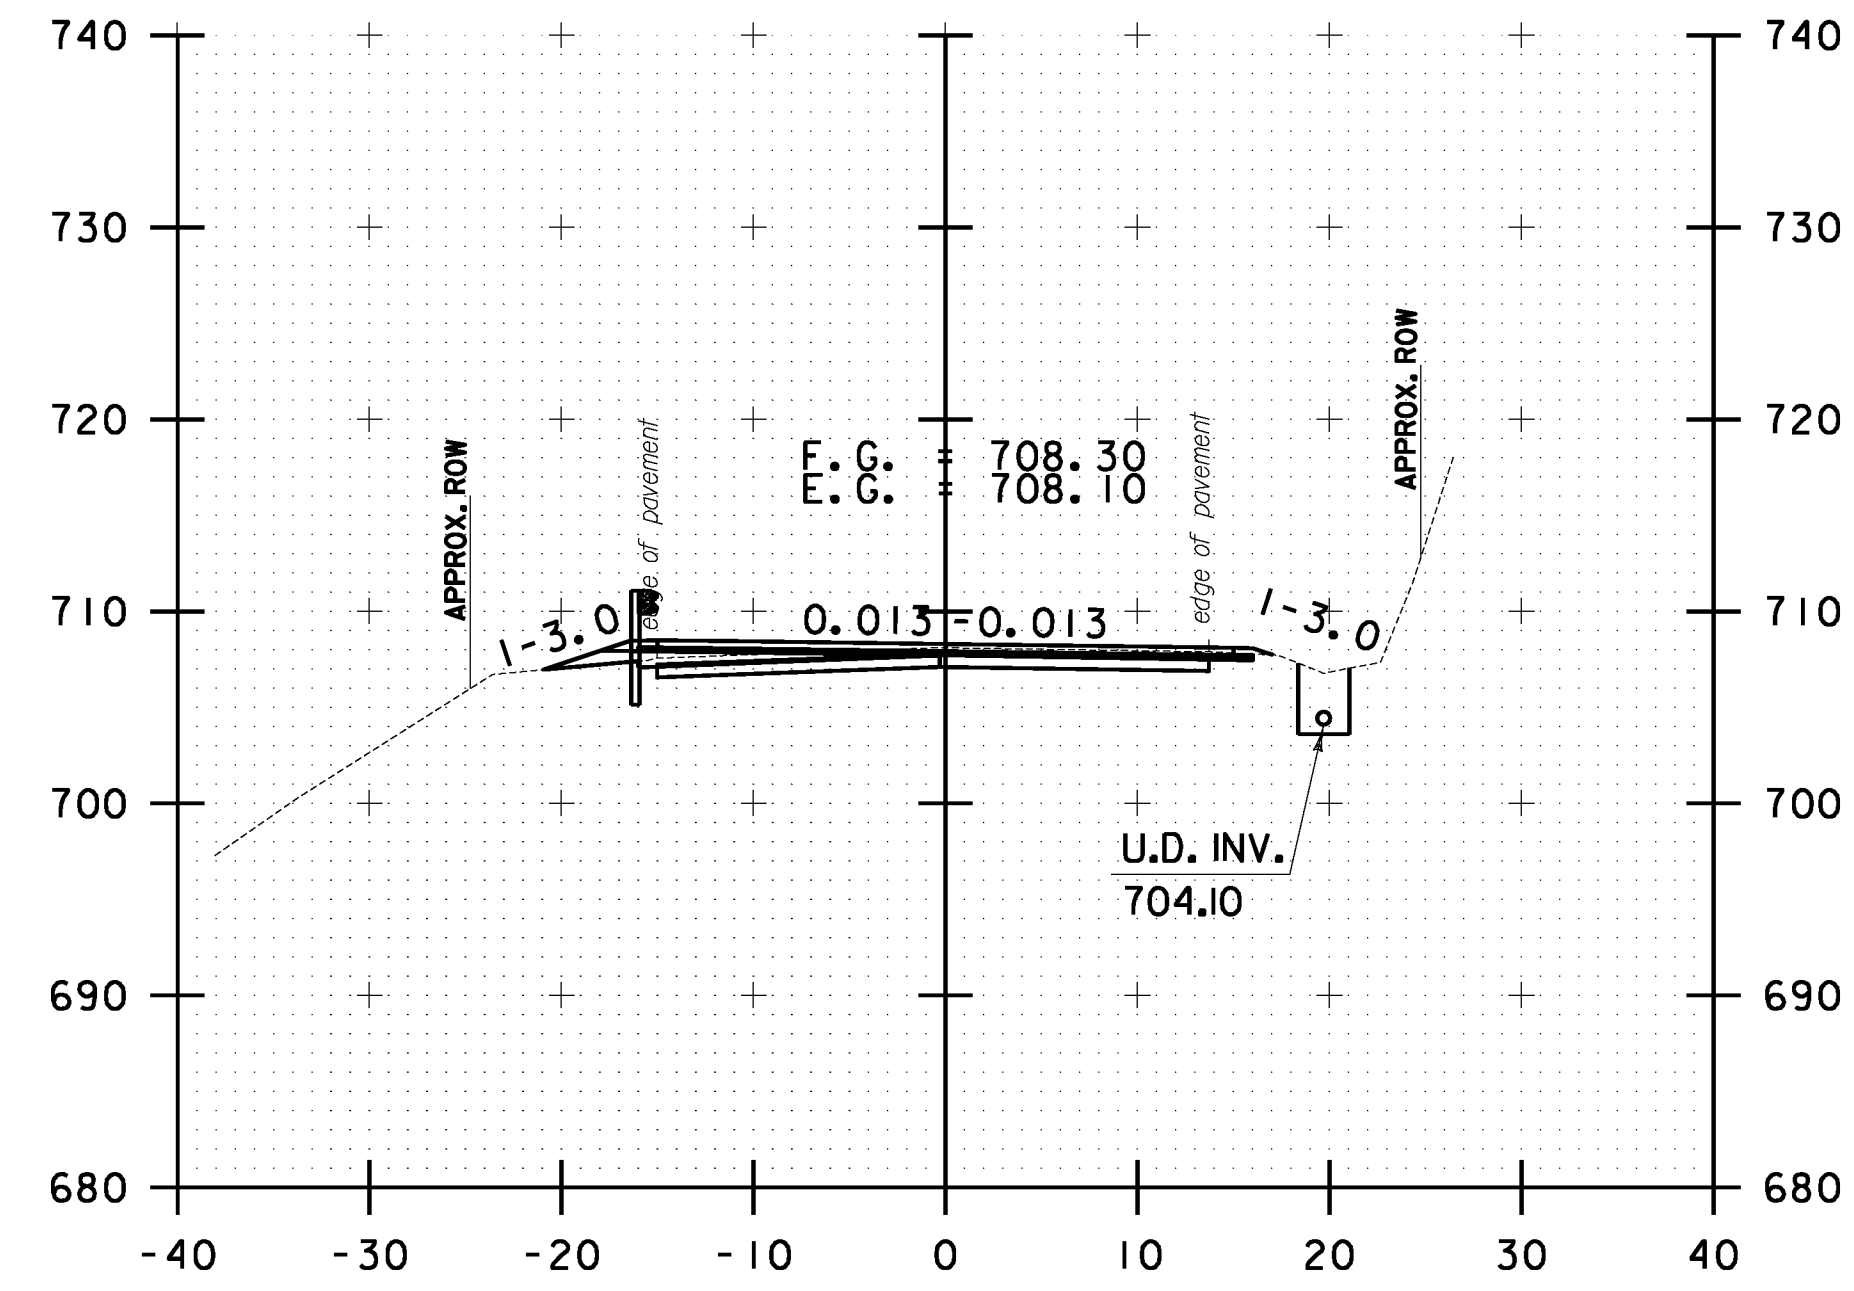


102+00.00

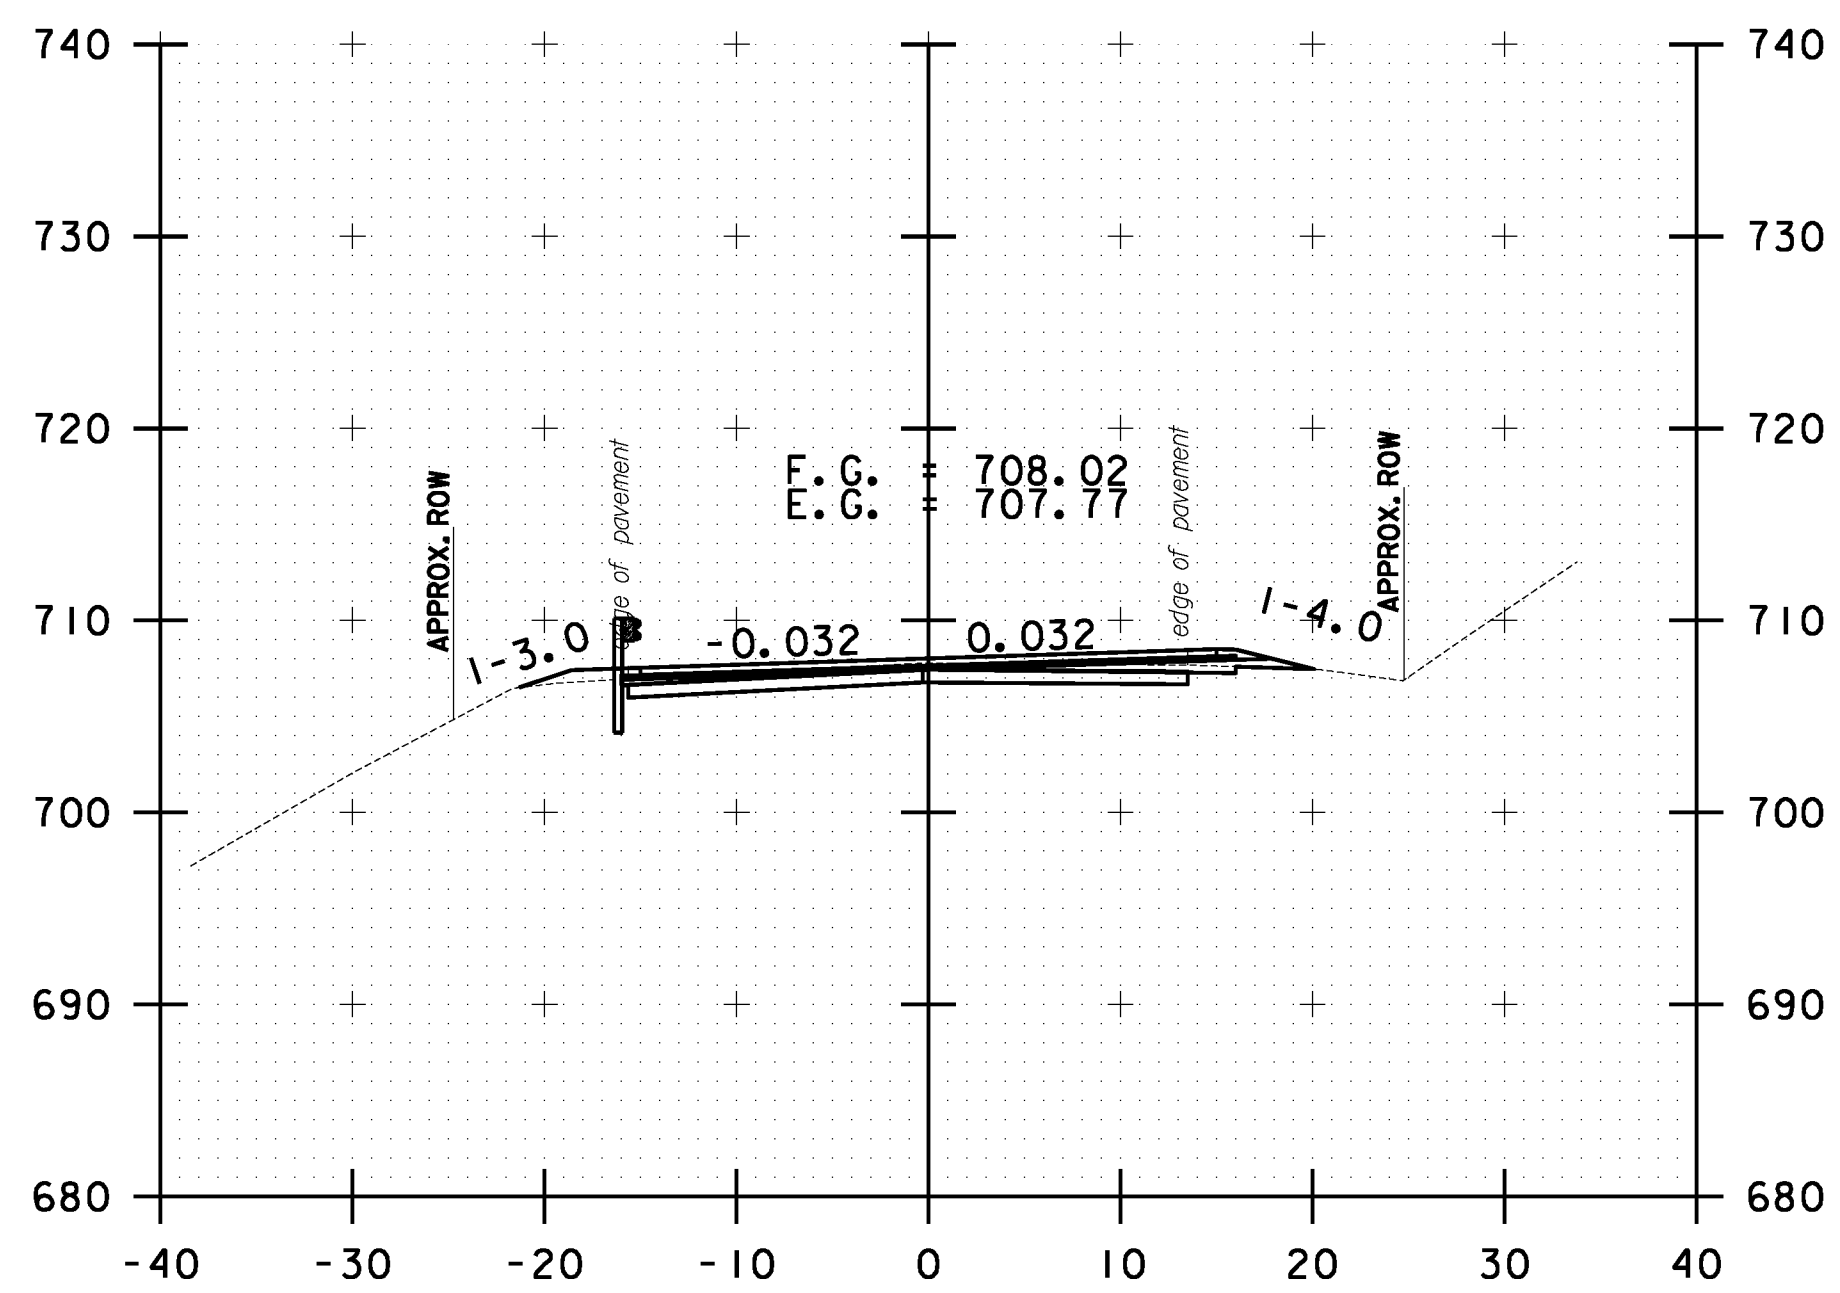


103+00.00

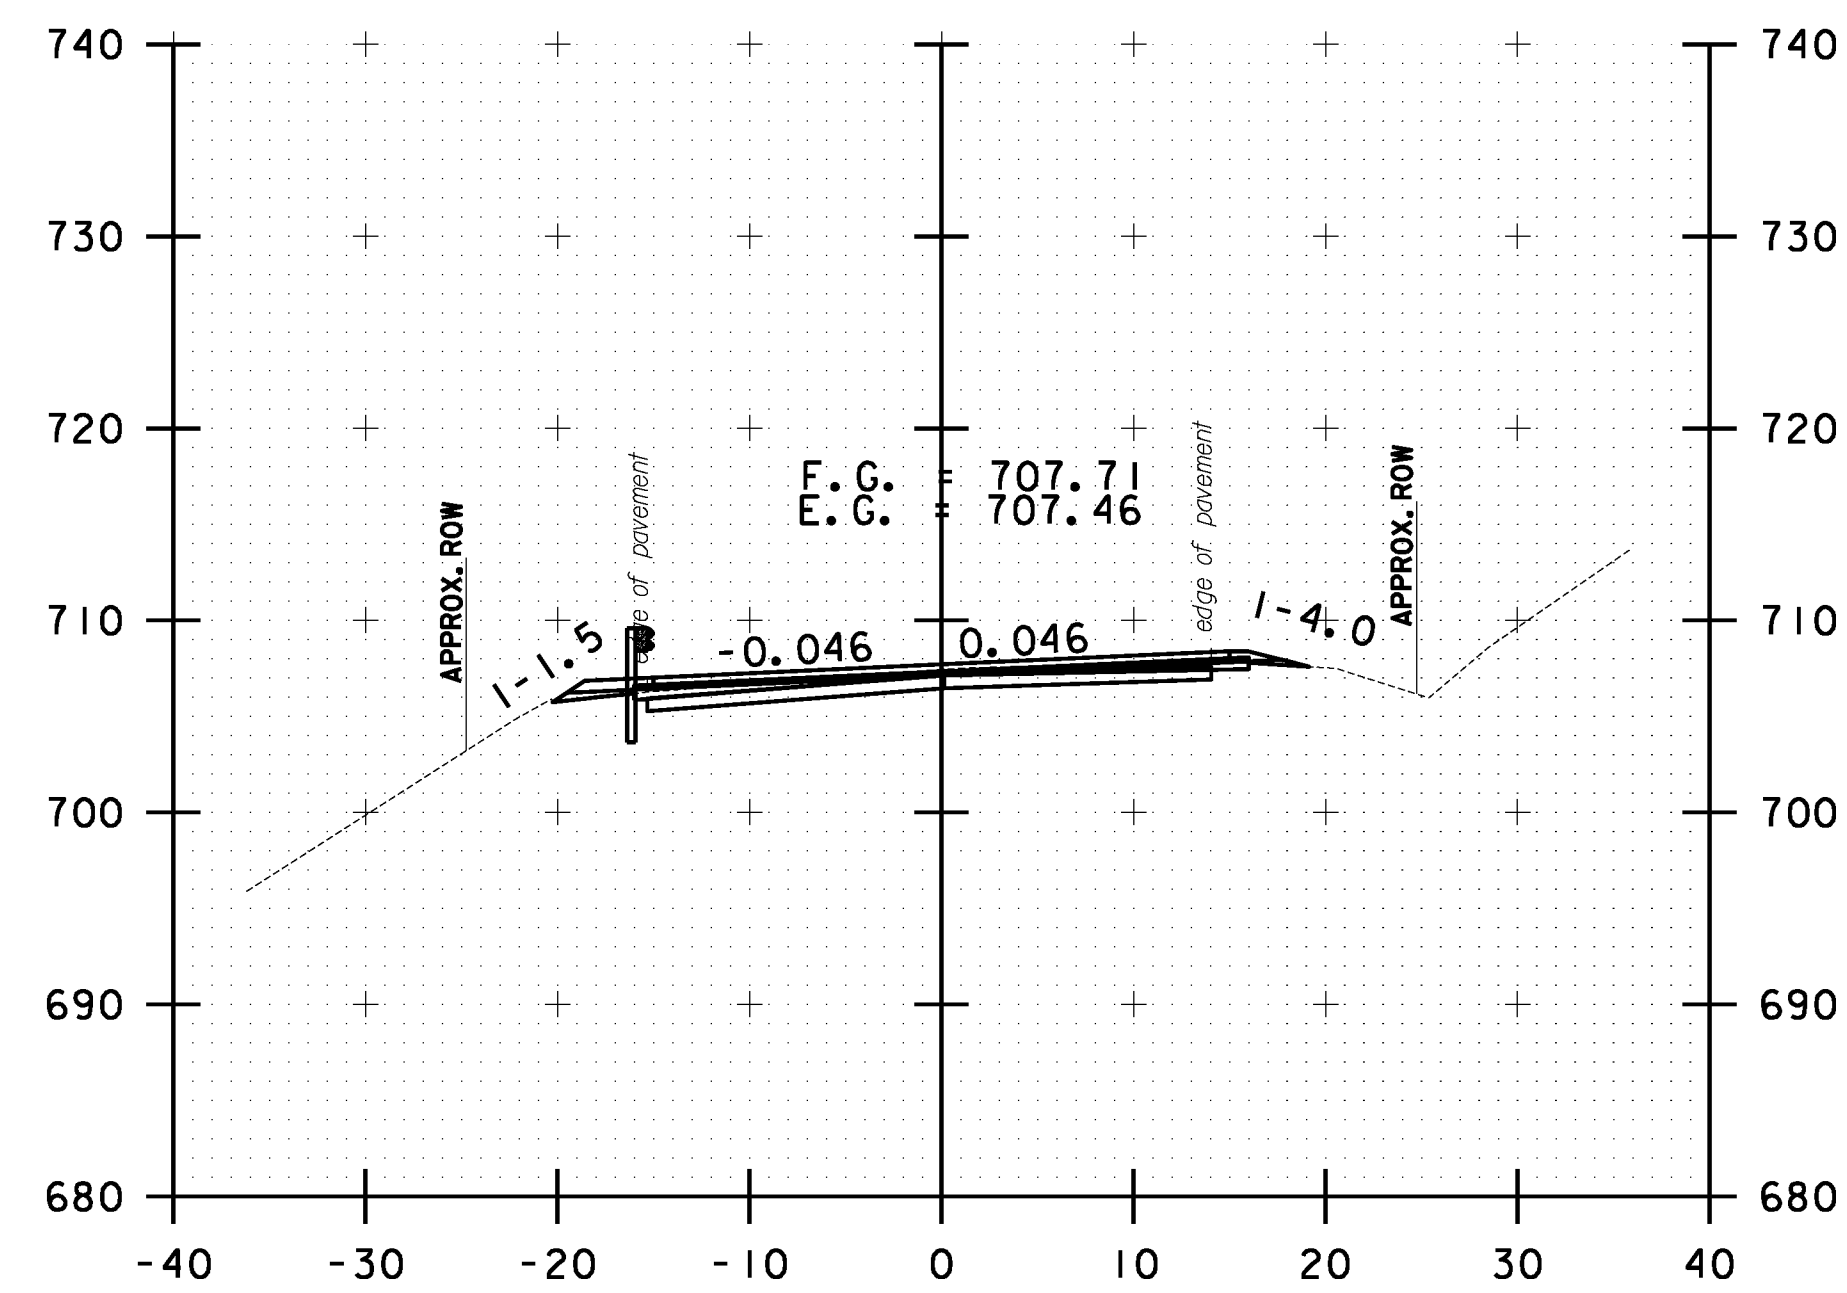


104+00.00

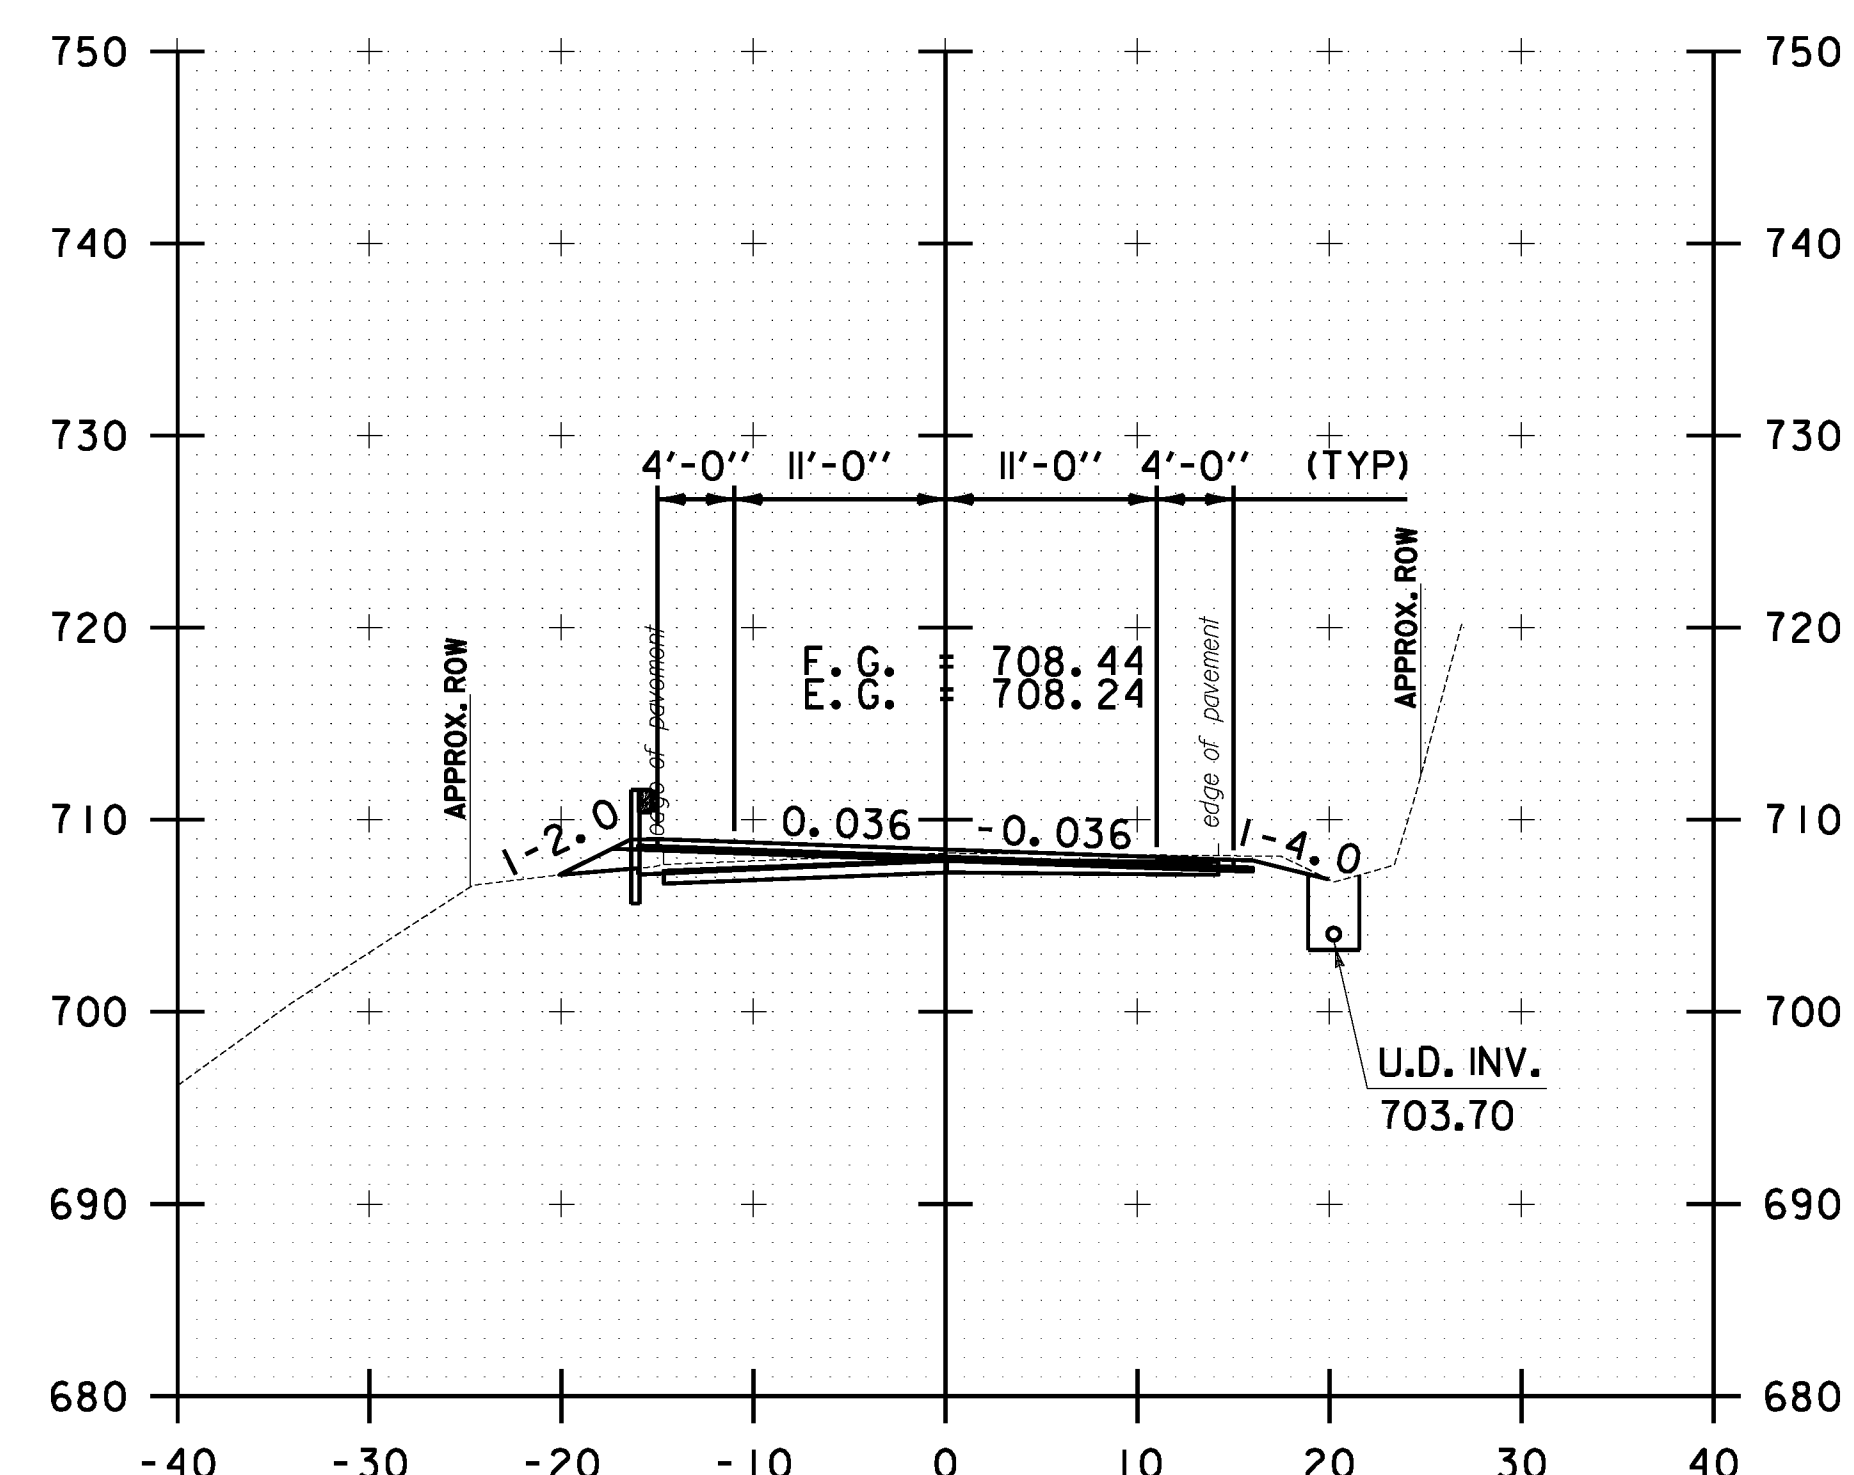


101+50.00

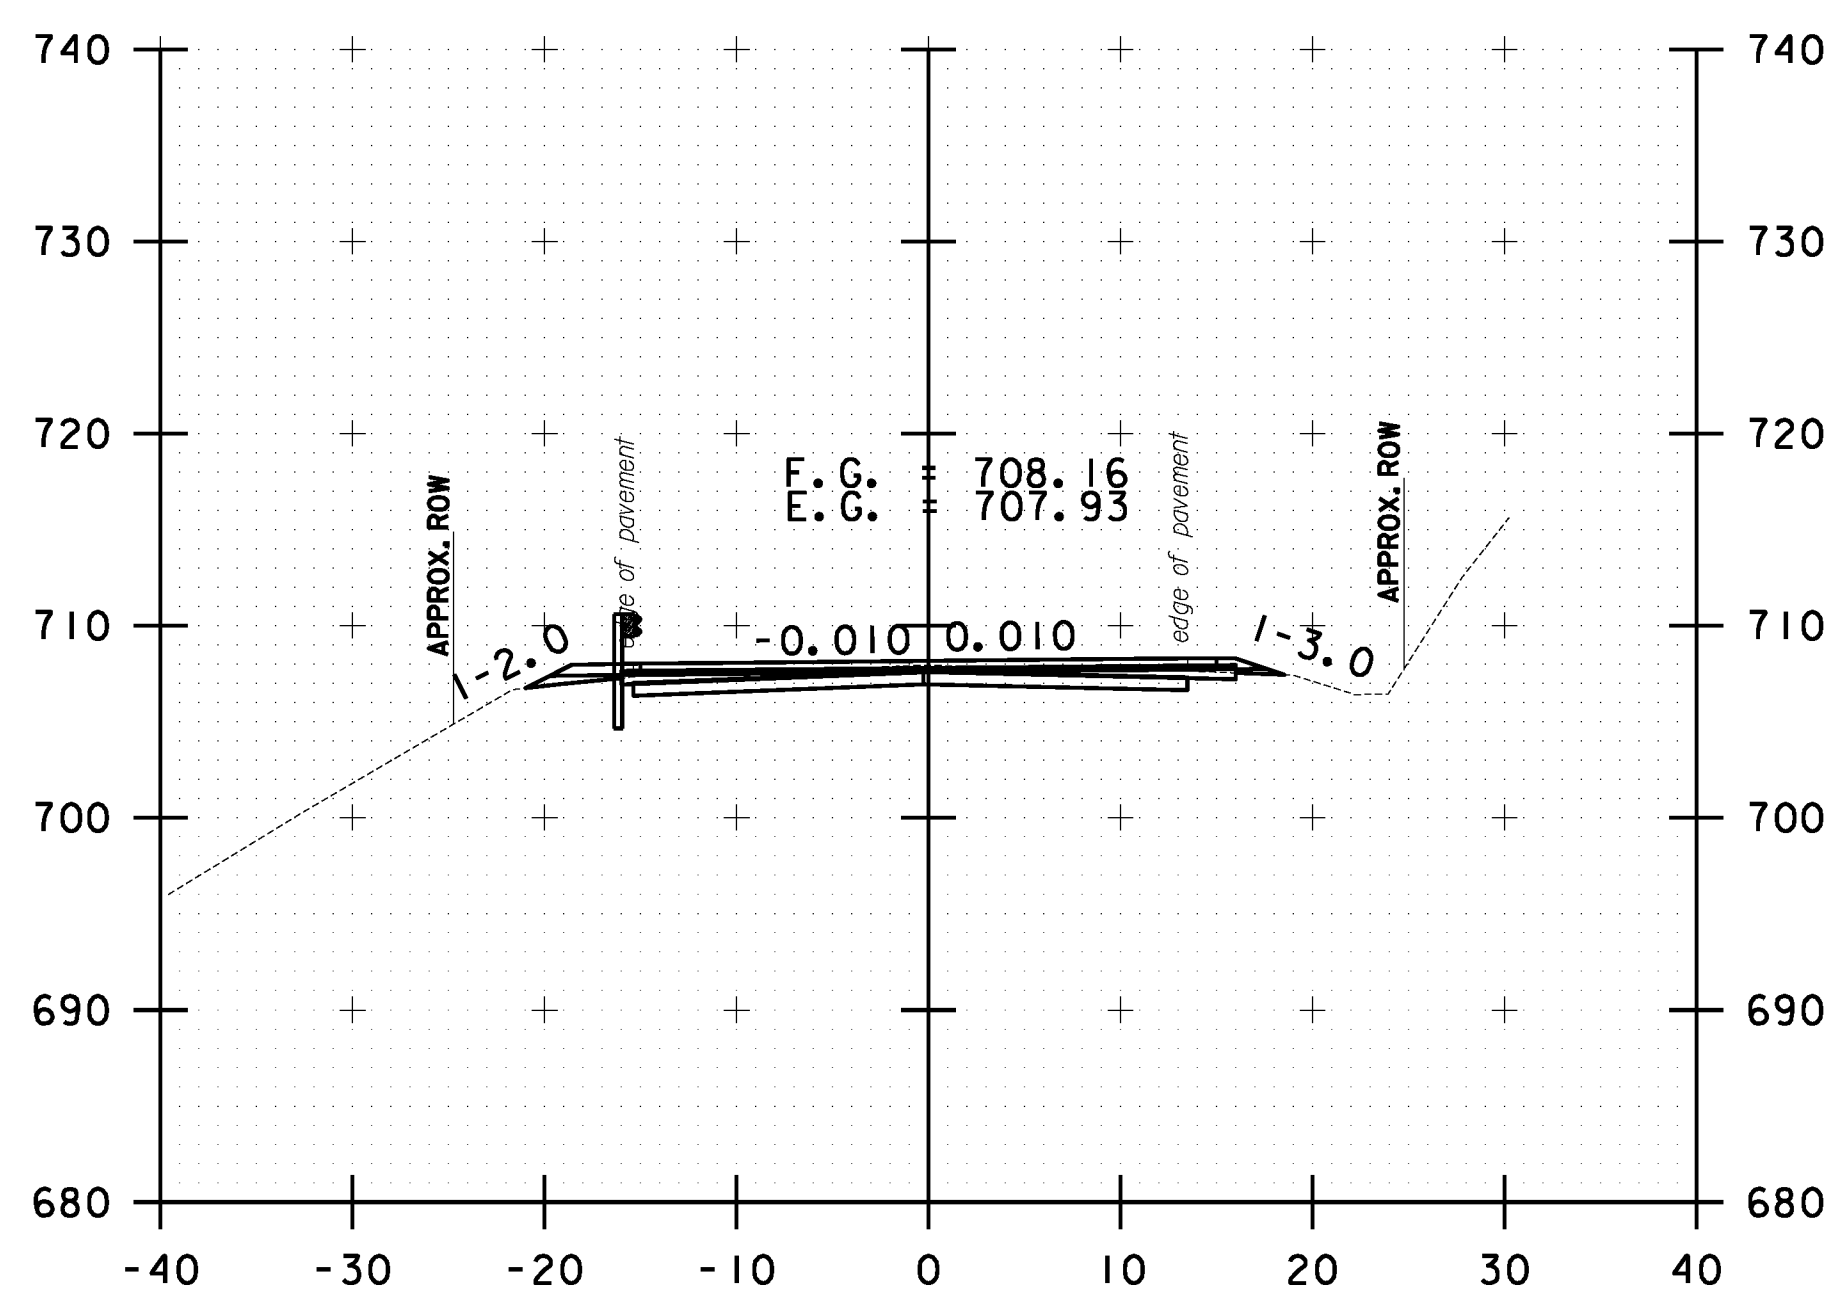

102+50.00

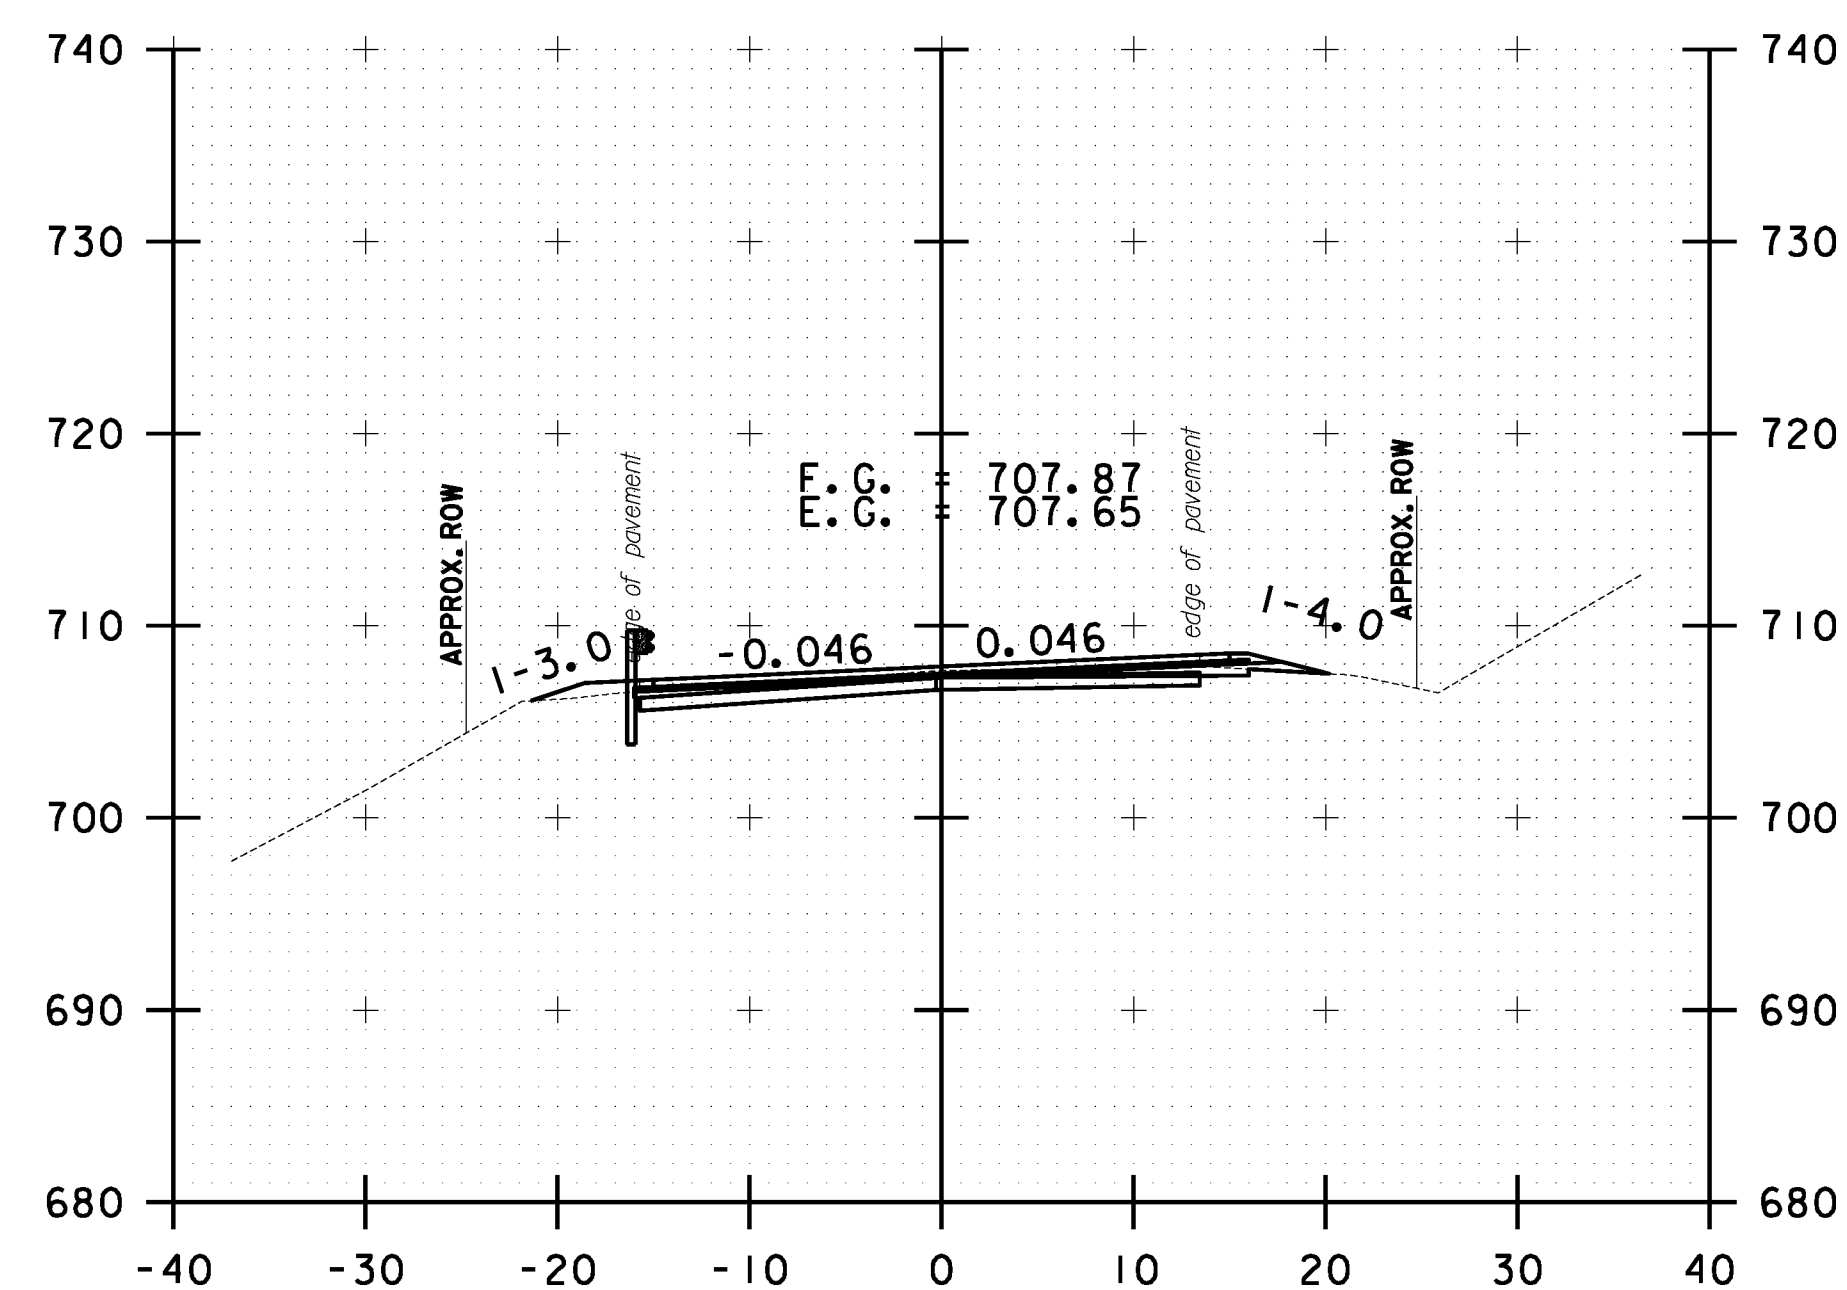

103+50.00

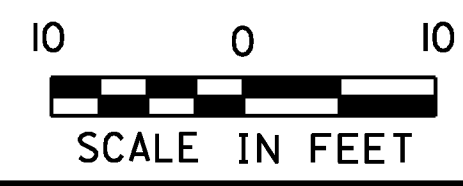

STOCKBRIDGE CROSS SECTION SHEET #34	PROJECT NAME: STOCKBRIDGE-BETHEL
	PROJECT NUMBER: STP 2910(1)
	FILE NAME: z10b214_stock.nc.dgn
	PLOT DATE: 3/17/2014
DESIGNED BY: L.M.B.	DRAWN BY: W.C.P.
IPARM FILE: z10b214xs34.1	CHECKED BY: J.P.S.
	SHEET 247 OF 397