




FILE NAME = Y:\P\c\10b214\10b214.dgn
 DATE/TIME = 3/17/2014
 USER = 4916

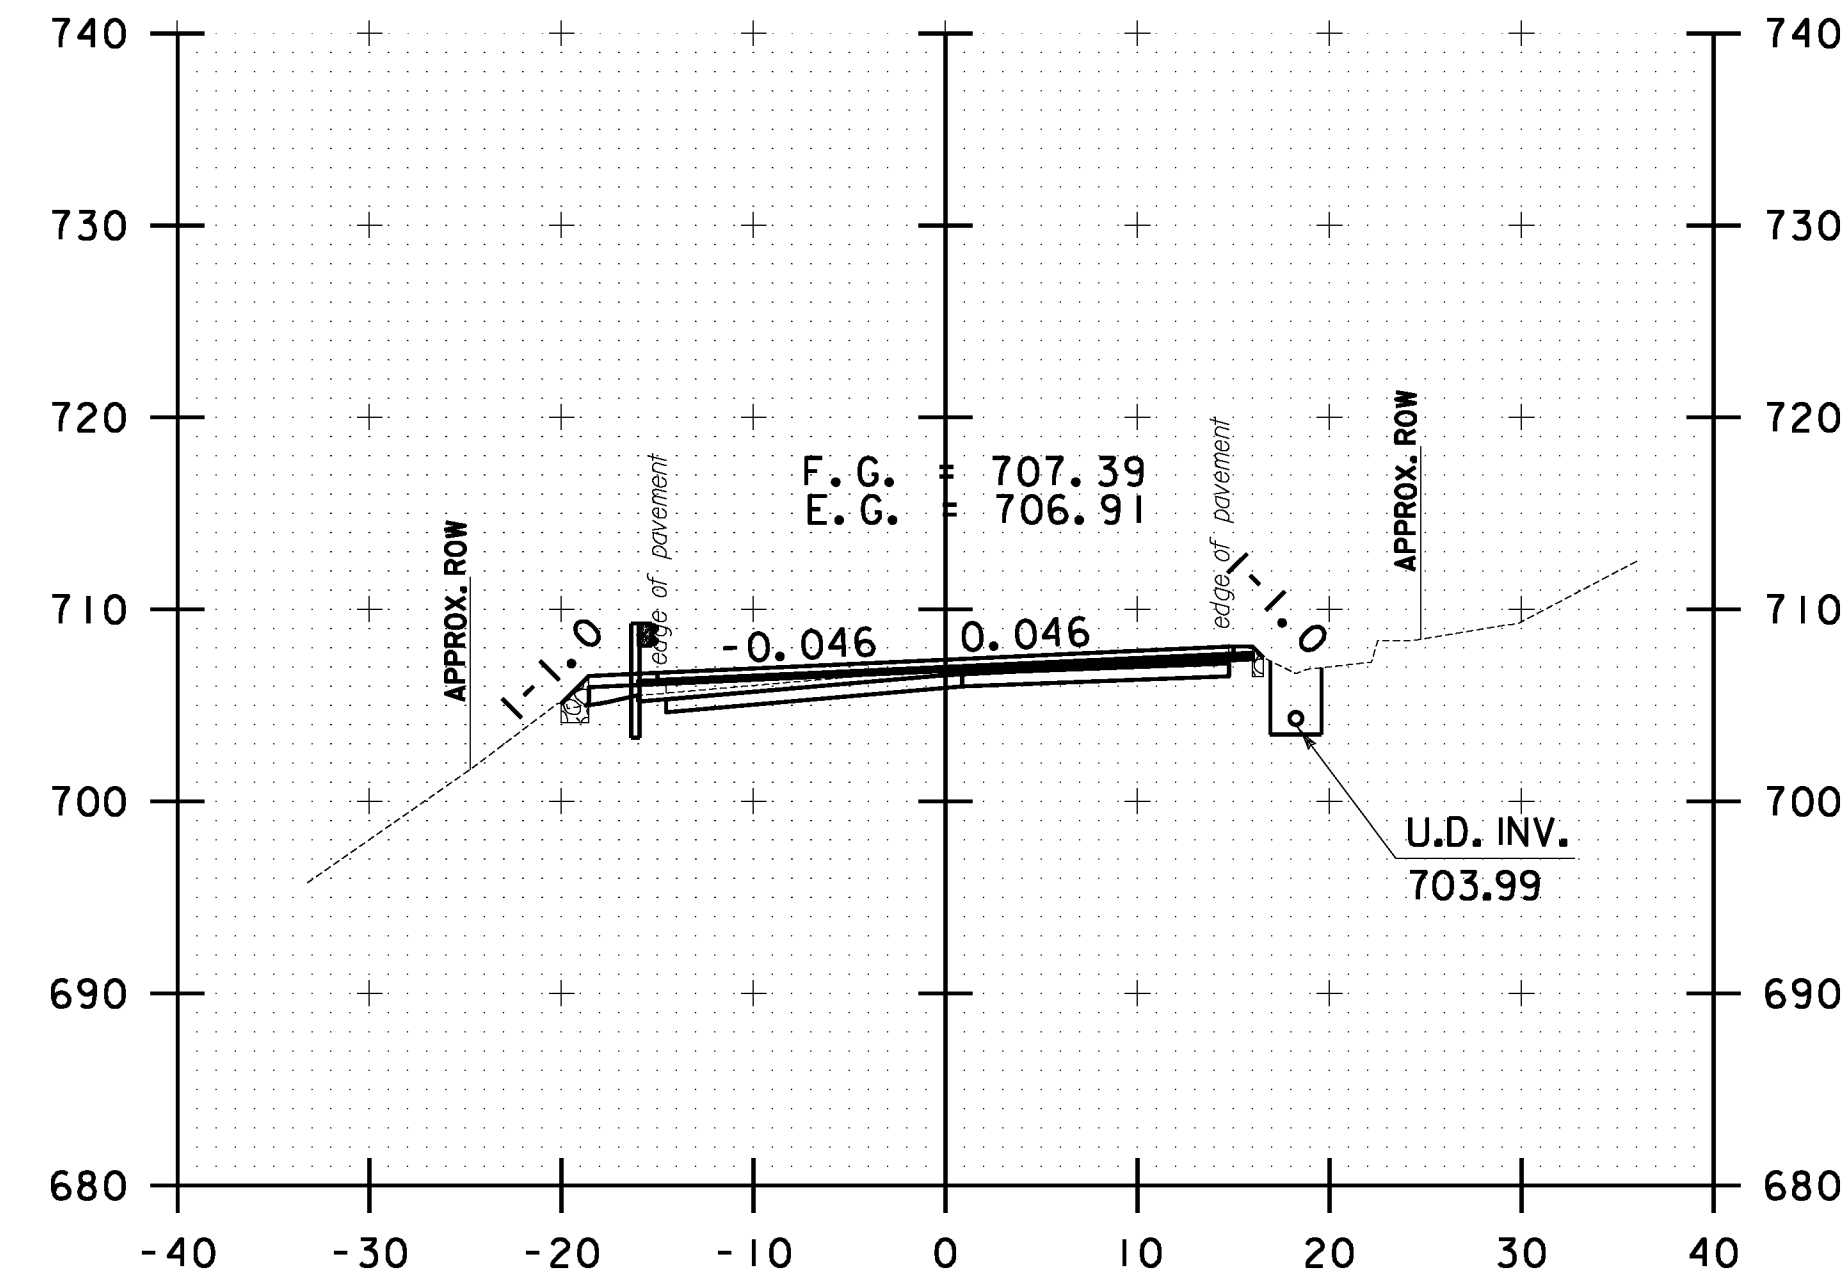


105+00.00

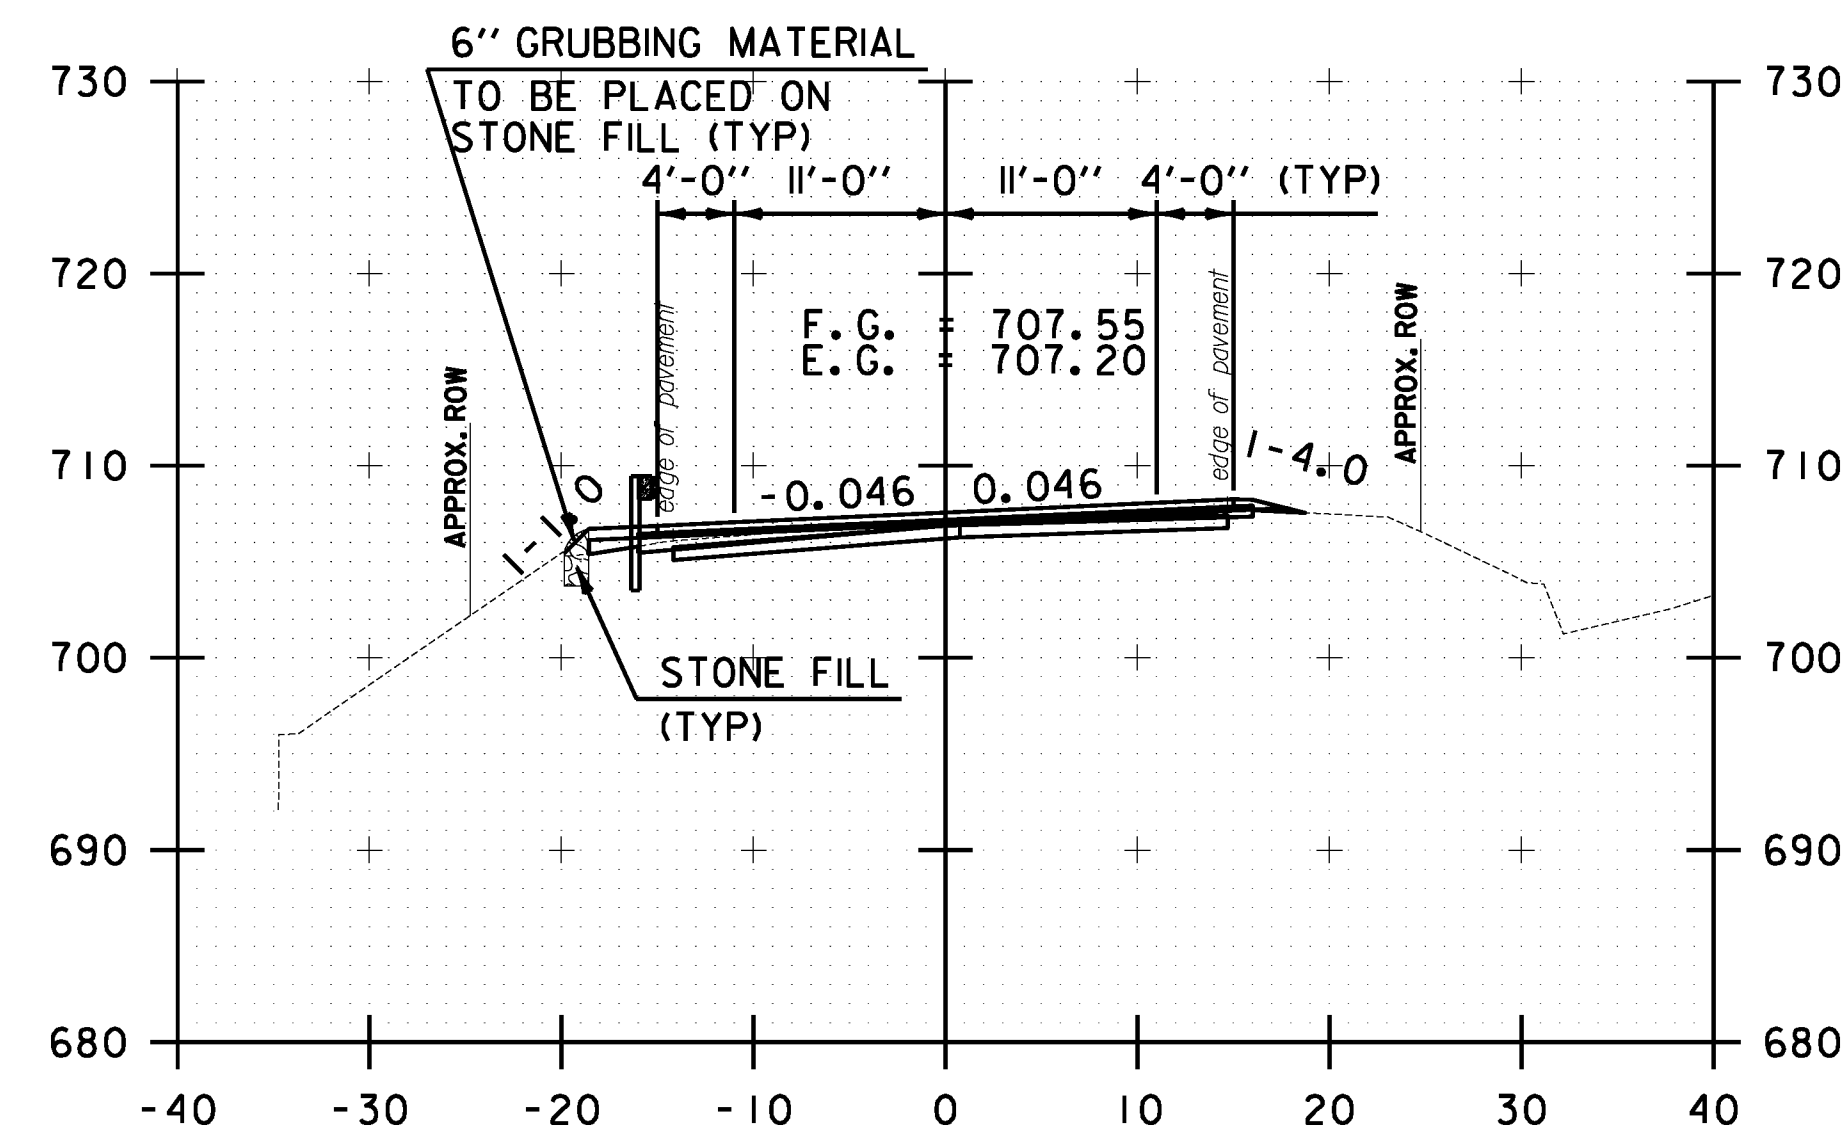


104+50.00

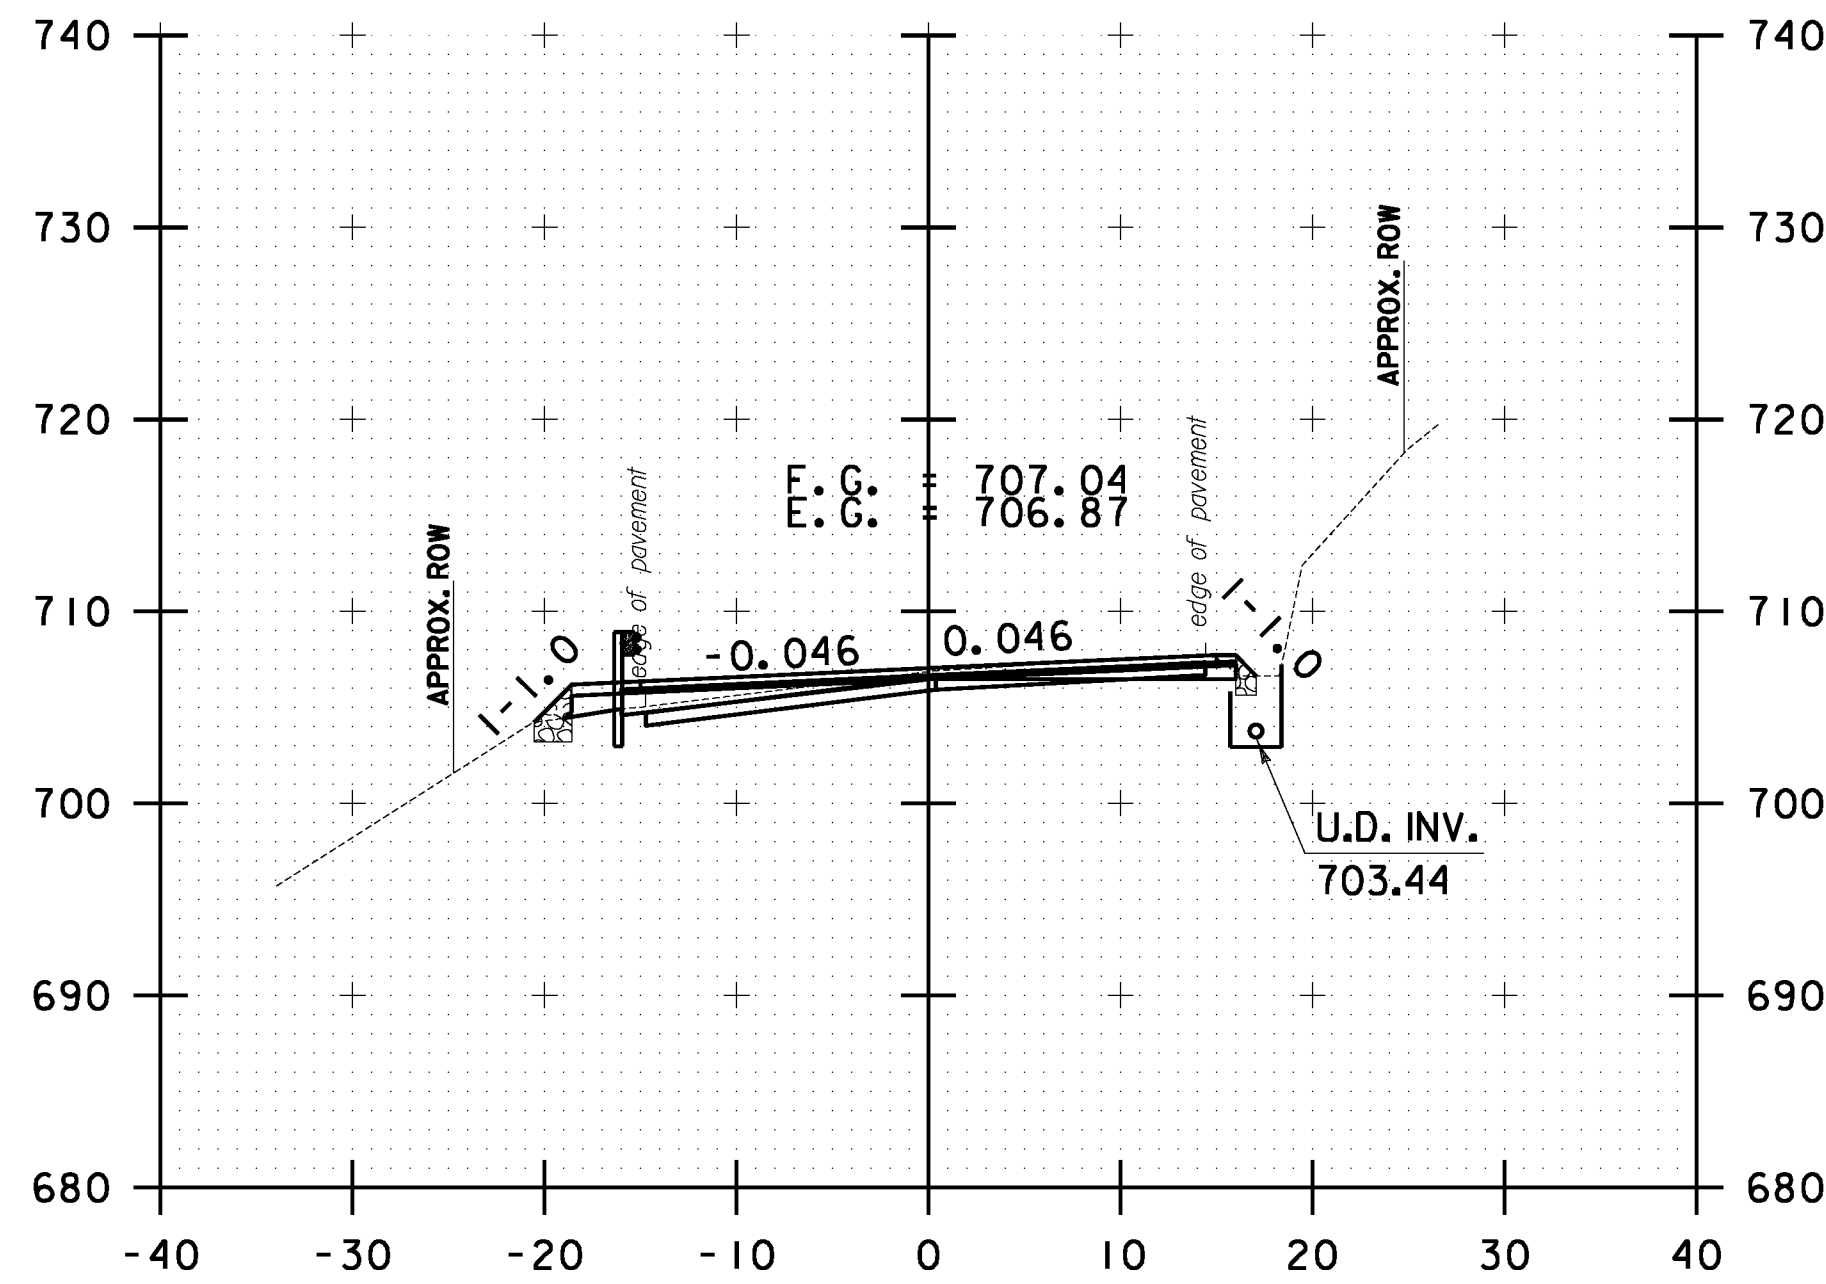


106+00.00

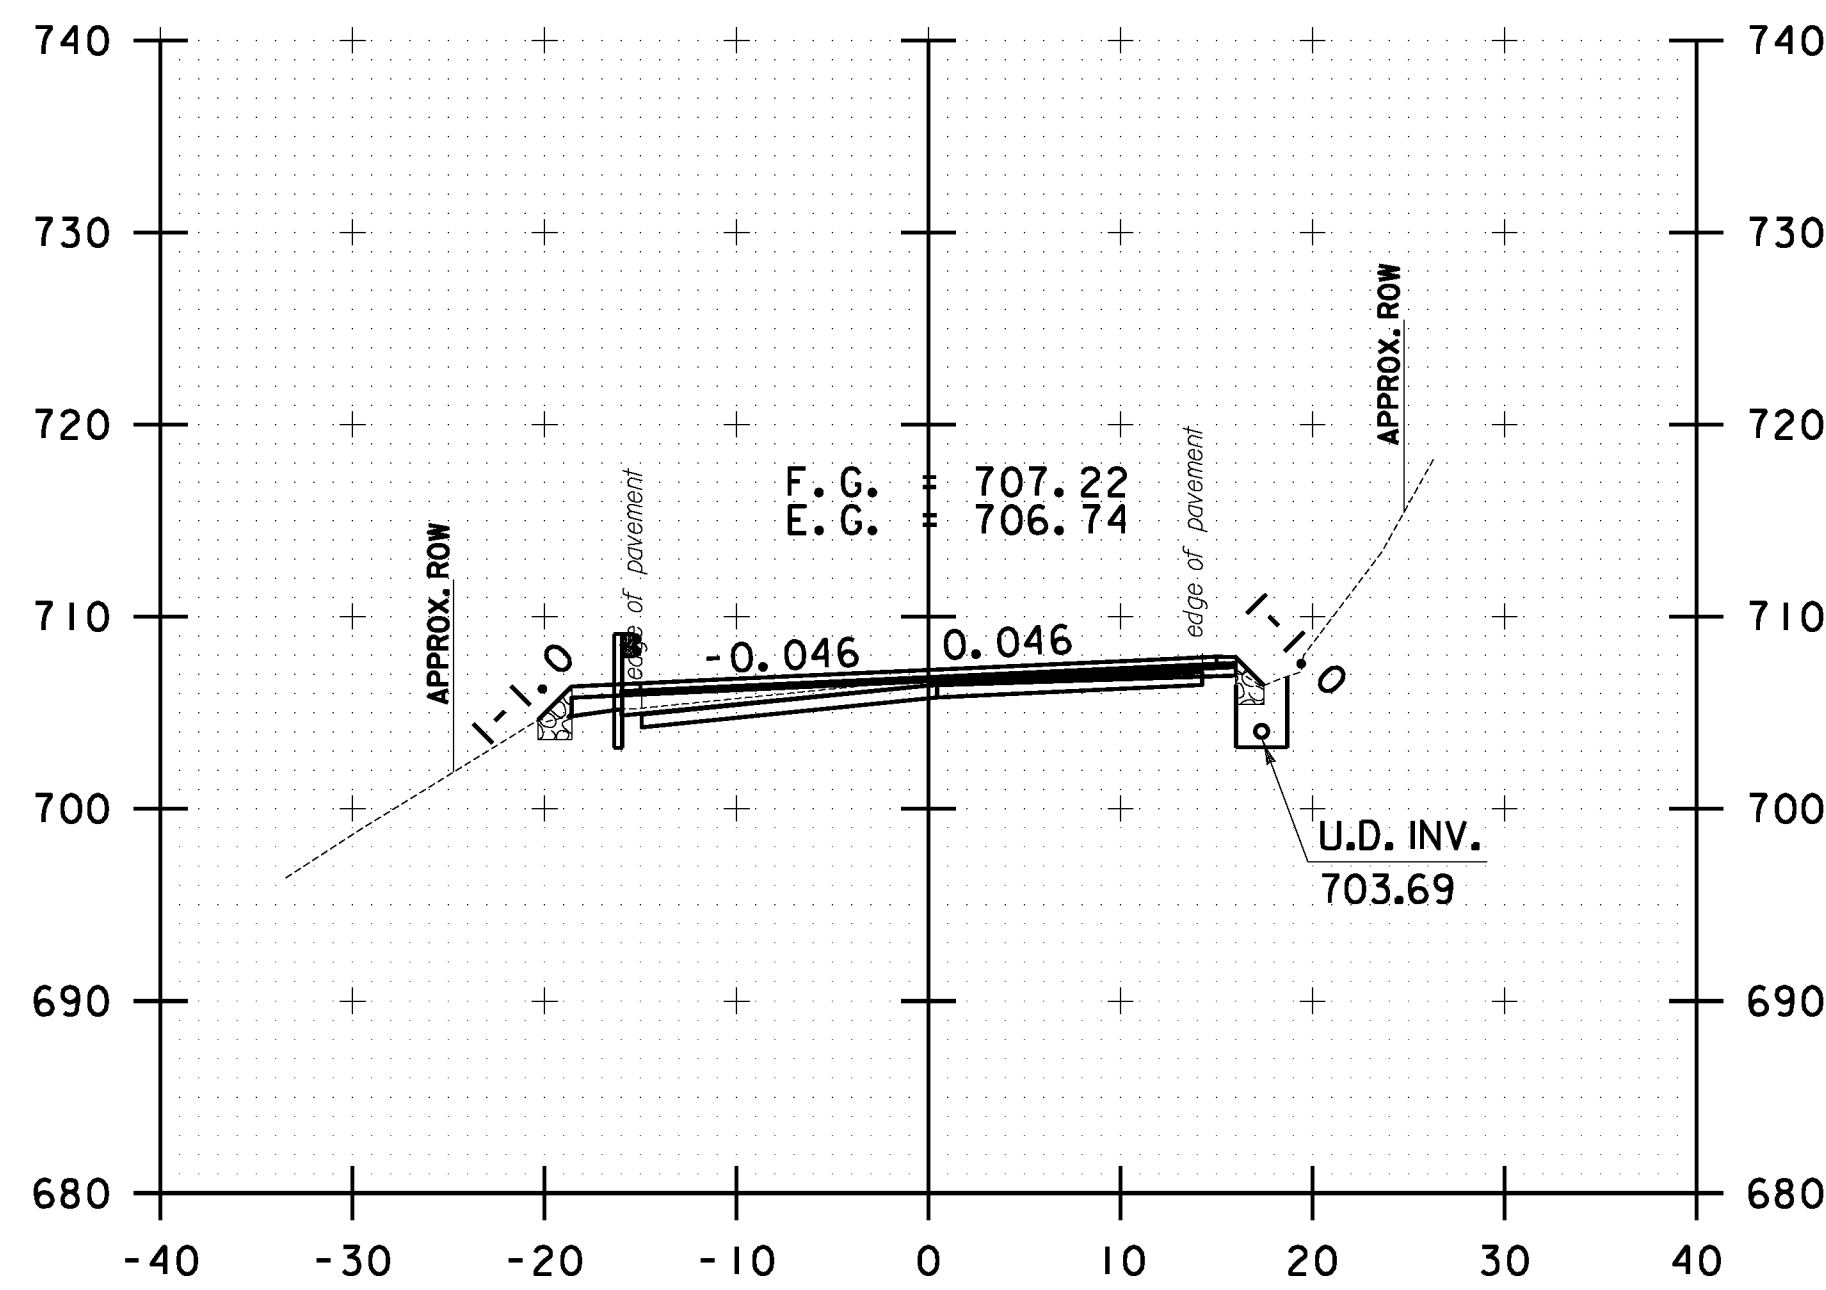


105+50.00

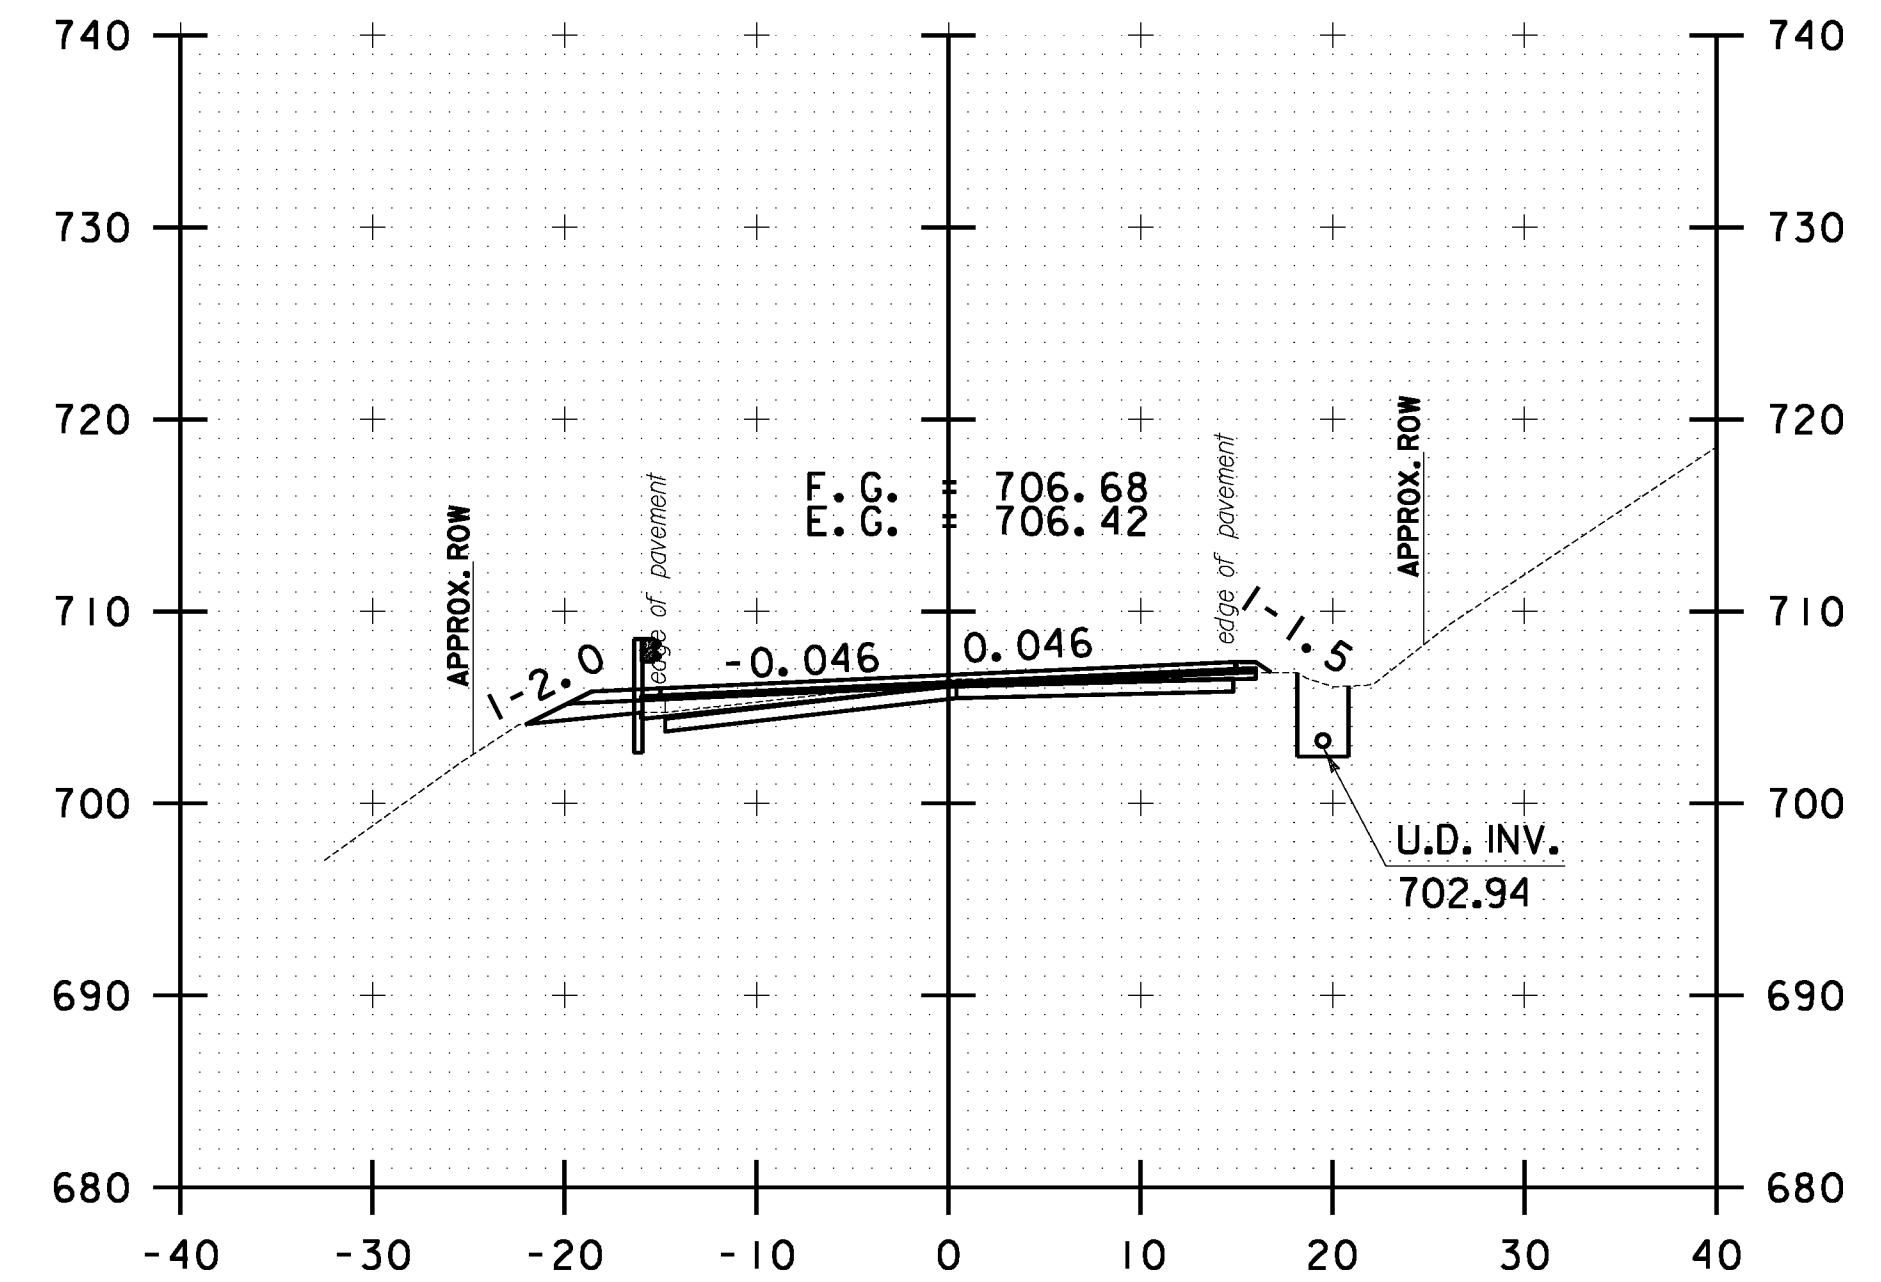

107+00.00

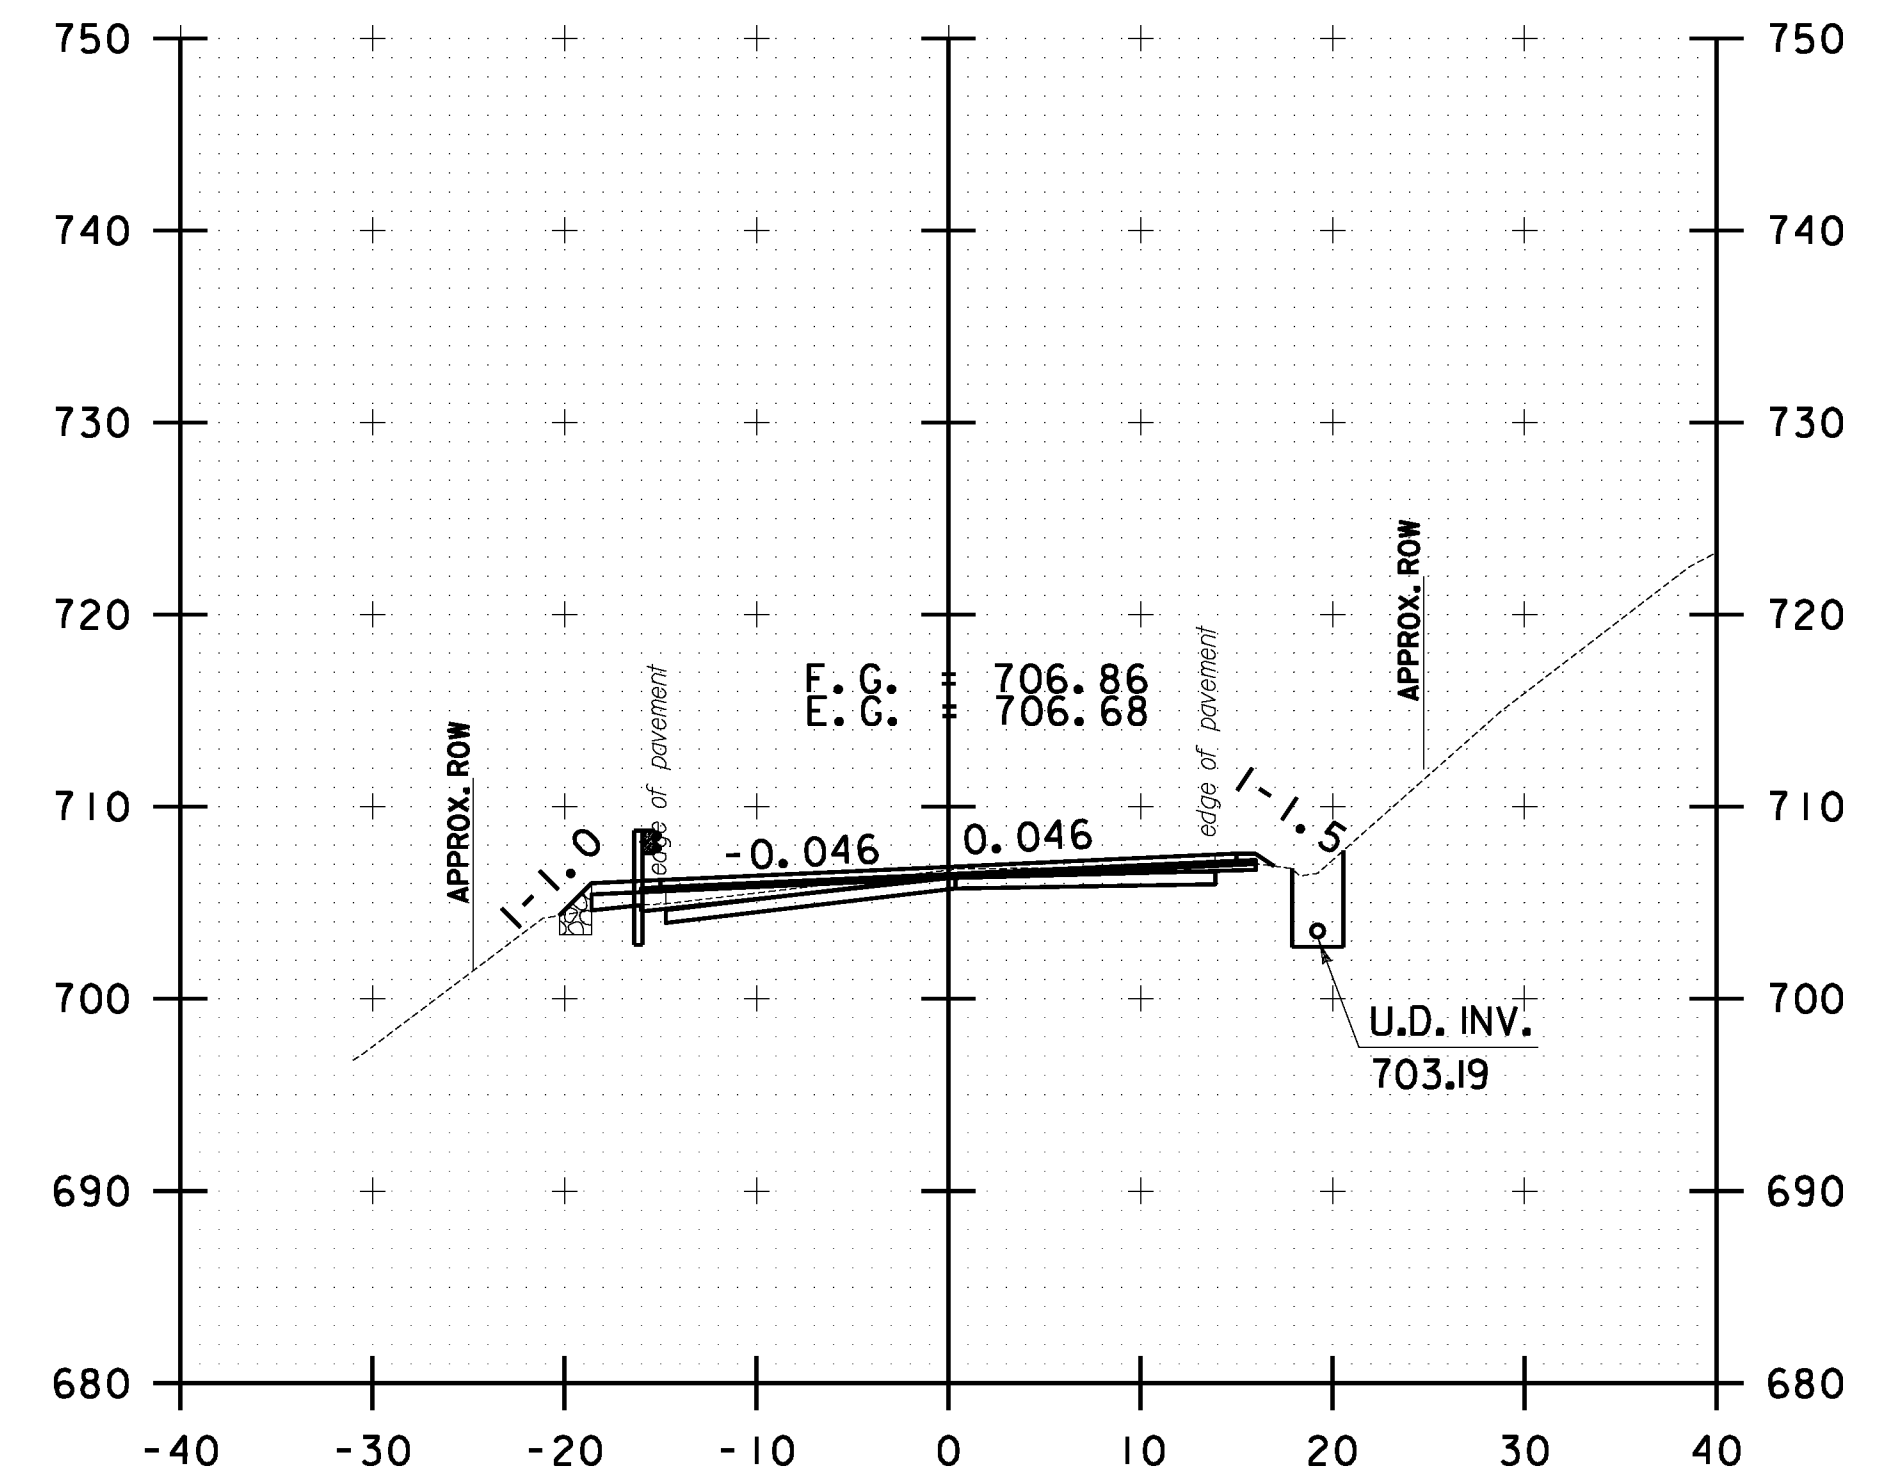

106+50.00

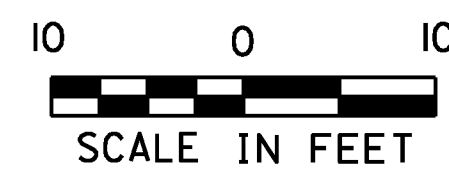

STOCKBRIDGE CROSS SECTION SHEET #35	PROJECT NAME: STOCKBRIDGE-BETHEL
	PROJECT NUMBER: STP 2910(1)
	FILE NAME: z10b214.stock.xc.dgn
	IPARM FILE: z10b214xs35.1
	PLOT DATE: 3/17/2014
	DRAWN BY: W.G.P.
	CHECKED BY: J.P.S.
	SHEET 248 OF 397