




FILE NAME = V:\P\c\ass\ANY\K2\22425\CADD\MSTN\10b214_stock.nc.dgn
 DATE/TIME = 3/17/2014
 USER = 4916

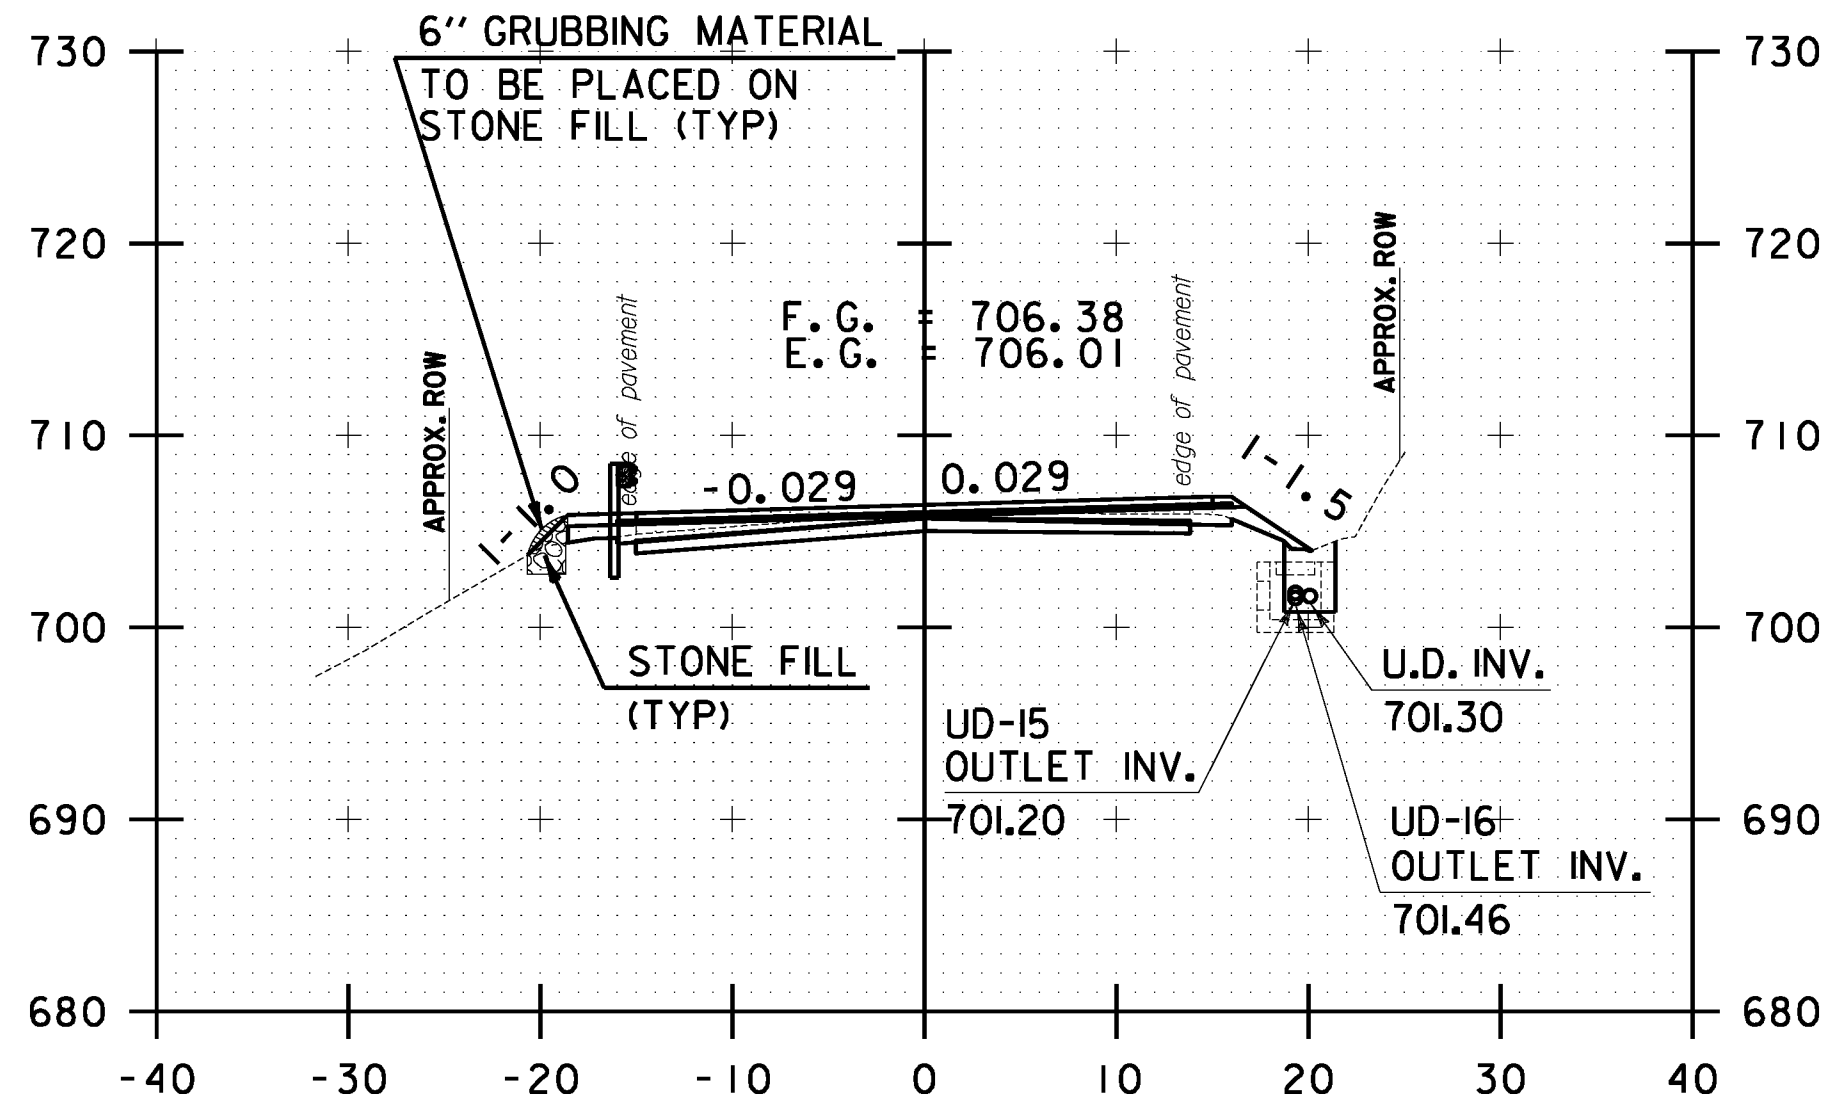


108+00.00

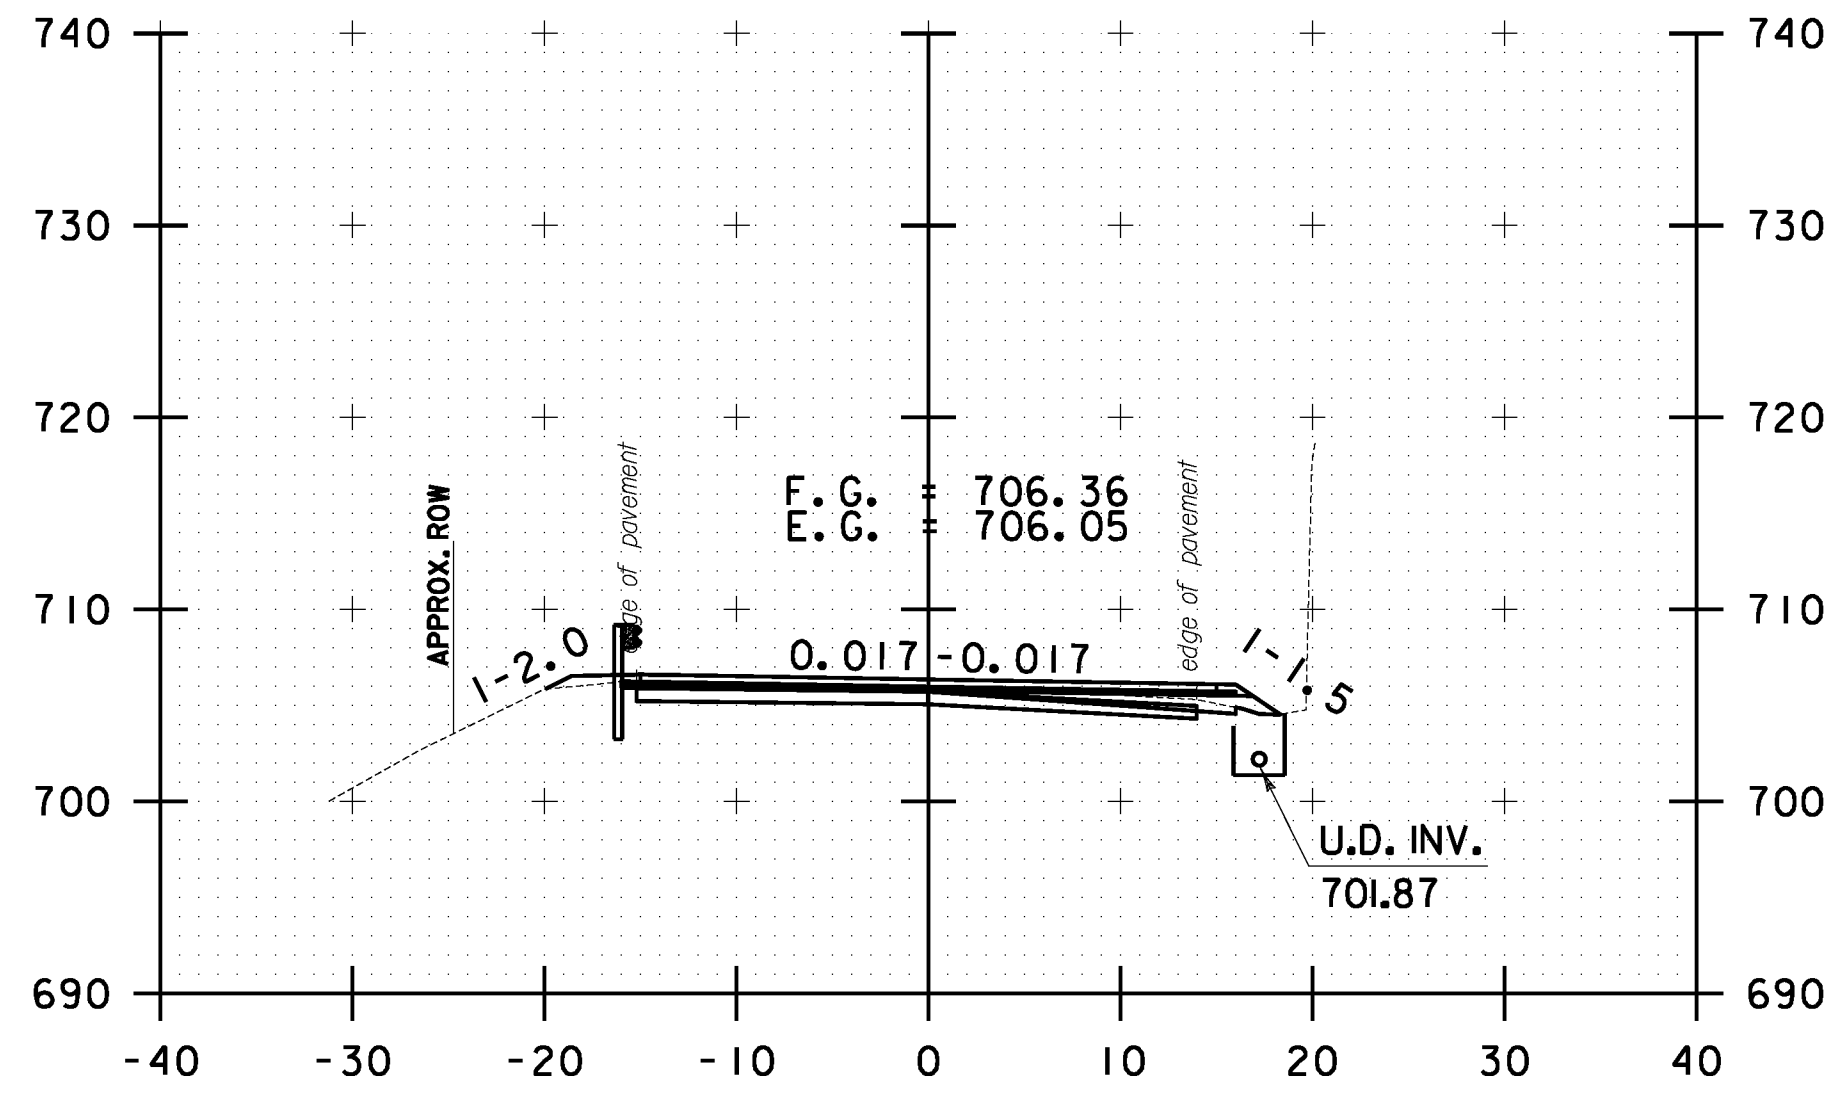


109+00.00

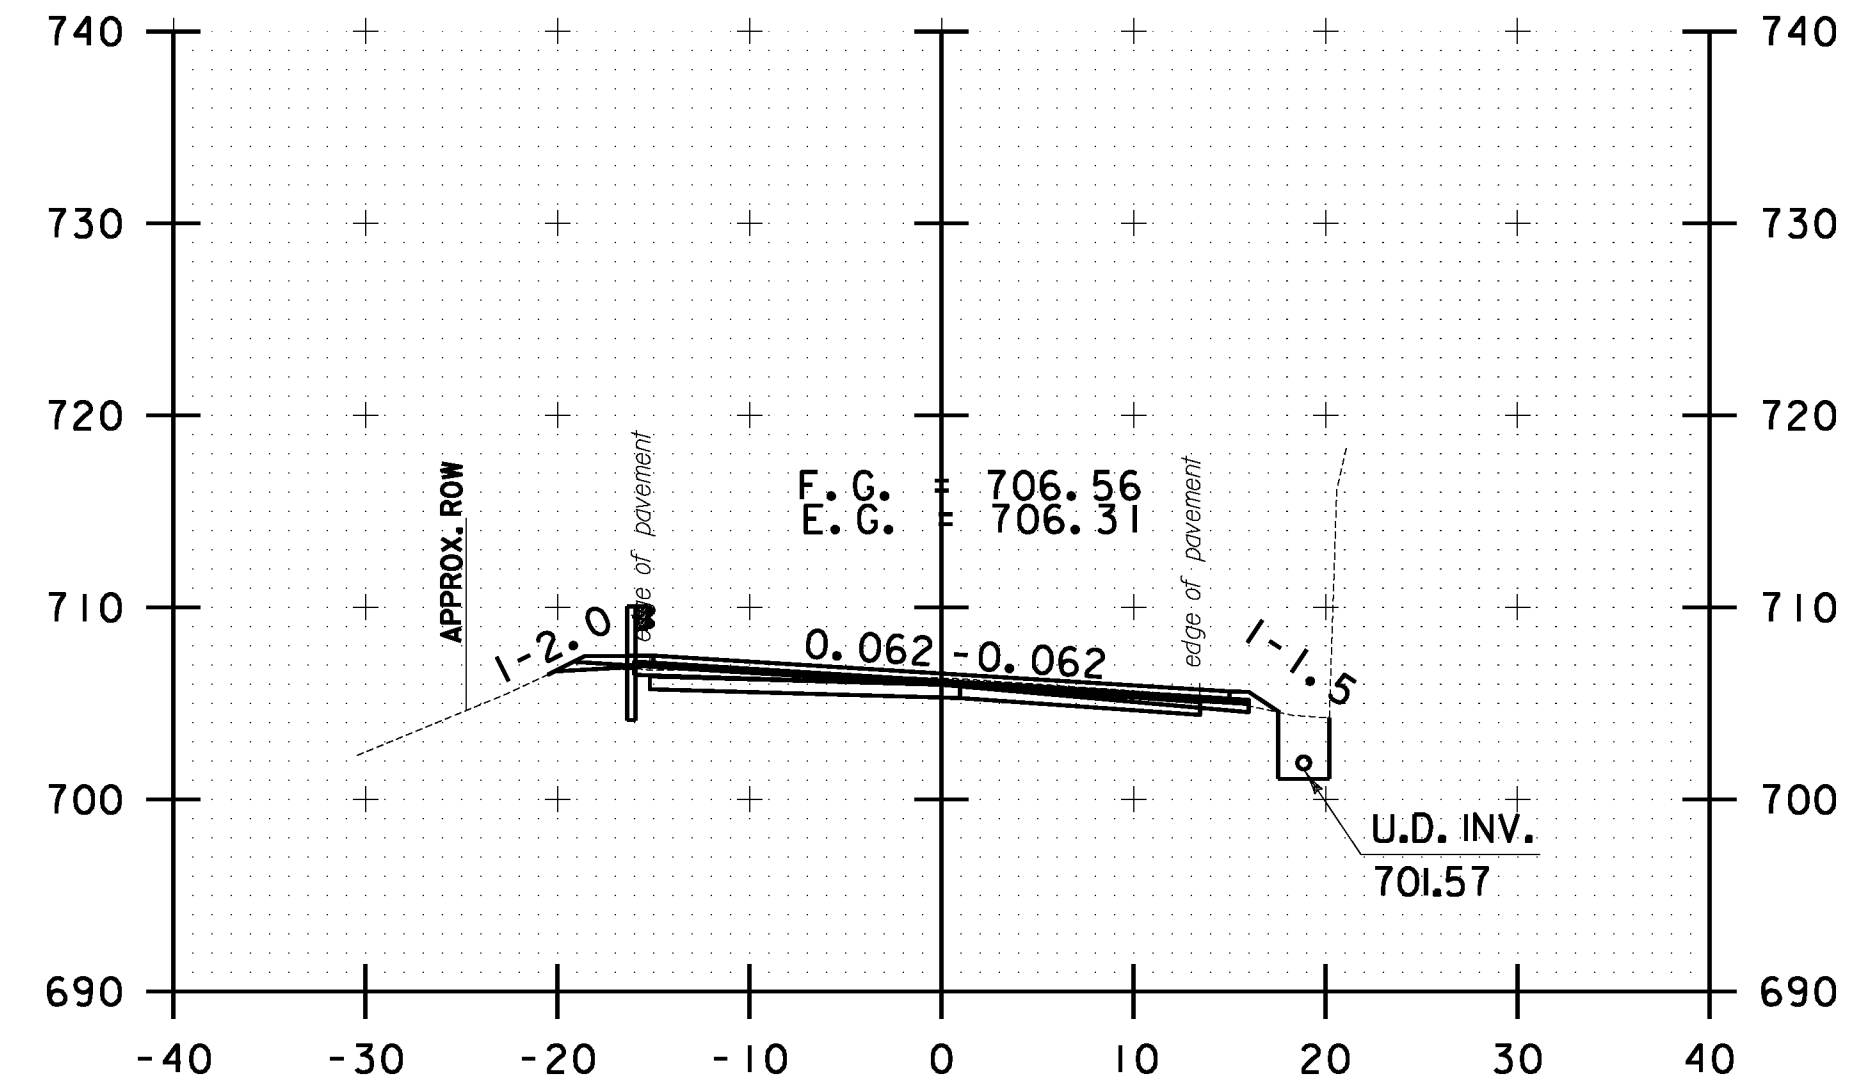


110+00.00

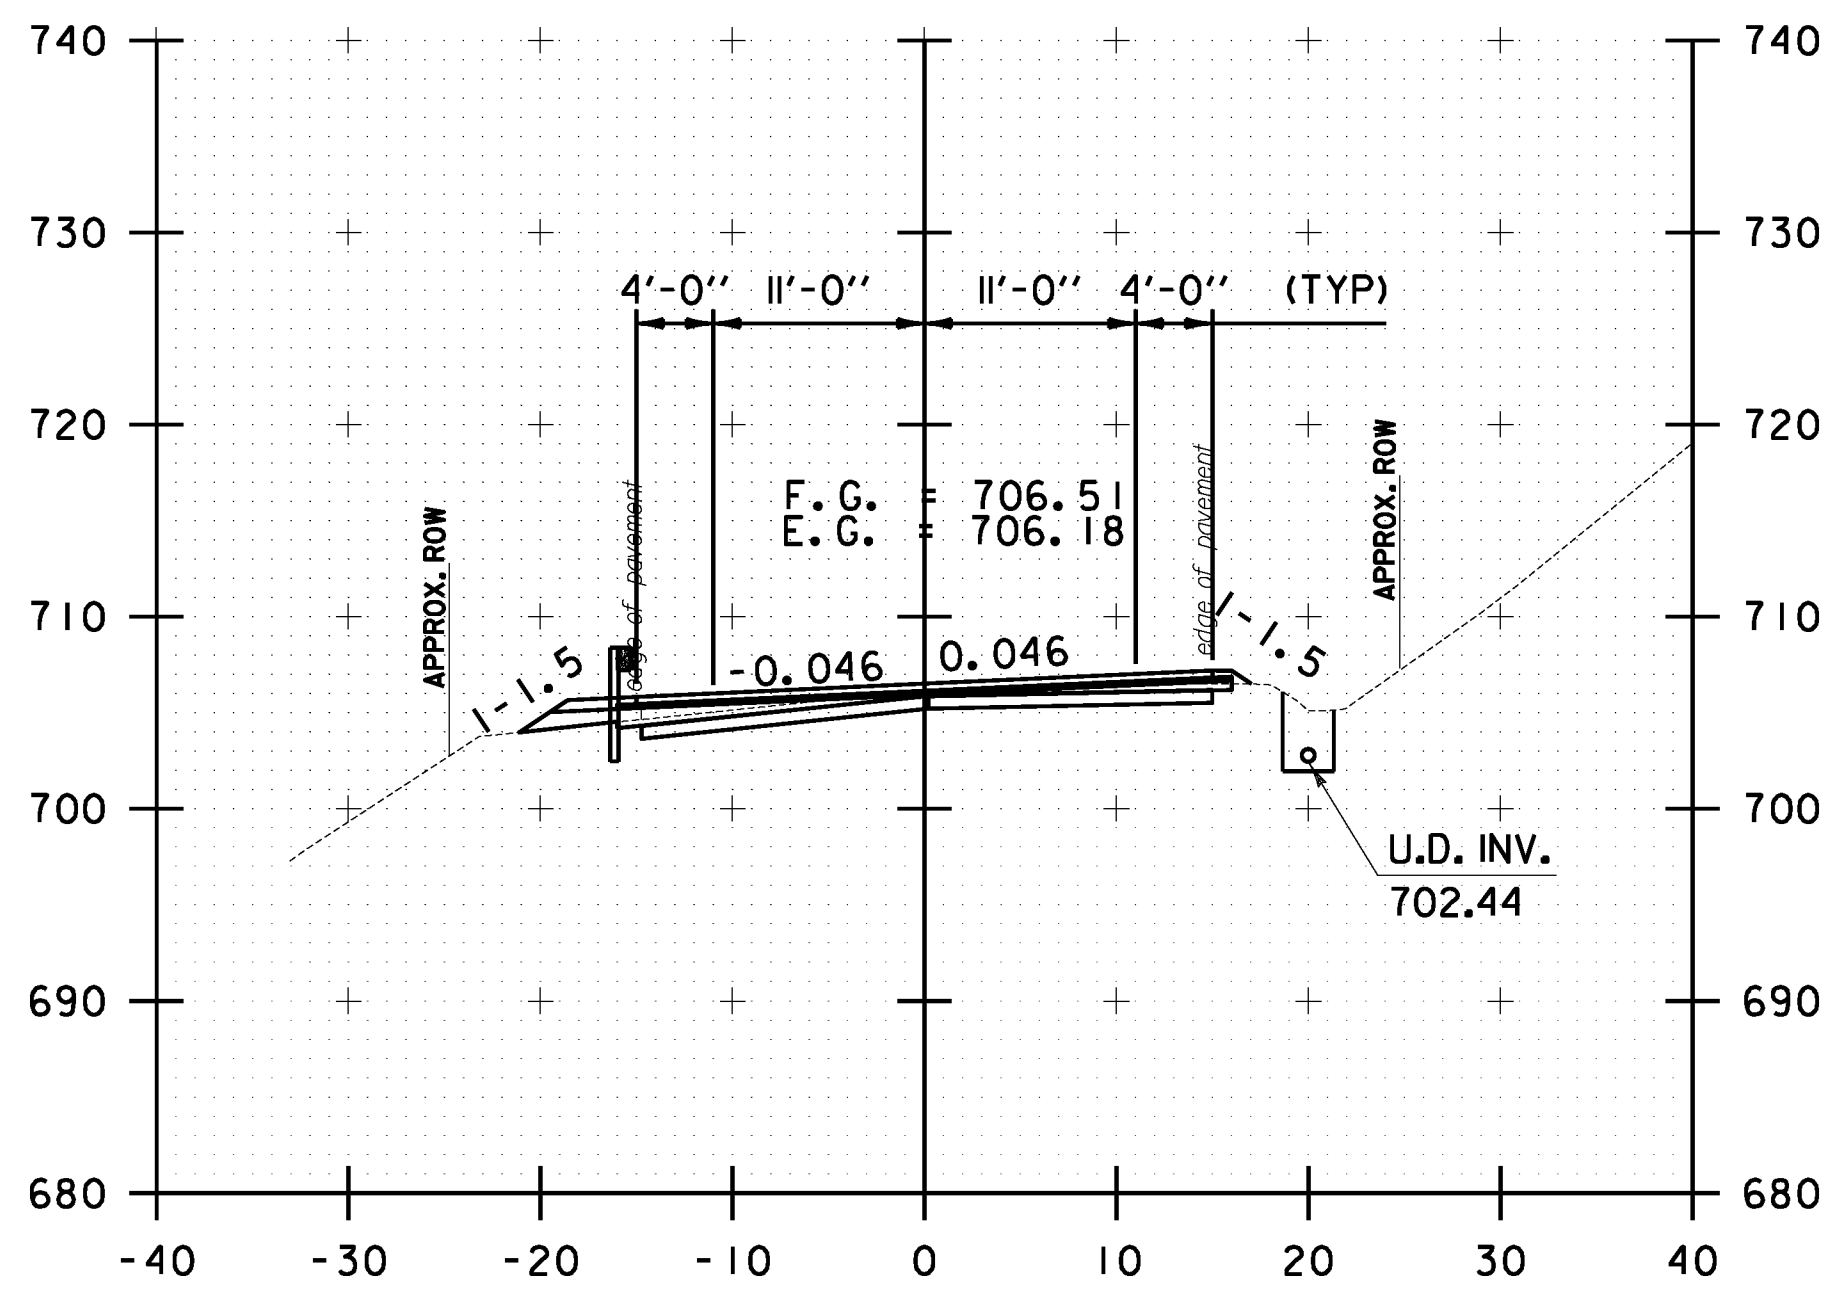


107+50.00

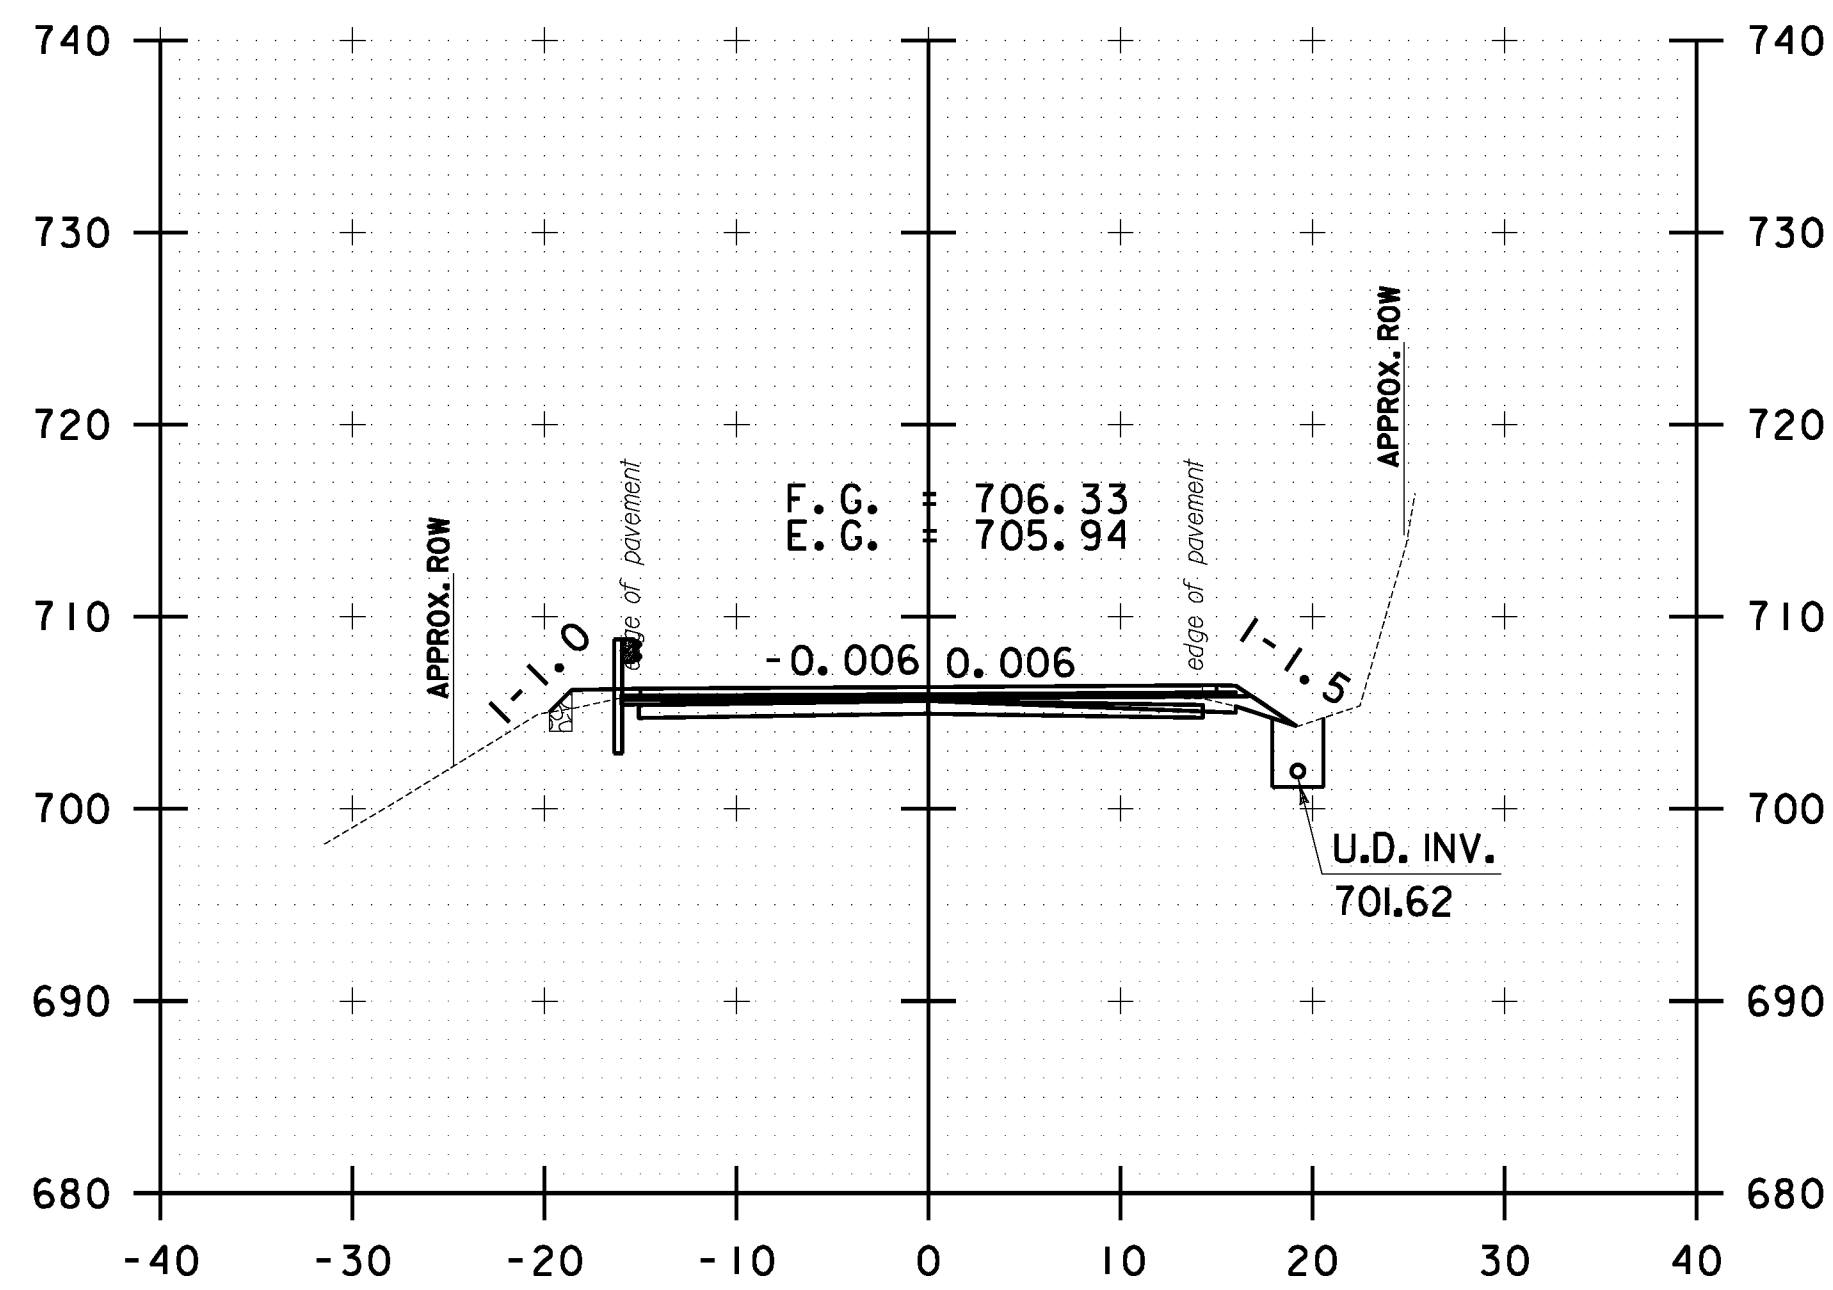

108+50.00

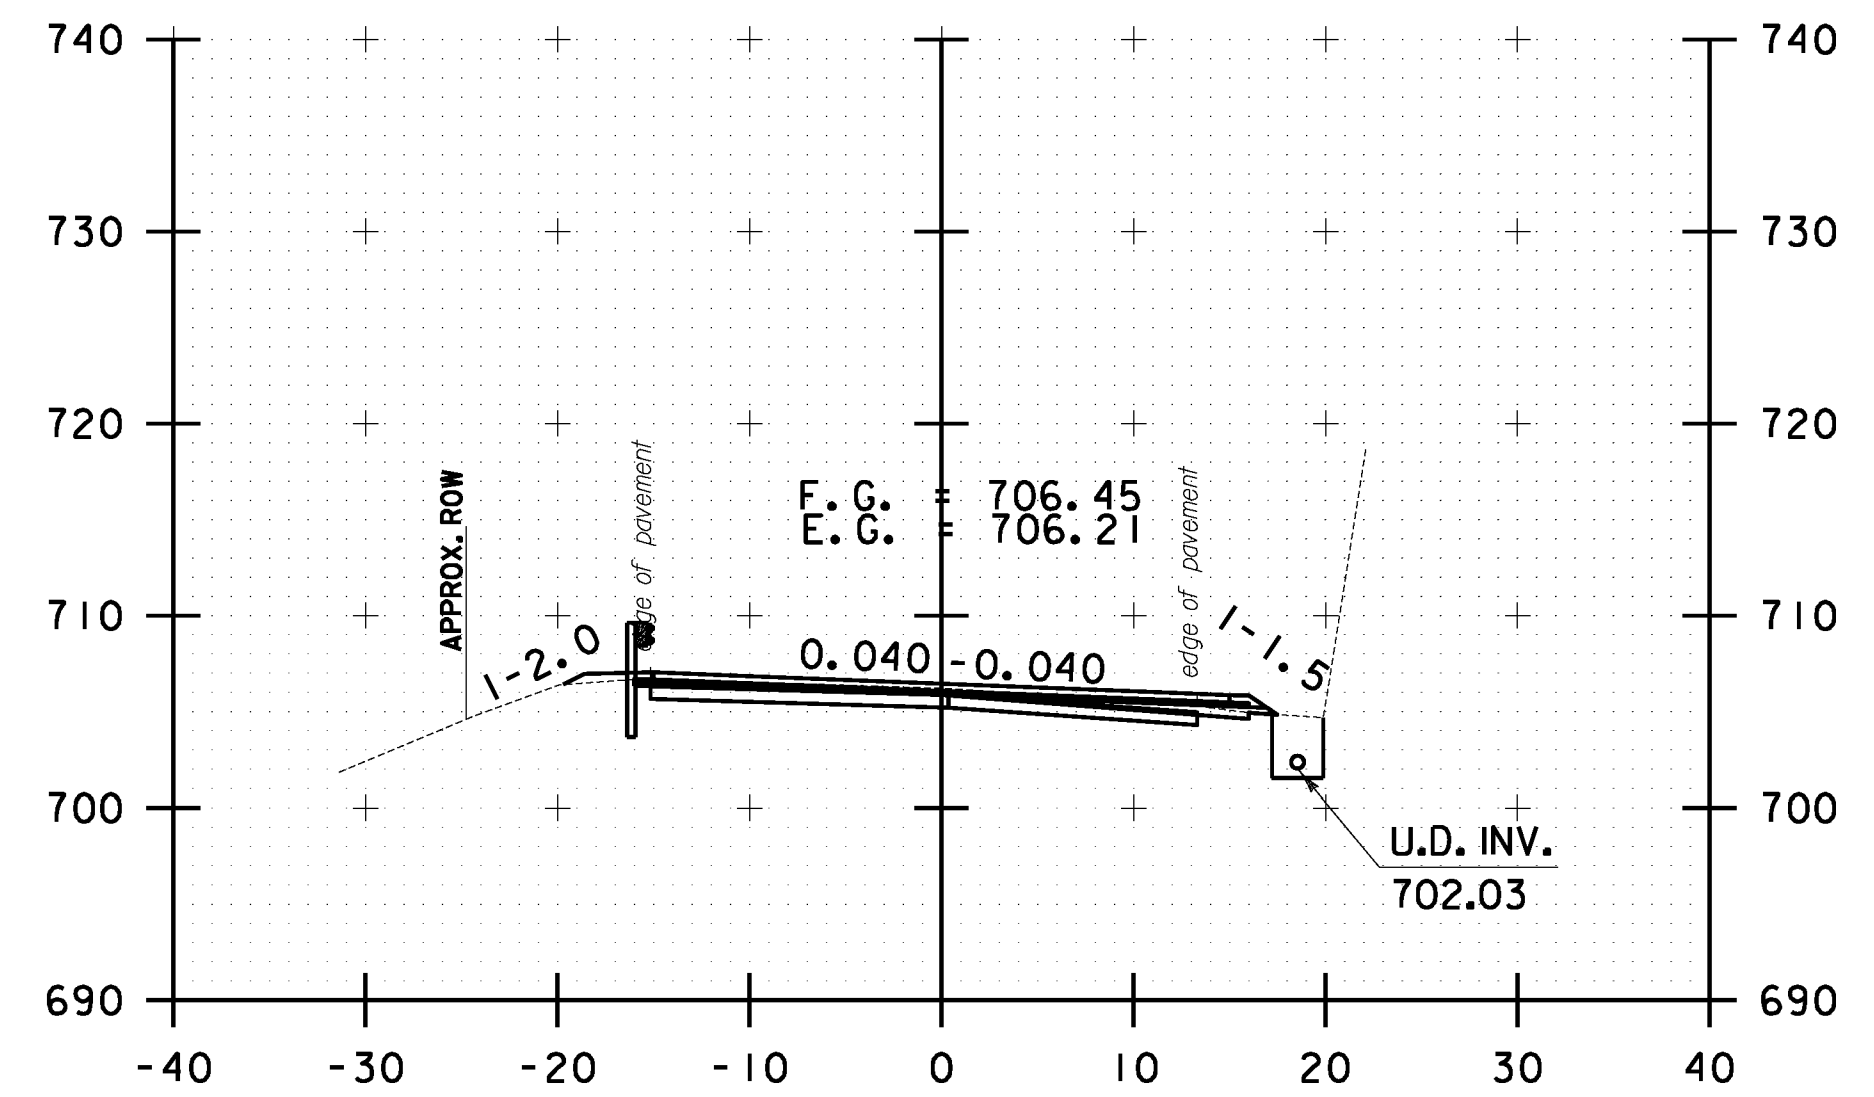

109+50.00

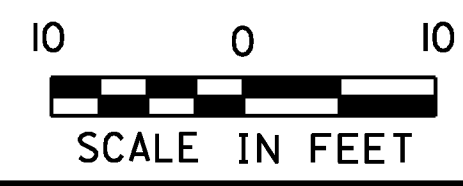

**STOCKBRIDGE
 CROSS SECTION
 SHEET #36**

PROJECT NAME: STOCKBRIDGE-BETHEL	
PROJECT NUMBER: STP 2910(I)	
FILE NAME: z10b214_stock.nc.dgn	PLOT DATE: 3/17/2014
PROJECT LEADER: D.E.G.	DRAWN BY: W.G.P.
DESIGNED BY: L.M.B.	CHECKED BY: J.P.S.
IPARM FILE: z10b214xs36.1	SHEET 249 OF 397