




FILE NAME = V:\P\c\ass\ANY\K2\22425\CADD\MSTN\10b214_stock.nc.dgn
 DATE/TIME = 3/17/2014
 USER = 4916

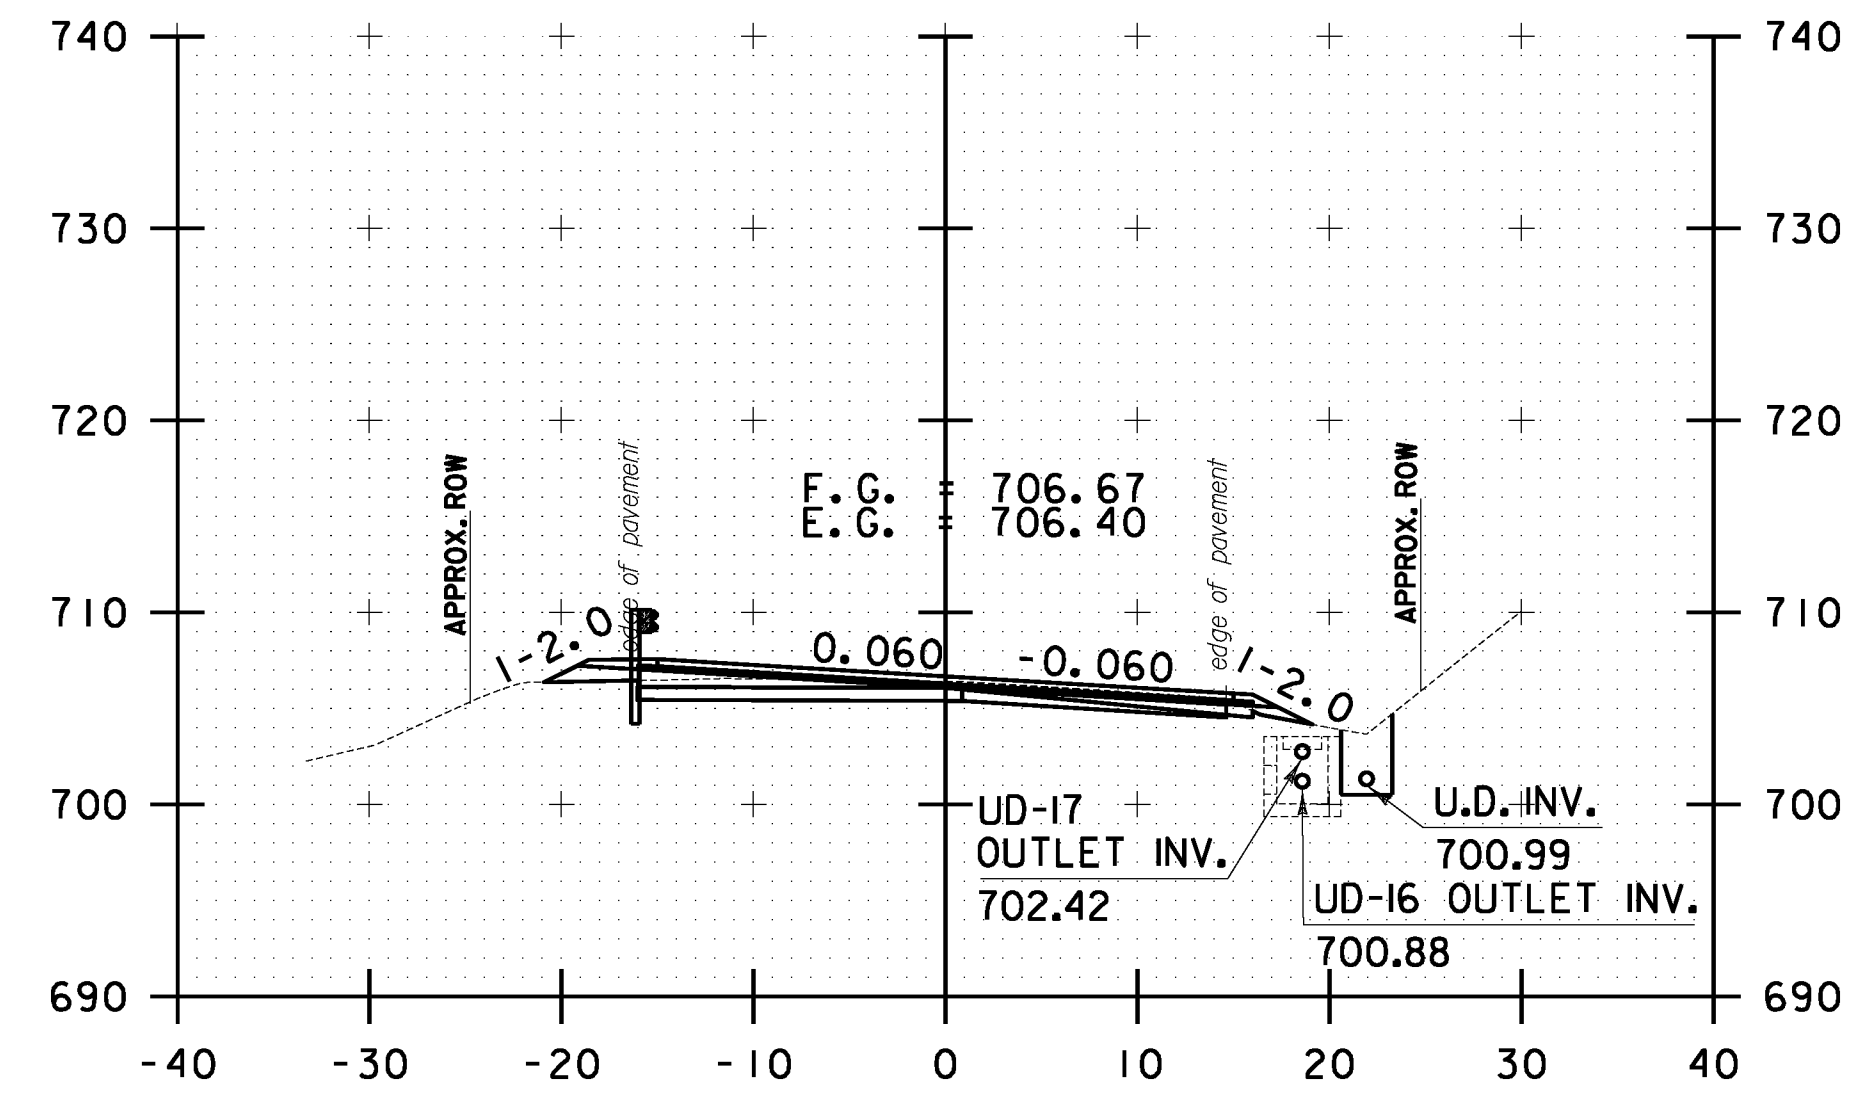


111+00.00

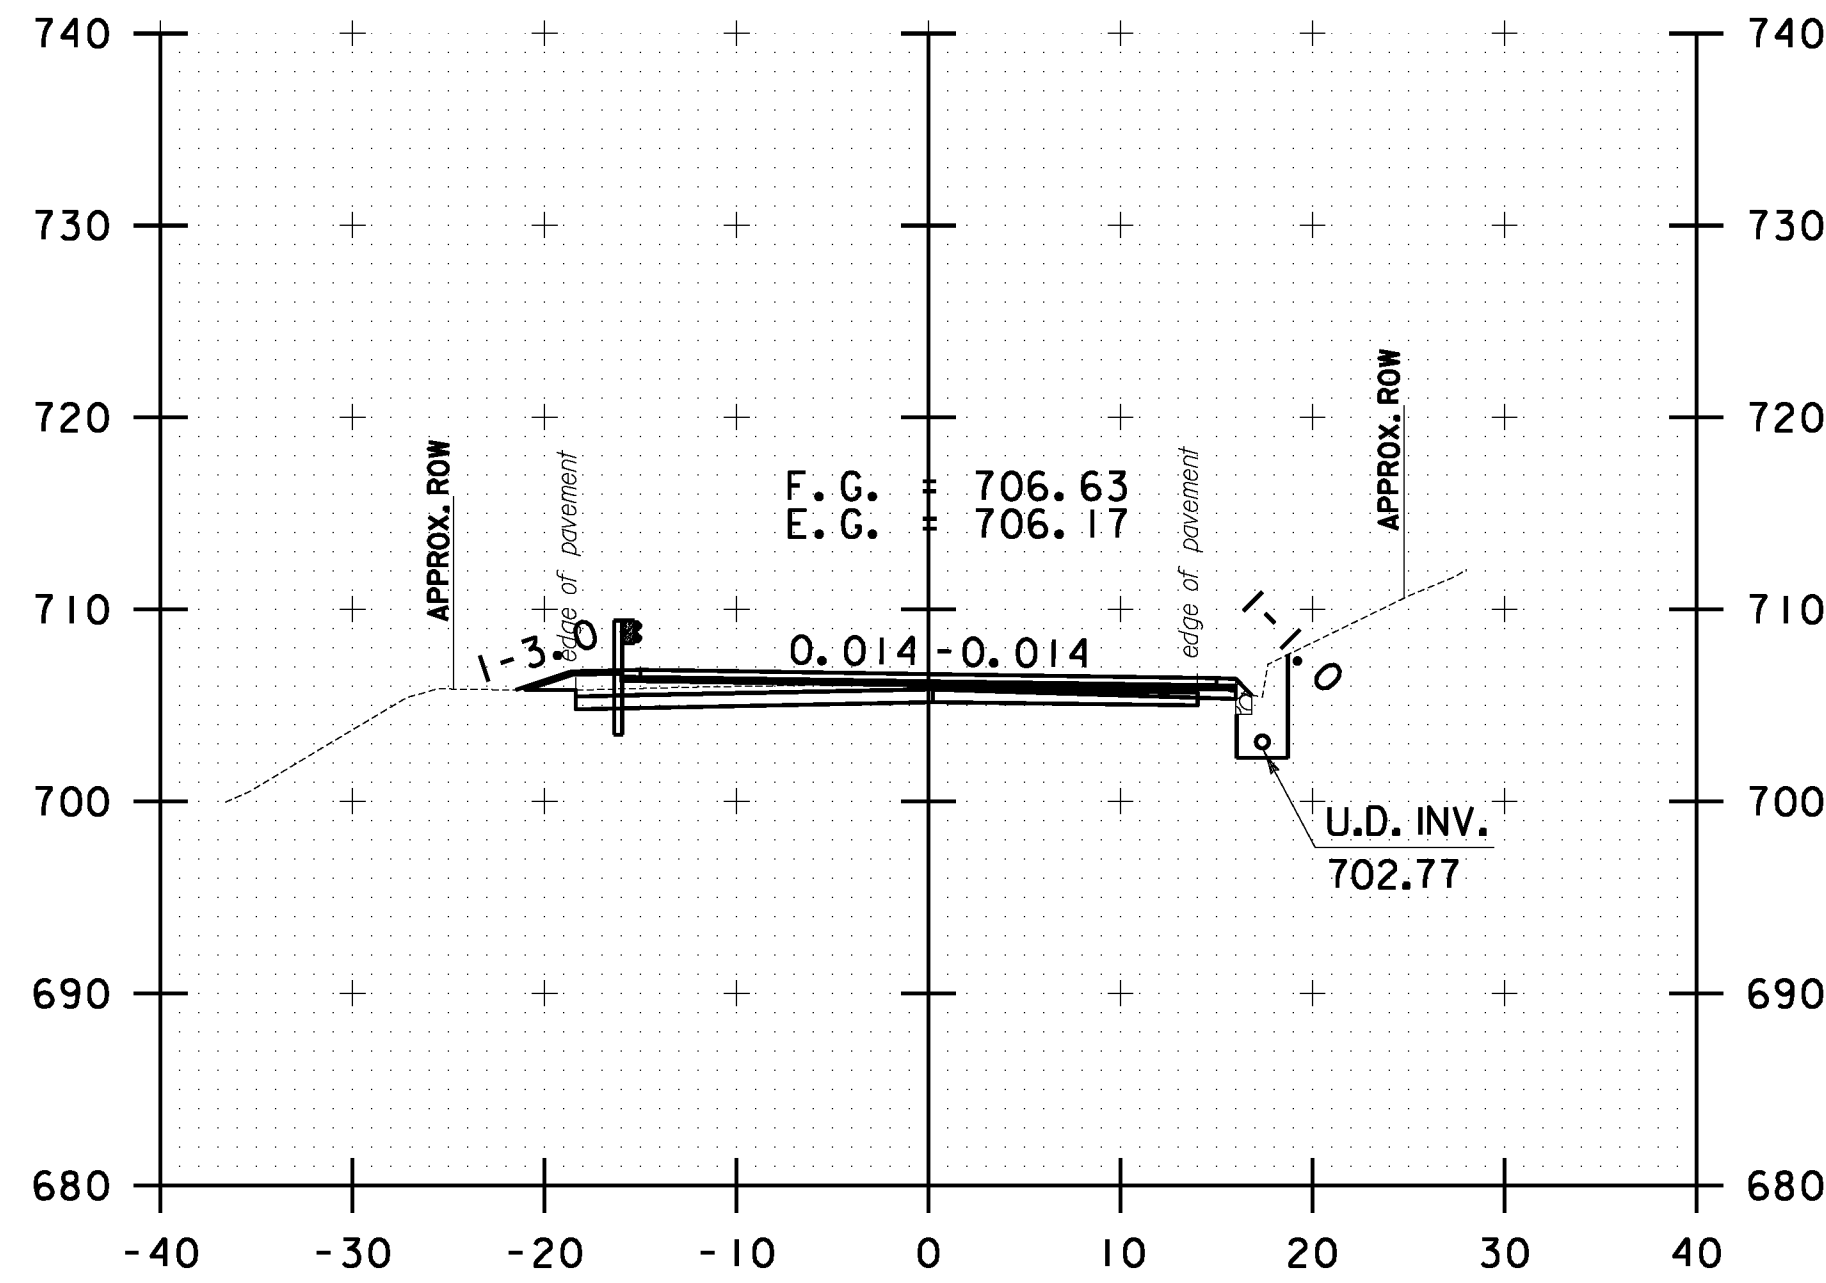


112+00.00

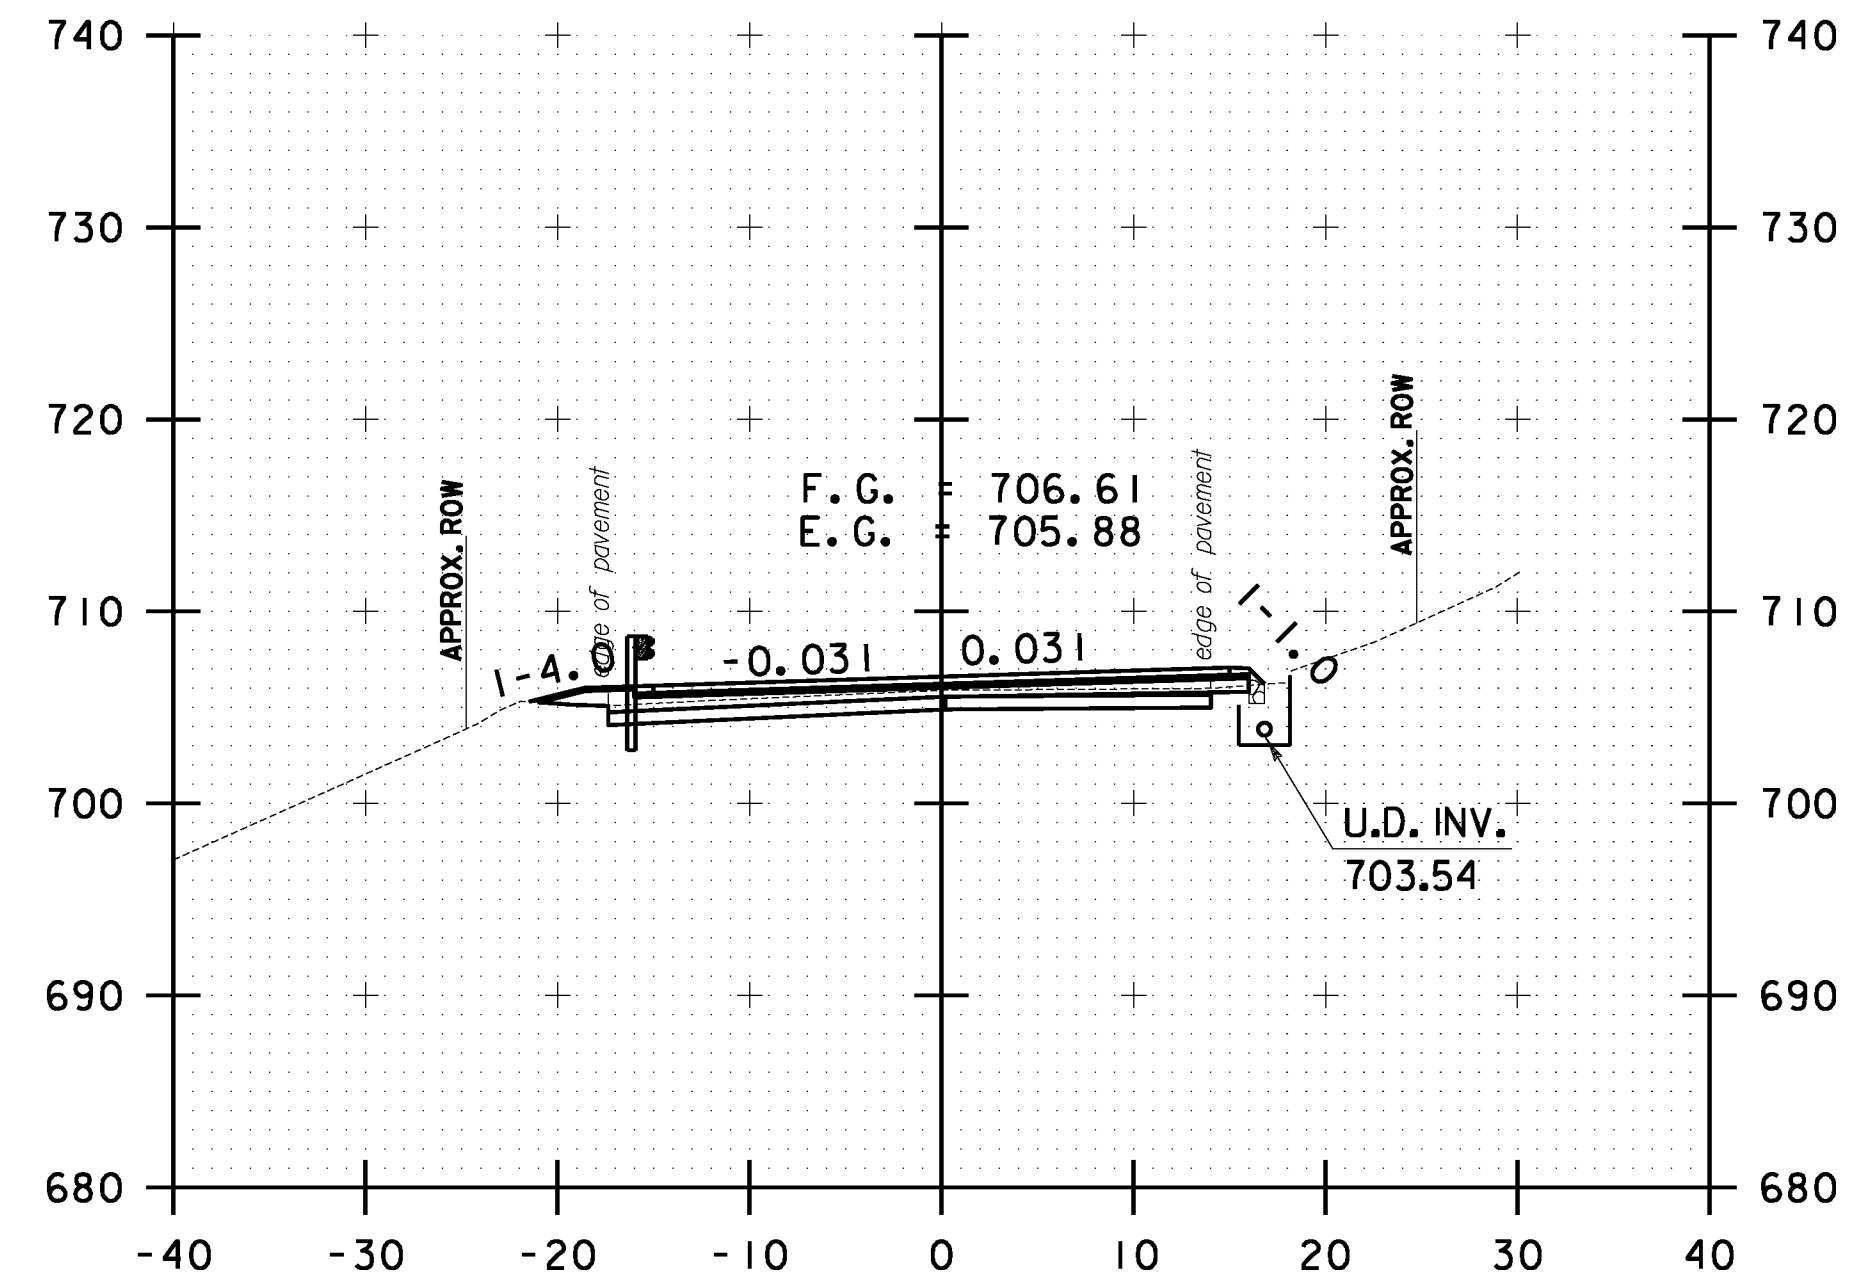


113+00.00

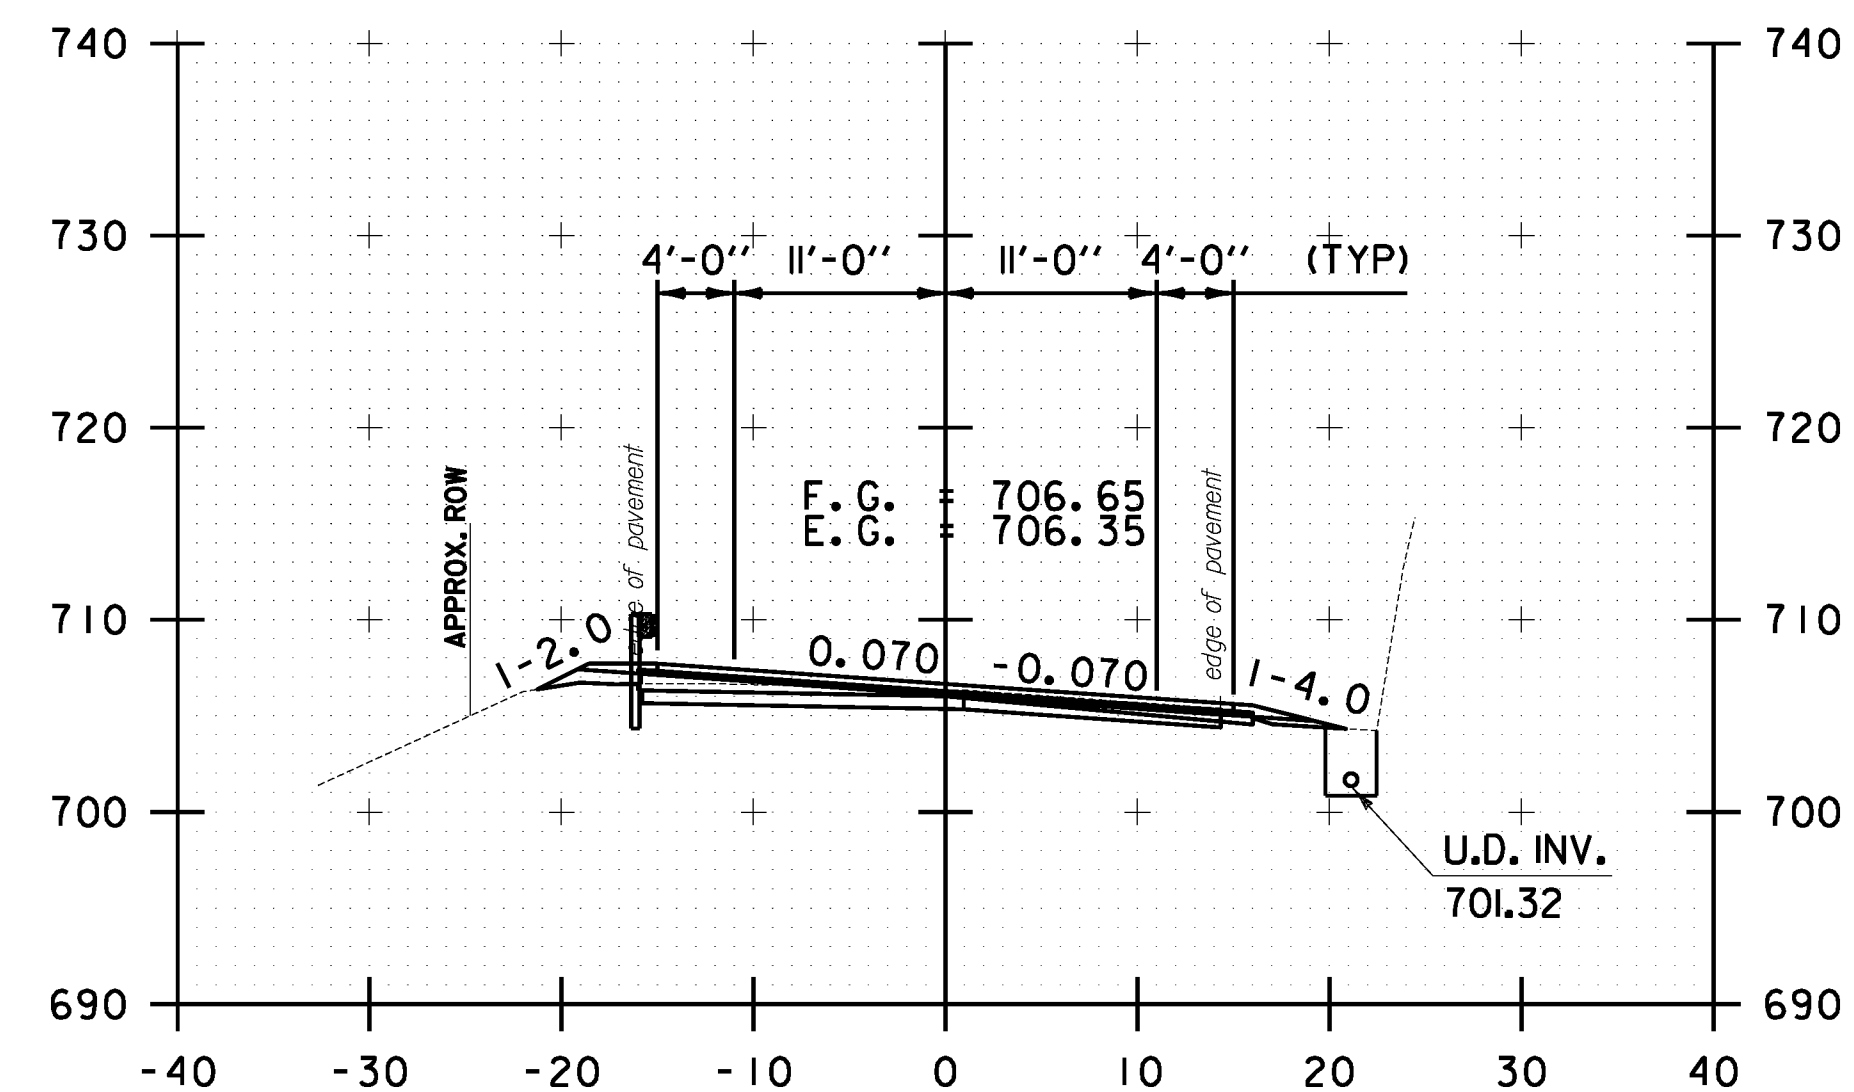

110+50.00

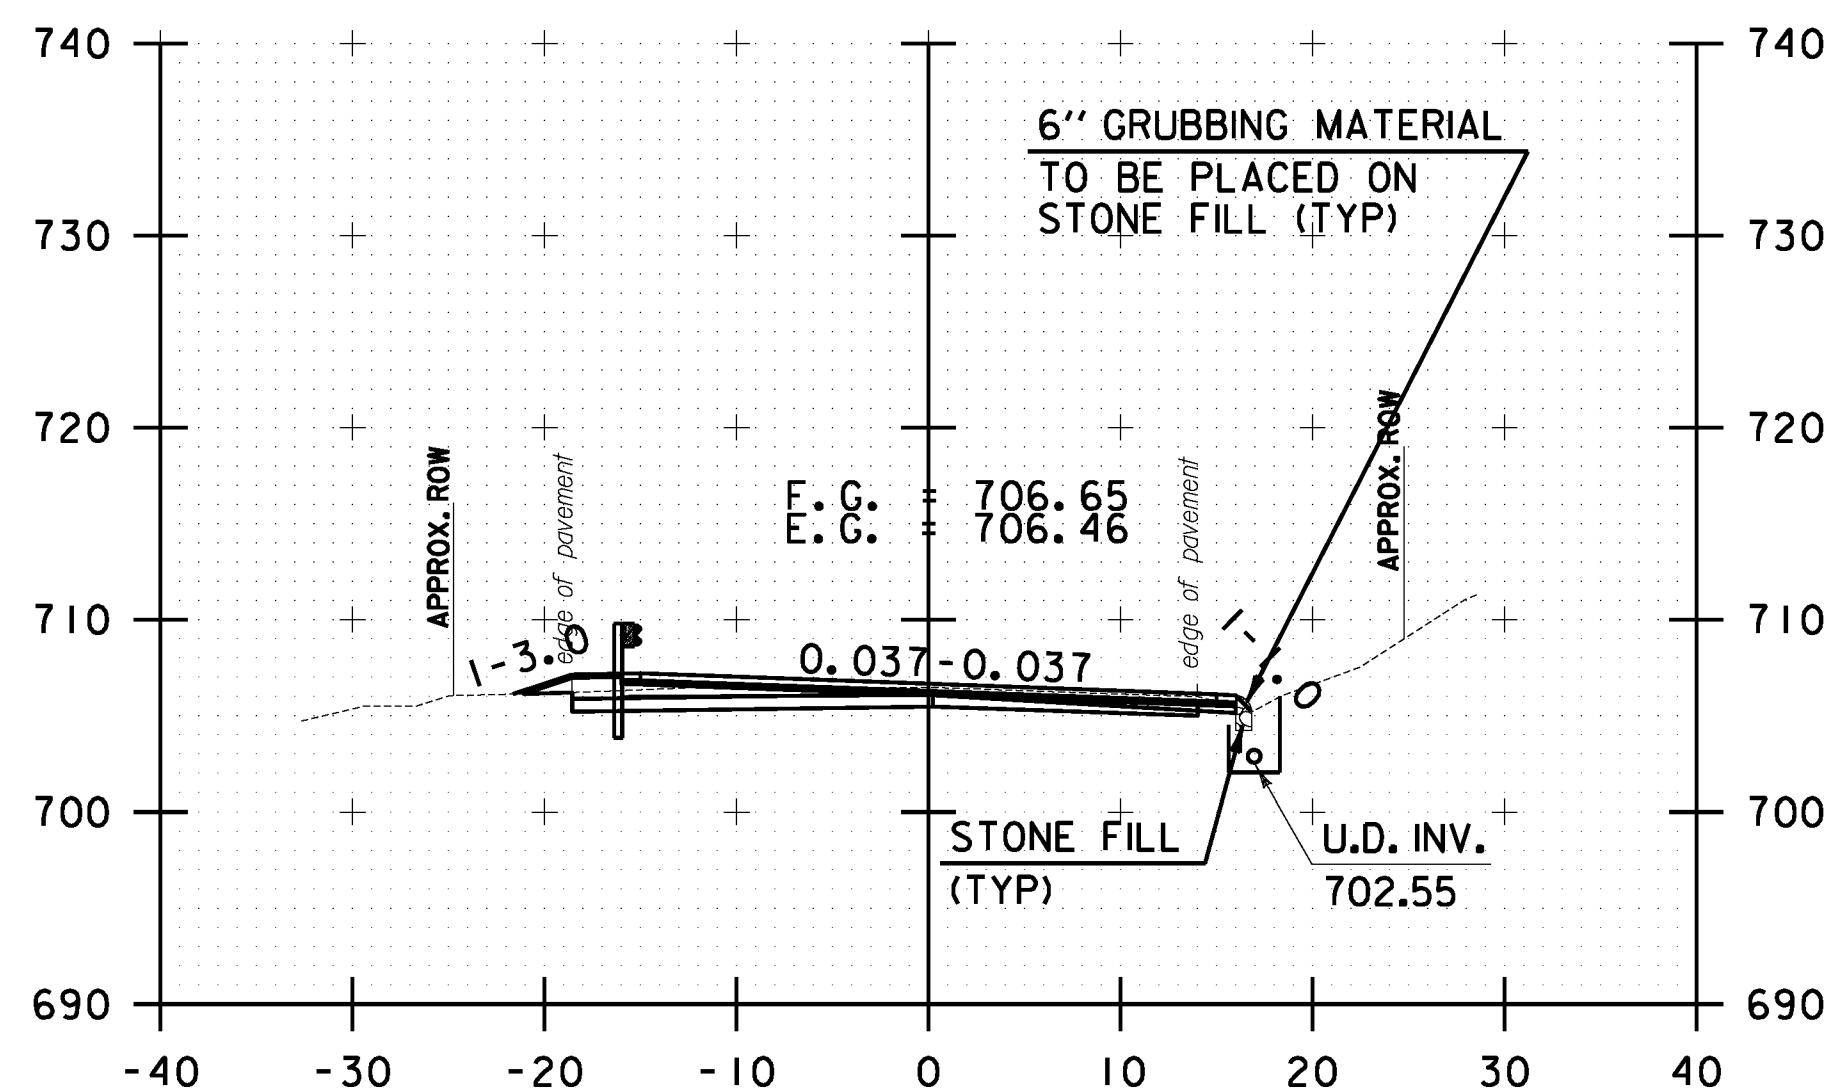

111+50.00

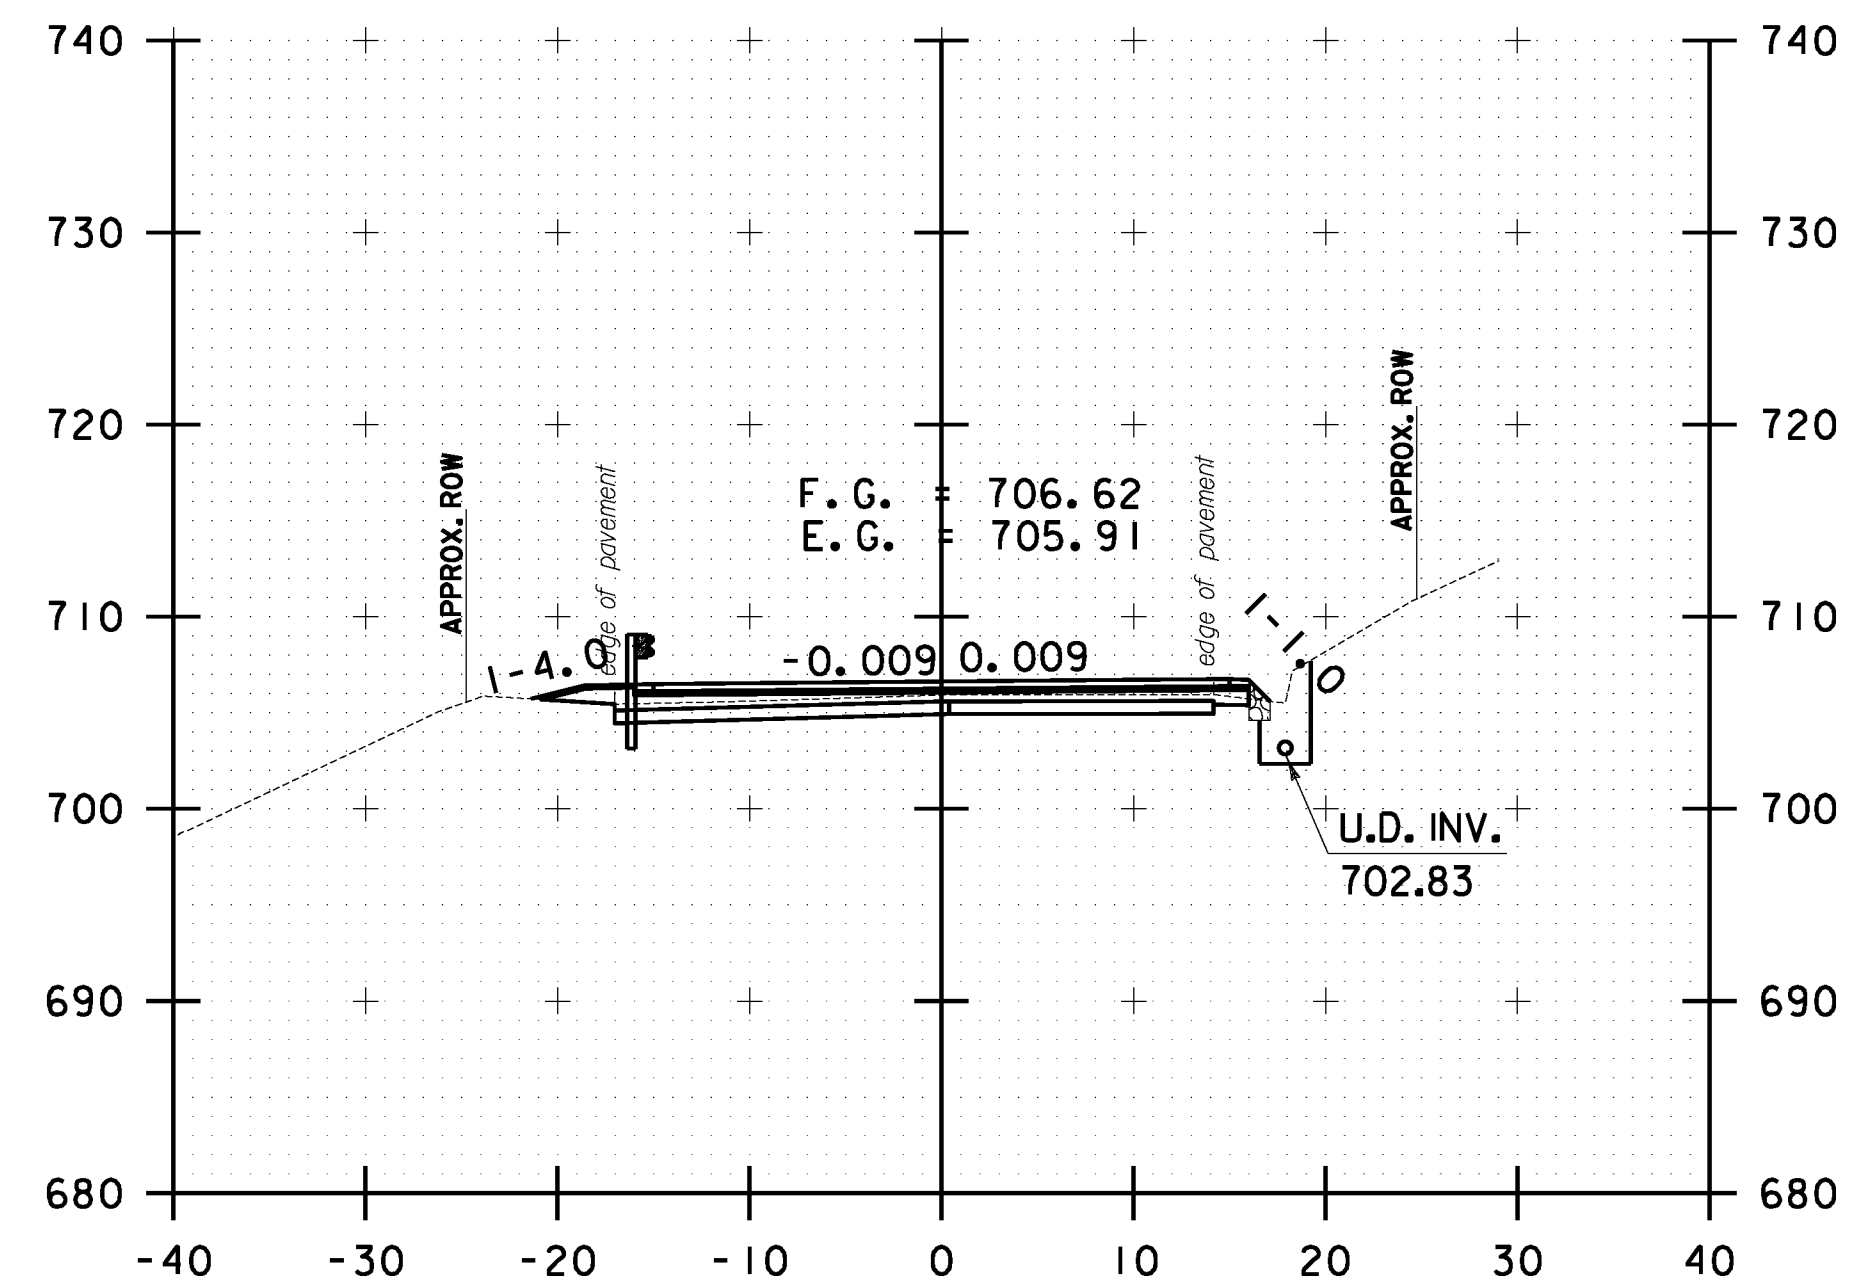

112+50.00



STOCKBRIDGE CROSS SECTION SHEET #37	PROJECT NAME: STOCKBRIDGE-BETHEL
	PROJECT NUMBER: STP 2910(1)
	FILE NAME: z10b214.stock.xc.dgn
	PLOT DATE: 3/17/2014
	DESIGNED BY: L.M.B.
	CHECKED BY: J.P.S.
	IPARM FILE: z10b214xs37.1
	DRAWN BY: W.G.P.
	SHEET 250 OF 397