




FILE NAME = Y:\P\c\g\ss\any\k2\22425\CADD\MSTN\10b214_stock.nc.dgn
 DATE/TIME = 3/17/2014
 USER = 4916

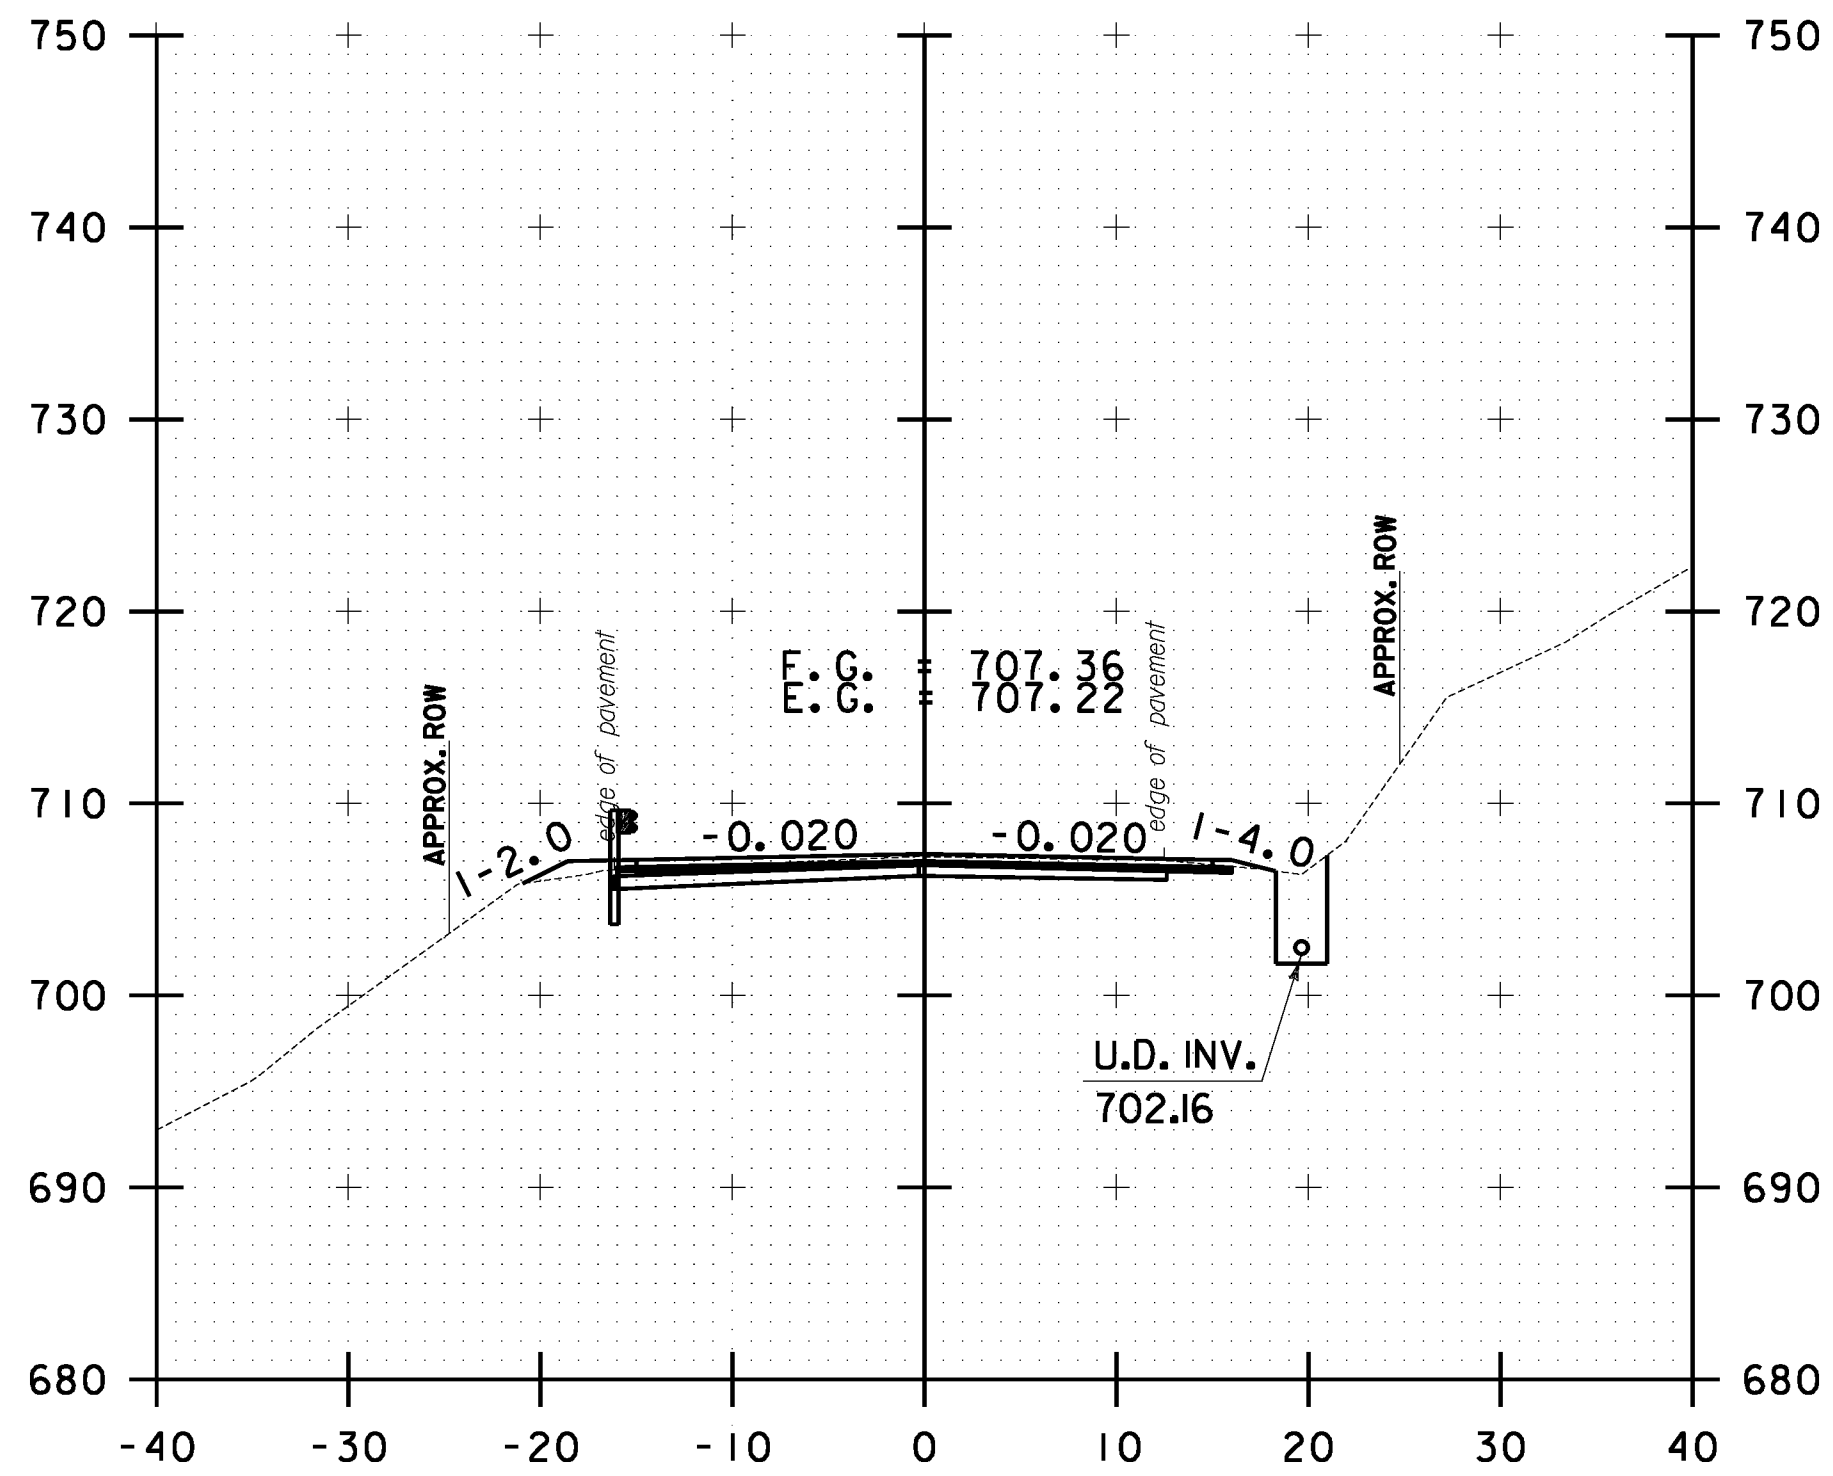


120+00.00

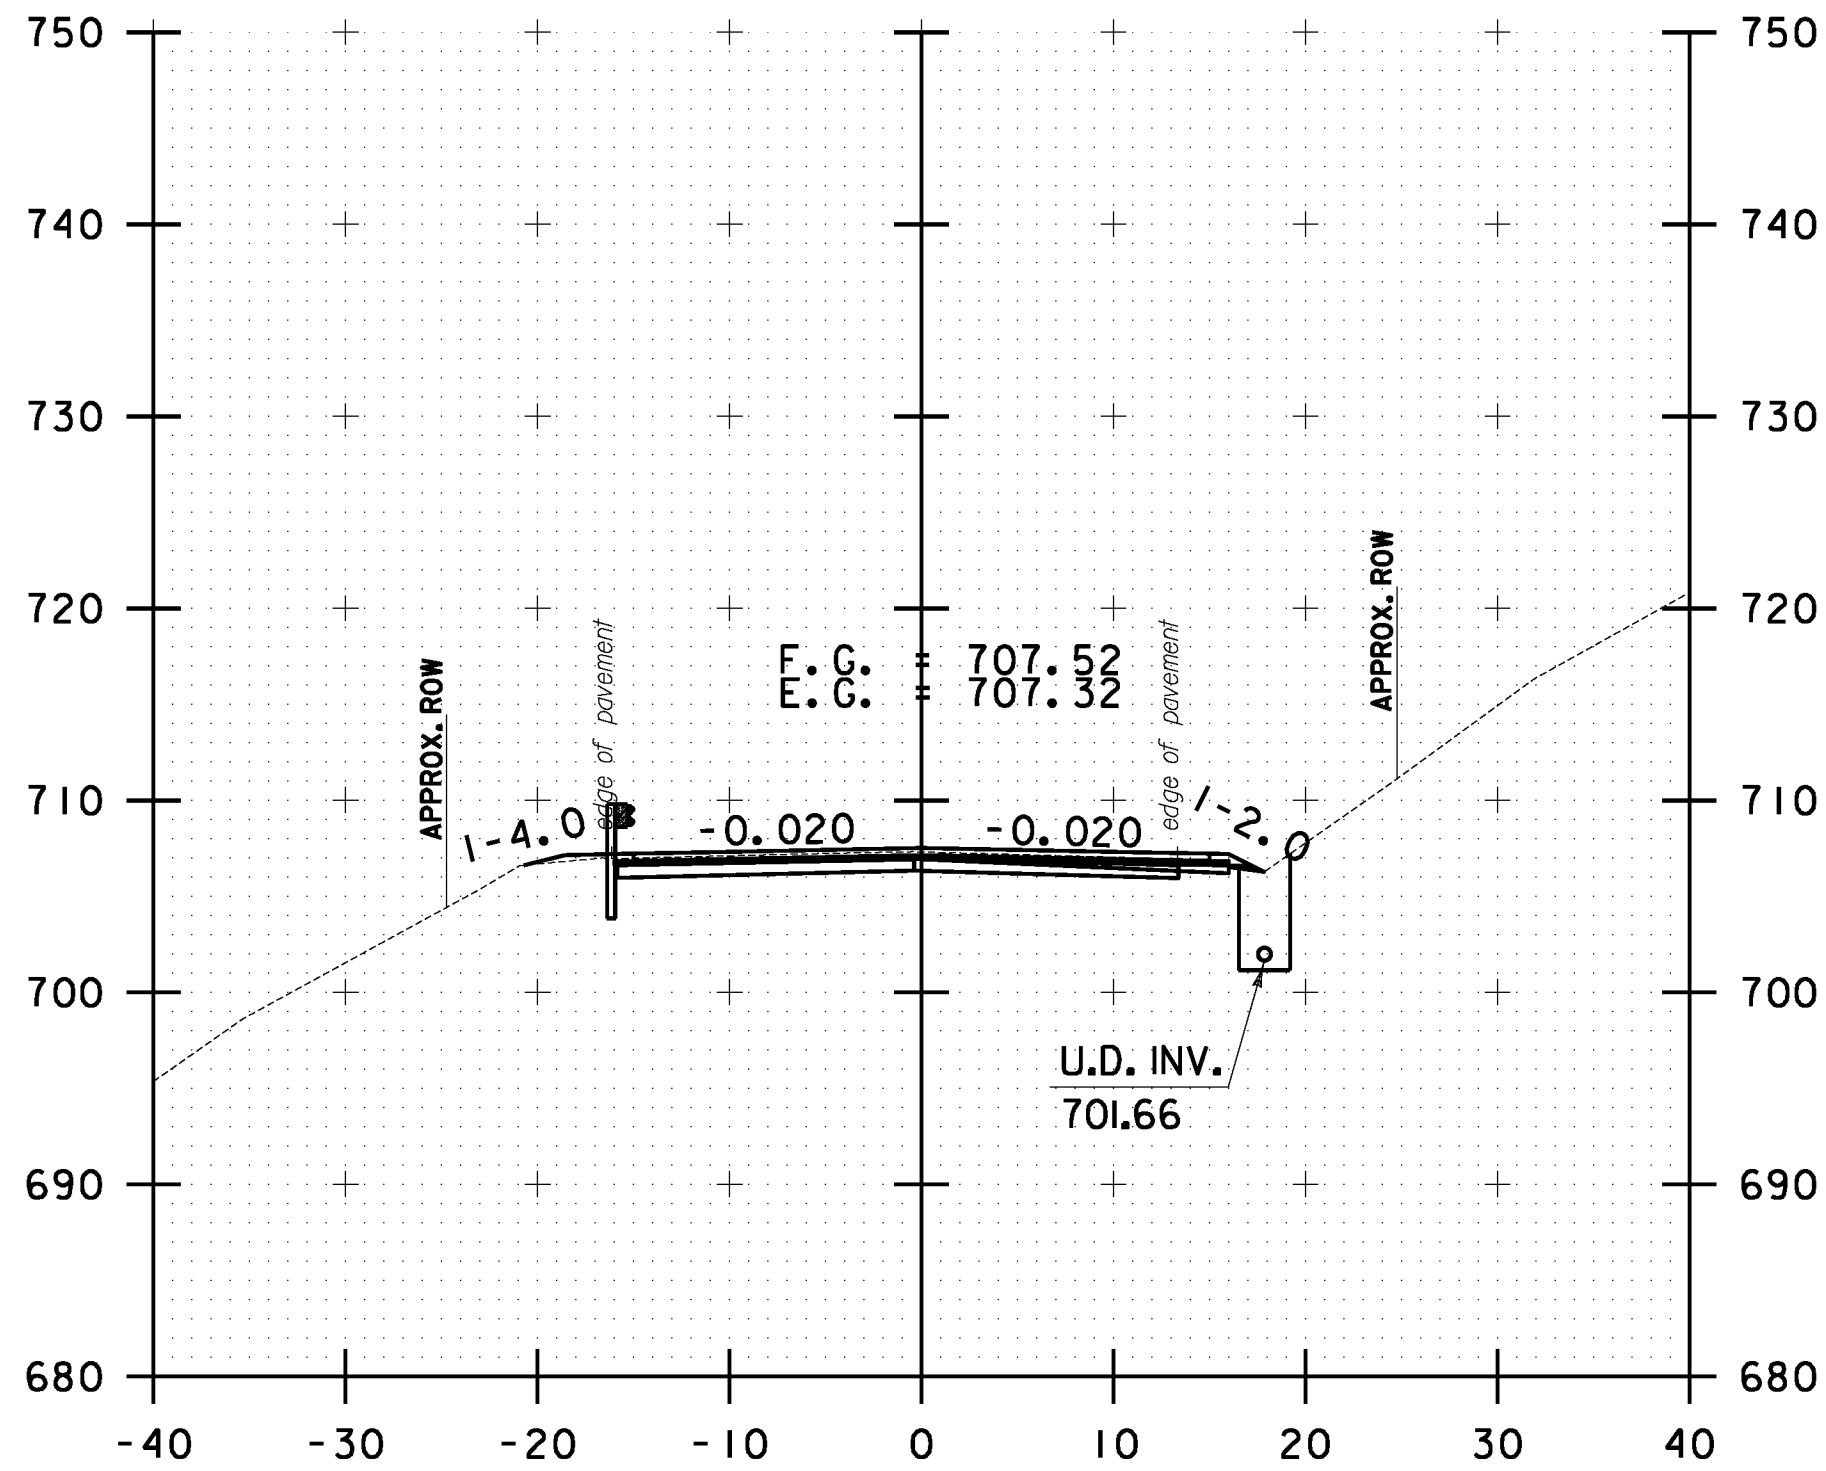


121+00.00

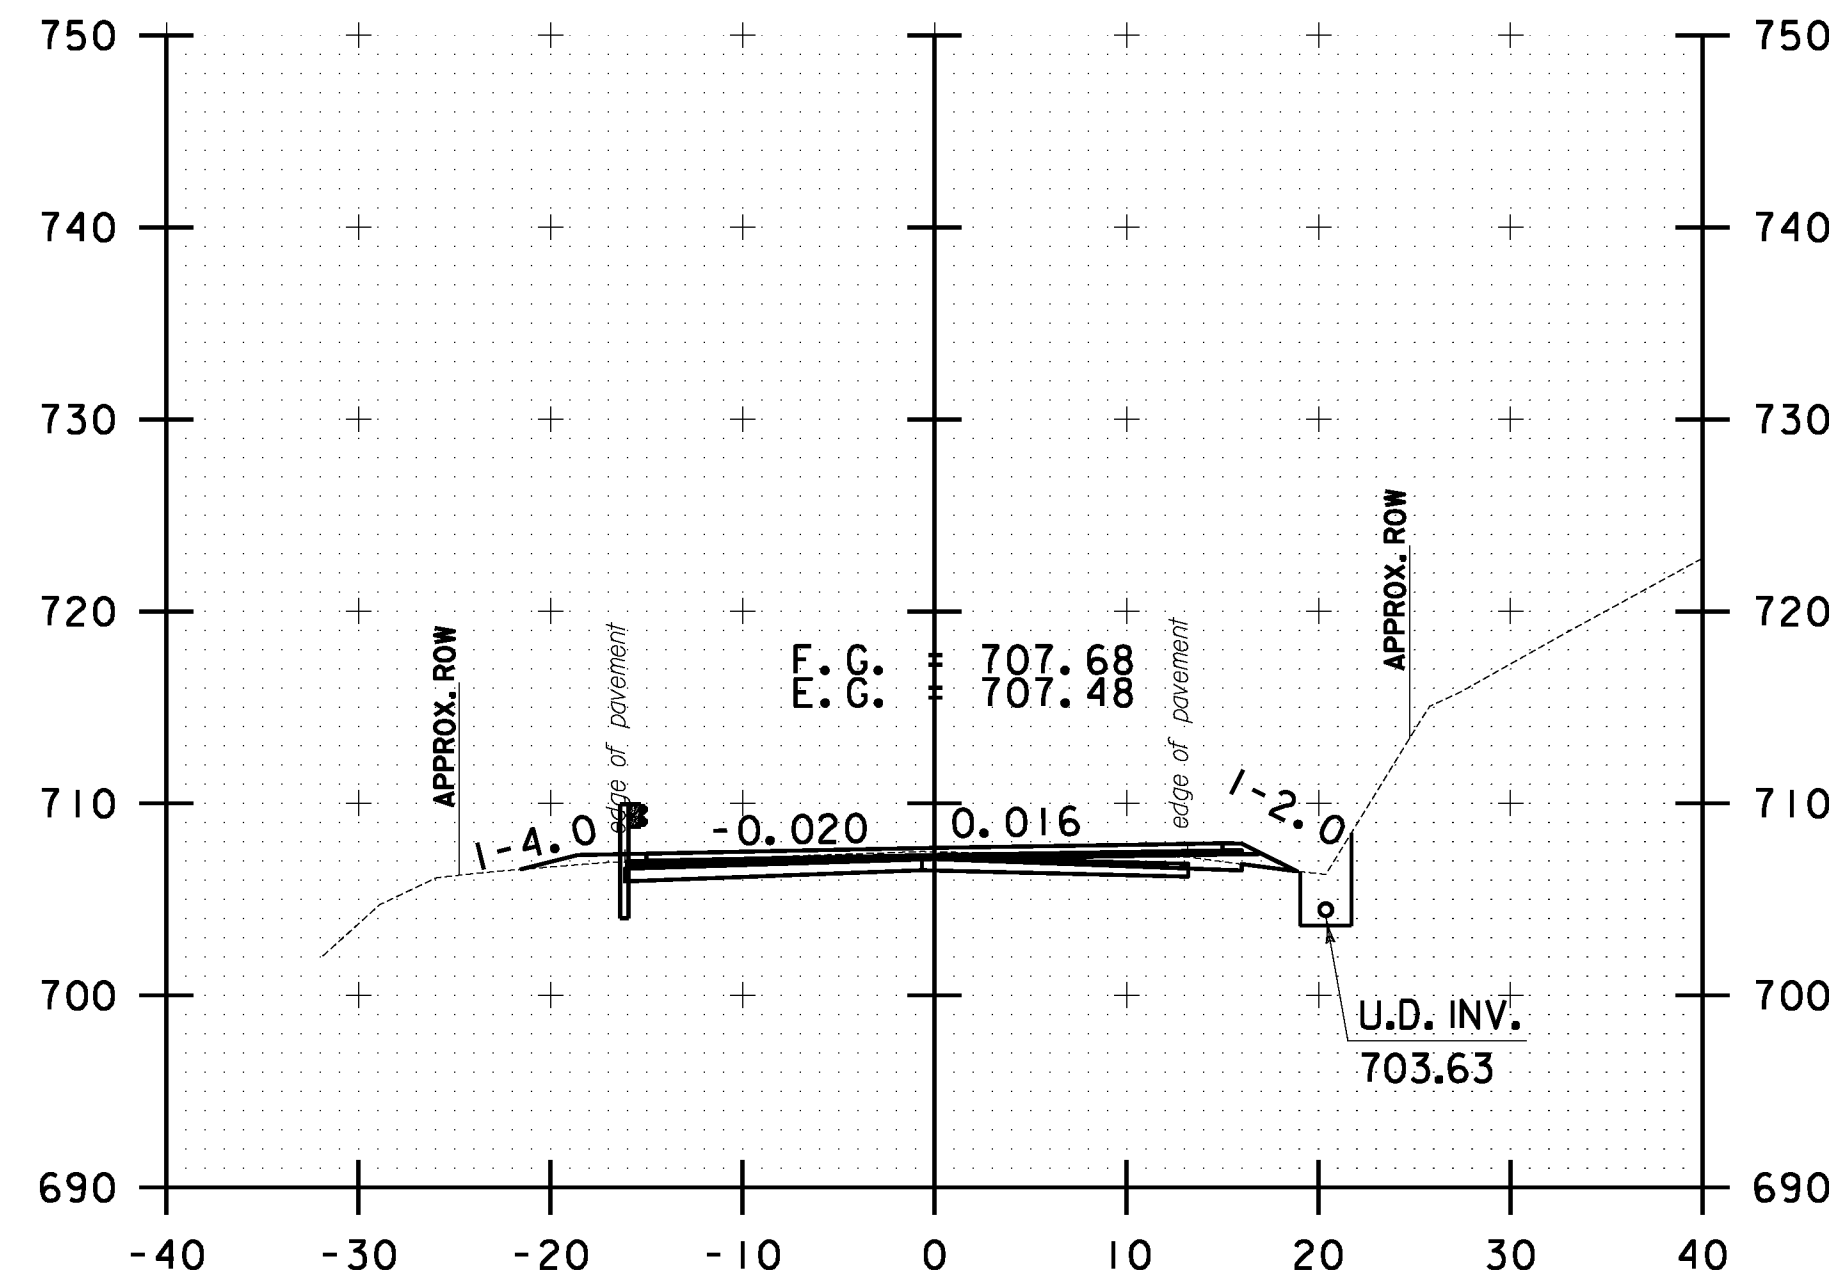


122+00.00

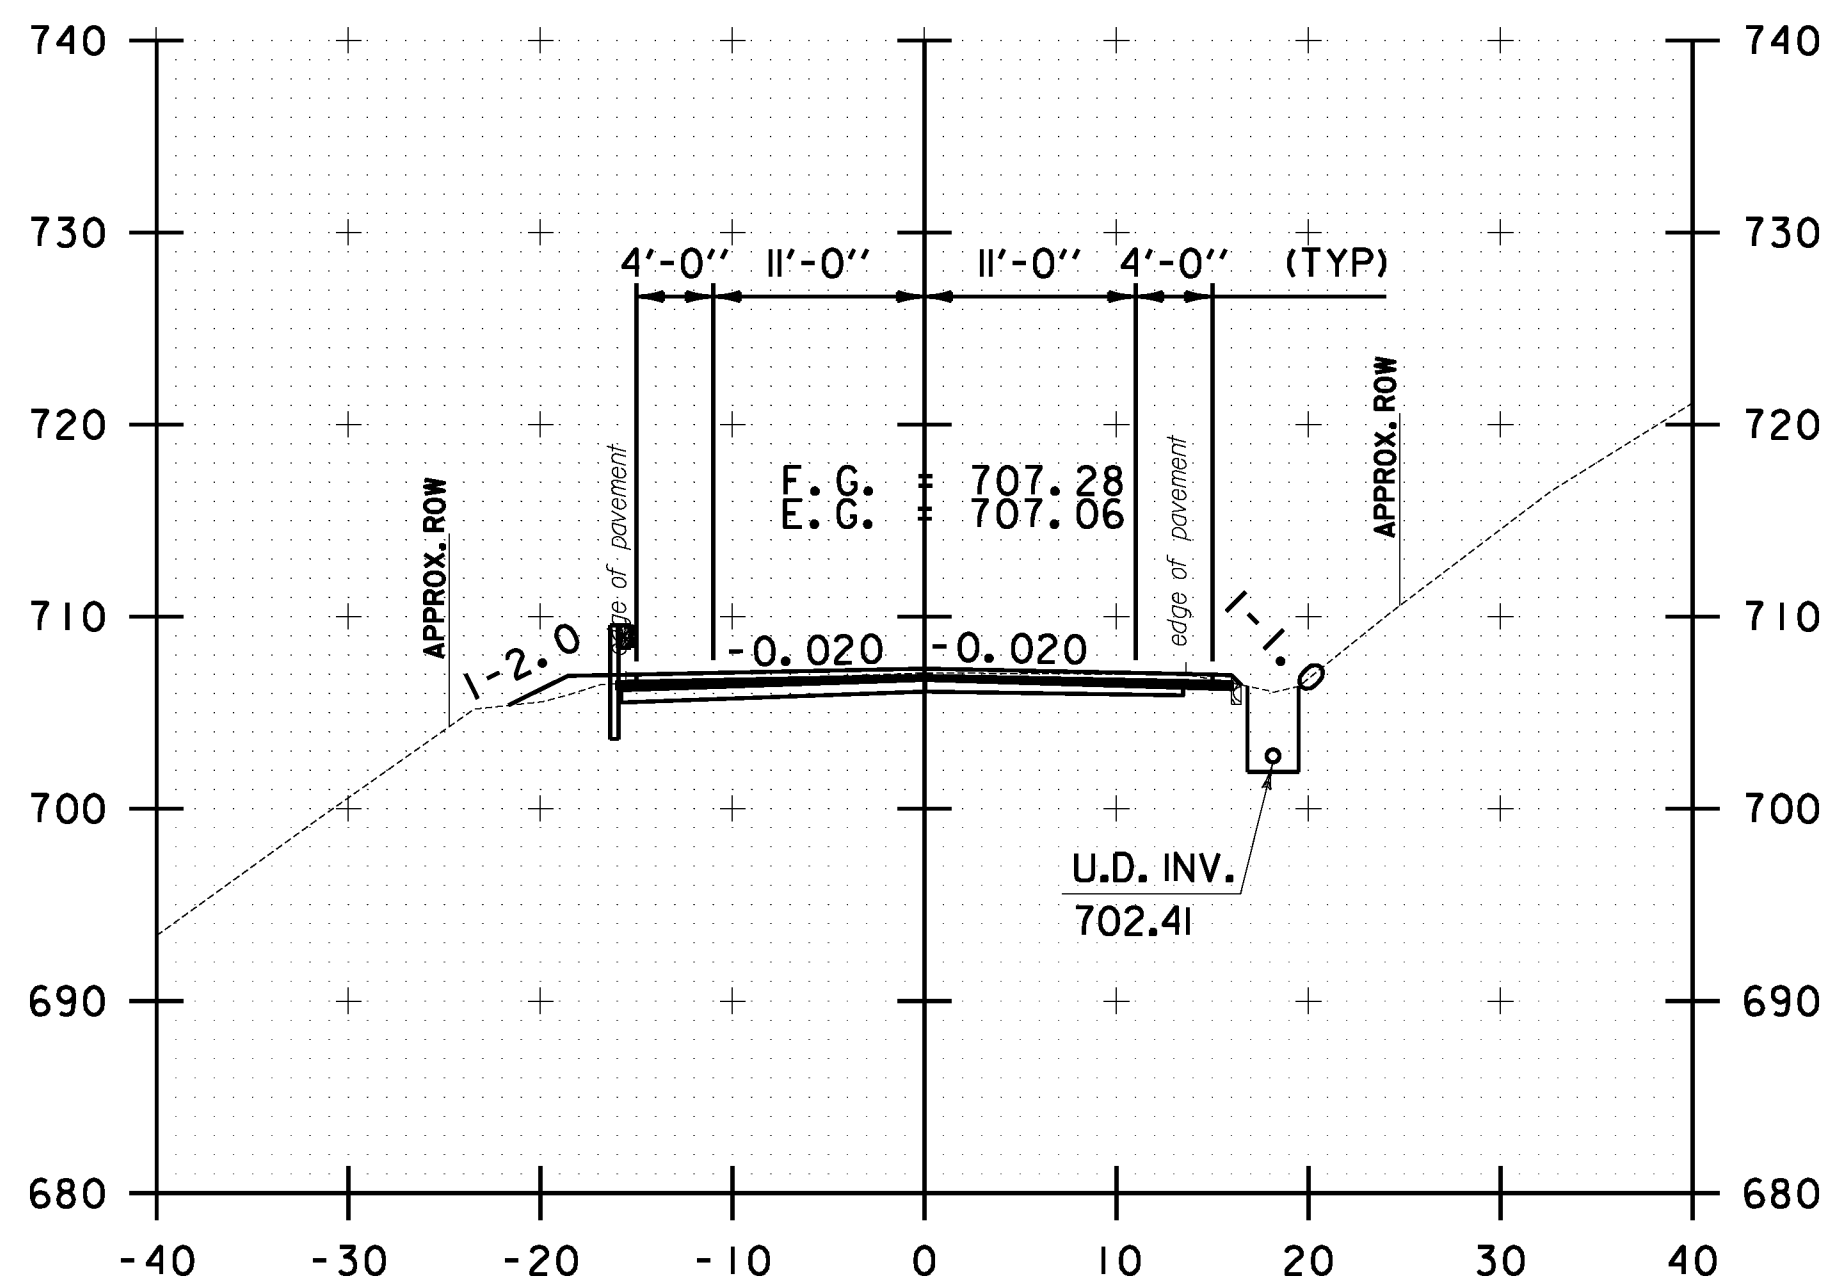


119+50.00

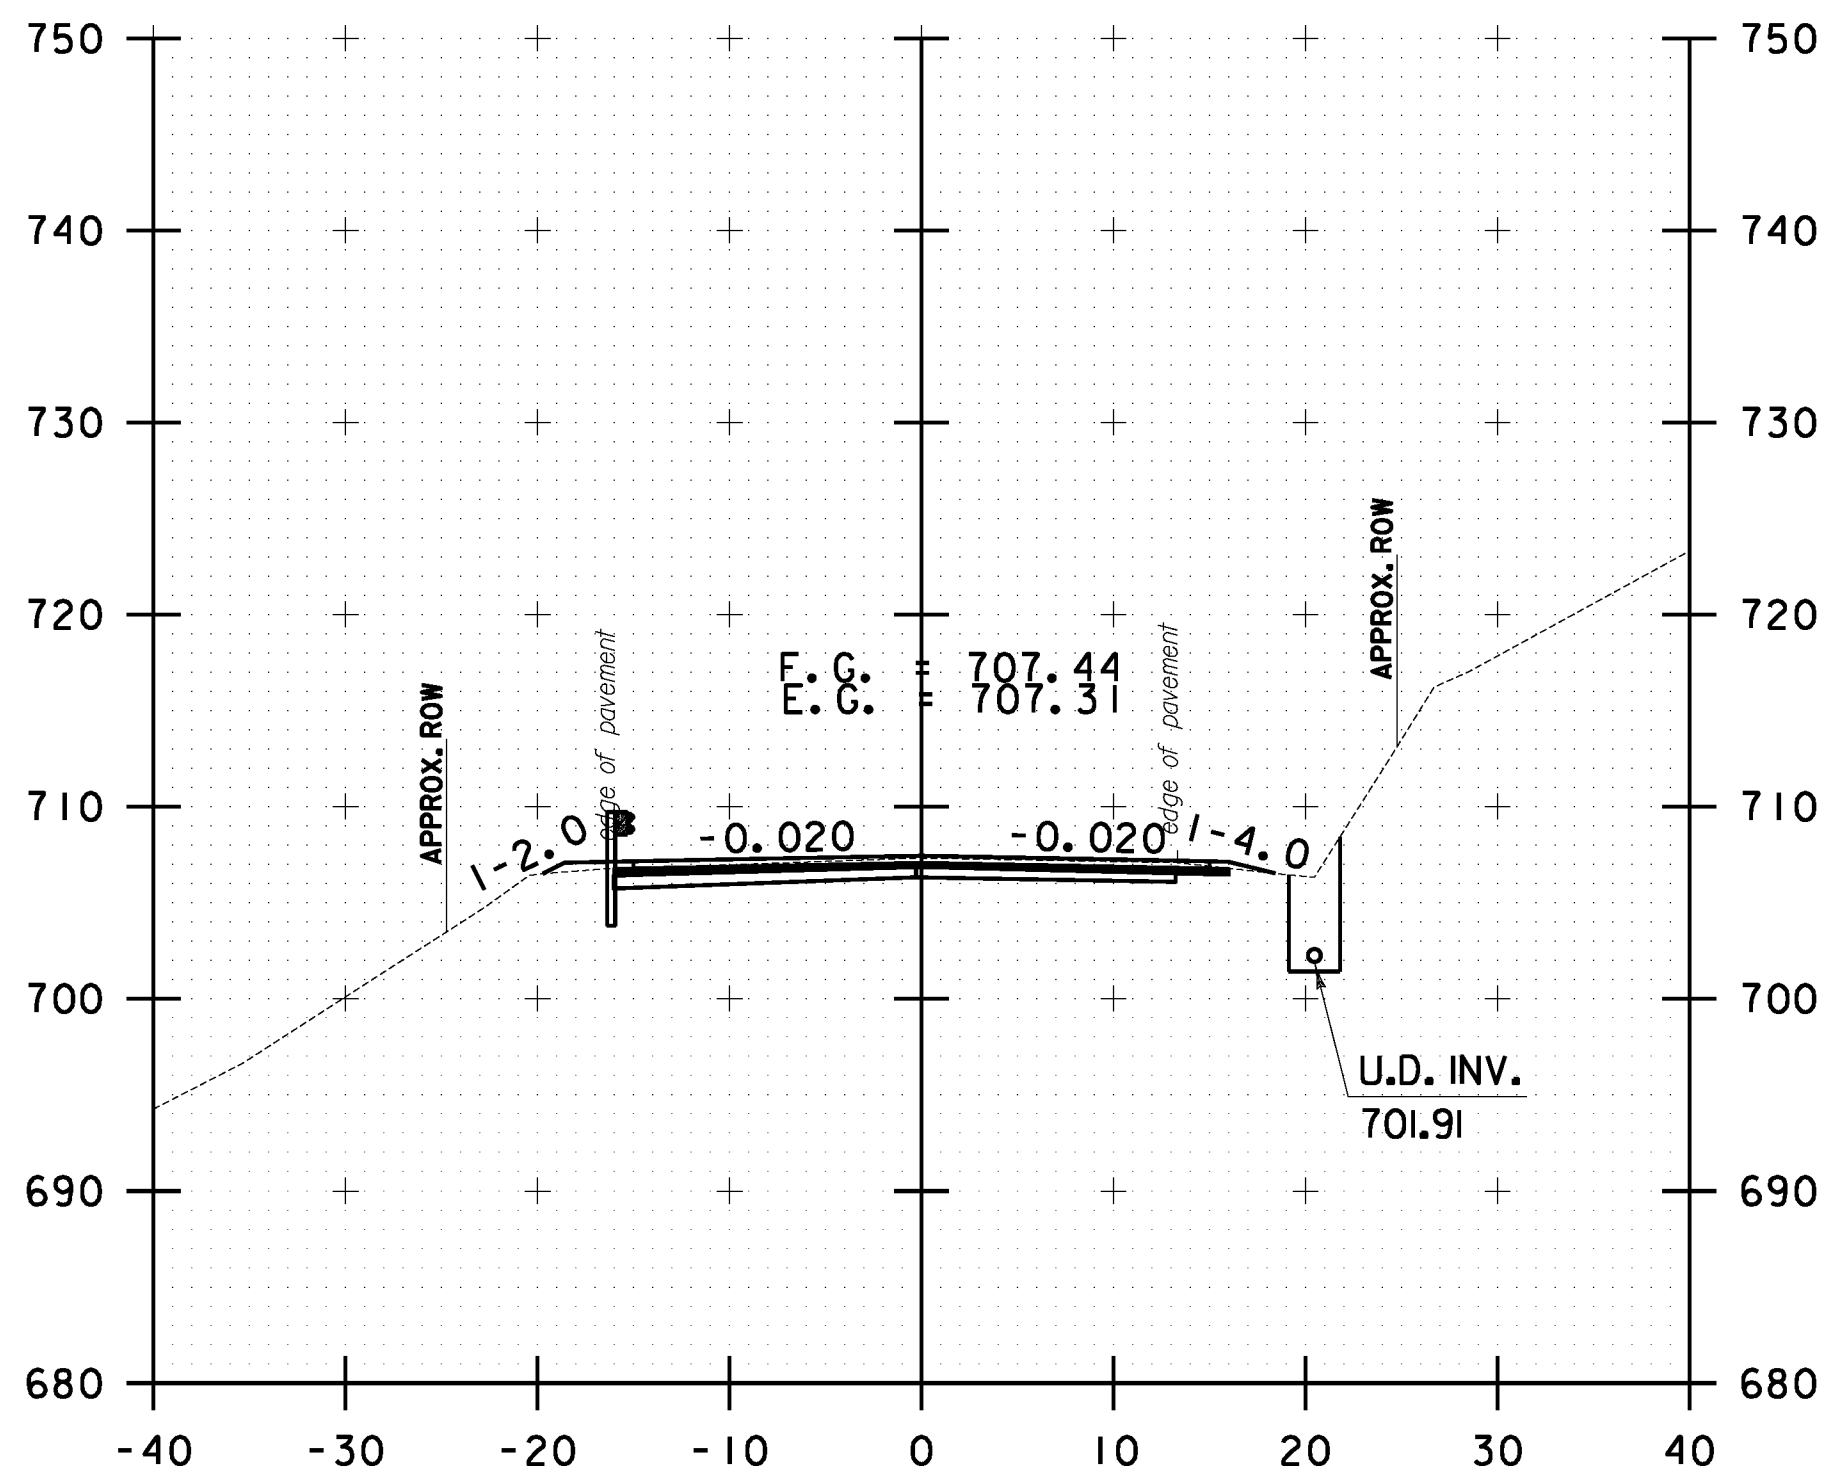

120+50.00

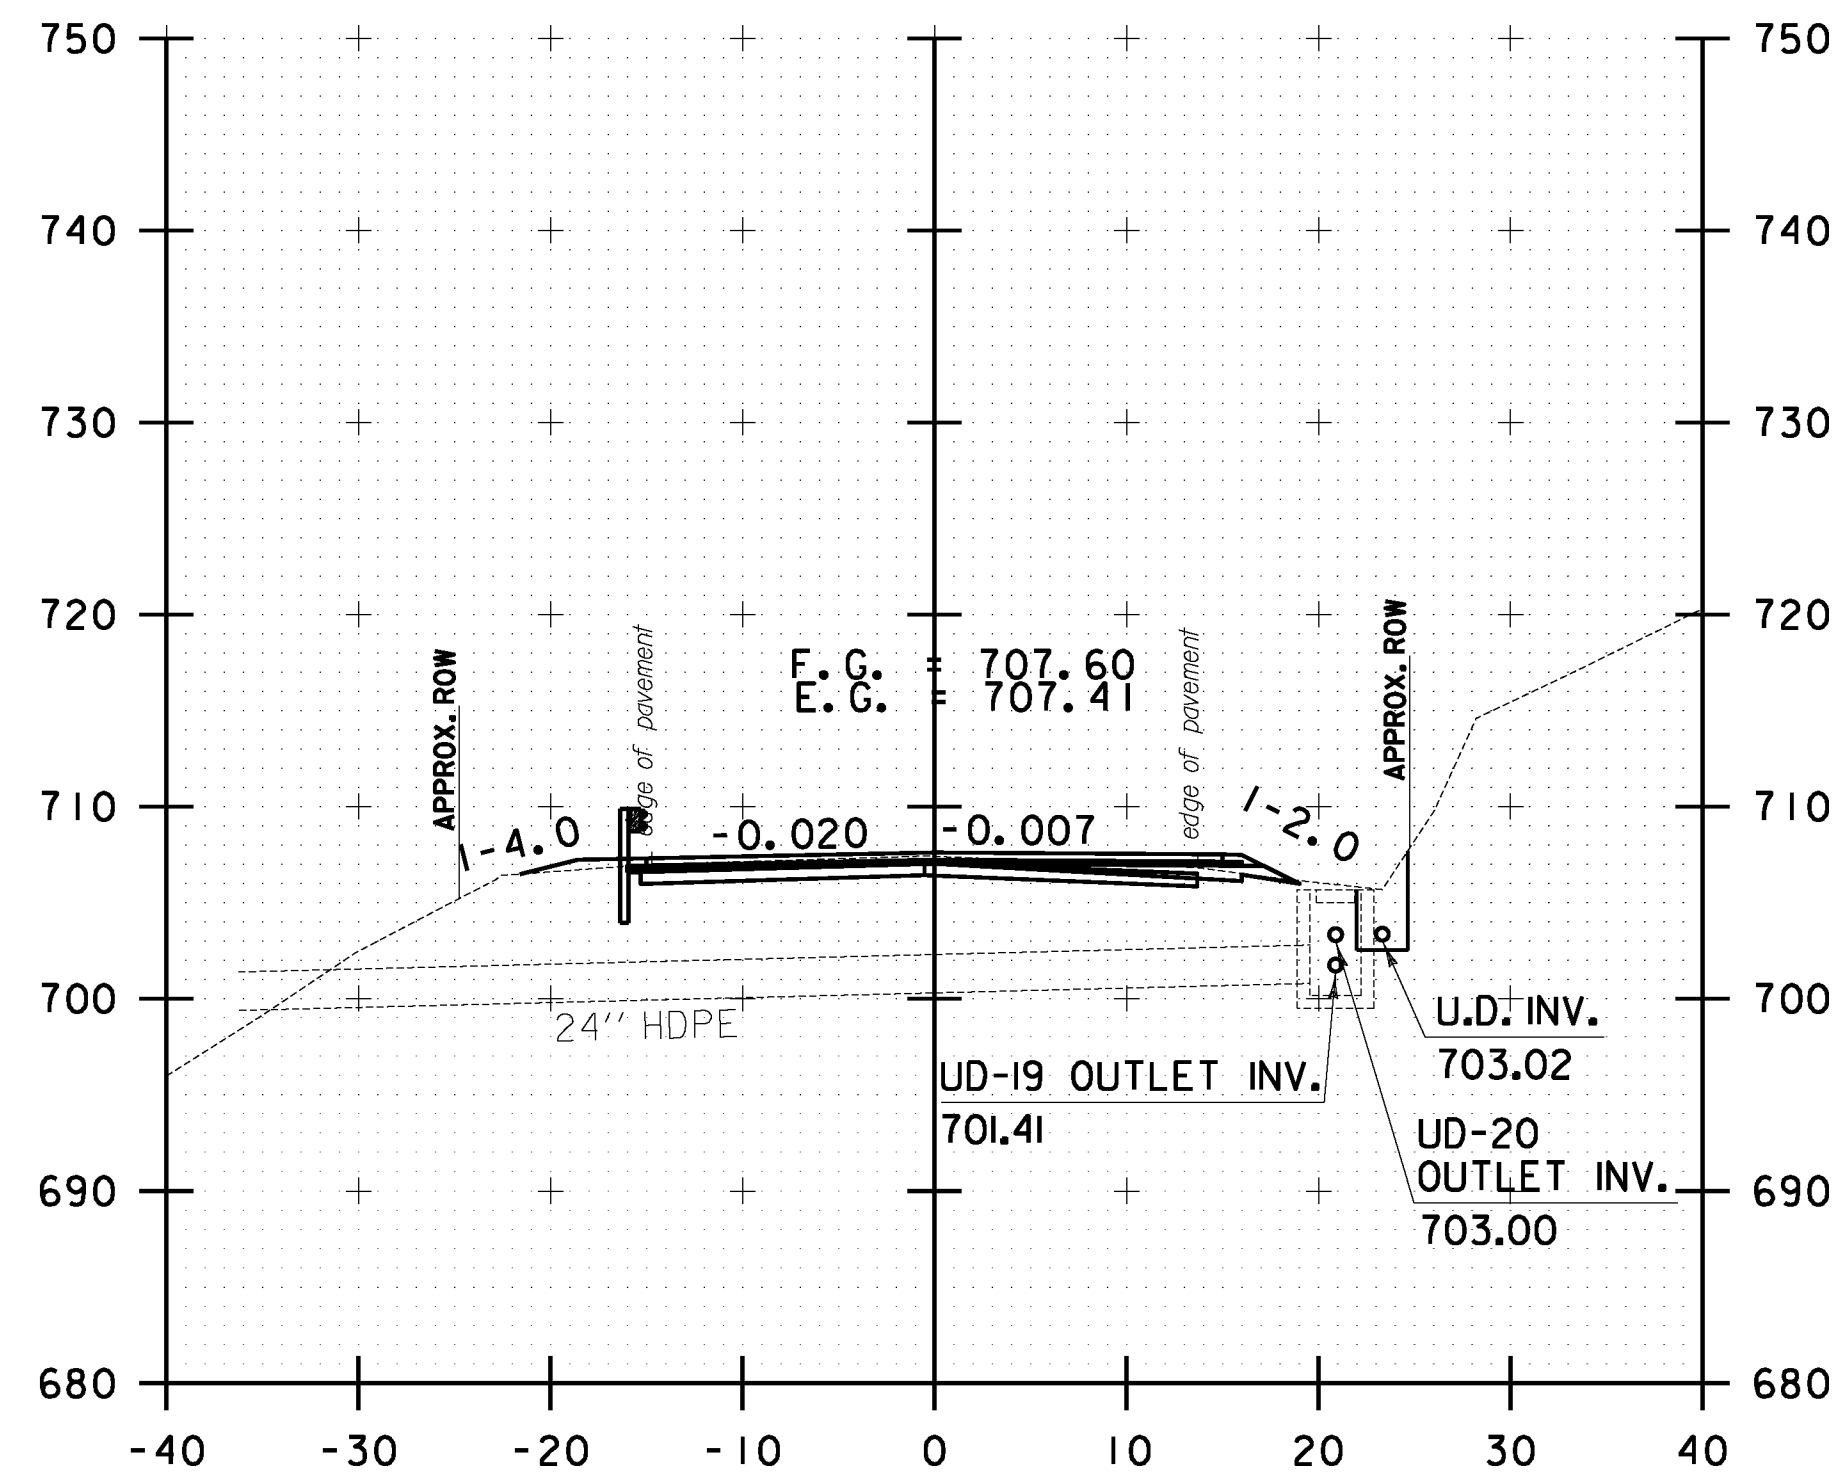

121+50.00

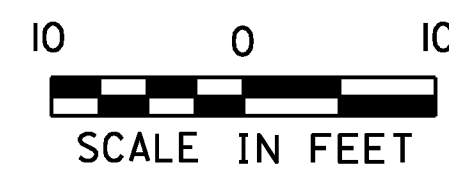

STOCKBRIDGE CROSS SECTION SHEET #40	PROJECT NAME: STOCKBRIDGE-BETHEL
	PROJECT NUMBER: STP 2910(I)
	FILE NAME: z10b214_stock.nc.dgn
	IPARM FILE: z10b214xs40.1
	PLOT DATE: 3/17/2014
	DRAWN BY: W.G.P.
	CHECKED BY: J.P.S.
	SHEET 253 OF 397