




FILE NAME = Y:\P\c\res\any\k2\22425\CADD\MSTN\10b214_stock.nc.dgn
 DATE/TIME = 3/17/2014
 USER = 4916

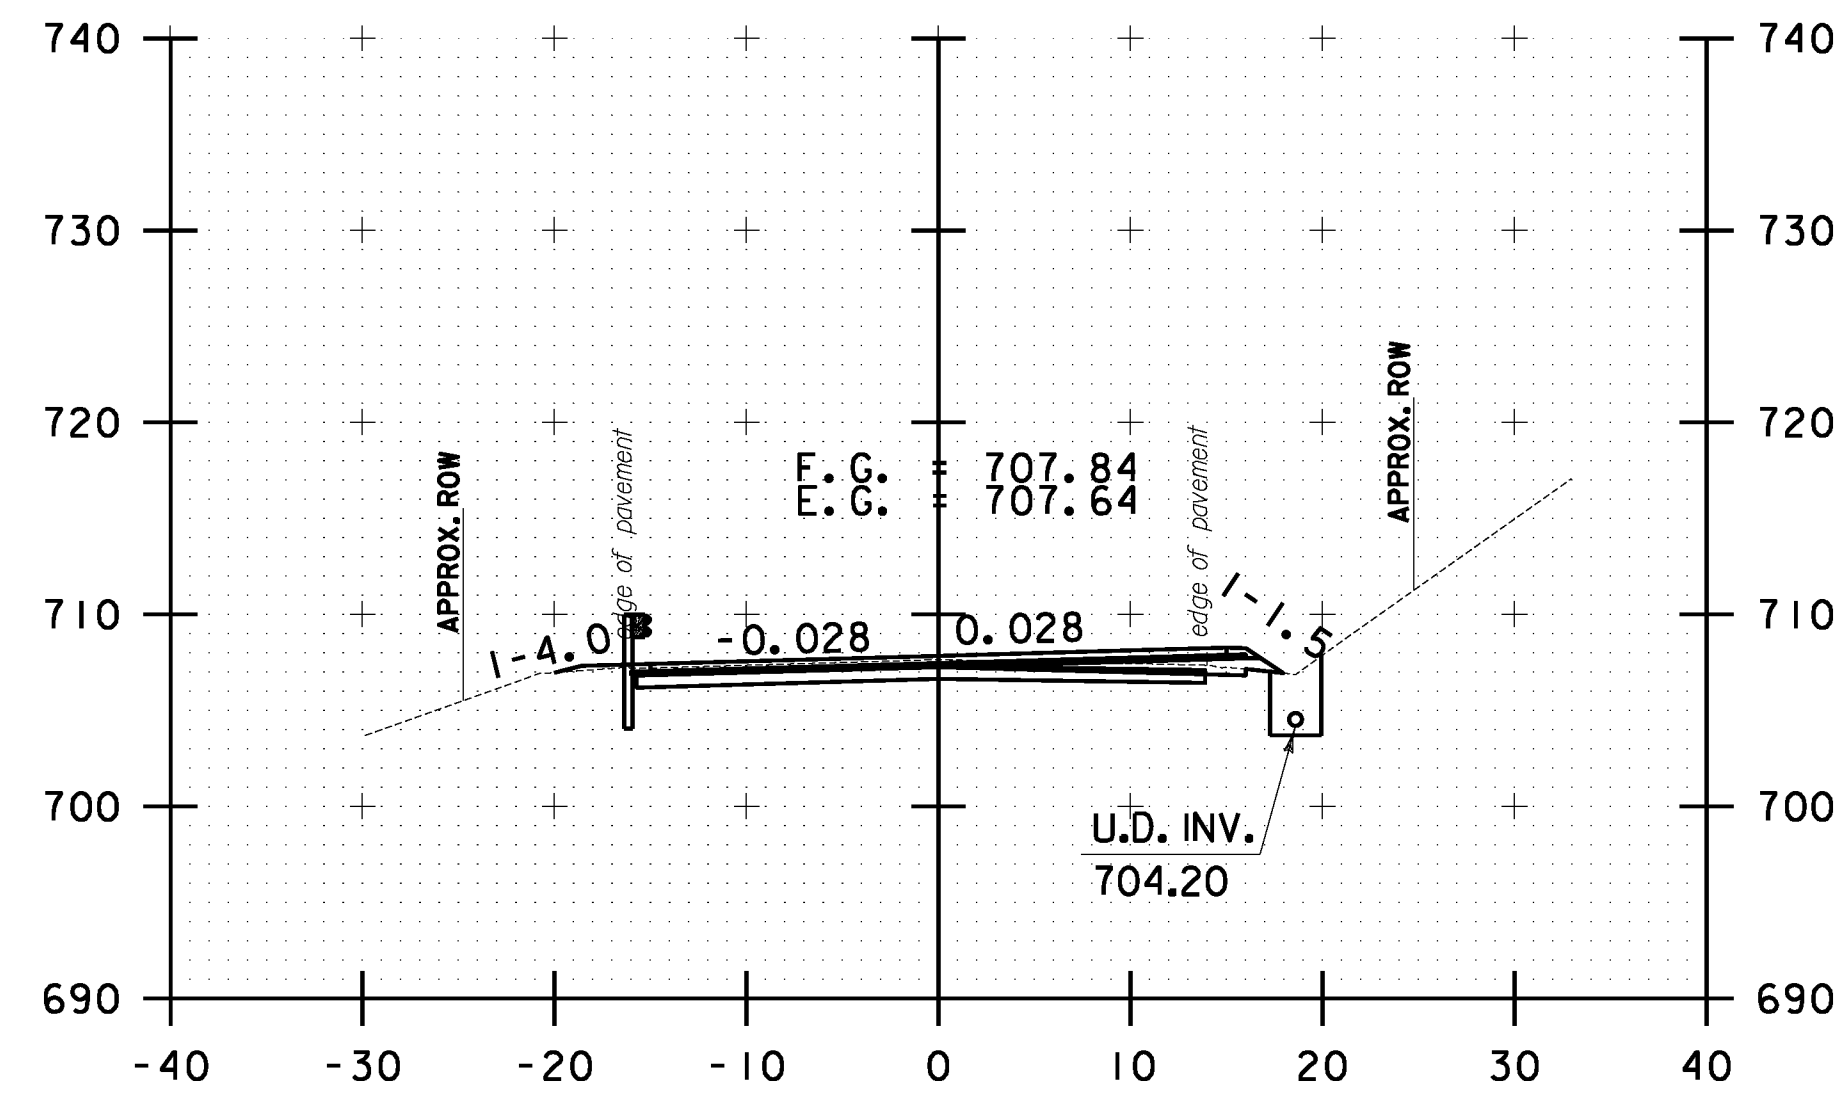


123+00.00

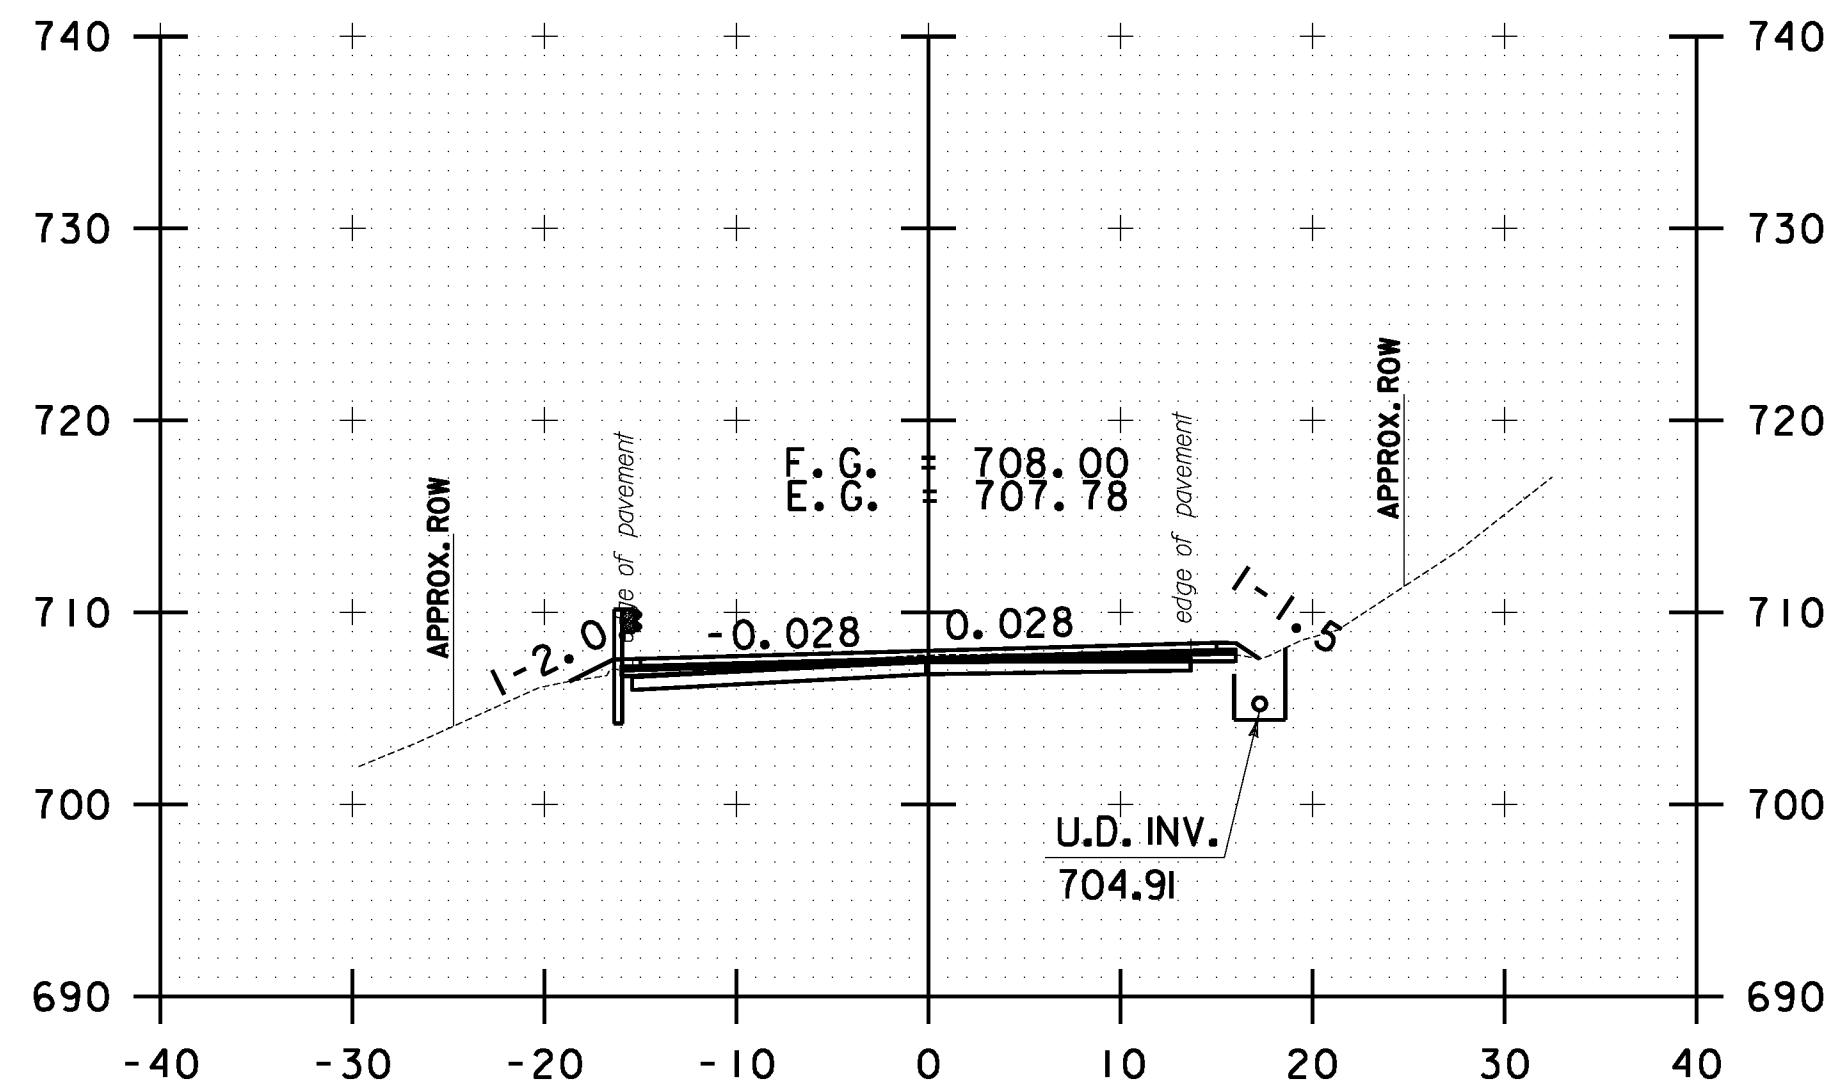


124+00.00

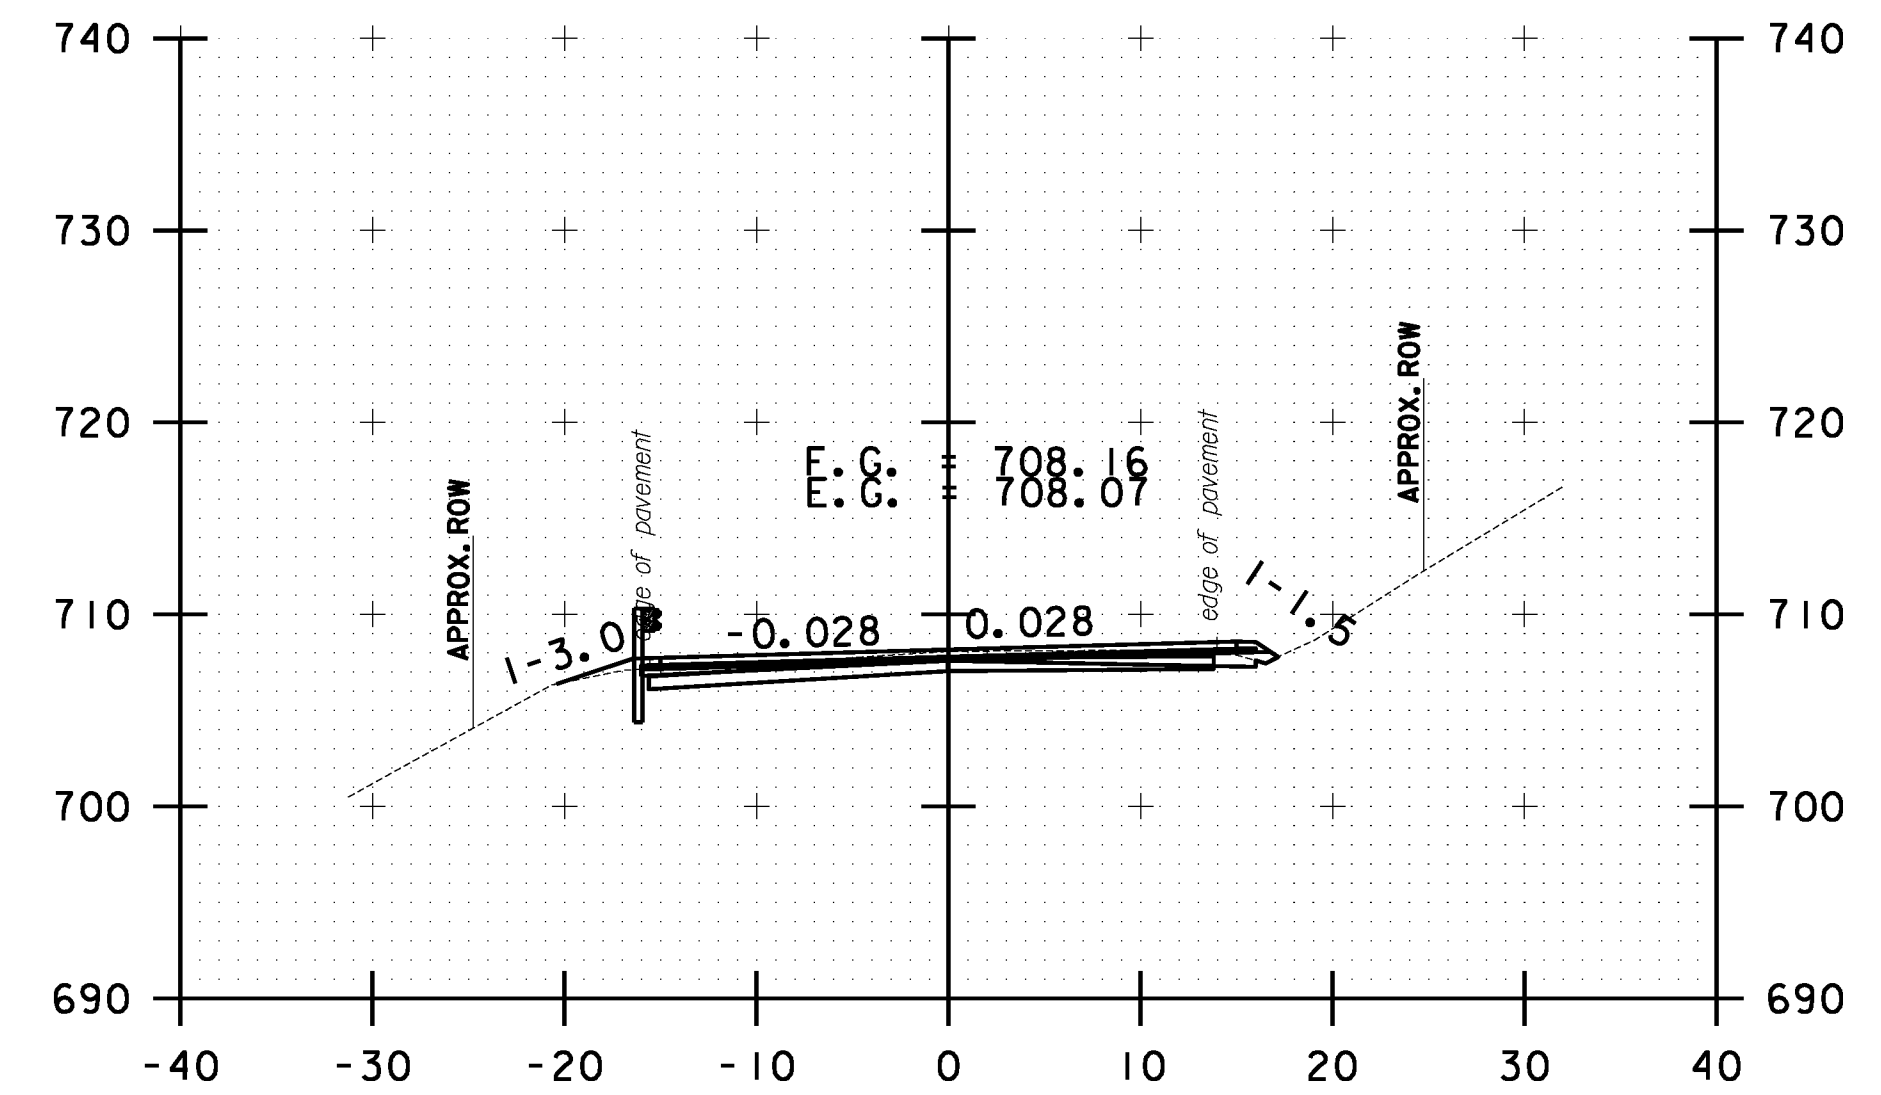


125+00.00

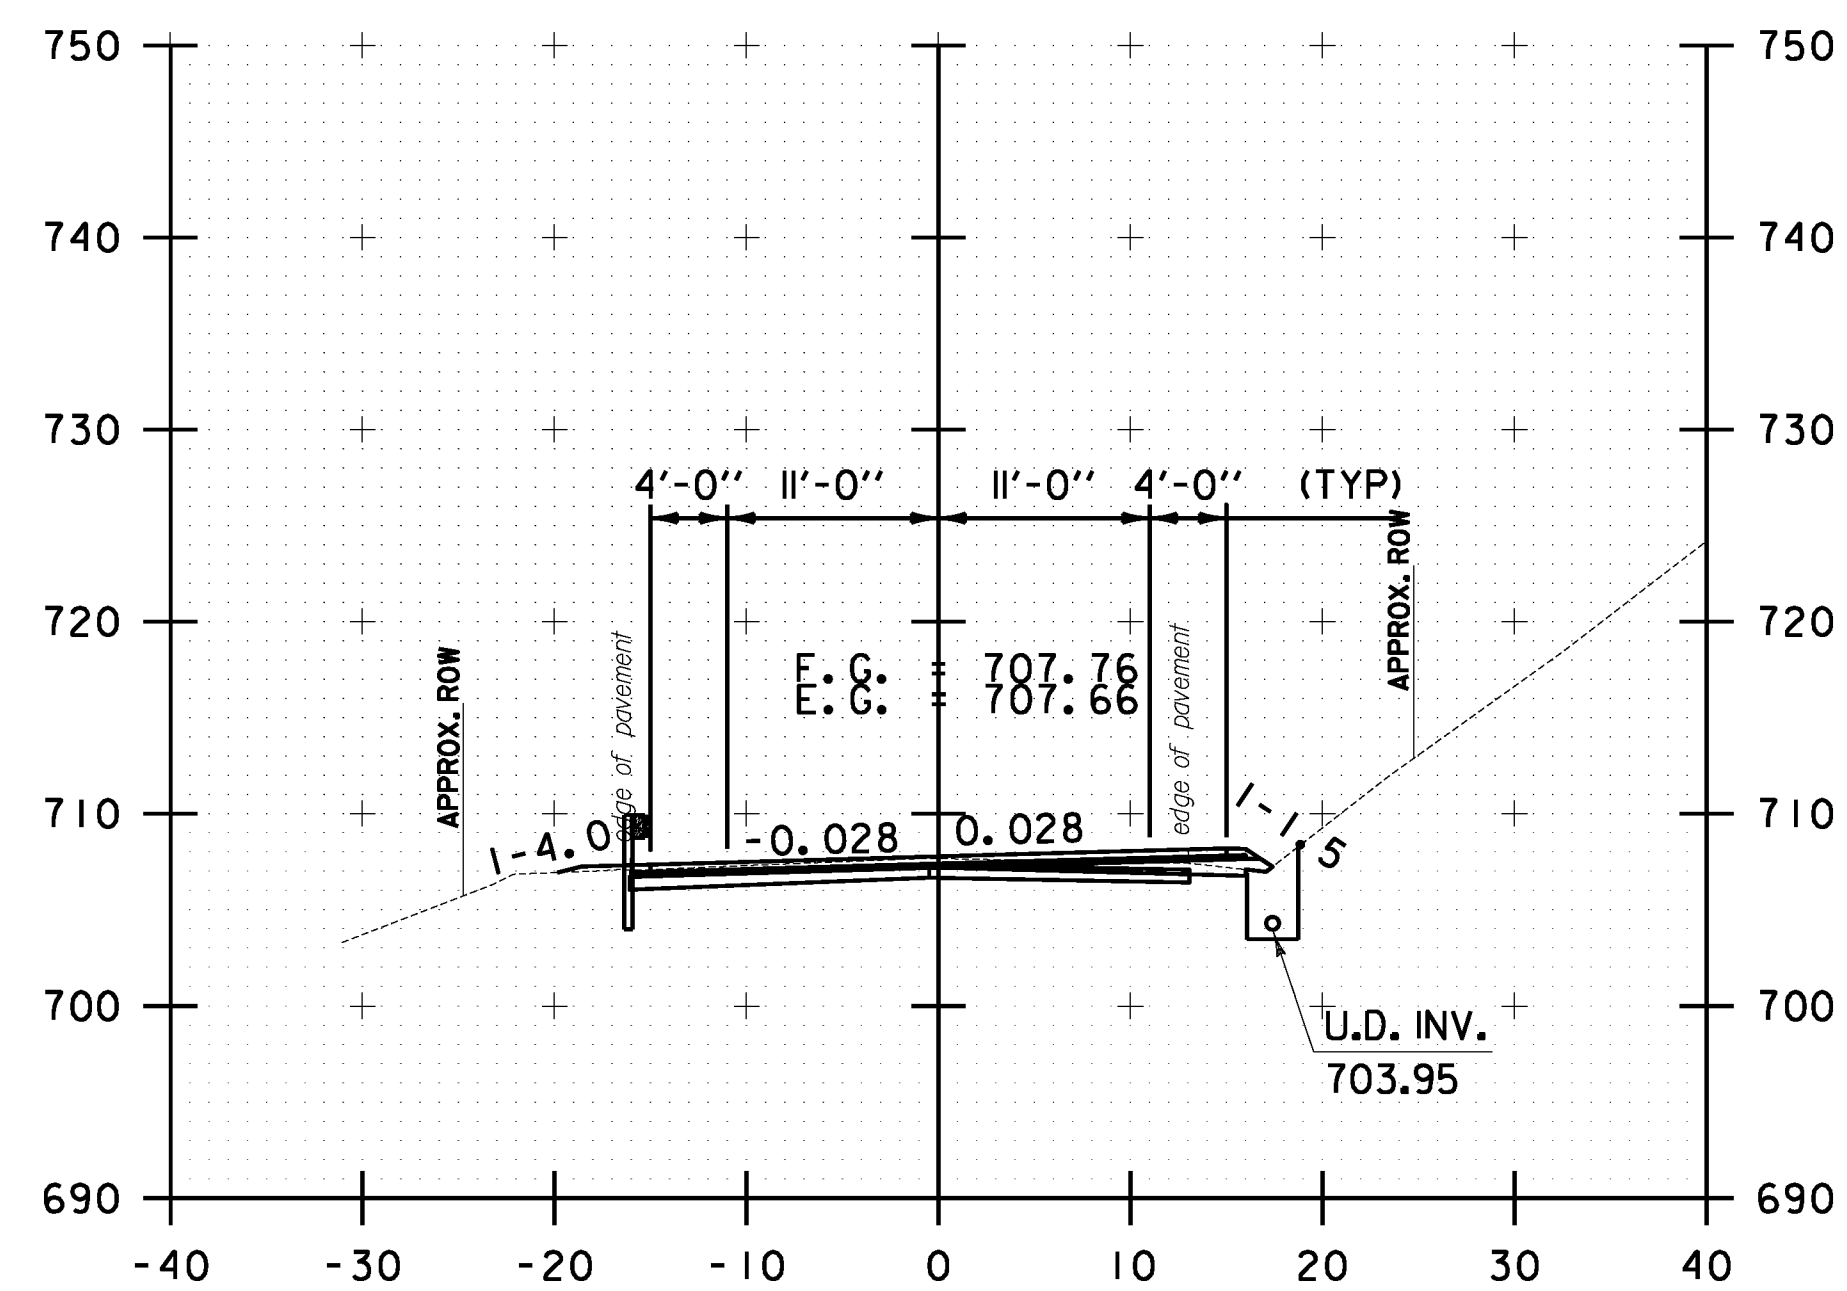

122+50.00

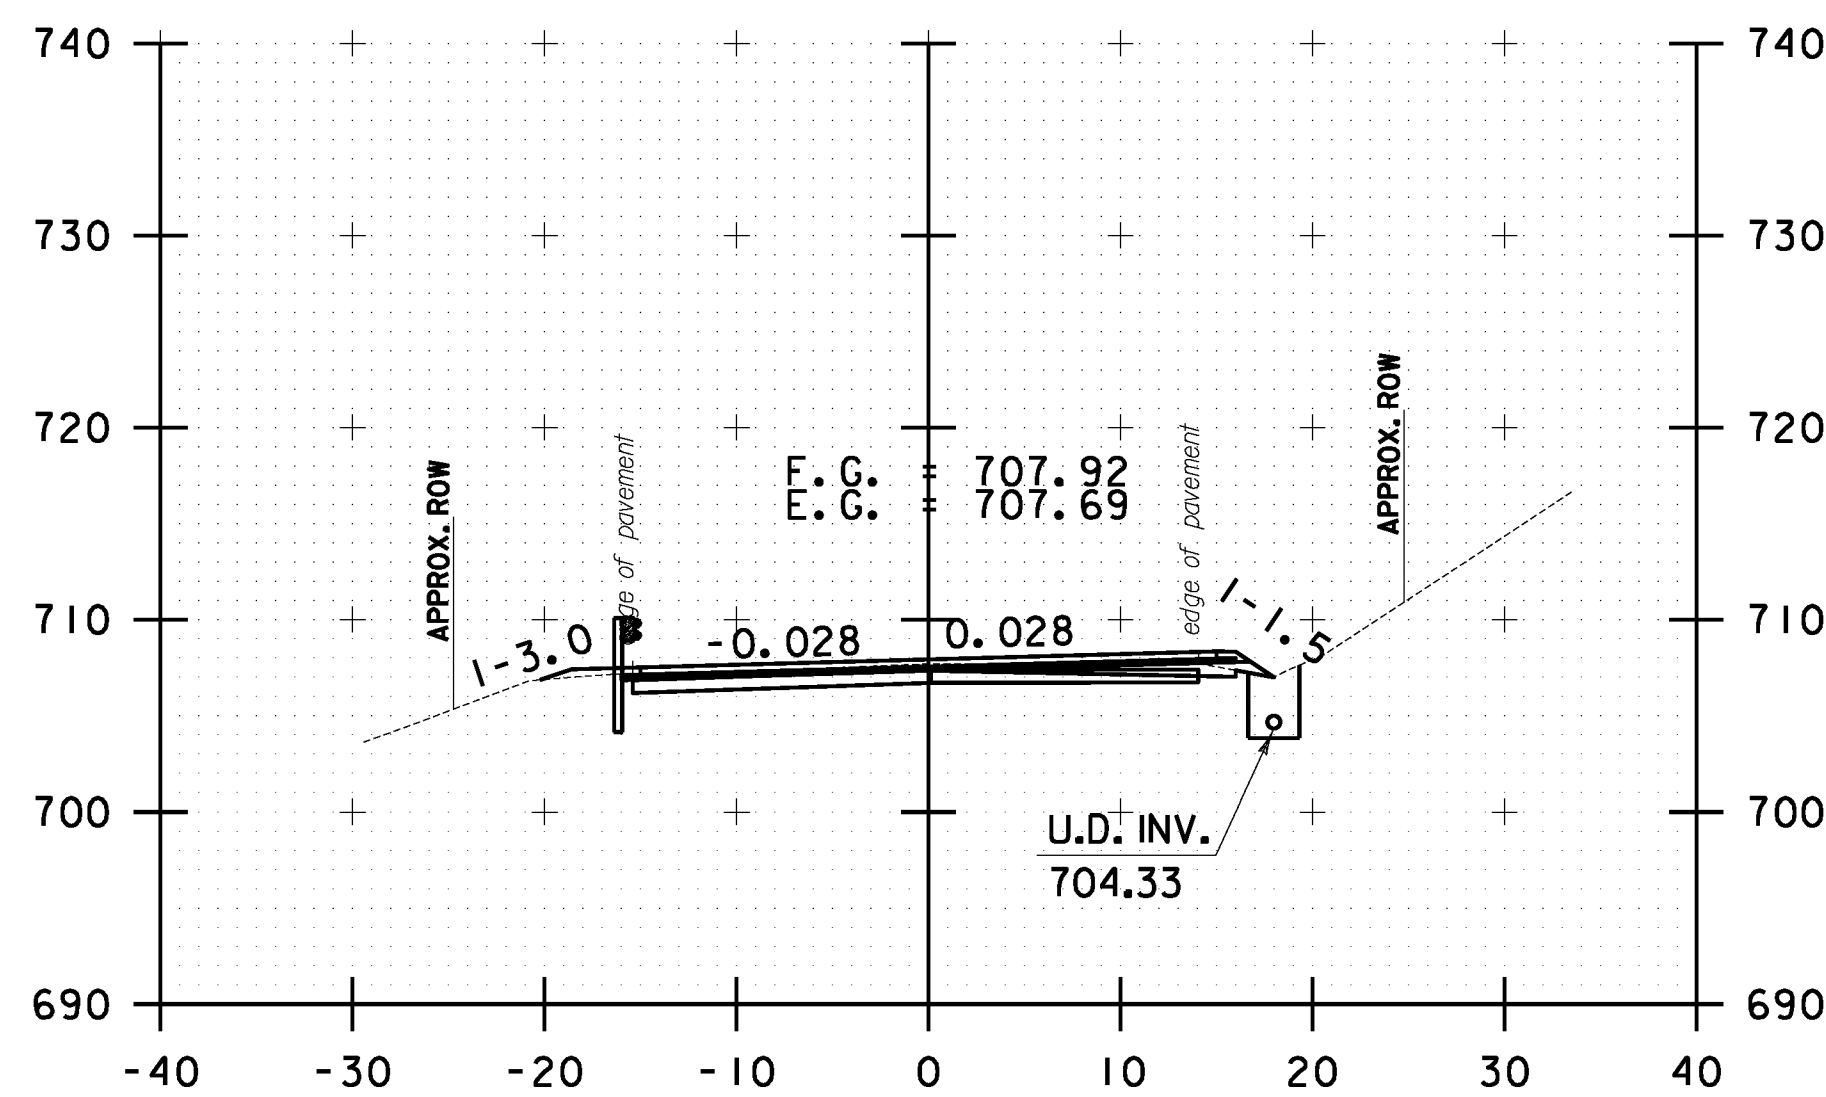

123+50.00

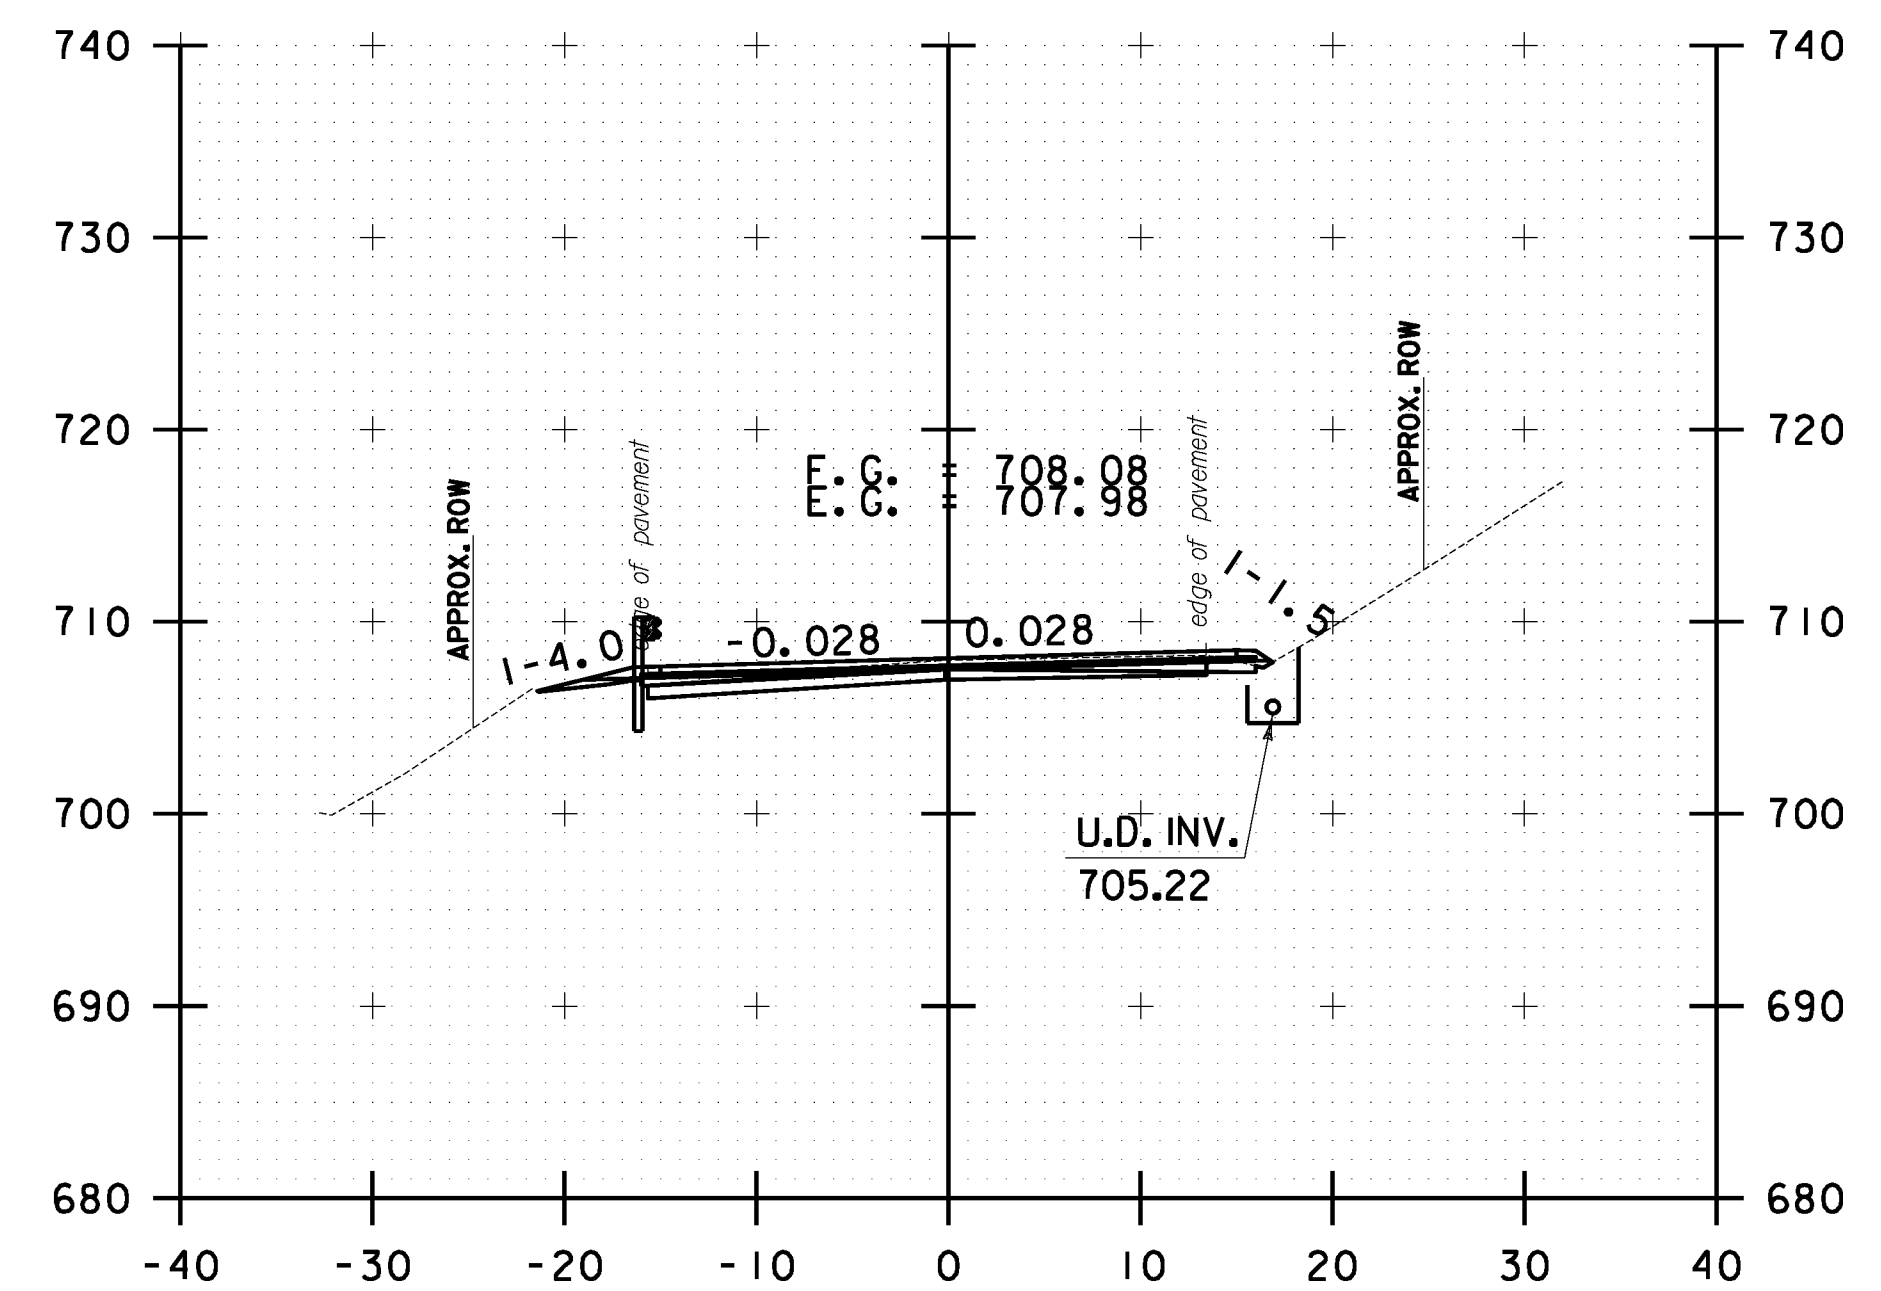

124+50.00



STOCKBRIDGE CROSS SECTION SHEET #41	PROJECT NAME: STOCKBRIDGE-BETHEL
	PROJECT NUMBER: STP 2910(1)
	FILE NAME: z10b214_stock.nc.dgn
DESIGNED BY: L.M.B.	PLOT DATE: 3/17/2014
IPARM FILE: z10b214xs41.1	DRAWN BY: W.G.P.
	CHECKED BY: J.P.S.
	SHEET 254 OF 397