




FILE NAME = Y:\P\c\p\stock\ANY\X2\22425\CADD\MSTN\10b214_stock.nc.dgn
 DATE/TIME = 3/17/2014
 USER = 4916

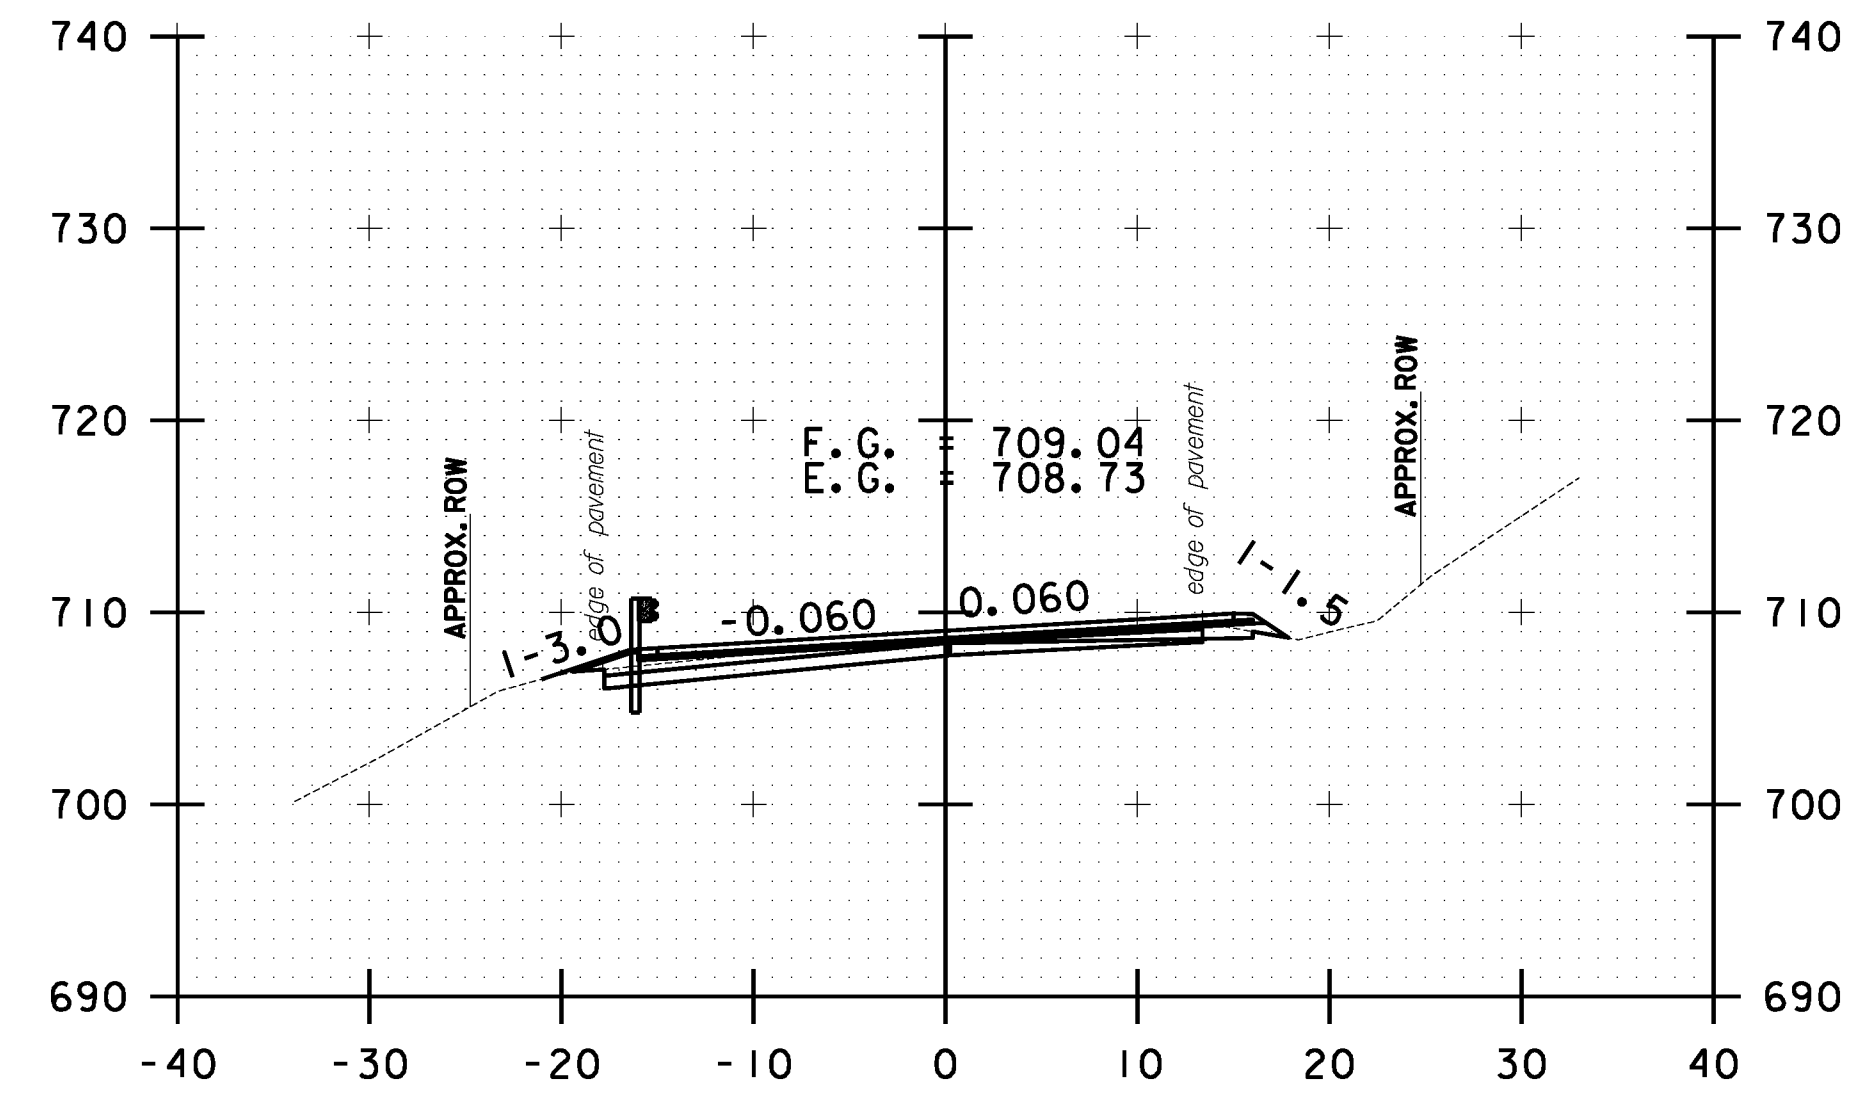


129+00.00

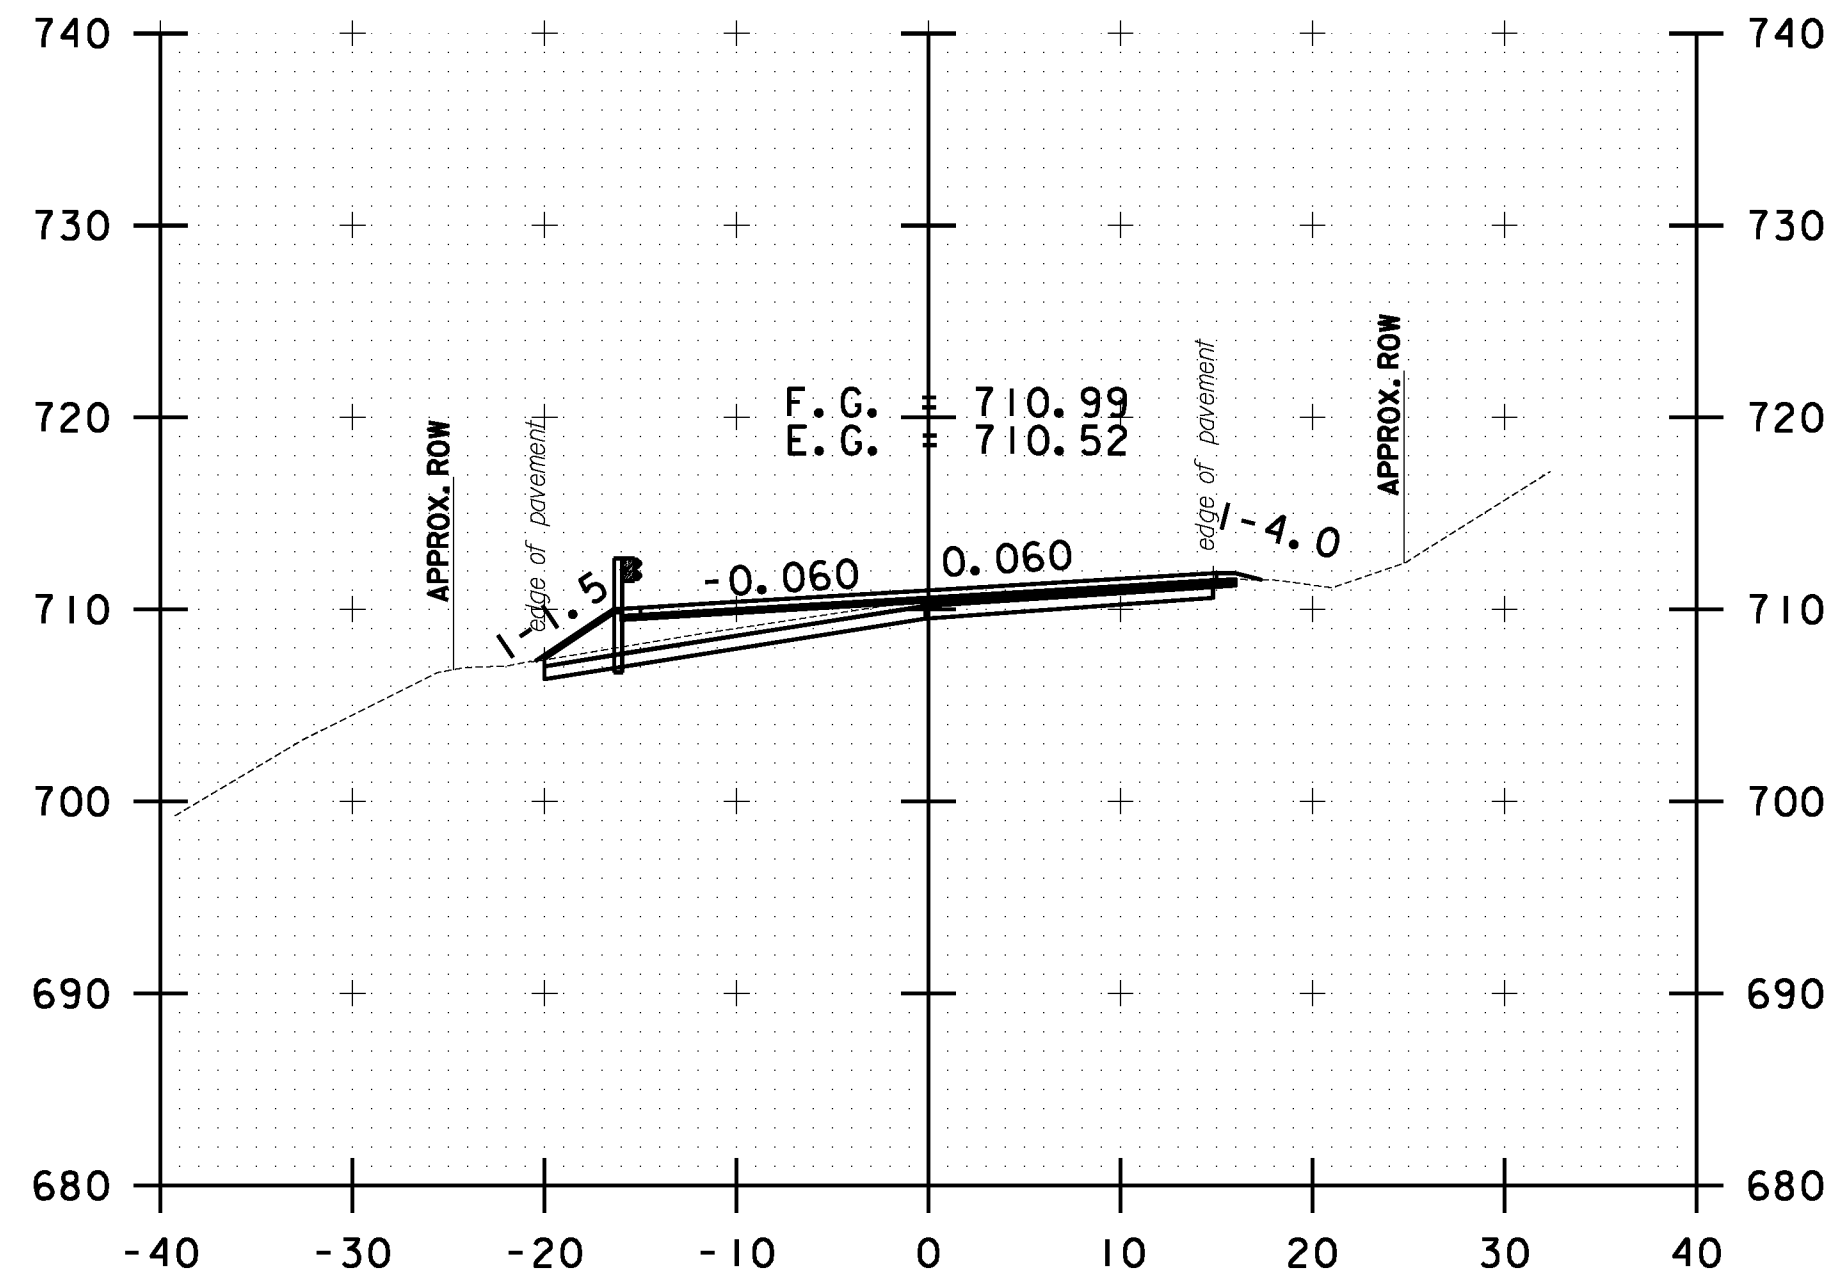


130+00.00

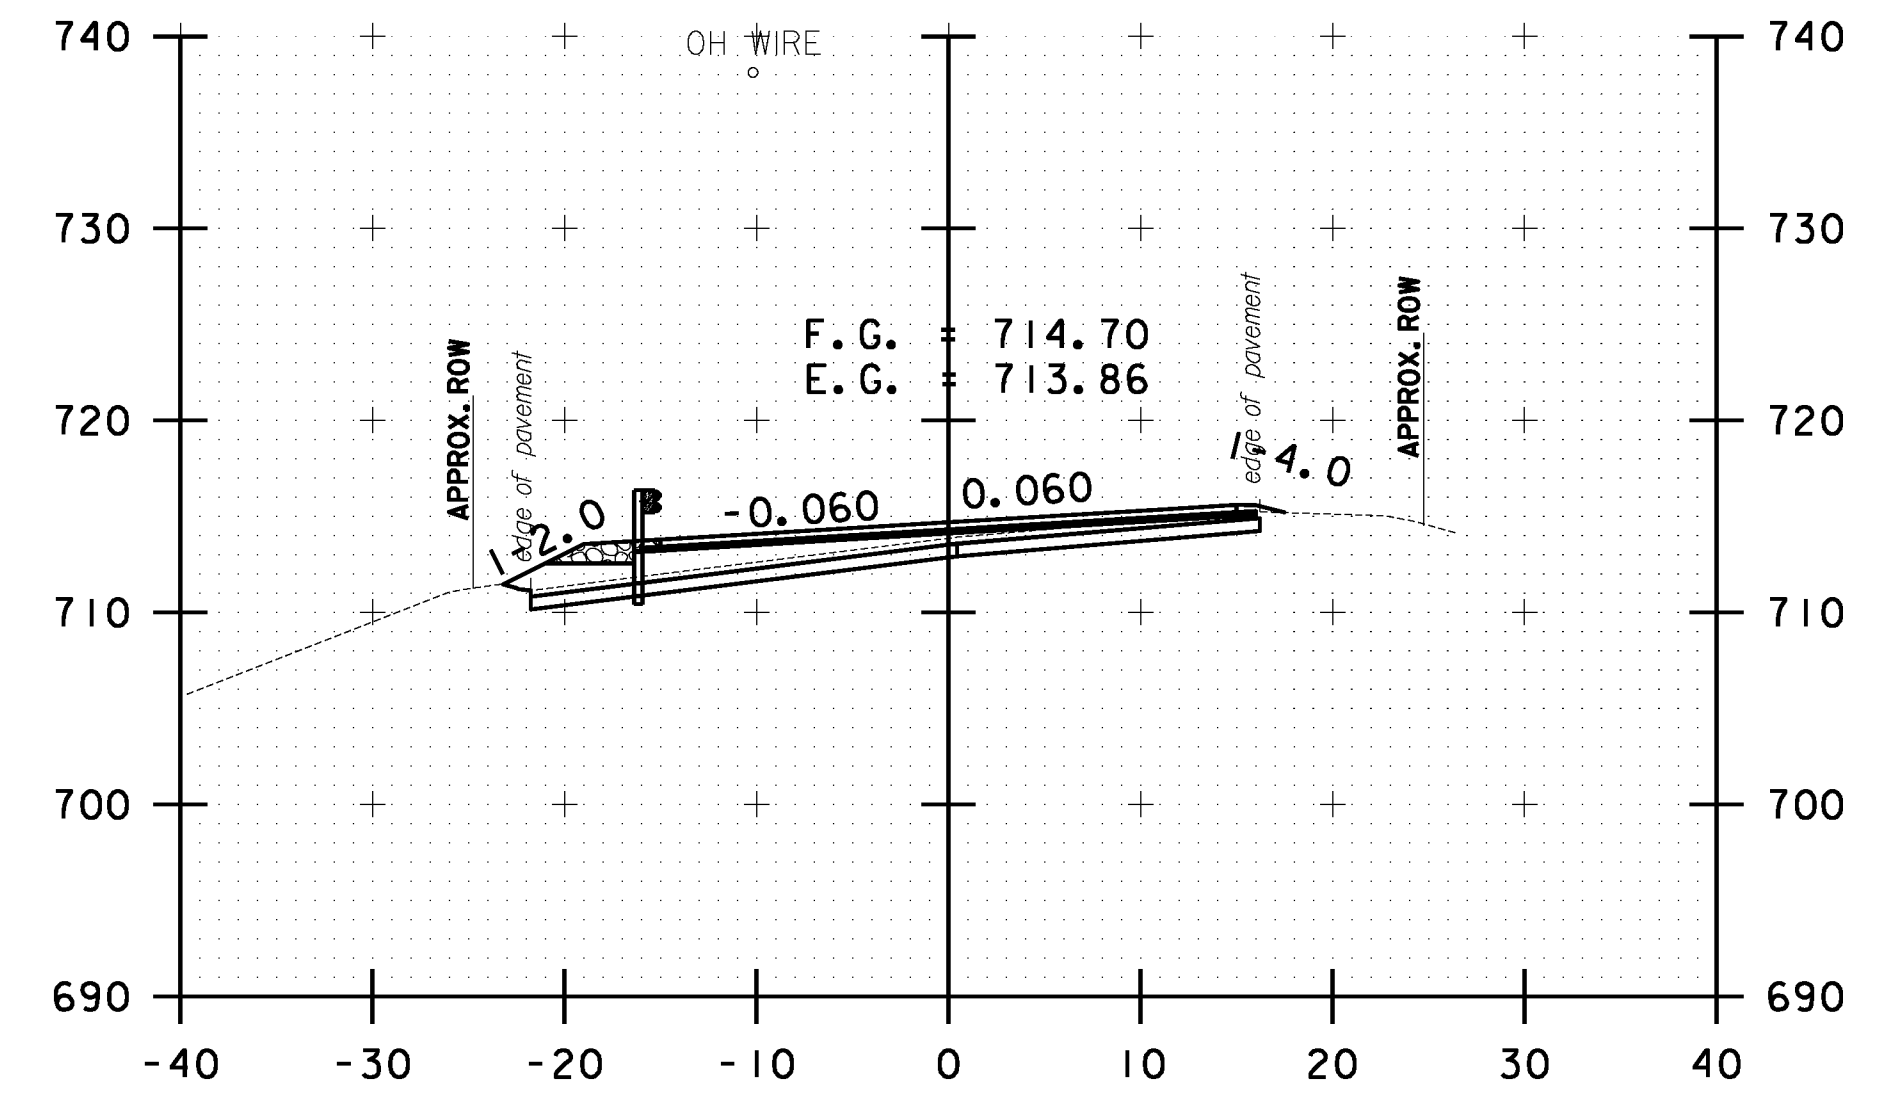


131+00.00

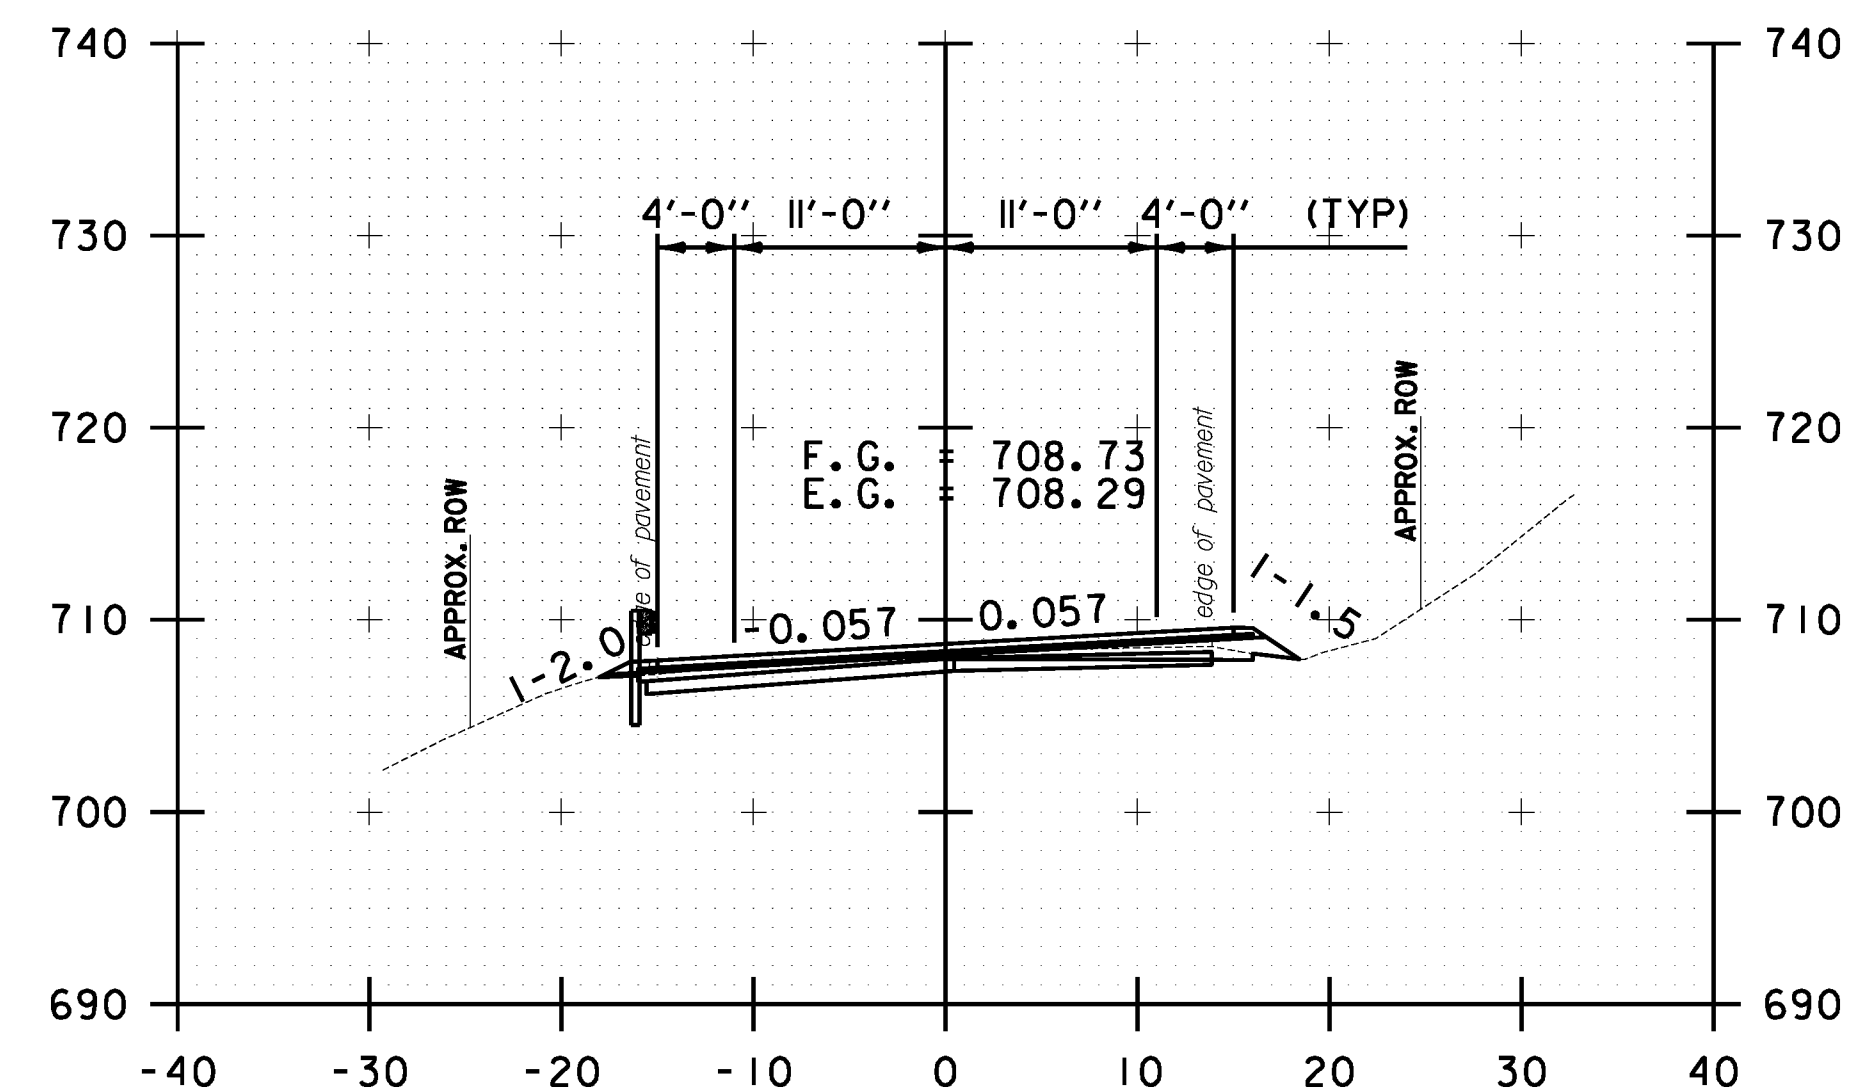


128+50.00

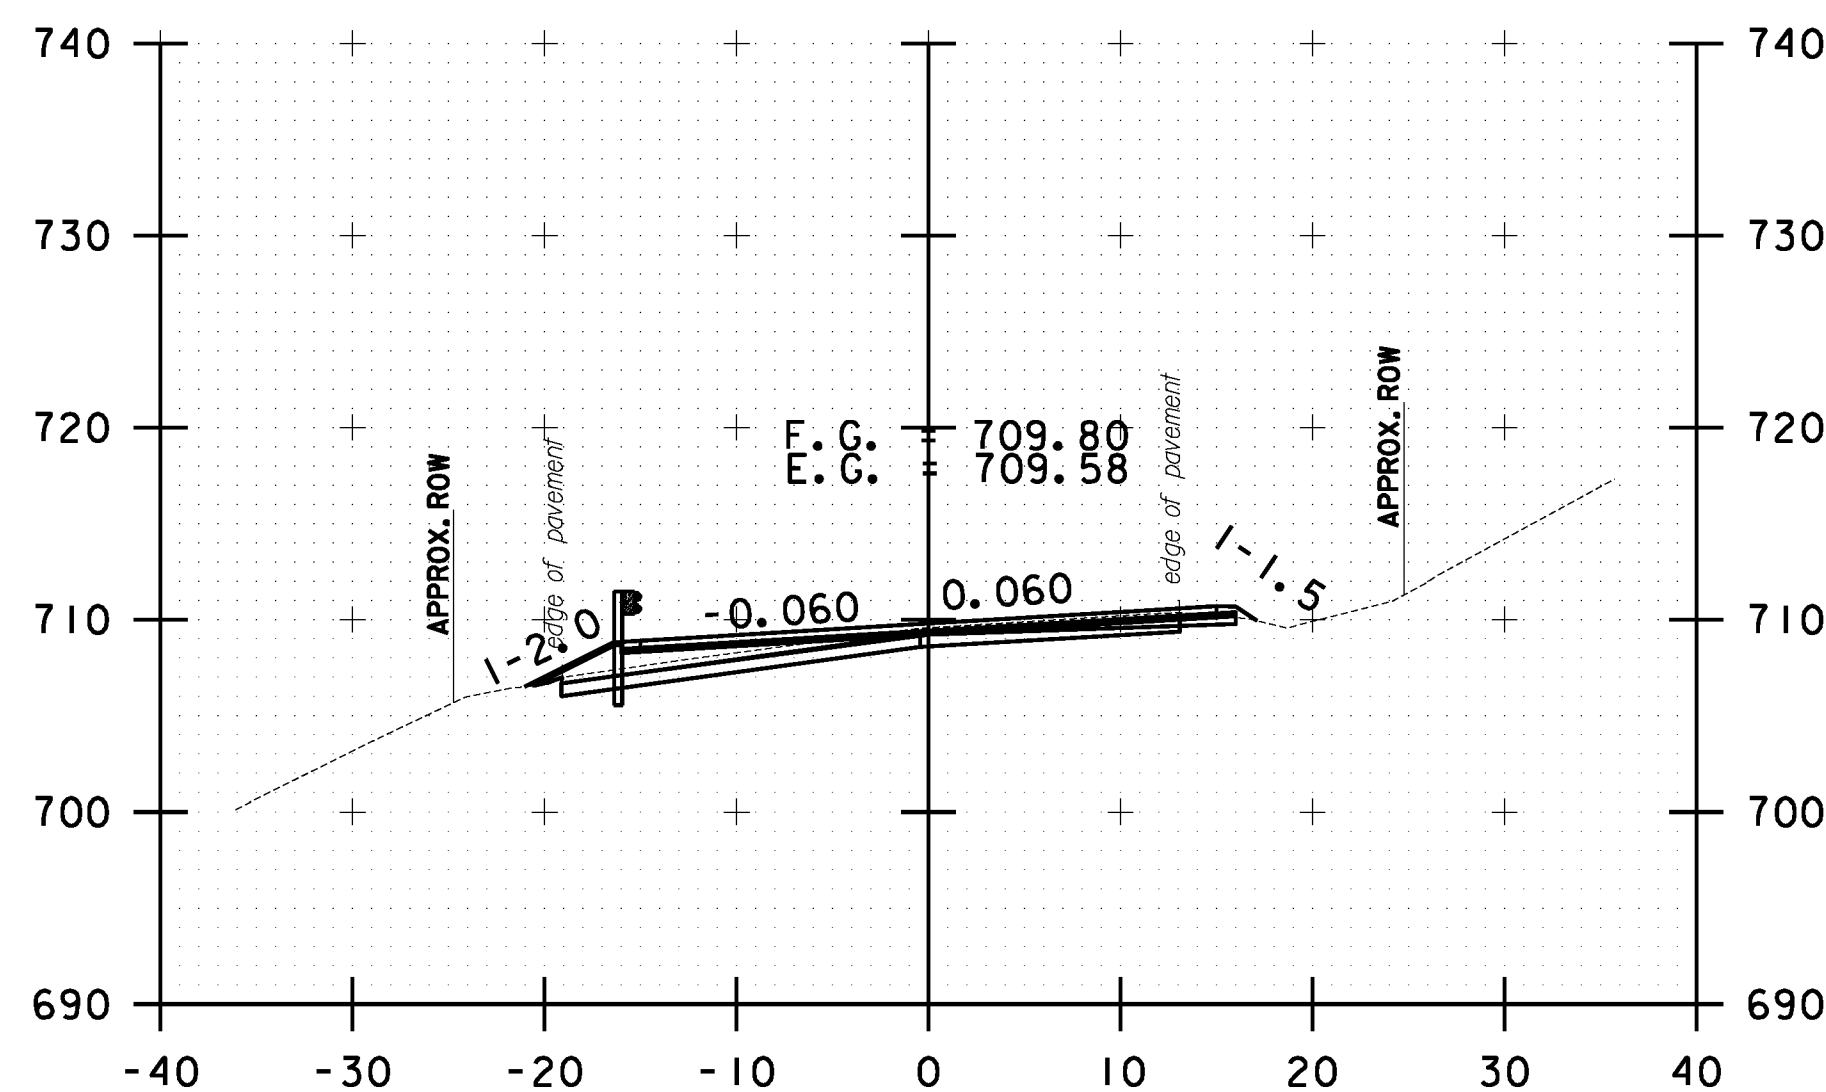

129+50.00

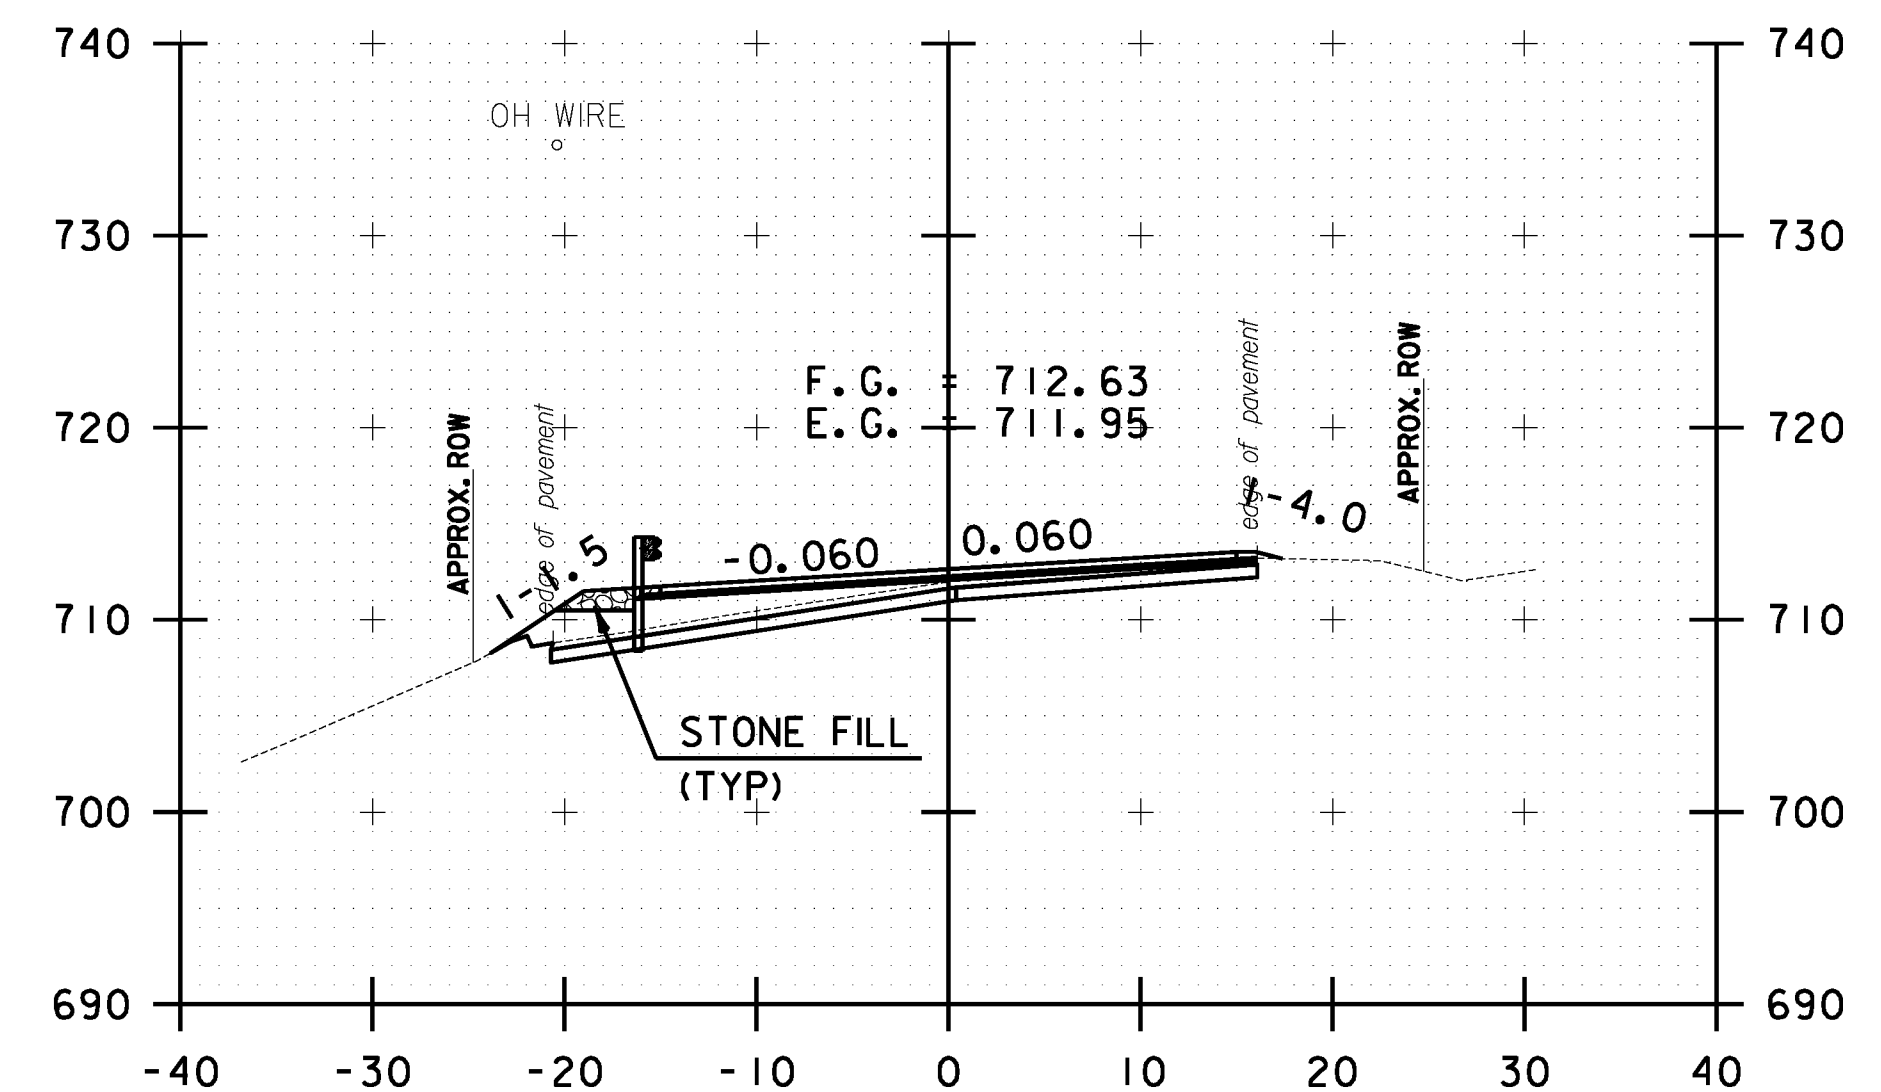

130+50.00

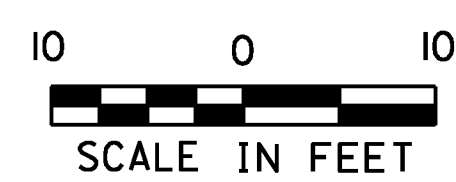

STOCKBRIDGE CROSS SECTION SHEET #43	PROJECT NAME: STOCKBRIDGE-BETHEL
	PROJECT NUMBER: STP 2910(1)
	FILE NAME: z10b214_stock.xc.dgn
DESIGNED BY: L.M.B.	PLOT DATE: 3/17/2014
IPARM FILE: z10b214xs43.1	DRAWN BY: W.G.P.
	CHECKED BY: J.P.S.
	SHEET 256 OF 397