




FILE NAME = Y:\P\c\res\any\k2\22426\CADD\MSTN\10b214_stock_xc.dgn
 DATE/TIME = 3/17/2014
 USER = 4916

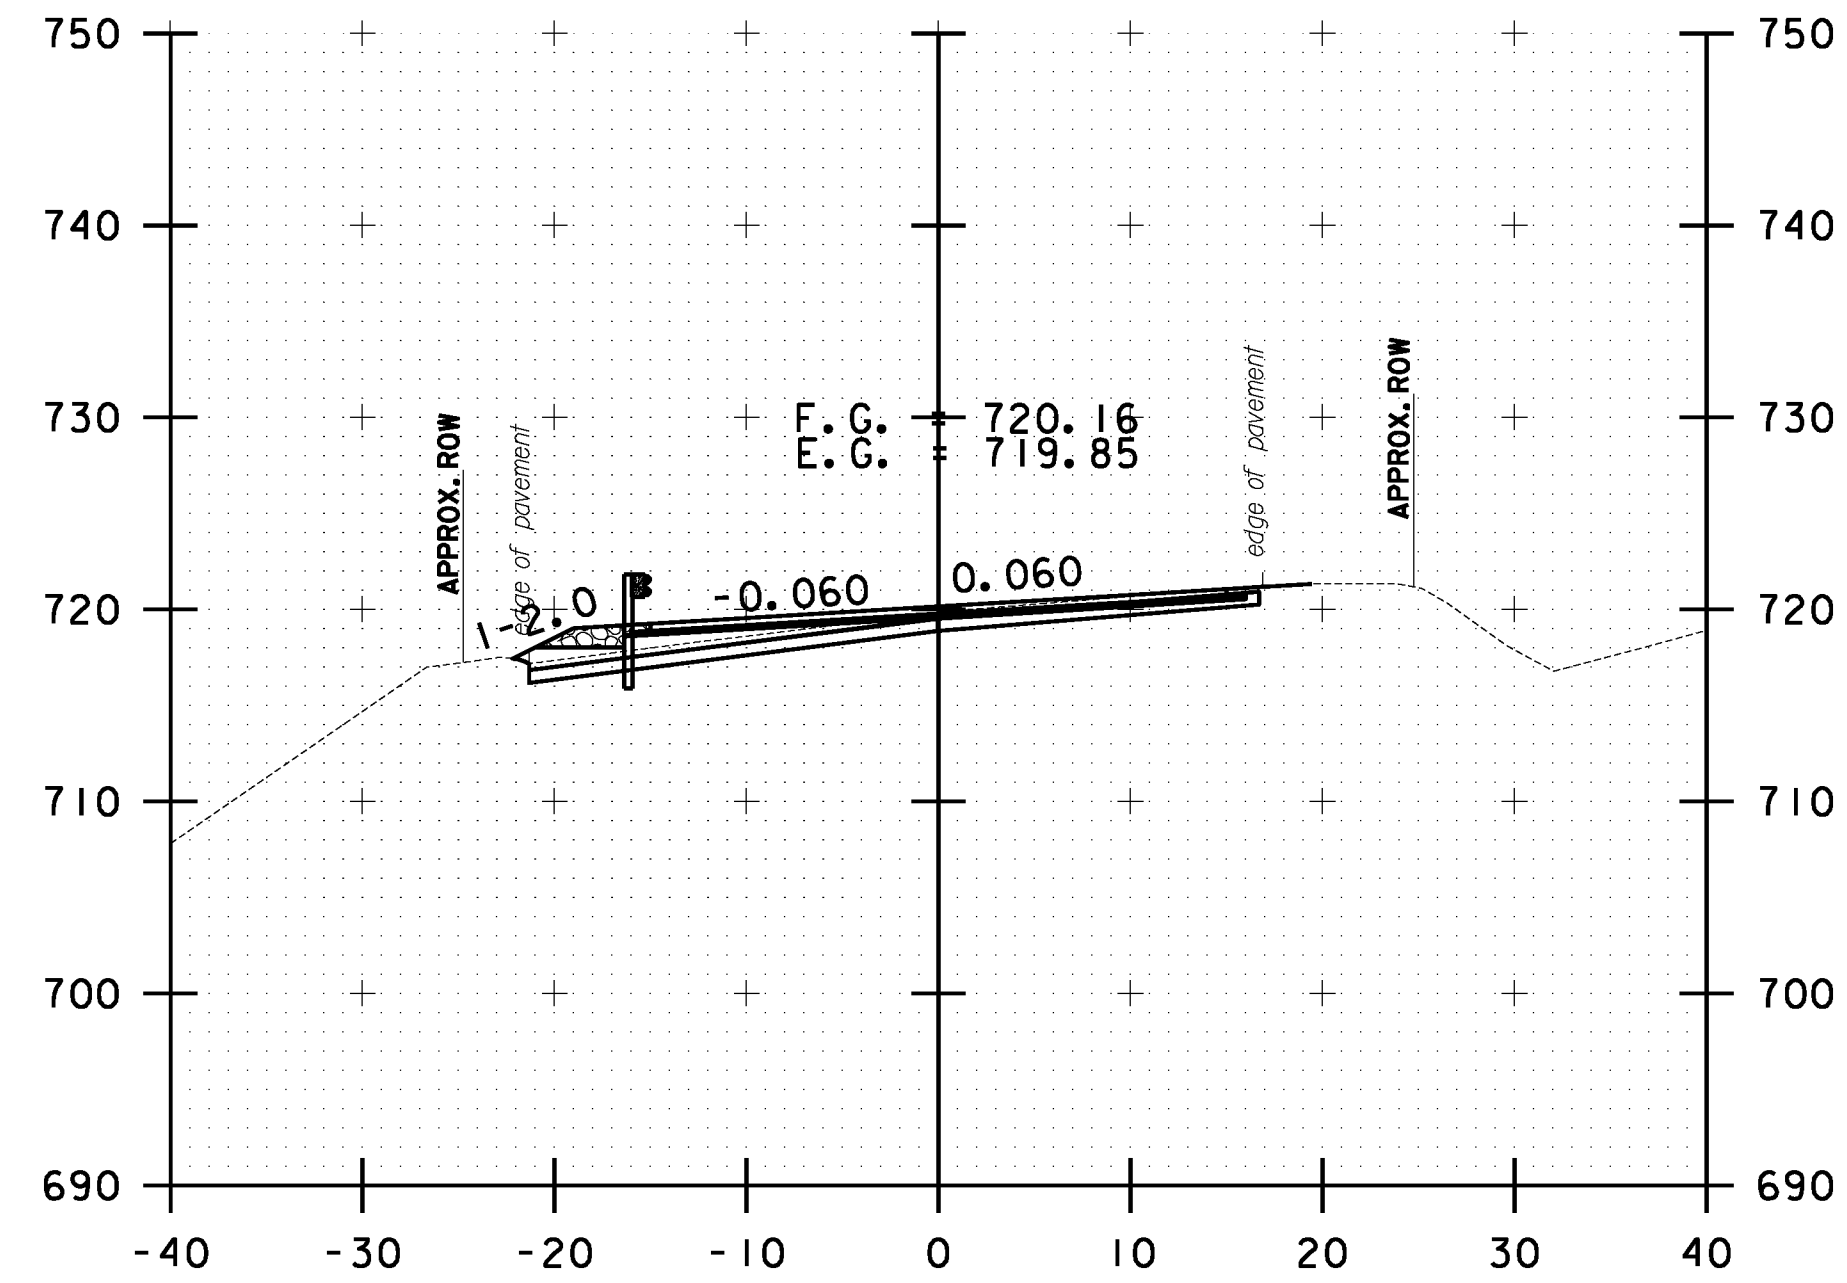


132+00.00

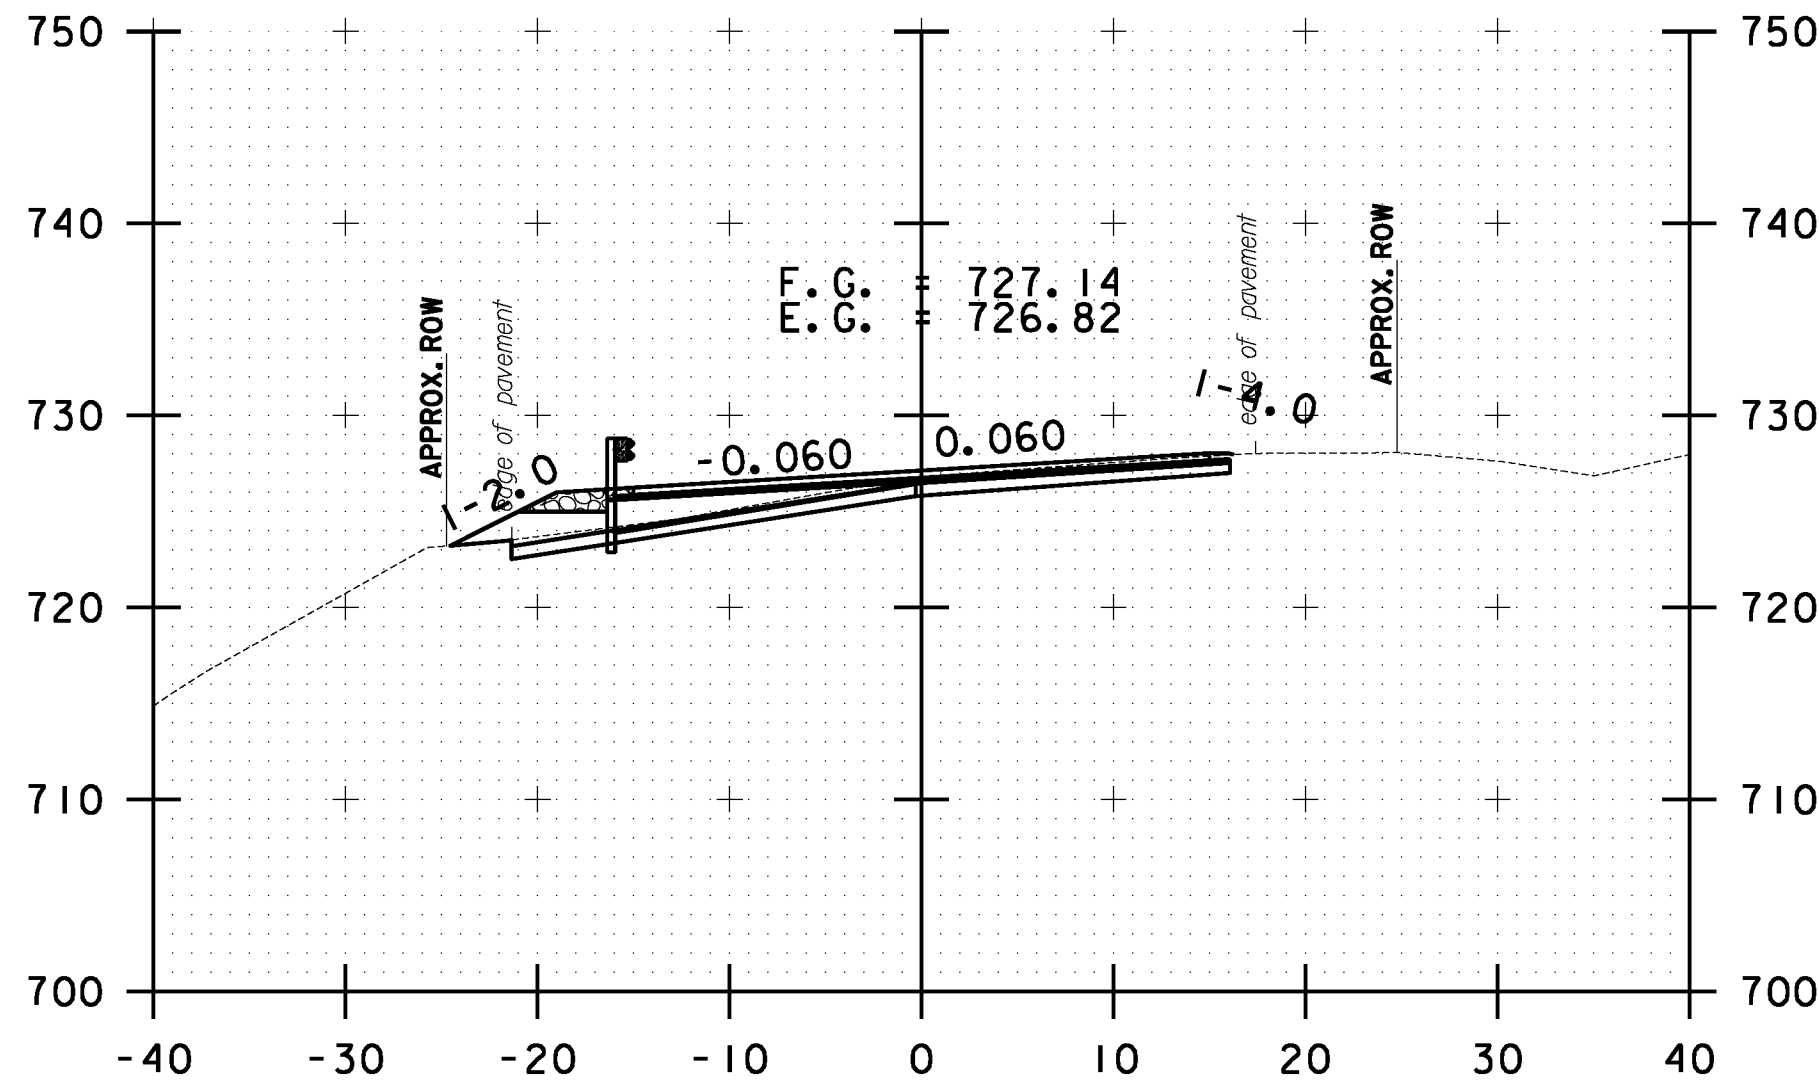


133+00.00

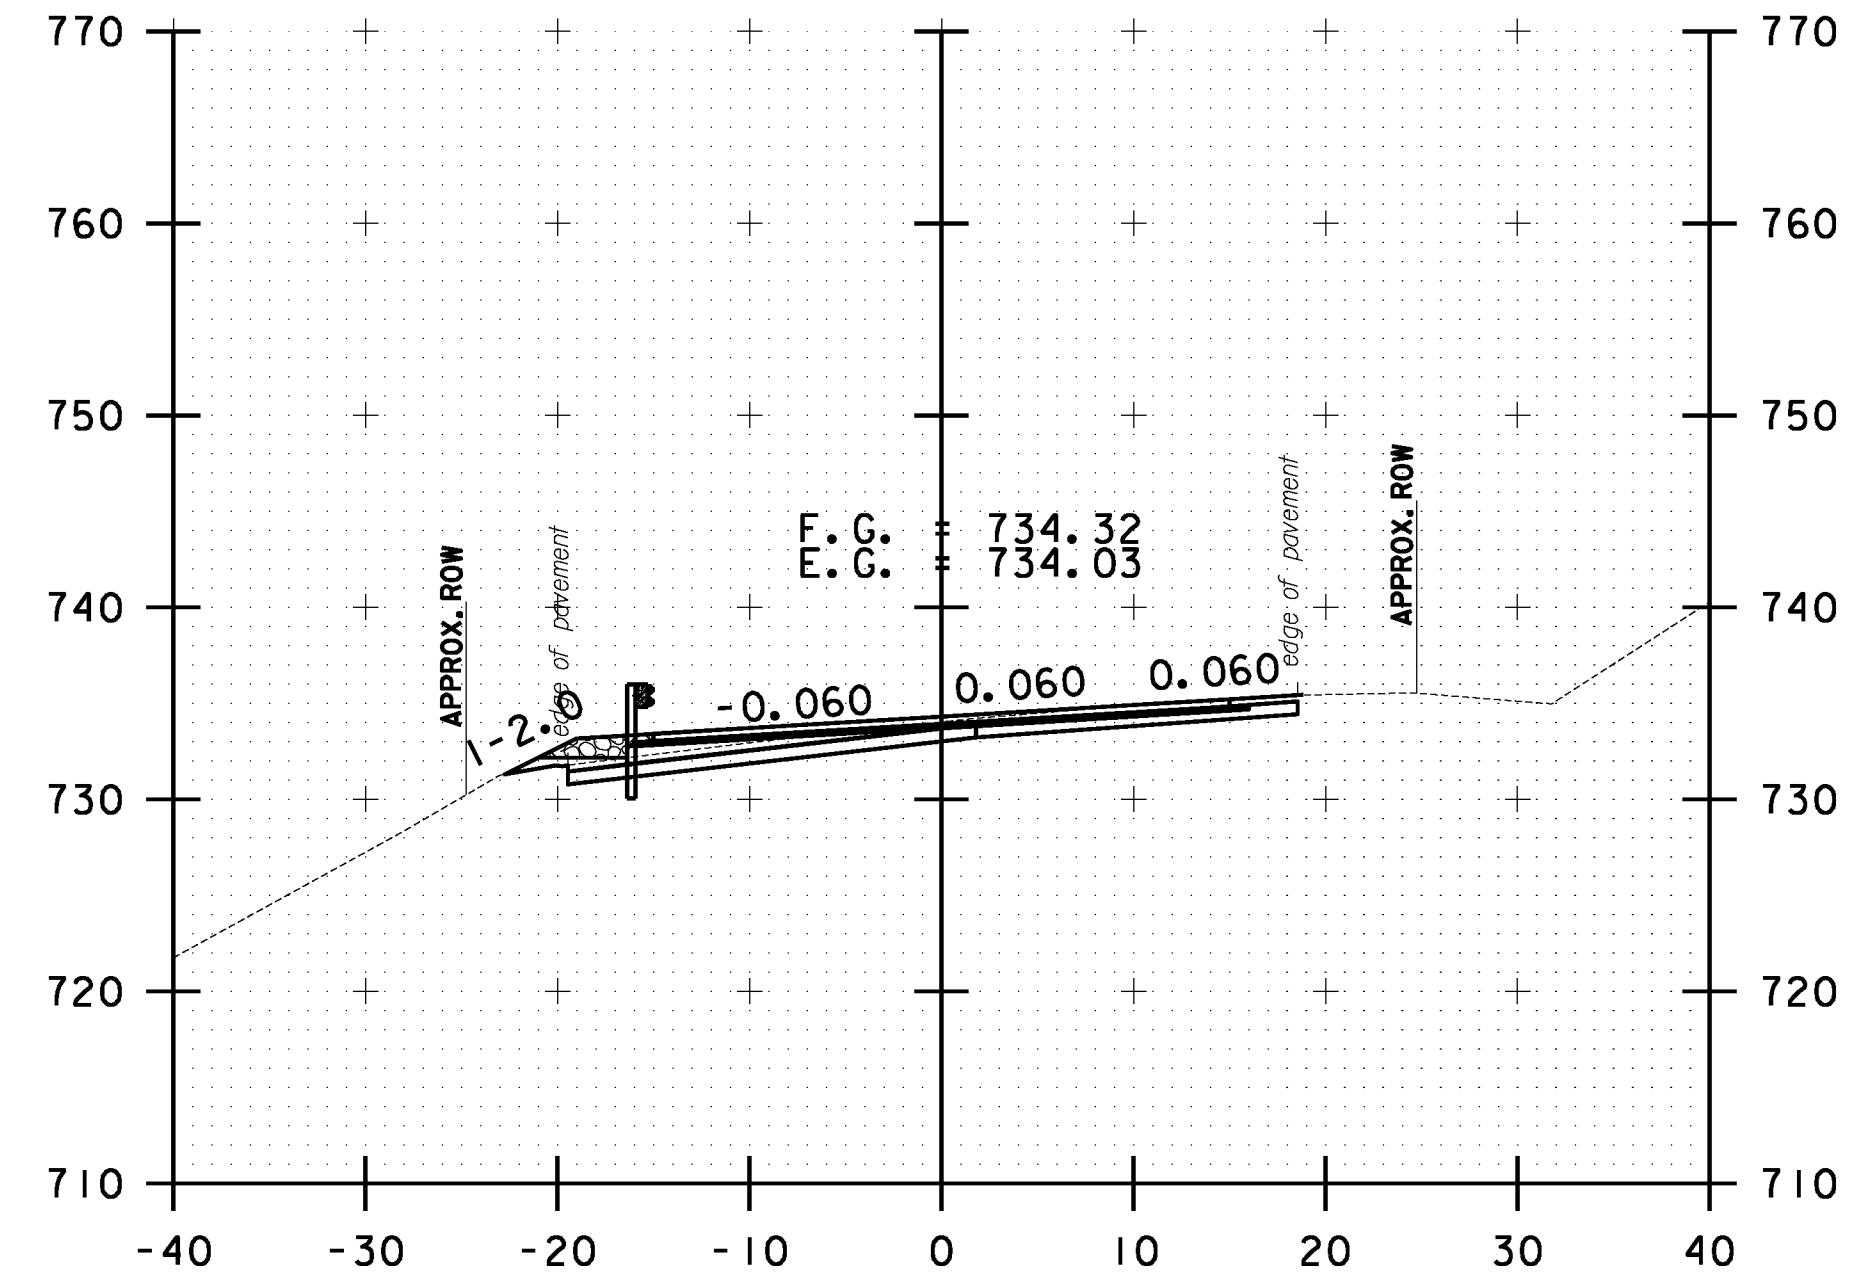


134+00.00

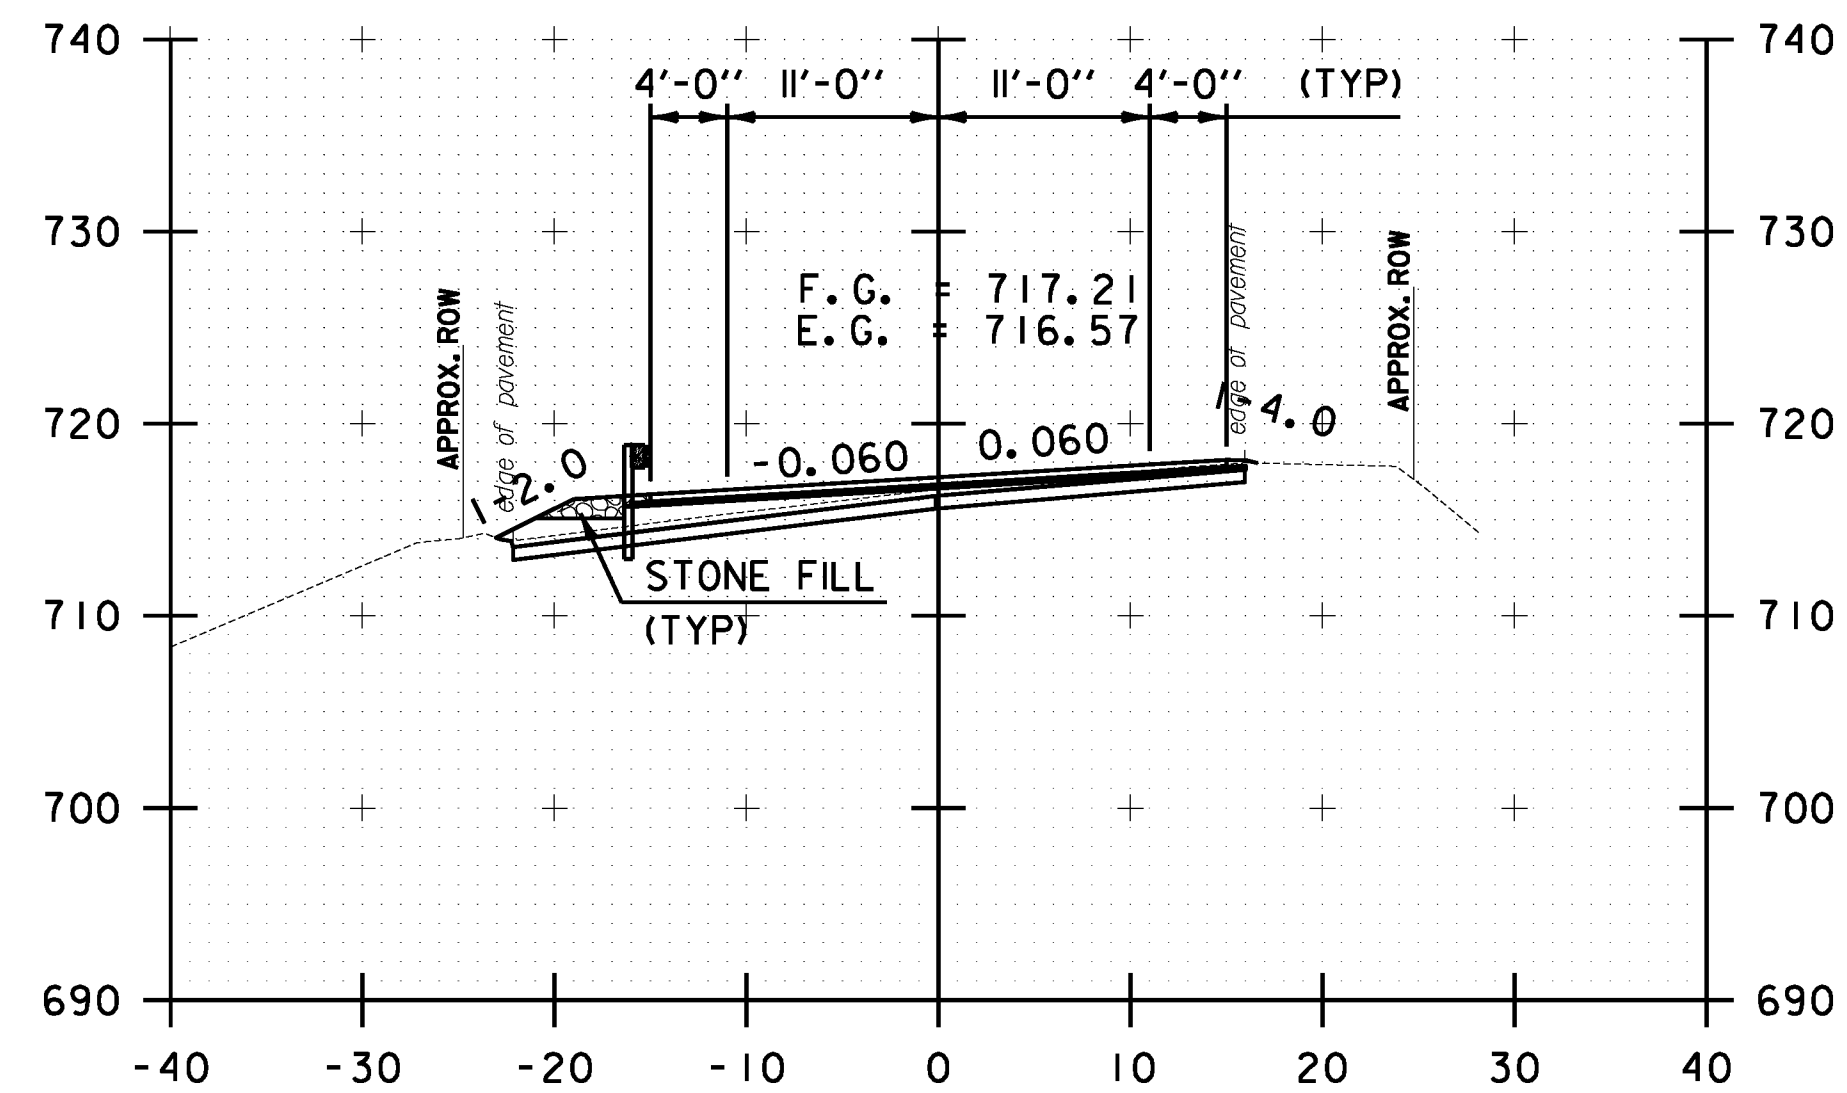


131+50.00

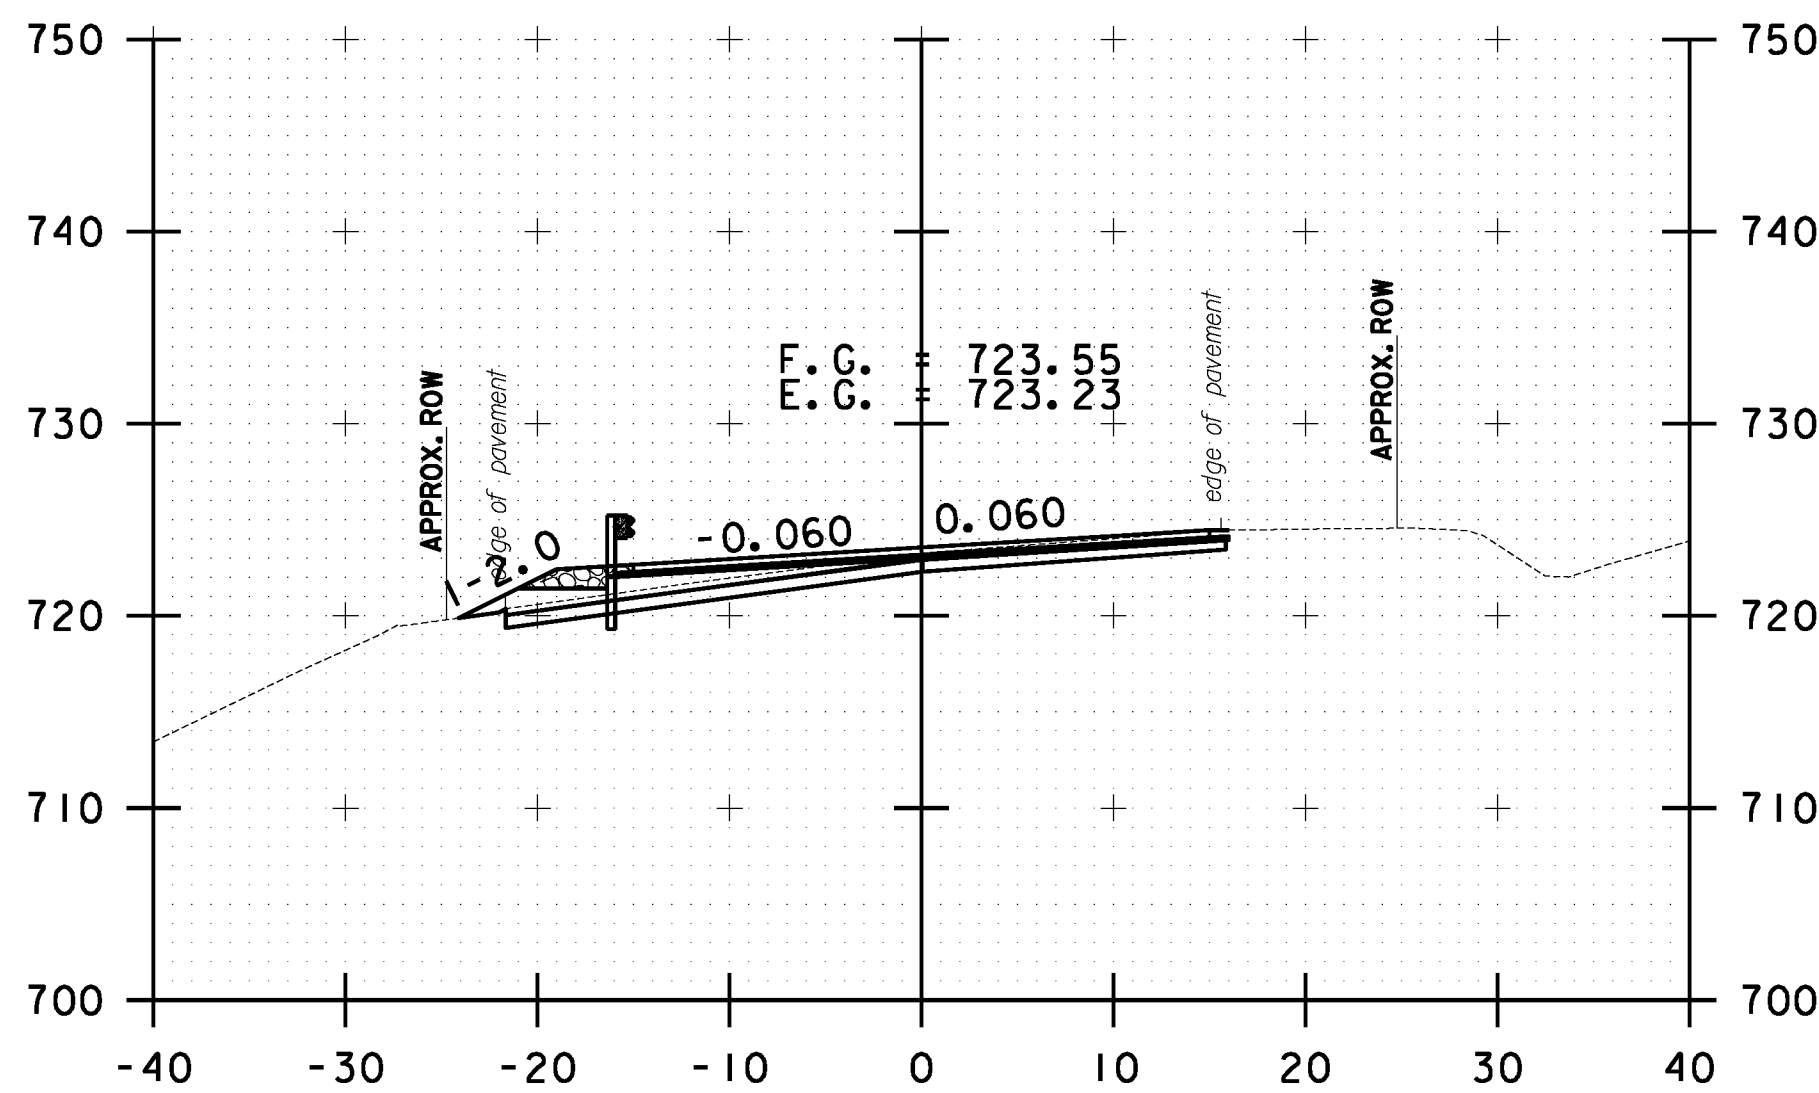

132+50.00

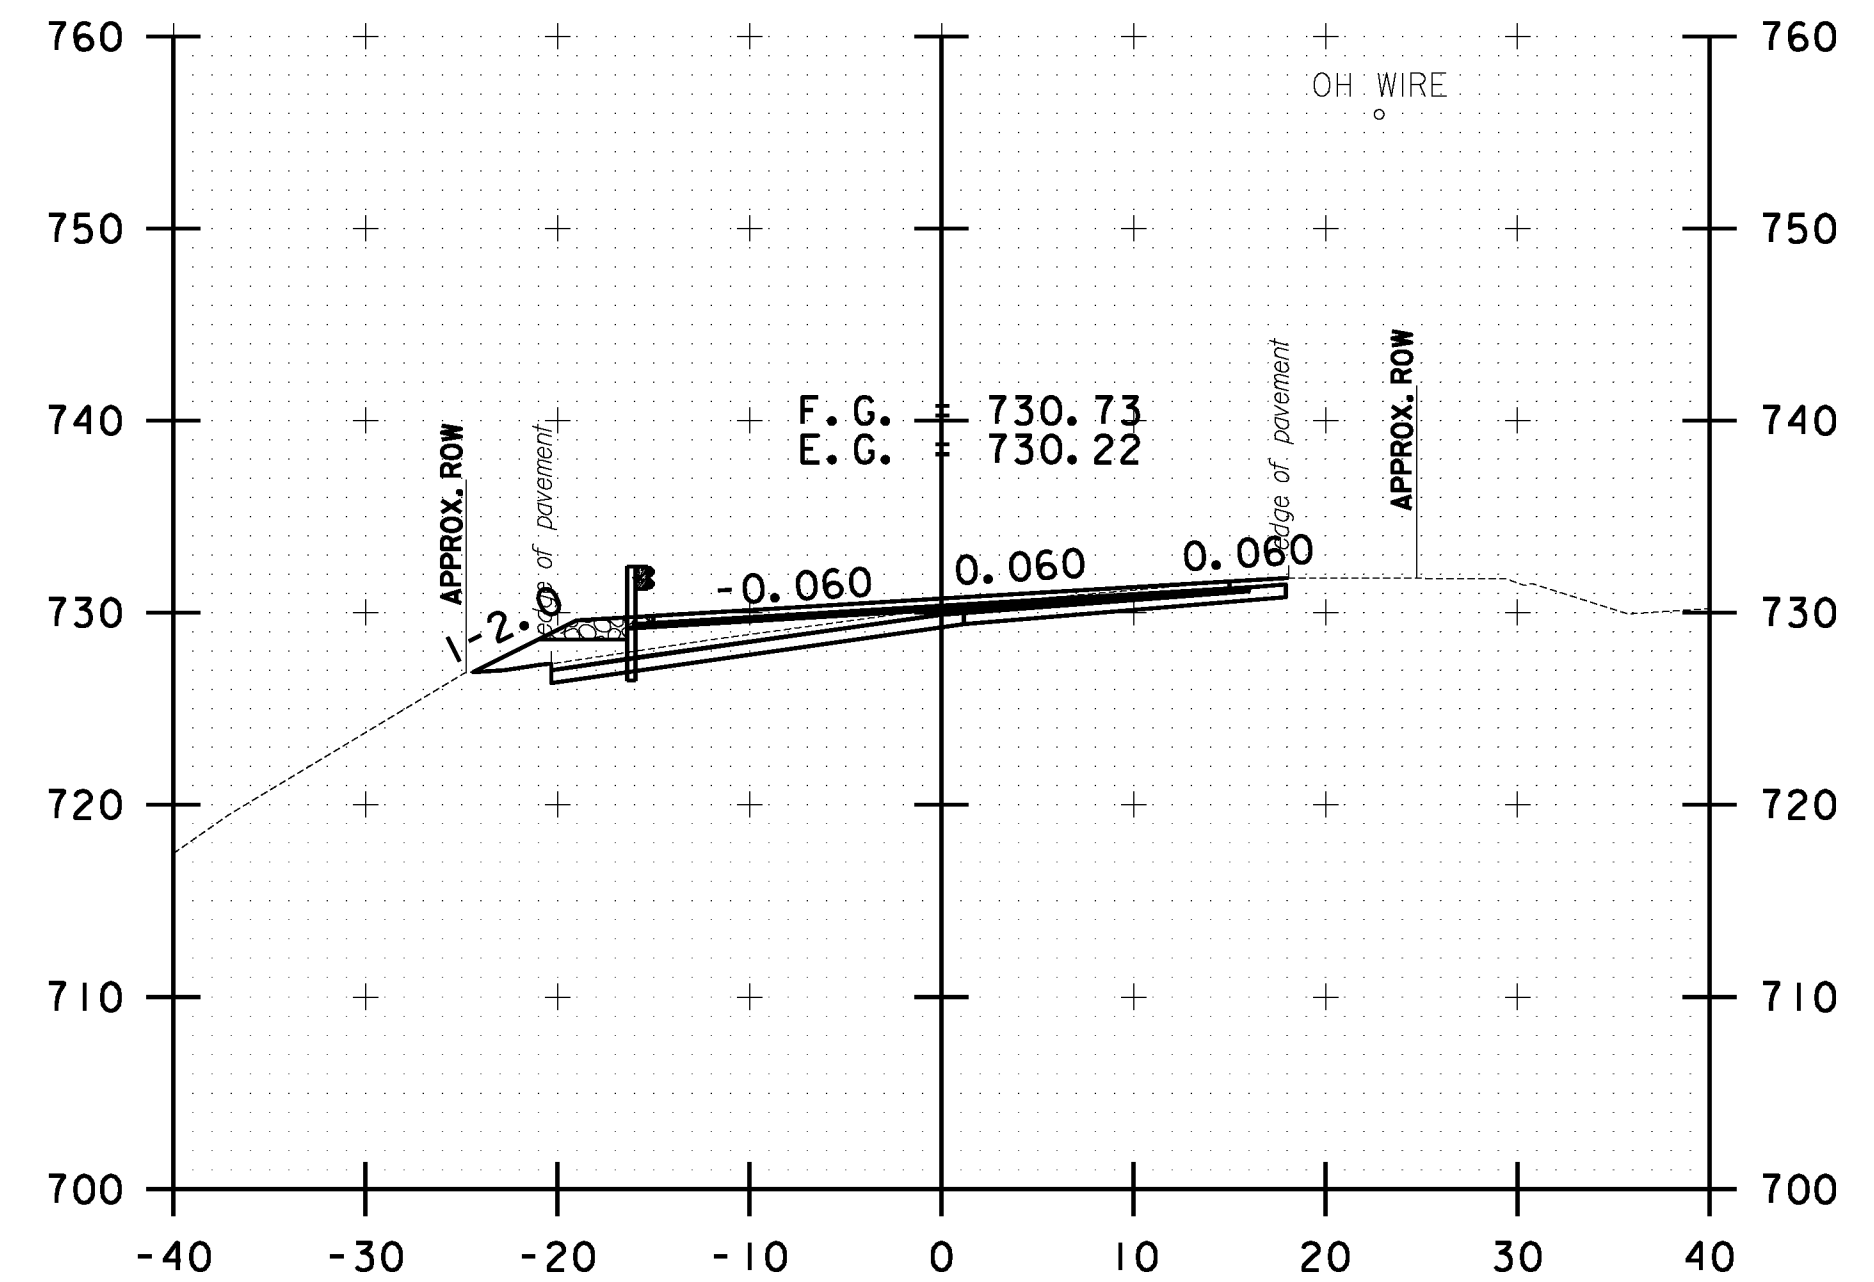

133+50.00

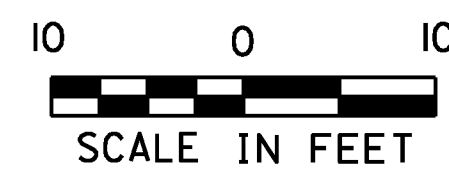

STOCKBRIDGE CROSS SECTION SHEET #44	PROJECT NAME: STOCKBRIDGE-BETHEL
	PROJECT NUMBER: STP 2910(1)
	FILE NAME: z10b214_stock_xc.dgn
	PLOT DATE: 3/17/2014
DESIGNED BY: L.M.B.	DRAWN BY: W.G.P.
IPARM FILE: z10b214xs44.1	CHECKED BY: J.P.S.
	SHEET 257 OF 397