




FILE NAME = Y:\P\c\jess\ANY\K2\22425\CADD\MSTN\10b214\_stock\_xc.dgn  
 DATE/TIME = 3/17/2014  
 USER = 4916

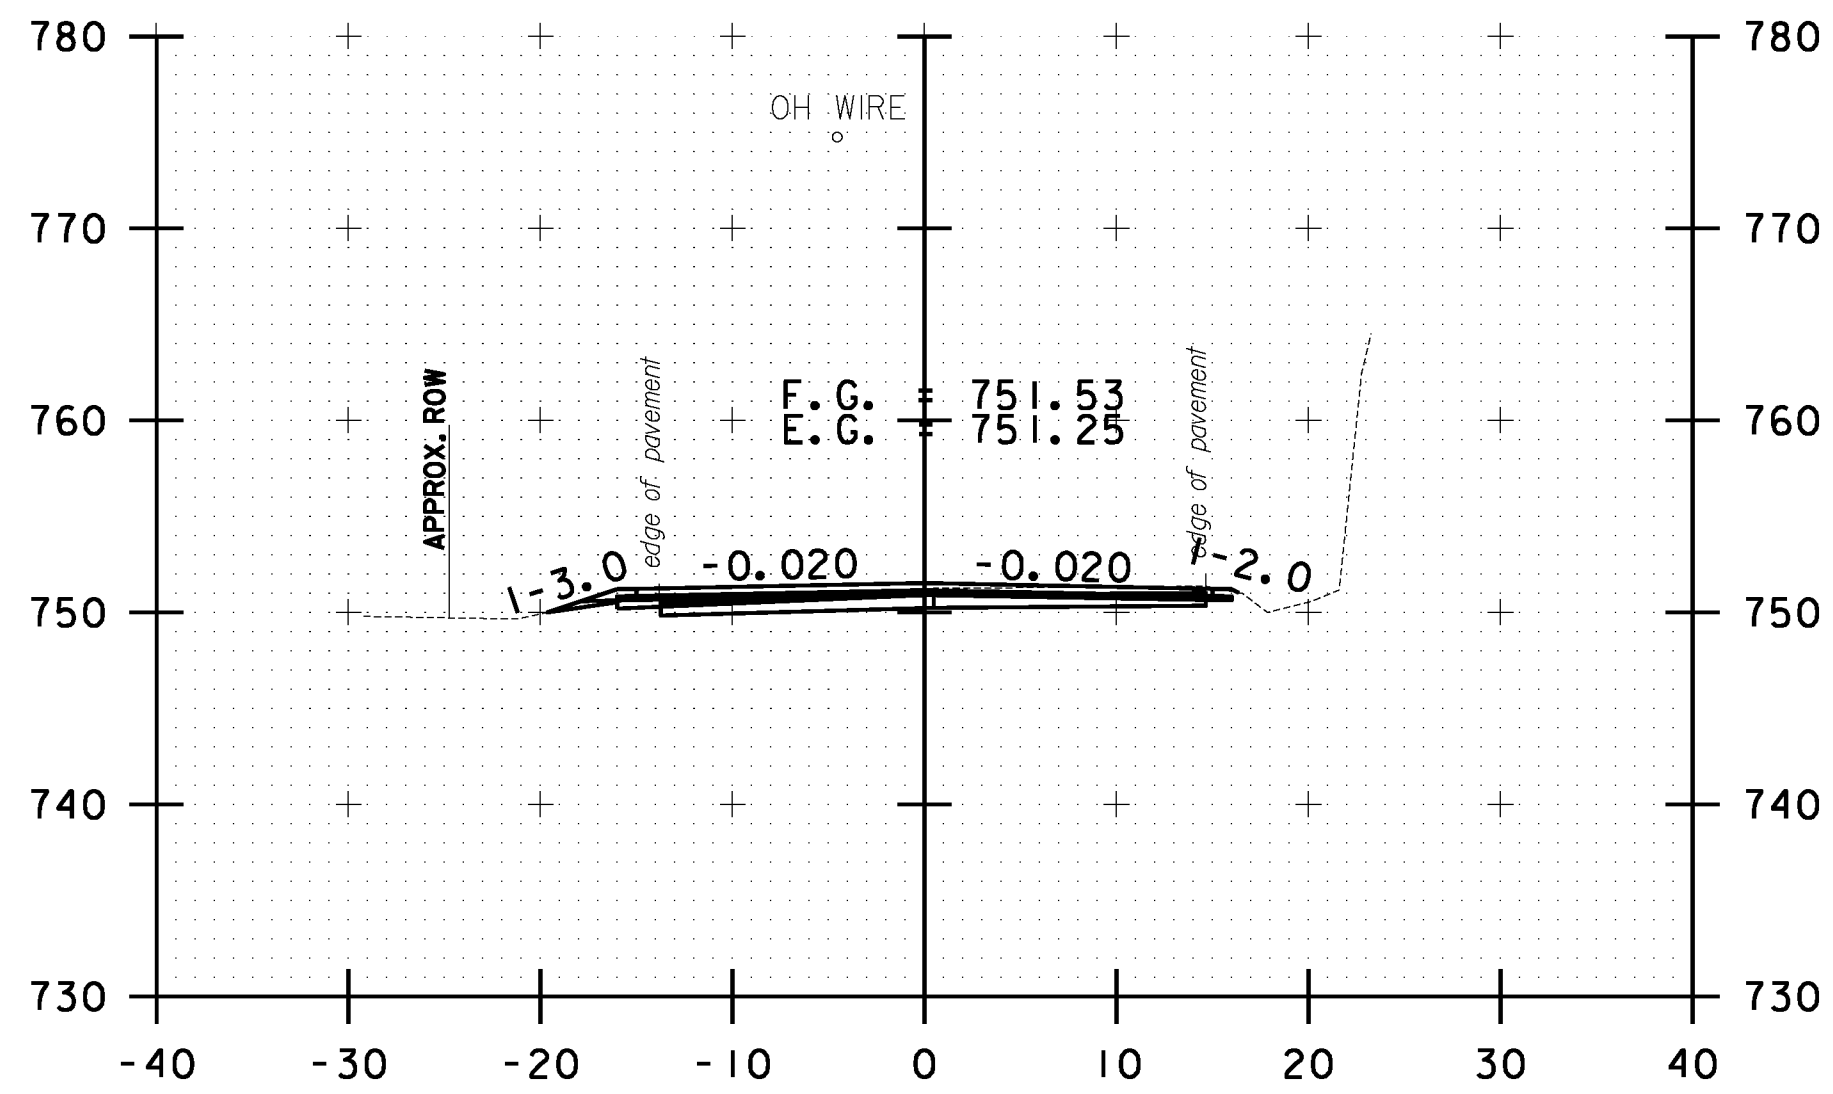


138+00.00

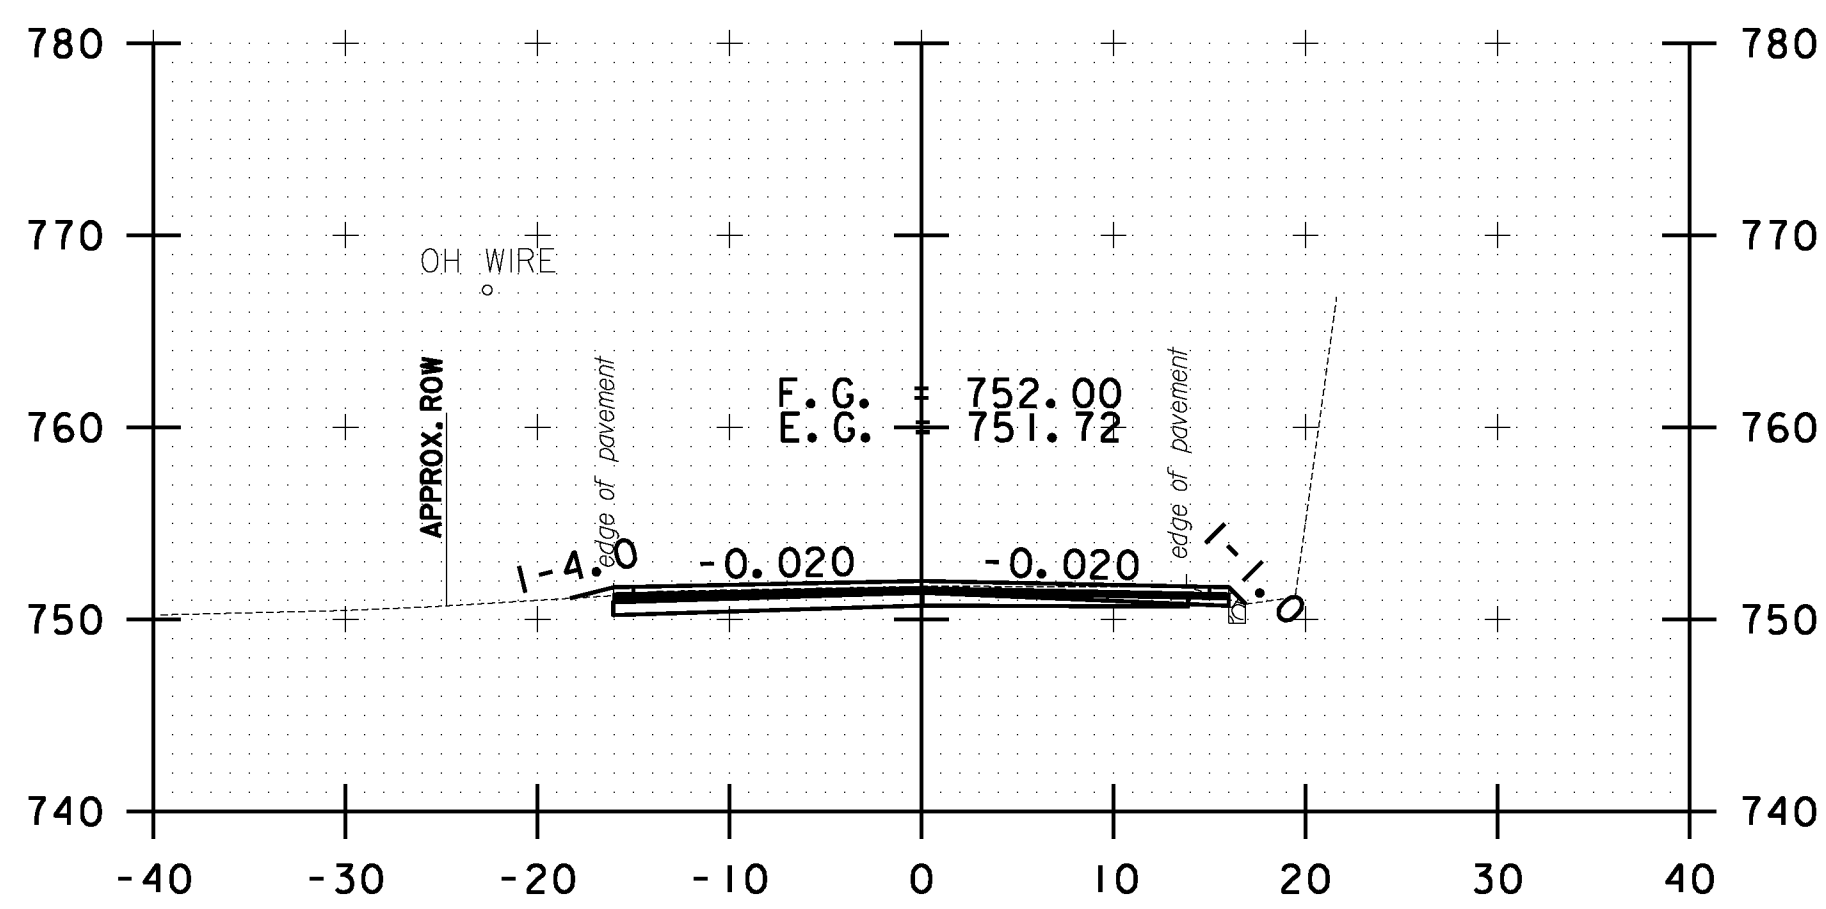


139+00.00

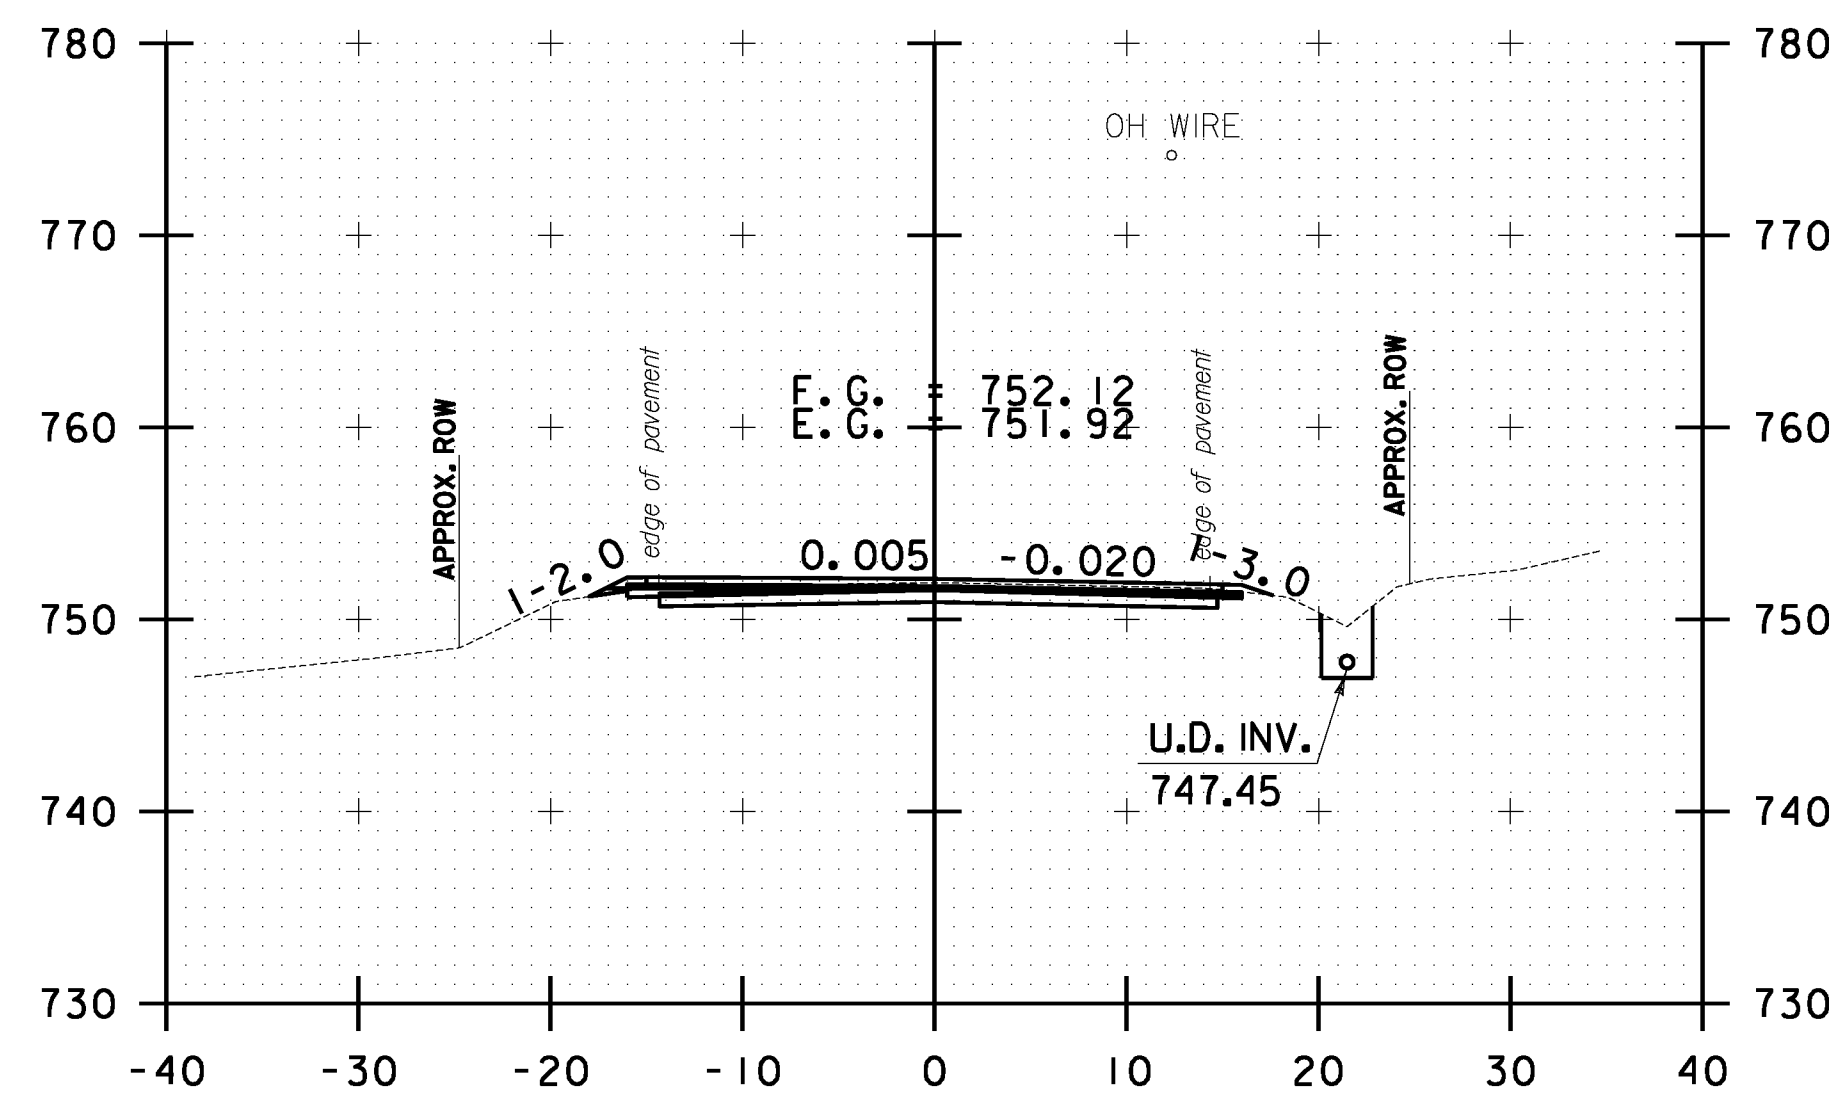


140+00.00

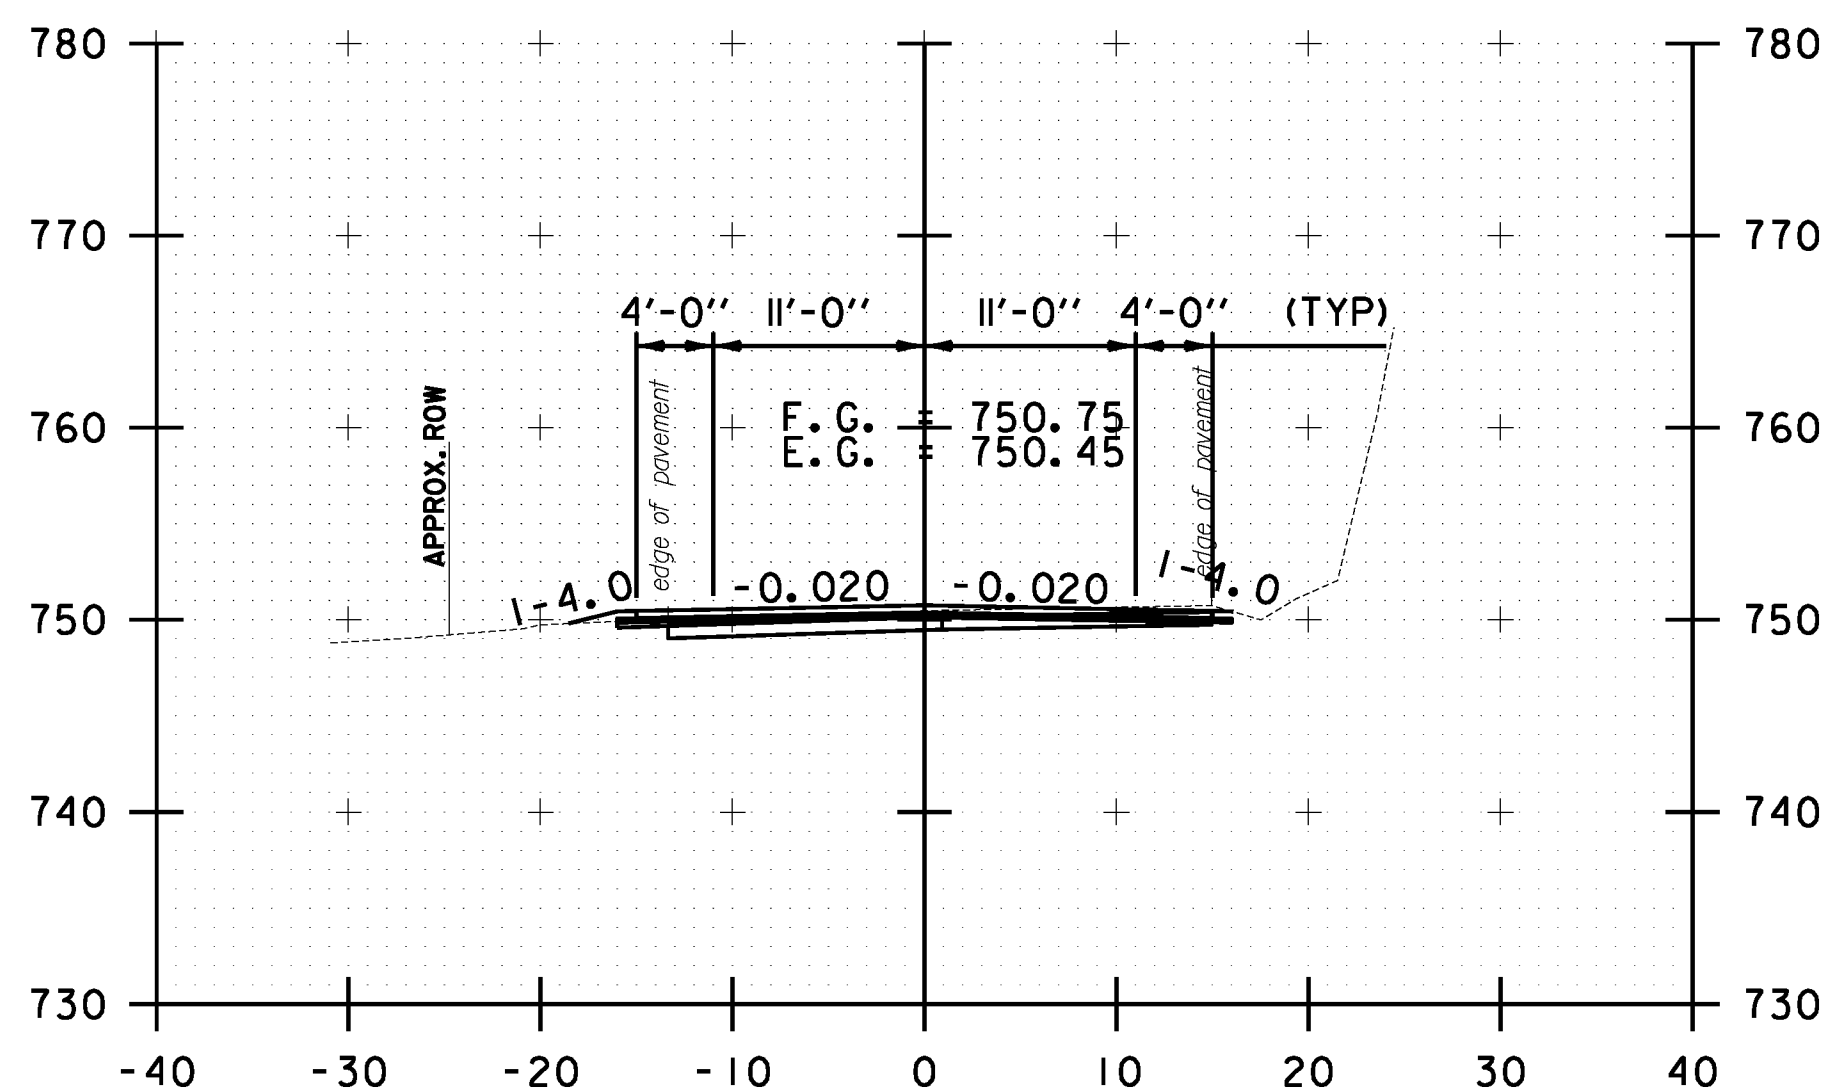


137+50.00

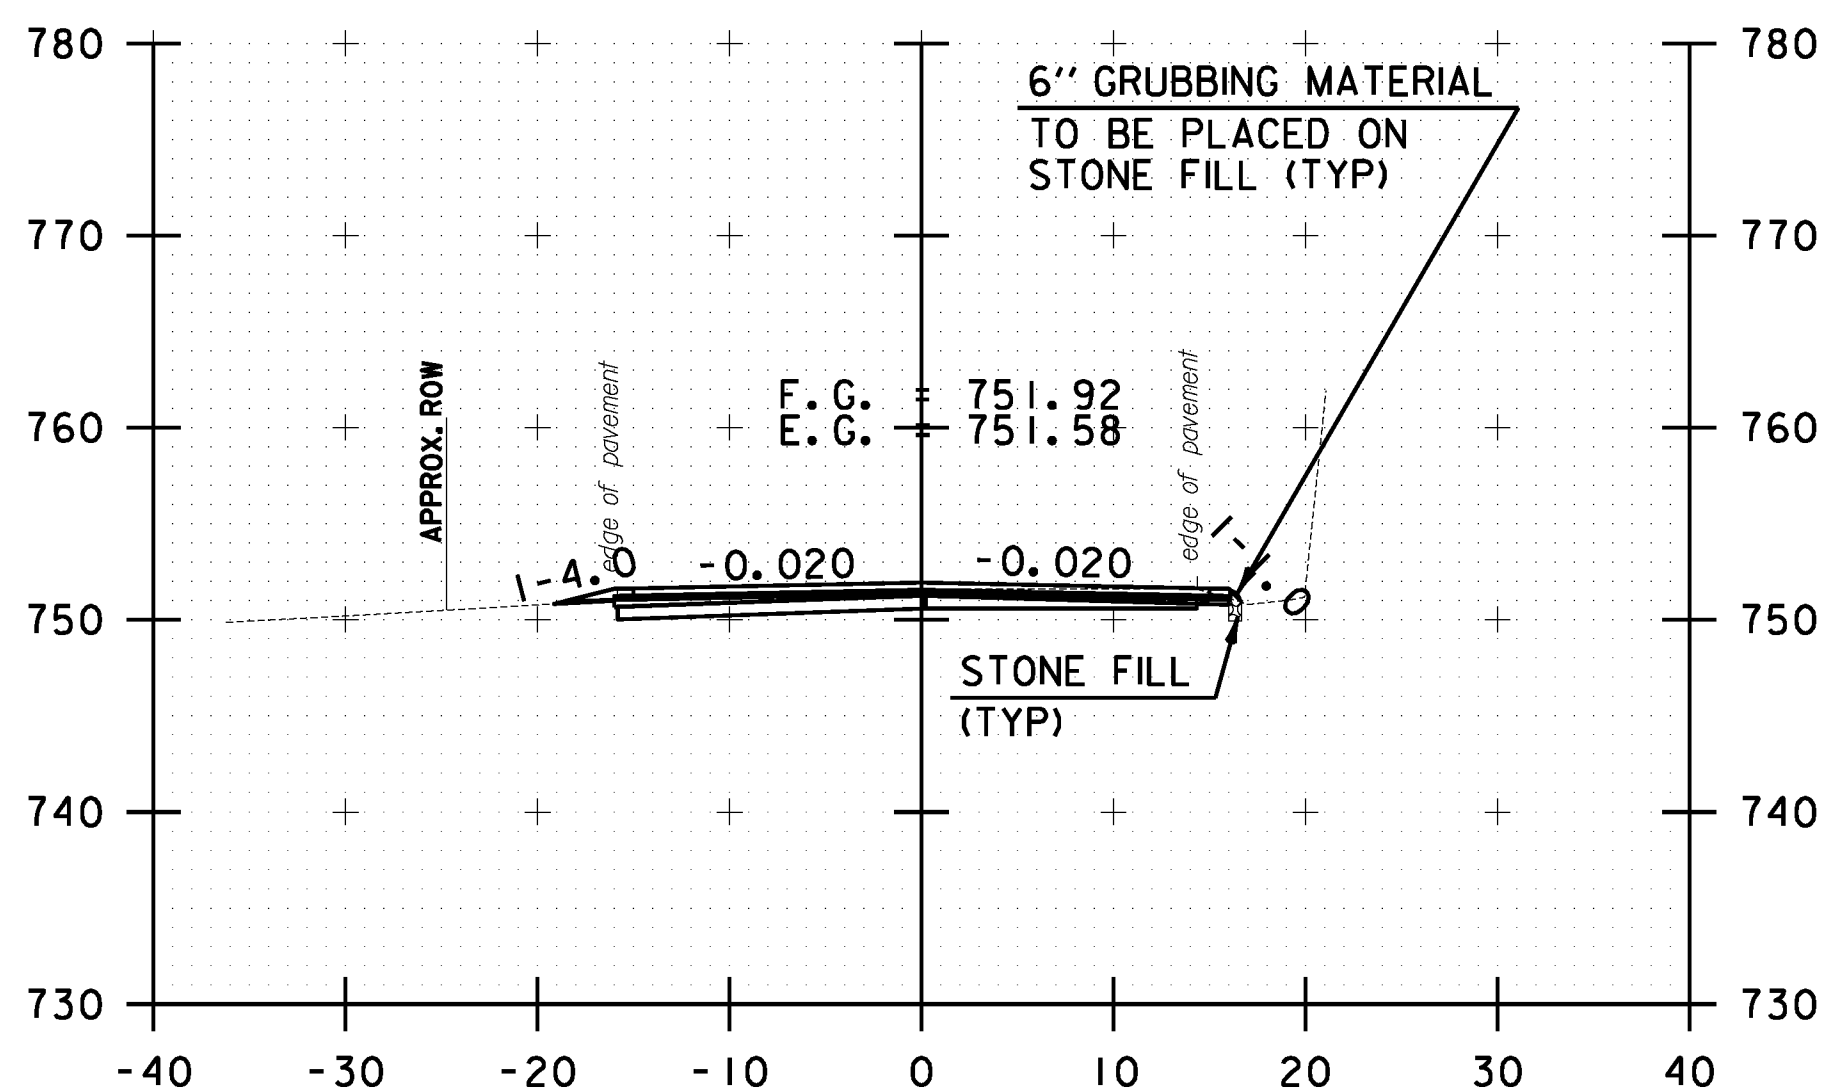

138+50.00

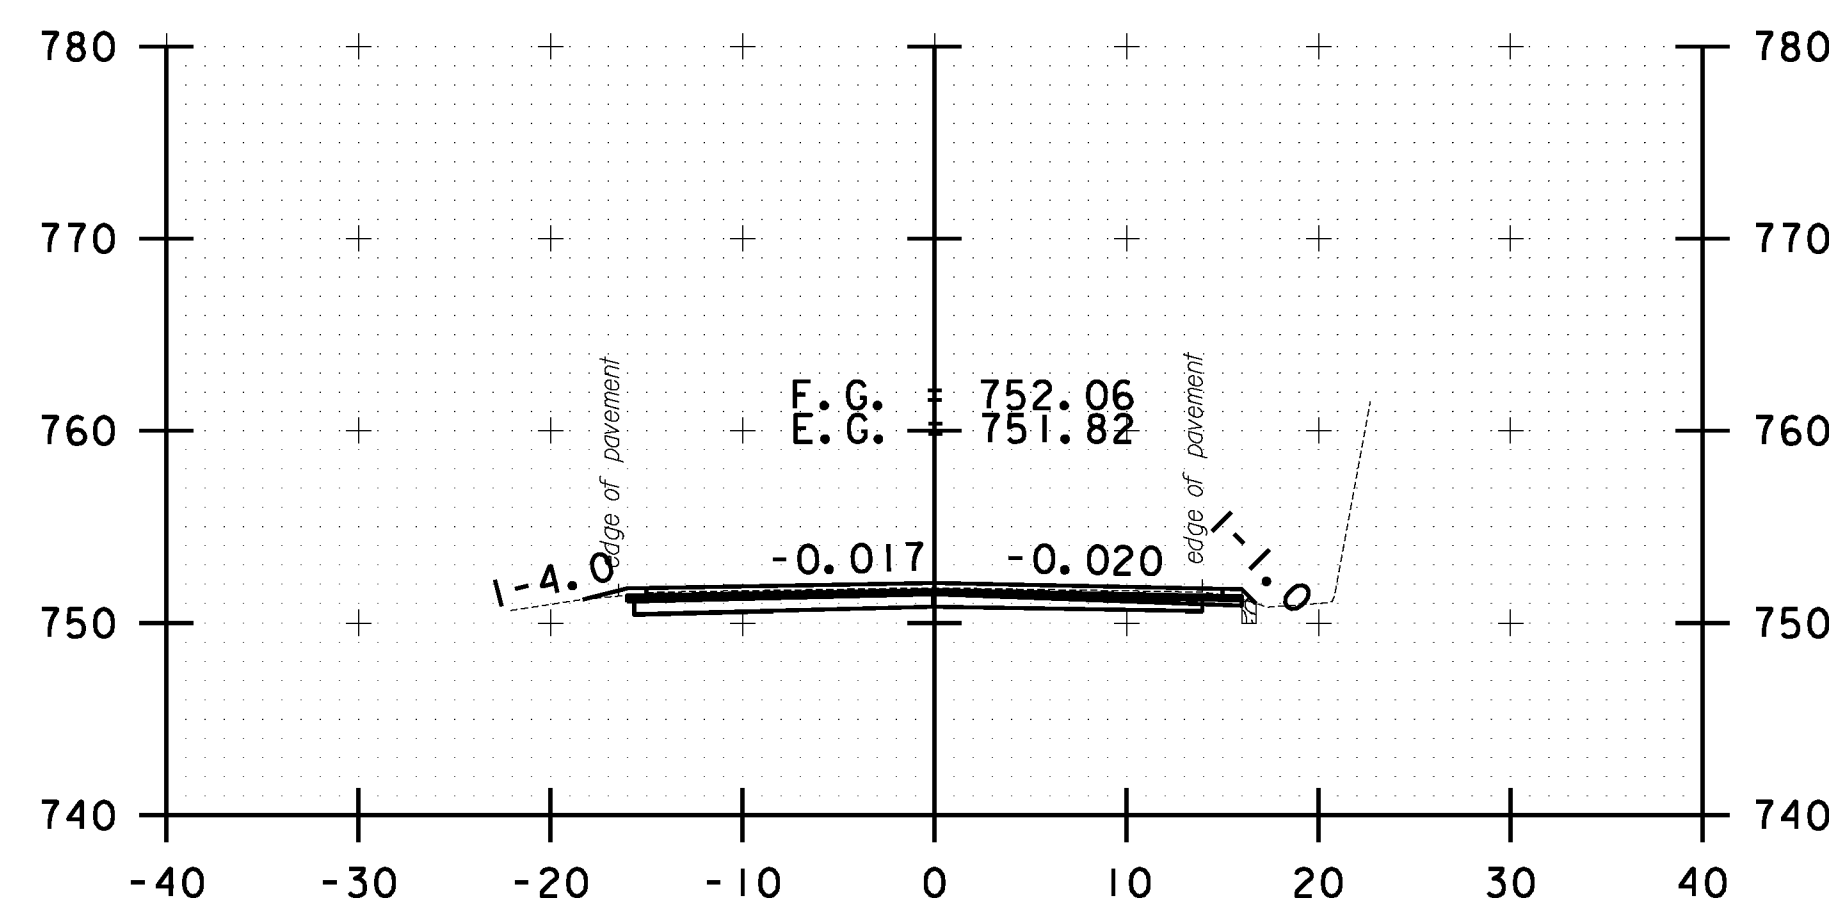

139+50.00

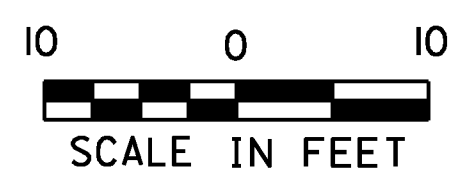

**STOCKBRIDGE  
 CROSS SECTION  
 SHEET #46**

PROJECT NAME: STOCKBRIDGE-BETHEL

PROJECT NUMBER: STP 2910(1)

FILE NAME: z10b214\_stock\_xc.dgn

PROJECT LEADER: D.E.G.

DESIGNED BY: L.M.B.

IPARM FILE: z10b214xs46.i

PLOT DATE: 3/17/2014

DRAWN BY: W.C.P.

CHECKED BY: J.P.S.

SHEET 259 OF 397