




FILE NAME = Y:\P\c\ess\ANY\X2\22425\CA001_MSTN\180b214_stock.nc.dgn
 DATE/TIME = 3/17/2014
 USER = 4916

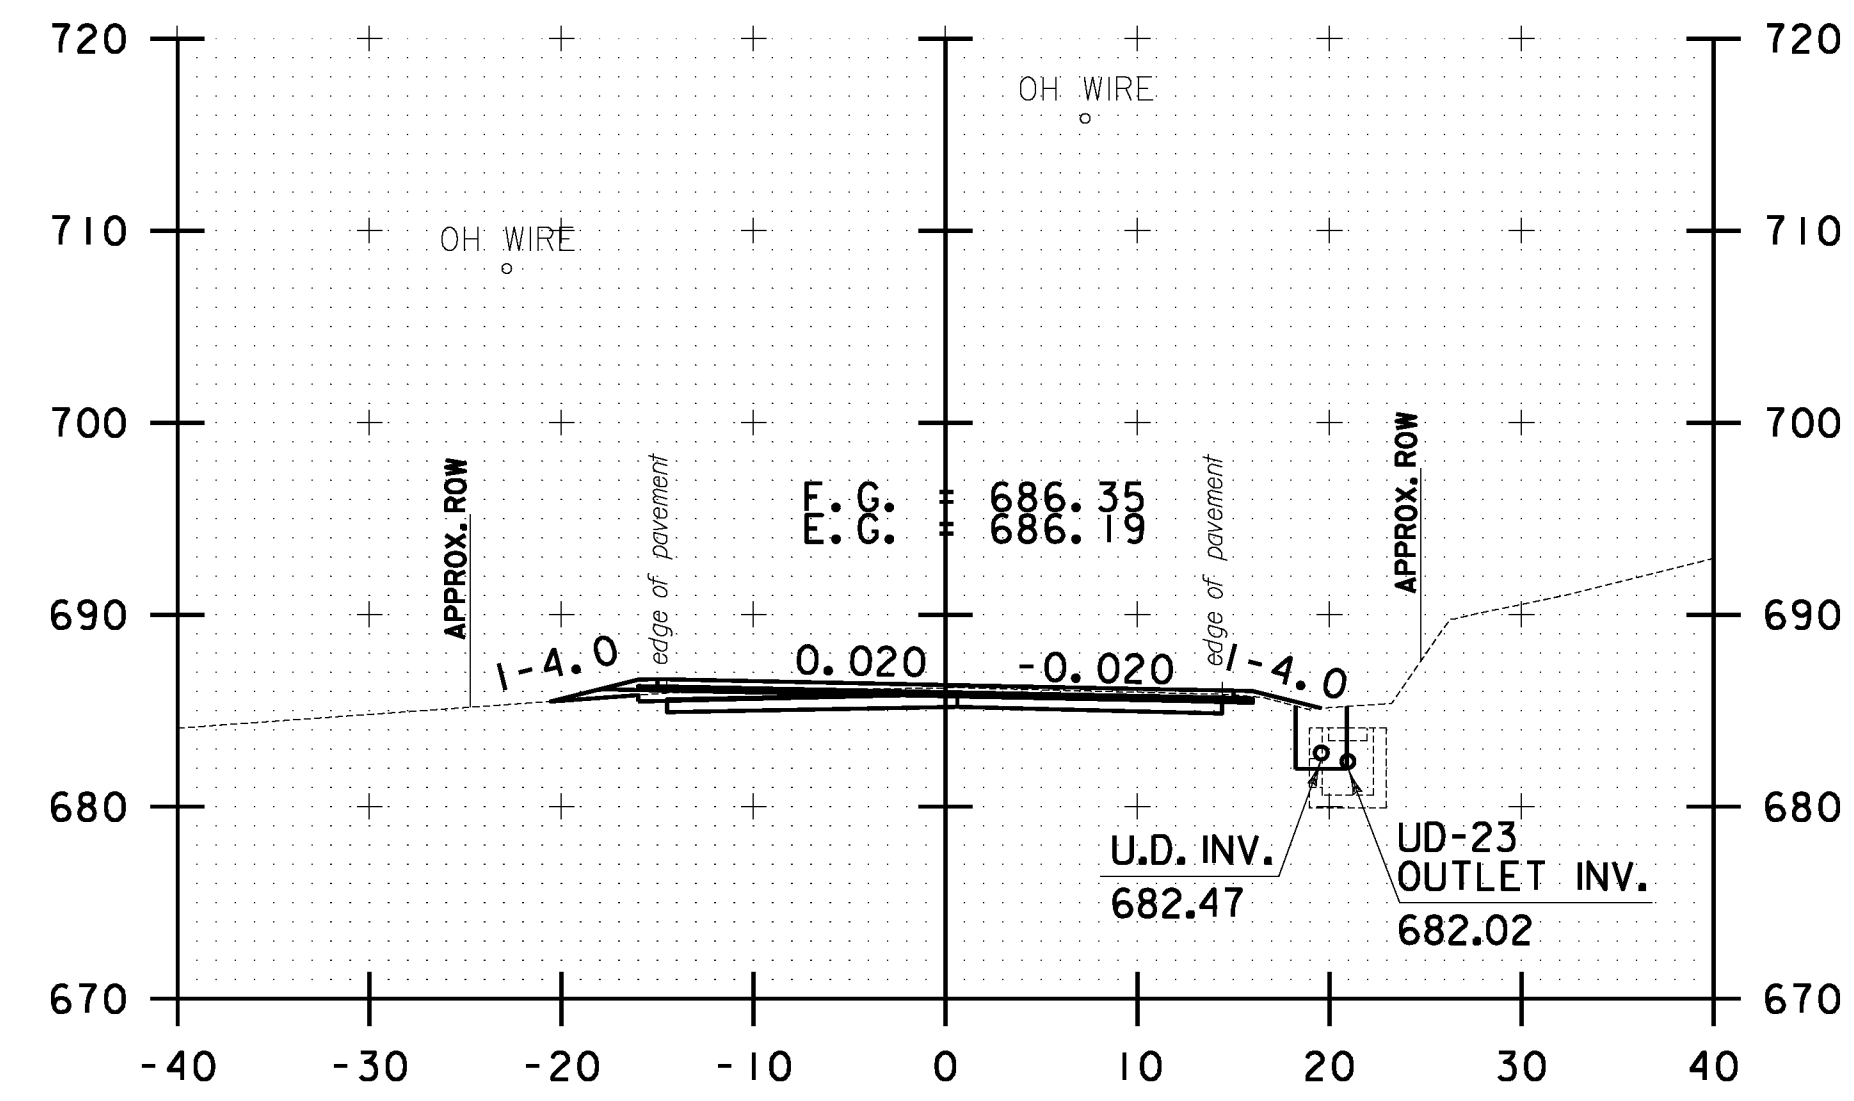


181+00.00

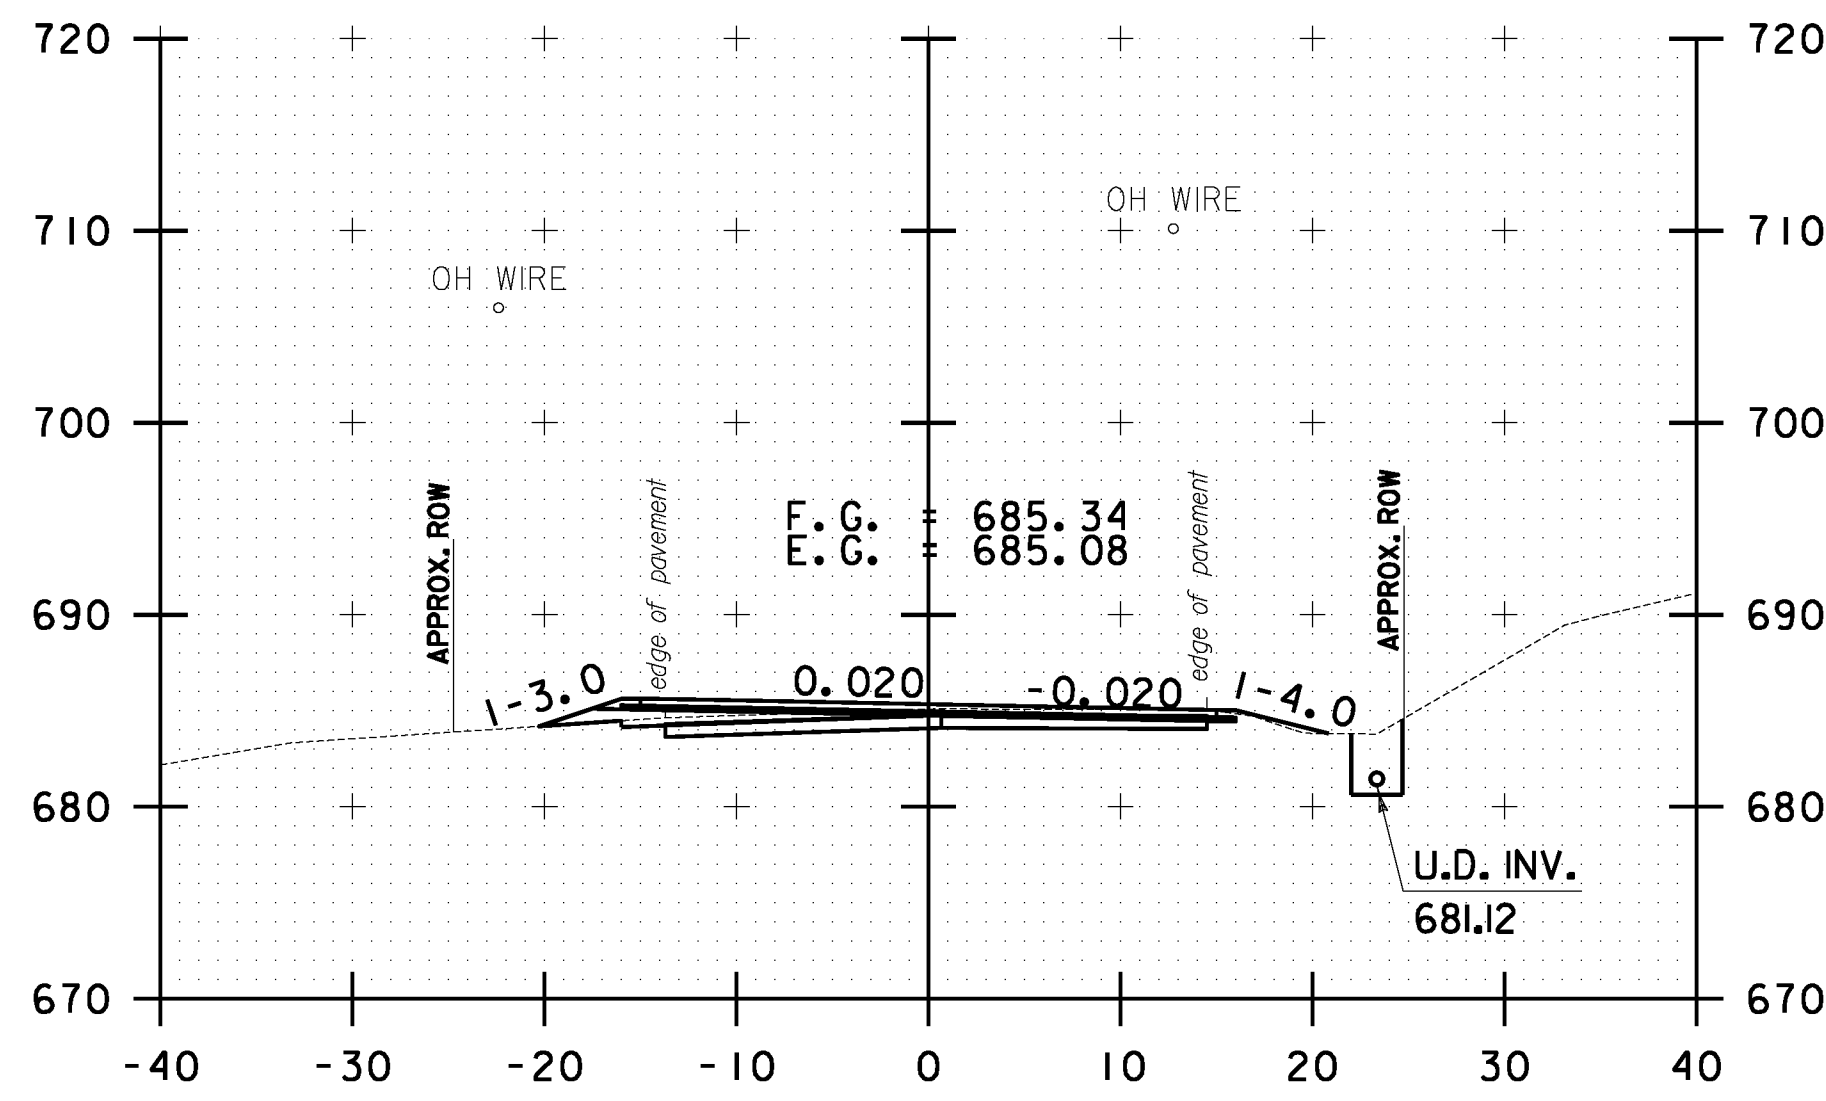


182+00.00

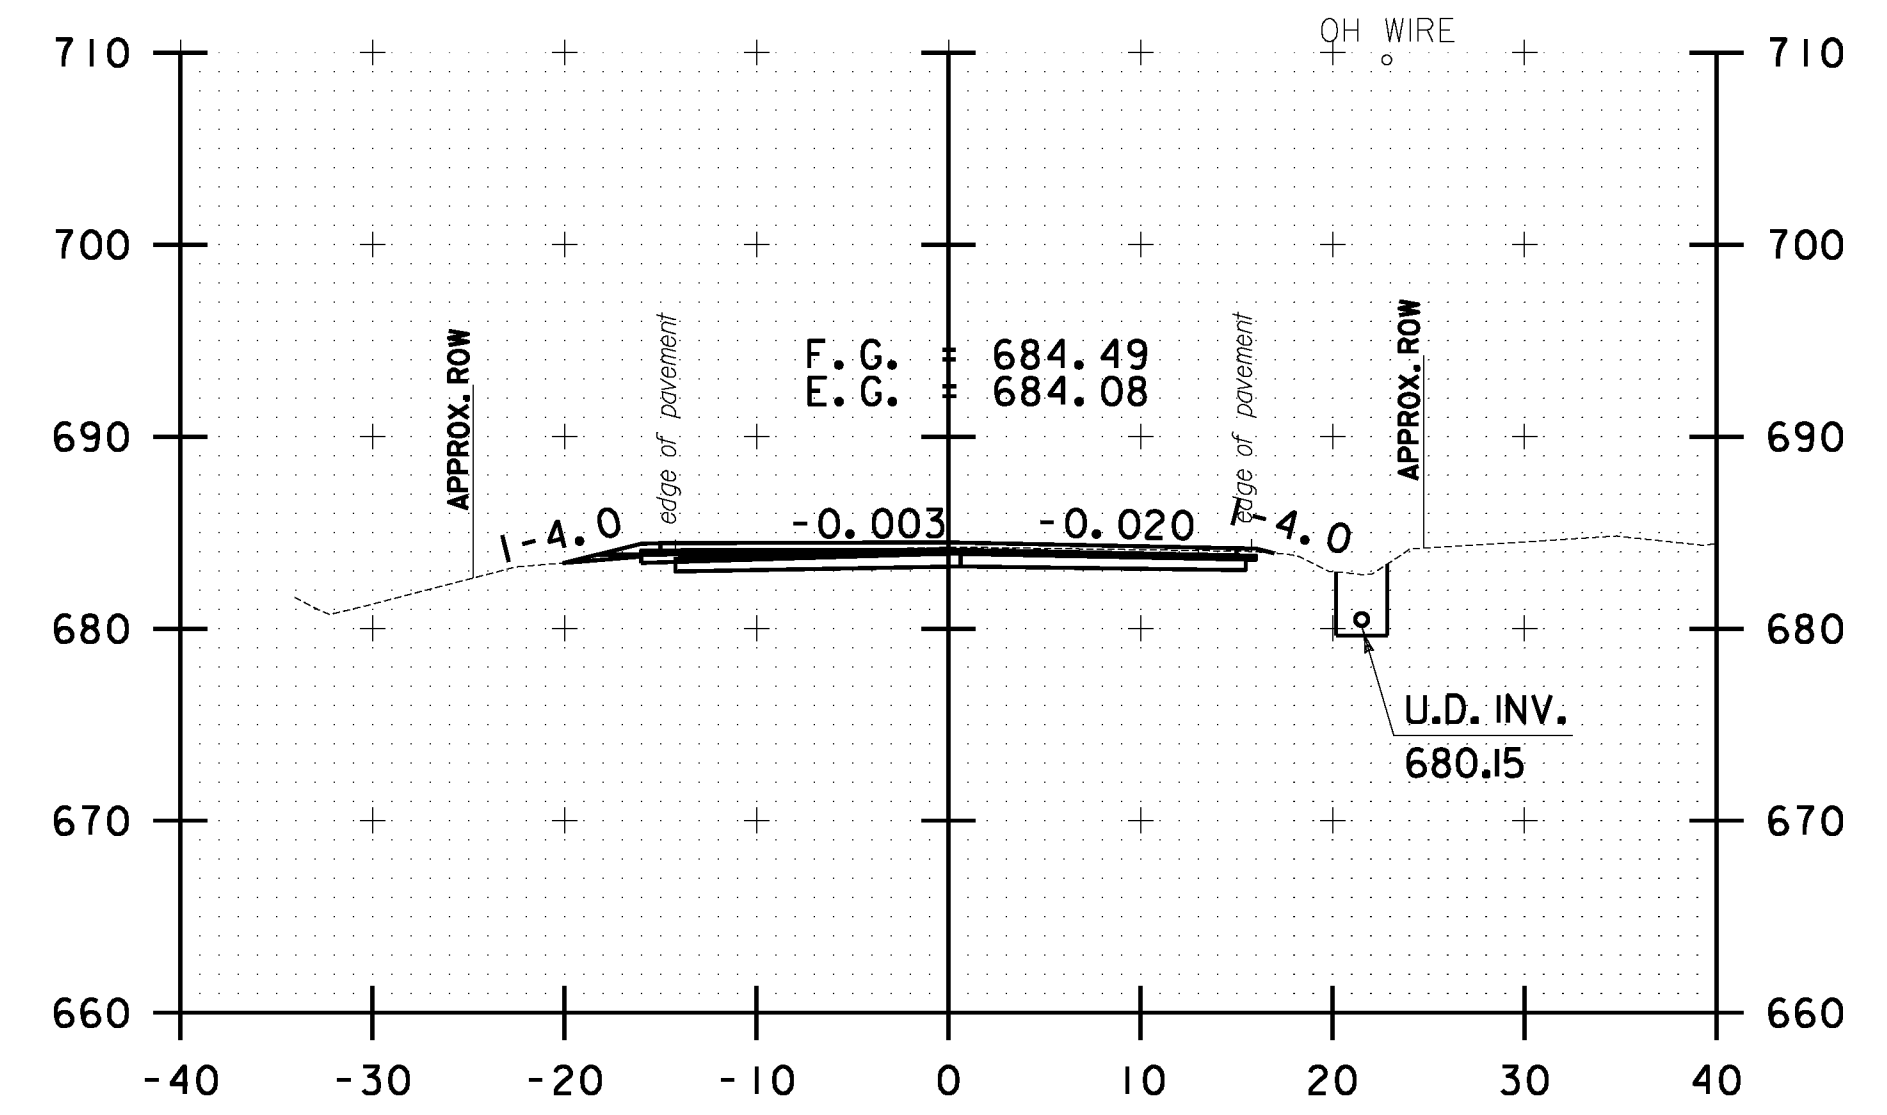


183+00.00

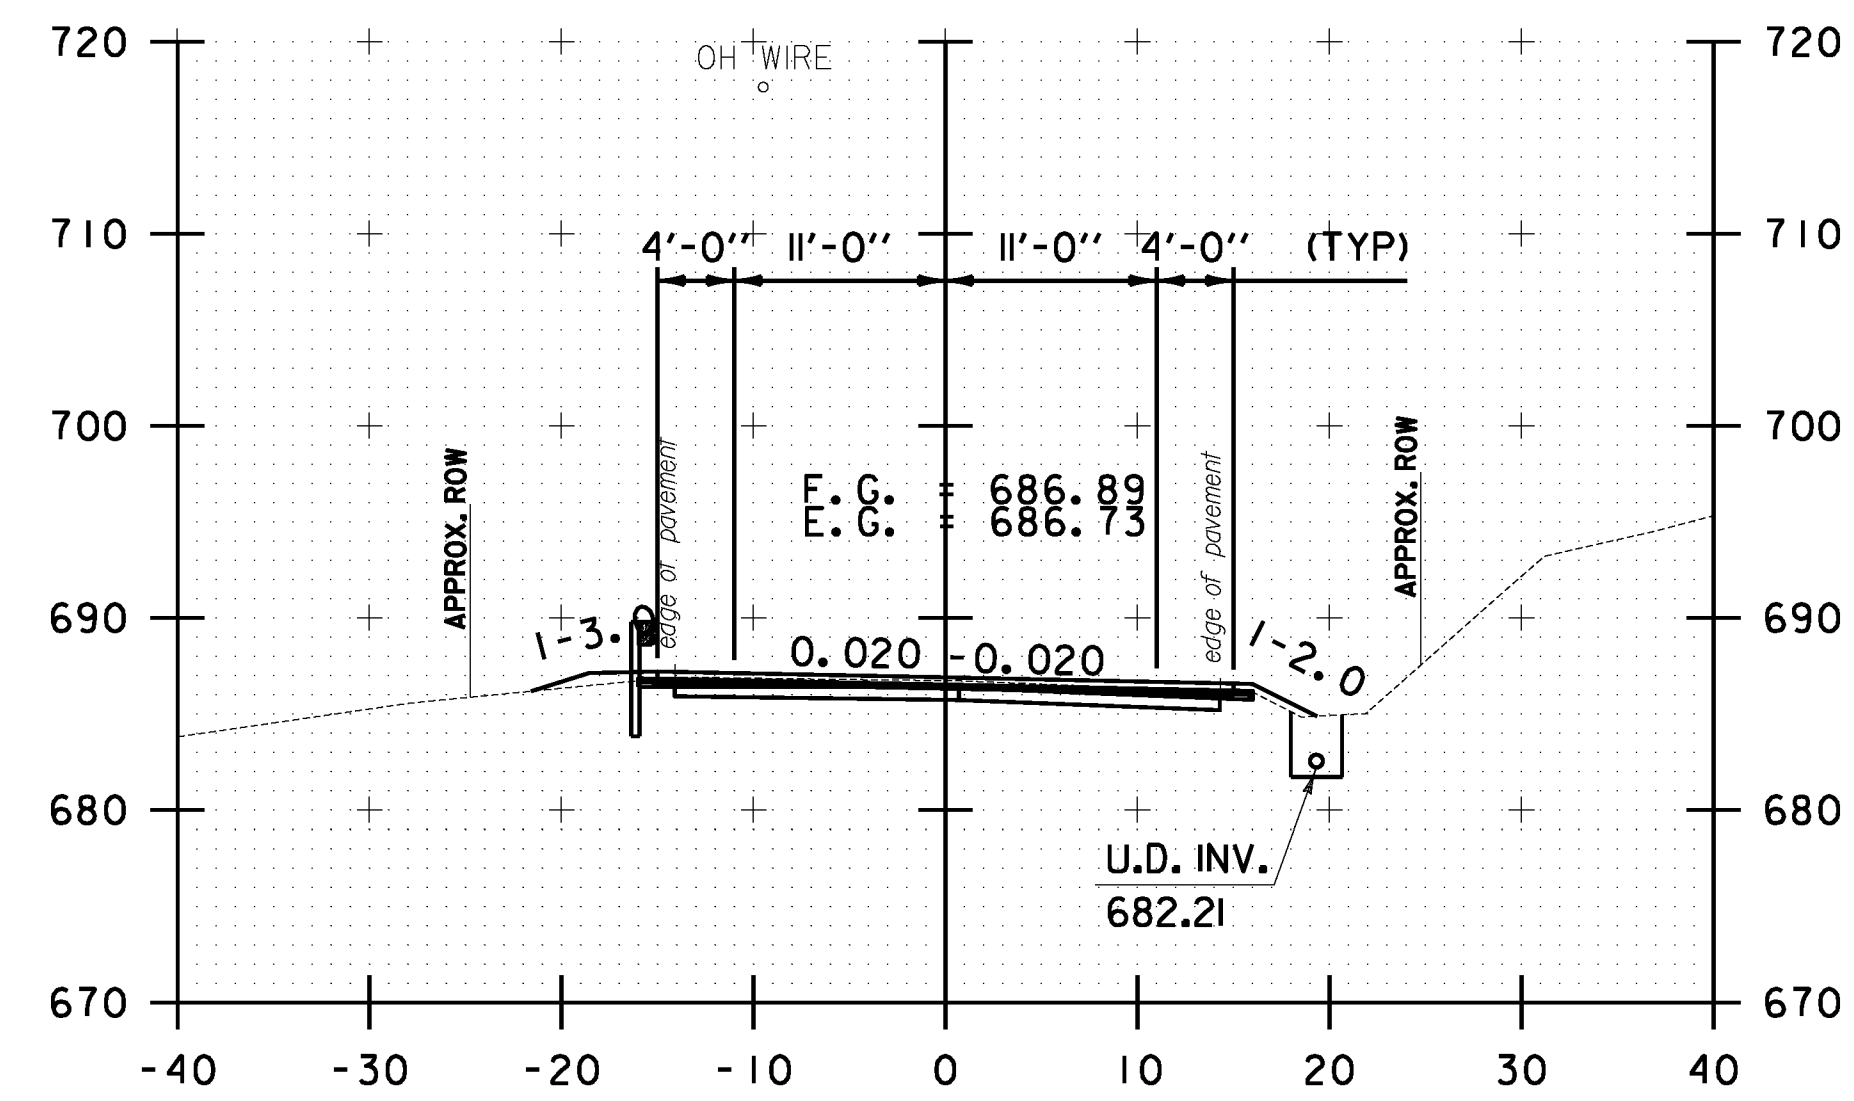

180+50.00

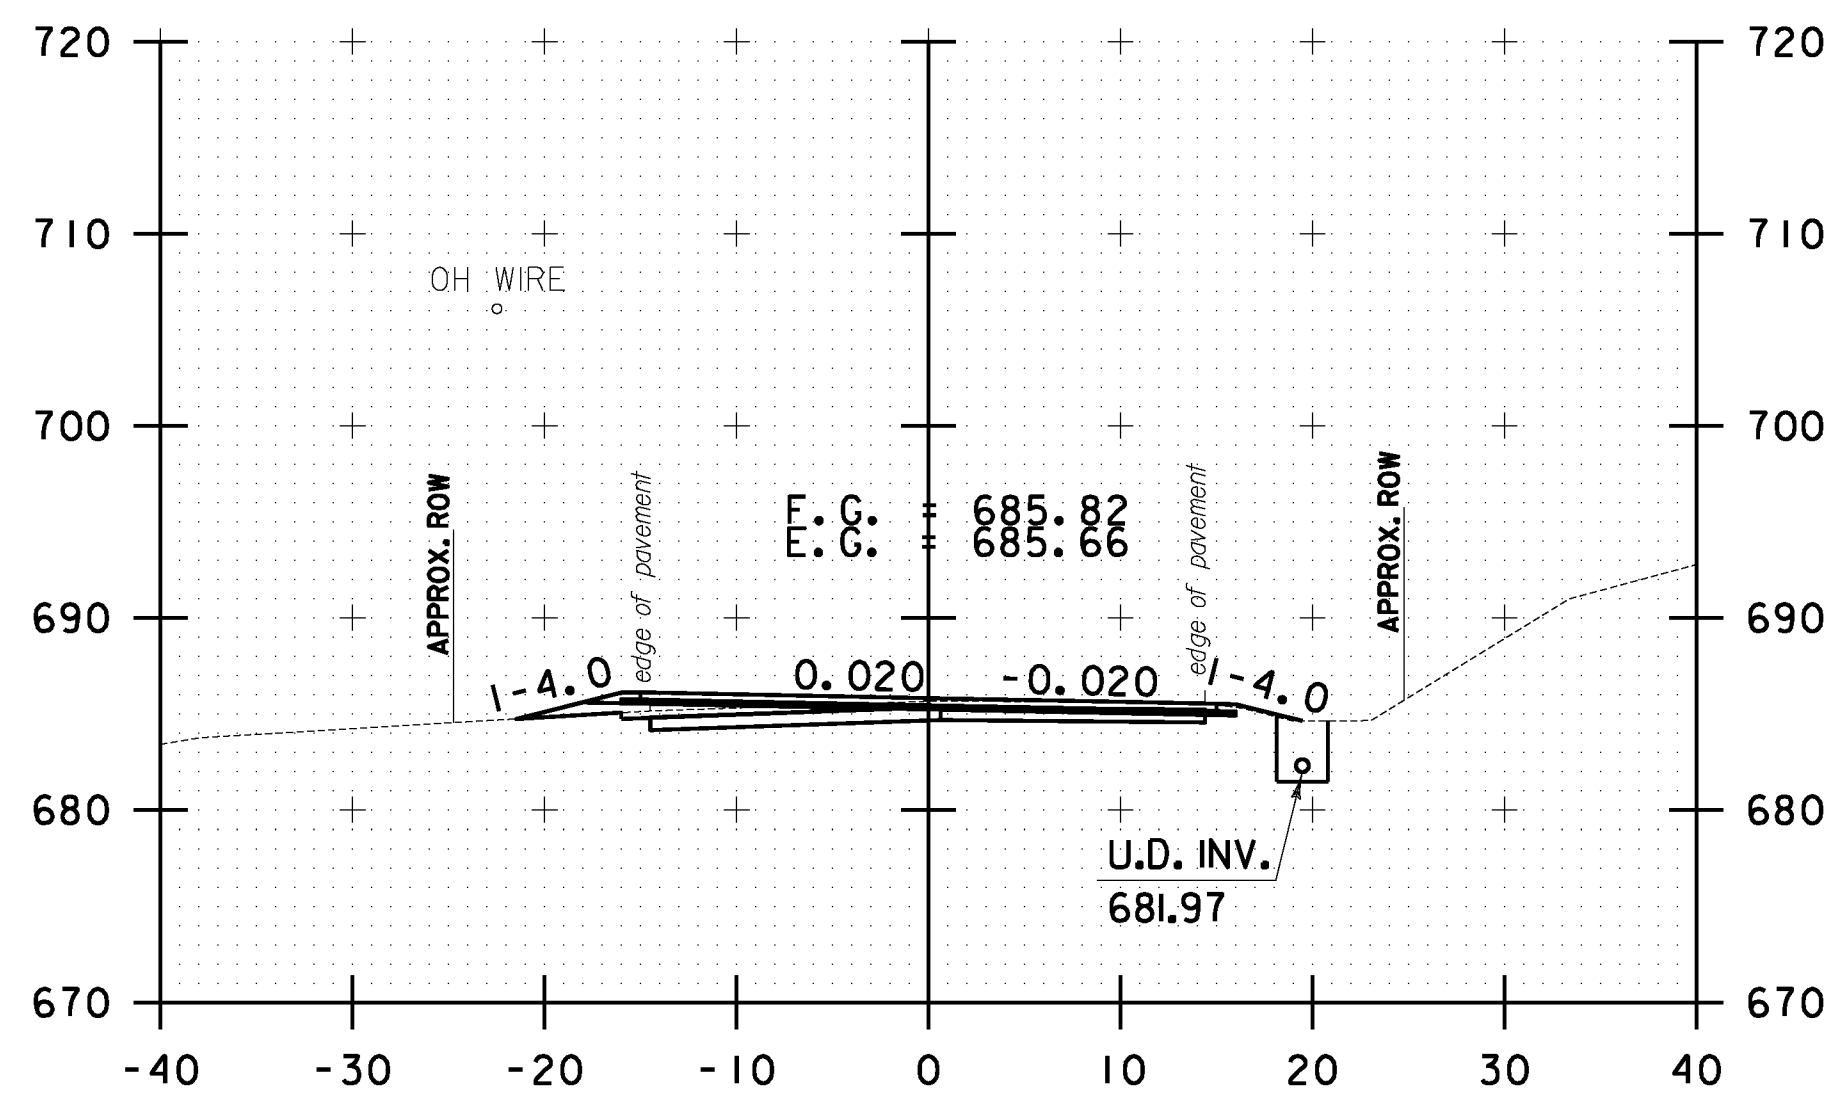

181+50.00

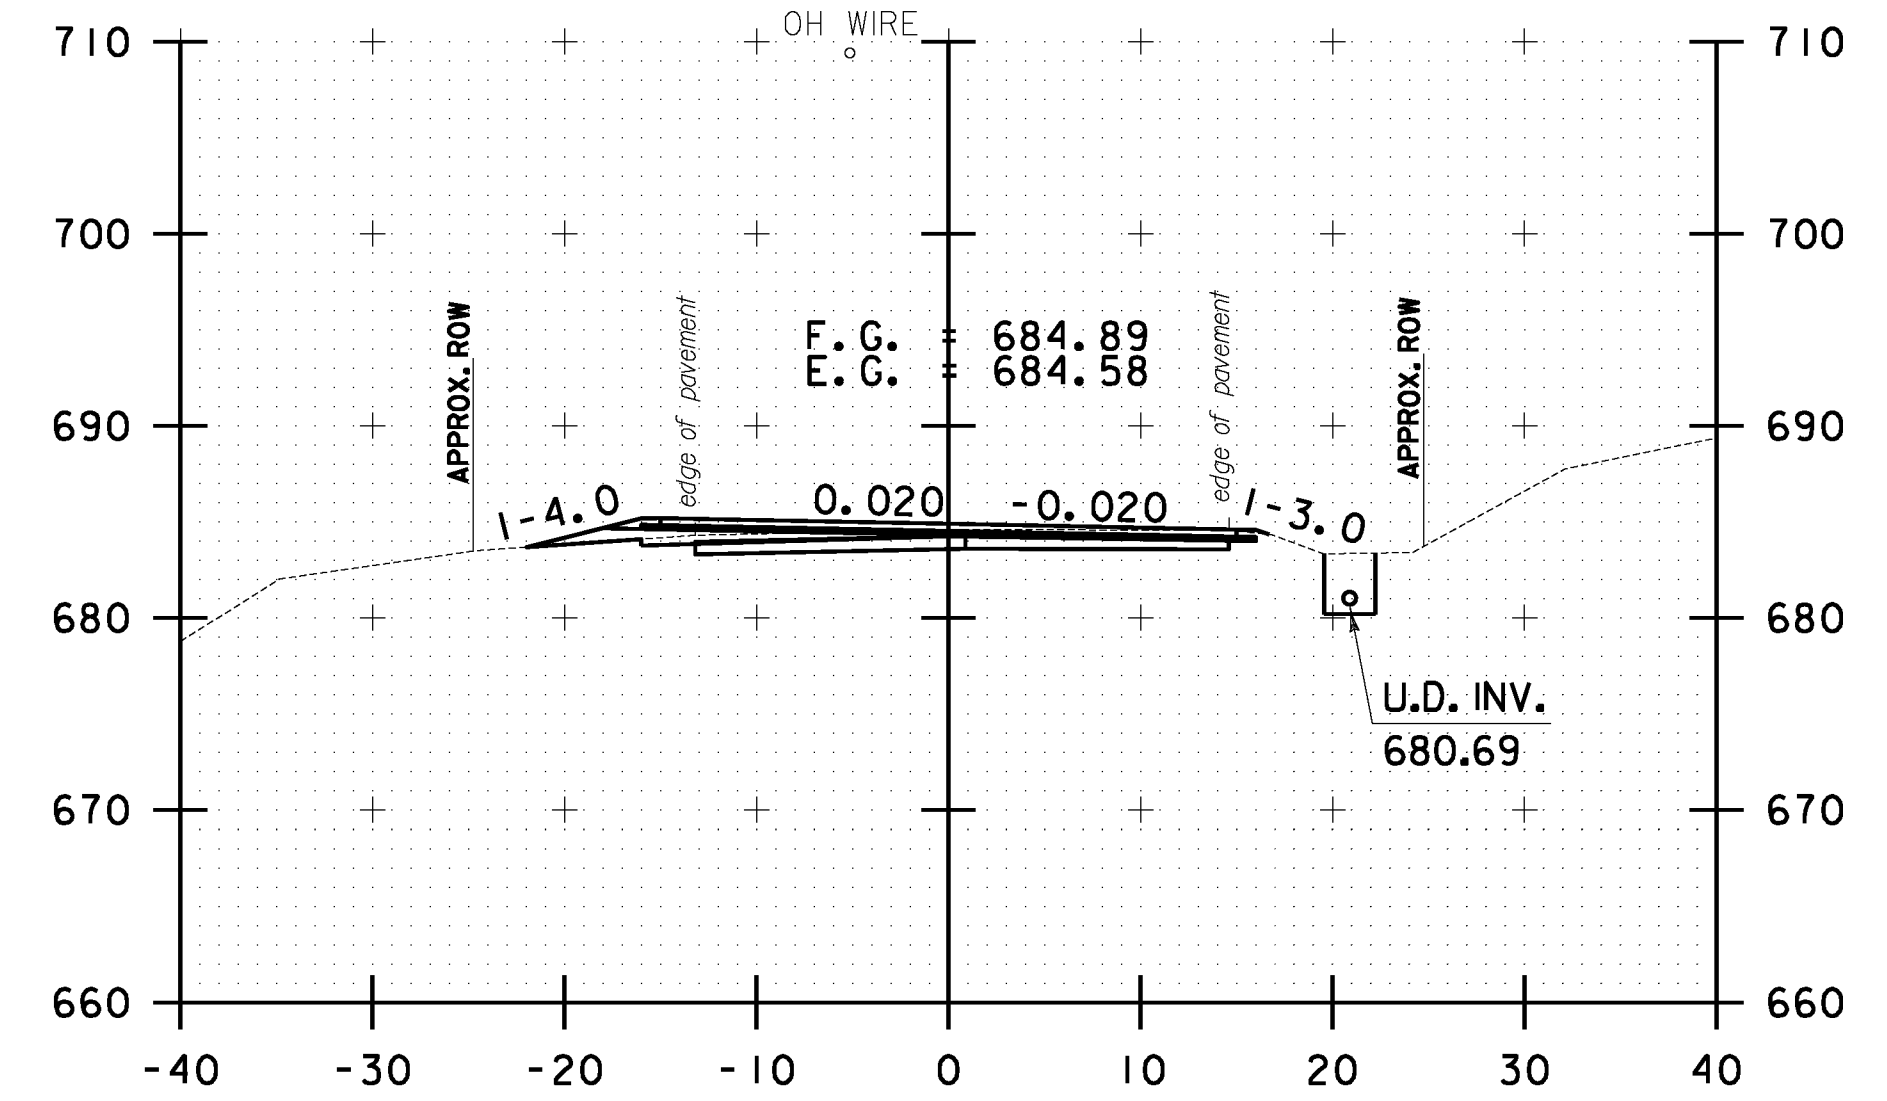

182+50.00



**STOCKBRIDGE
 CROSS SECTION
 SHEET #56**

PROJECT NAME: STOCKBRIDGE-BETHEL	
PROJECT NUMBER: STP 2910(1)	
FILE NAME: z10b214_stock.nc.dgn	PLOT DATE: 3/17/2014
PROJECT LEADER: D.E.G.	DRAWN BY: W.C.P.
DESIGNED BY: L.M.B.	CHECKED BY: J.P.S.
IPARM FILE: z10b214xs56.1	SHEET 269 OF 397