




FILE NAME = Y:\P\c\res\any\k2\22425\CA001\MSTN\10b214_stock_xc.dgn
 DATE/TIME = 3/17/2014
 USER = 4916

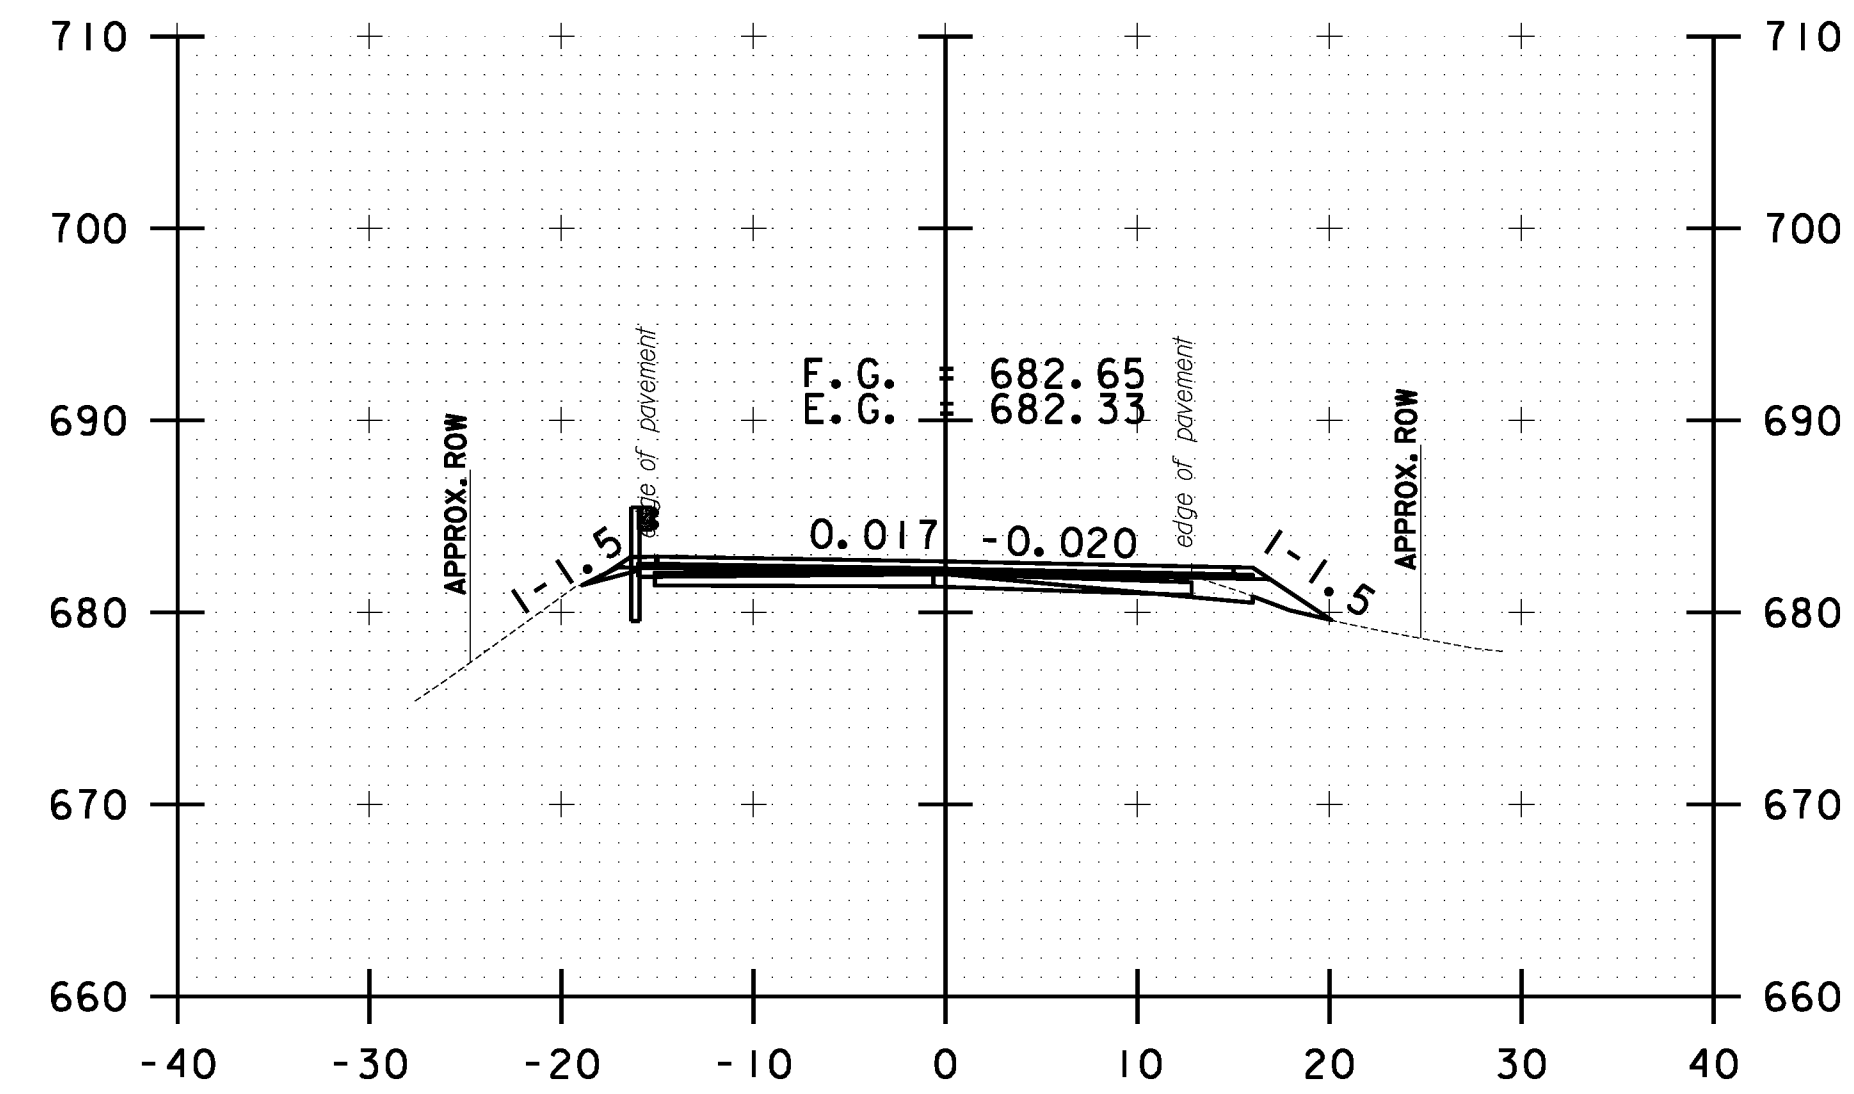


187+00.00

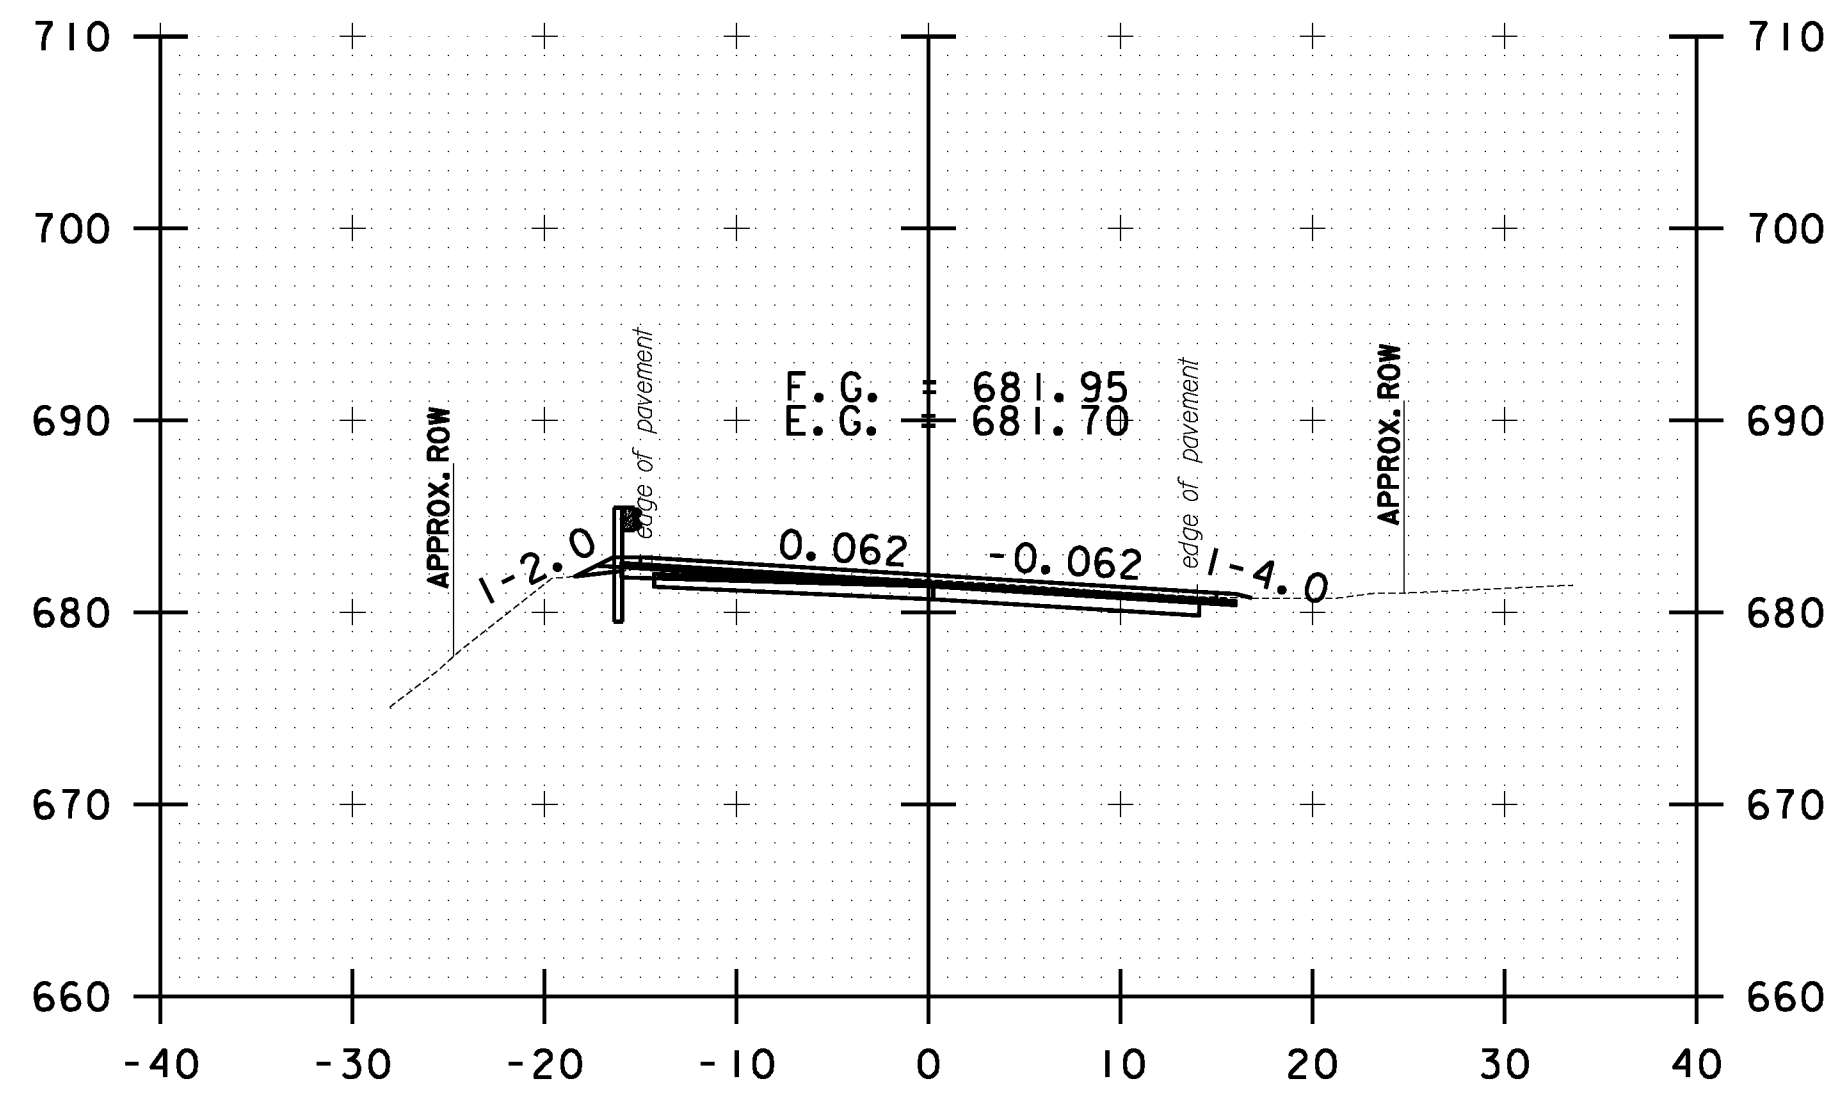


188+00.00

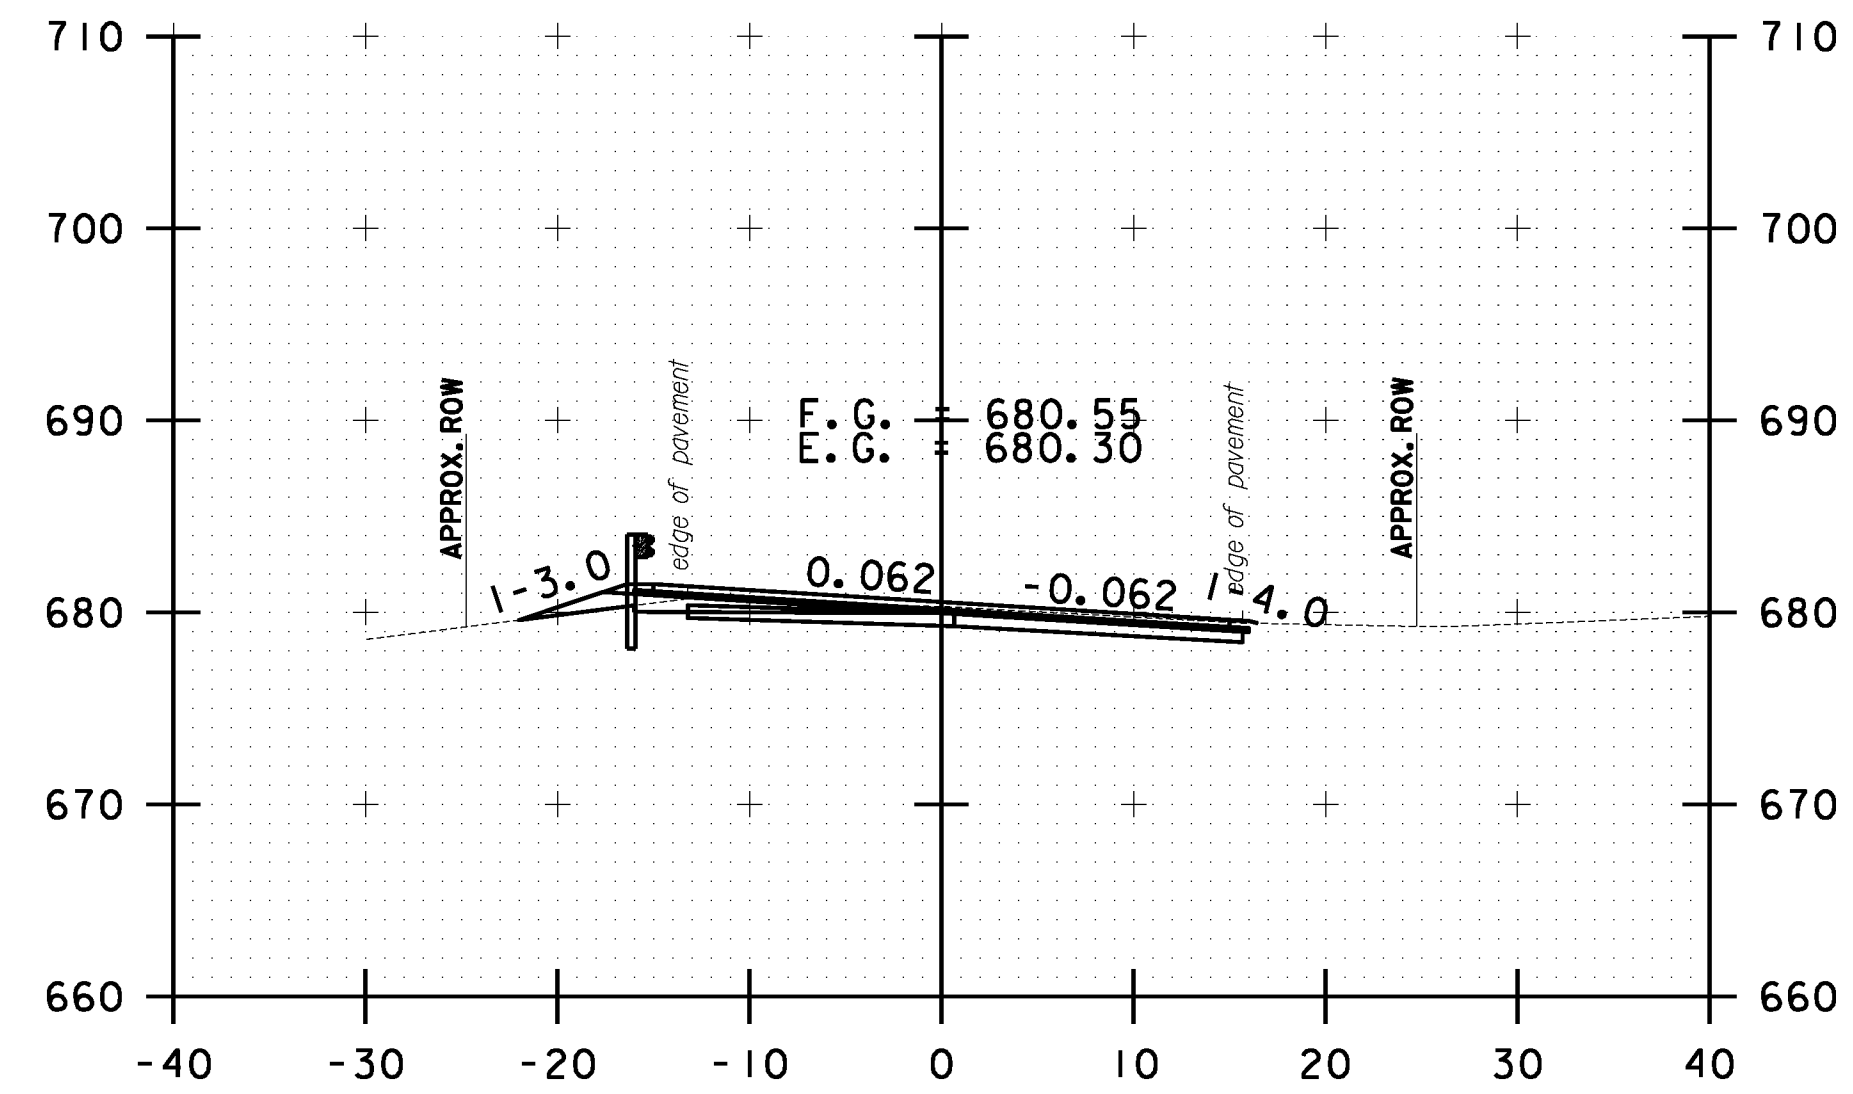


189+00.00

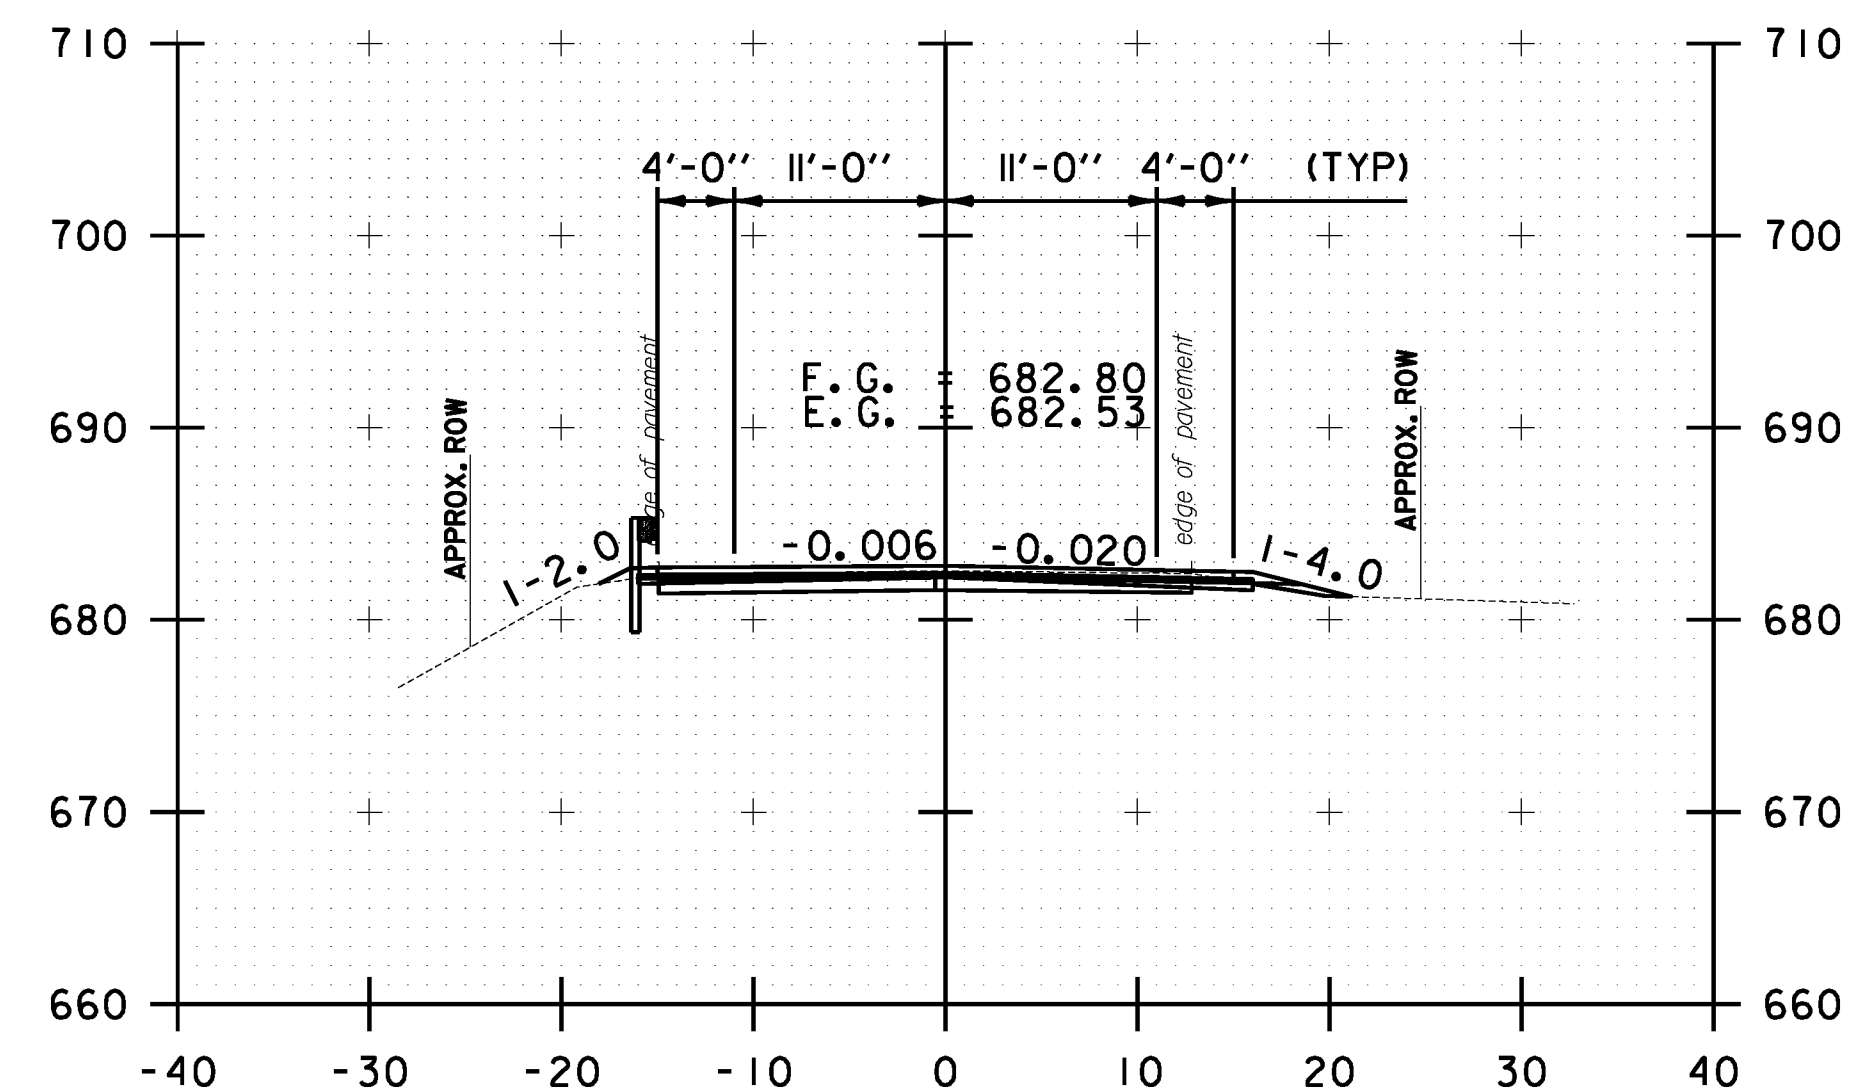

186+50.00

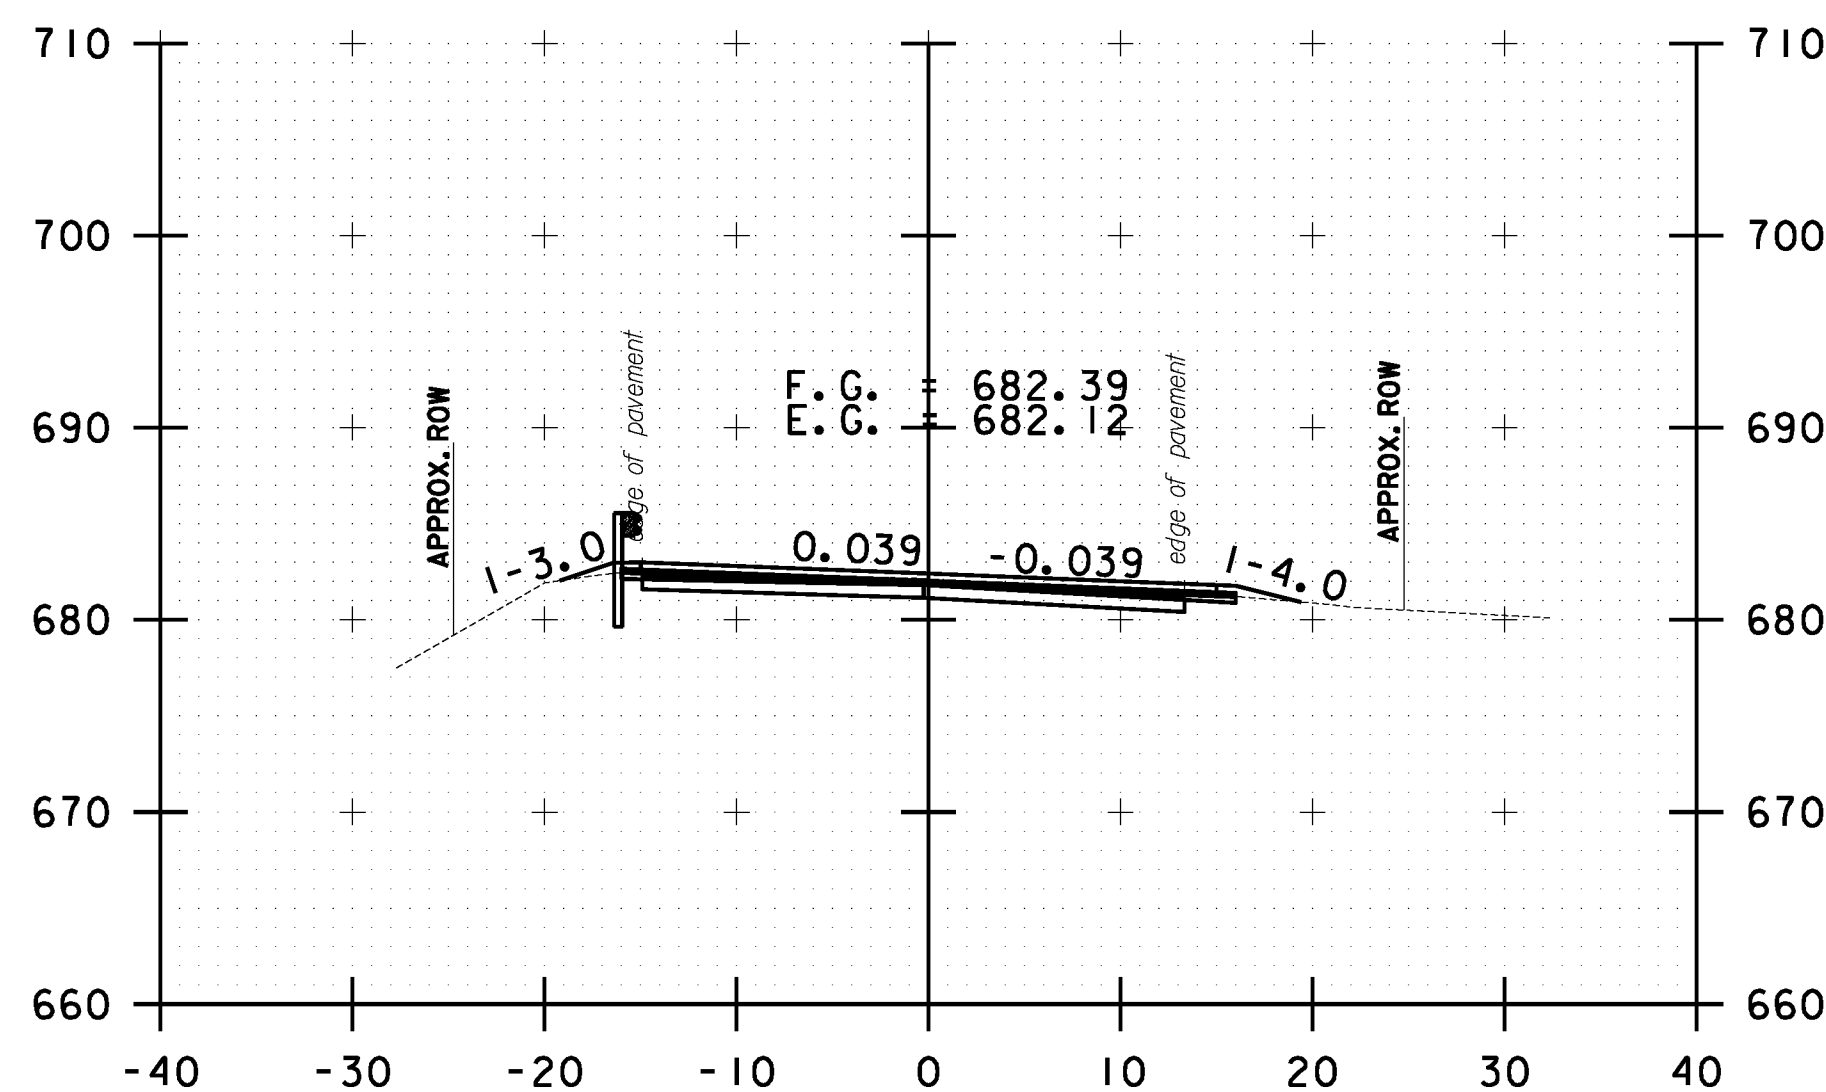

187+50.00

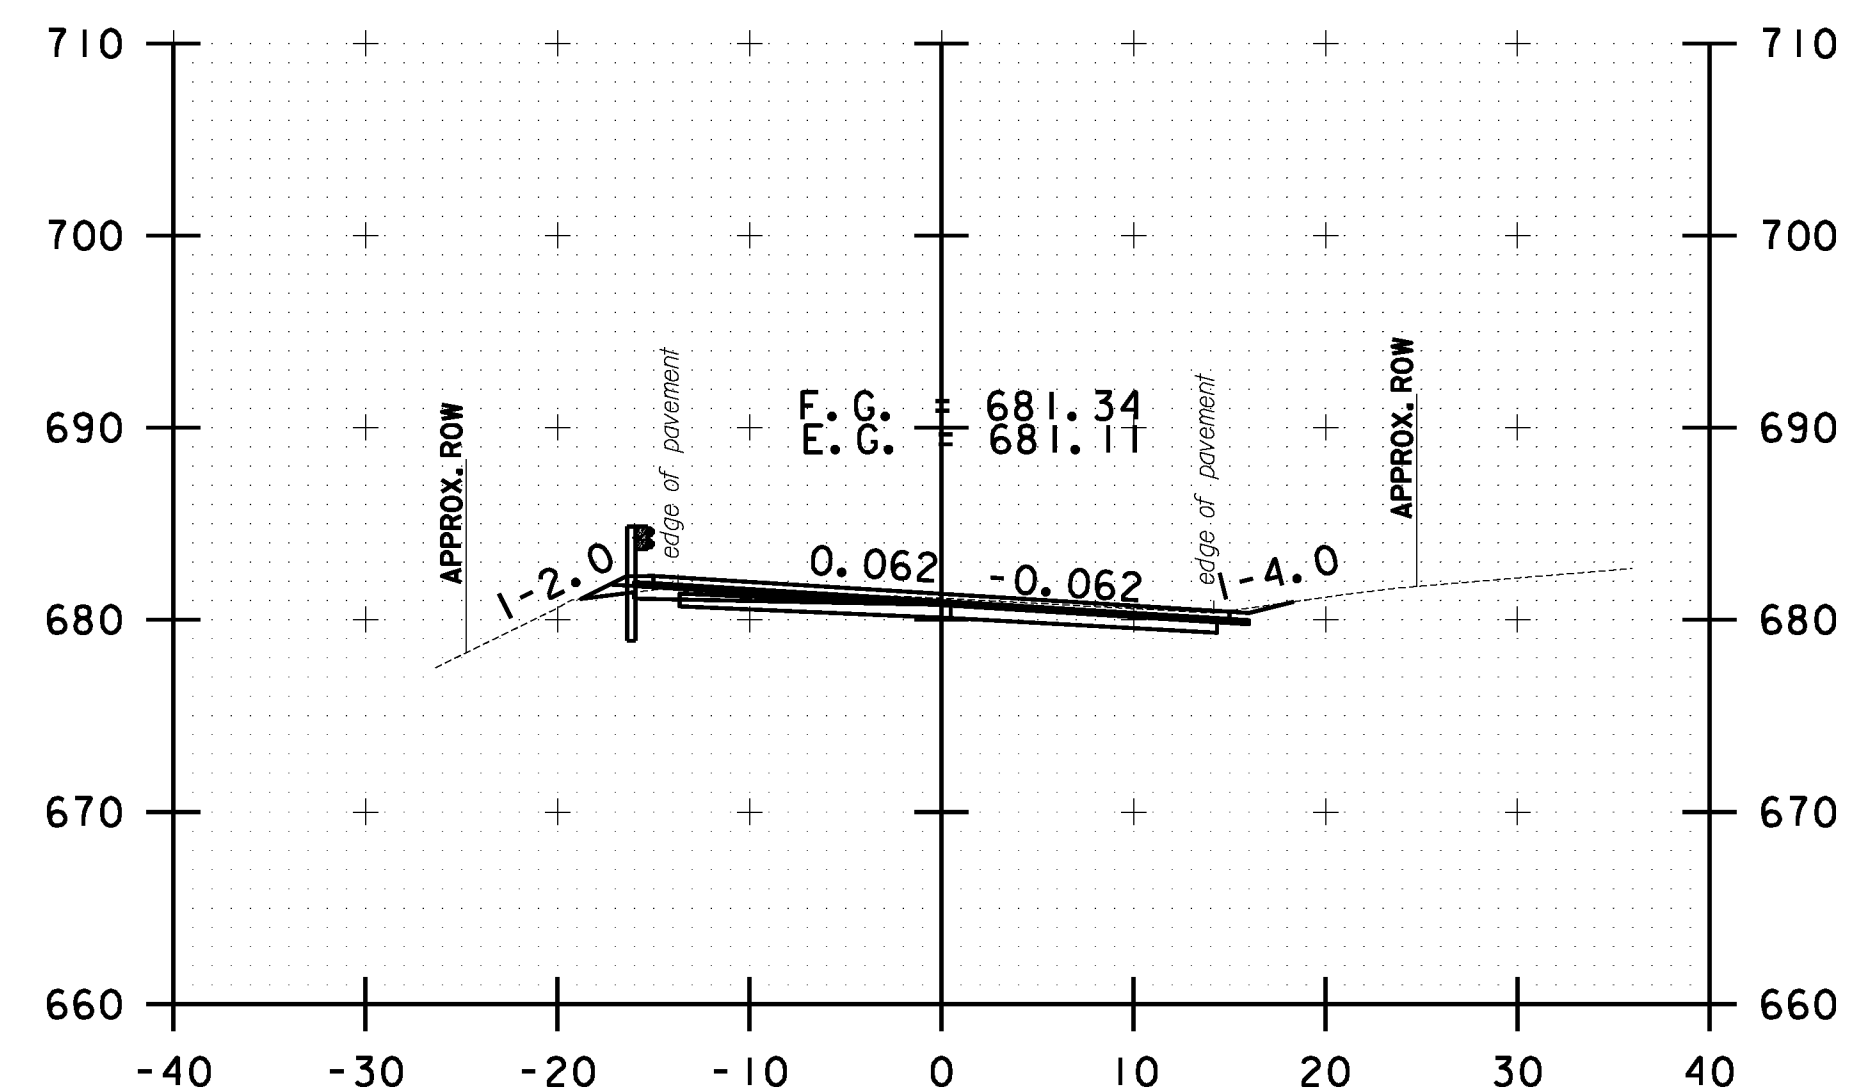

188+50.00



STOCKBRIDGE CROSS SECTION SHEET #58	PROJECT NAME: STOCKBRIDGE-BETHEL
	PROJECT NUMBER: STP 2910(1)
	FILE NAME: z10b214_stock_xc.dgn
DESIGNED BY: L.M.B.	PLOT DATE: 3/17/2014
IPARM FILE: z10b214xs58.1	DRAWN BY: W.G.P.
	CHECKED BY: J.P.S.
	SHEET 271 OF 397