



FILE NAME = \\157\projects\14NY\122426\CADD\1\STN\z10b214_stock_xc.dgn
 DATE = 3/17/2014
 USER = J4916




191+50.00

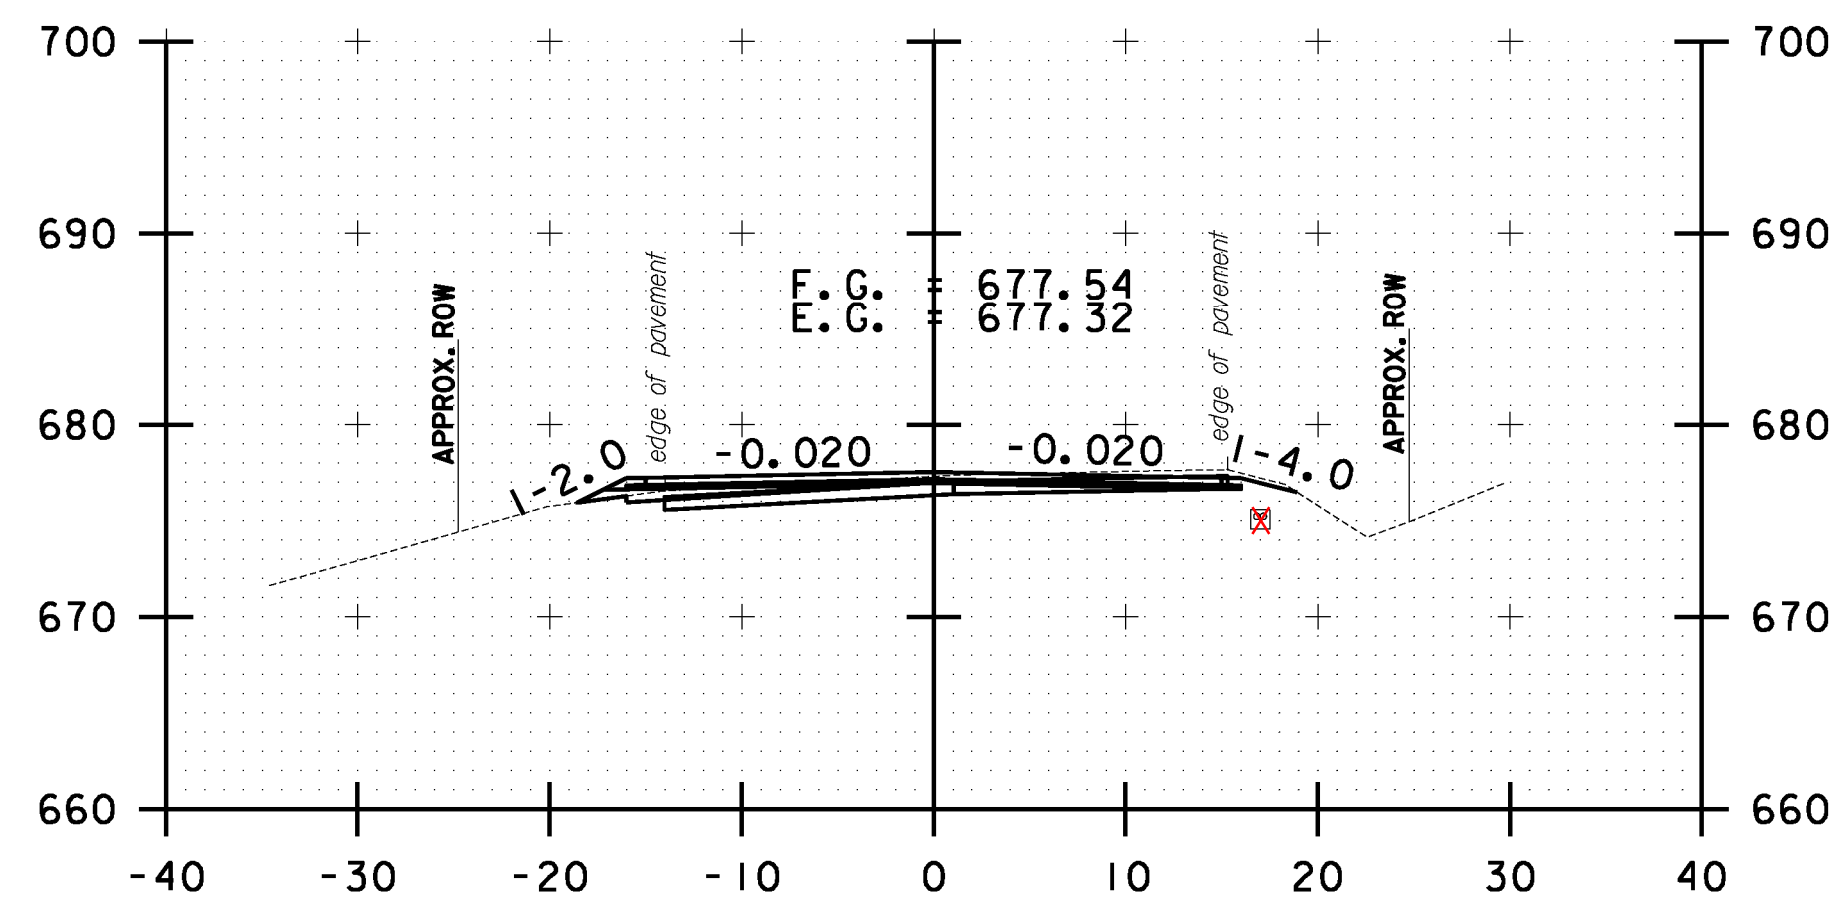


193+00.00

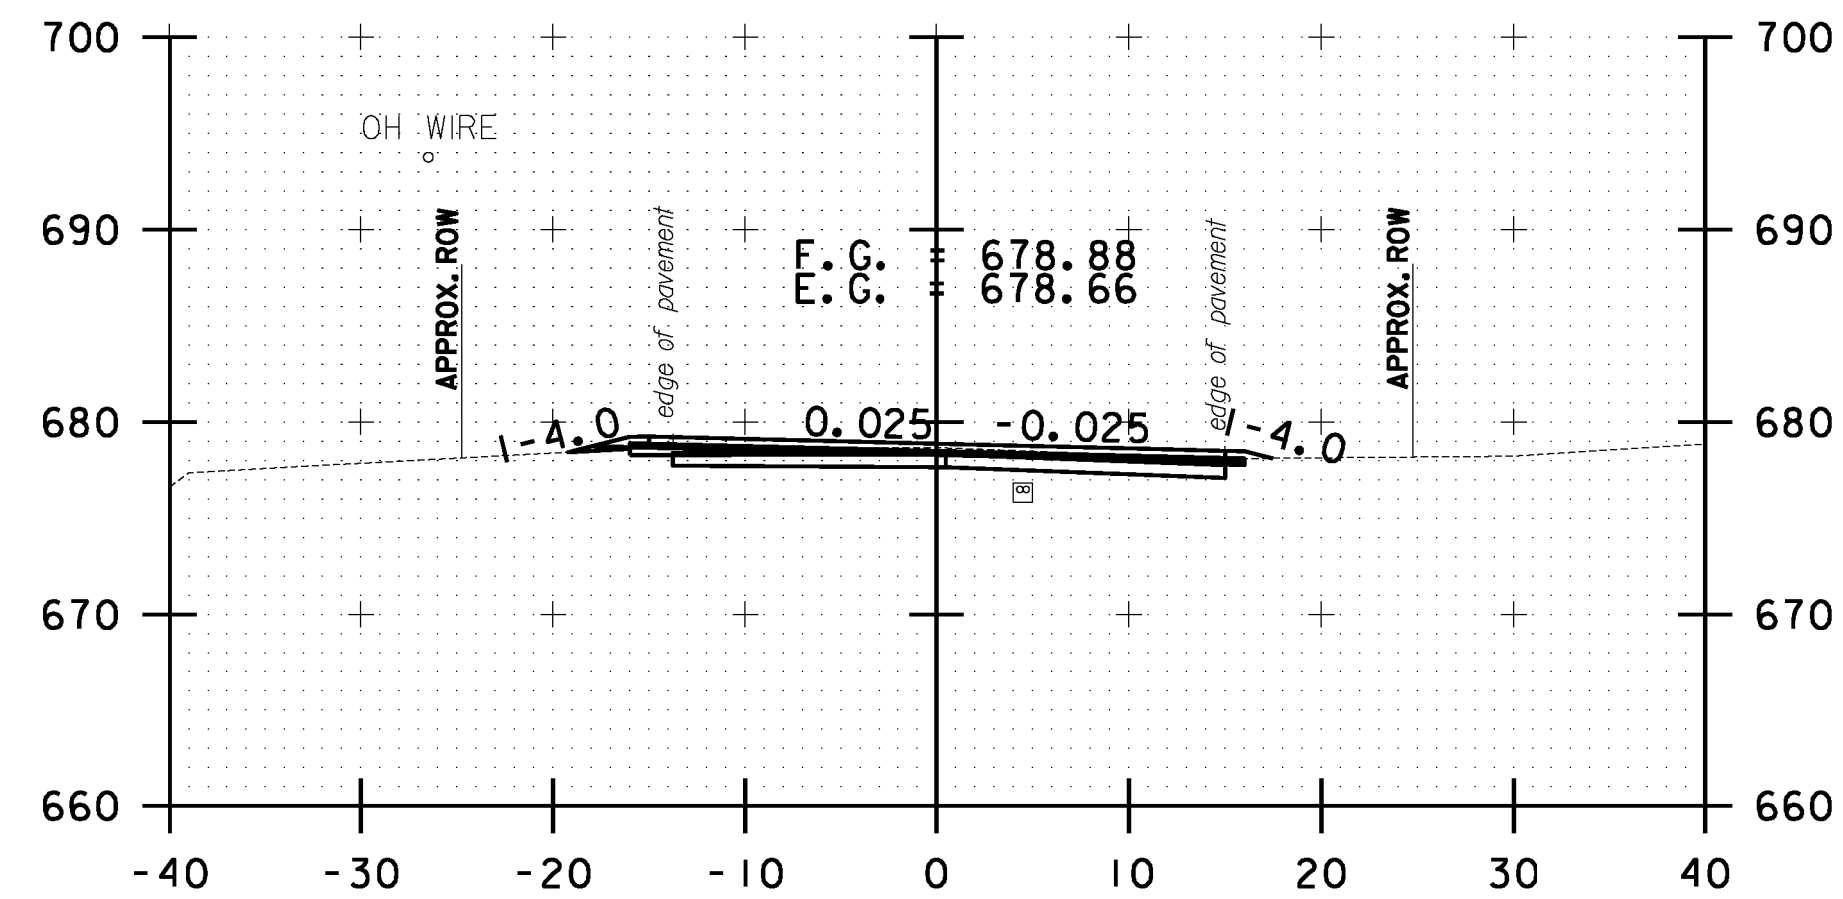


190+00.00

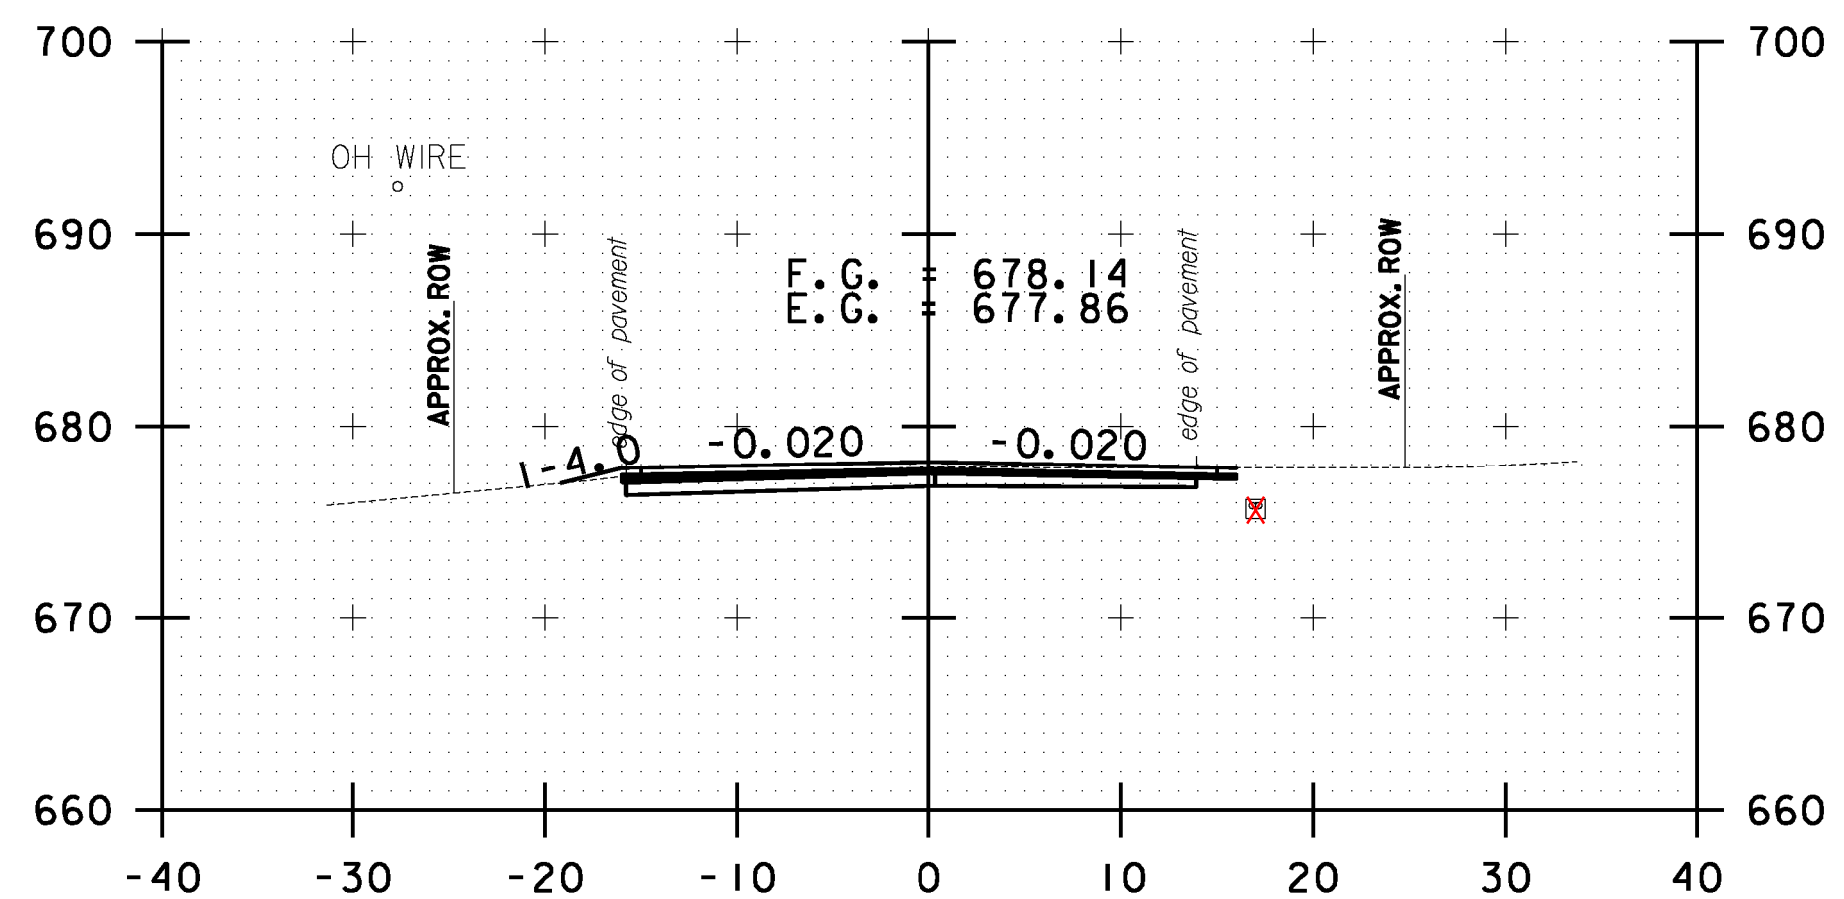


191+00.00

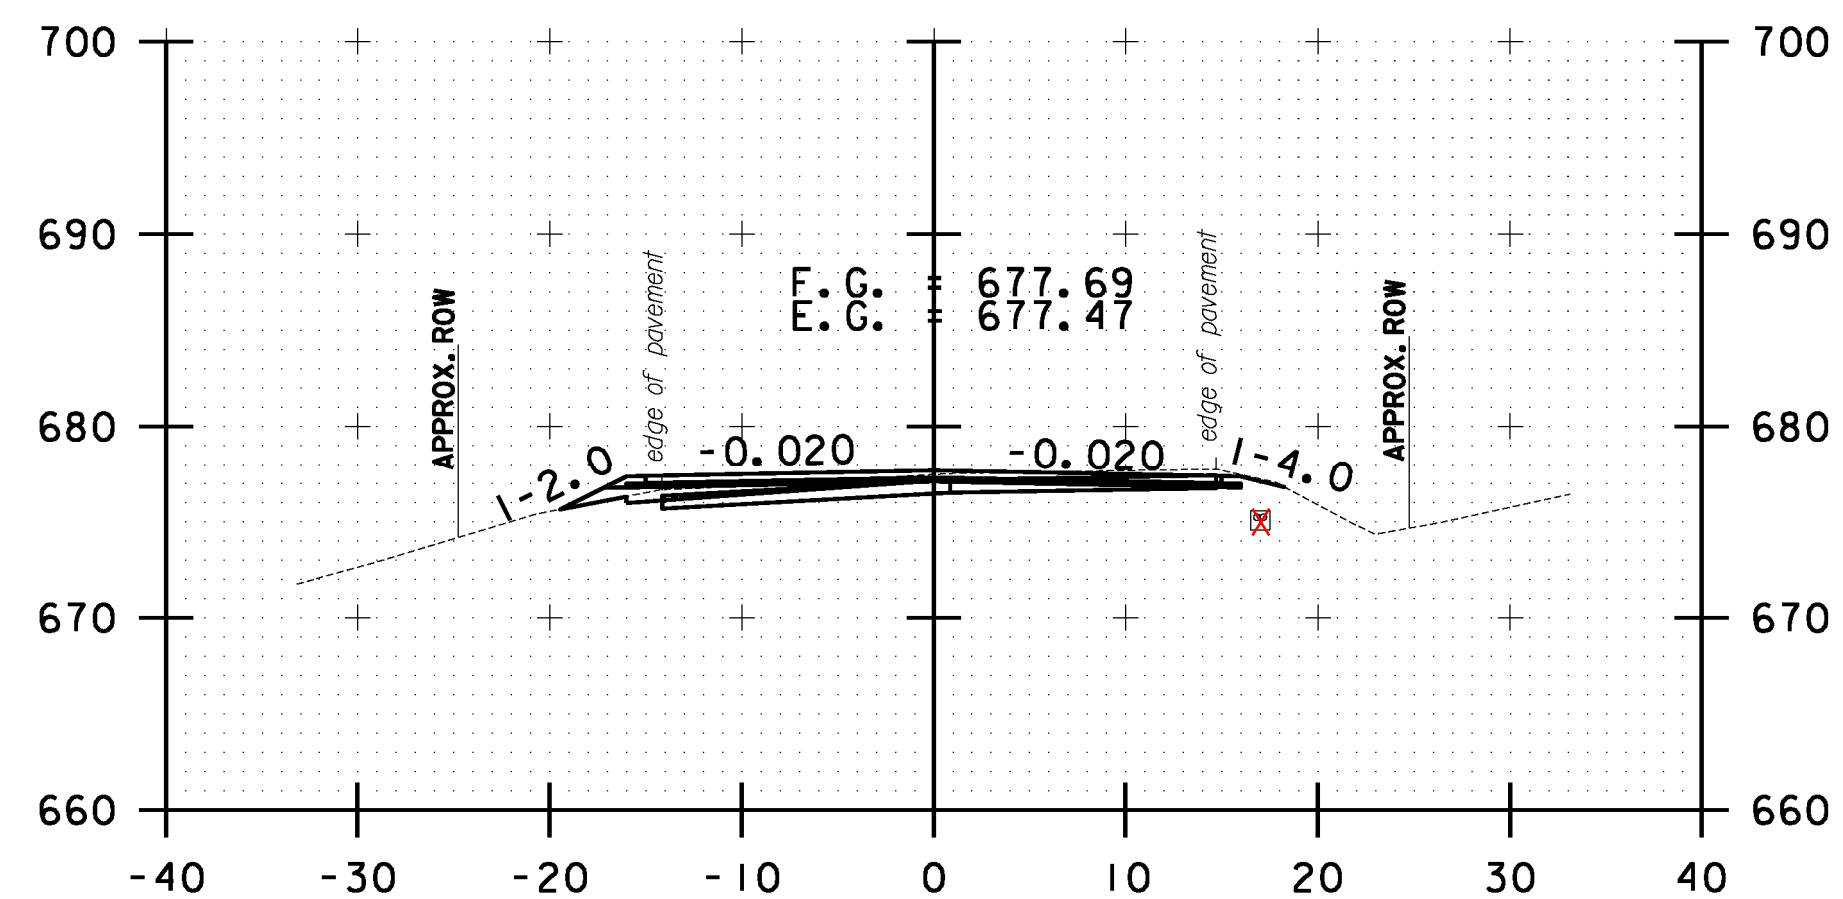


192+50.00

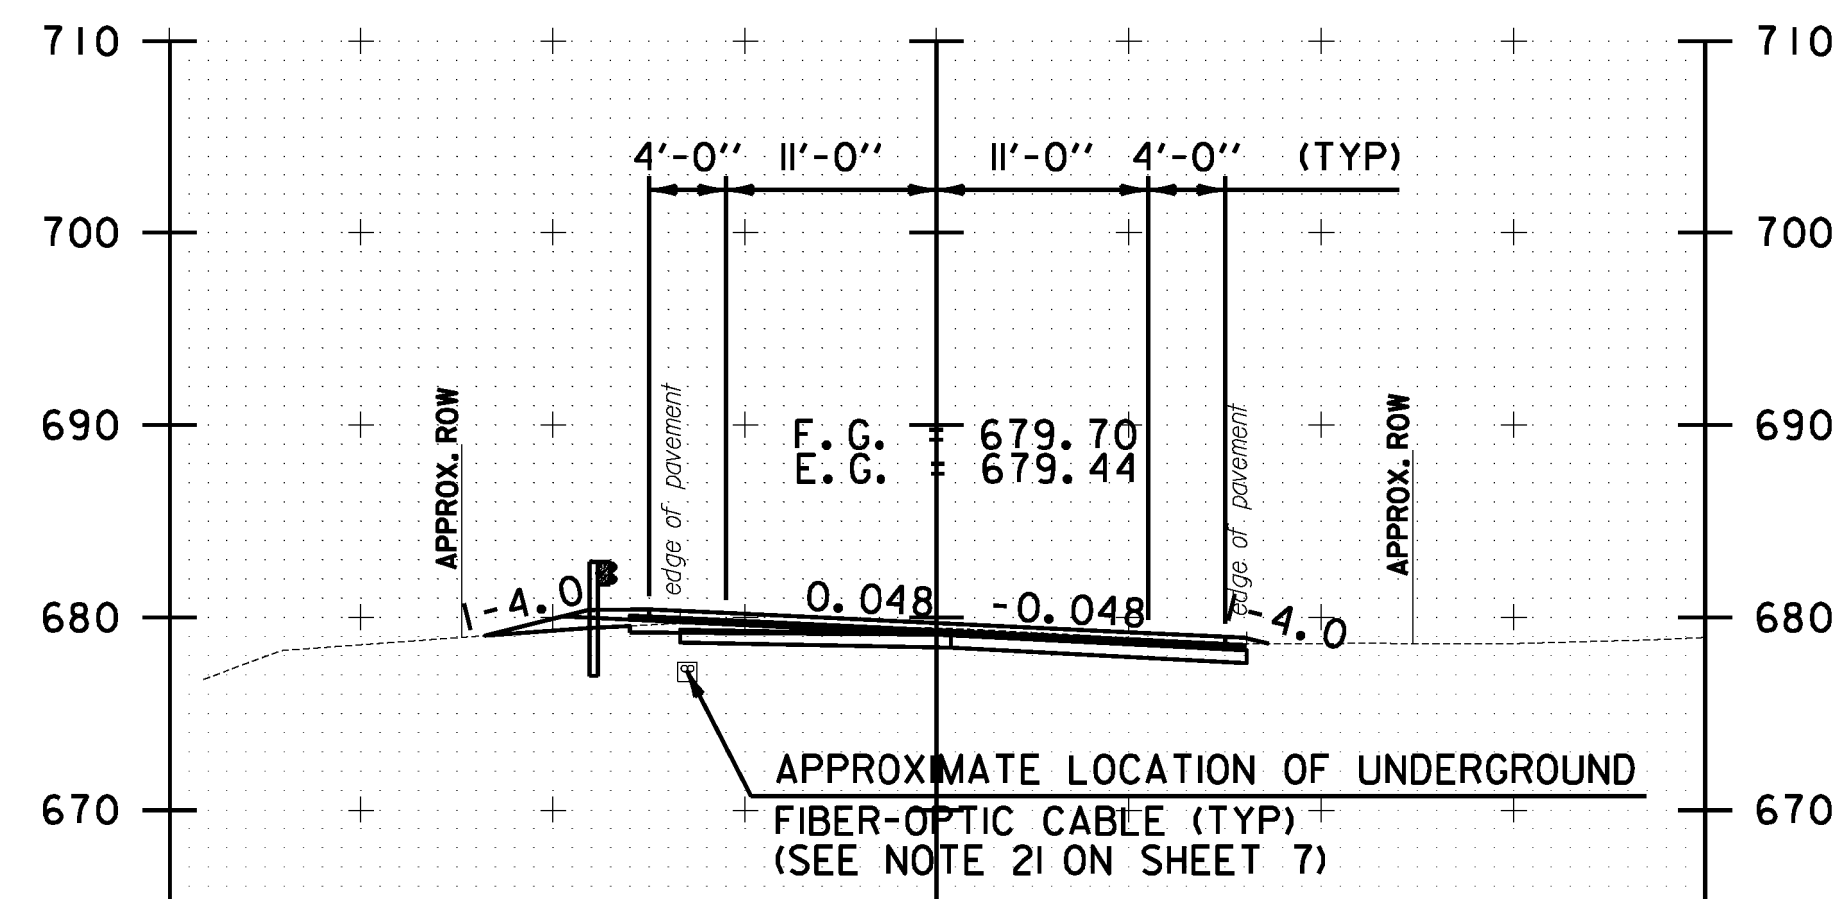


189+50.00

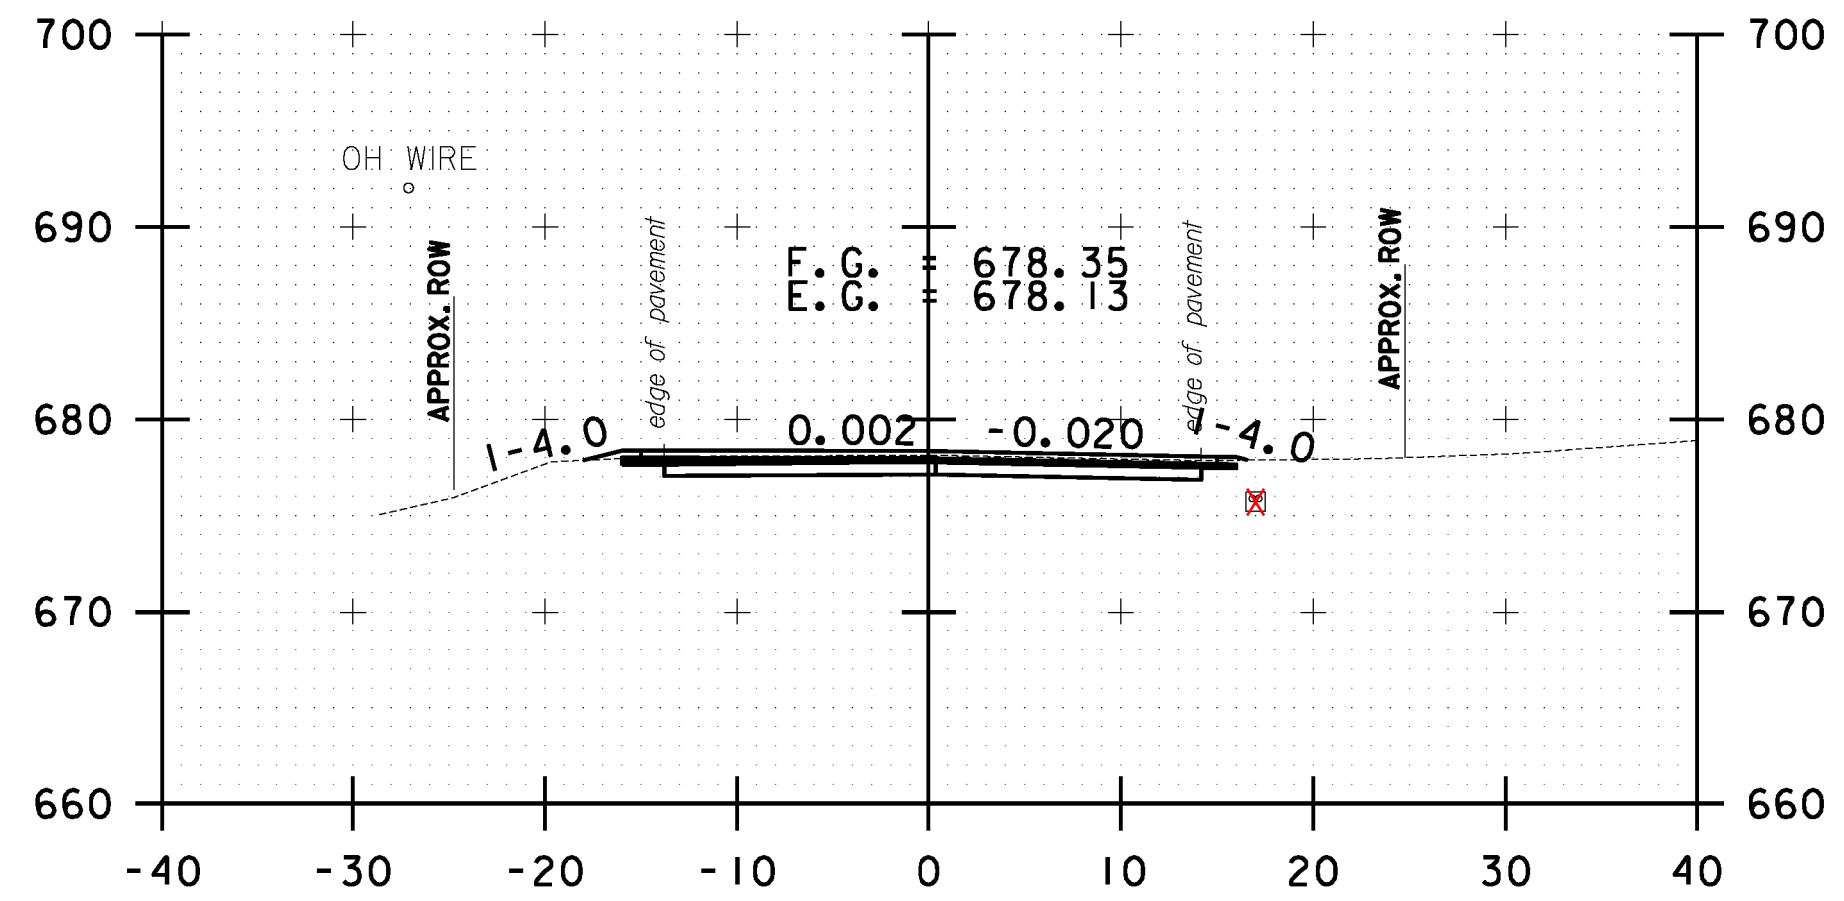

190+50.00

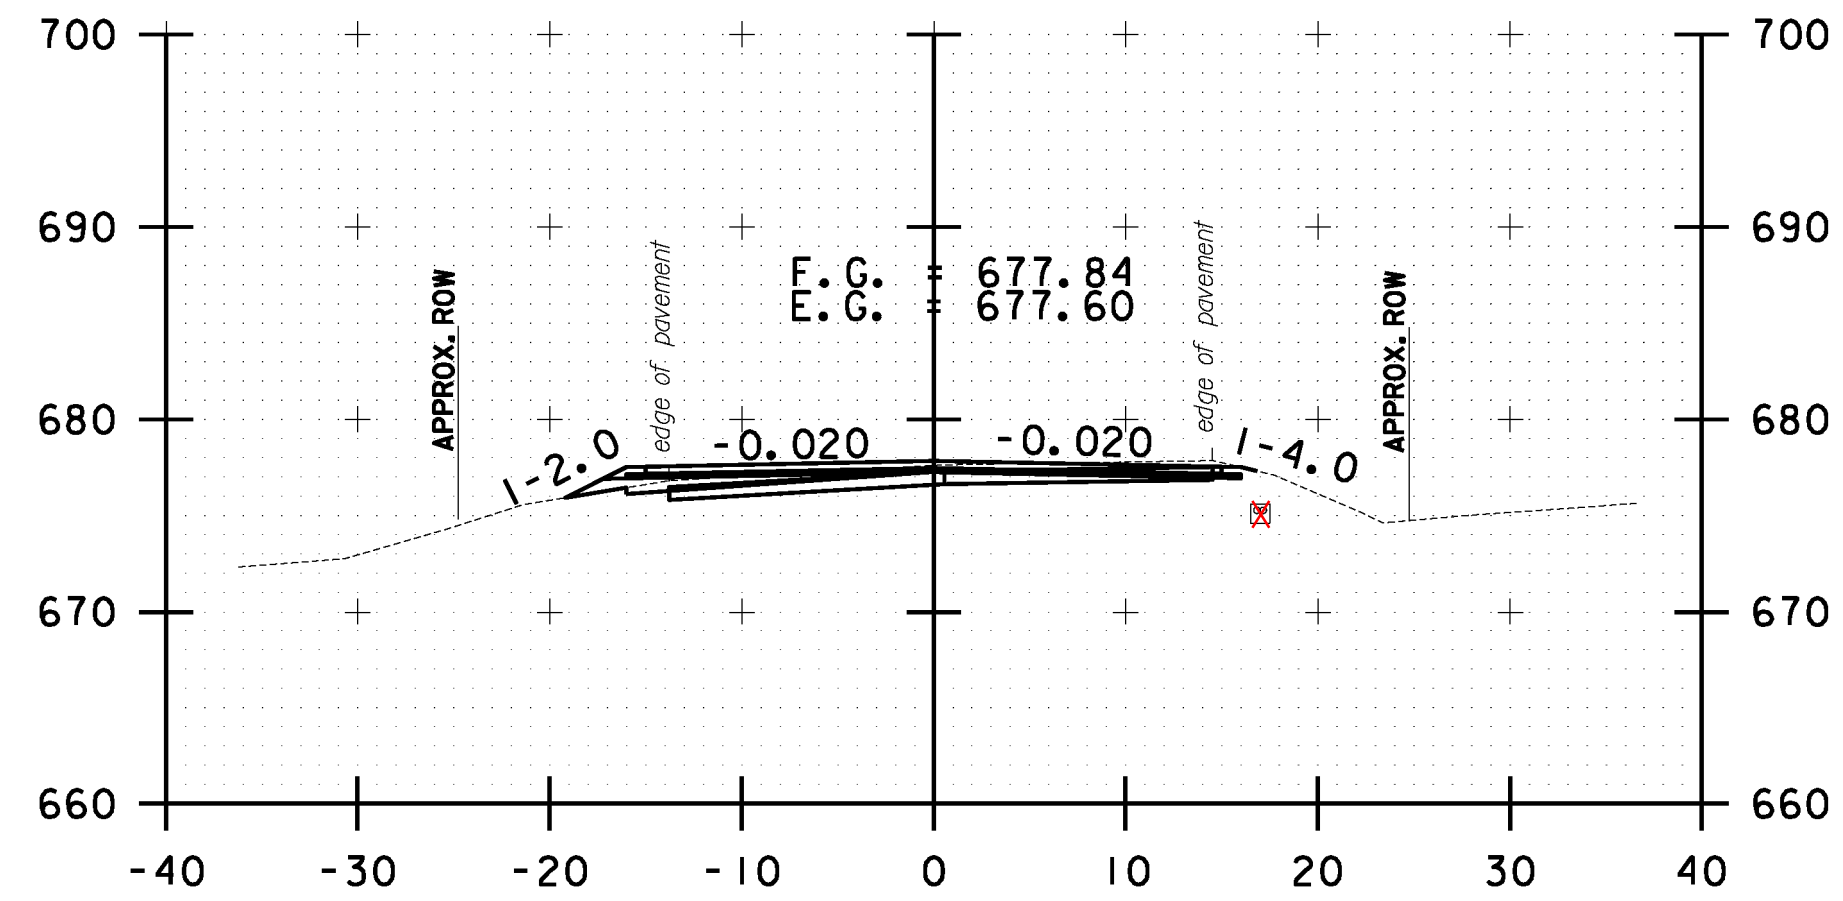

192+00.00

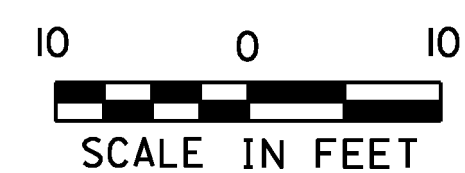

STOCKBRIDGE CROSS SECTION SHEET #59	PROJECT NAME: STOCKBRIDGE-BETHEL	PLOT DATE: 3/17/2014
	PROJECT NUMBER: STP 2910(1)	DRAWN BY: W.G.P.
	FILE NAME: z10b214_stock_xc.dgn	CHECKED BY: J.P.S.
	PROJECT LEADER: D.E.G. DESIGNED BY: L.M.B. IPARM FILE: z10b214xs59.1	SHEET 272 OF 397