




FILE NAME = \\157\projects\151\122426\CADD\MST\12\10b214\_stock\_xc.dgn  
 DATE = 3/17/2014  
 USER = LMB

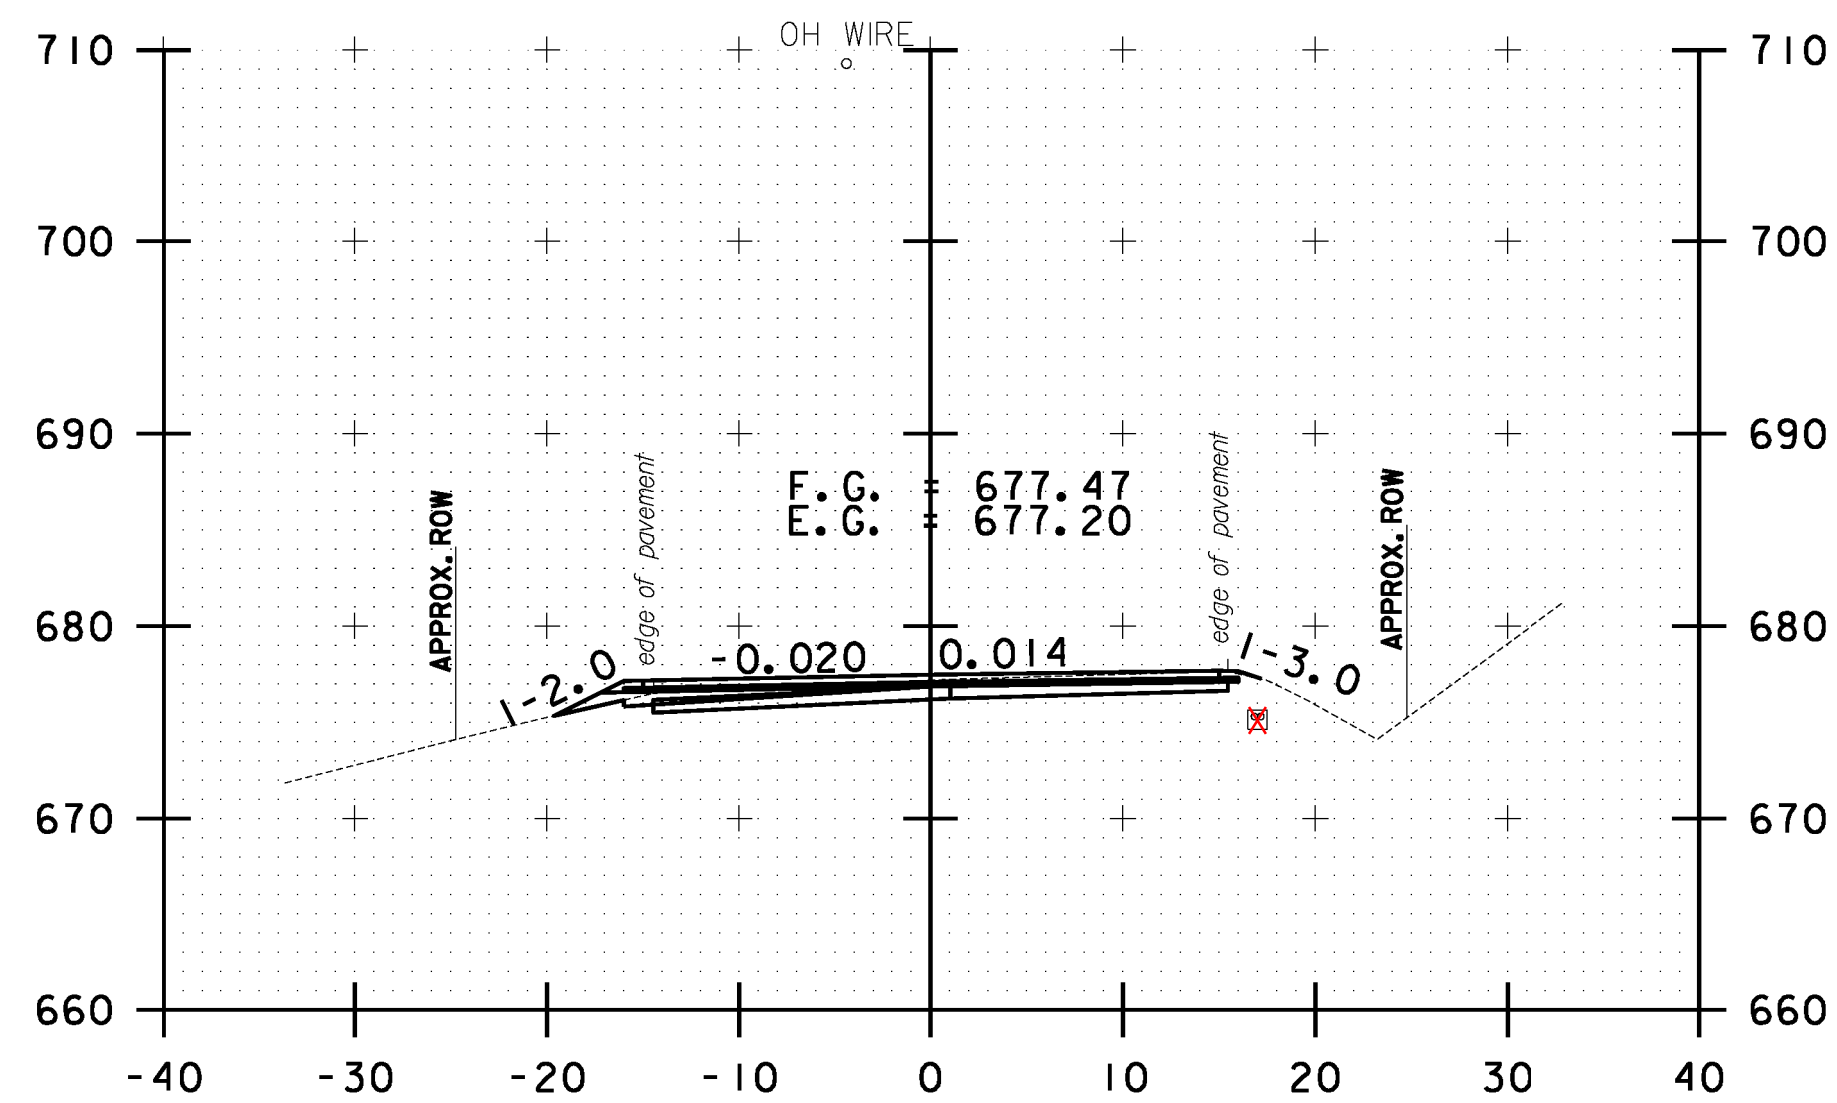


194+00.00

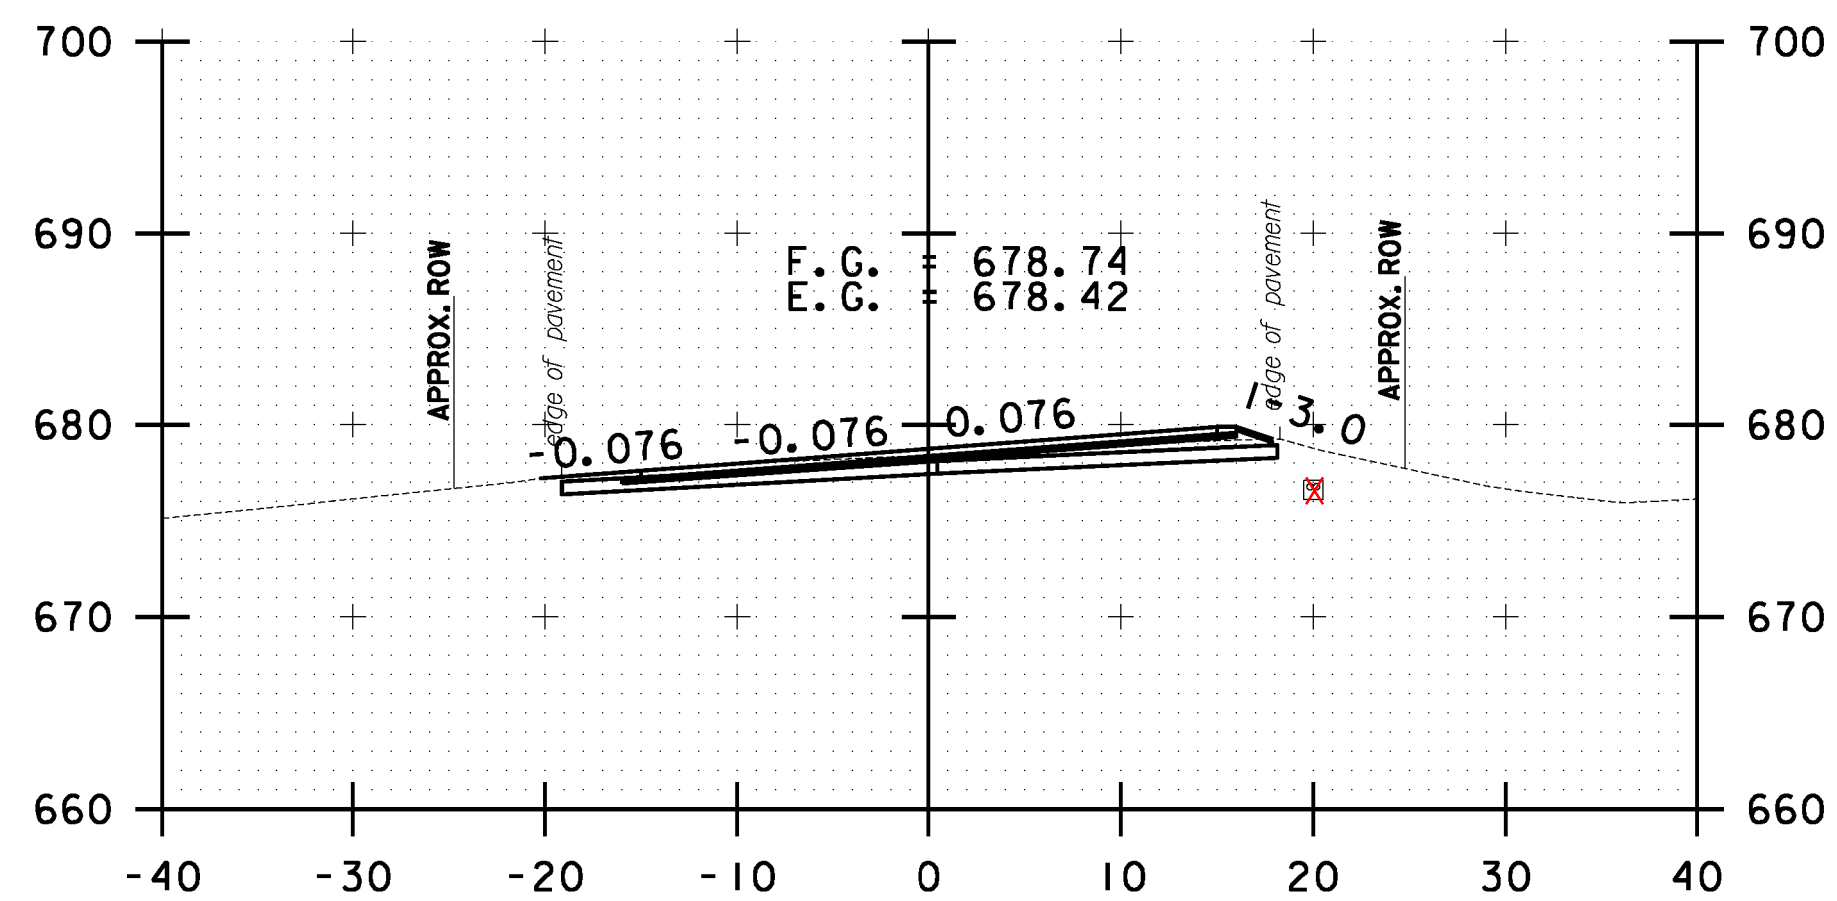


195+50.00

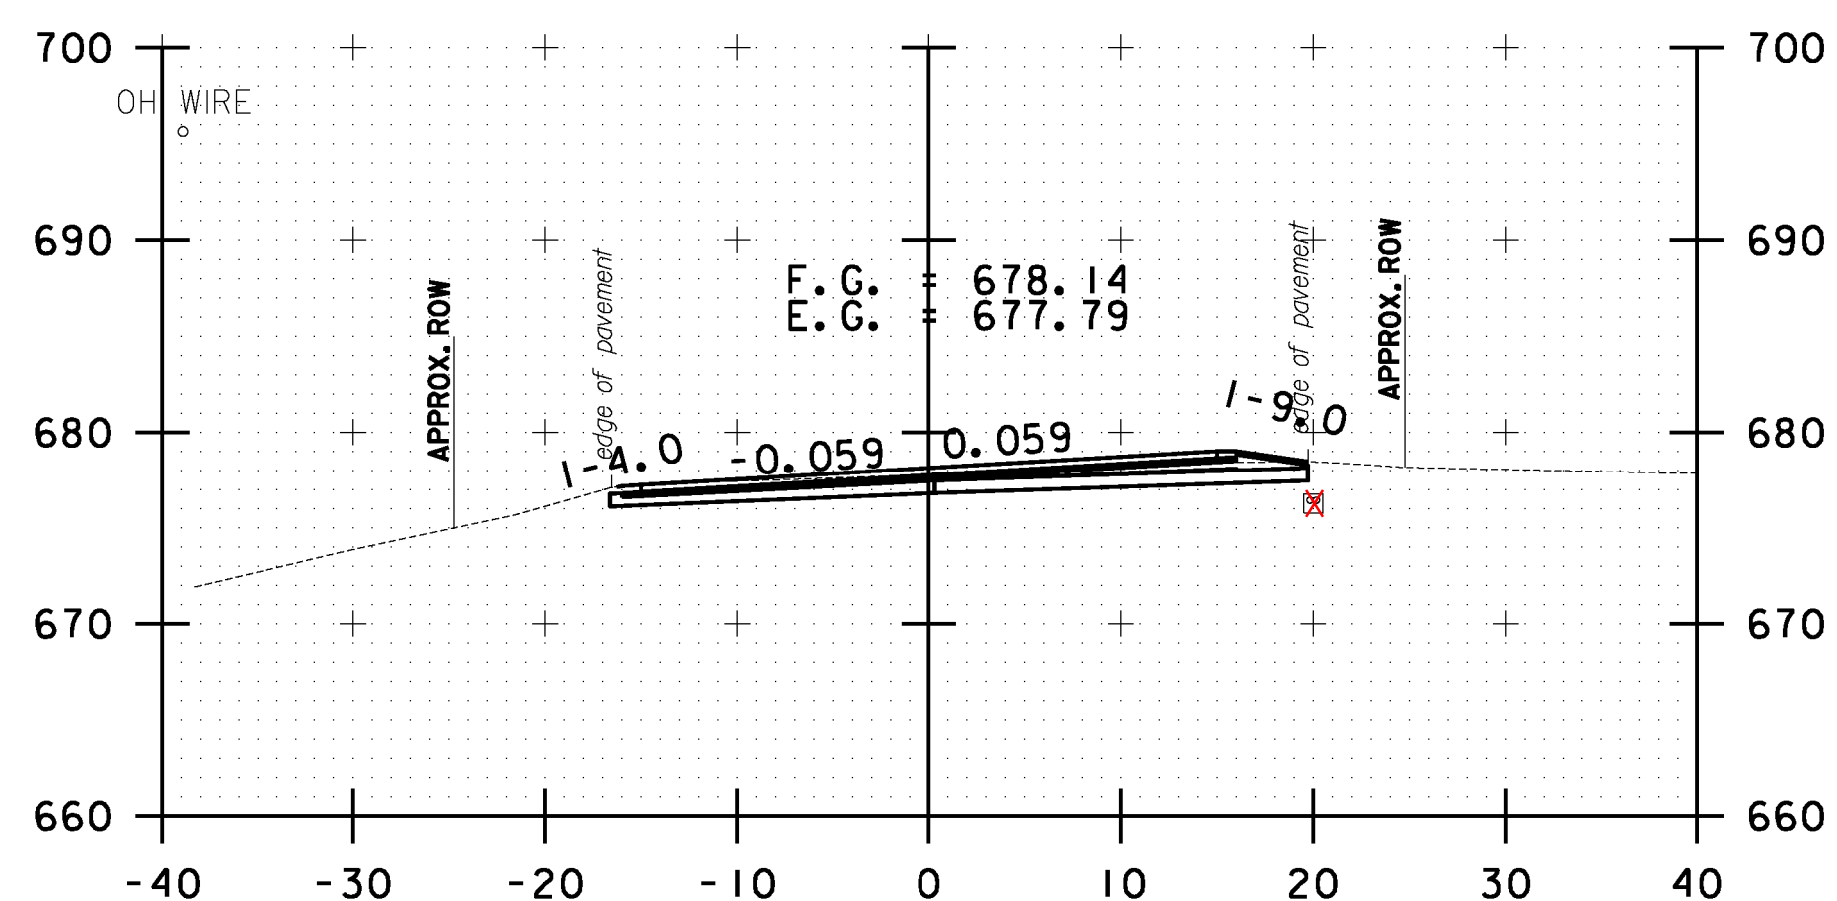


195+00.00

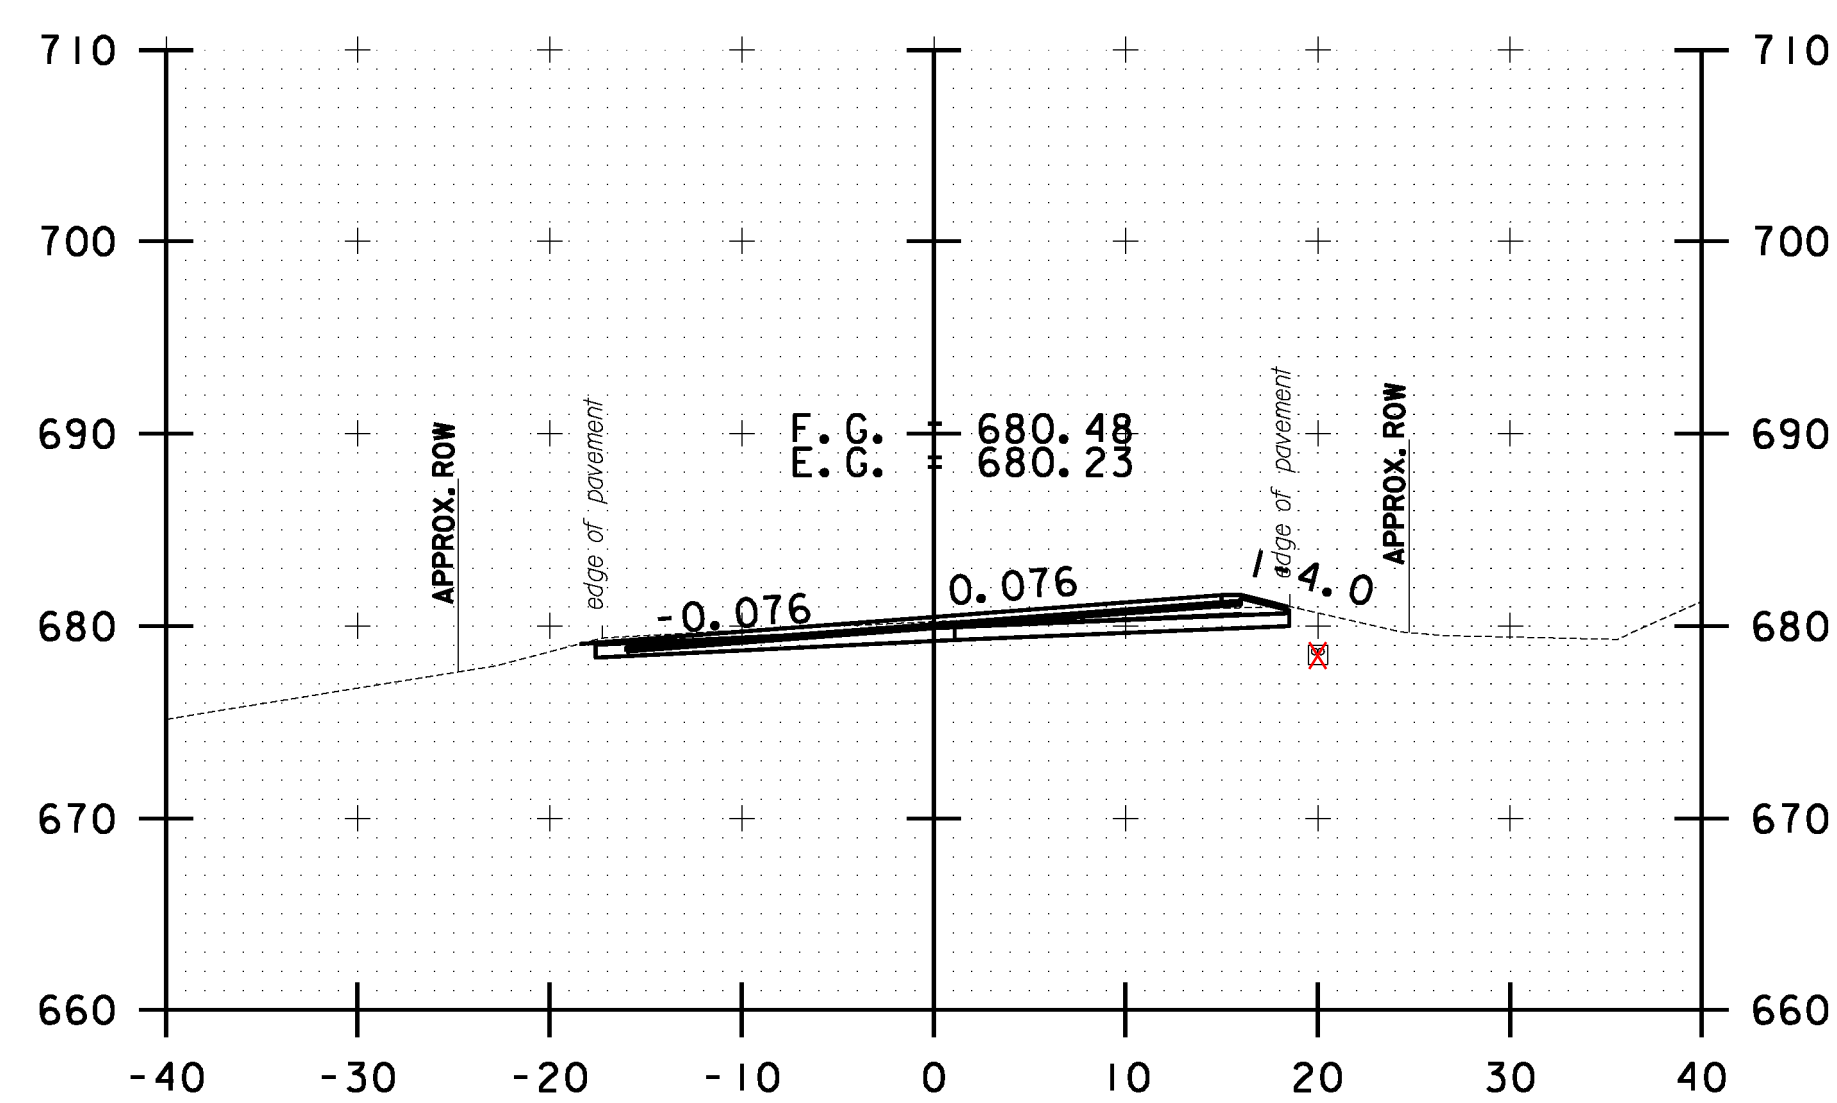


196+50.00

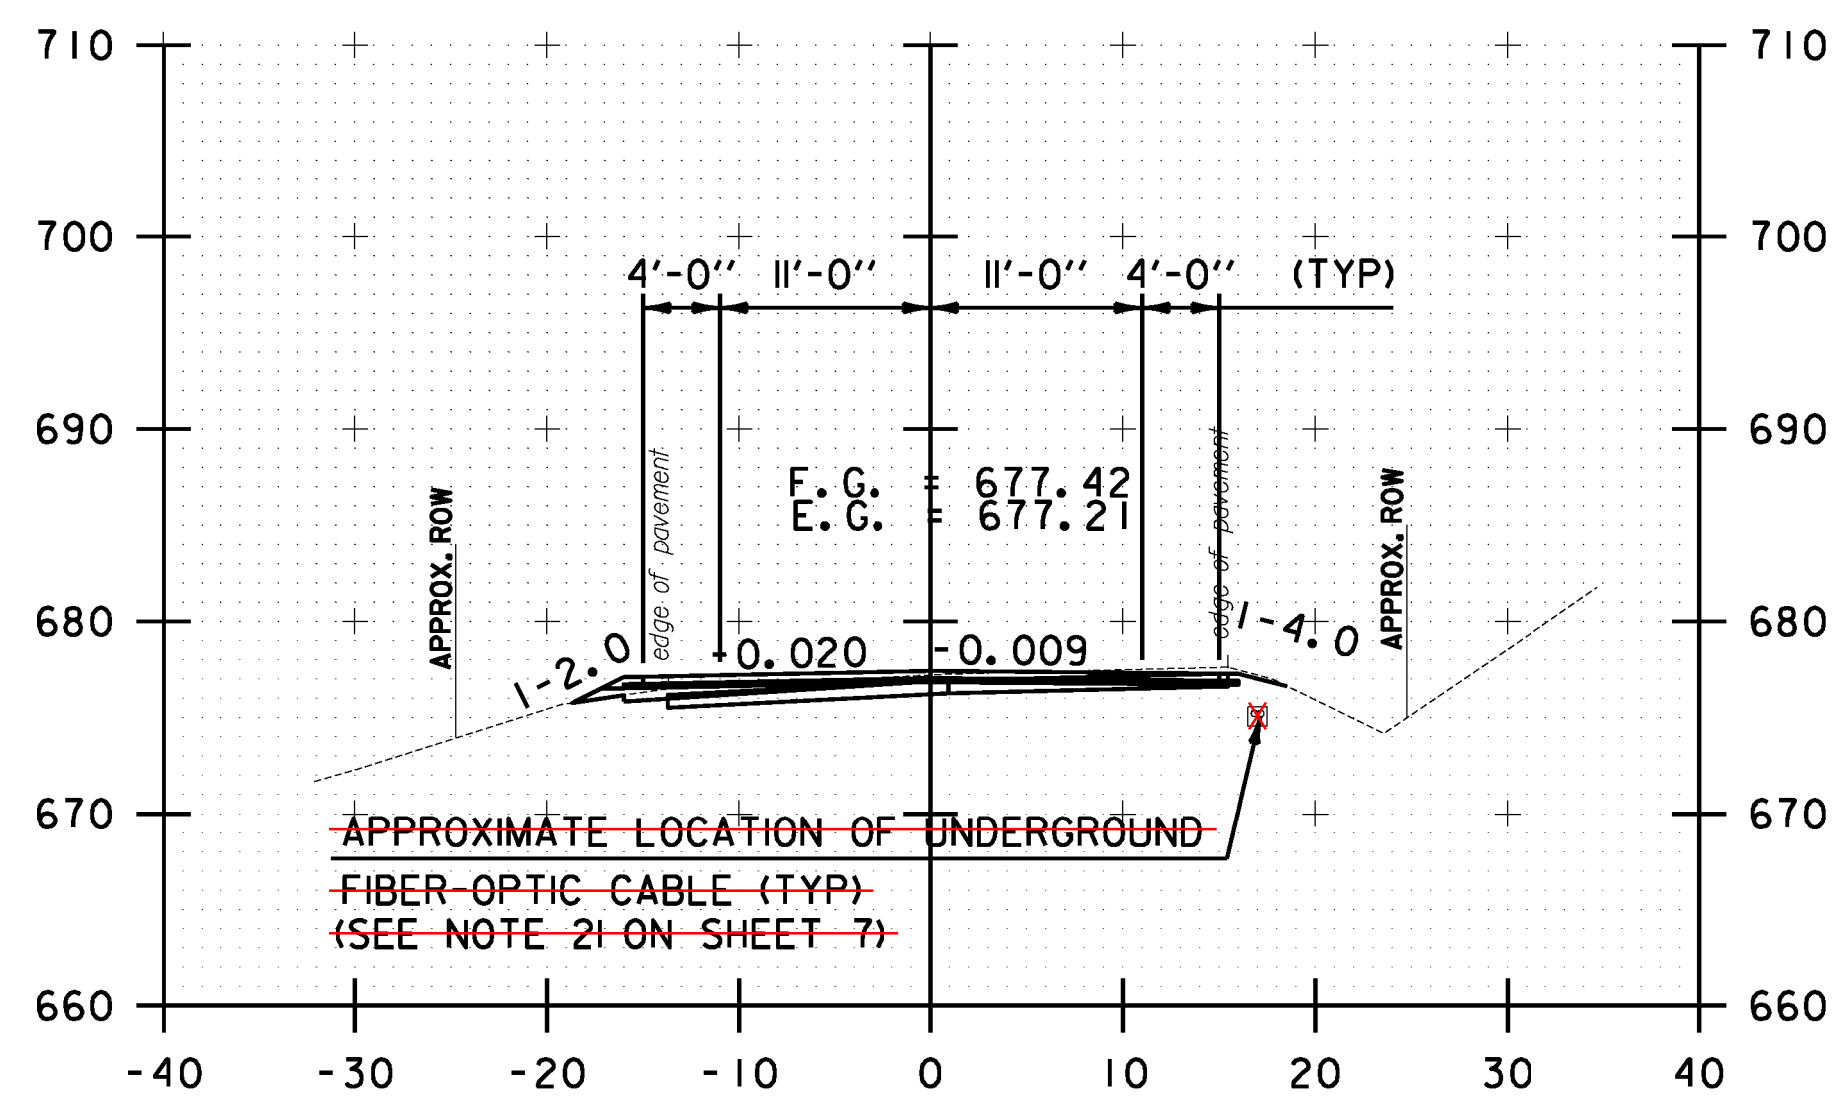


193+50.00

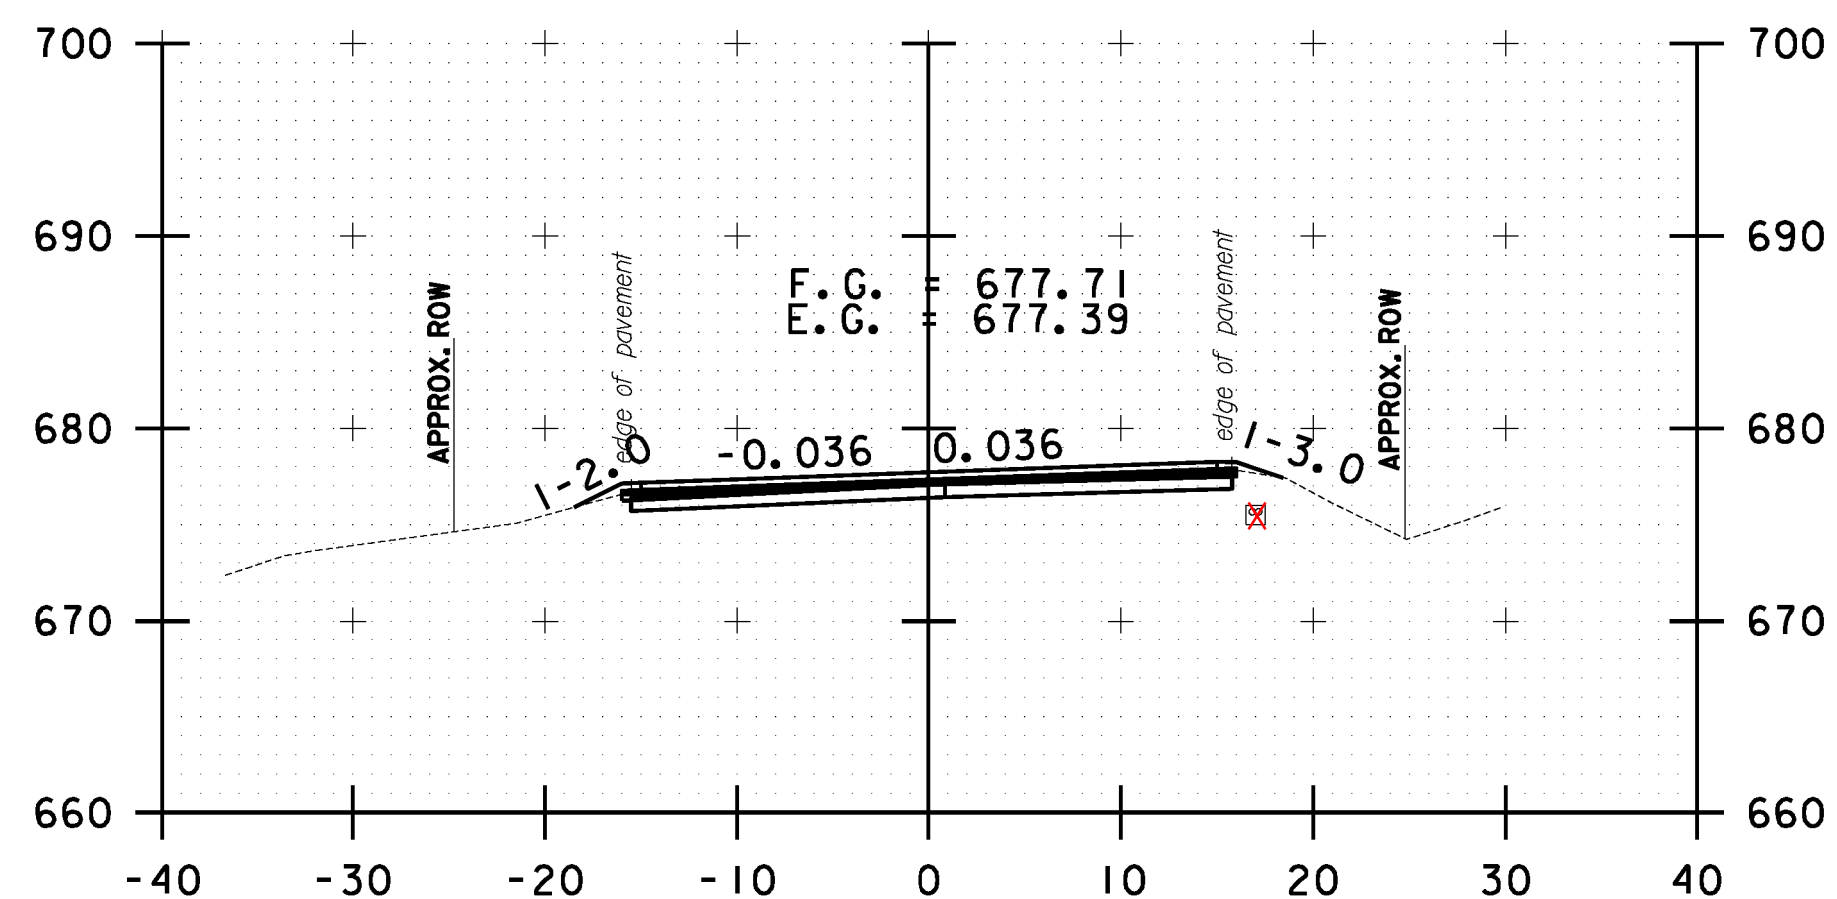

194+50.00

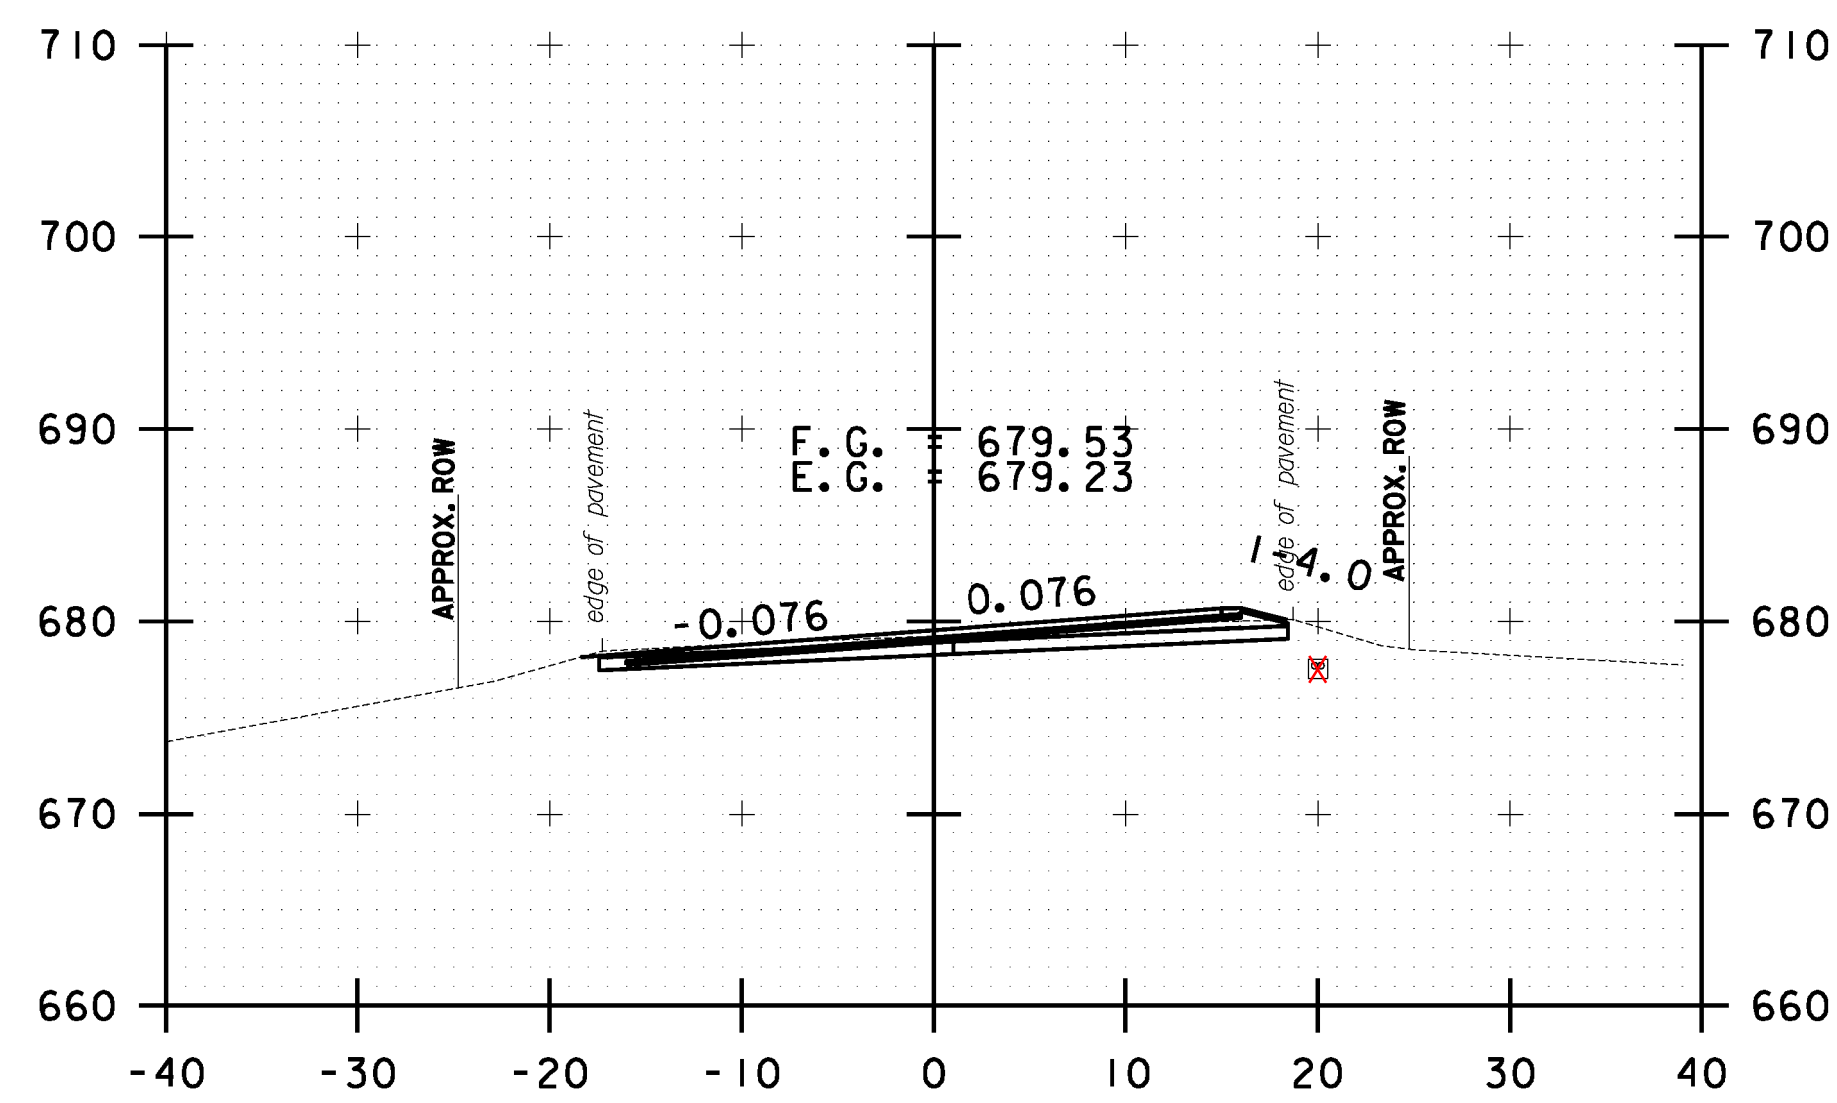

196+00.00

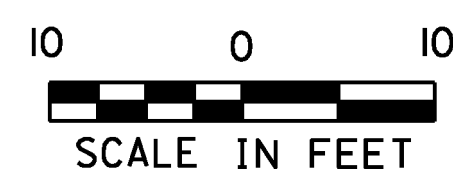

<b>STOCKBRIDGE CROSS SECTION SHEET #60</b>	PROJECT NAME: STOCKBRIDGE-BETHEL
	PROJECT NUMBER: STP 2910(1)
	FILE NAME: z10b214_stock_xc.dgn
	IPARM FILE: z10b214xs60.i
	PLOT DATE: 3/17/2014
	DRAWN BY: W.G.P.
	CHECKED BY: J.P.S.
	SHEET 273 OF 397