




FILE NAME = \\172\projects\14\172\14\22426\CADD\1\STN\z10b214_stock_xc.dgn
 DATE TIME = 3/17/2014 1:49:16
 USER = j4916

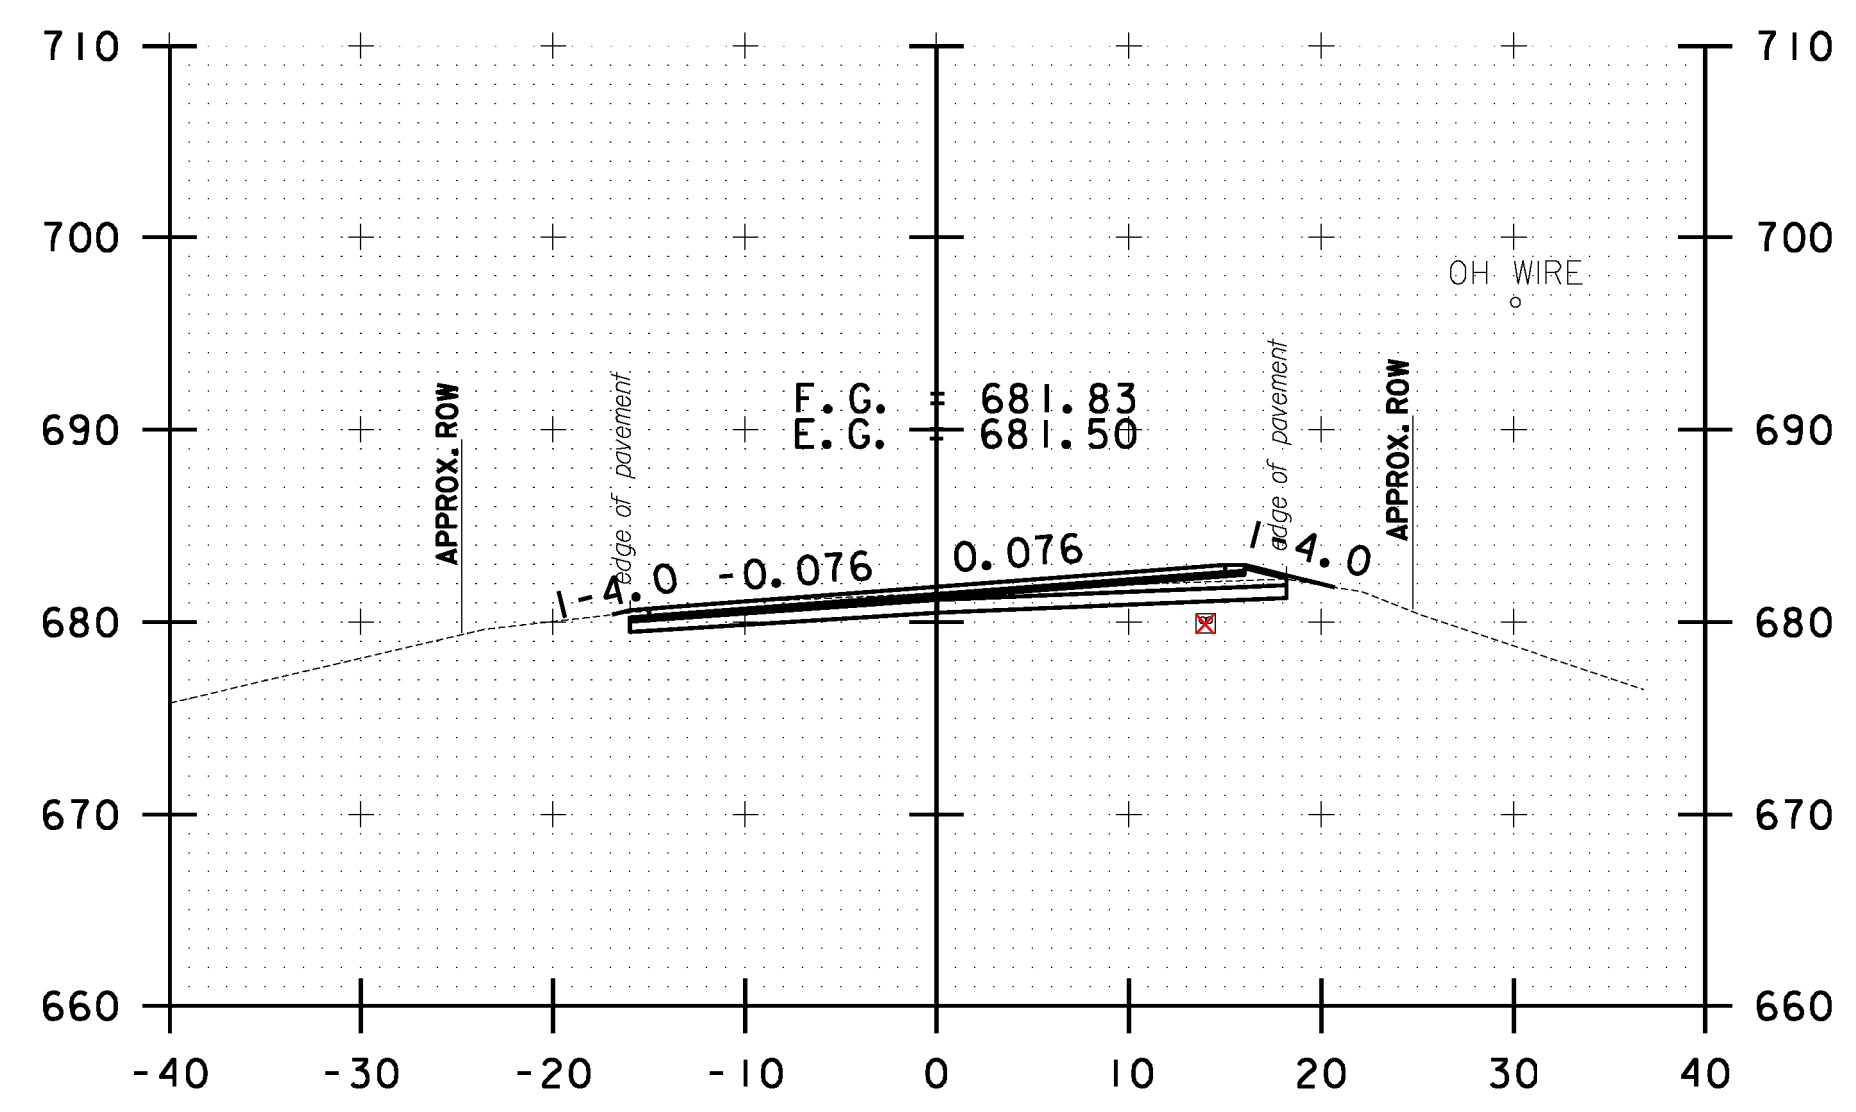


200+50.00

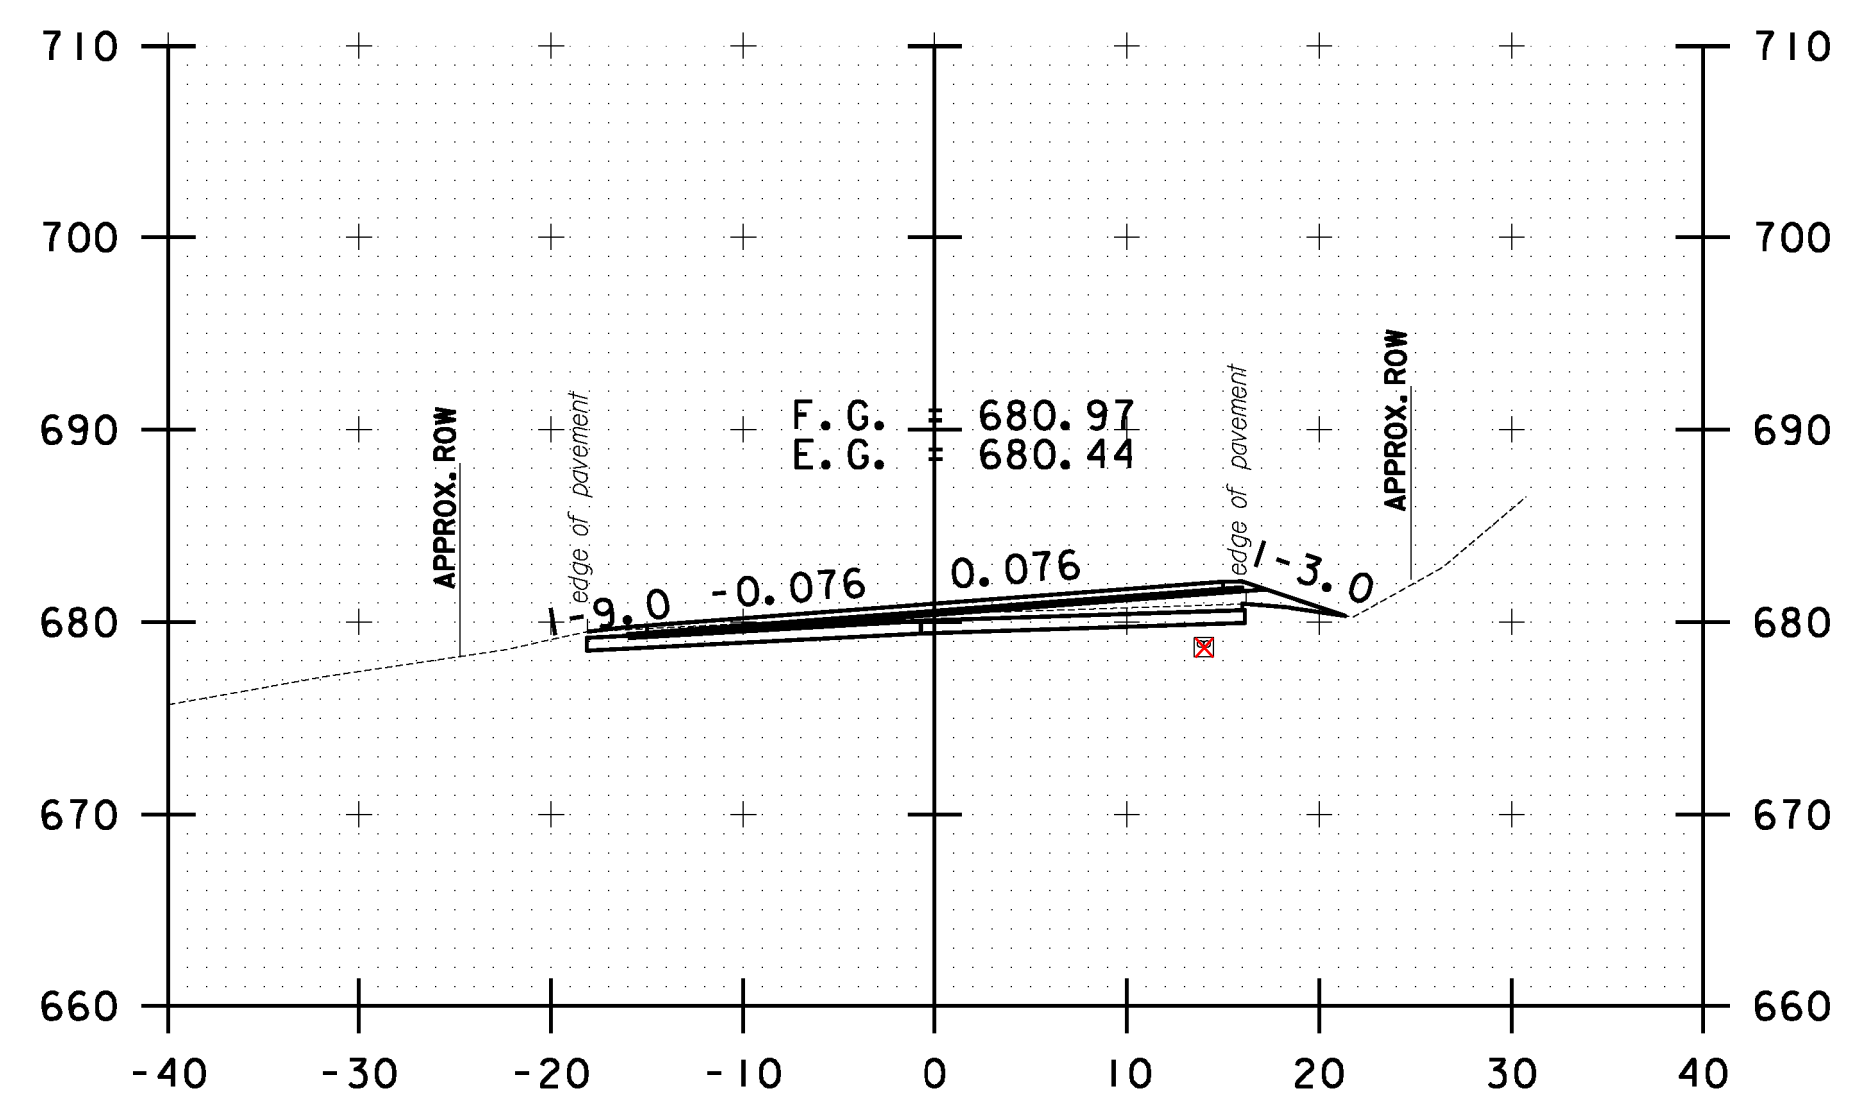


201+50.00

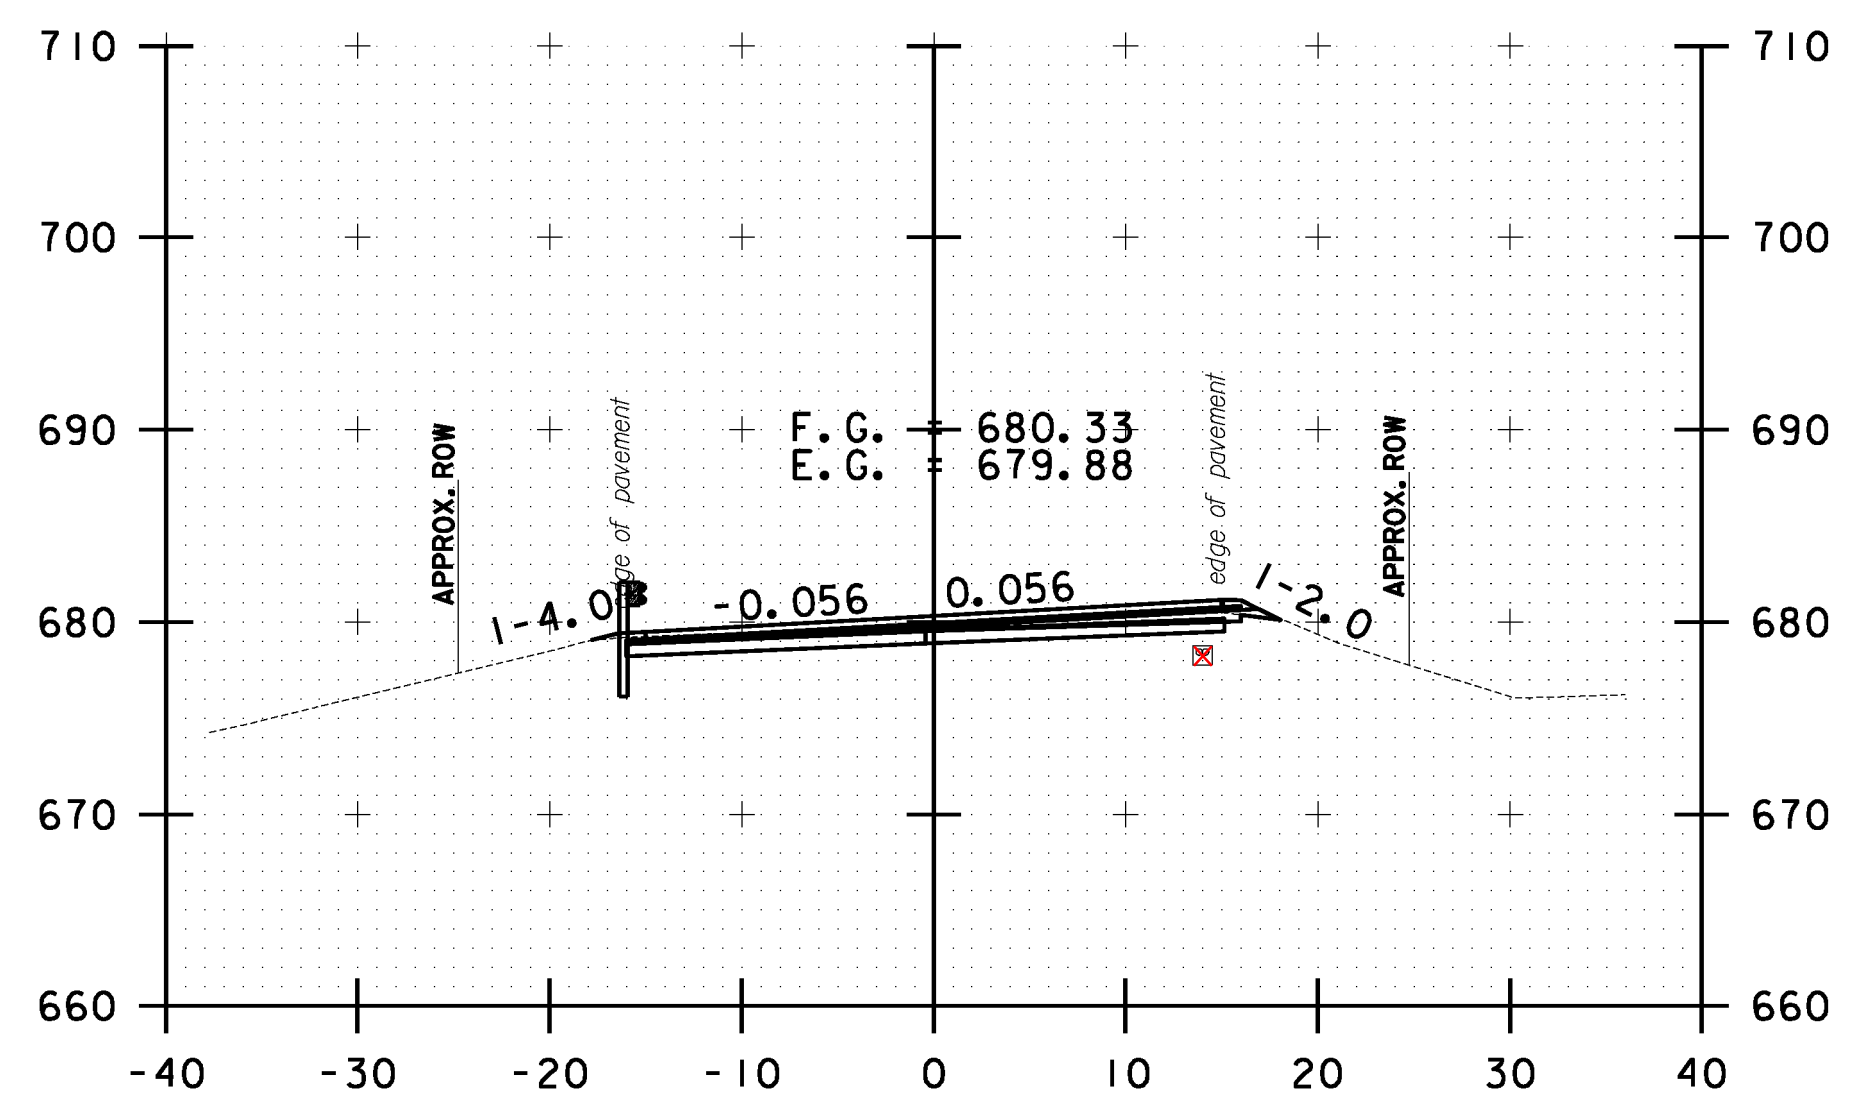


202+50.00

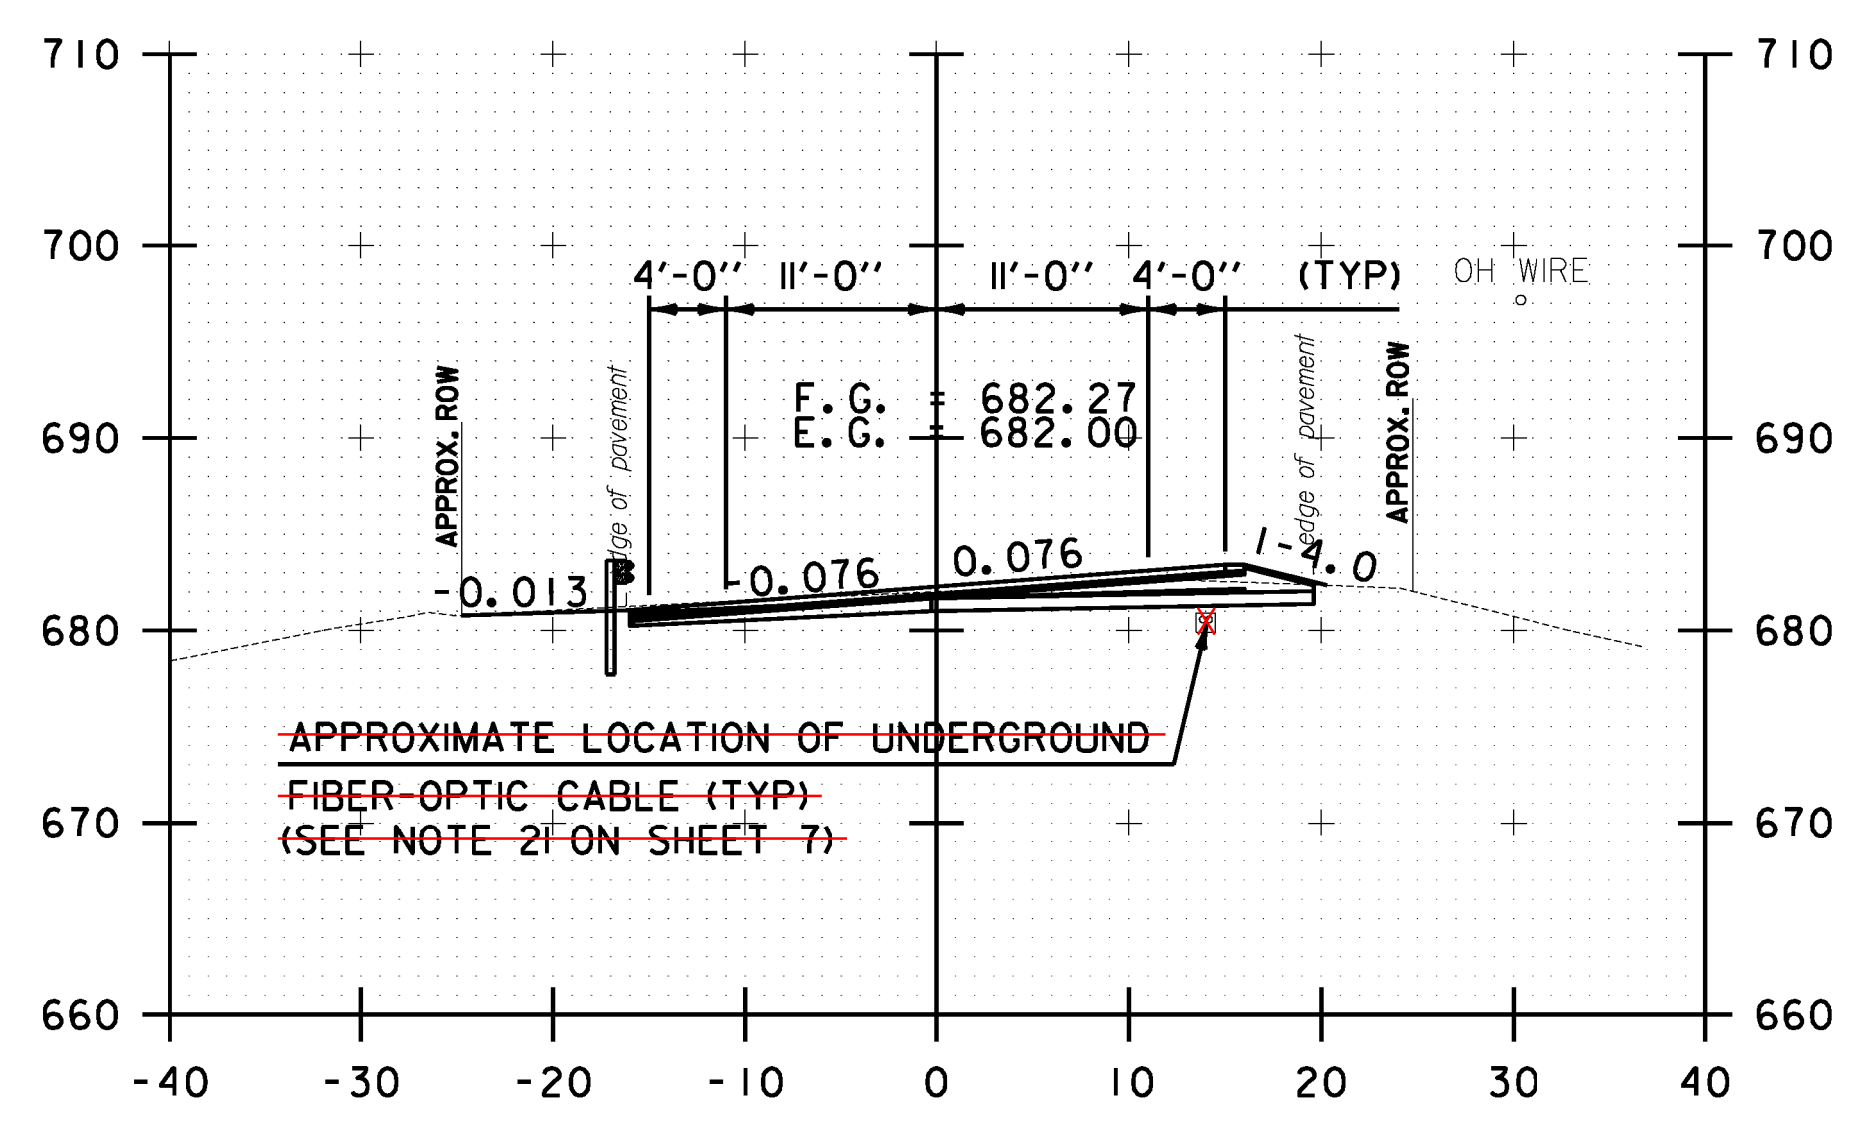


200+00.00

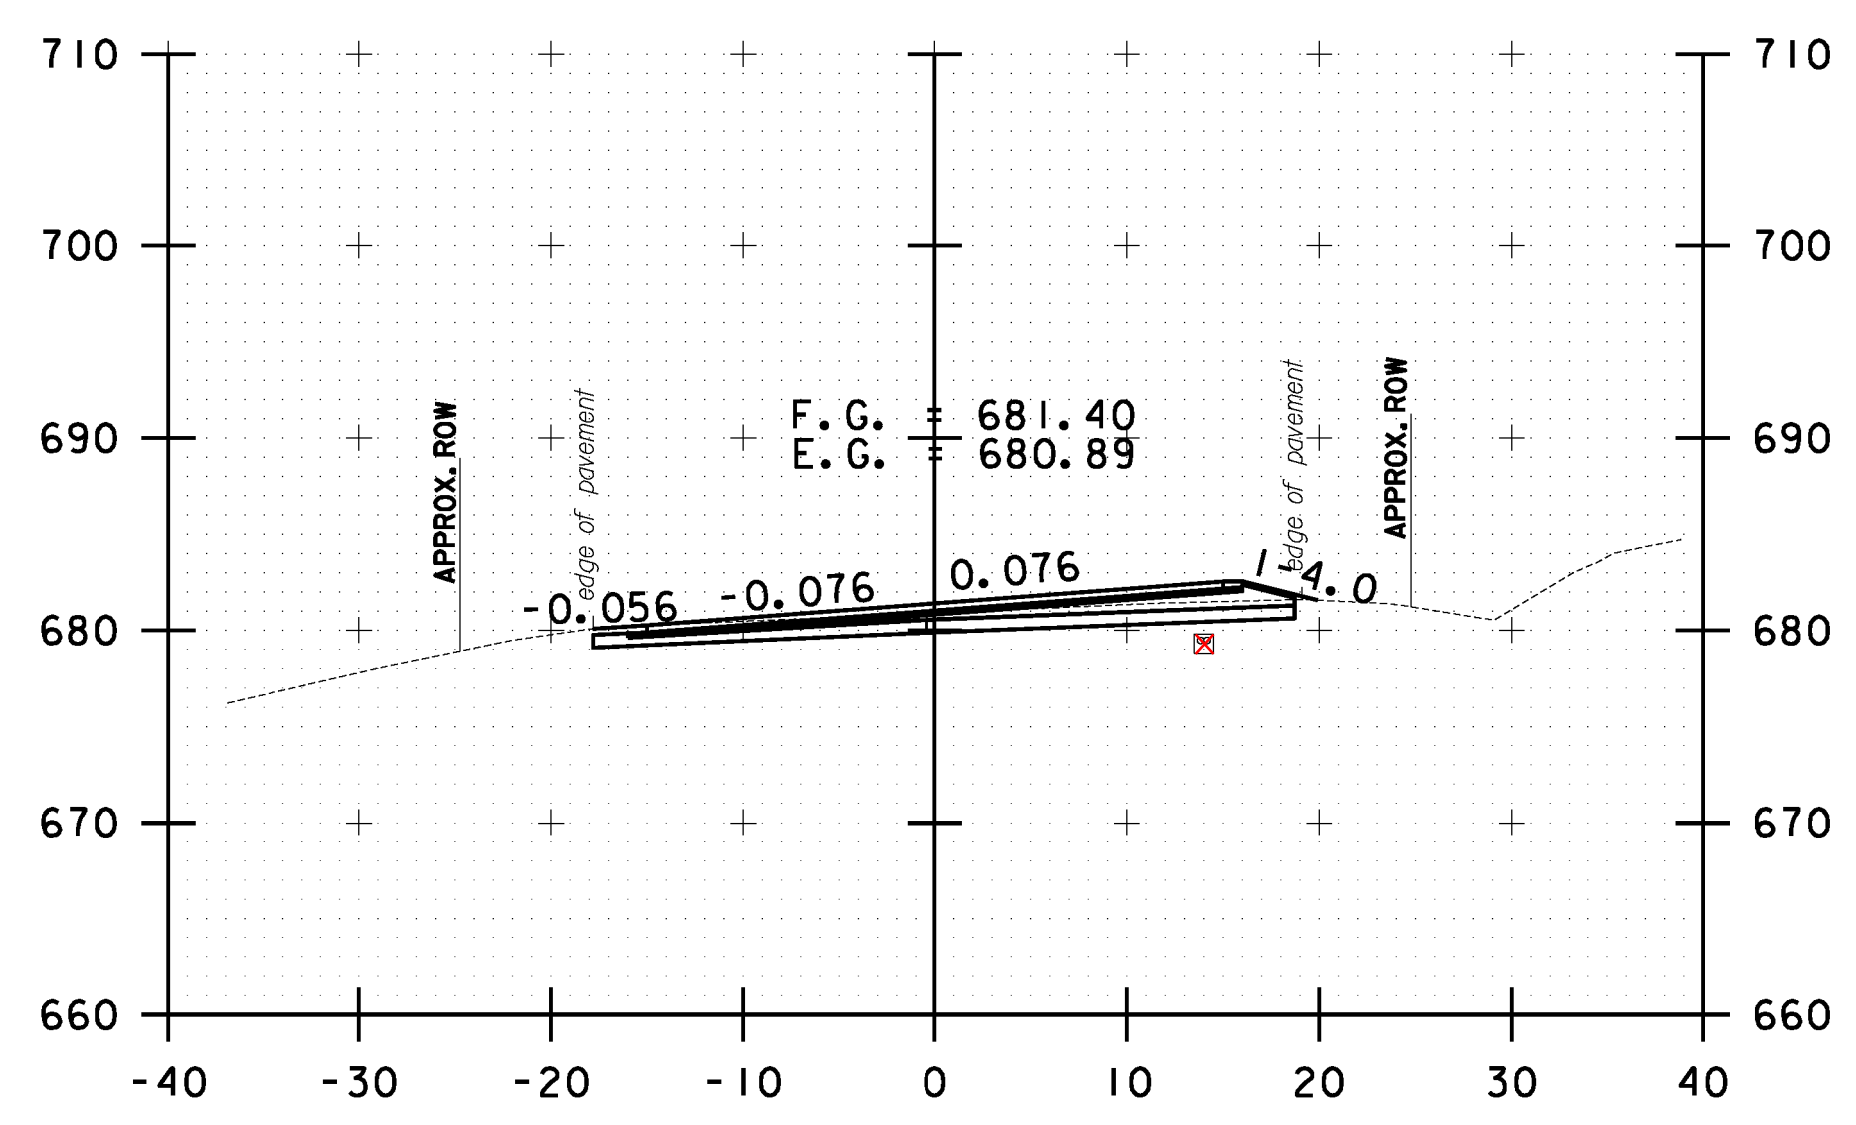

201+00.00

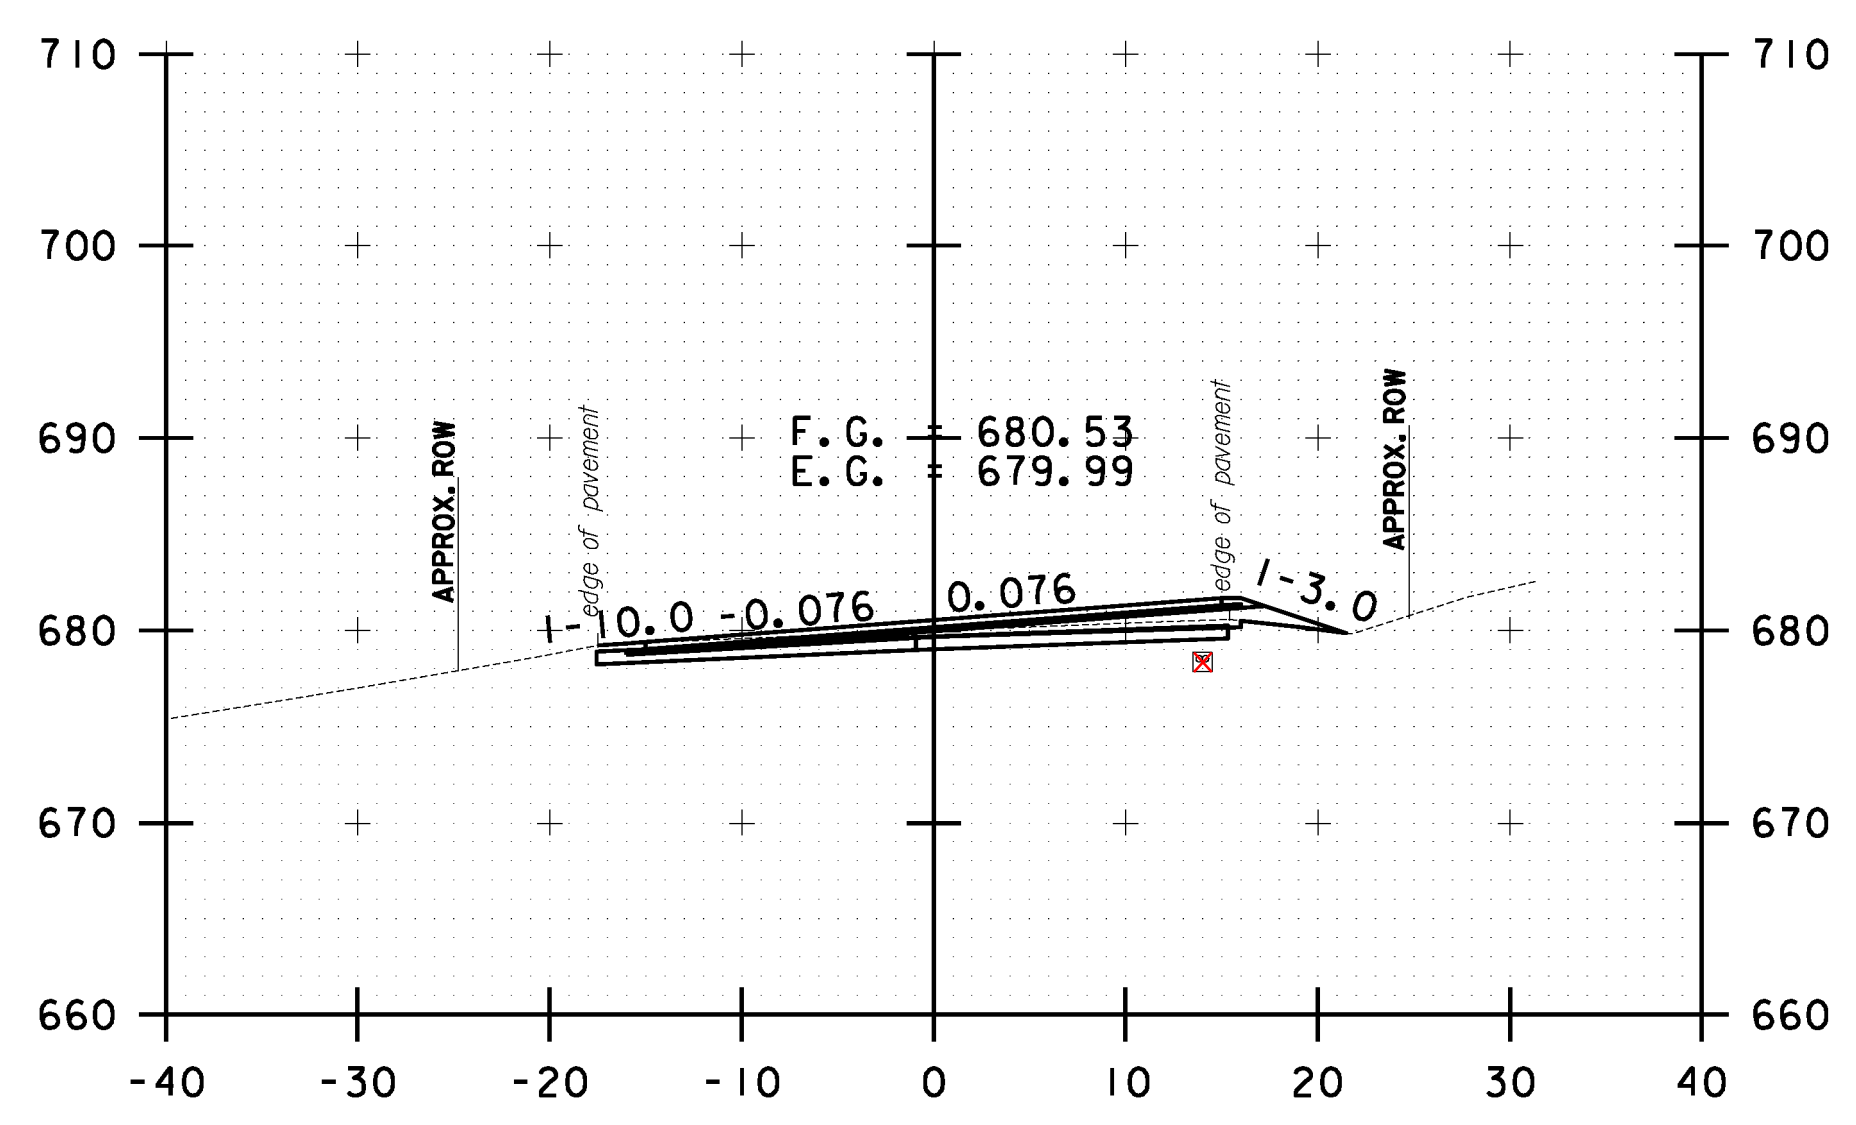

202+00.00

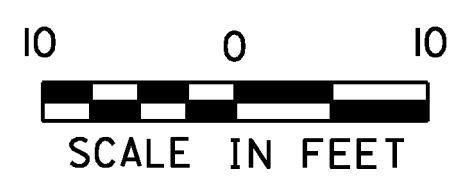

STOCKBRIDGE CROSS SECTION SHEET #62	PROJECT NAME: STOCKBRIDGE-BETHEL
	PROJECT NUMBER: STP 2910(1)
	FILE NAME: z10b214_stock_xc.dgn
	IPARM FILE: z10b214xs62.i
	PLOT DATE: 3/17/2014
	DRAWN BY: W.G.P.
	CHECKED BY: J.P.S.
	SHEET 275 OF 397