




FILE NAME = I:\Projects\100\10022426\CADD\10022426\10022426\10022426.dgn
 DATE = 3/17/2014
 USER = LMB

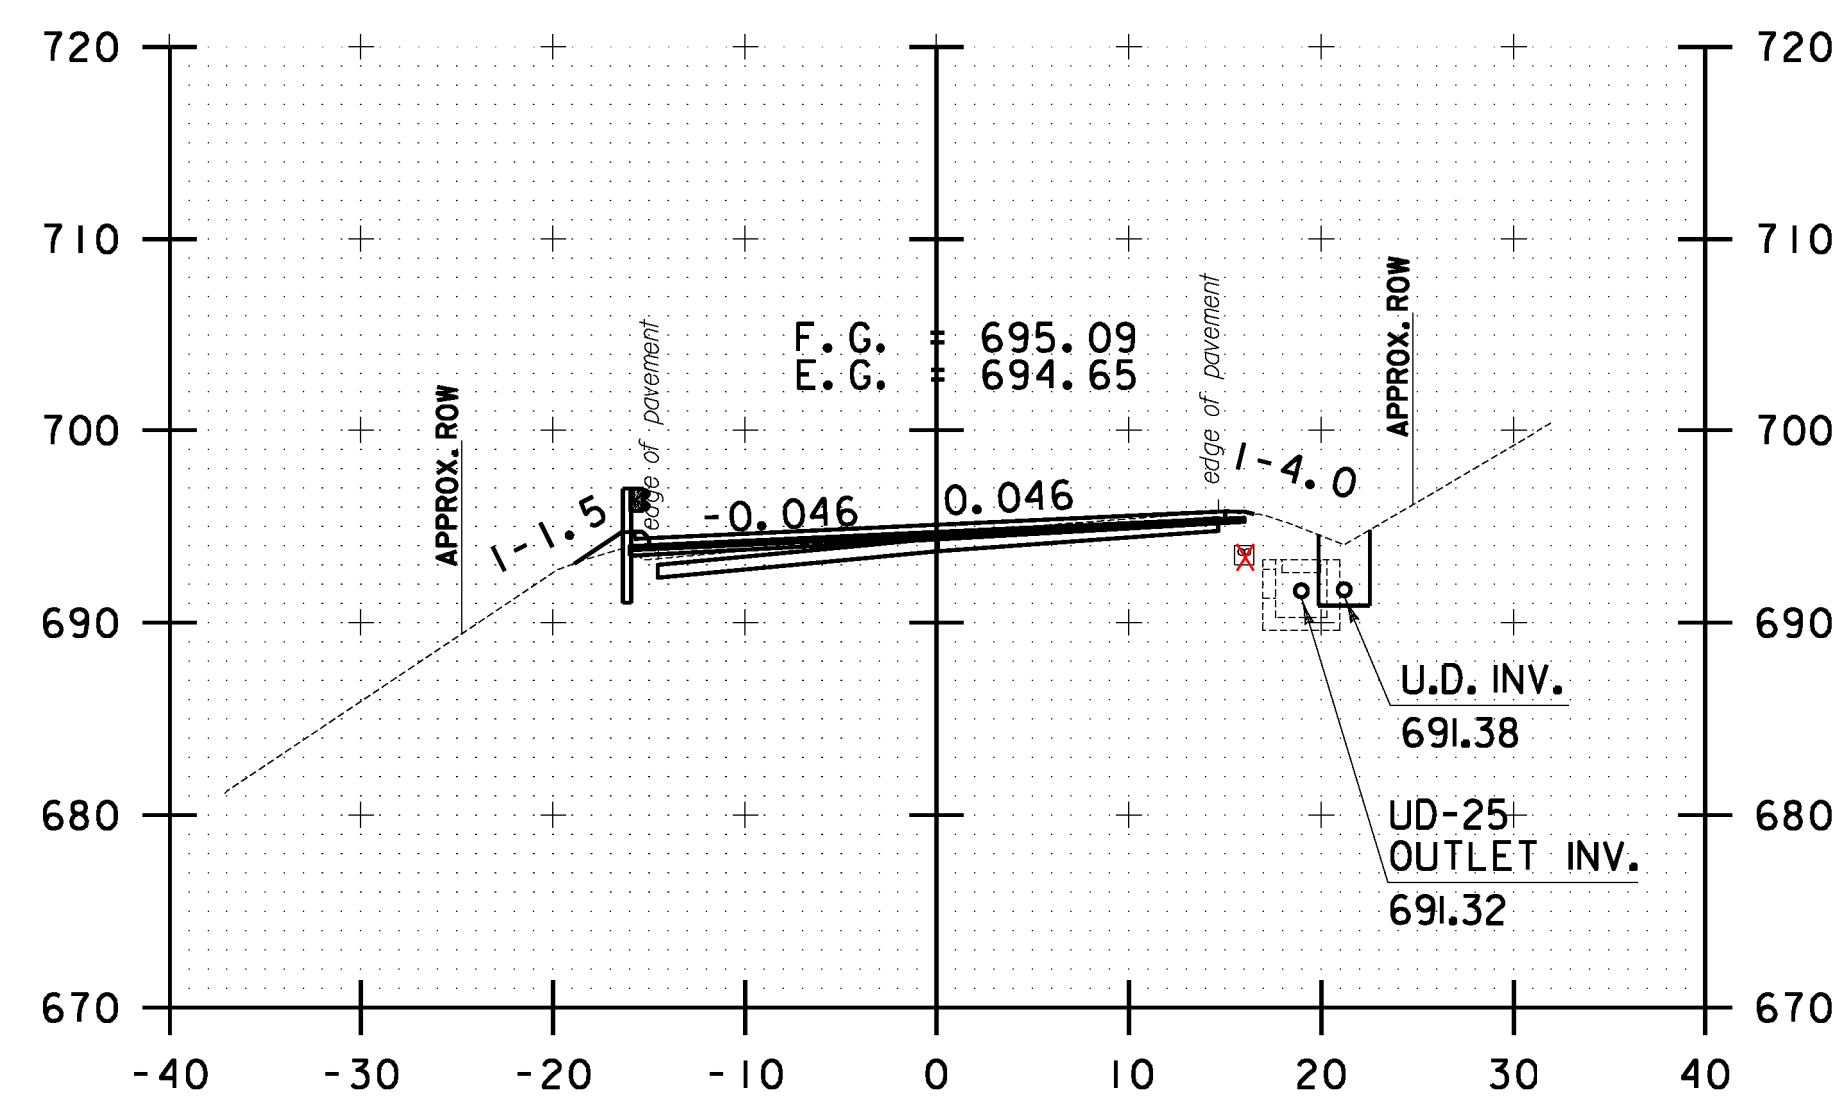


206+50.00

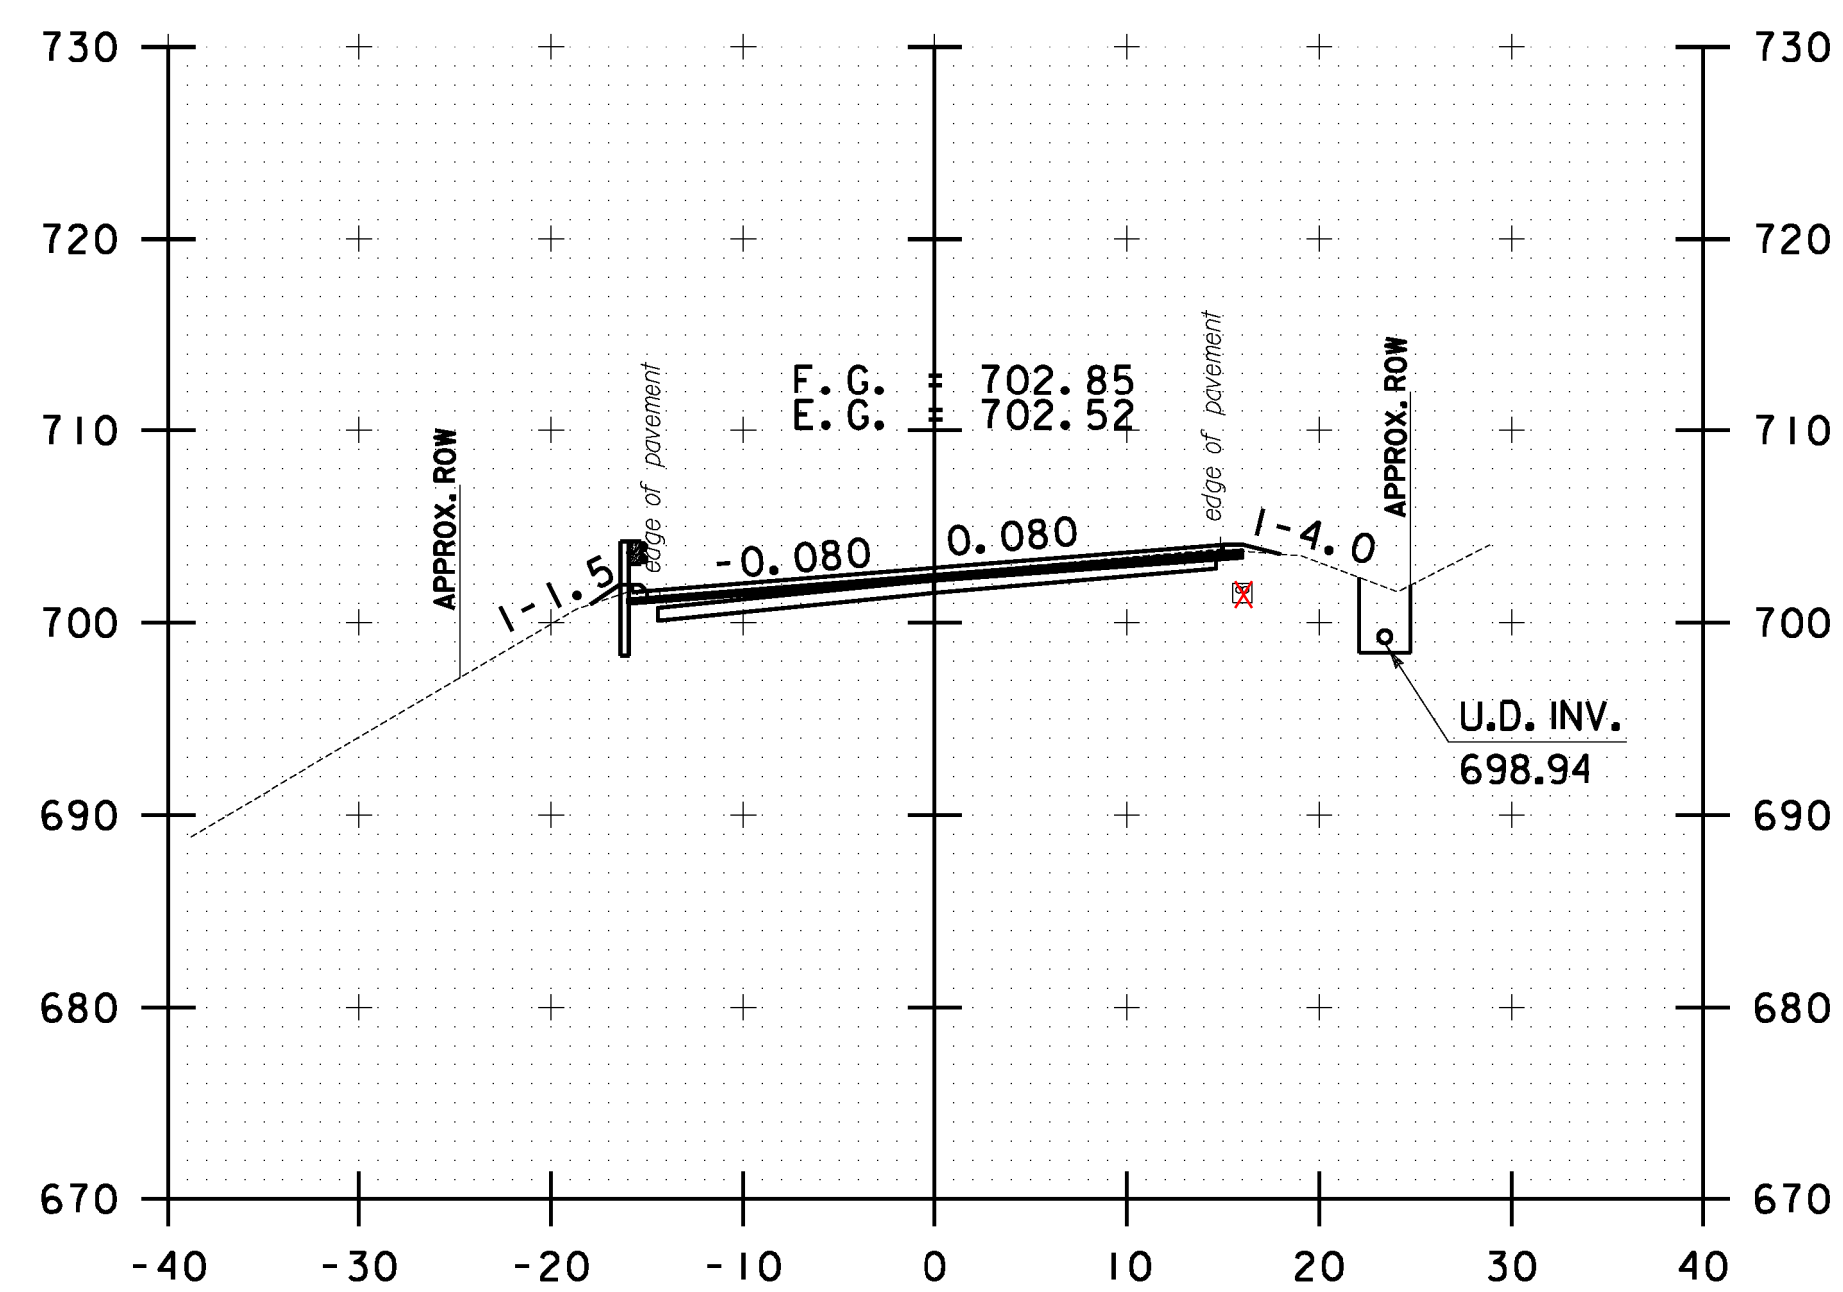


207+50.00

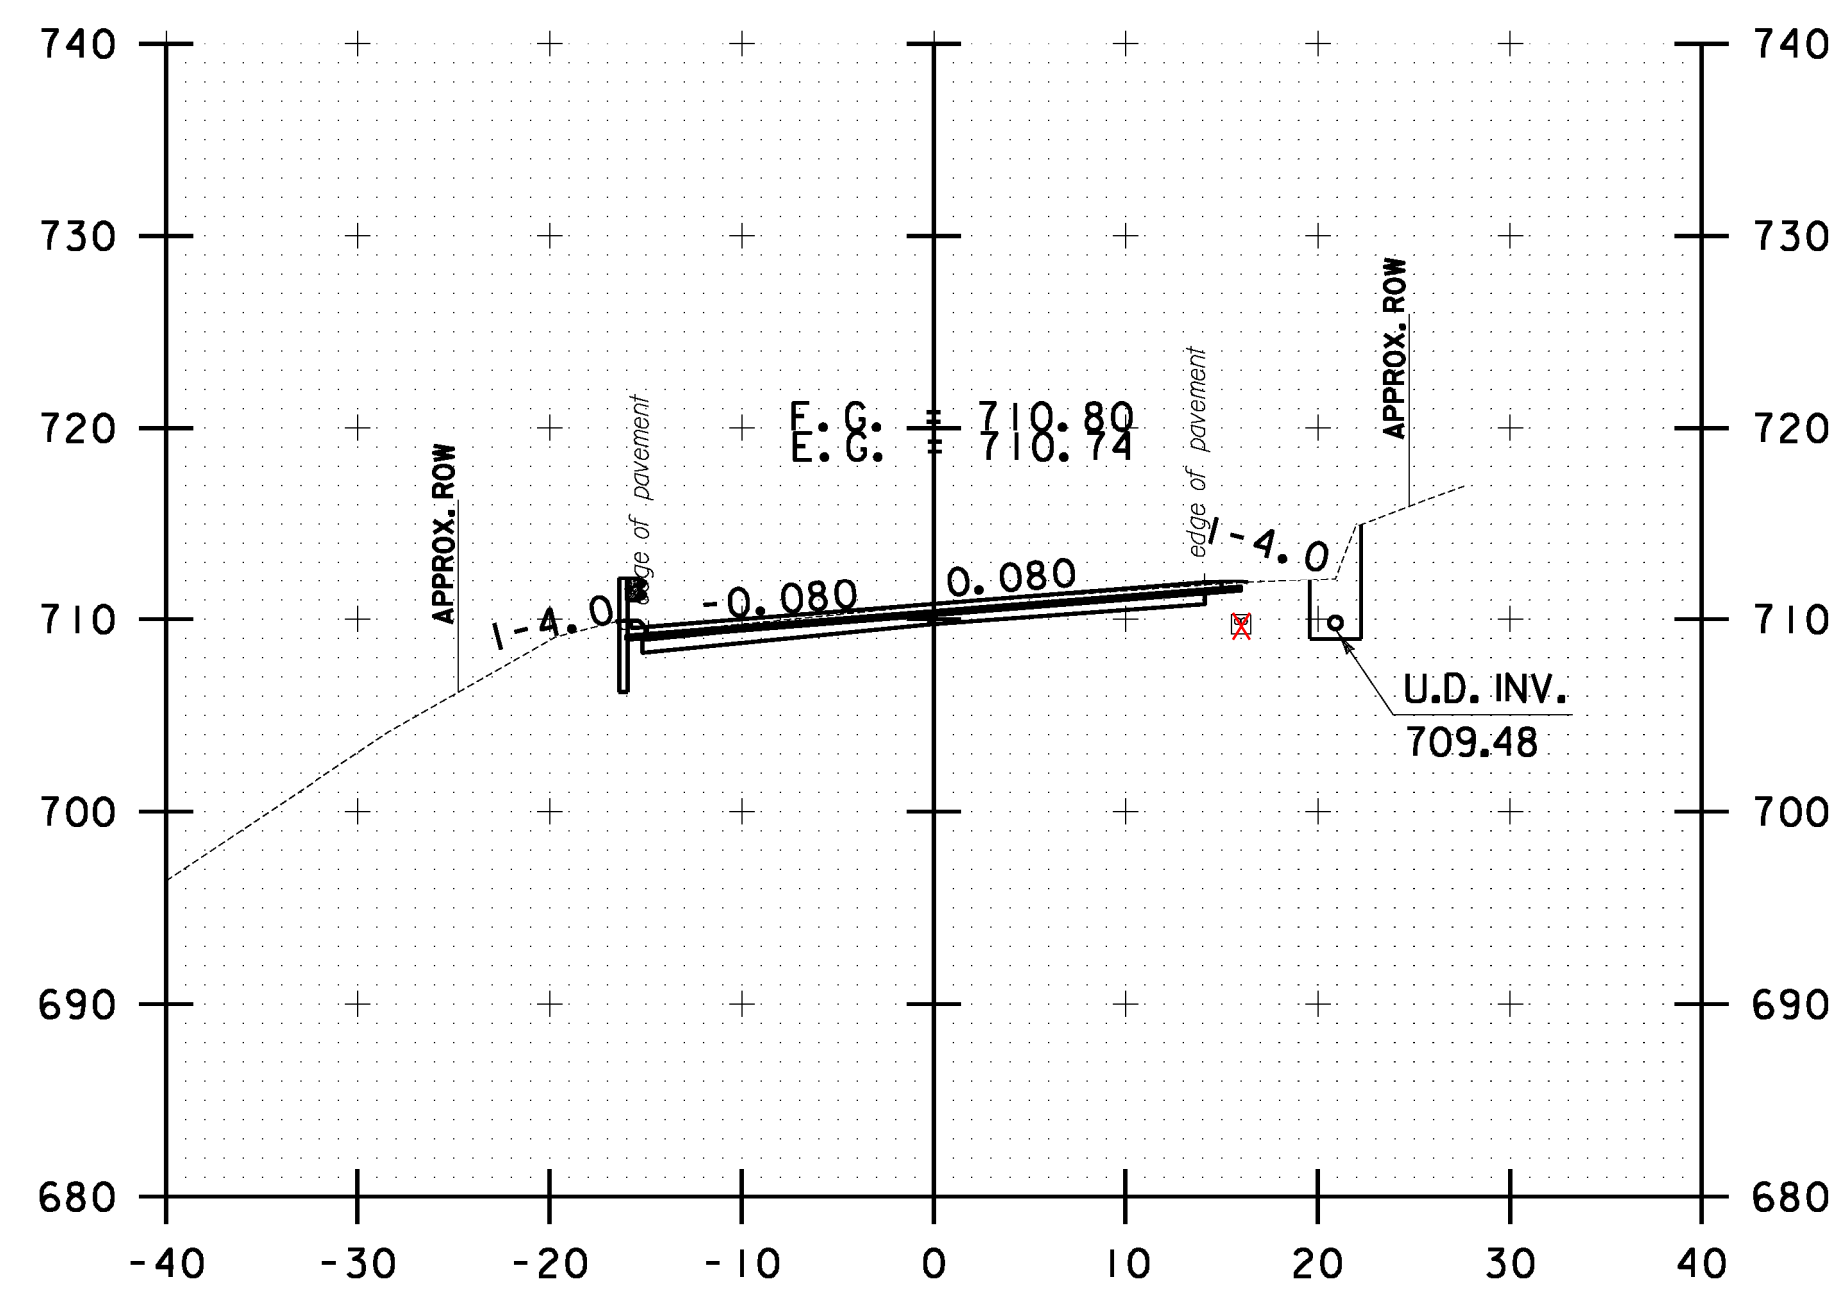


208+50.00

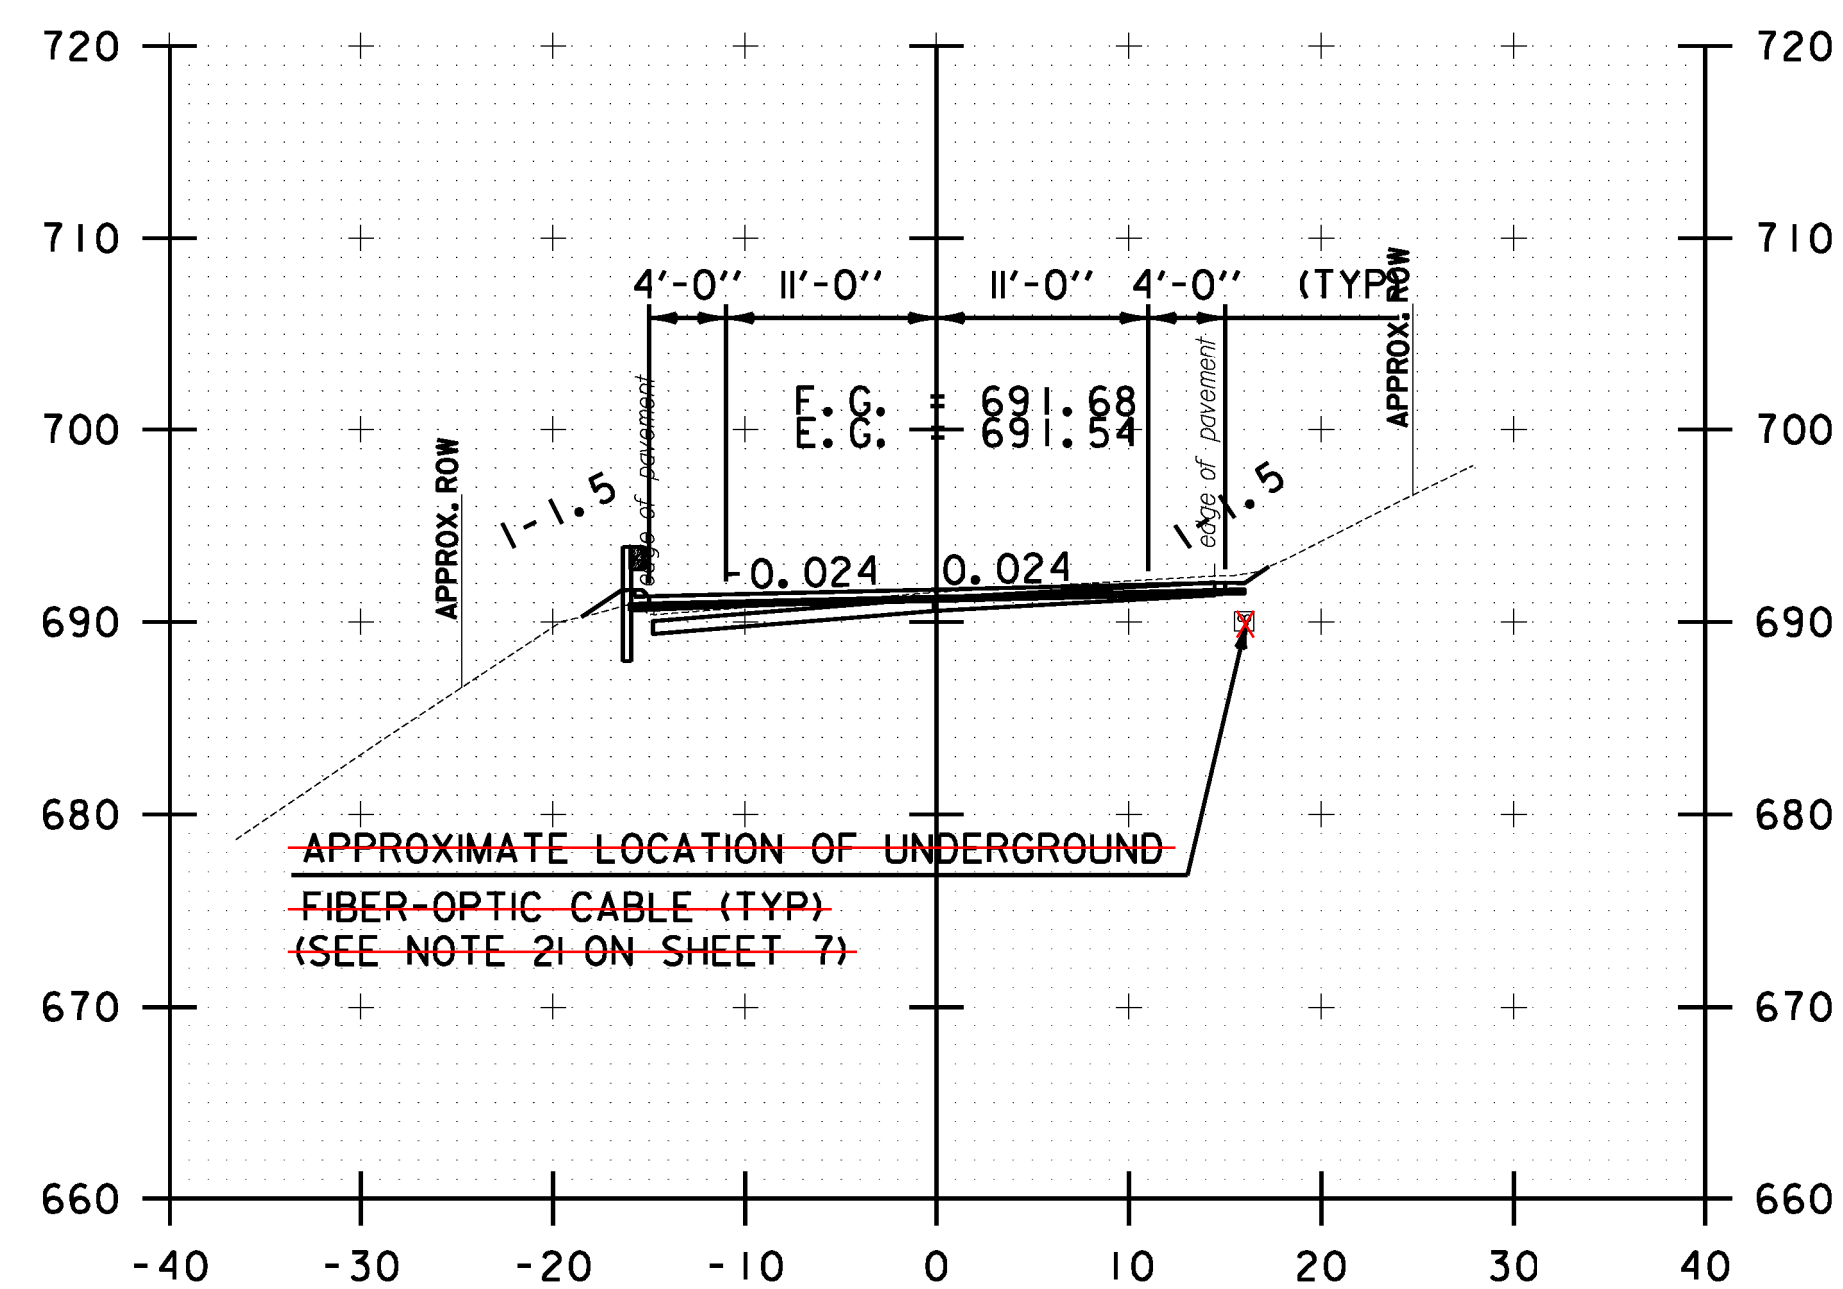


206+00.00

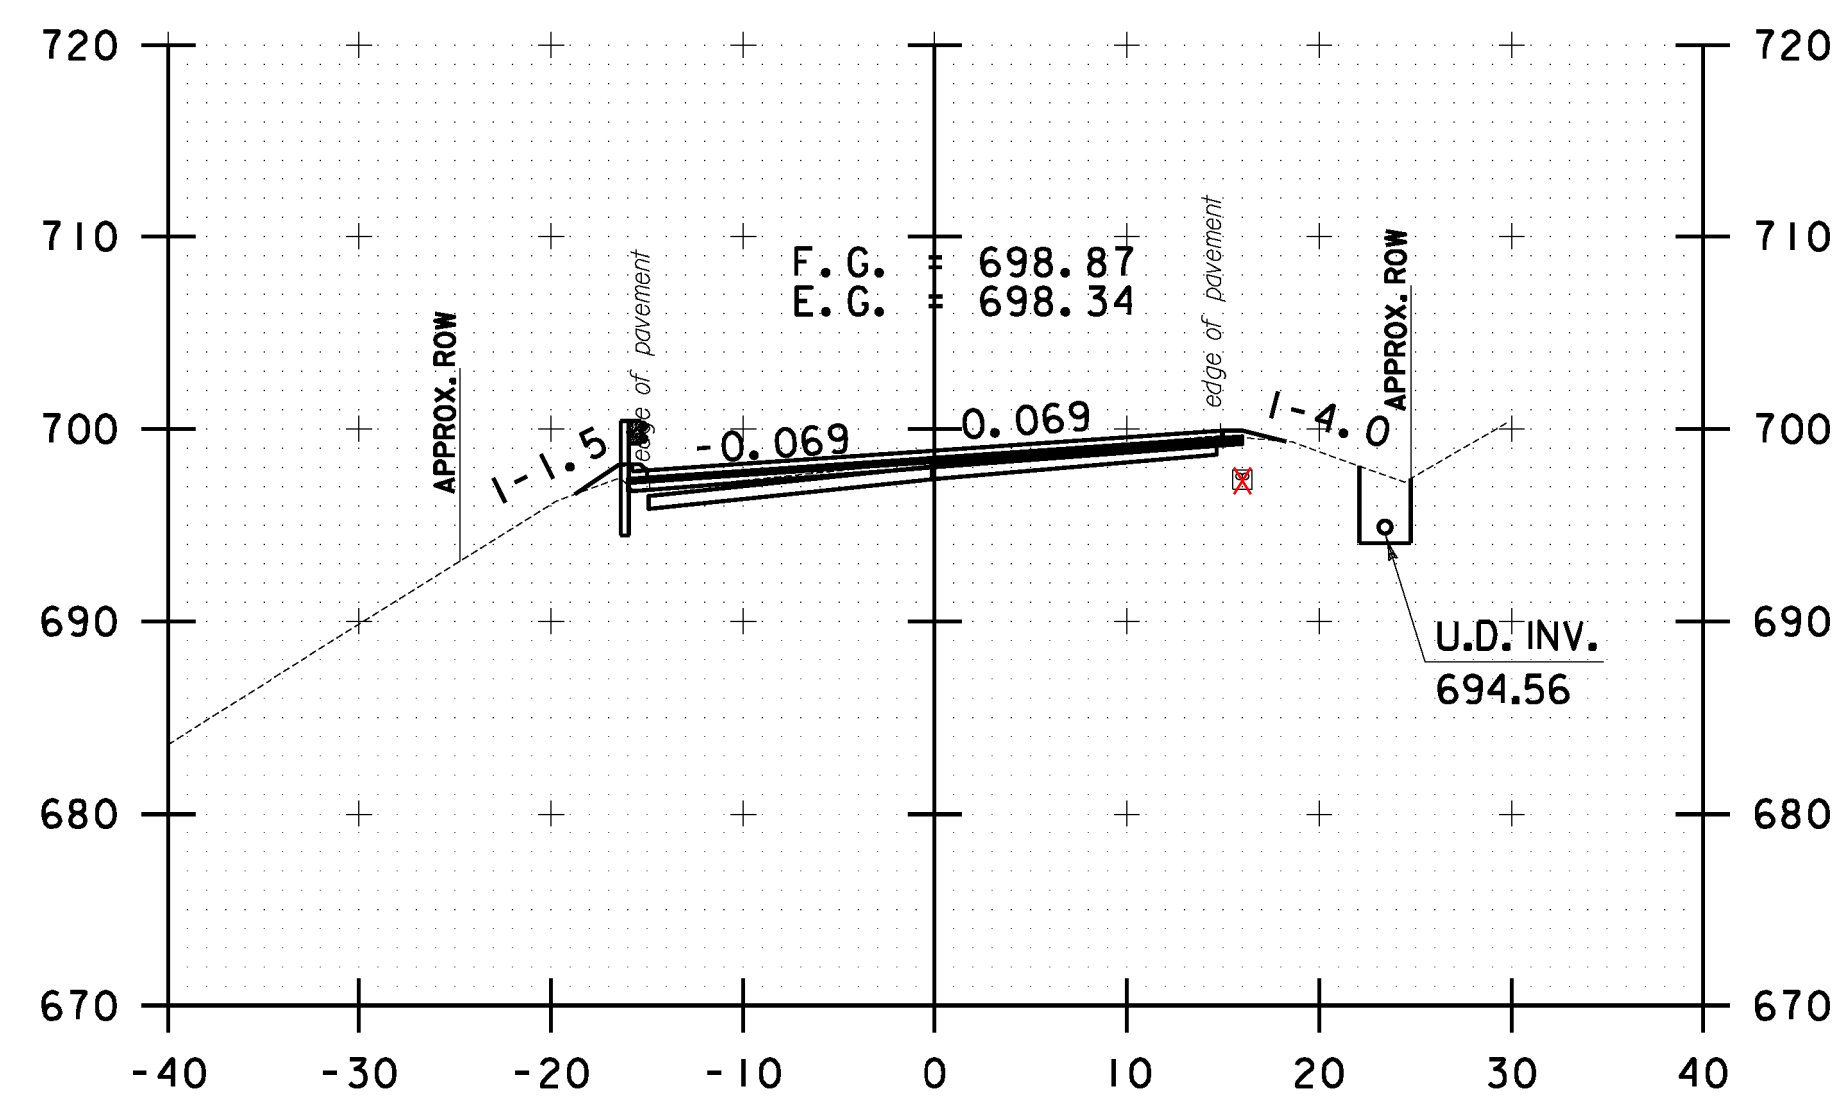

207+00.00

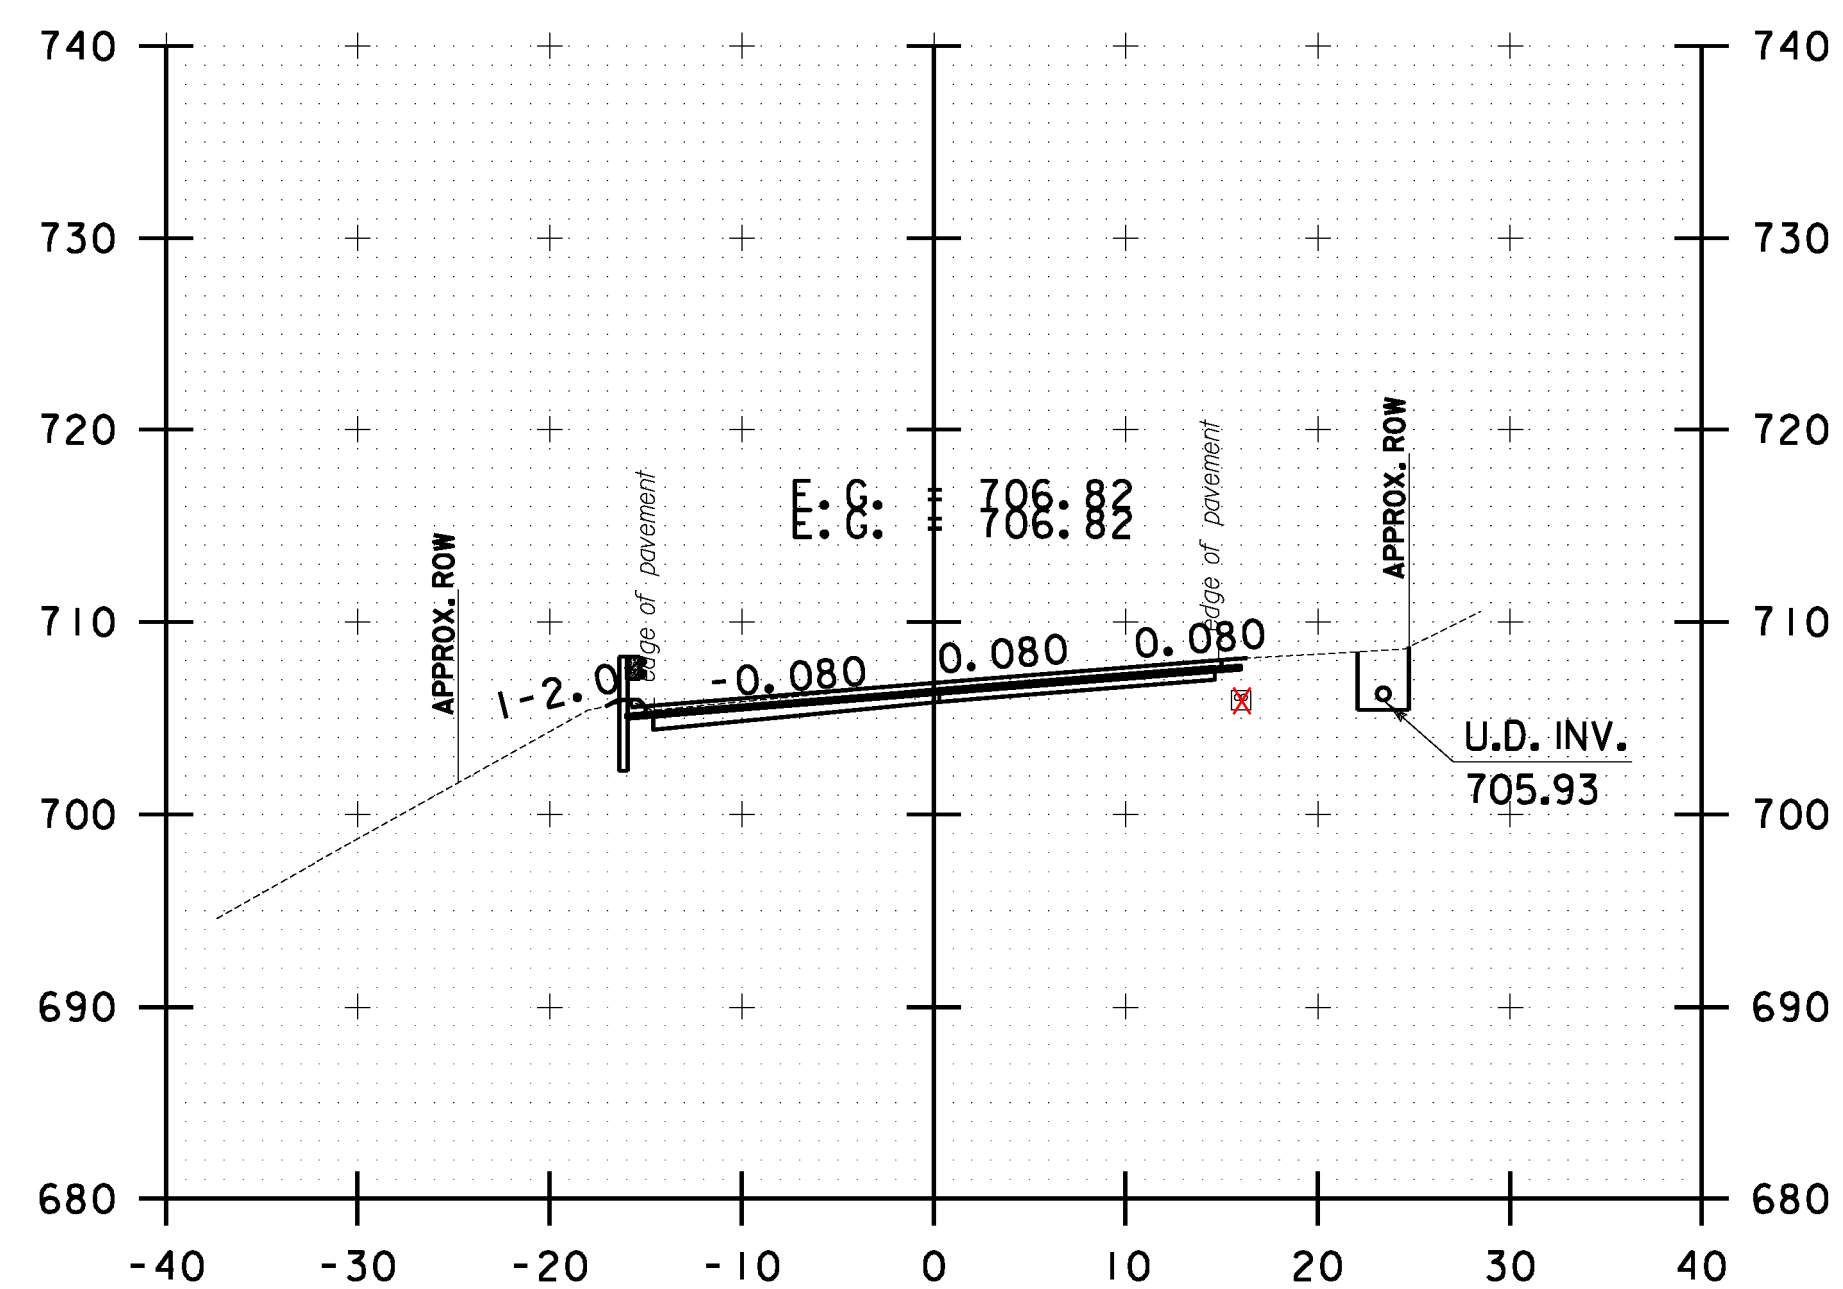

208+00.00

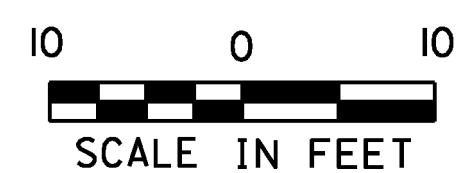

SCALE IN FEET

STOCKBRIDGE CROSS SECTION SHEET #64	PROJECT NAME: STOCKBRIDGE-BETHEL
	PROJECT NUMBER: STP 2910(1)
	FILE NAME: z10b214_stock_xc.dgn
	PLOT DATE: 3/17/2014
	PROJECT LEADER: D.E.G.
	DESIGNED BY: L.M.B.
	IPARM FILE: z10b214xs64.i
	DRAWN BY: W.G.P.
	CHECKED BY: J.P.S.
	SHEET 277 OF 397