




FILE NAME = I:\Projects\14NY\K222426\CAD\1\MS\IN\z10b214_stock_xc.dgn
 DATE TIME = 3/17/2014 11:49:16
 USER = J4916

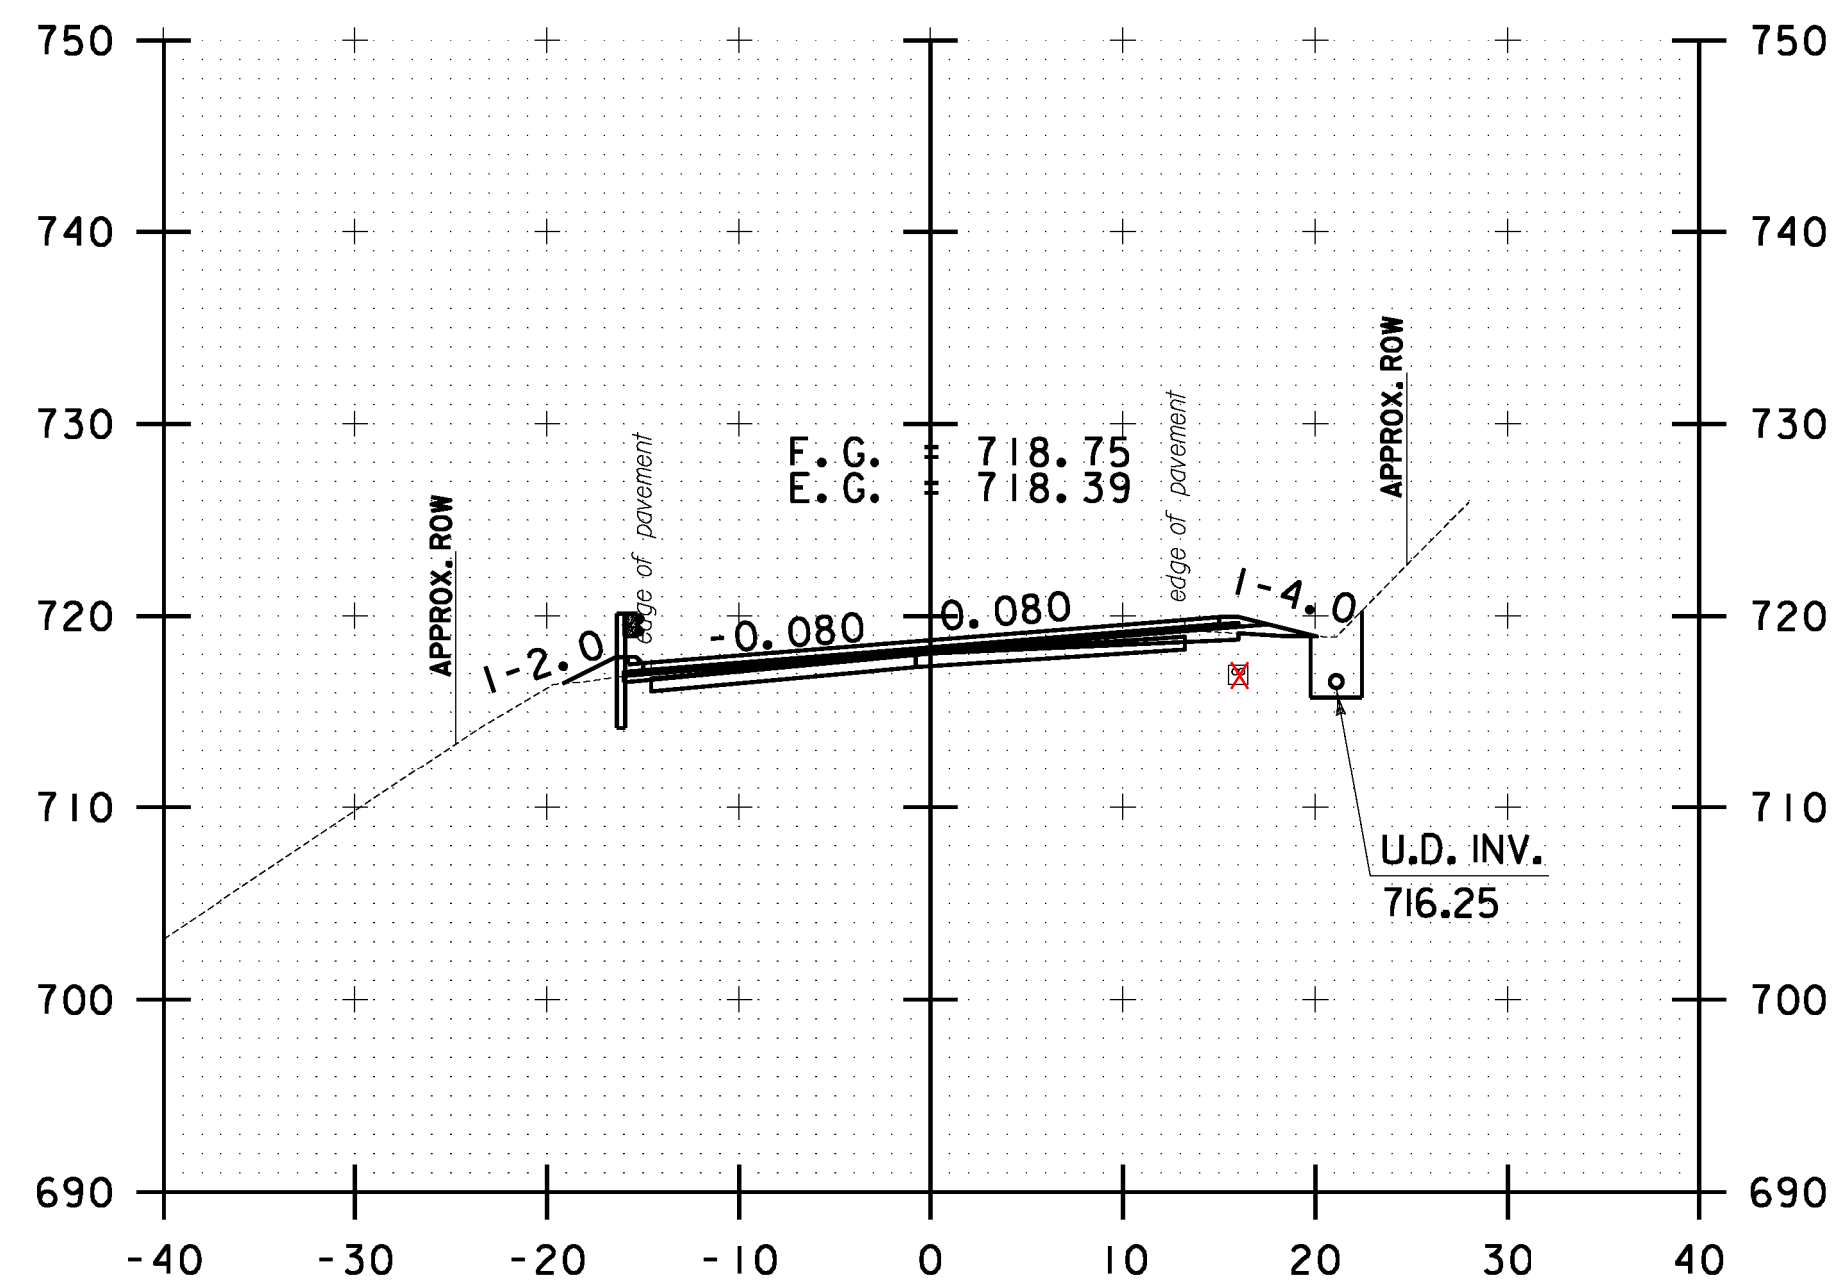


209+50.00

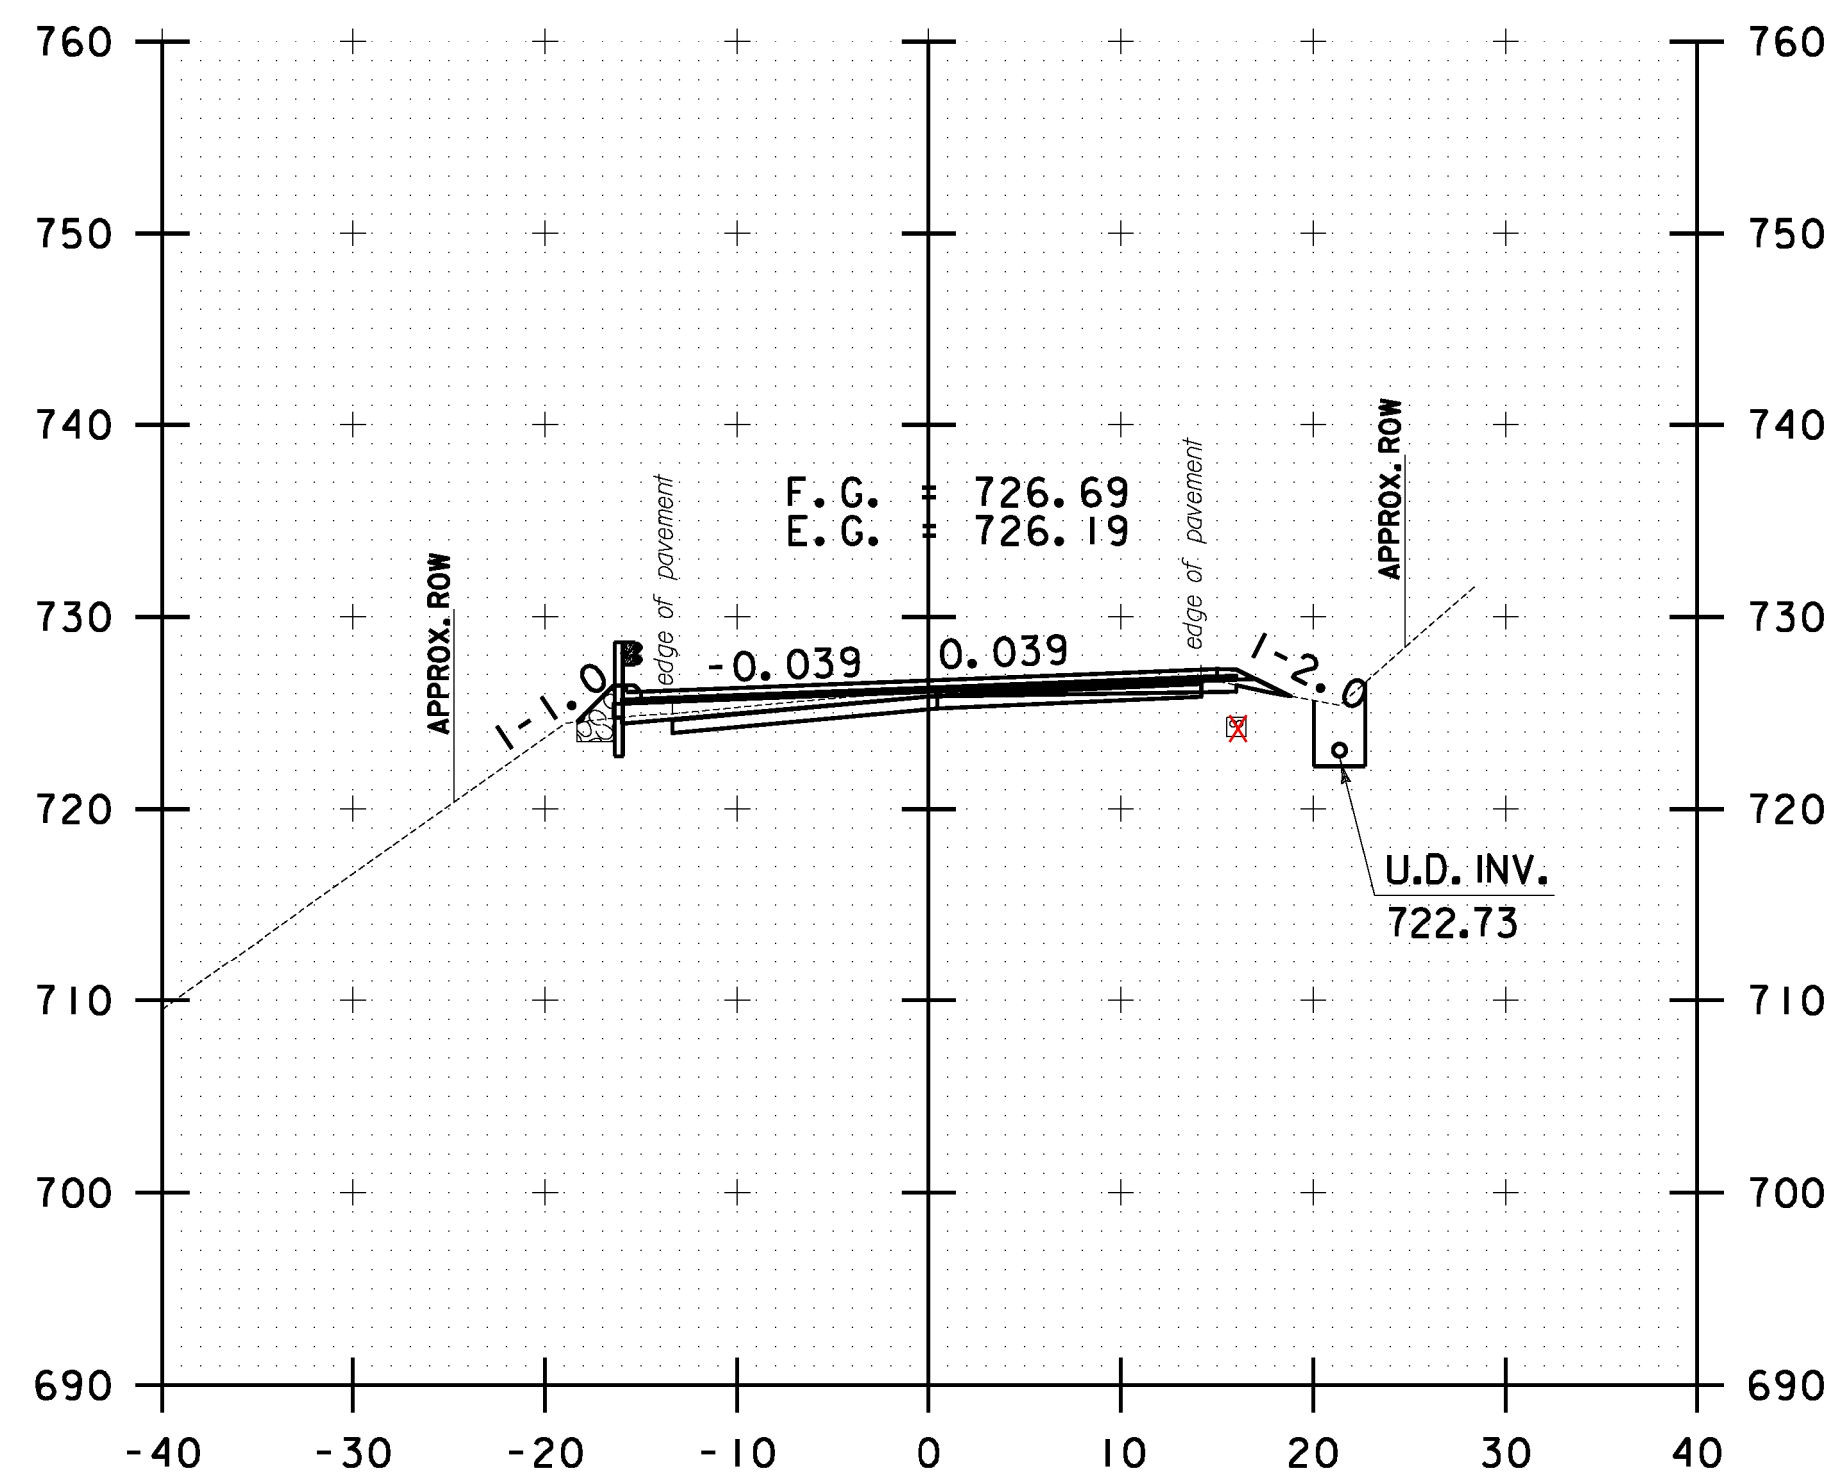


210+50.00

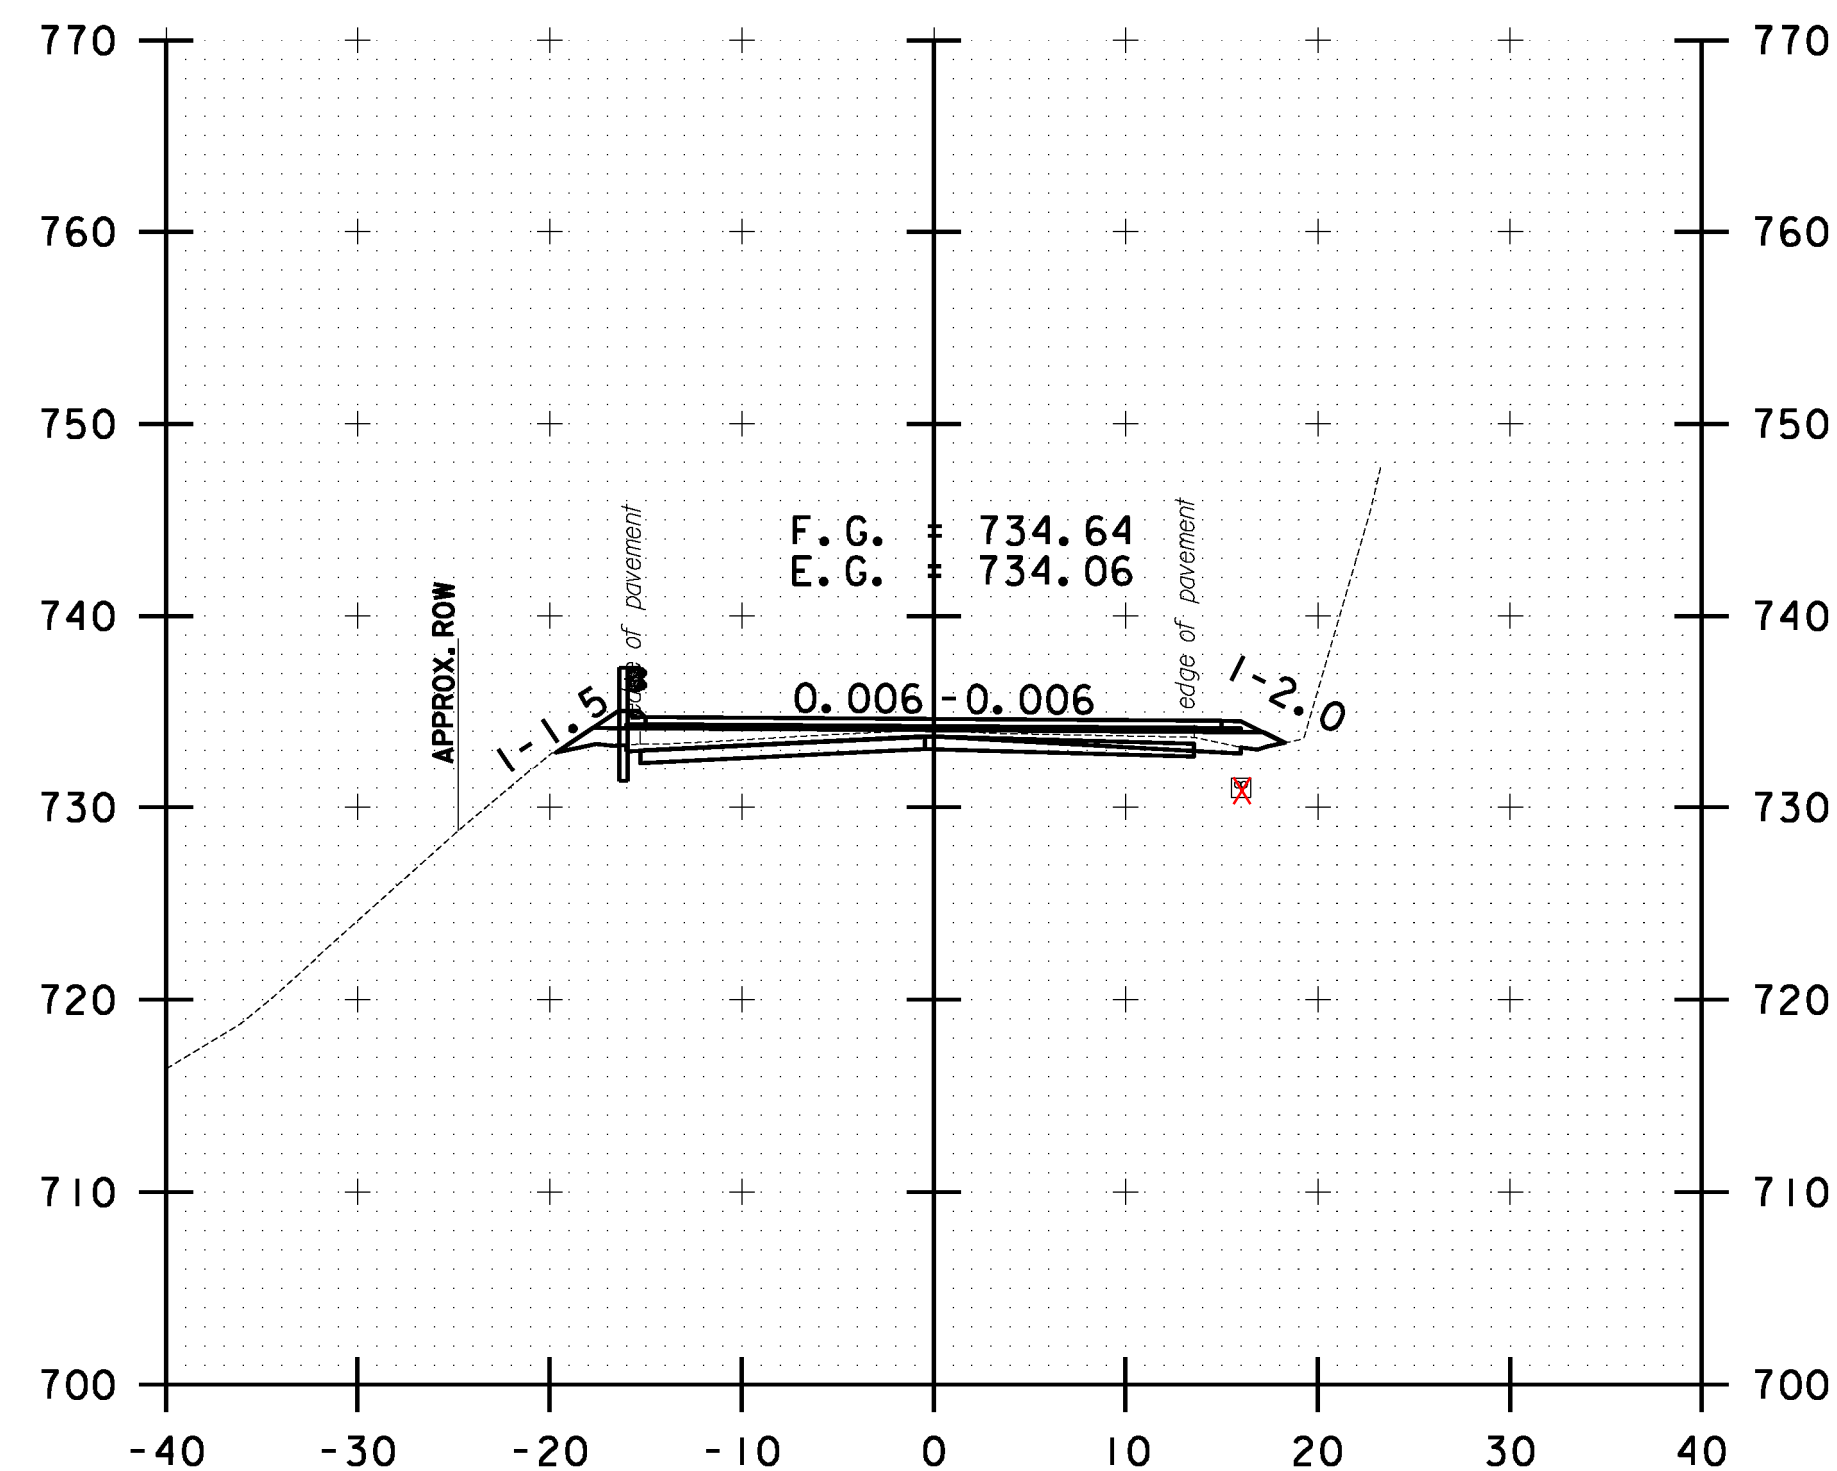


211+50.00

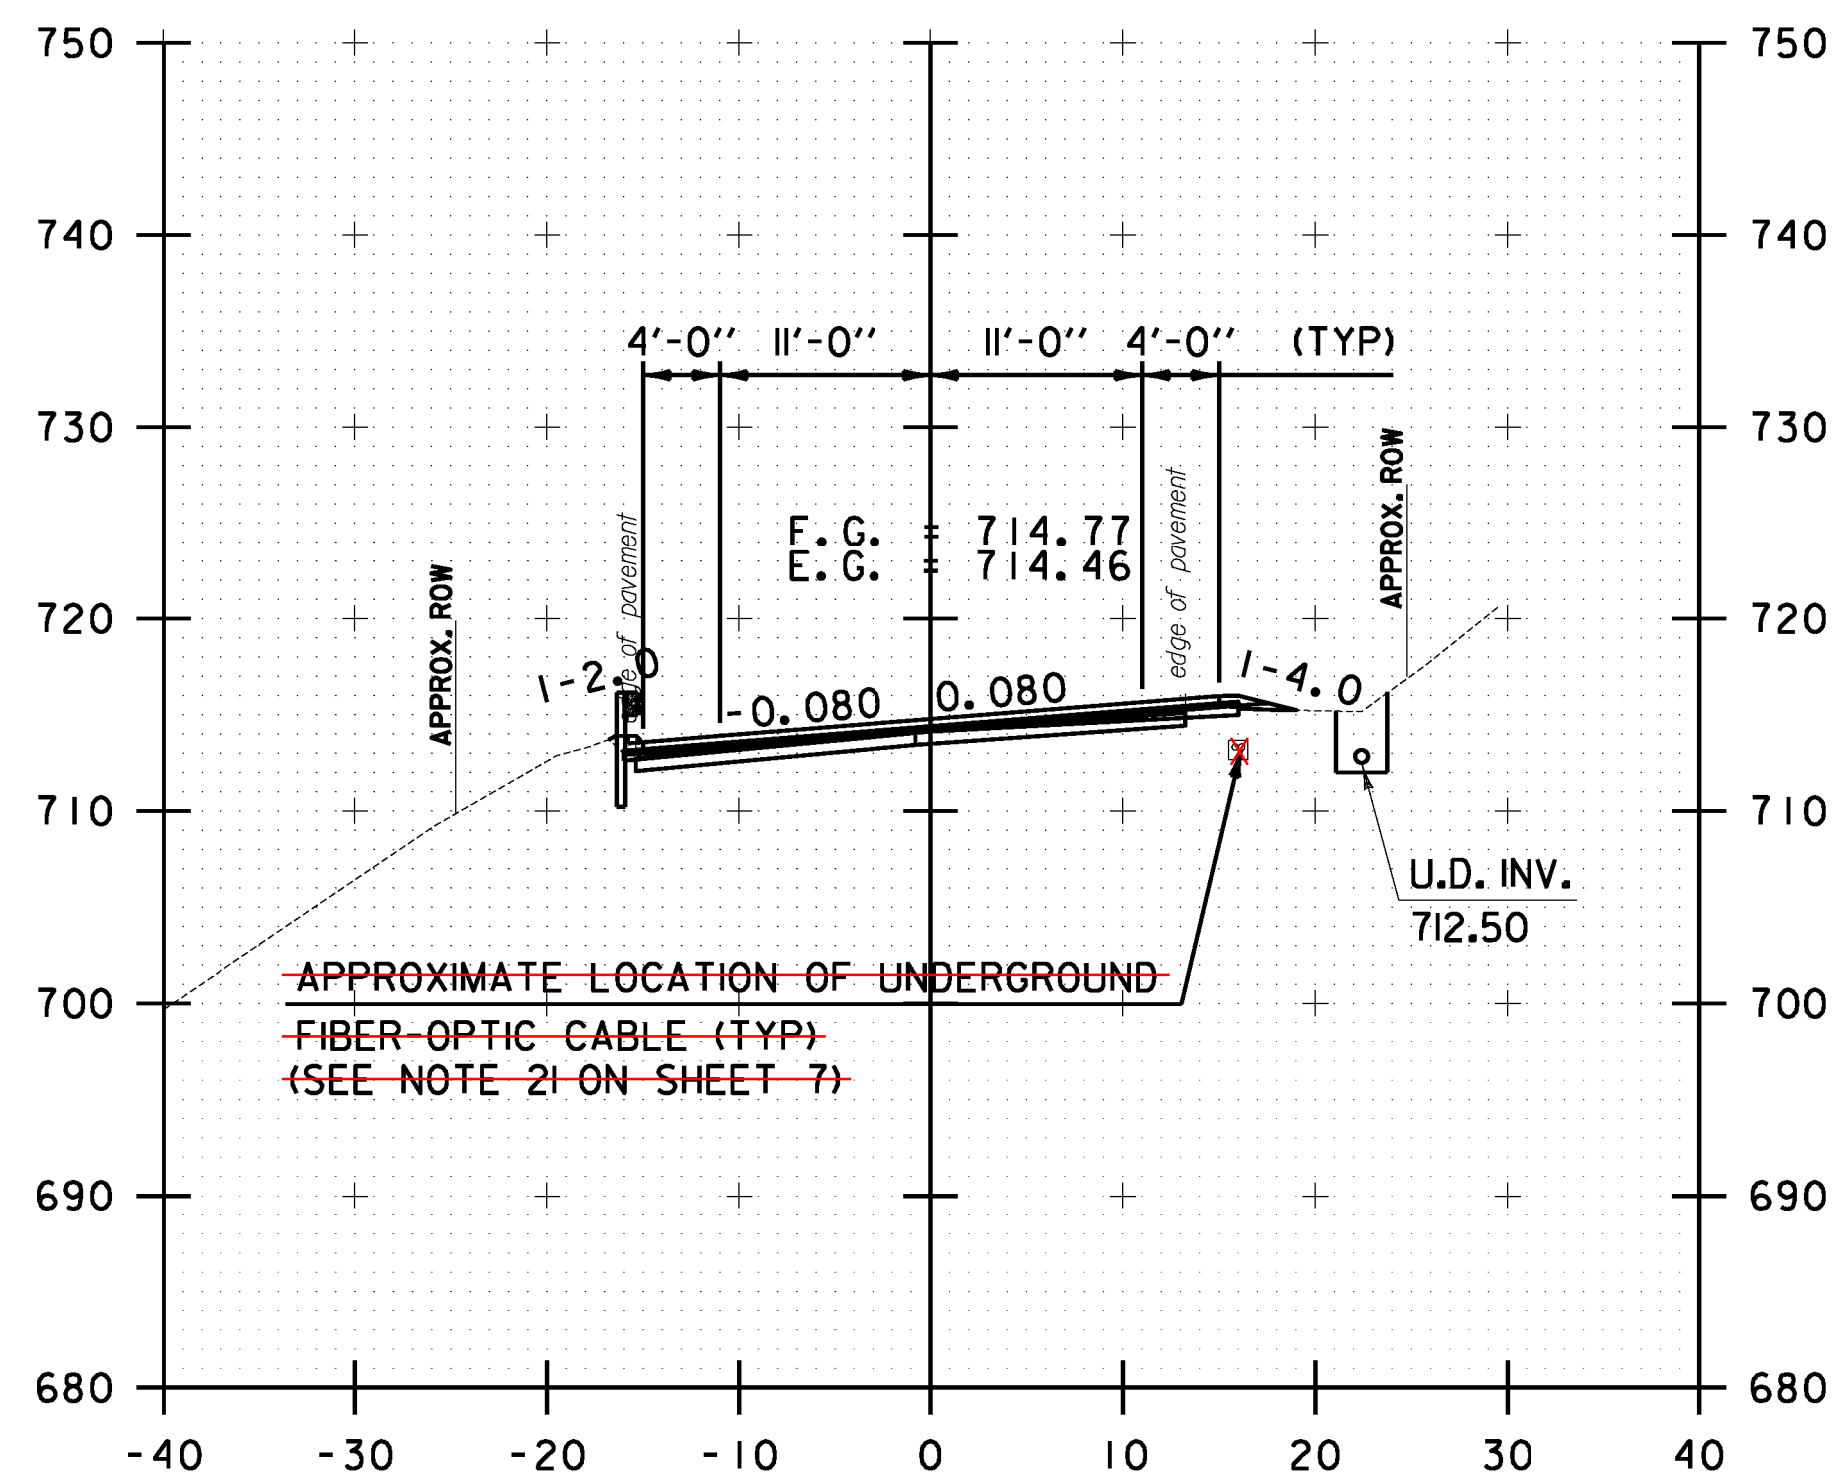


209+00.00

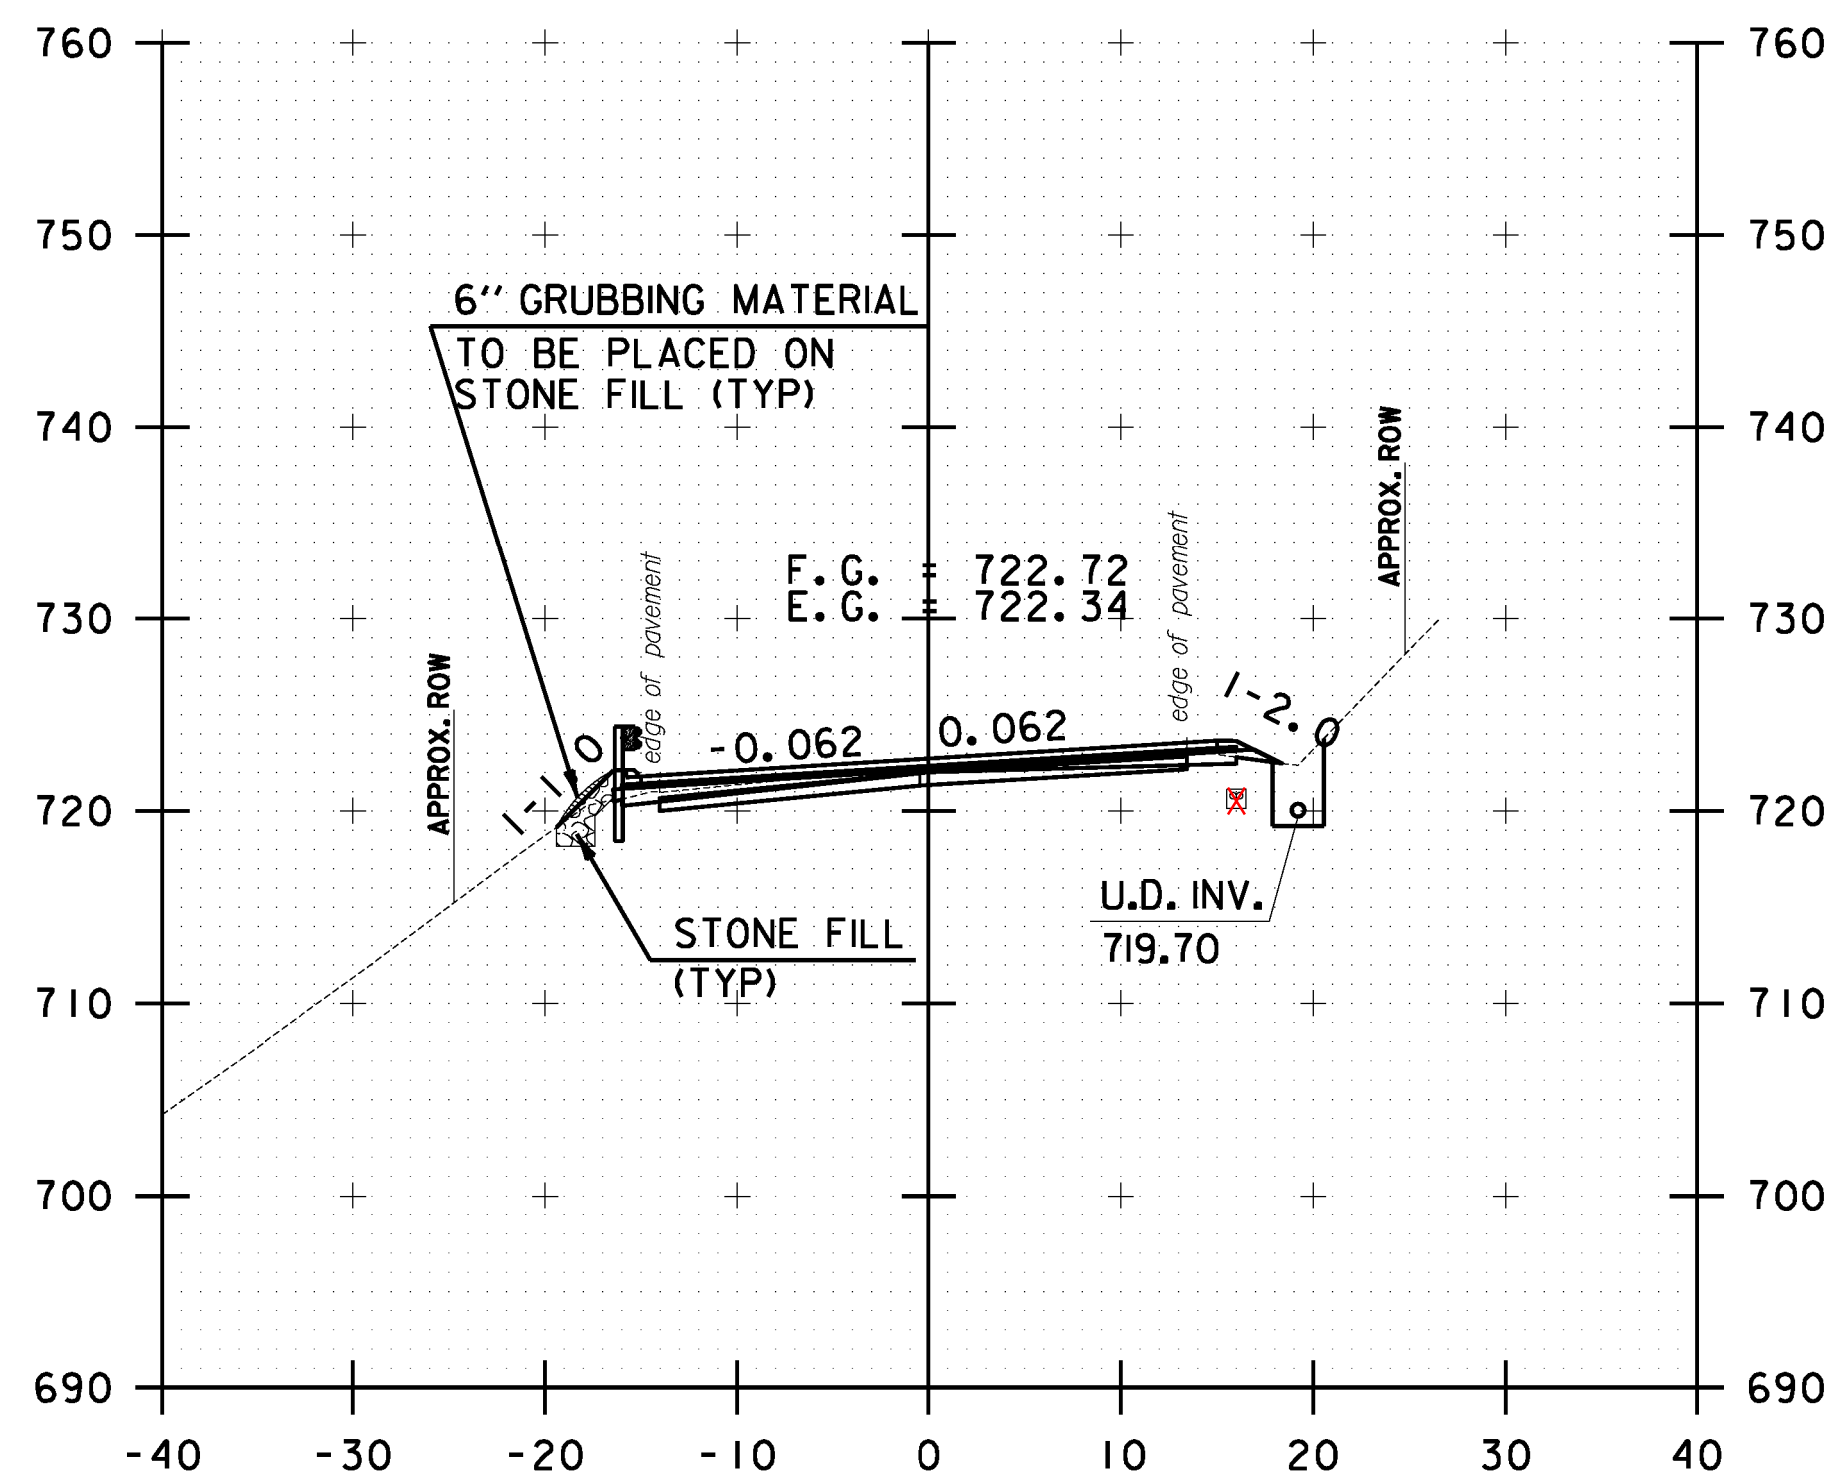

210+00.00

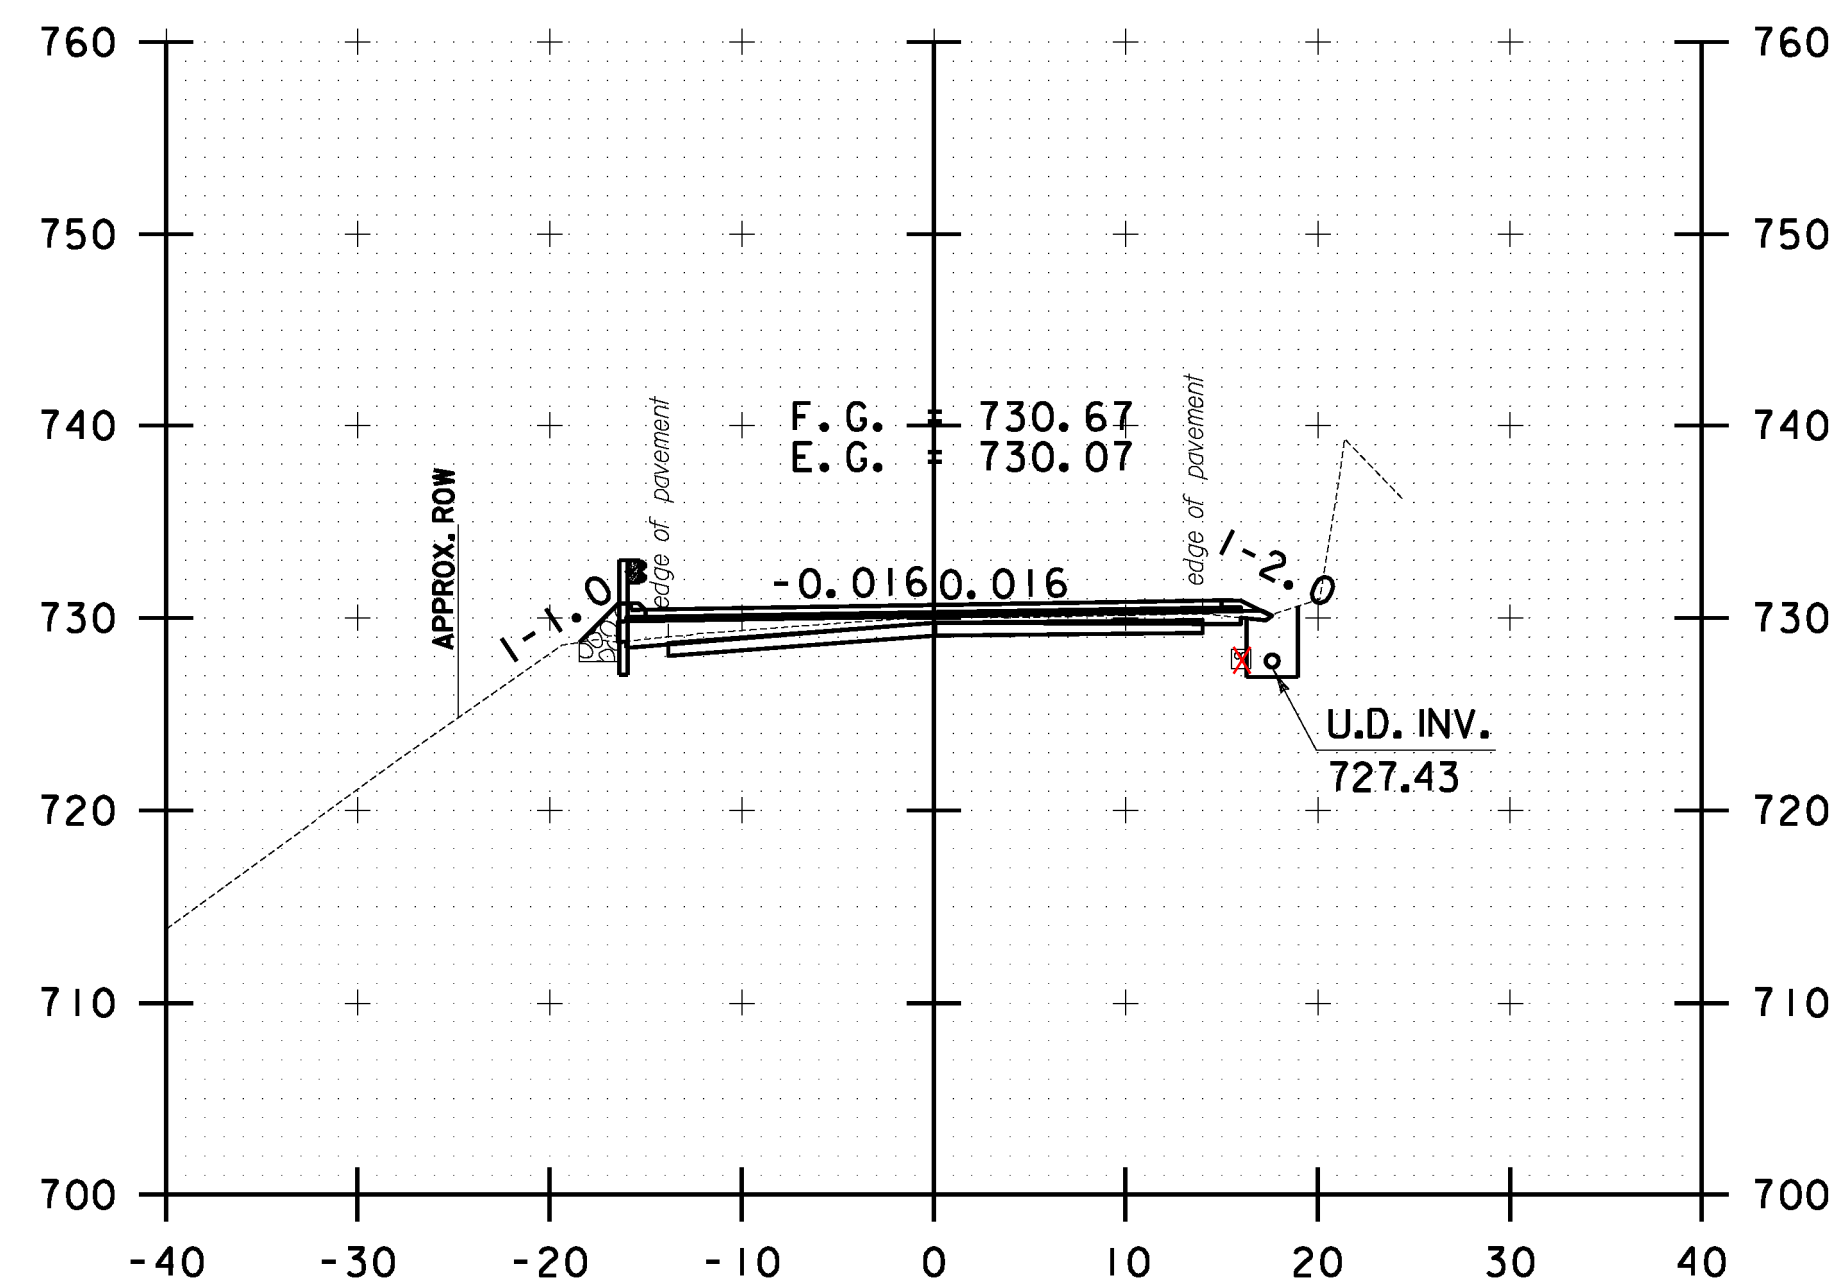

211+00.00

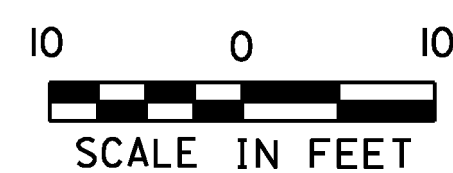

STOCKBRIDGE CROSS SECTION SHEET #65	PROJECT NAME: STOCKBRIDGE-BETHEL
	PROJECT NUMBER: STP 2910(1)
	FILE NAME: z10b214_stock_xc.dgn
	PLOT DATE: 3/17/2014
DESIGNED BY: L.M.B.	CHECKED BY: J.P.S.
IPARM FILE: z10b214xs65.i	SHEET 278 OF 397