




FILE NAME = \\172\projects\14NY\14222426\CADD\14\STN\z10b214_stock_xc.dgn
 DATE = 3/17/2014
 USER = J4916

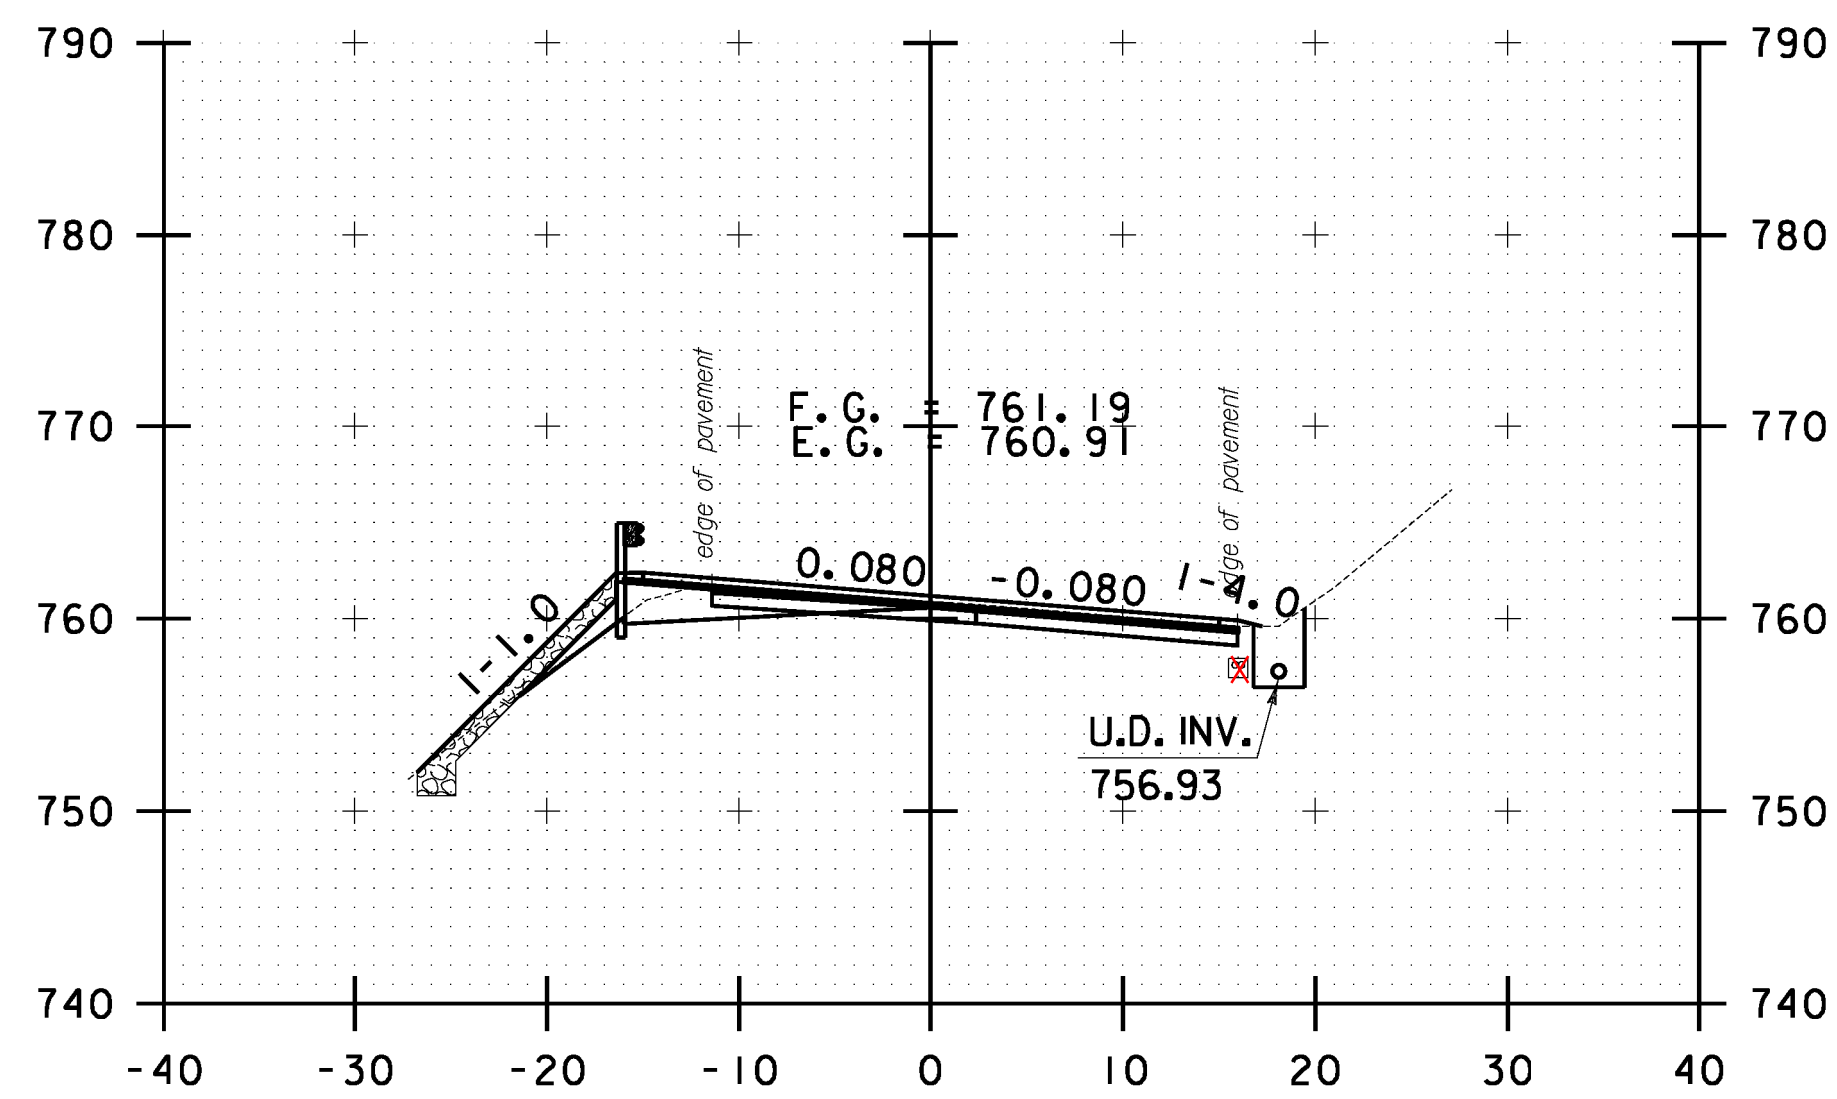


215+50.00

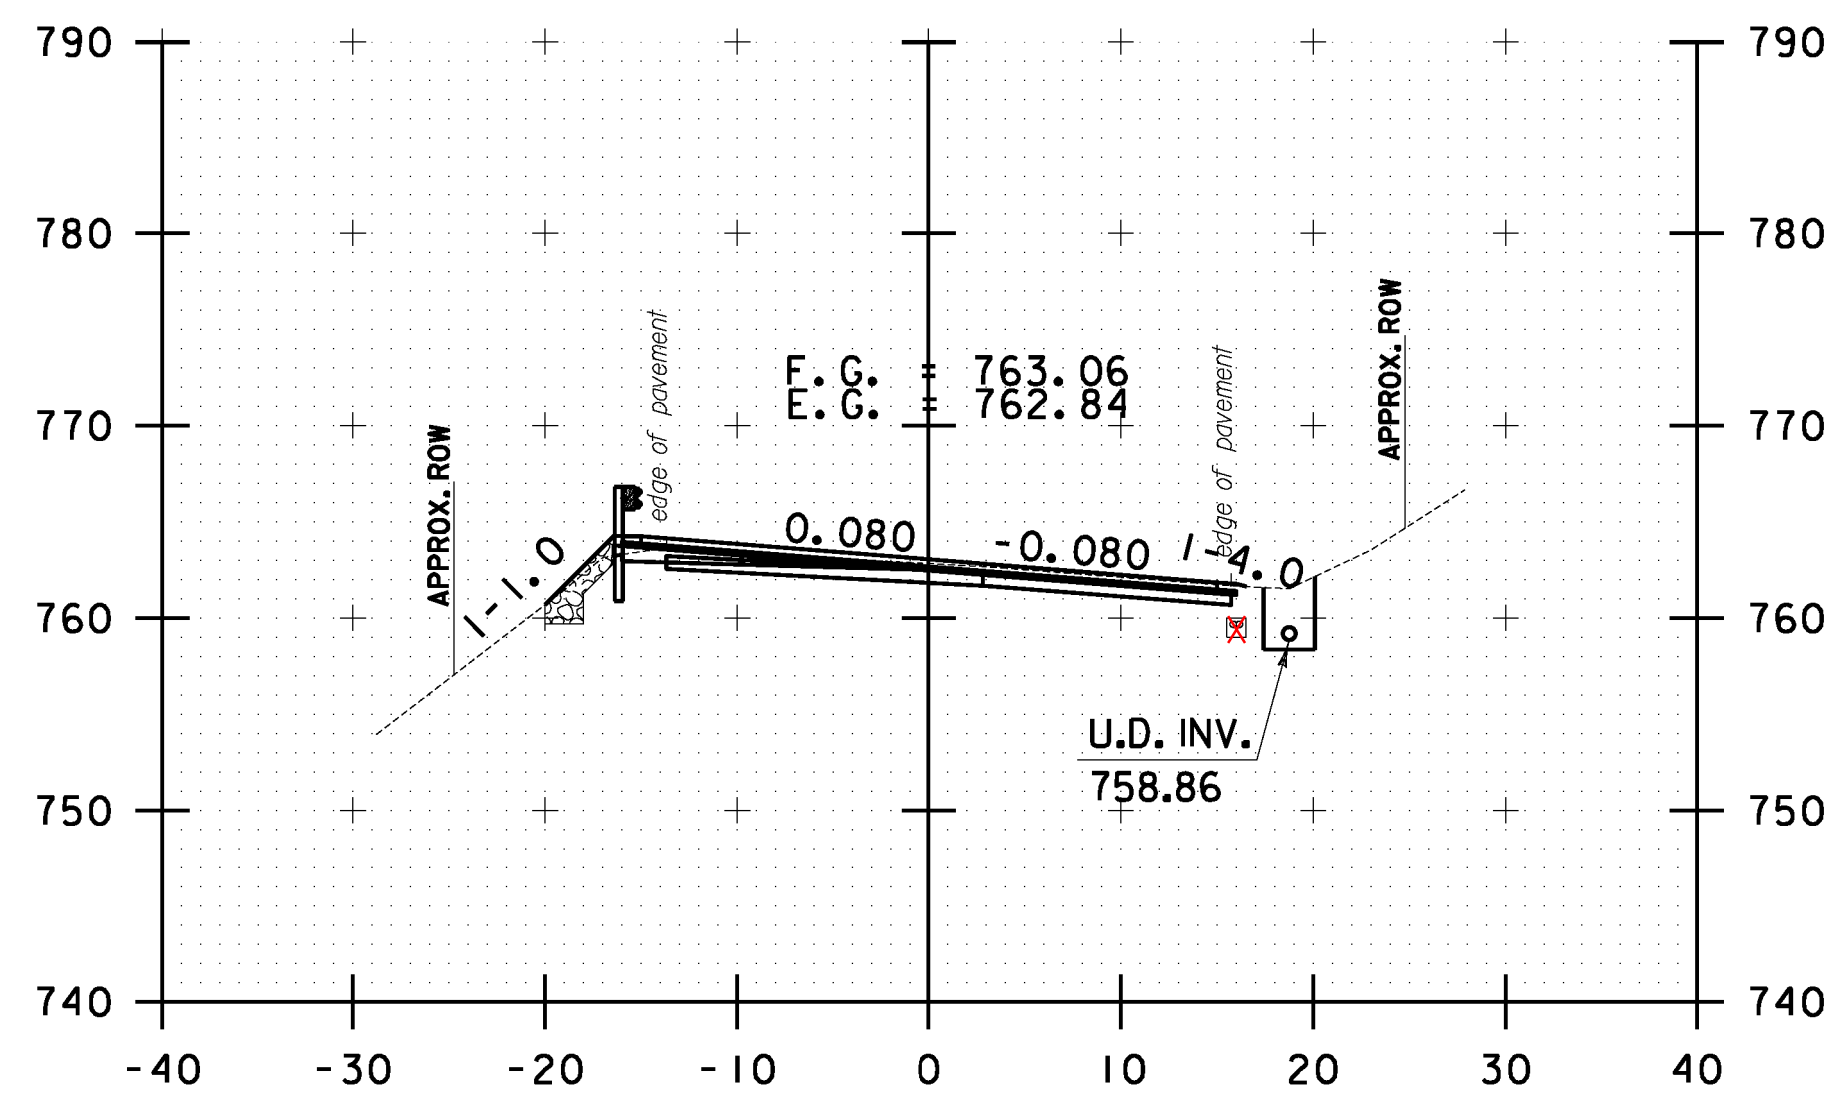


216+50.00

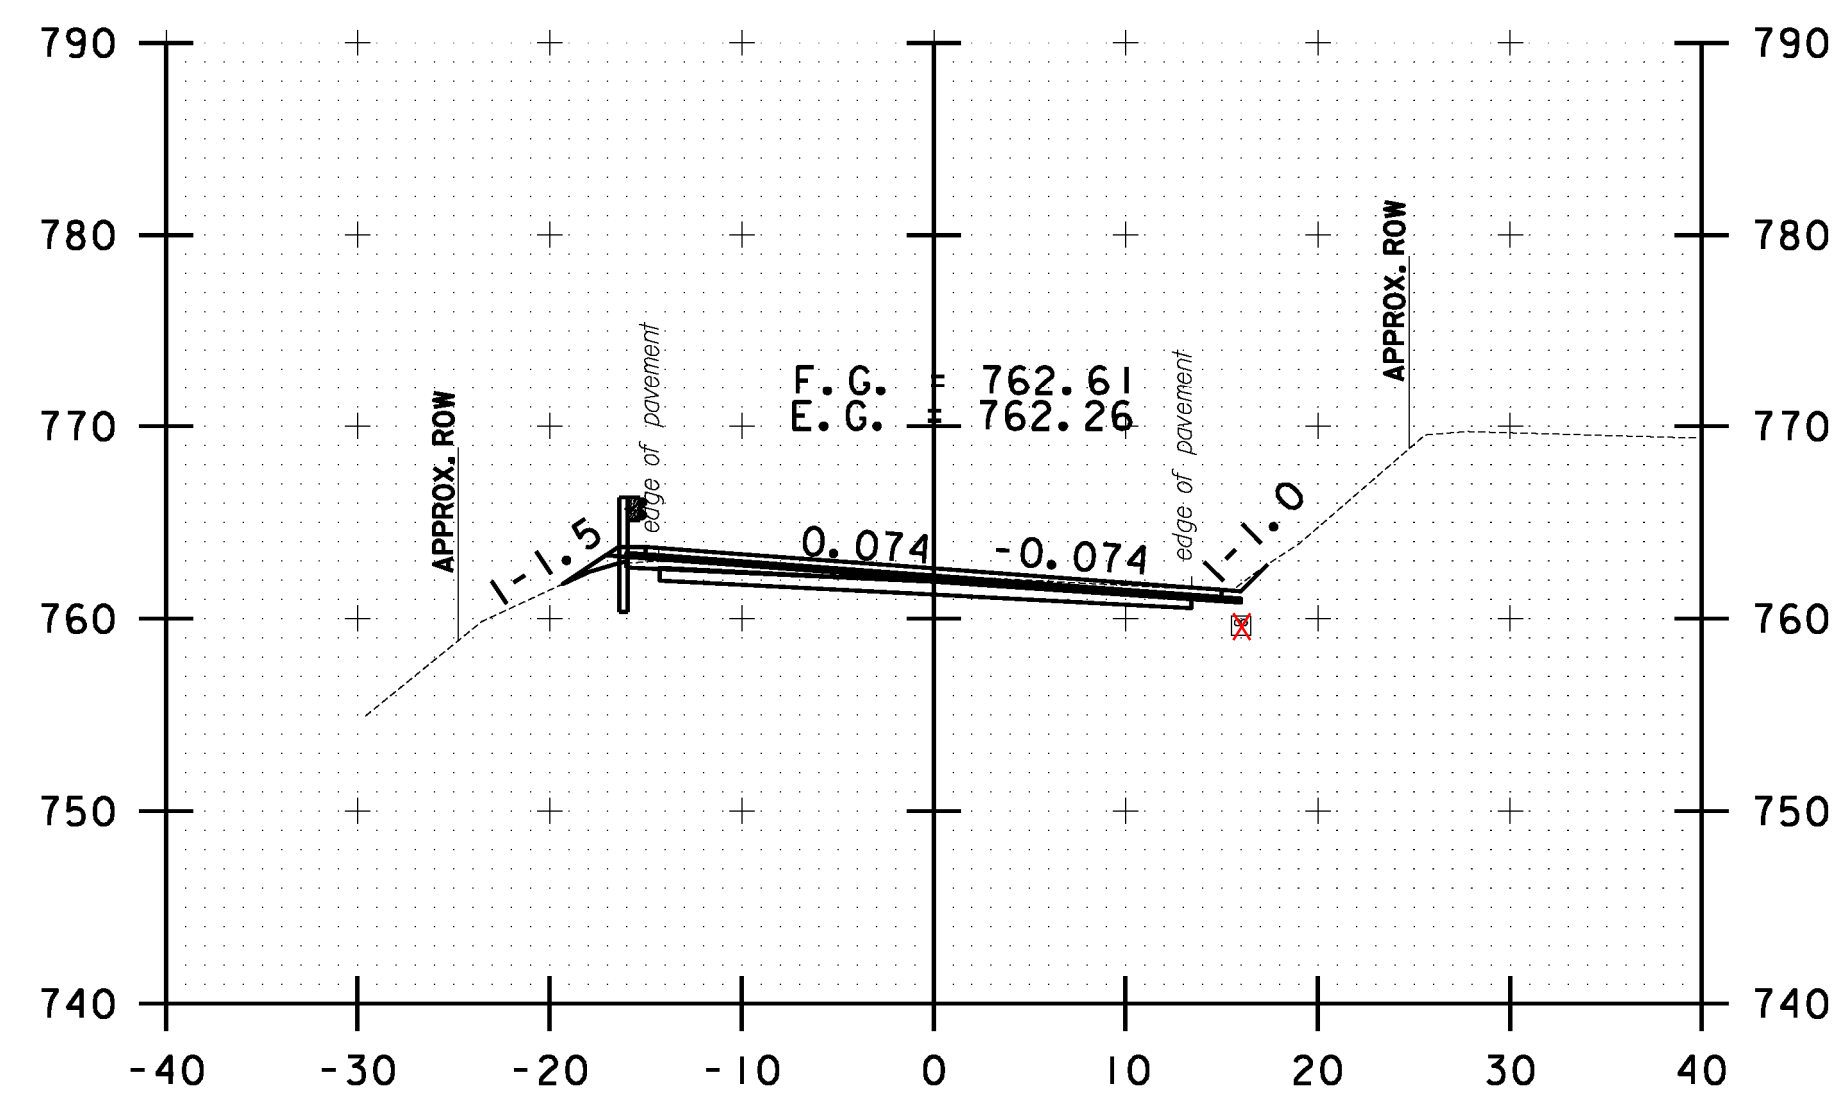


217+50.00

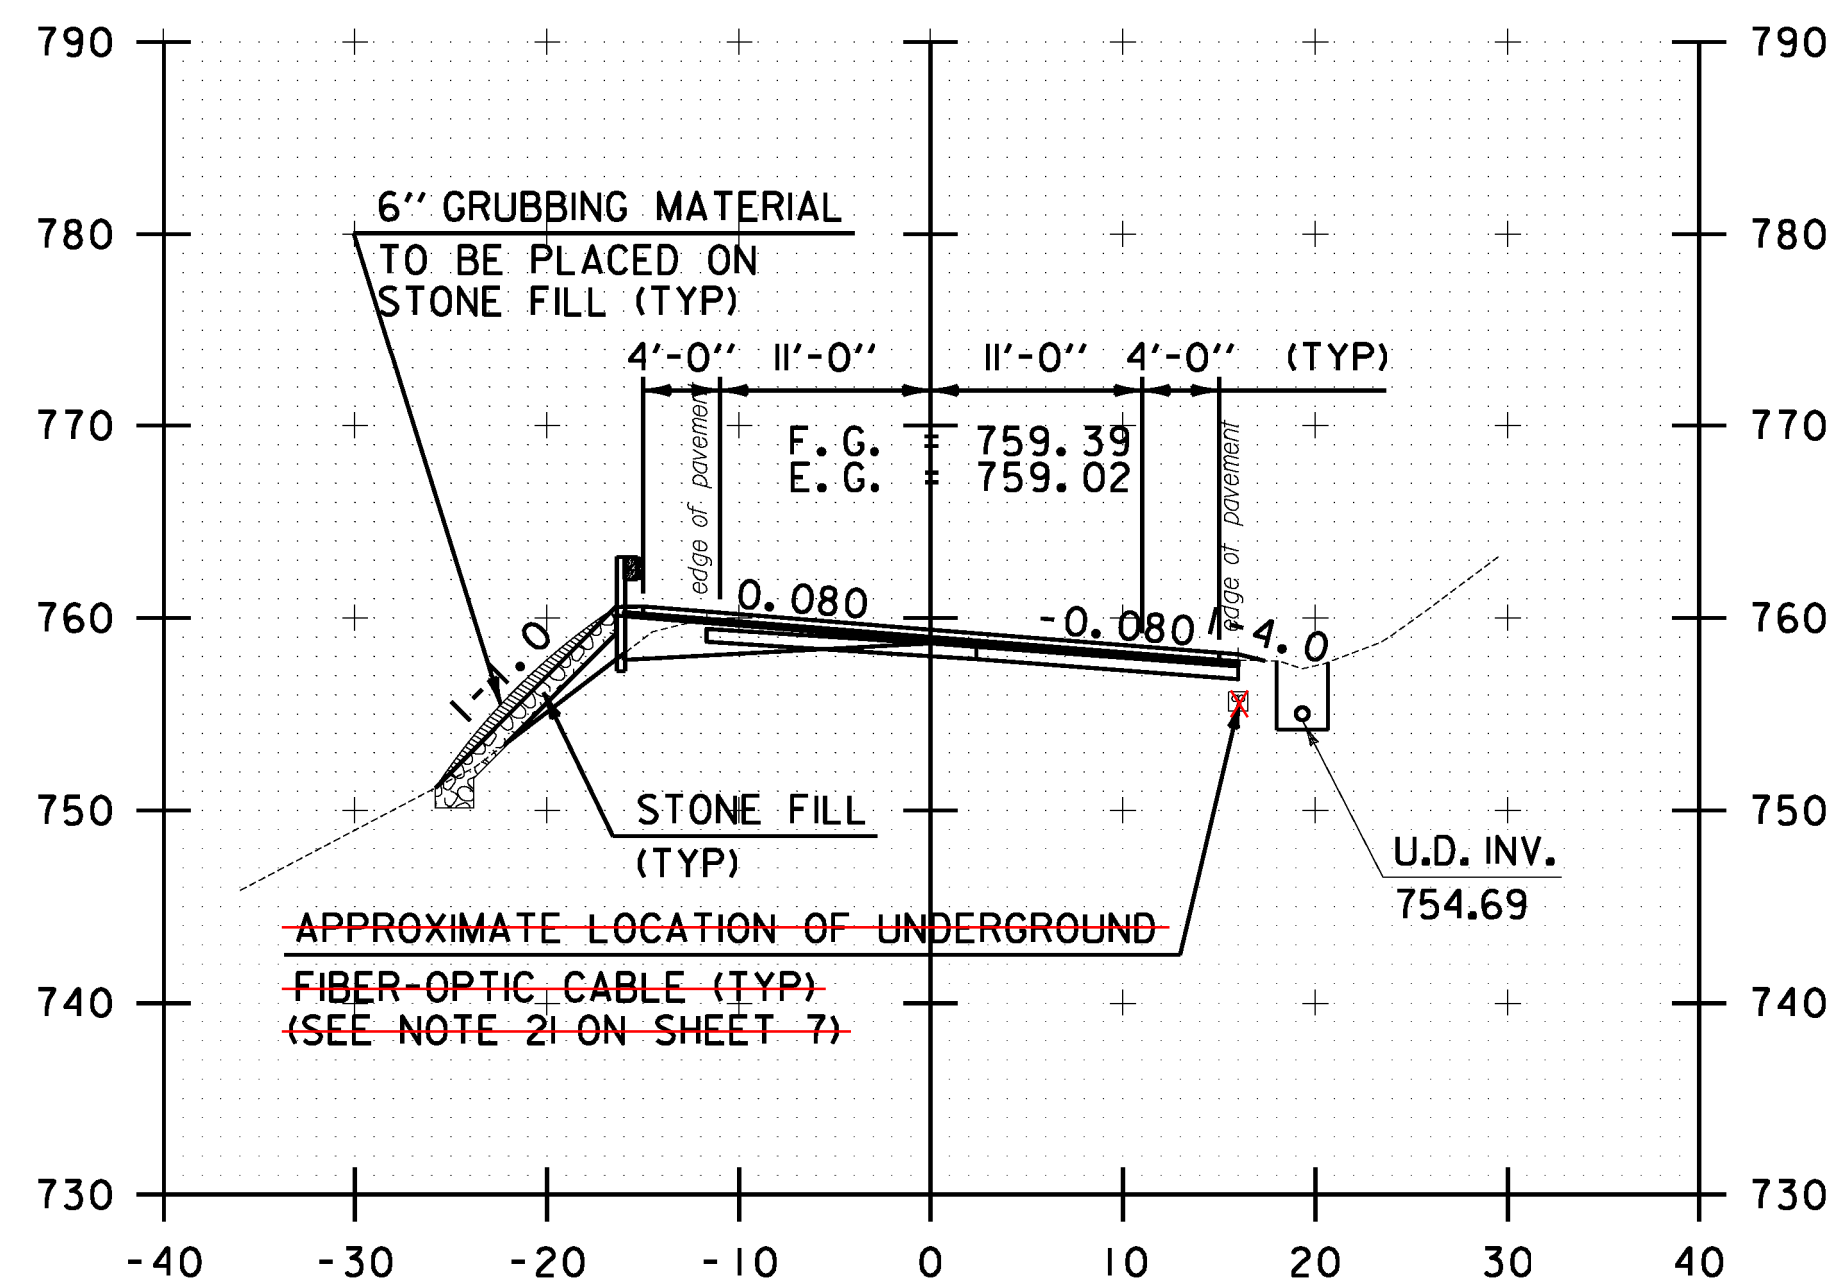


215+00.00

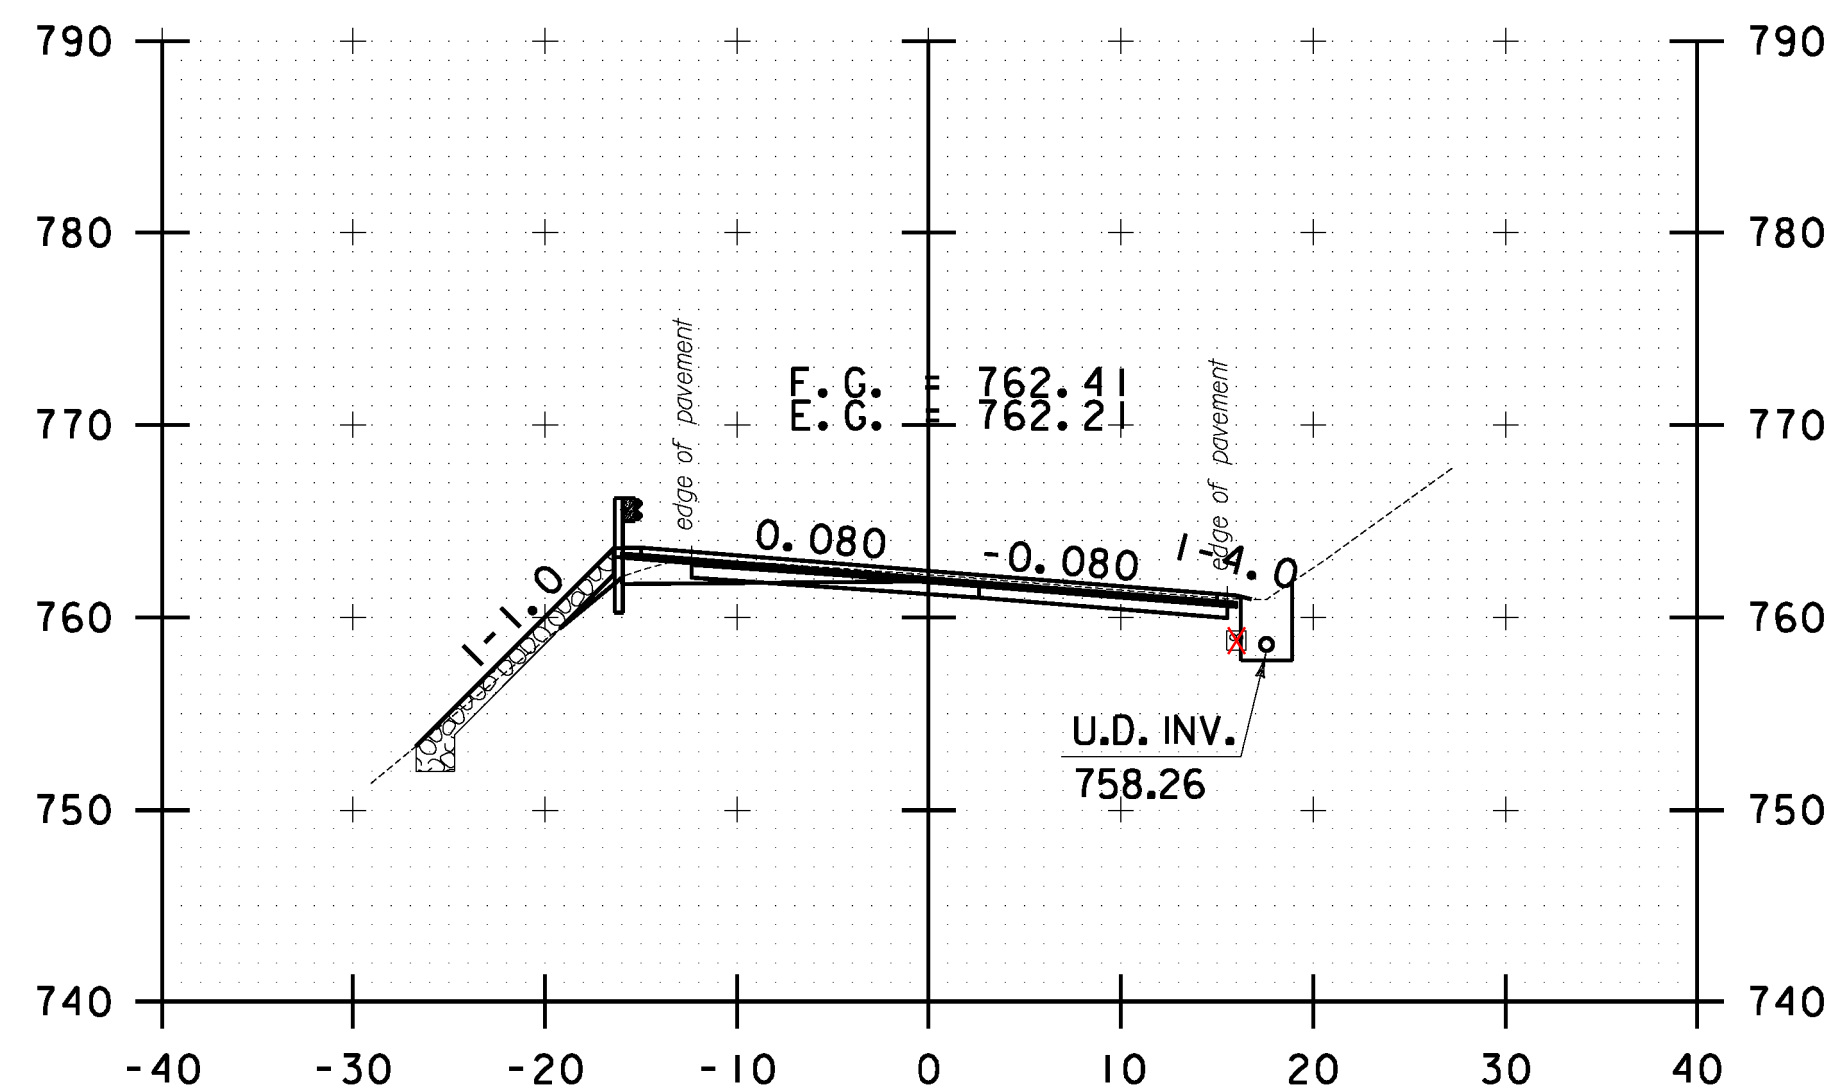

216+00.00

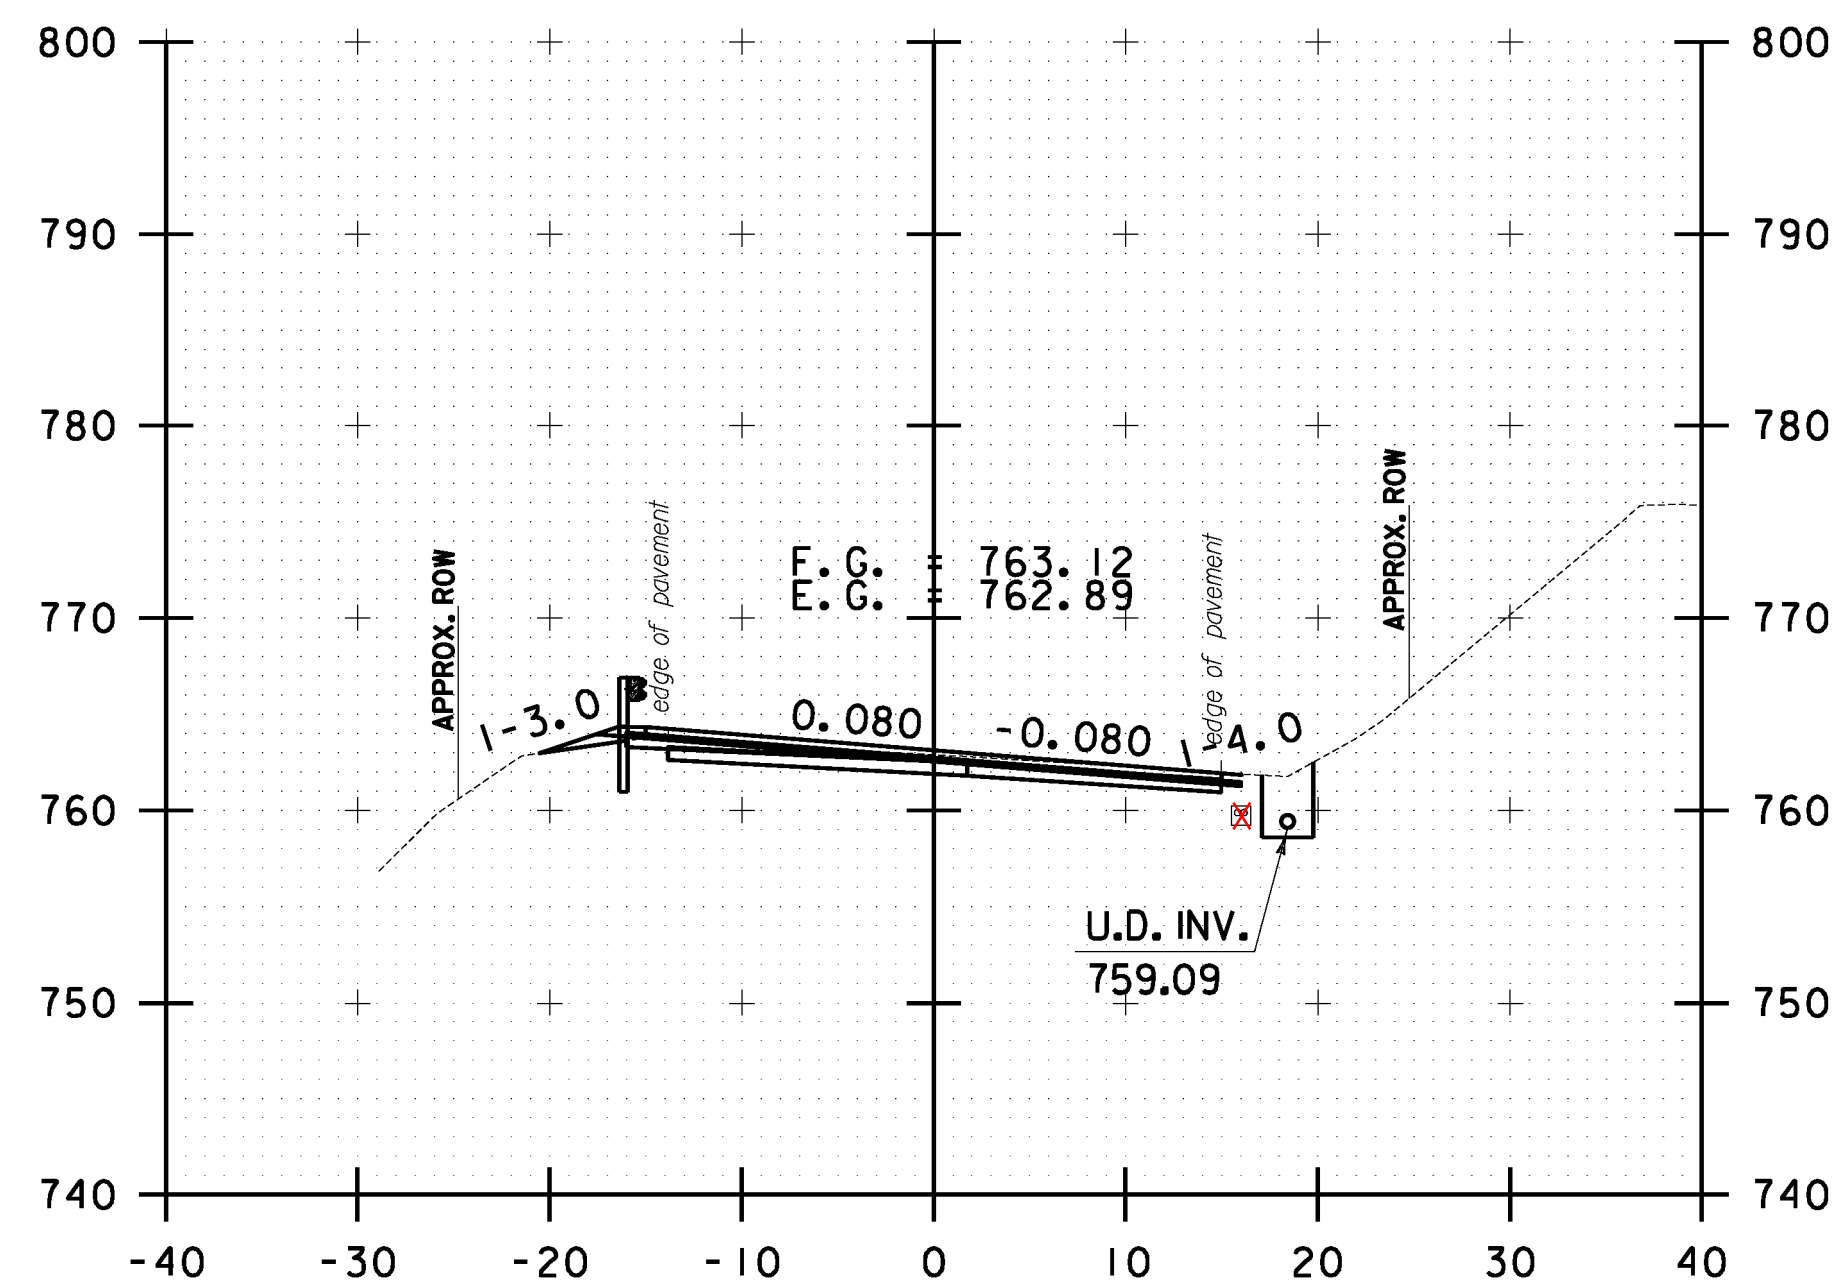

217+00.00

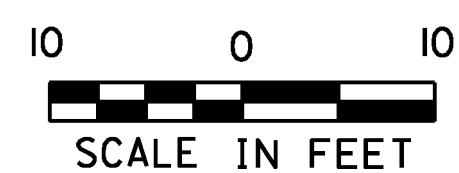

STOCKBRIDGE CROSS SECTION SHEET #67	PROJECT NAME: STOCKBRIDGE-BETHEL
	PROJECT NUMBER: STP 2910(1)
	FILE NAME: z10b214_stock_xc.dgn
	IPARM FILE: z10b214xs67.i
	PLOT DATE: 3/17/2014
	DRAWN BY: W.G.P.
	CHECKED BY: J.P.S.
	SHEET 280 OF 397