




FILE NAME = \\172\projects\14\172\stock\214\stock_xc.dgn
 DATE = 3/17/2014
 USER = LMB

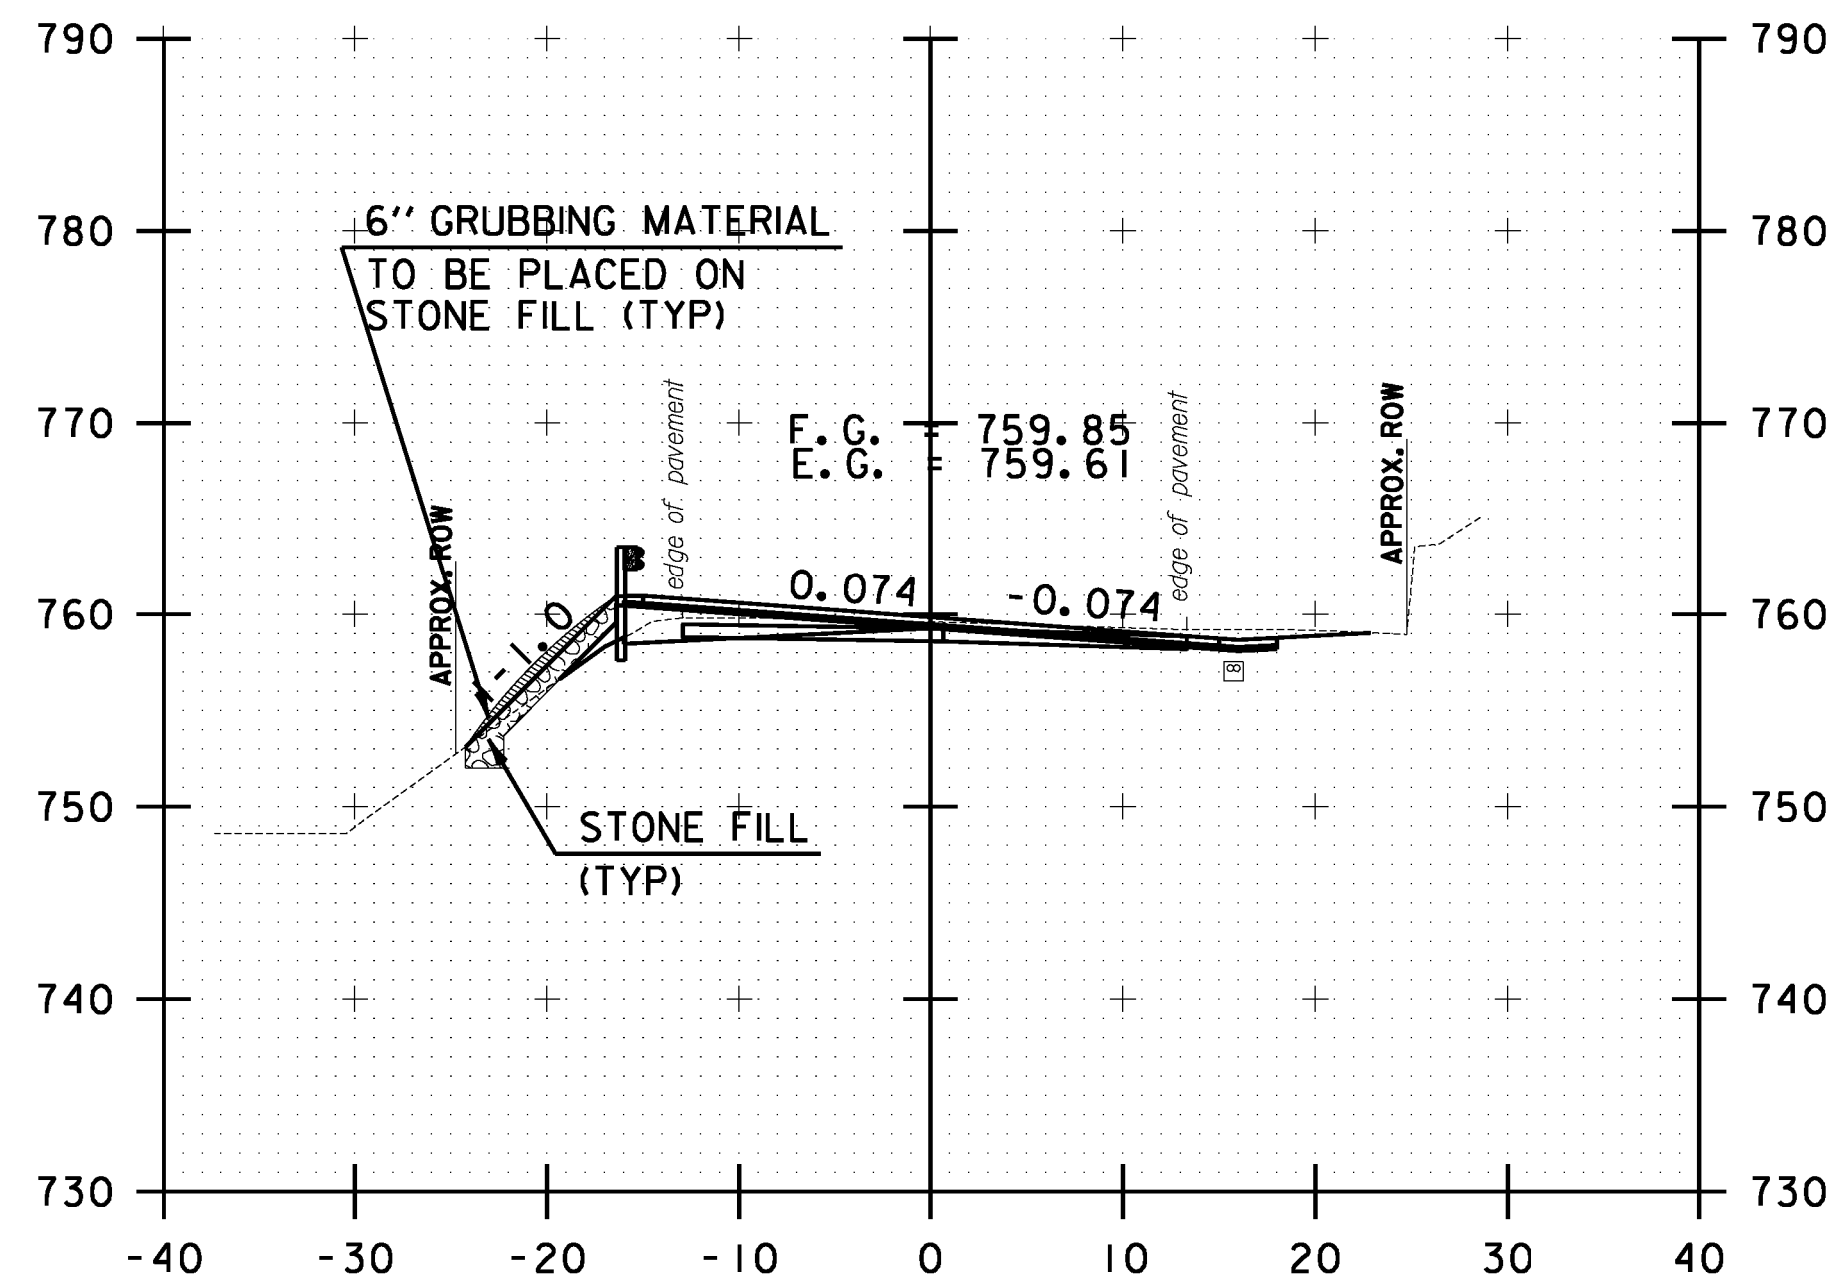


218+50.00

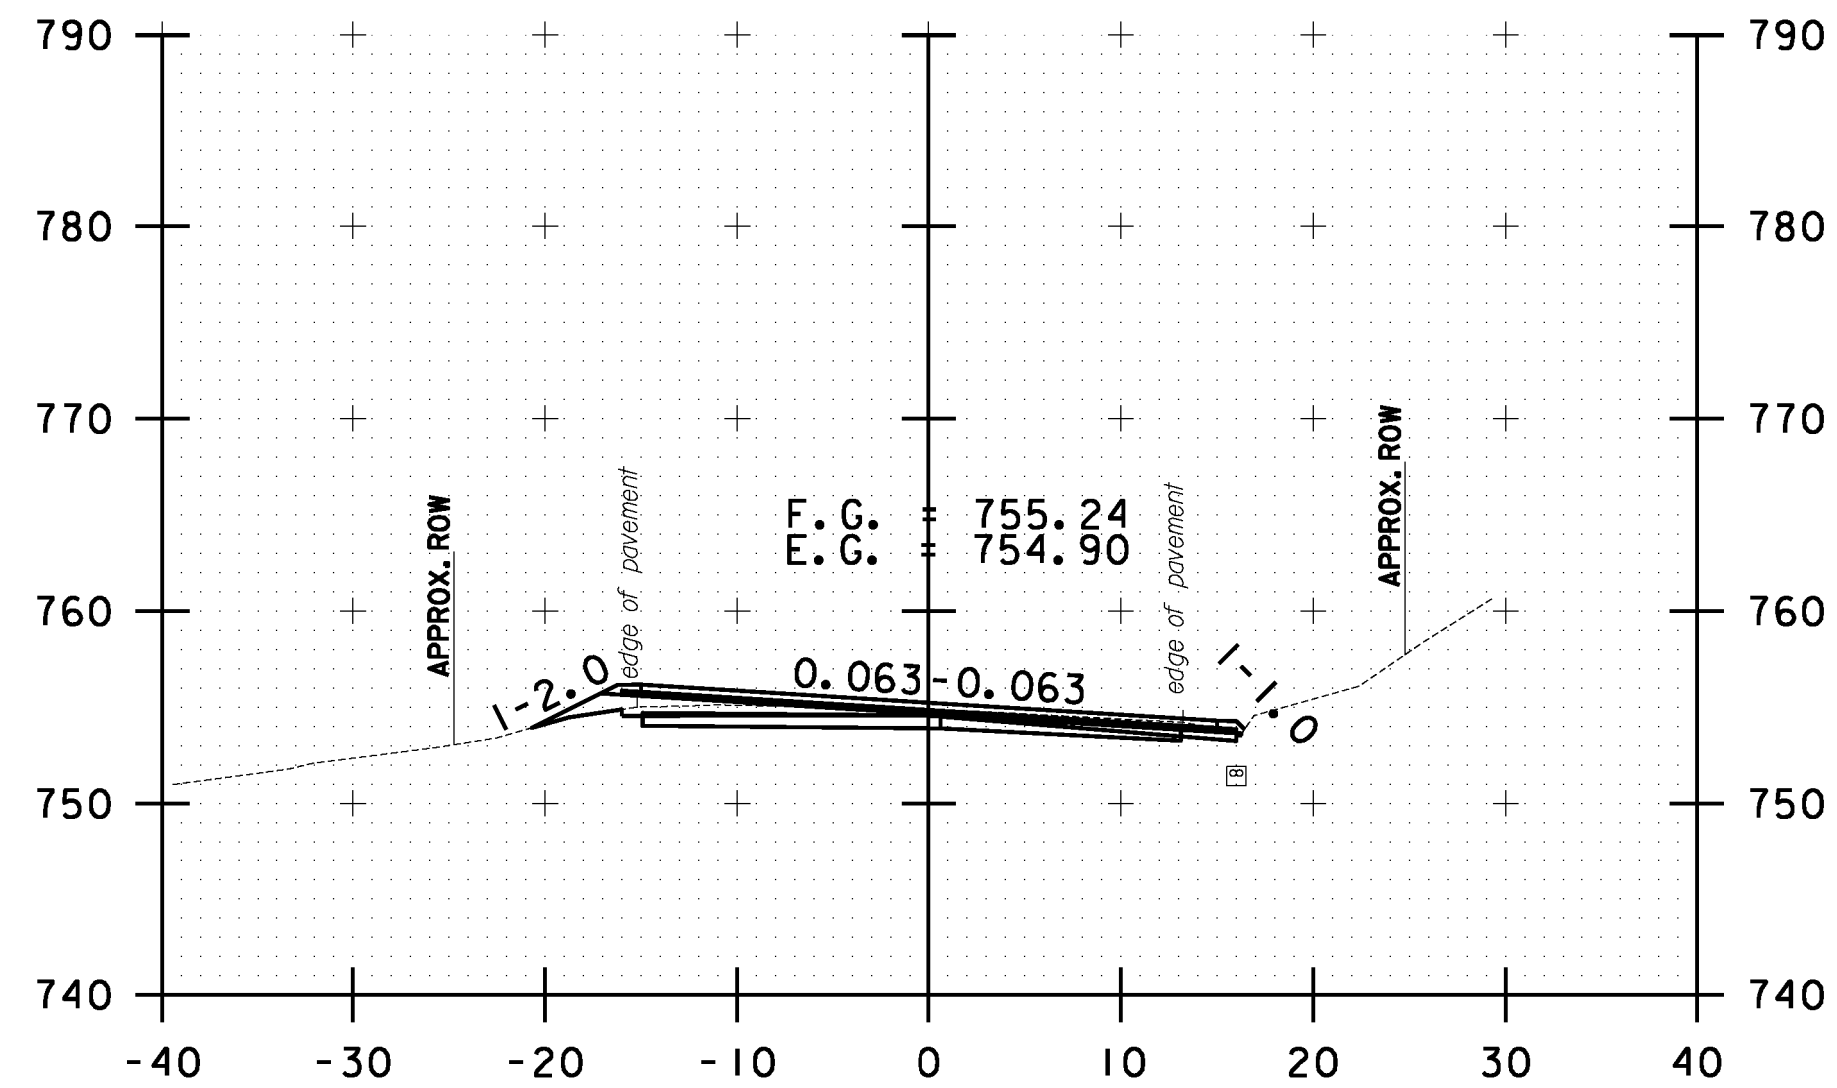


219+50.00

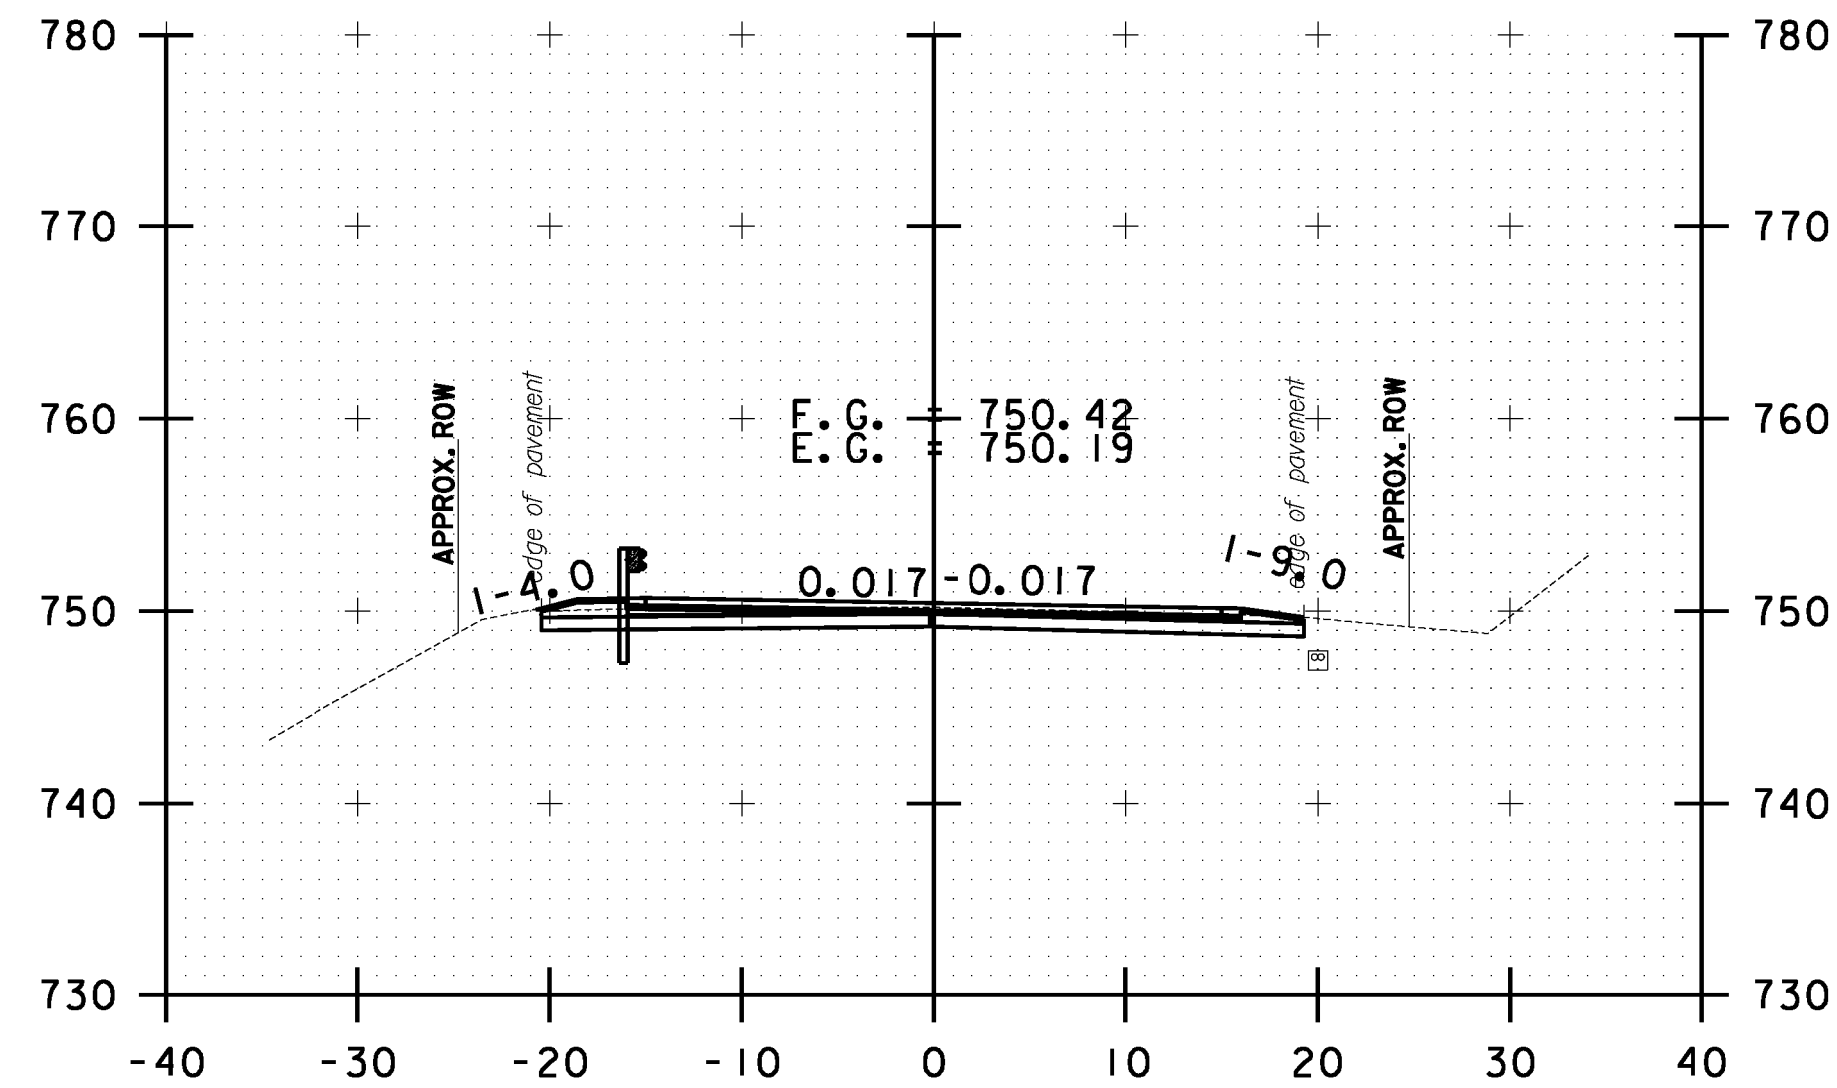


220+50.00

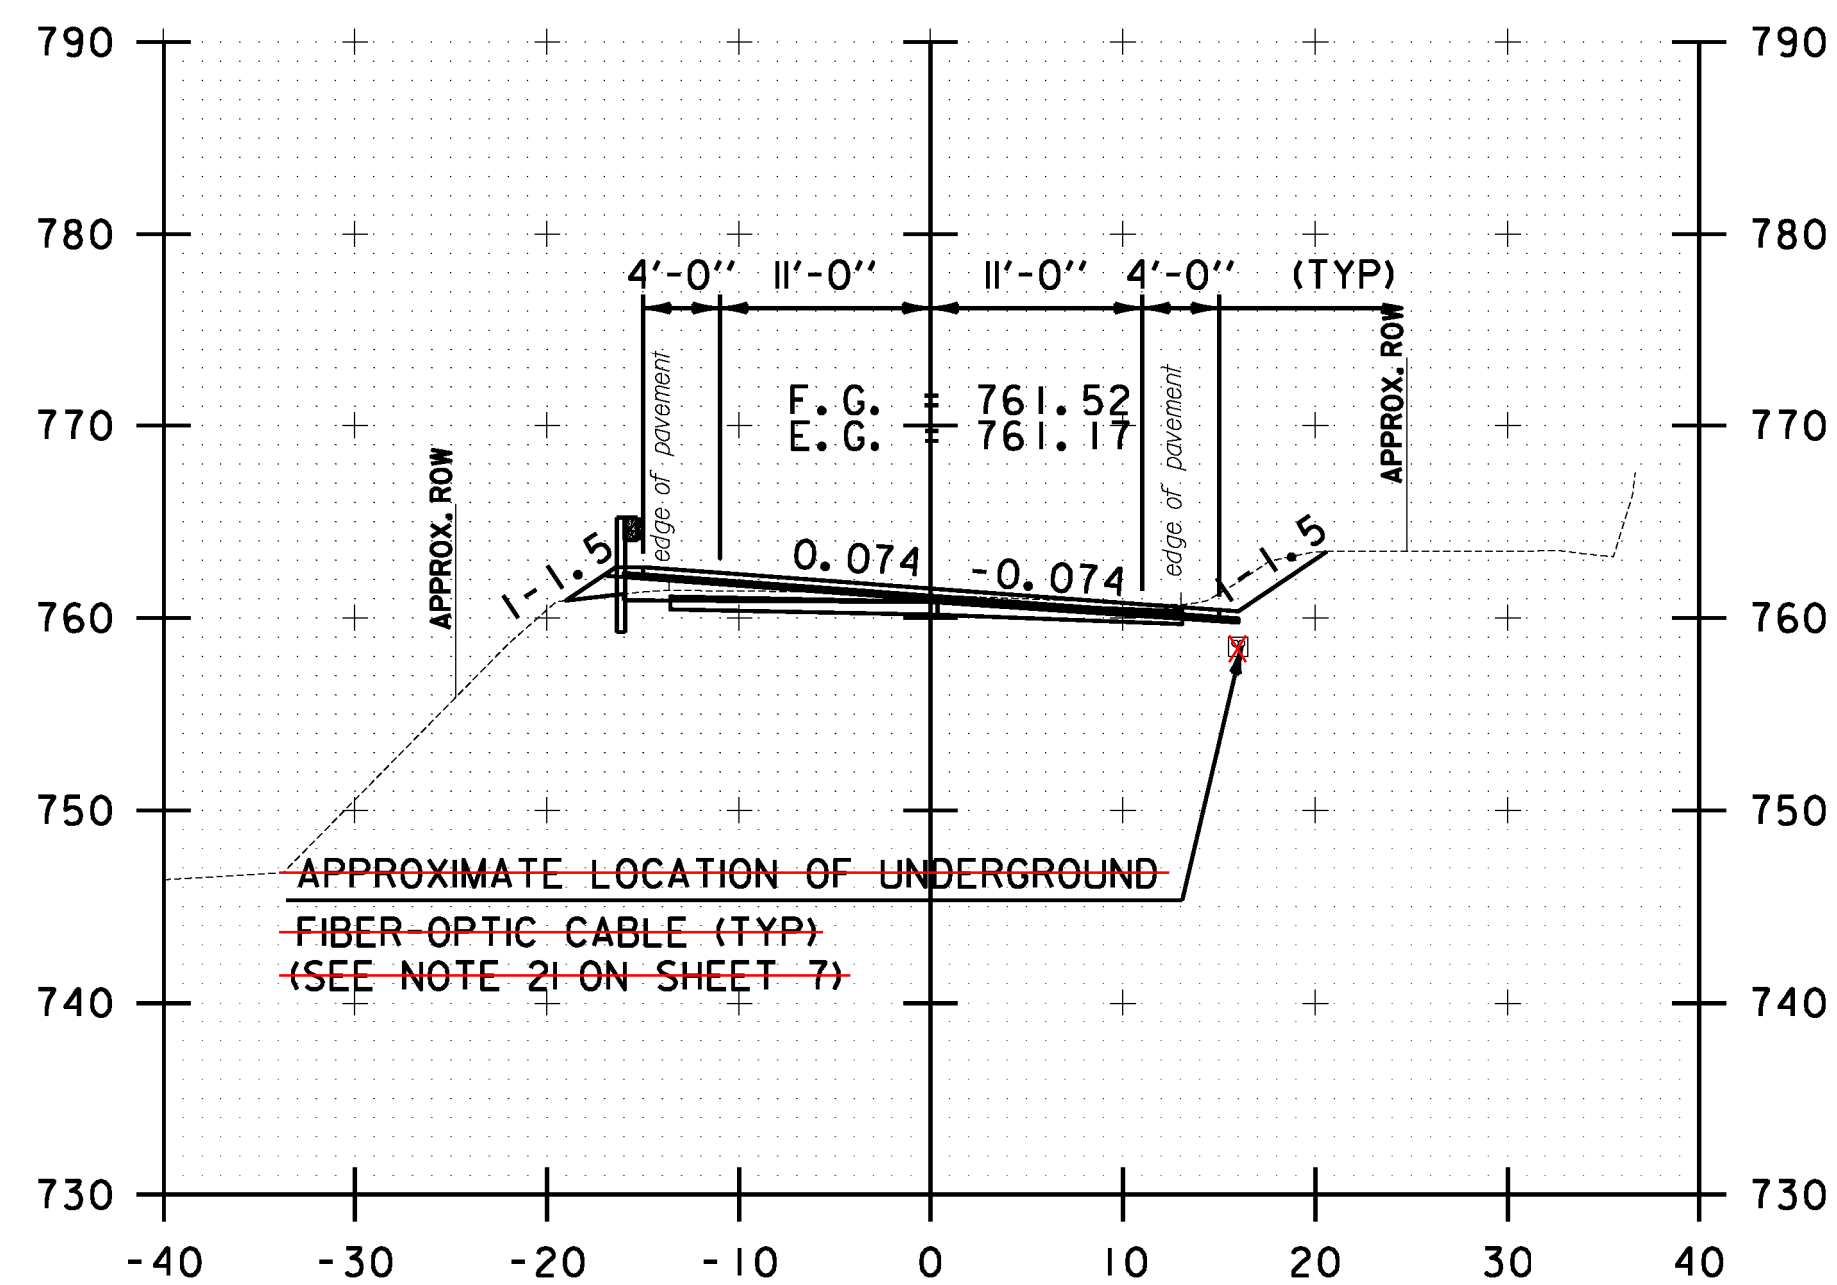


218+00.00

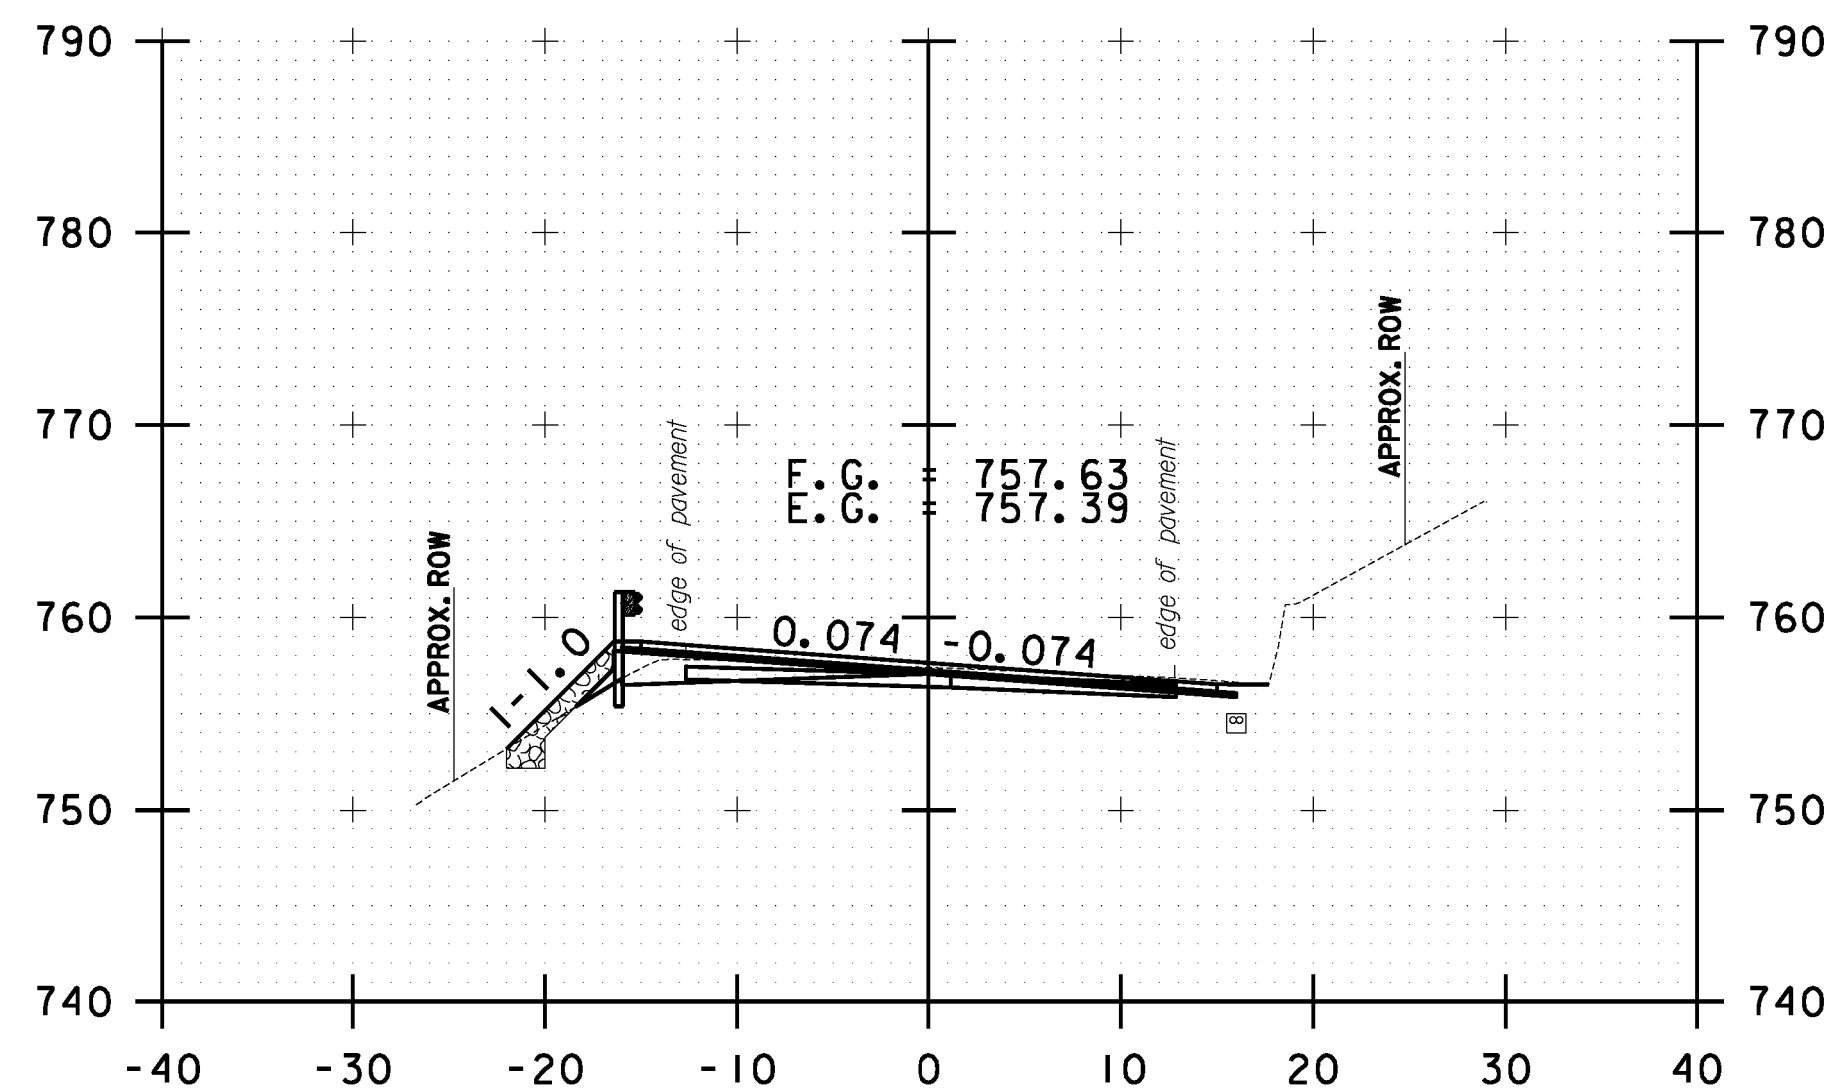

219+00.00

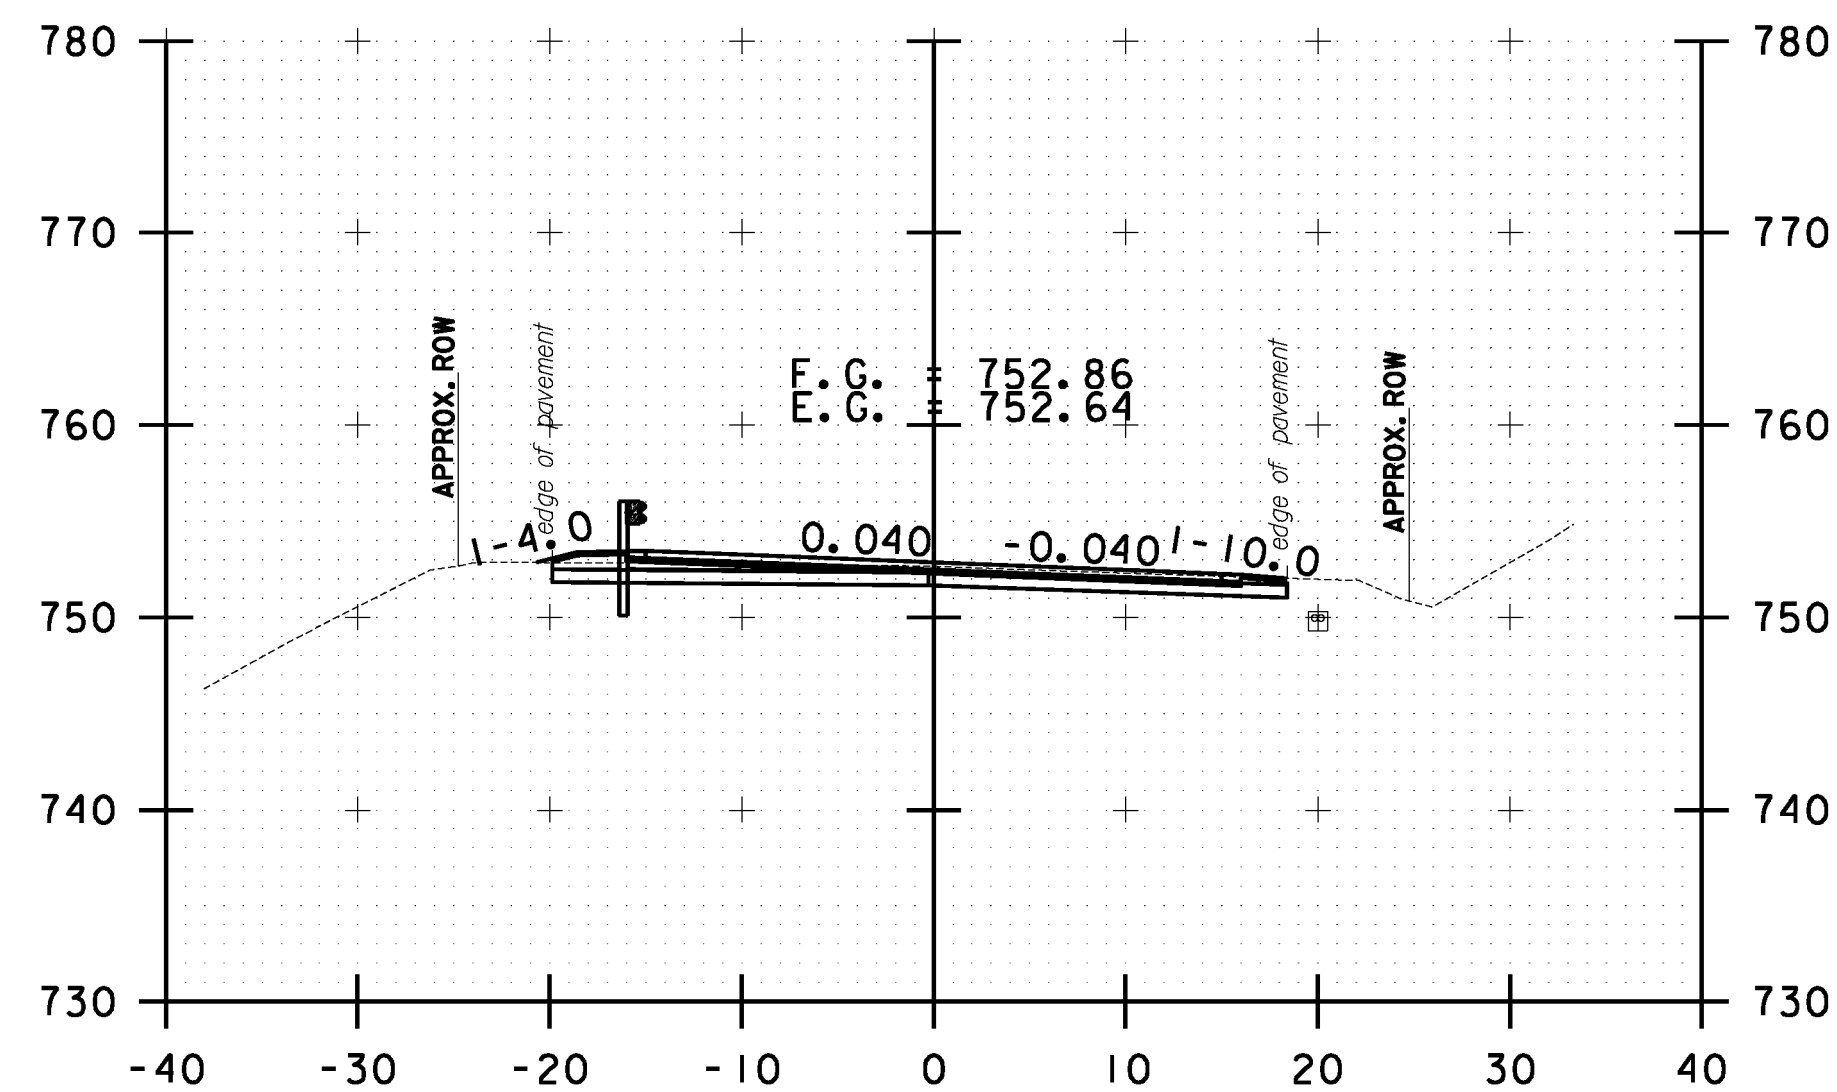

220+00.00

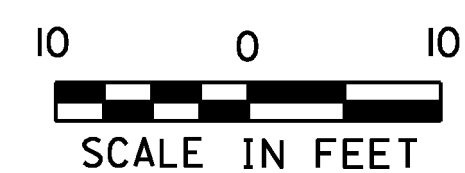

STOCKBRIDGE CROSS SECTION SHEET #68	PROJECT NAME: STOCKBRIDGE-BETHEL
	PROJECT NUMBER: STP 2910(1)
	FILE NAME: z10b214_stock_xc.dgn
	IPARM FILE: z10b214xs68.i
	PLOT DATE: 3/17/2014
	DRAWN BY: W.G.P.
	CHECKED BY: J.P.S.
	SHEET 281 OF 397