




FILE NAME = Y:\P\c\p\stock\ANY\K2\22425\CADD\MSTN10b214_stock.nc.dgn
 DATE/TIME = 3/17/2014
 USER = 4916

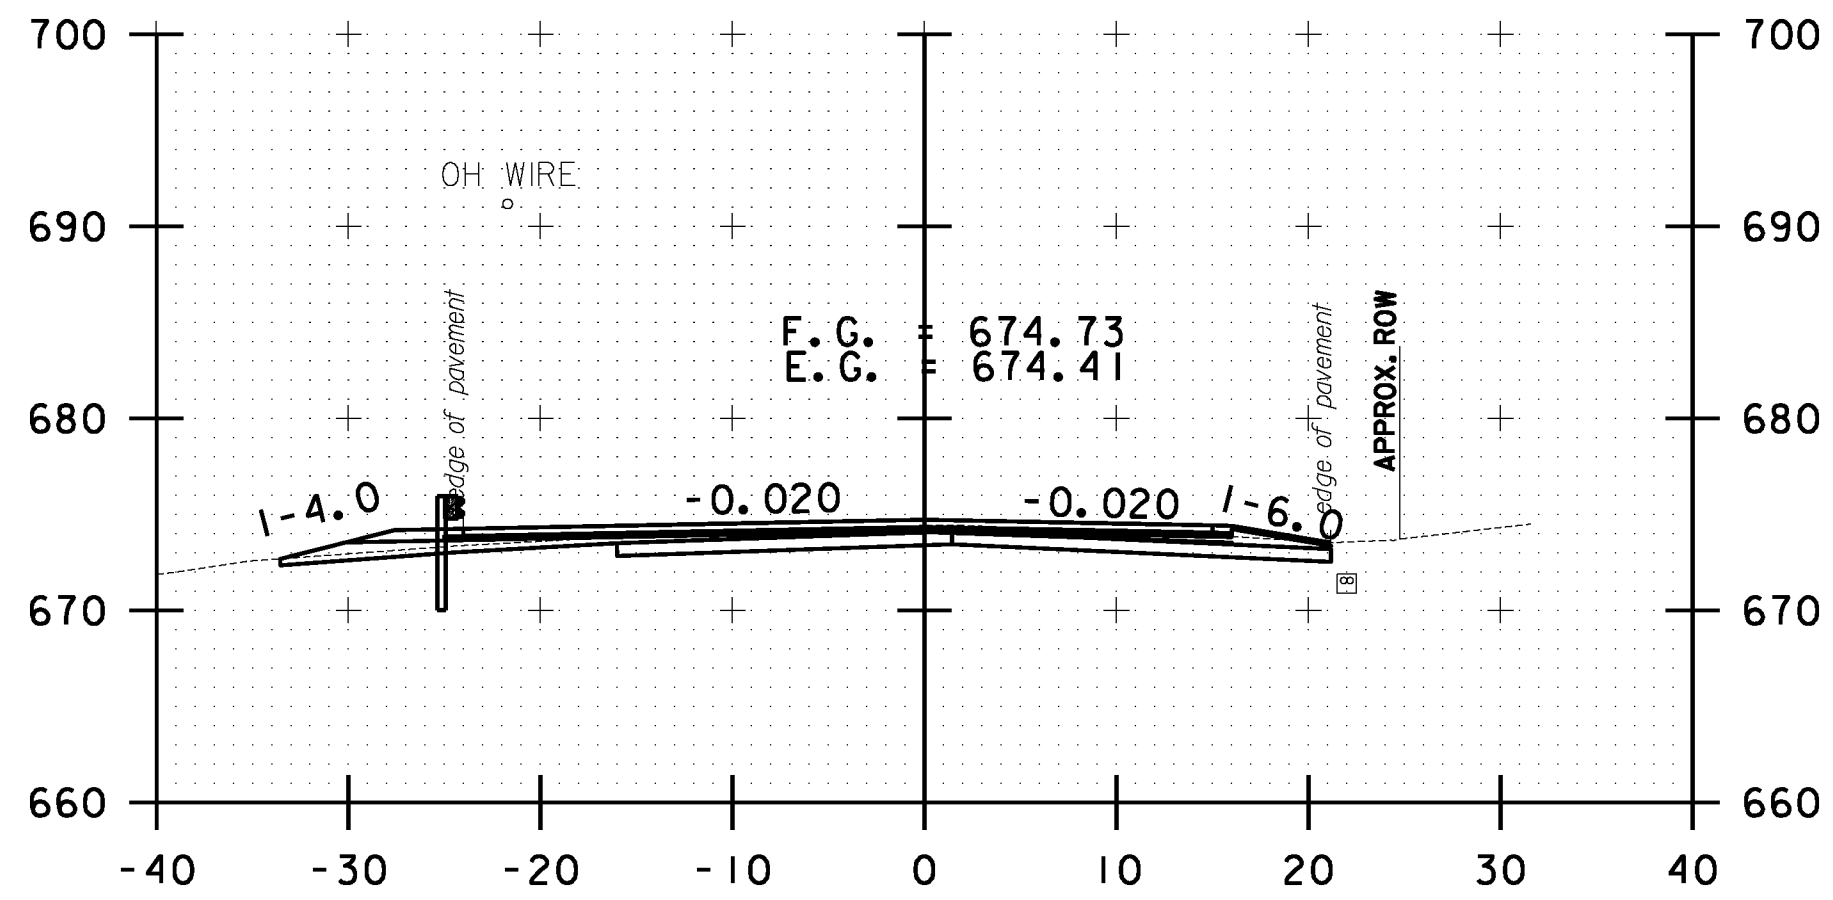


232+50.00

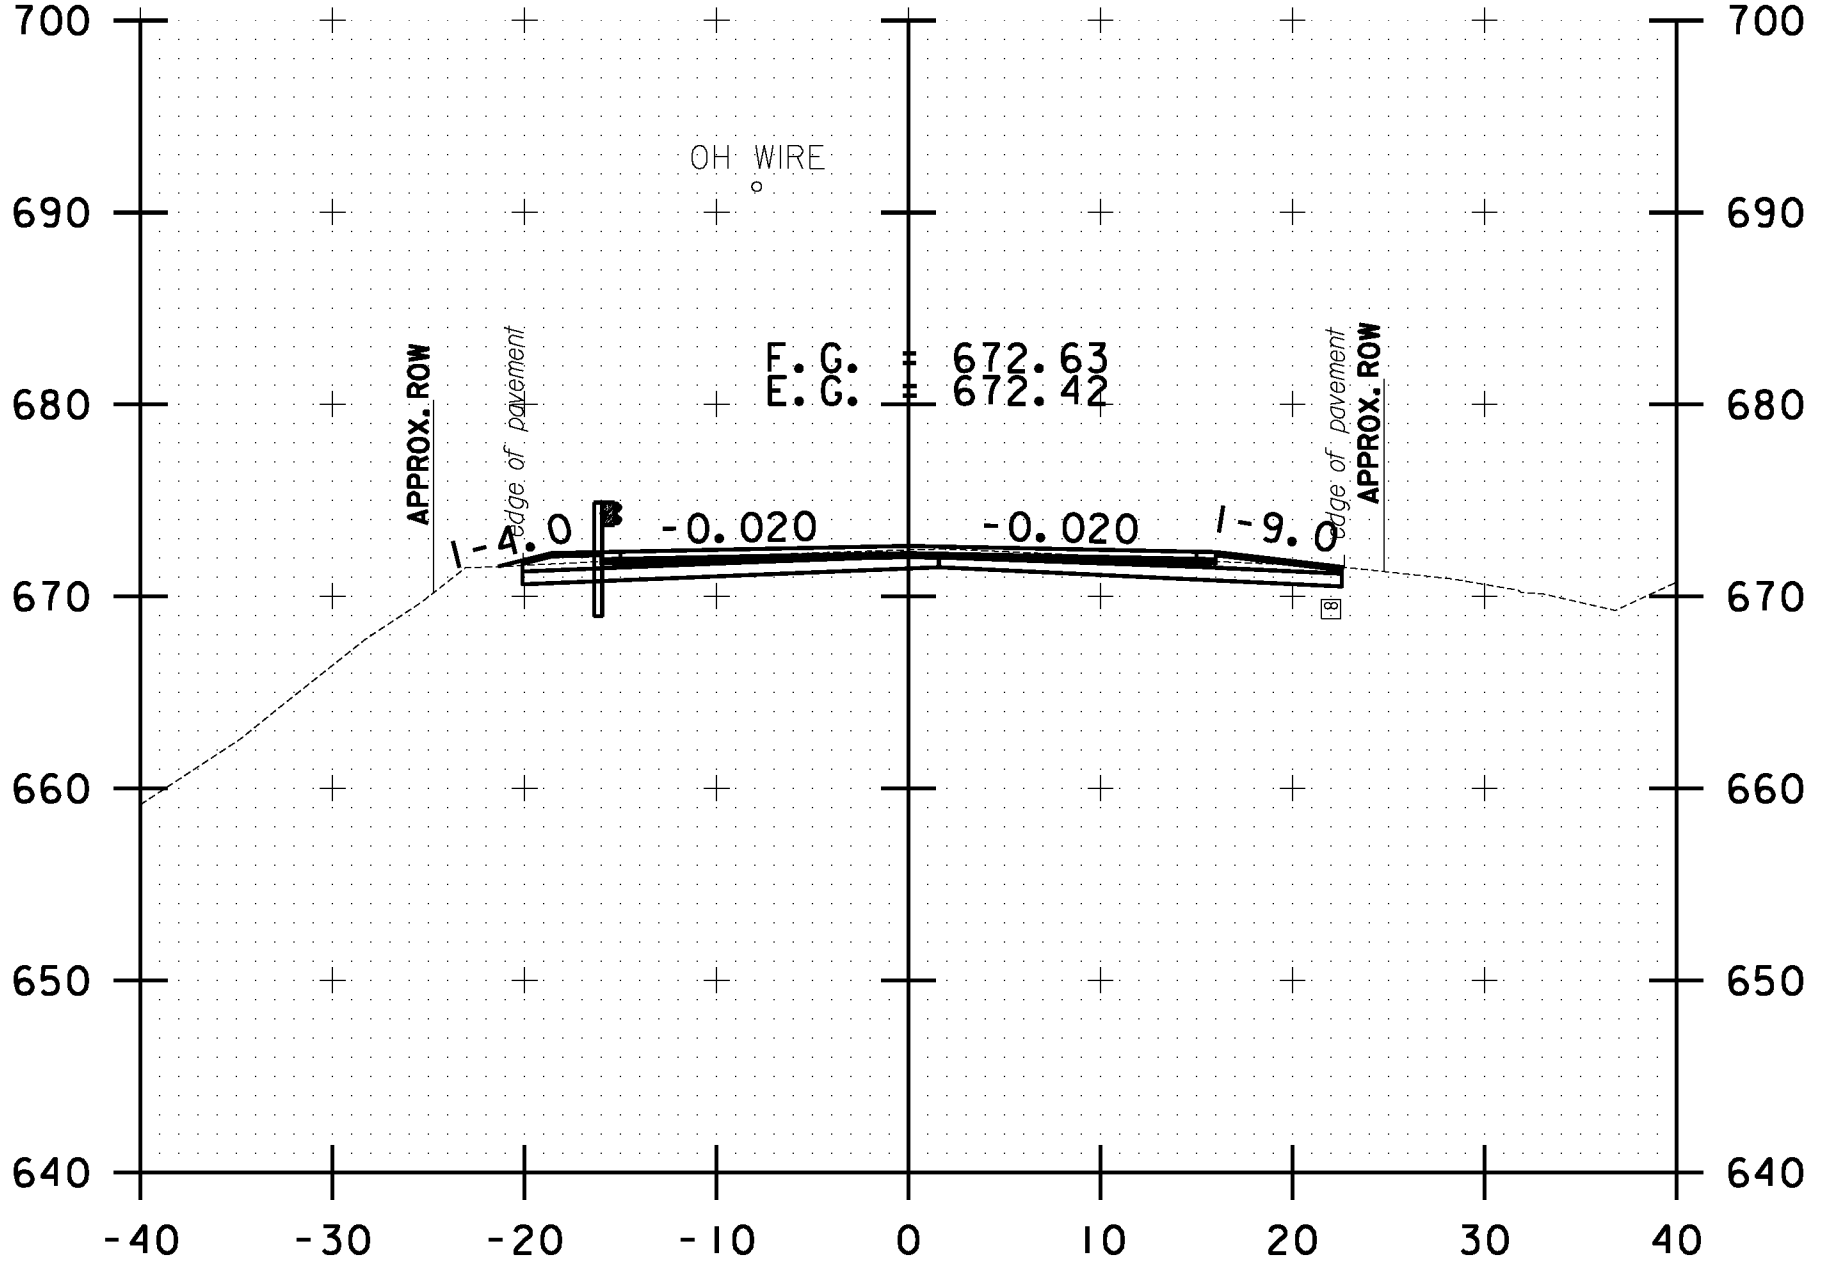


233+50.00

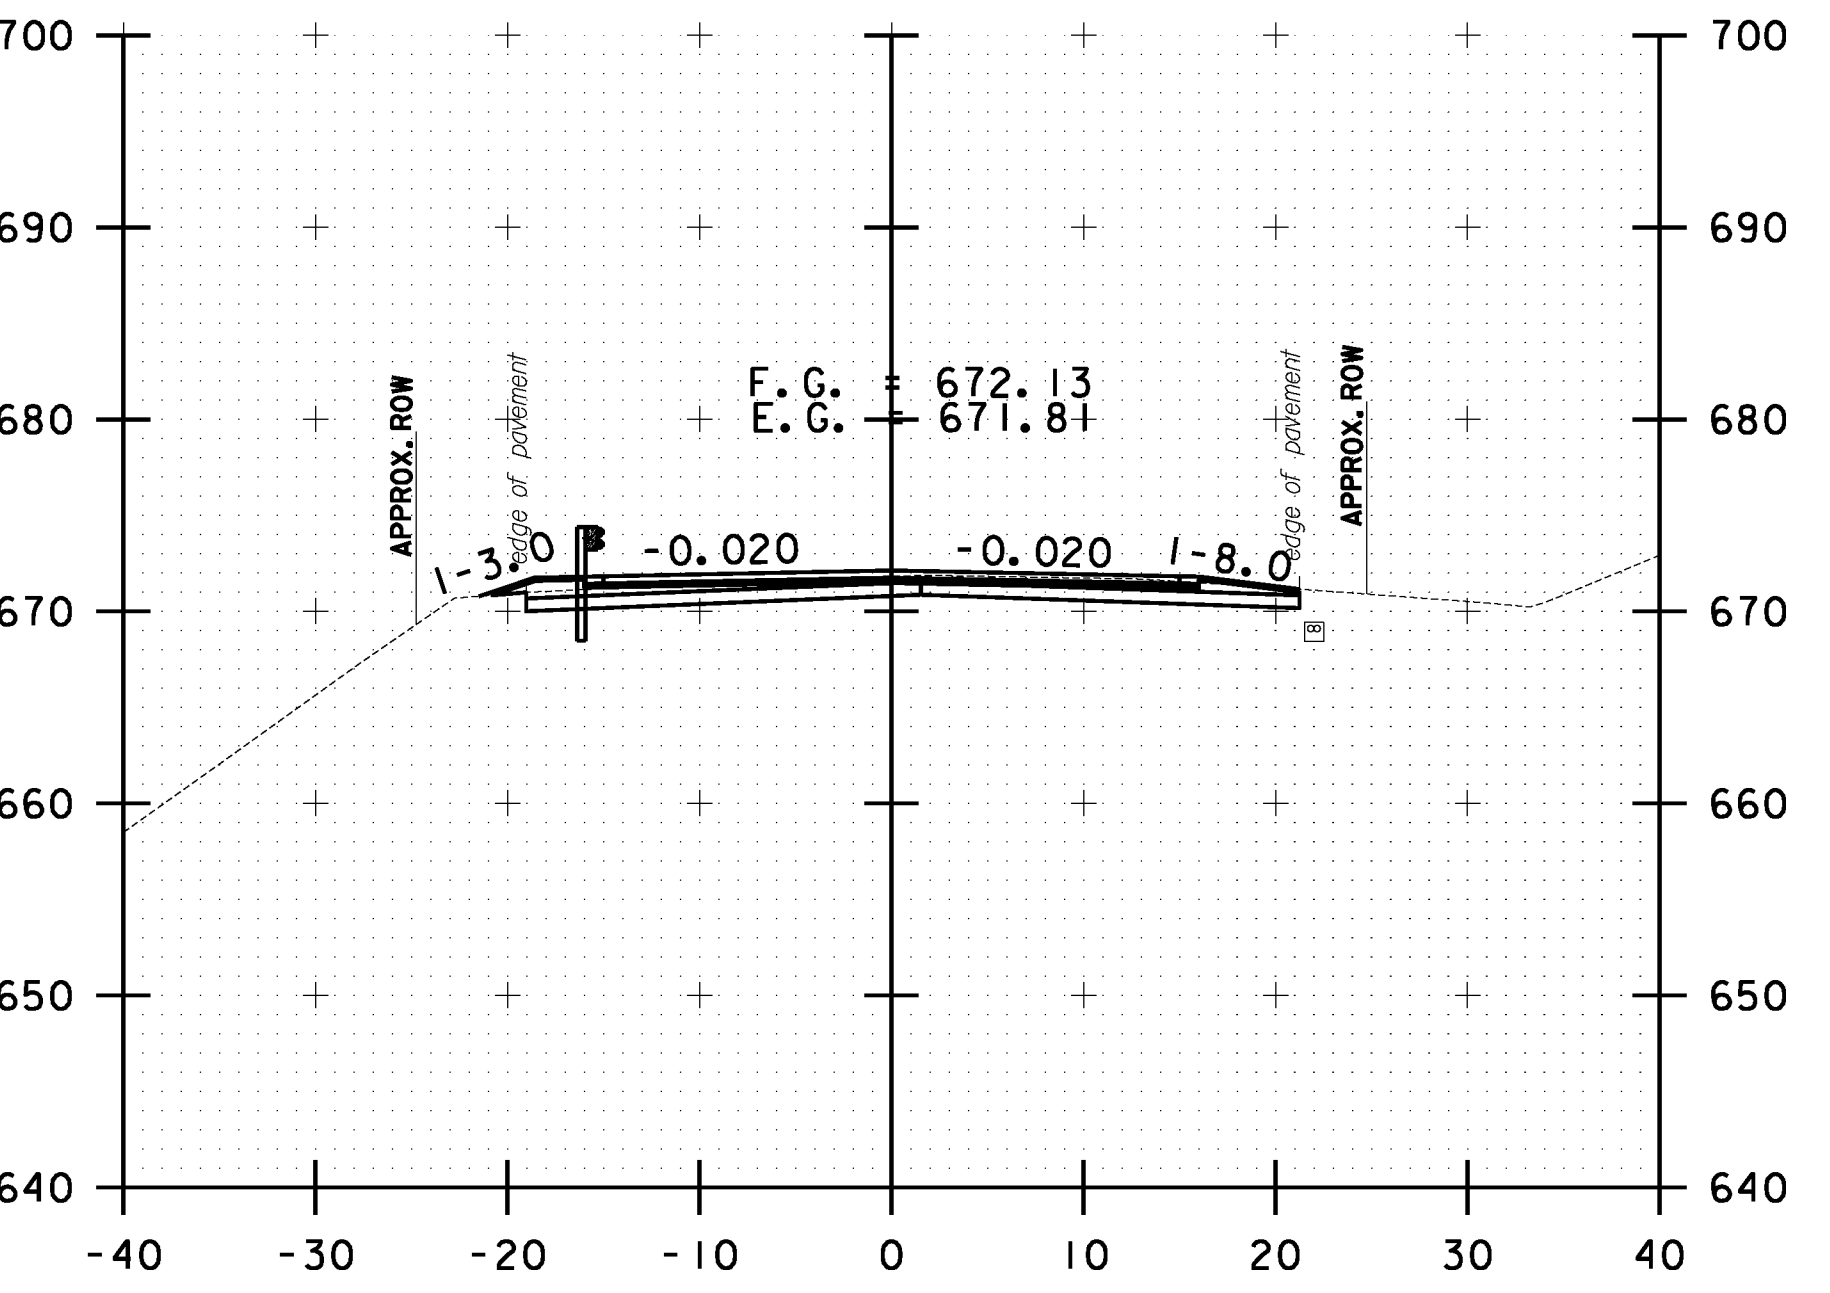


234+50.00

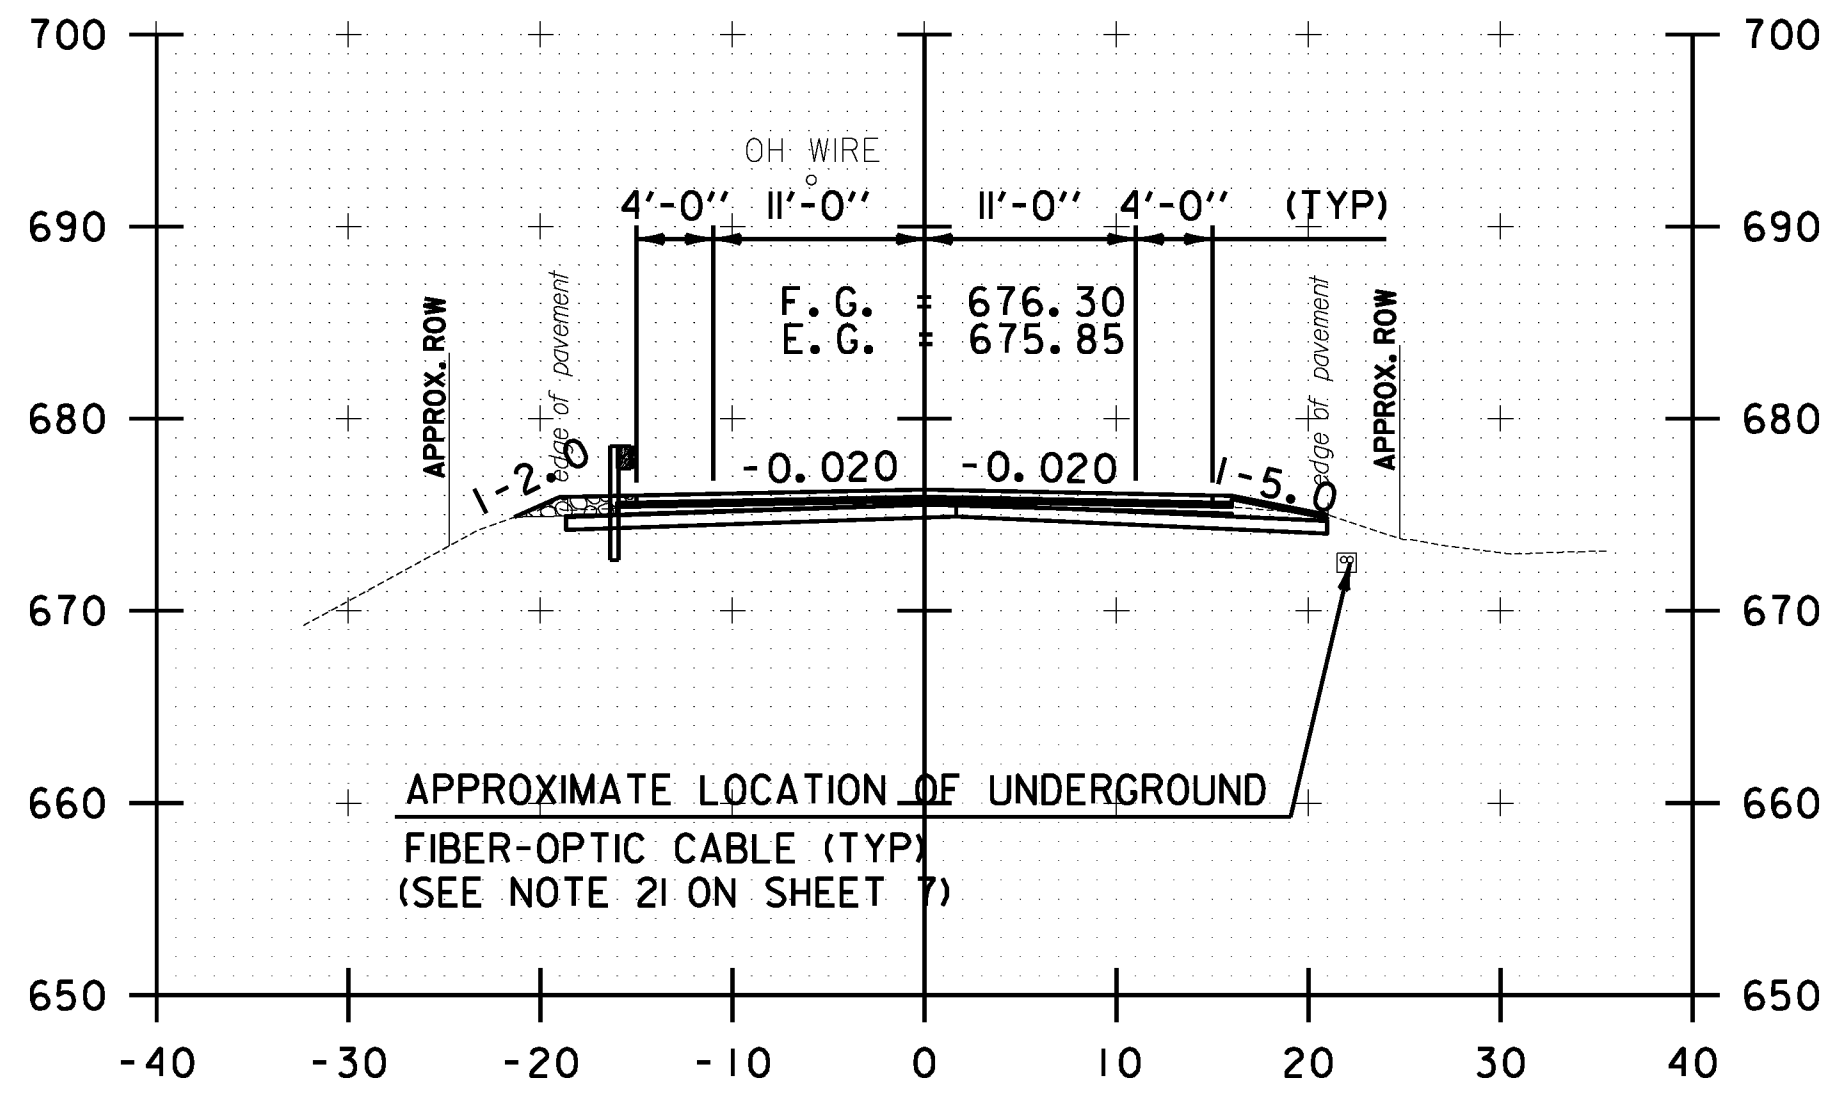


232+00.00

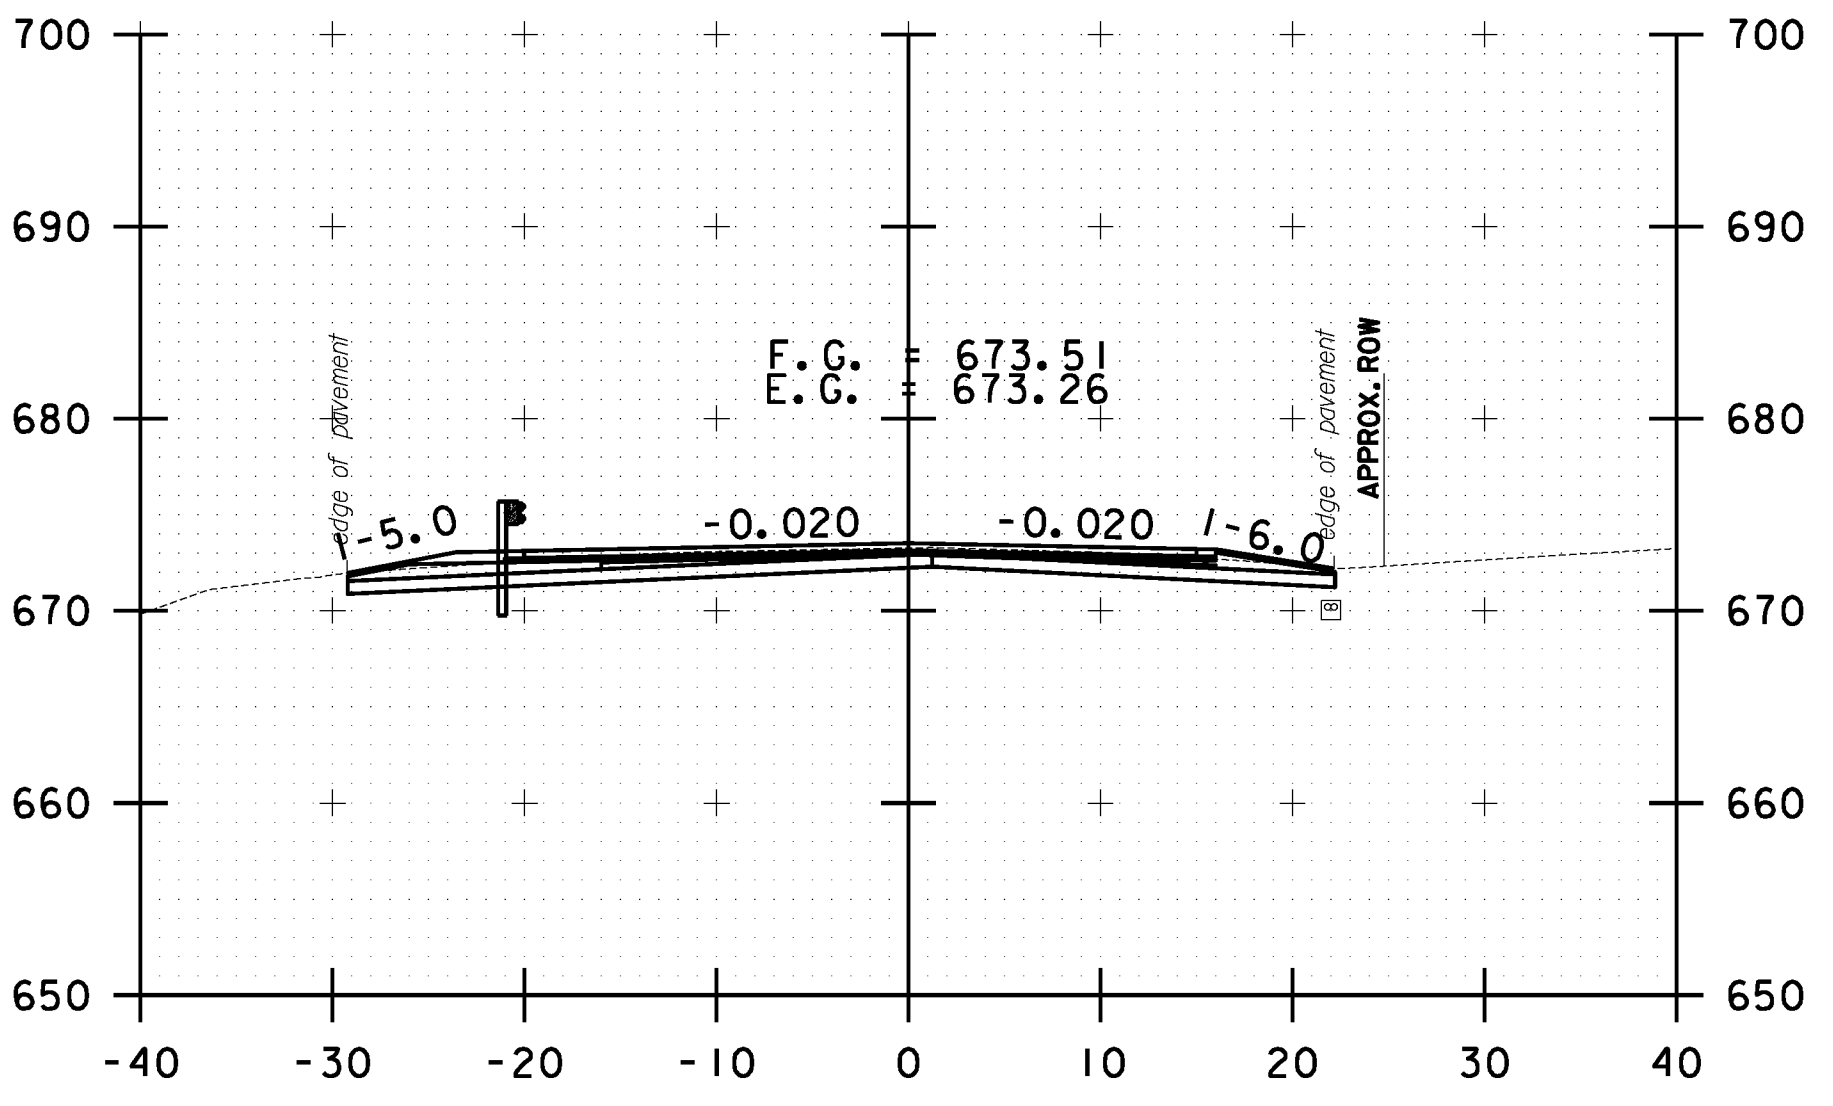

233+00.00

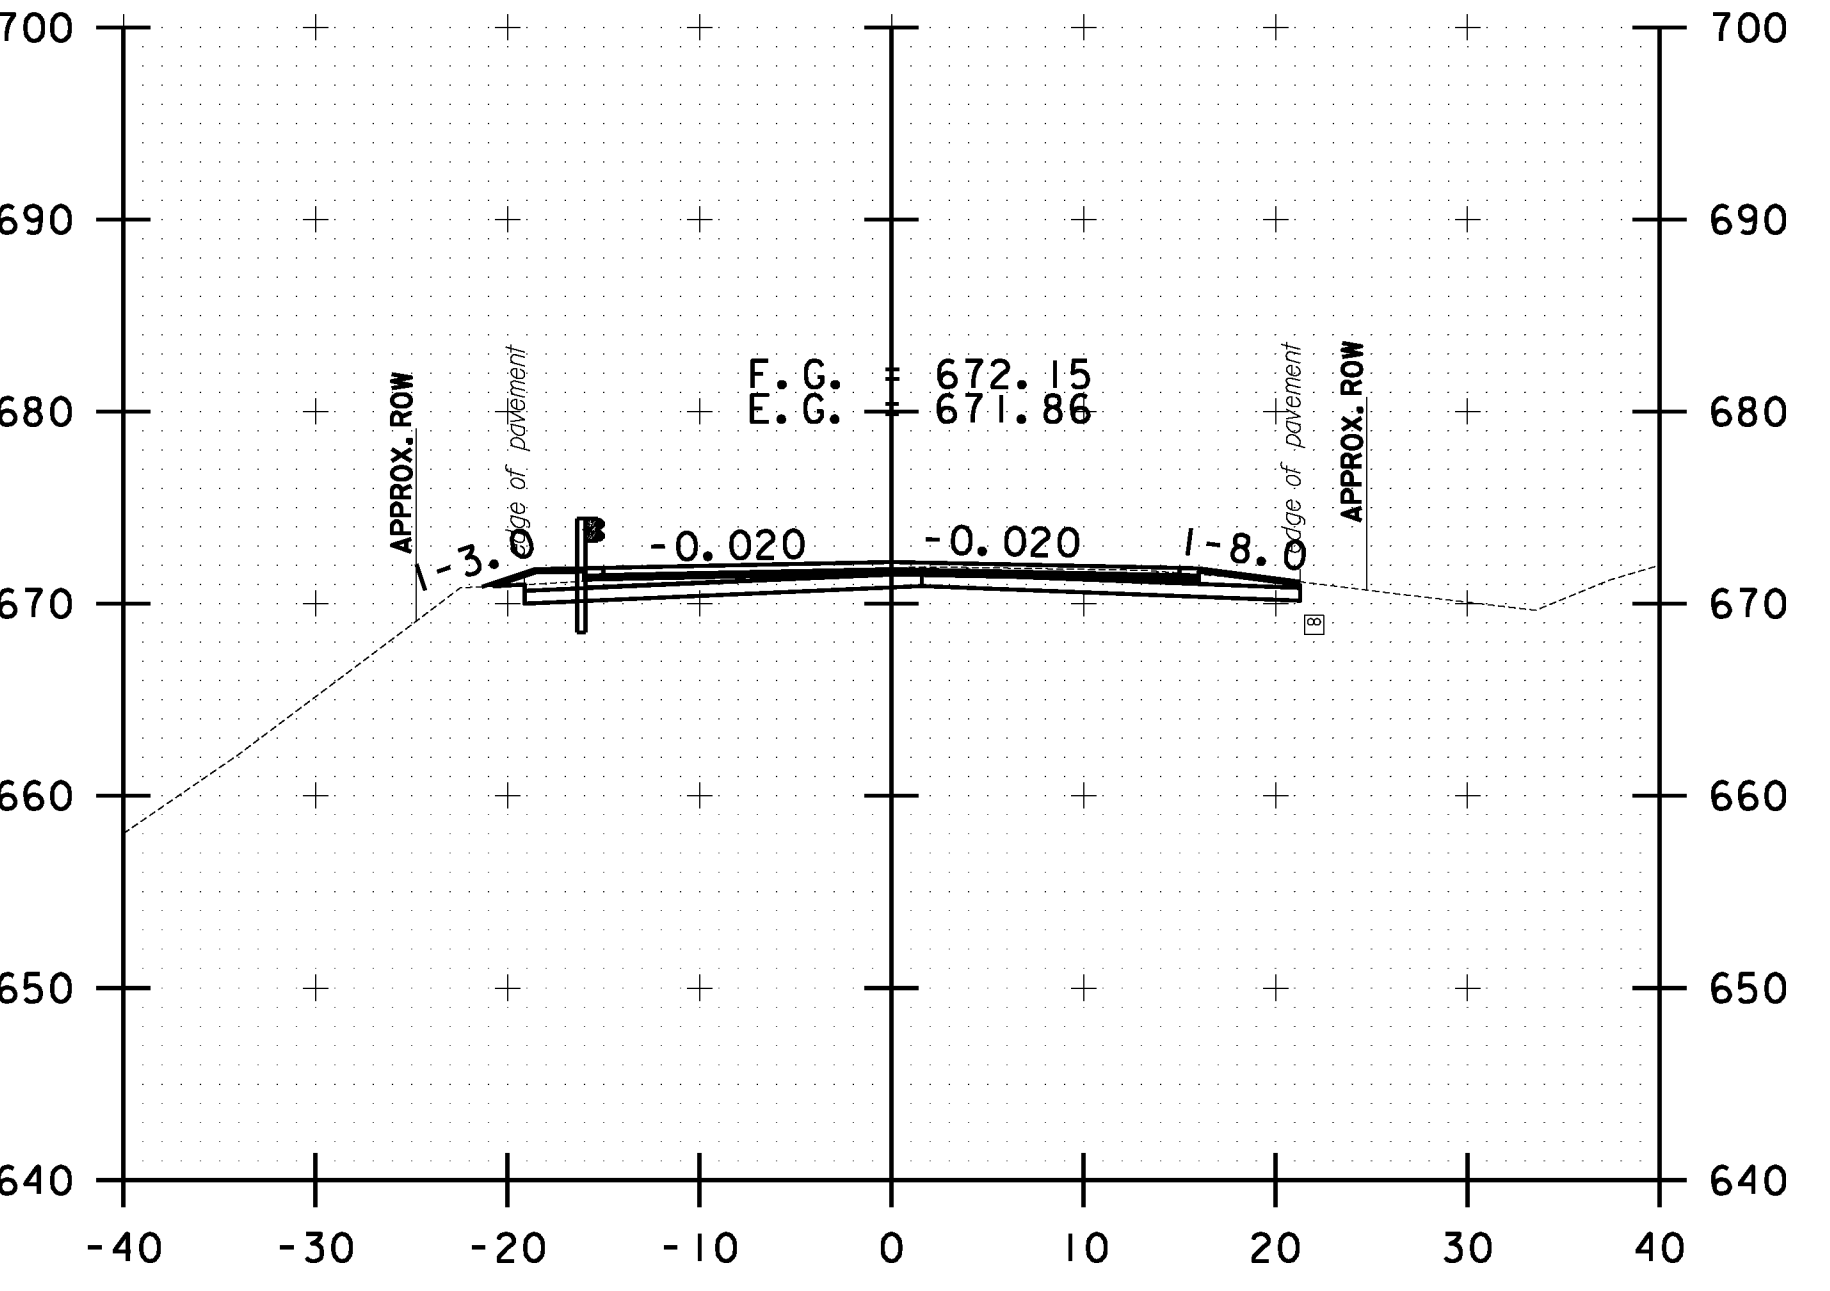

234+00.00

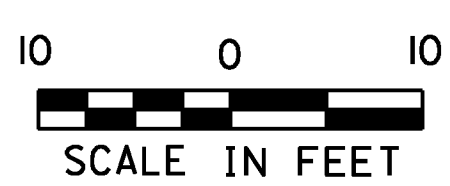

**STOCKBRIDGE
 CROSS SECTION
 SHEET #73**

PROJECT NAME: STOCKBRIDGE-BETHEL	PLOT DATE: 3/17/2014
PROJECT NUMBER: STP 2910(1)	DRAWN BY: W.G.P.
FILE NAME: z10b214.stock_xc.dgn	CHECKED BY: J.P.S.
DESIGNED BY: L.M.B.	SHEET 286 OF 397
IPARM FILE: z10b214xs73.1	