




FILE NAME = Y:\P\c\projects\ANY\K2\22426\CA001\MSTN\10b214\_stock.nc.dgn  
 DATE/TIME = 3/17/2014  
 USER = 4916

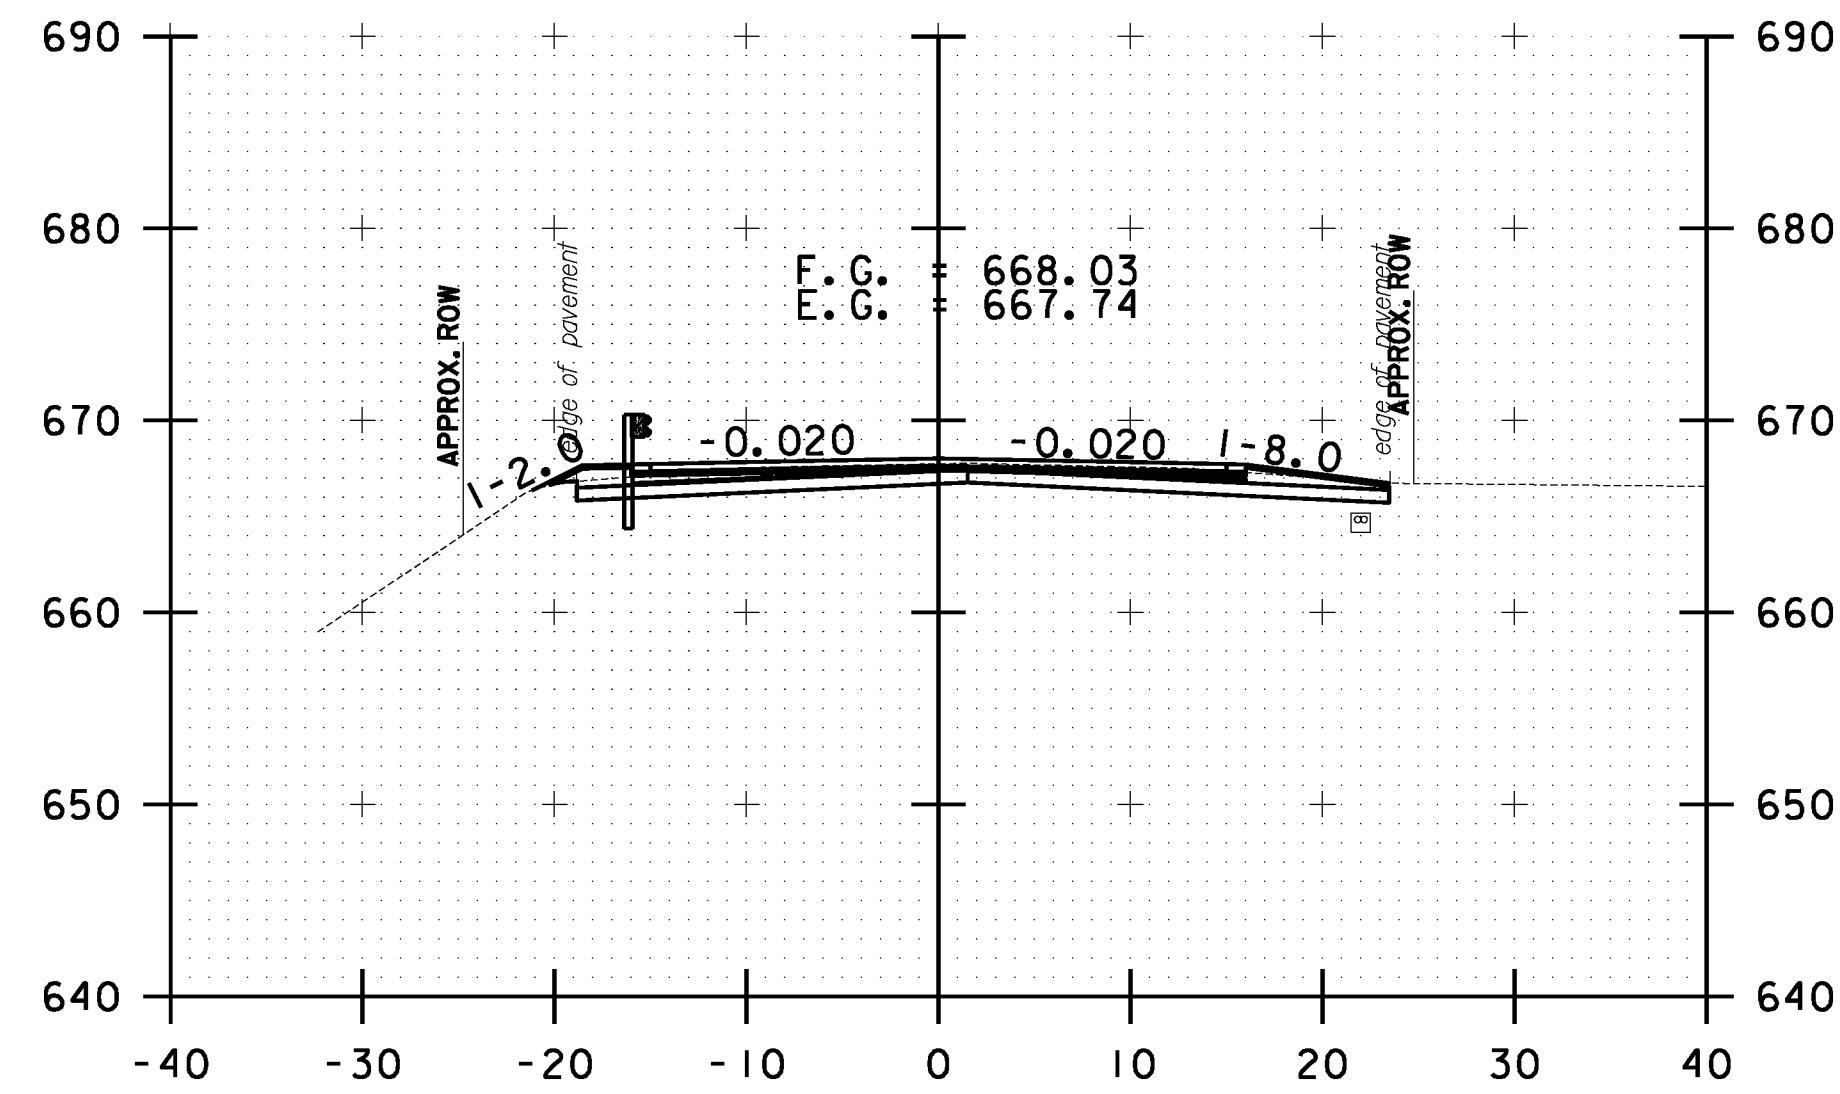


241+50.00

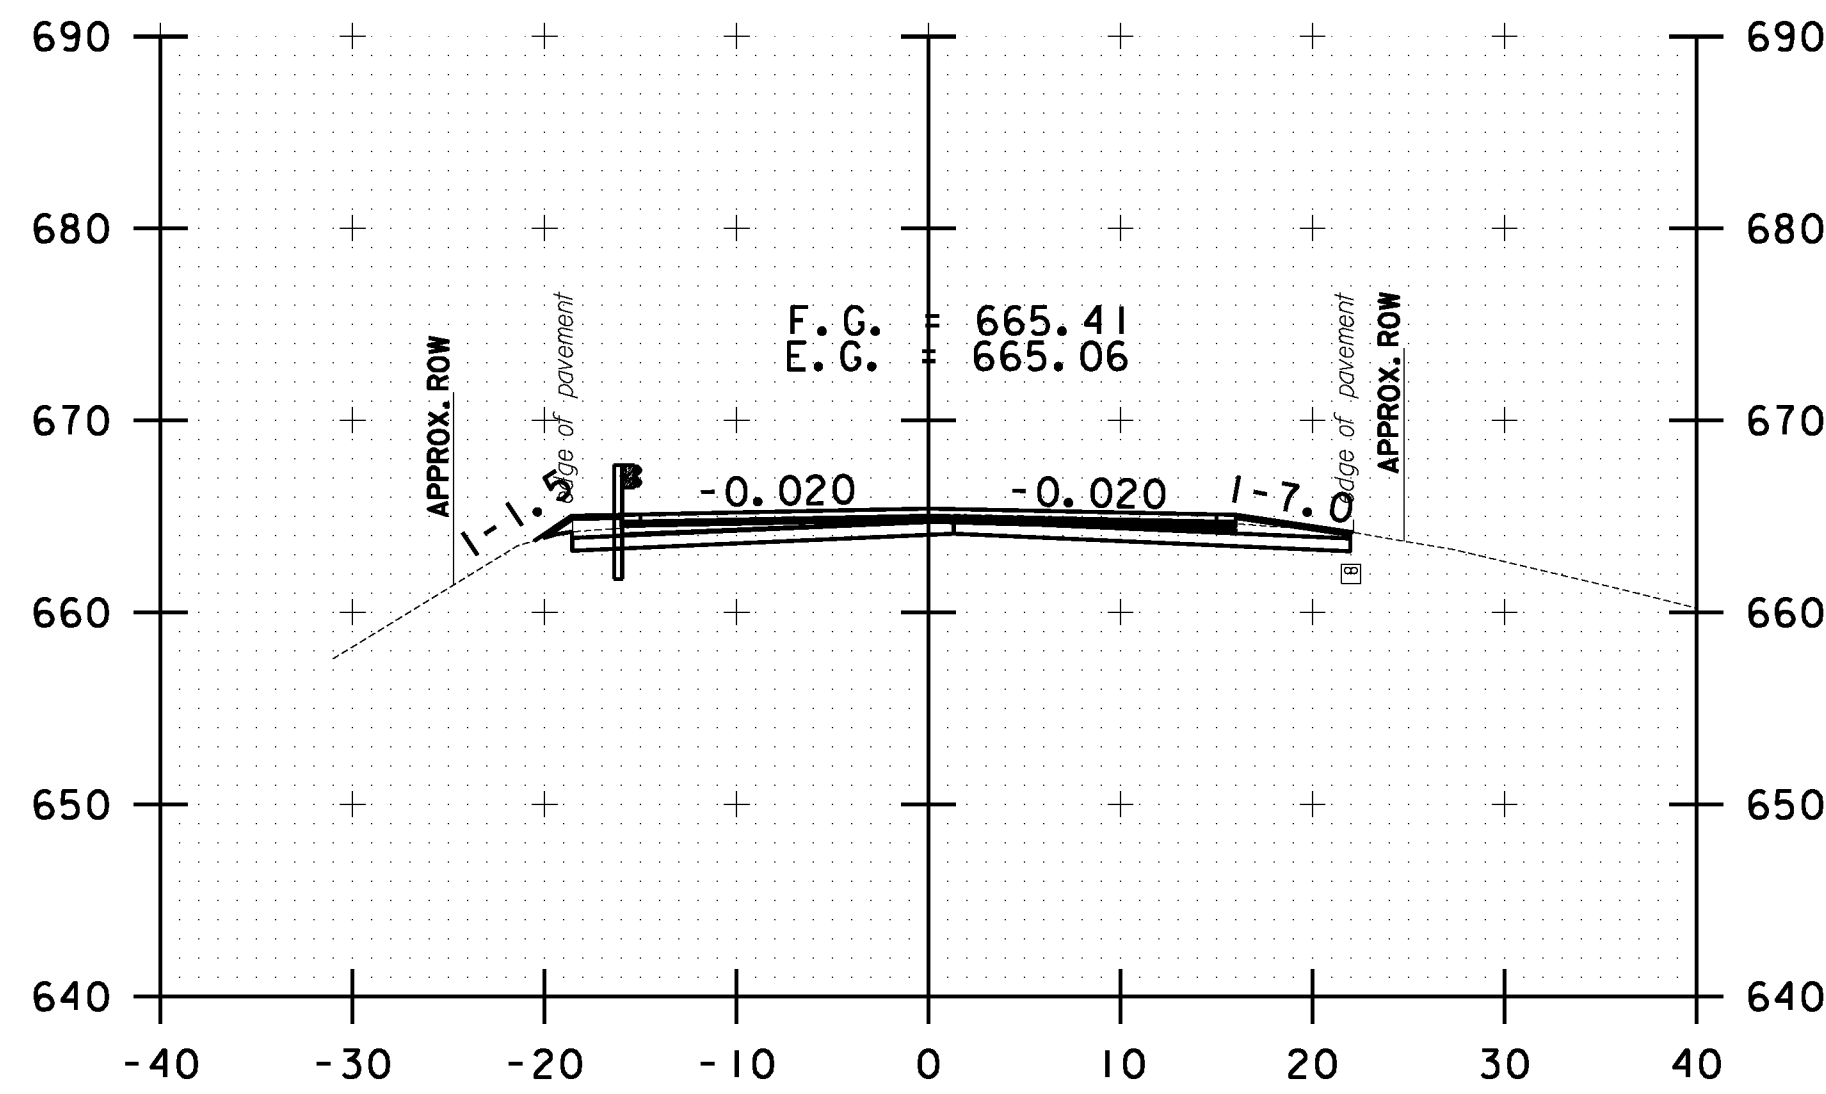


242+50.00

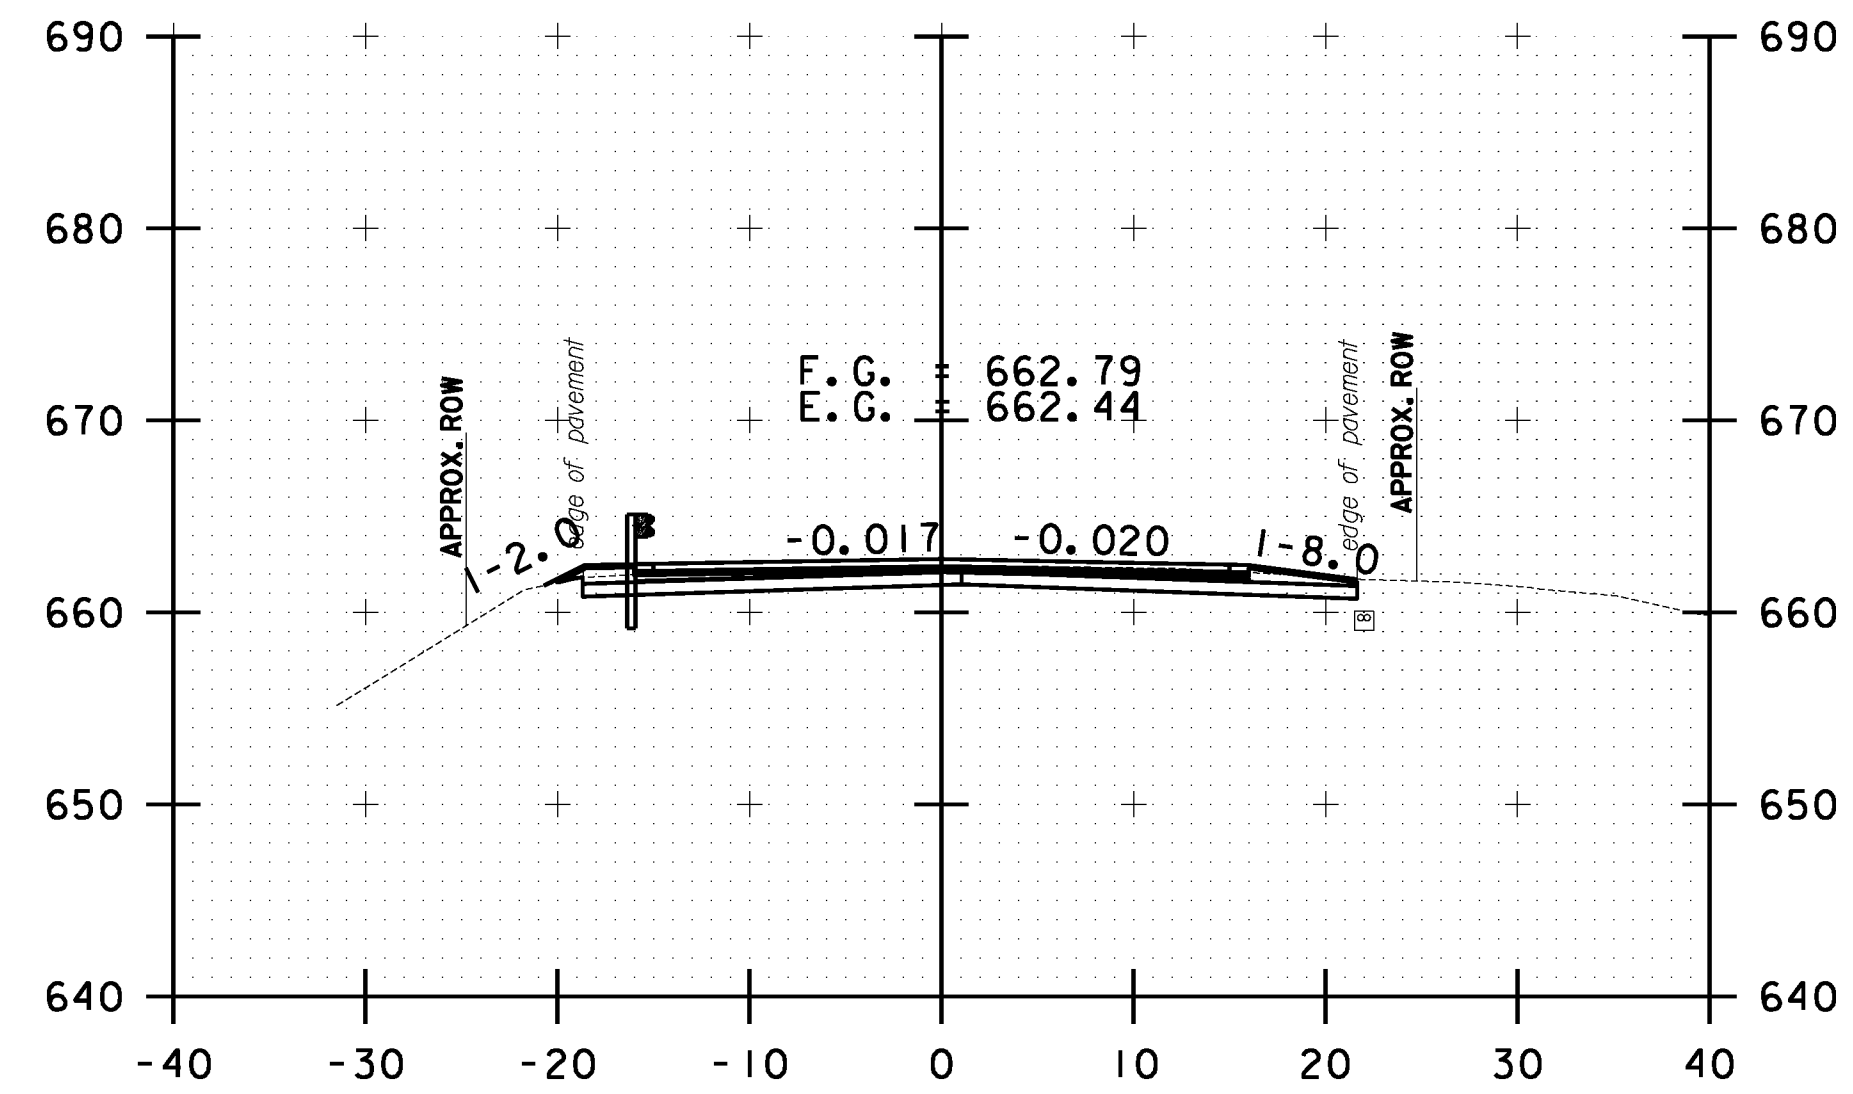


243+50.00

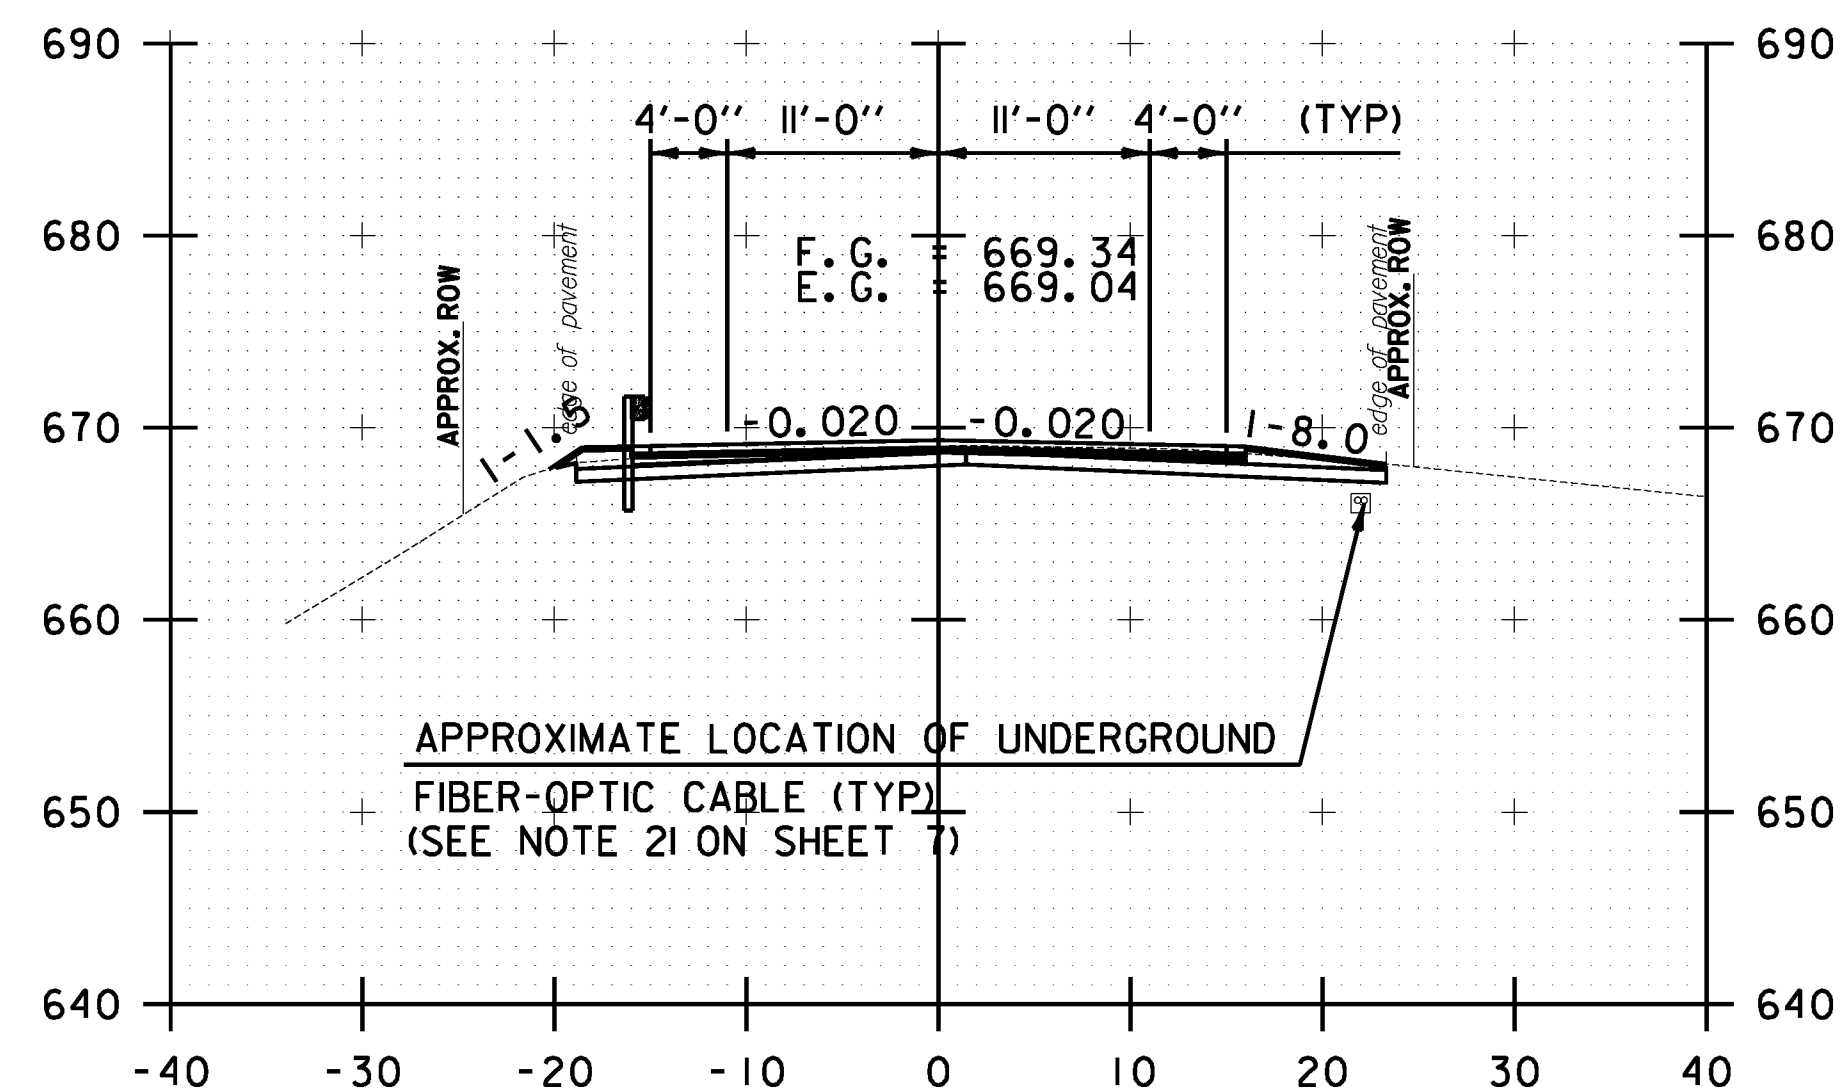


241+00.00

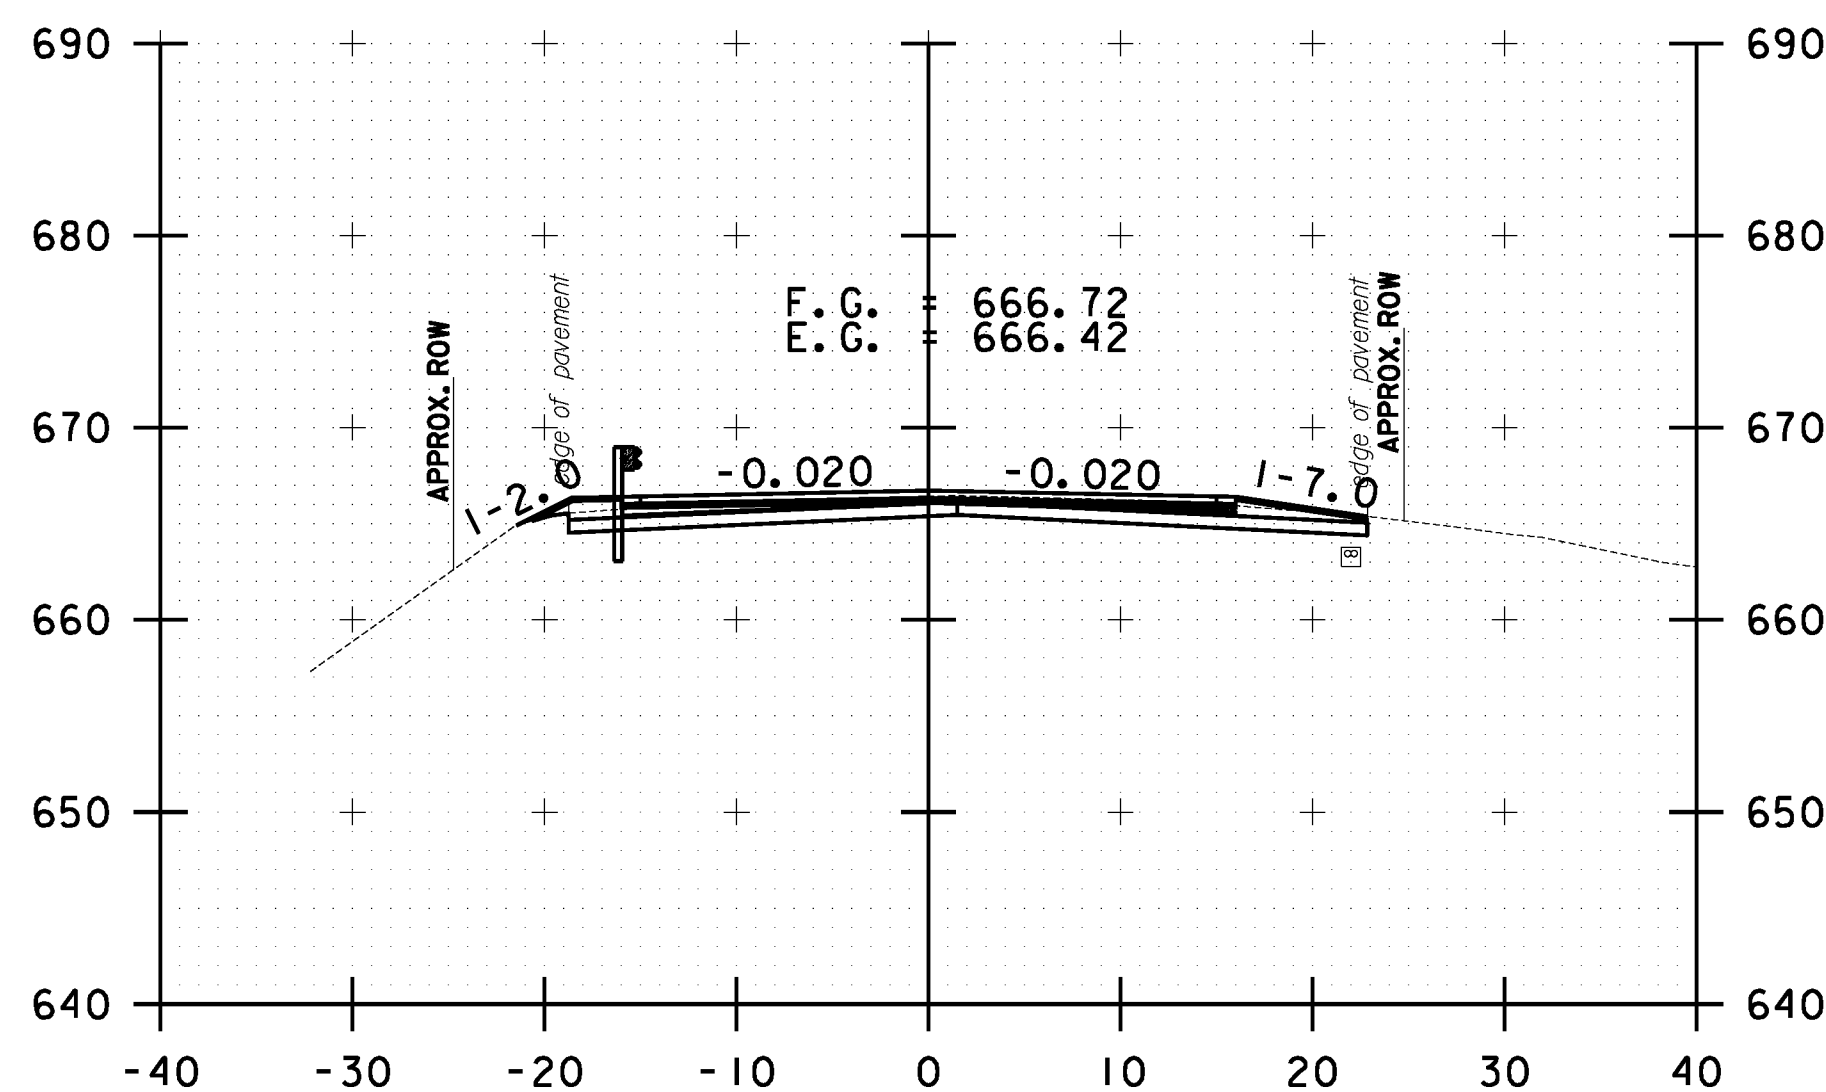

242+00.00

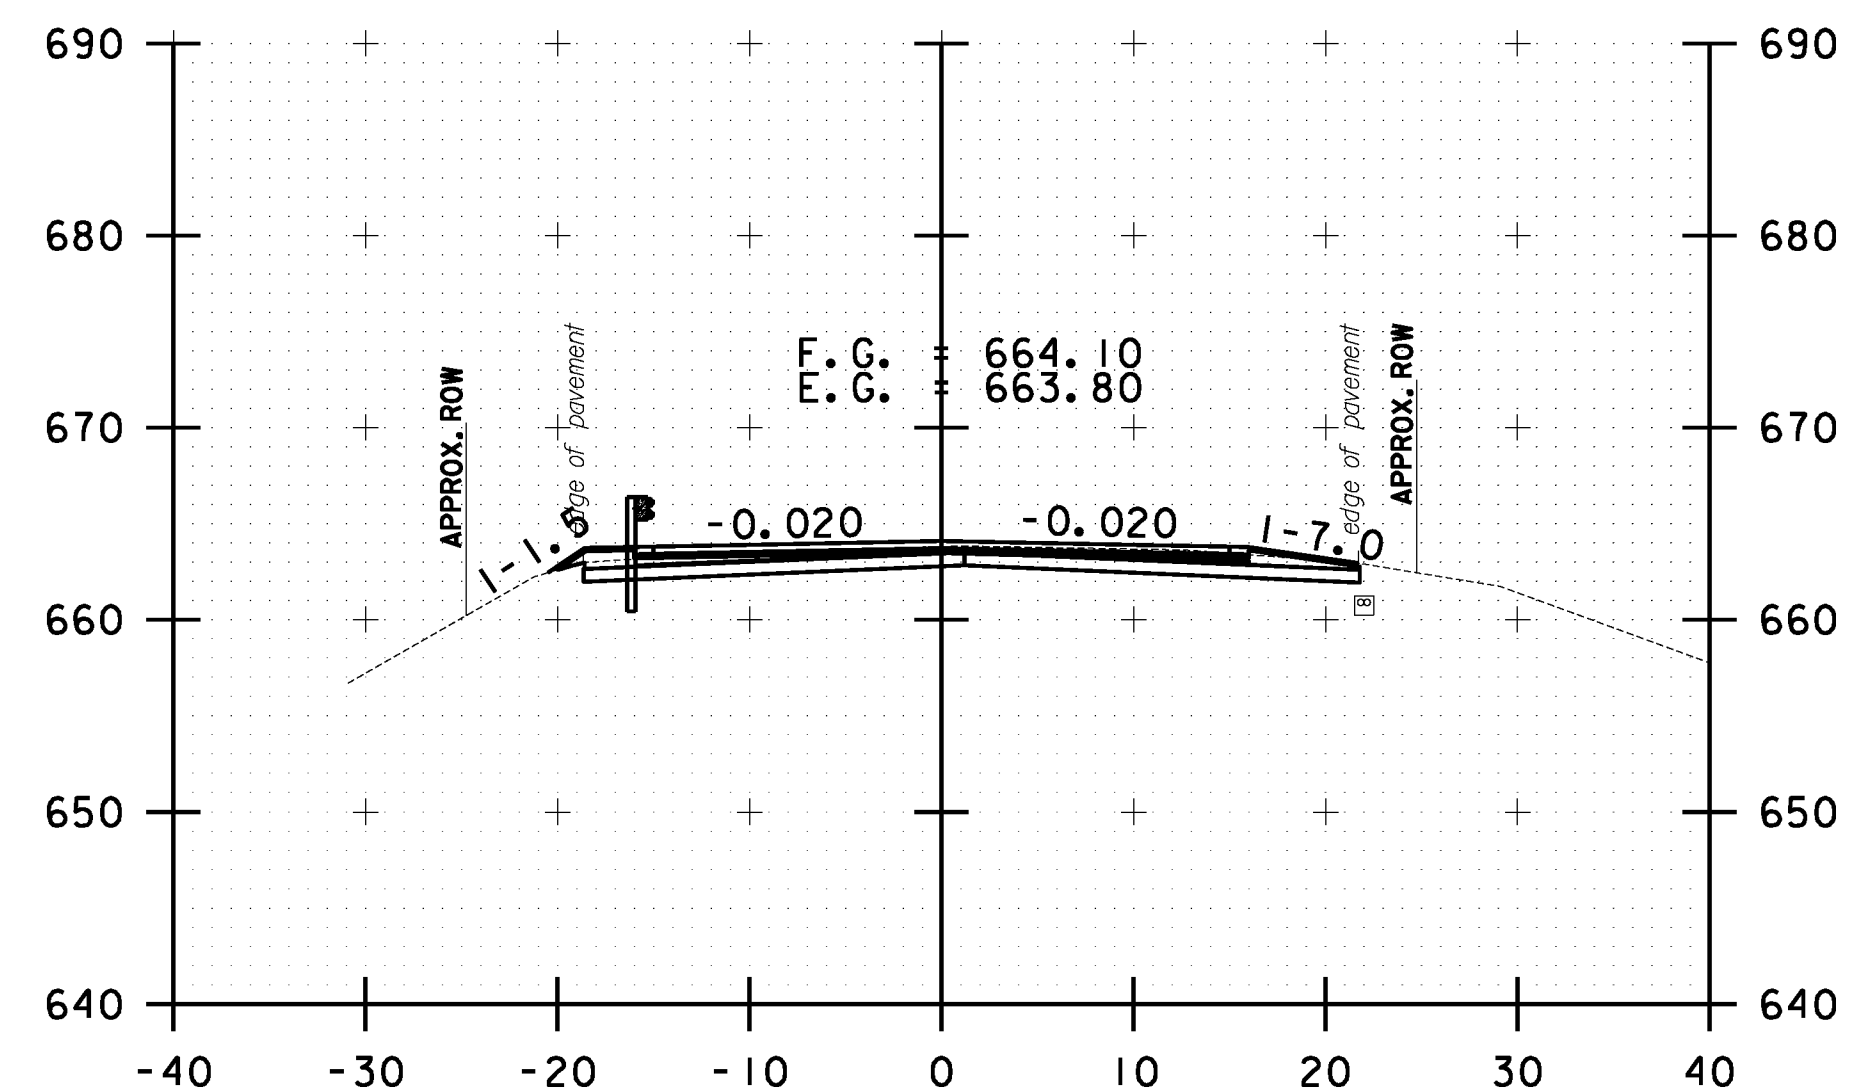

243+00.00

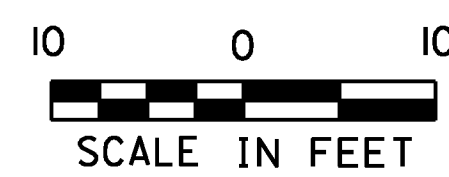

<b>STOCKBRIDGE CROSS SECTION SHEET #76</b>	PROJECT NAME: STOCKBRIDGE-BETHEL
	PROJECT NUMBER: STP 2910(1)
	FILE NAME: z10b214_stock.xc.dgn
	PLOT DATE: 3/17/2014
	DESIGNED BY: L.M.B.
	CHECKED BY: J.P.S.
	IPARM FILE: z10b214xs76.1
	SHEET 289 OF 397