




FILE NAME = Y:\P\c\ass\ANY\X2\22425\CA001\MSTN\10b214_stock.nc.dgn
 DATE/TIME = 3/17/2014
 USER = 4916

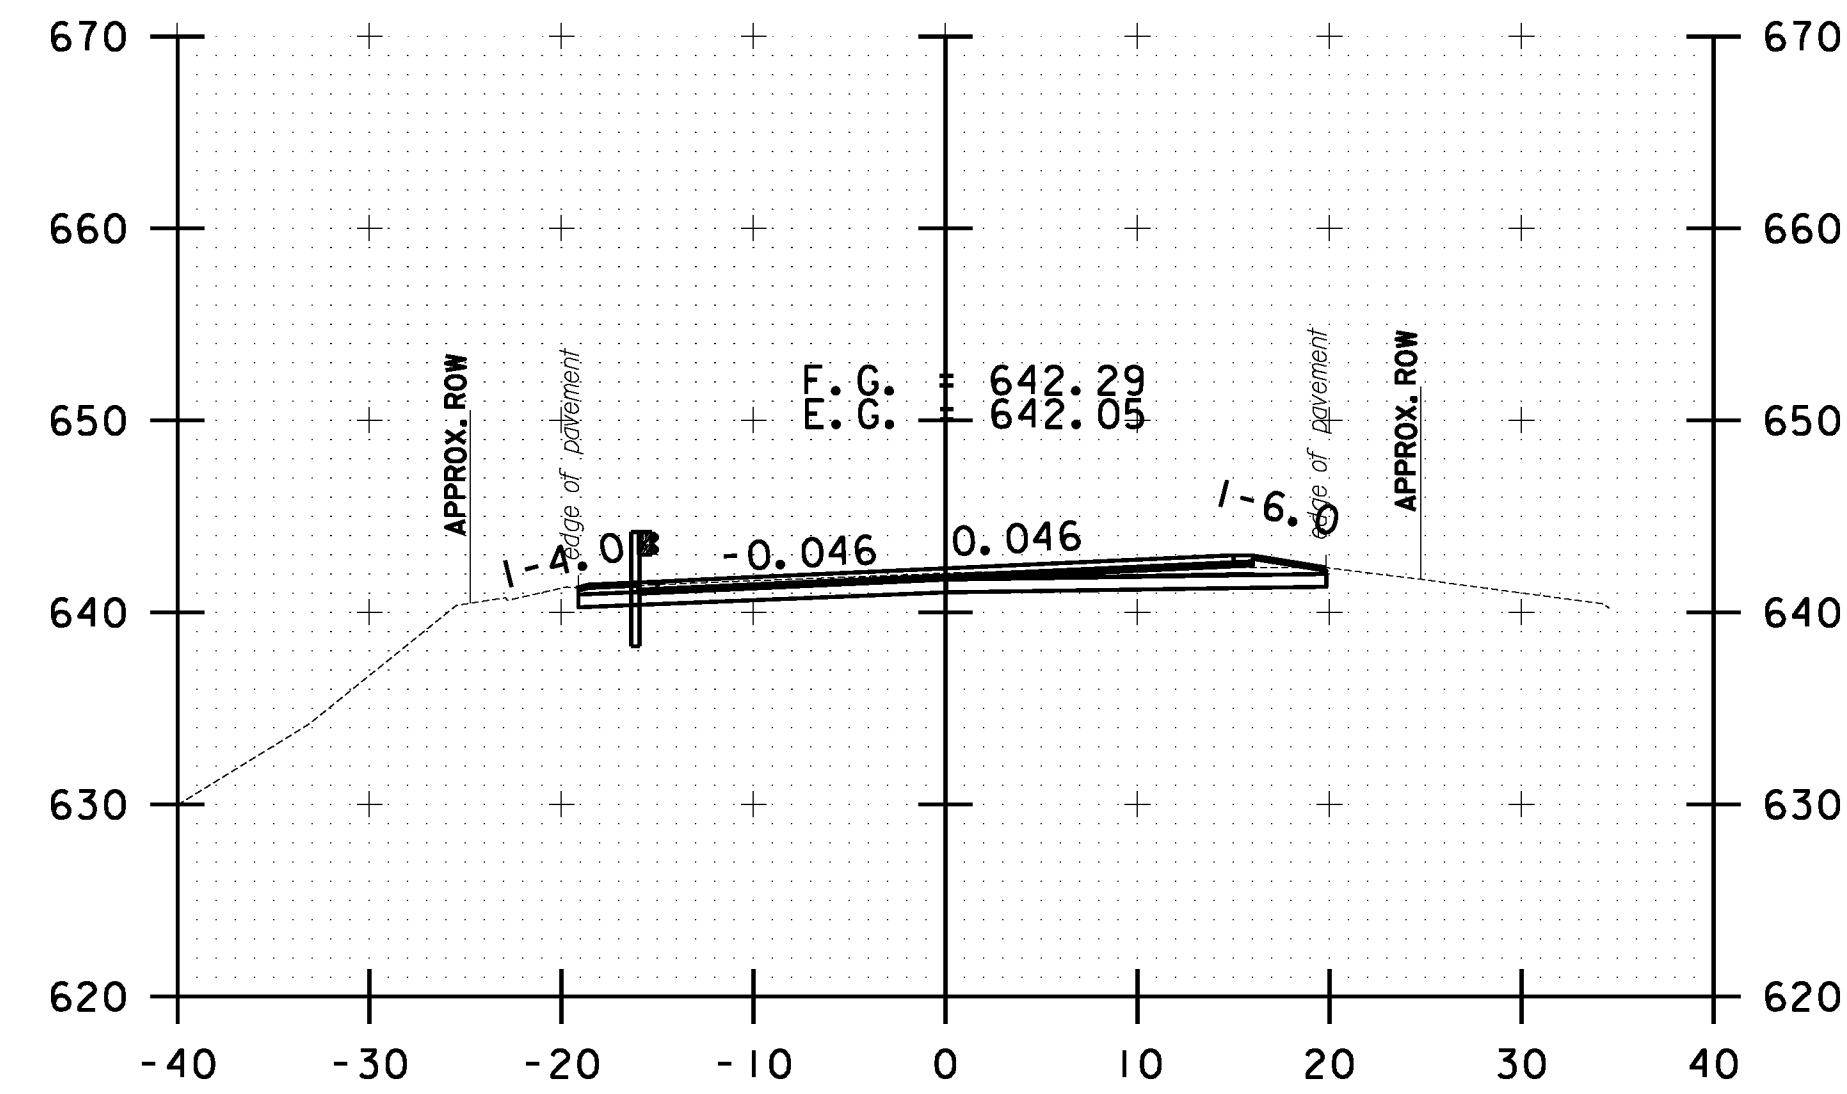


263+50.00

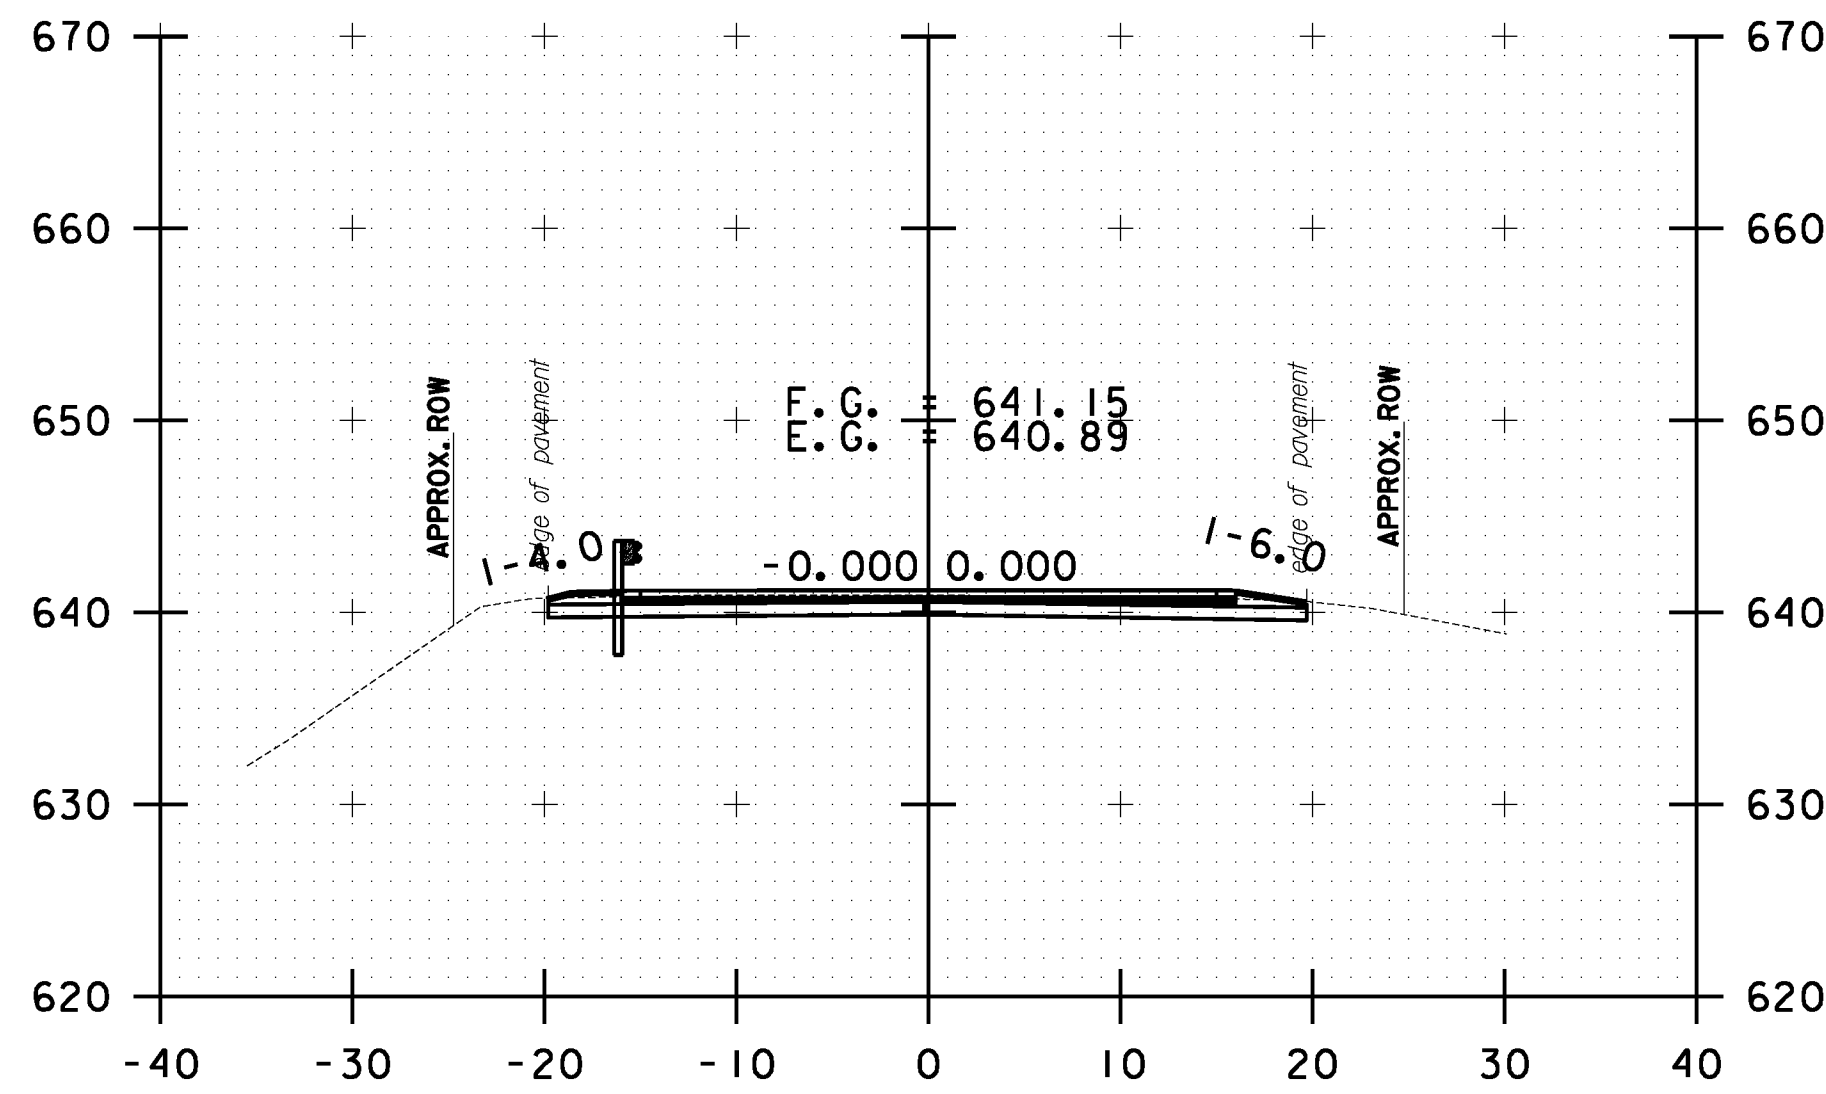


264+50.00

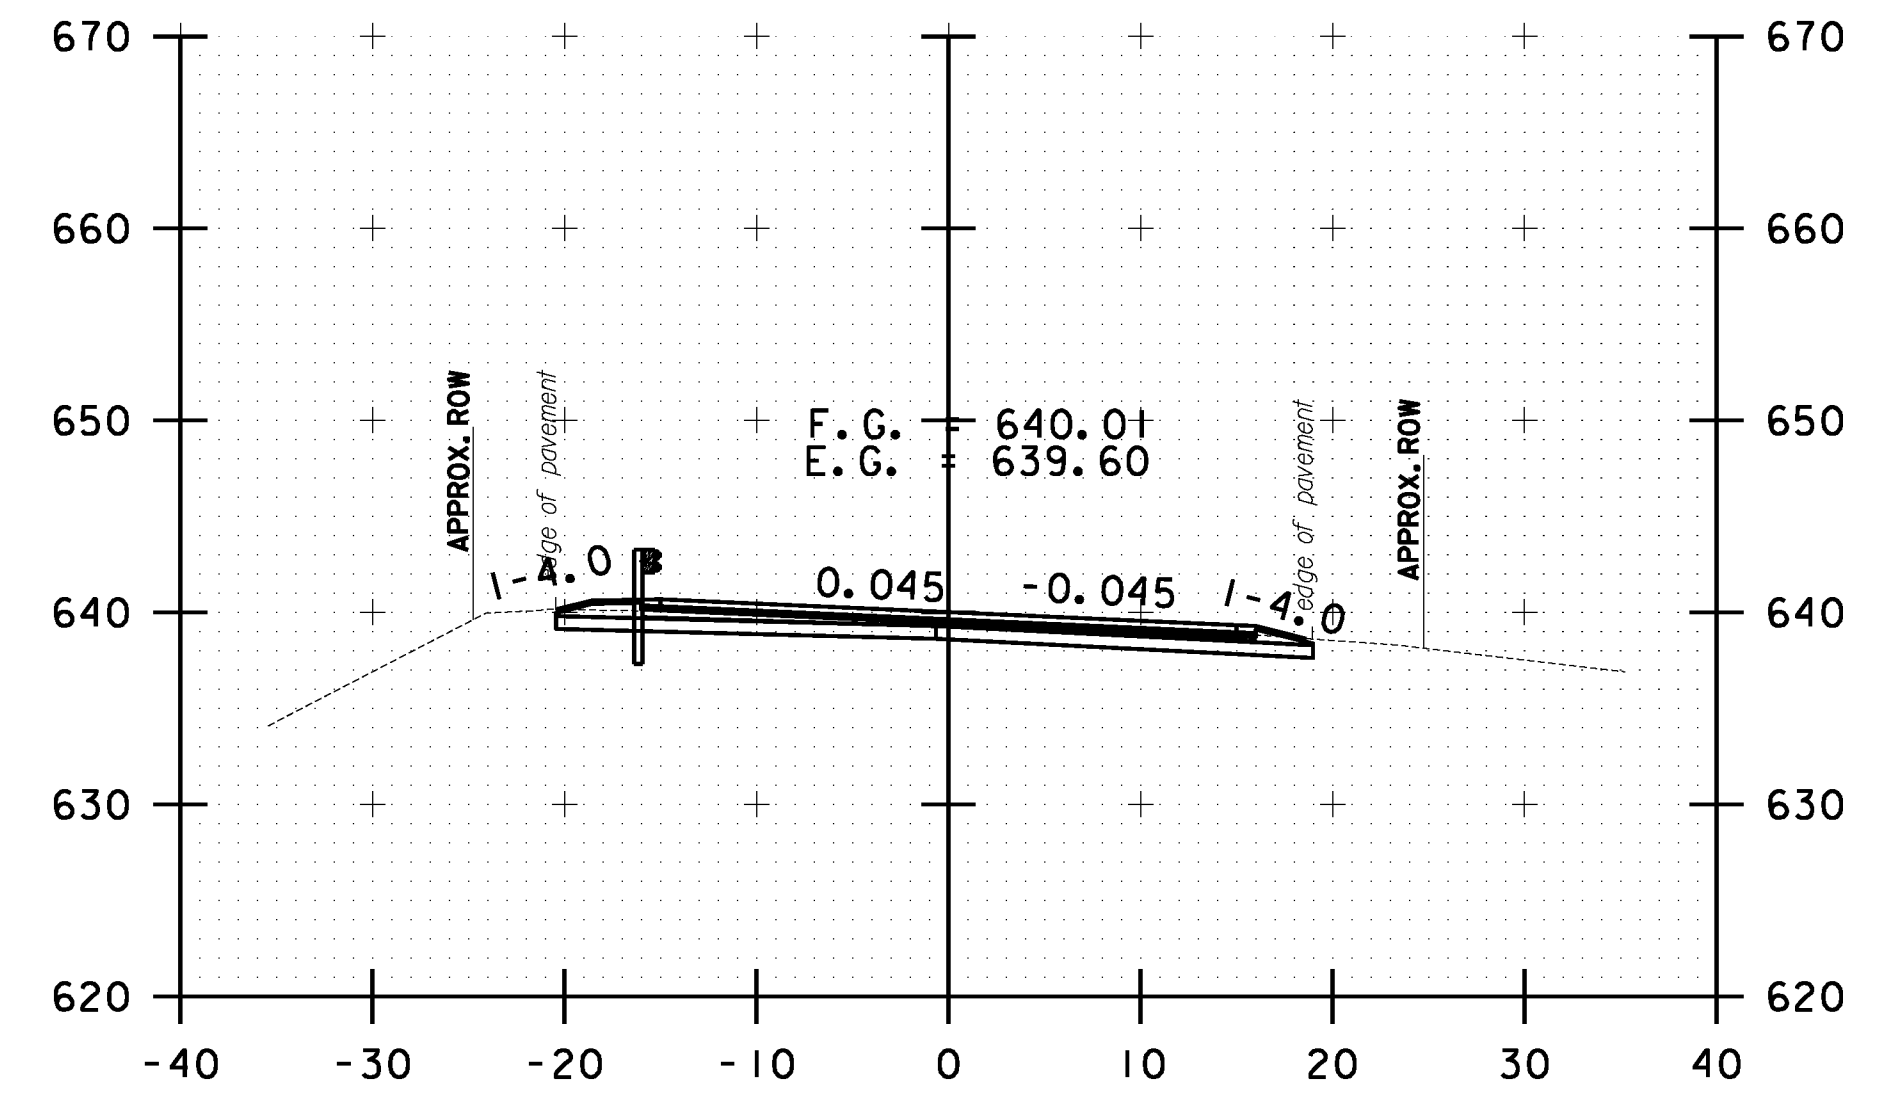


265+50.00

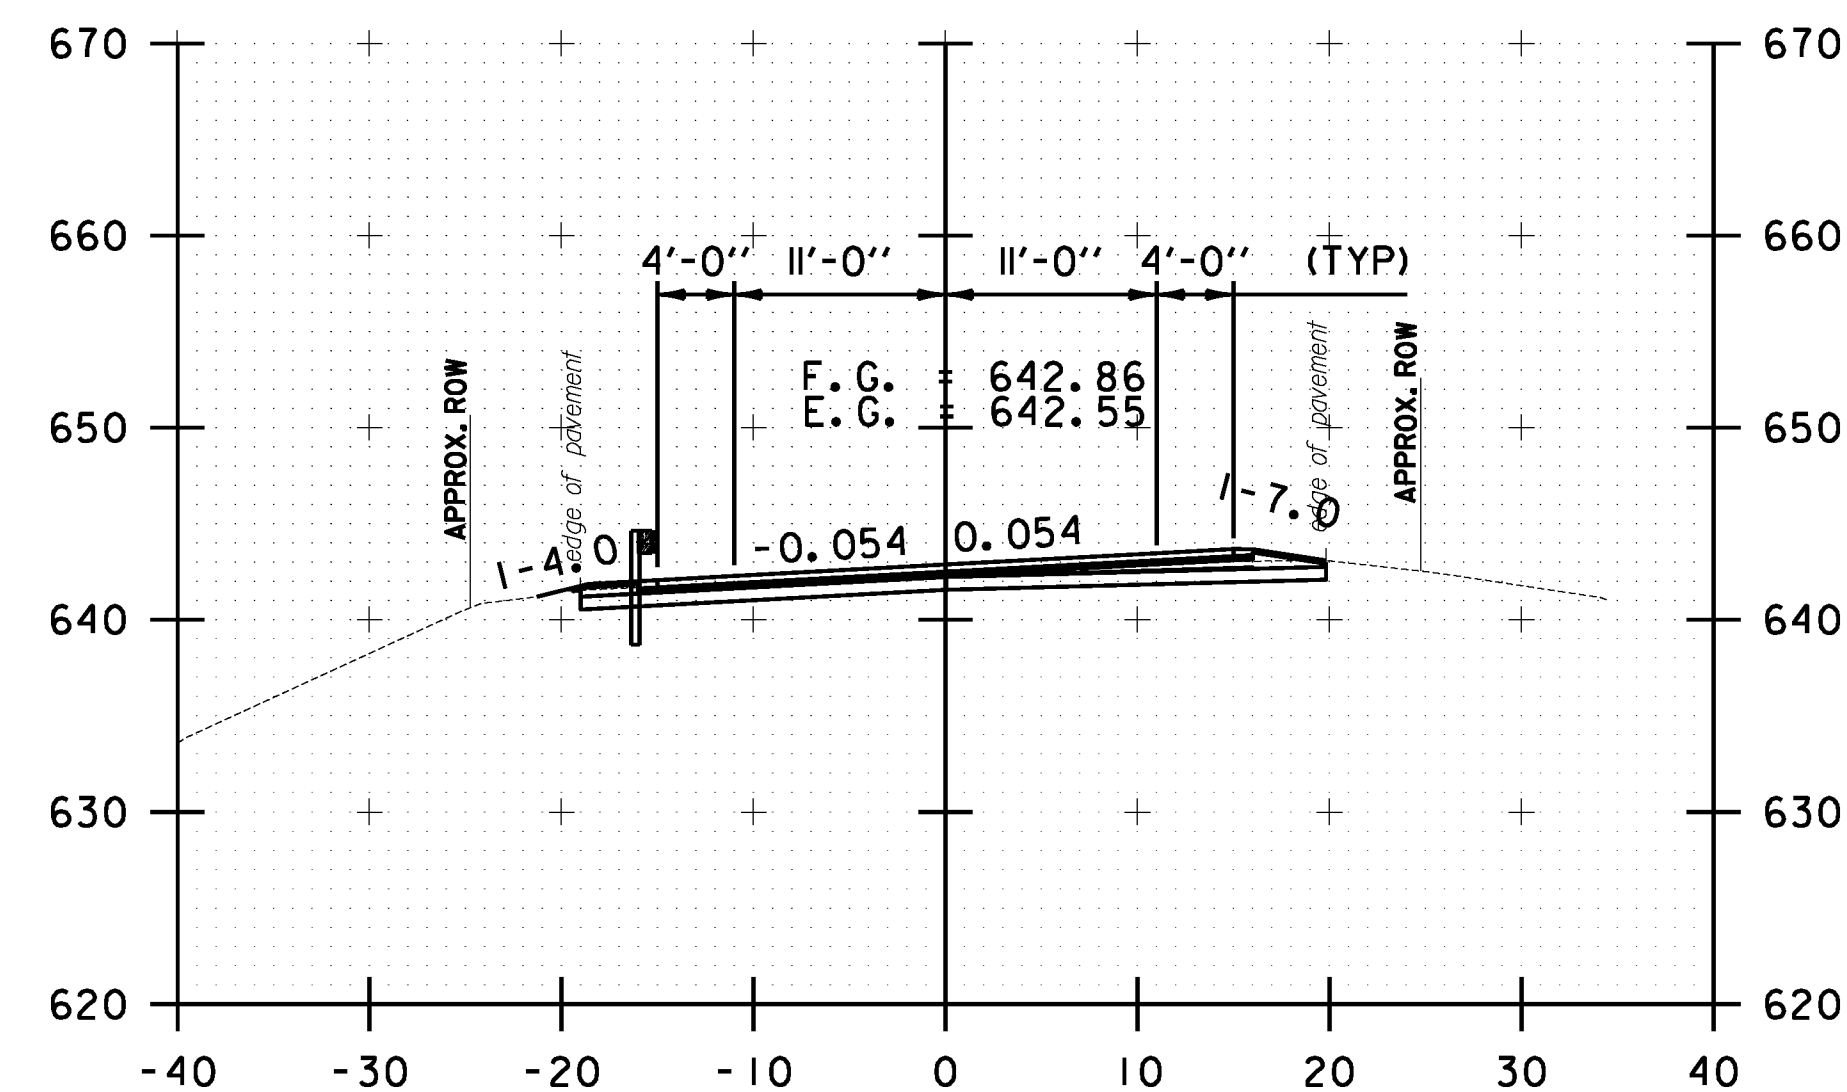


263+00.00

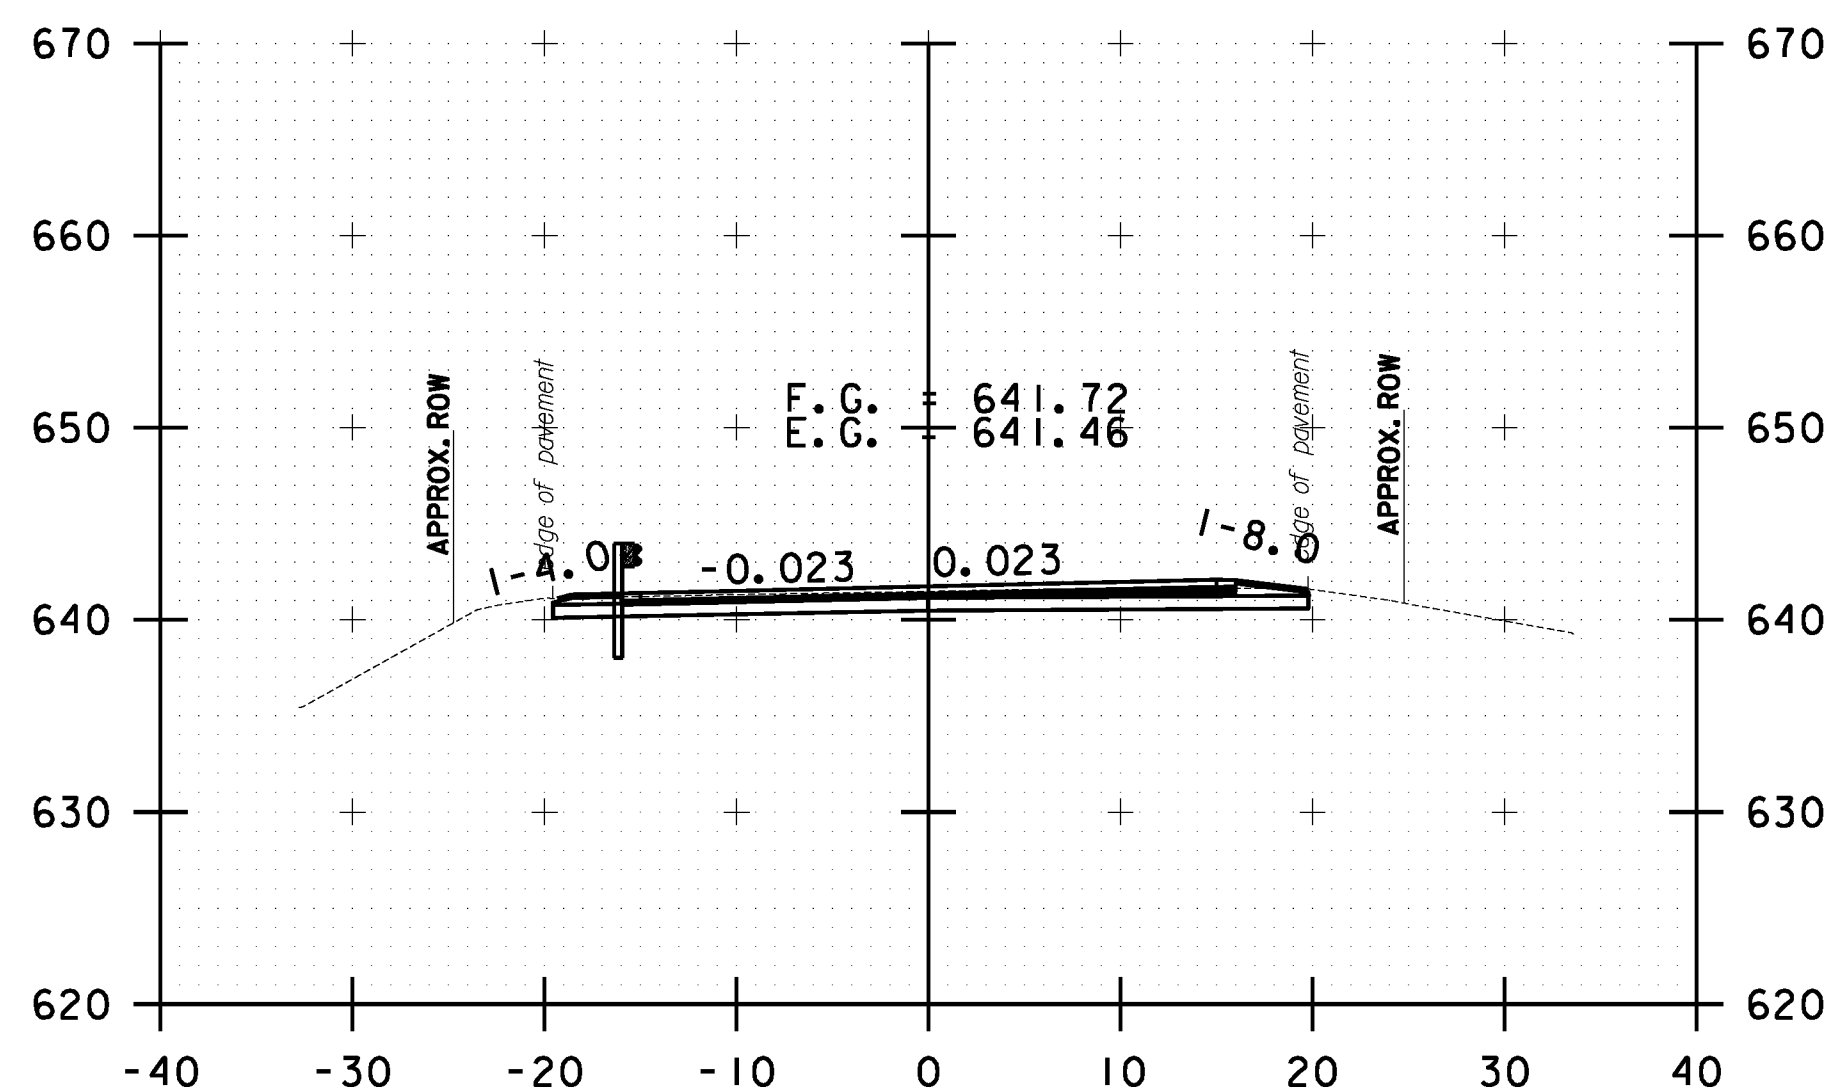

264+00.00

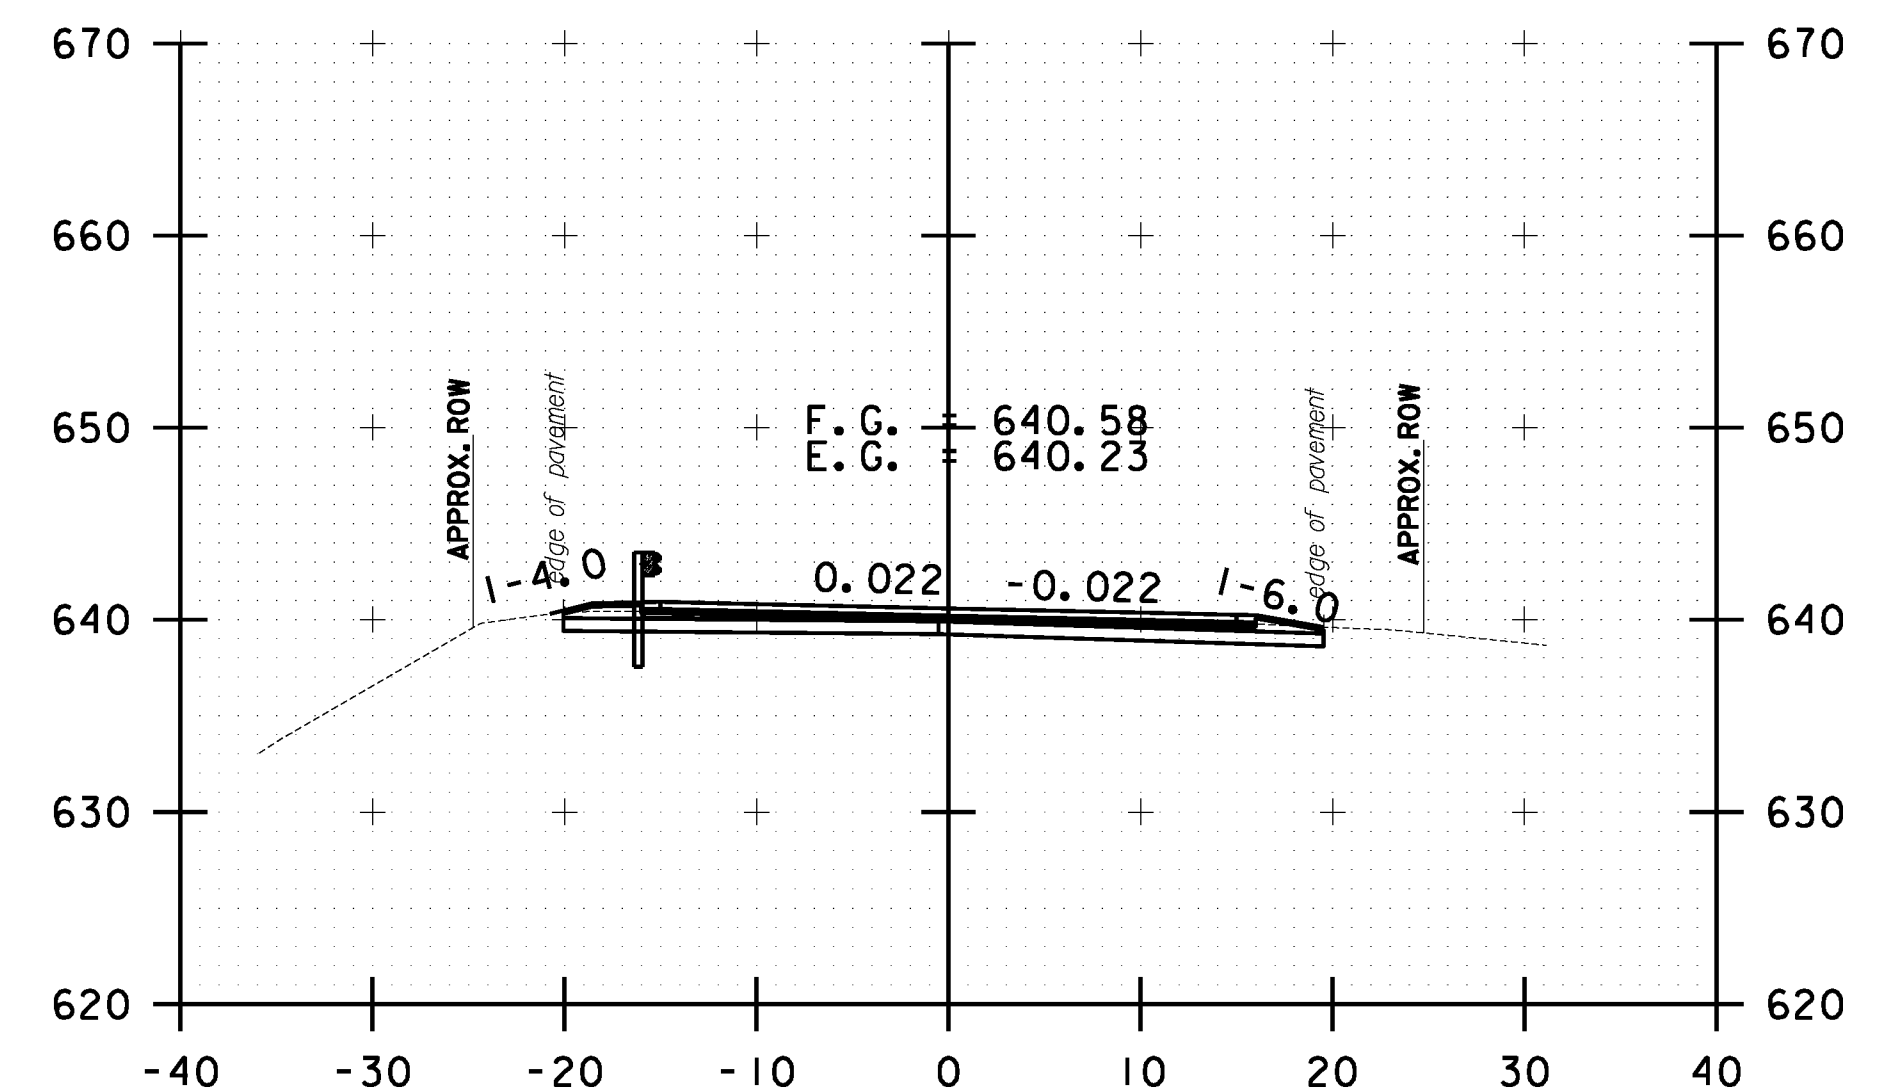

265+00.00

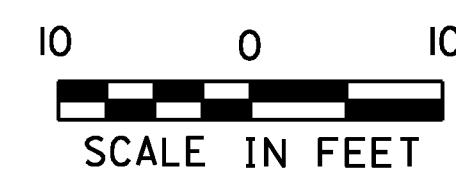

STOCKBRIDGE CROSS SECTION SHEET #83	PROJECT NAME: STOCKBRIDGE-BETHEL
	PROJECT NUMBER: STP 2910(1)
	FILE NAME: z10b214_stock.xc.dgn
	DESIGNED BY: L.M.B.
	PLOT DATE: 3/17/2014
	DRAWN BY: W.G.P.
	CHECKED BY: J.P.S.
	SHEET 296 OF 397