




FILE NAME = V:\P\c\ass\ANY\K2\22425\CADD\MSTN\10b214_stock_xc.dgn
 DATE/TIME = 3/17/2014
 USER = 4916

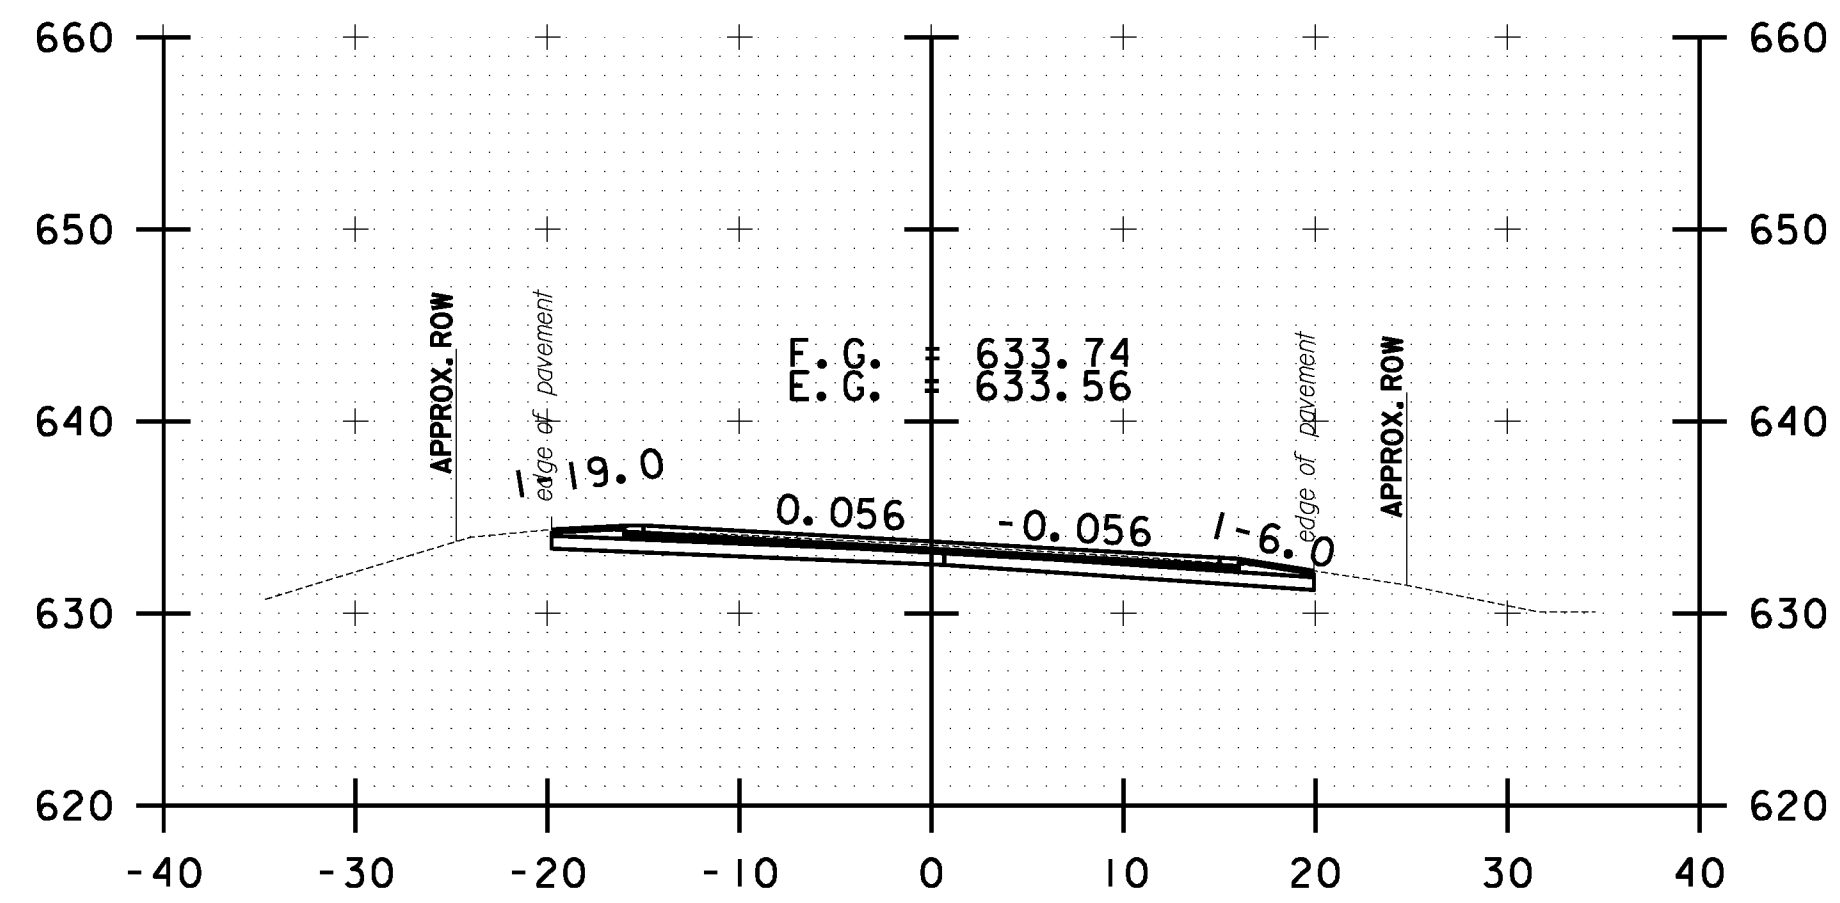


271+00.00

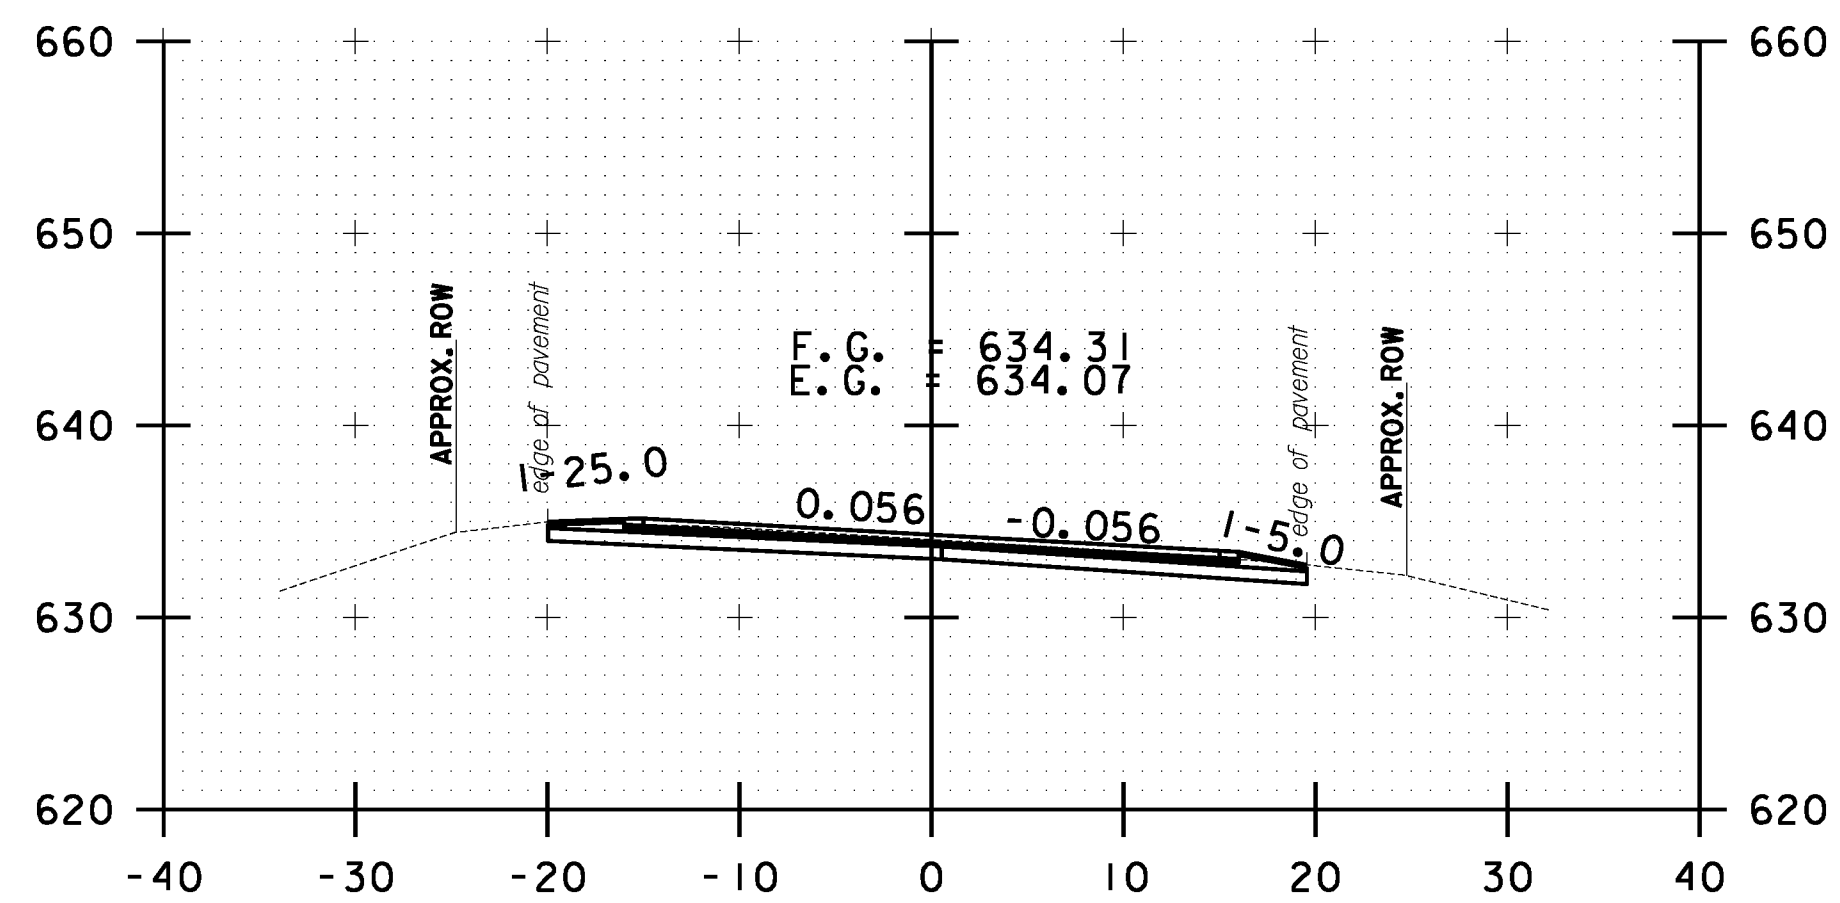


270+50.00

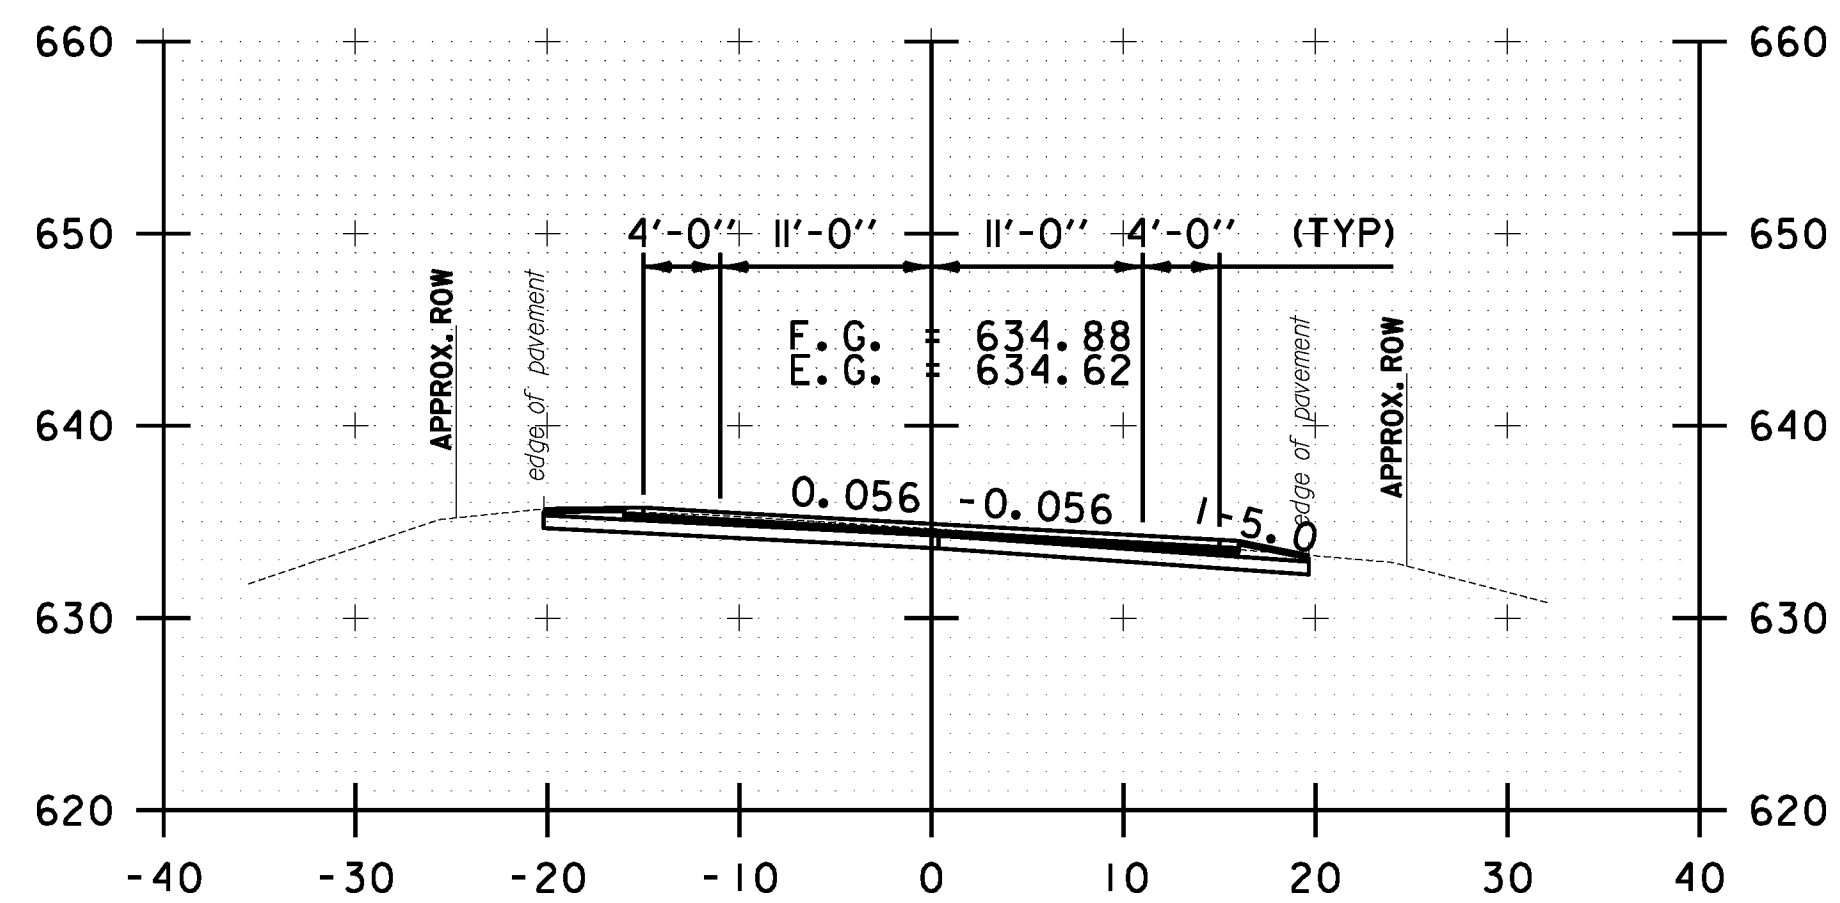


270+00.00

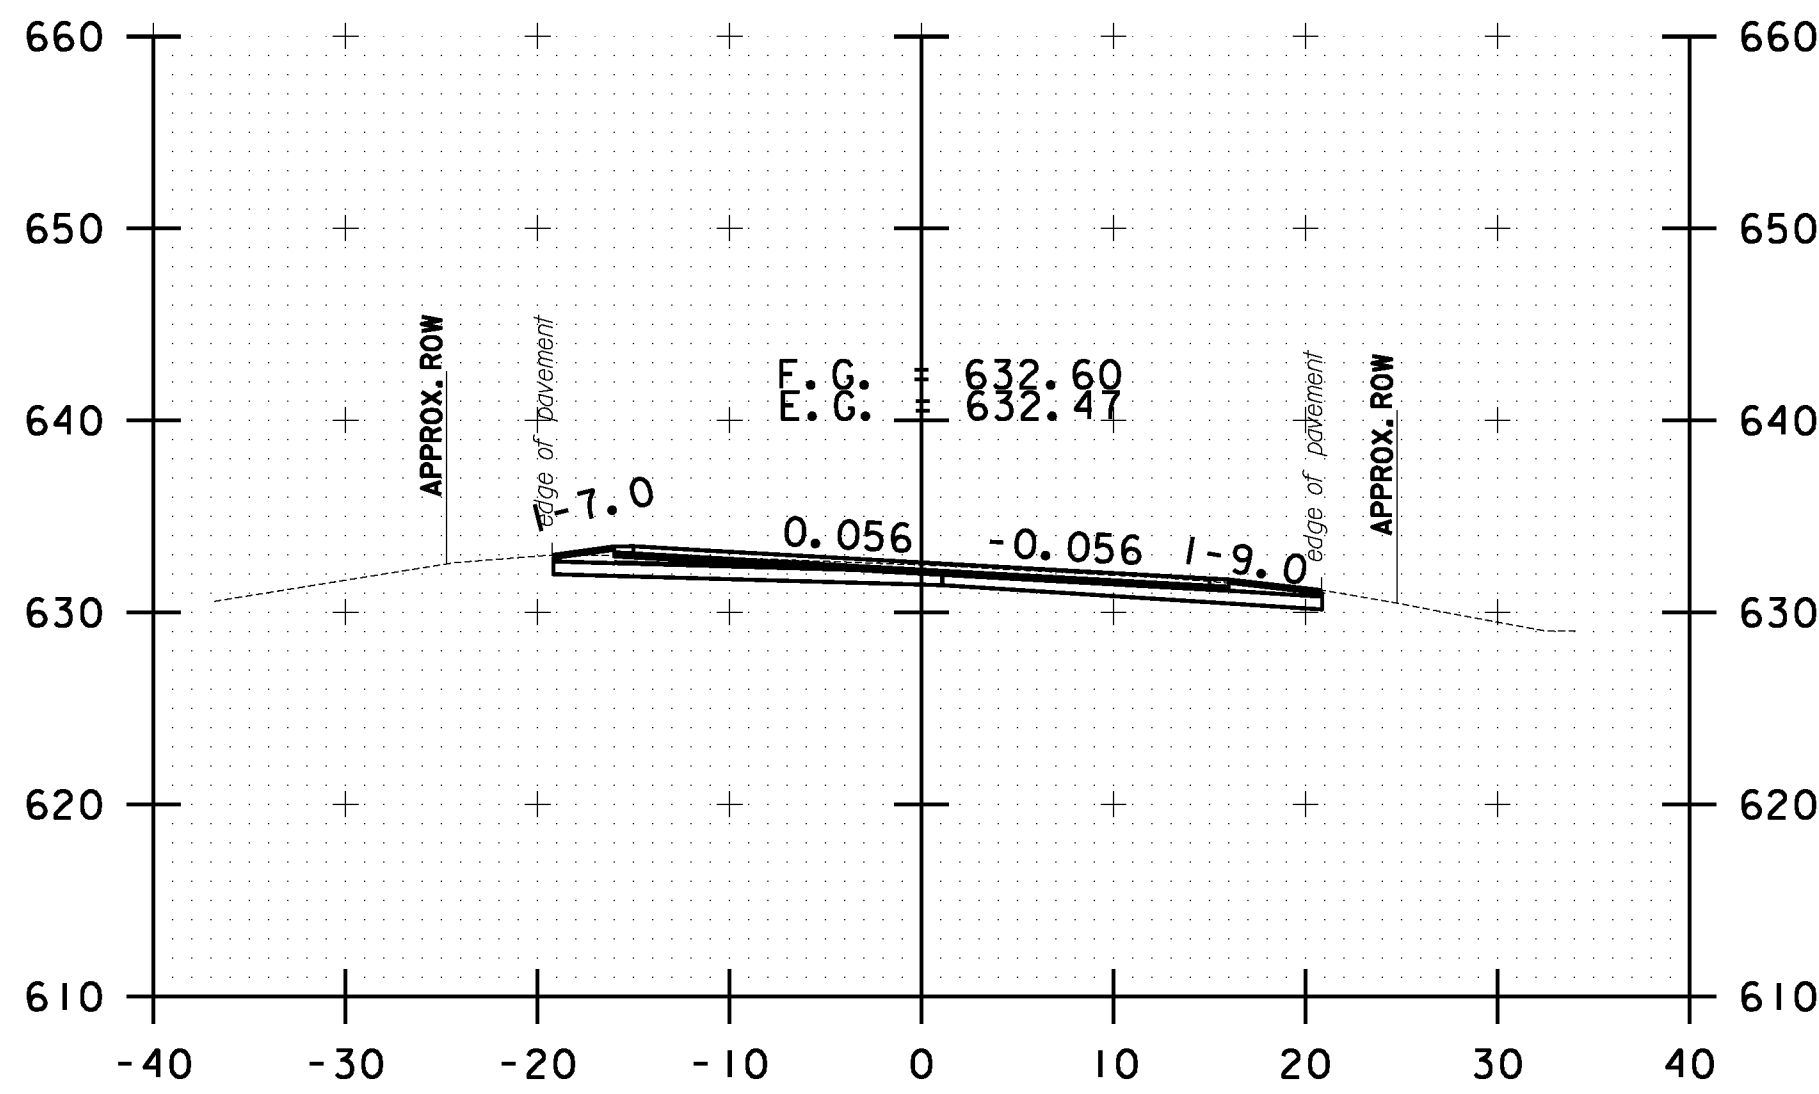


272+00.00

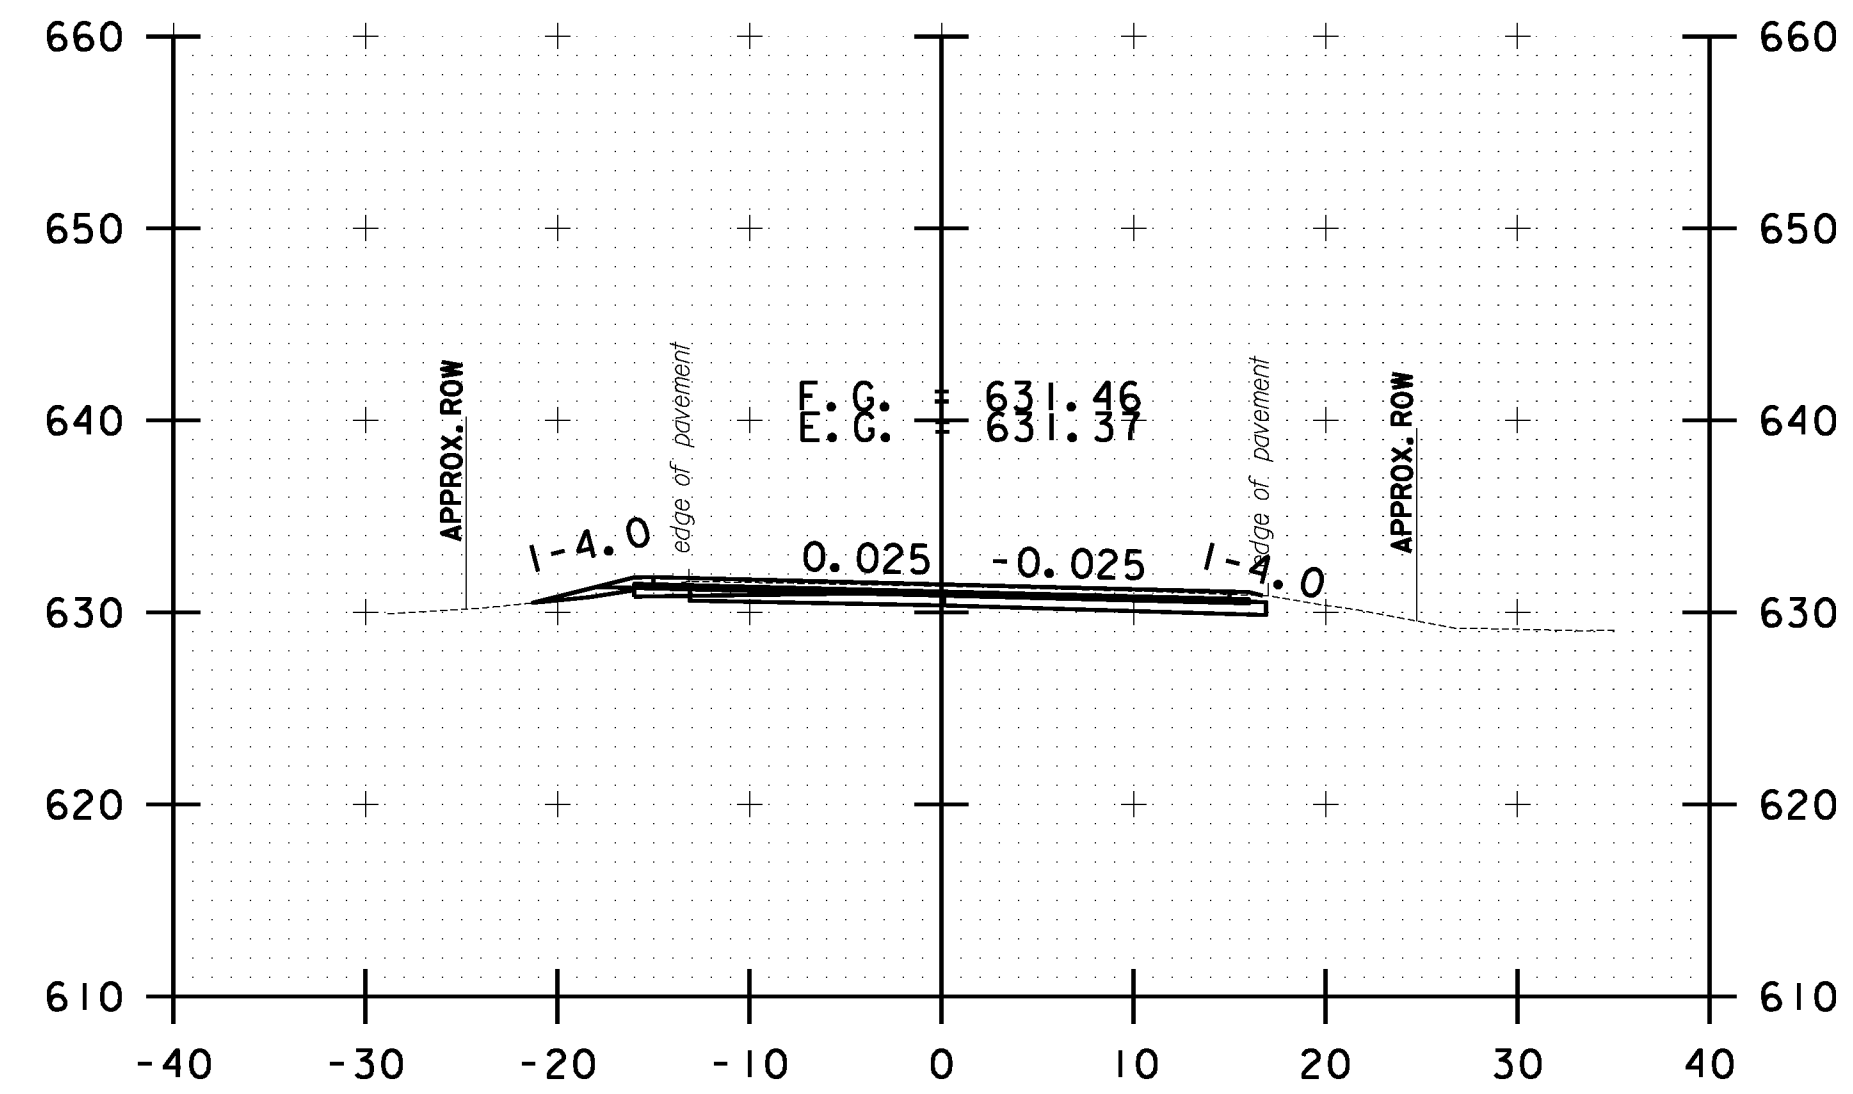


273+00.00

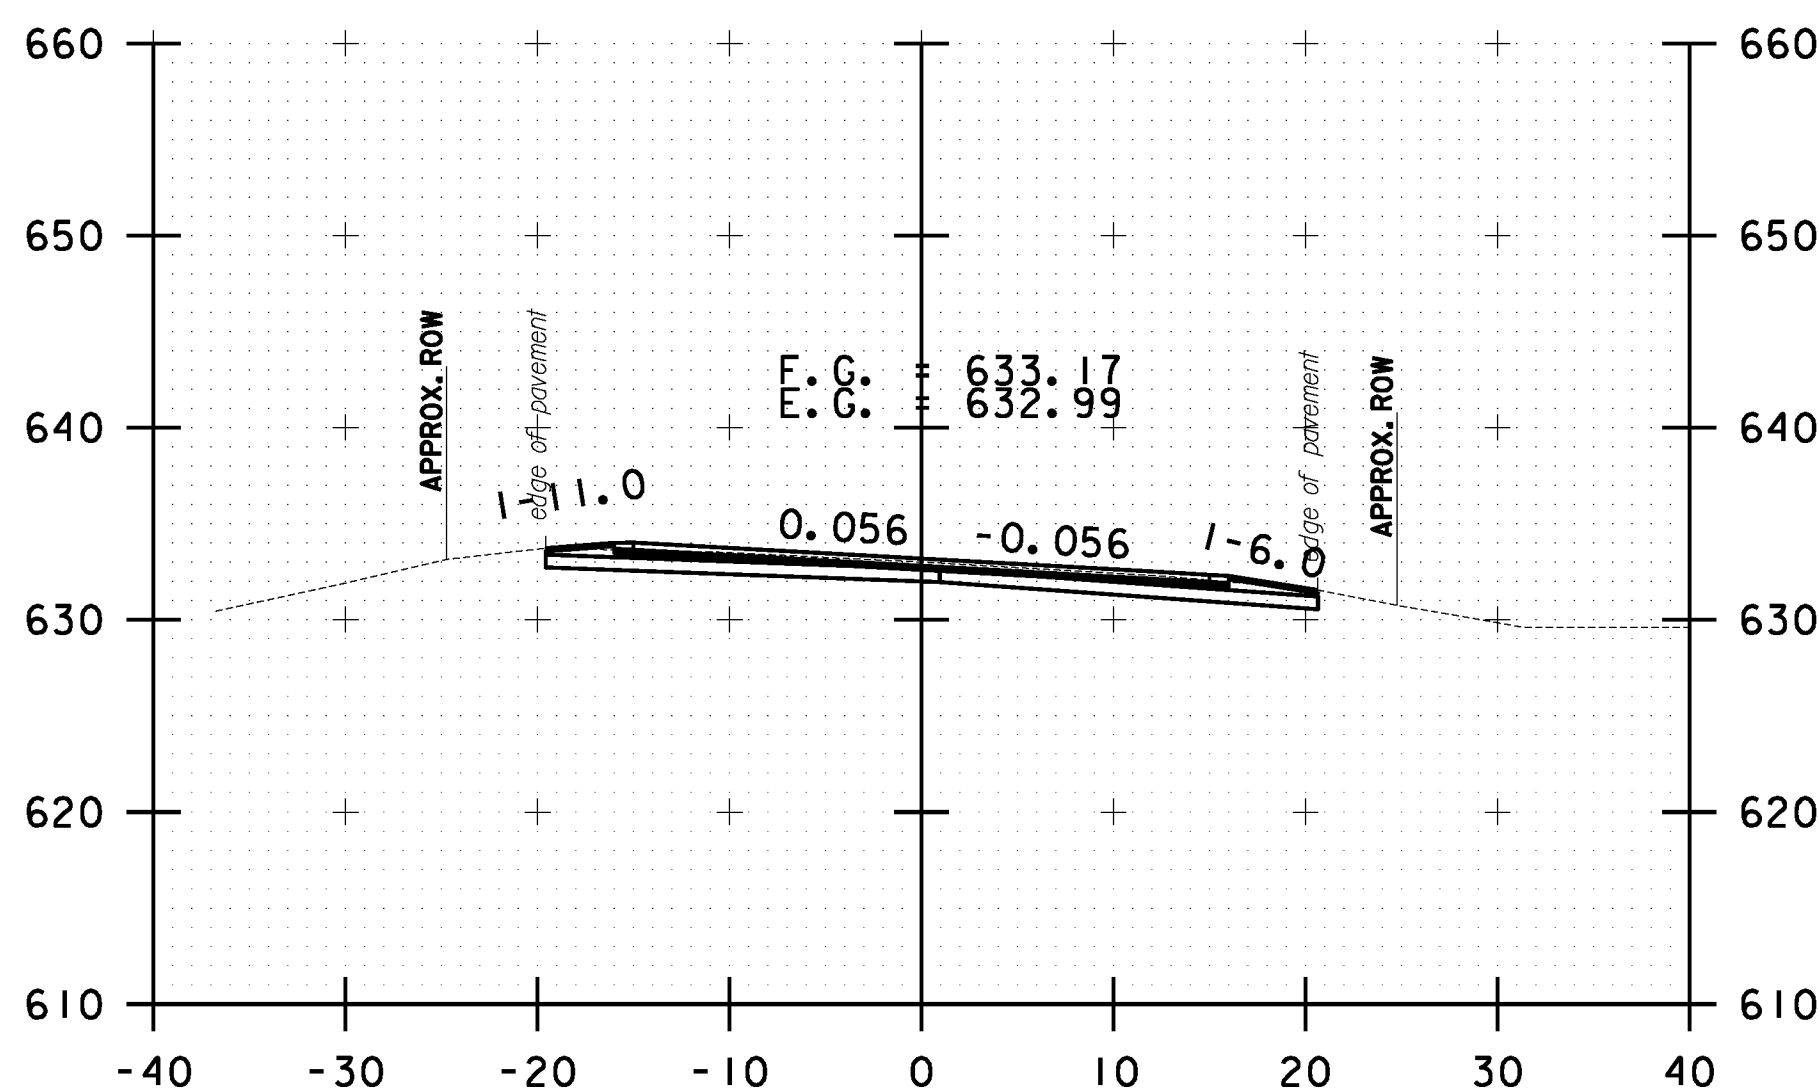

271+50.00

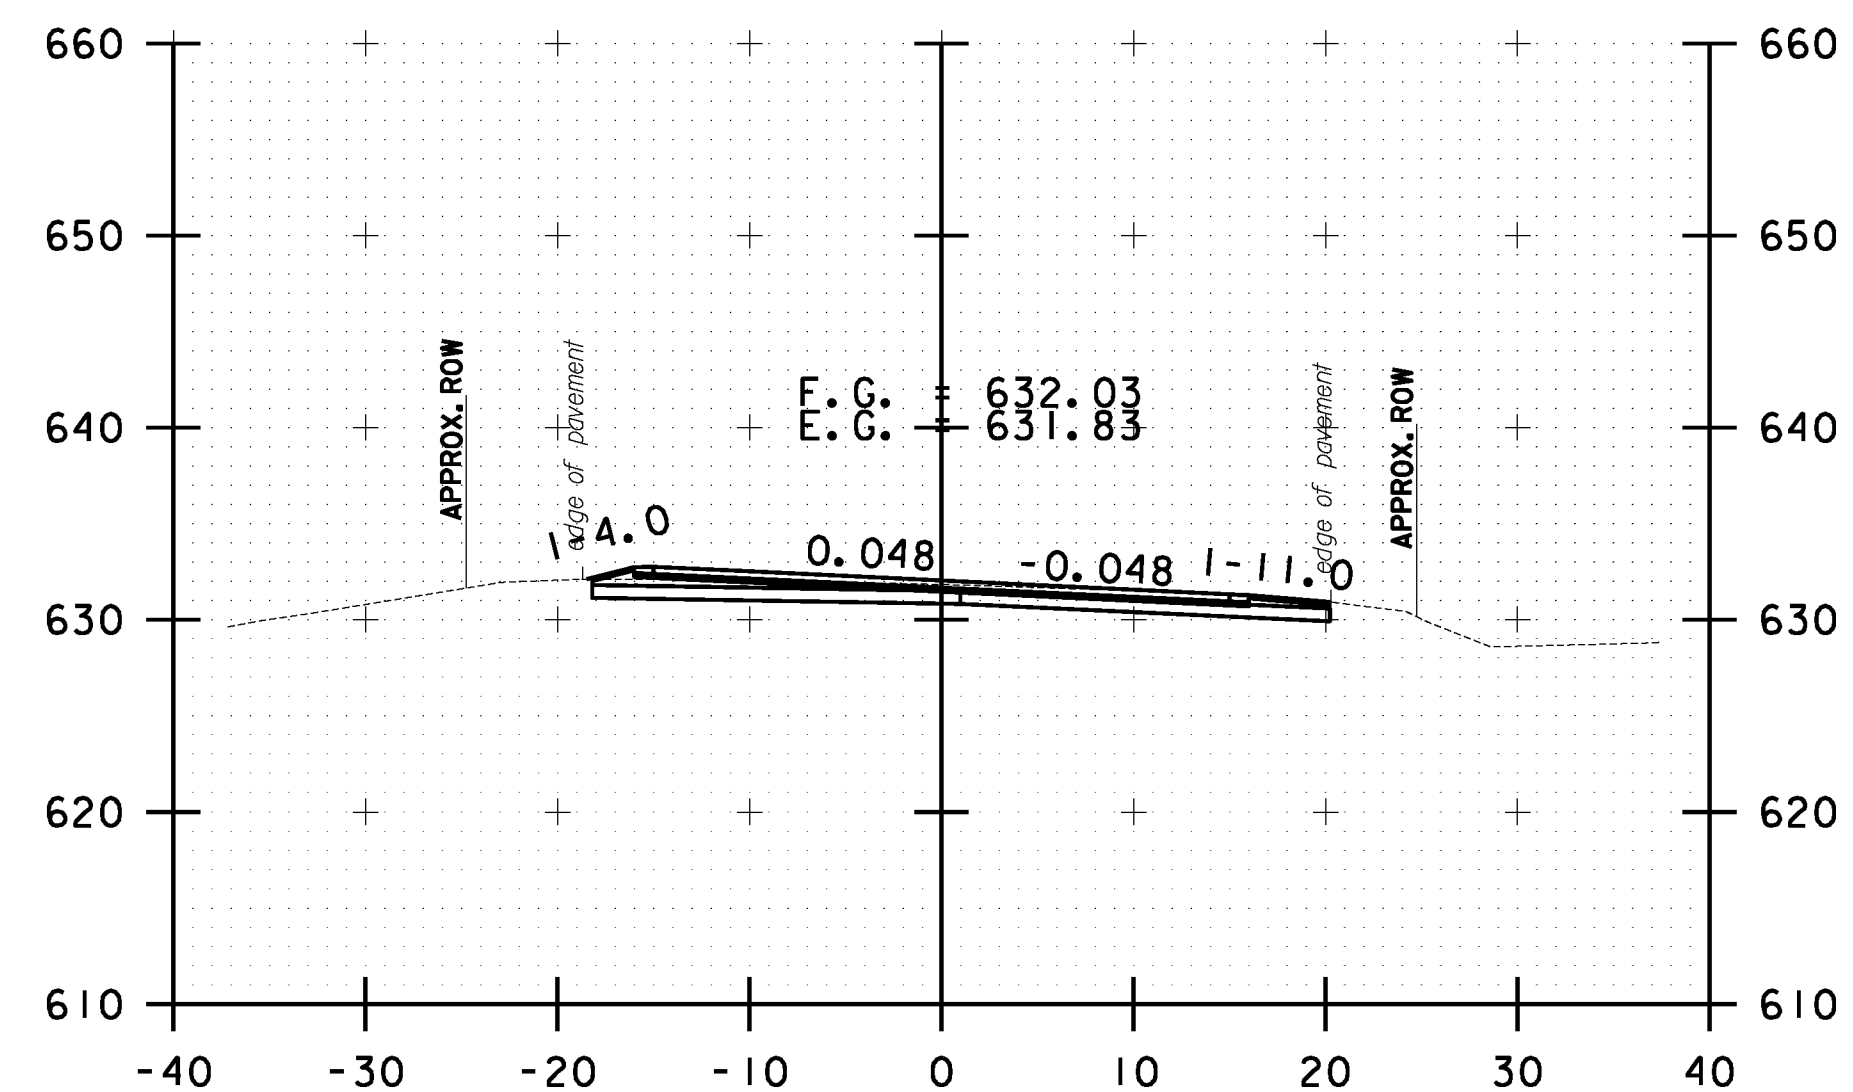

272+50.00

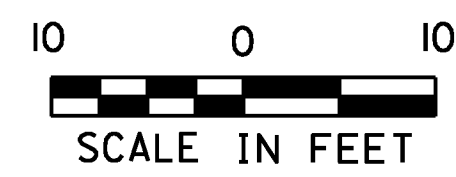

**STOCKBRIDGE
 CROSS SECTION
 SHEET #85**

PROJECT NAME: STOCKBRIDGE-BETHEL

PROJECT NUMBER: STP 2910(1)

FILE NAME: z10b214_stock_xc.dgn

PROJECT LEADER: D.E.G.

DESIGNED BY: L.M.B.

IPARM FILE: z10b214xs85.1

PLOT DATE: 3/17/2014

DRAWN BY: W.G.P.

CHECKED BY: J.P.S.

SHEET 298 OF 397