




FILE NAME = V:\P\c\ass\any\k2\22425\CADD\MSTN\10b214_stock.nc.dgn
 DATE/TIME = 3/17/2014
 USER = 4916

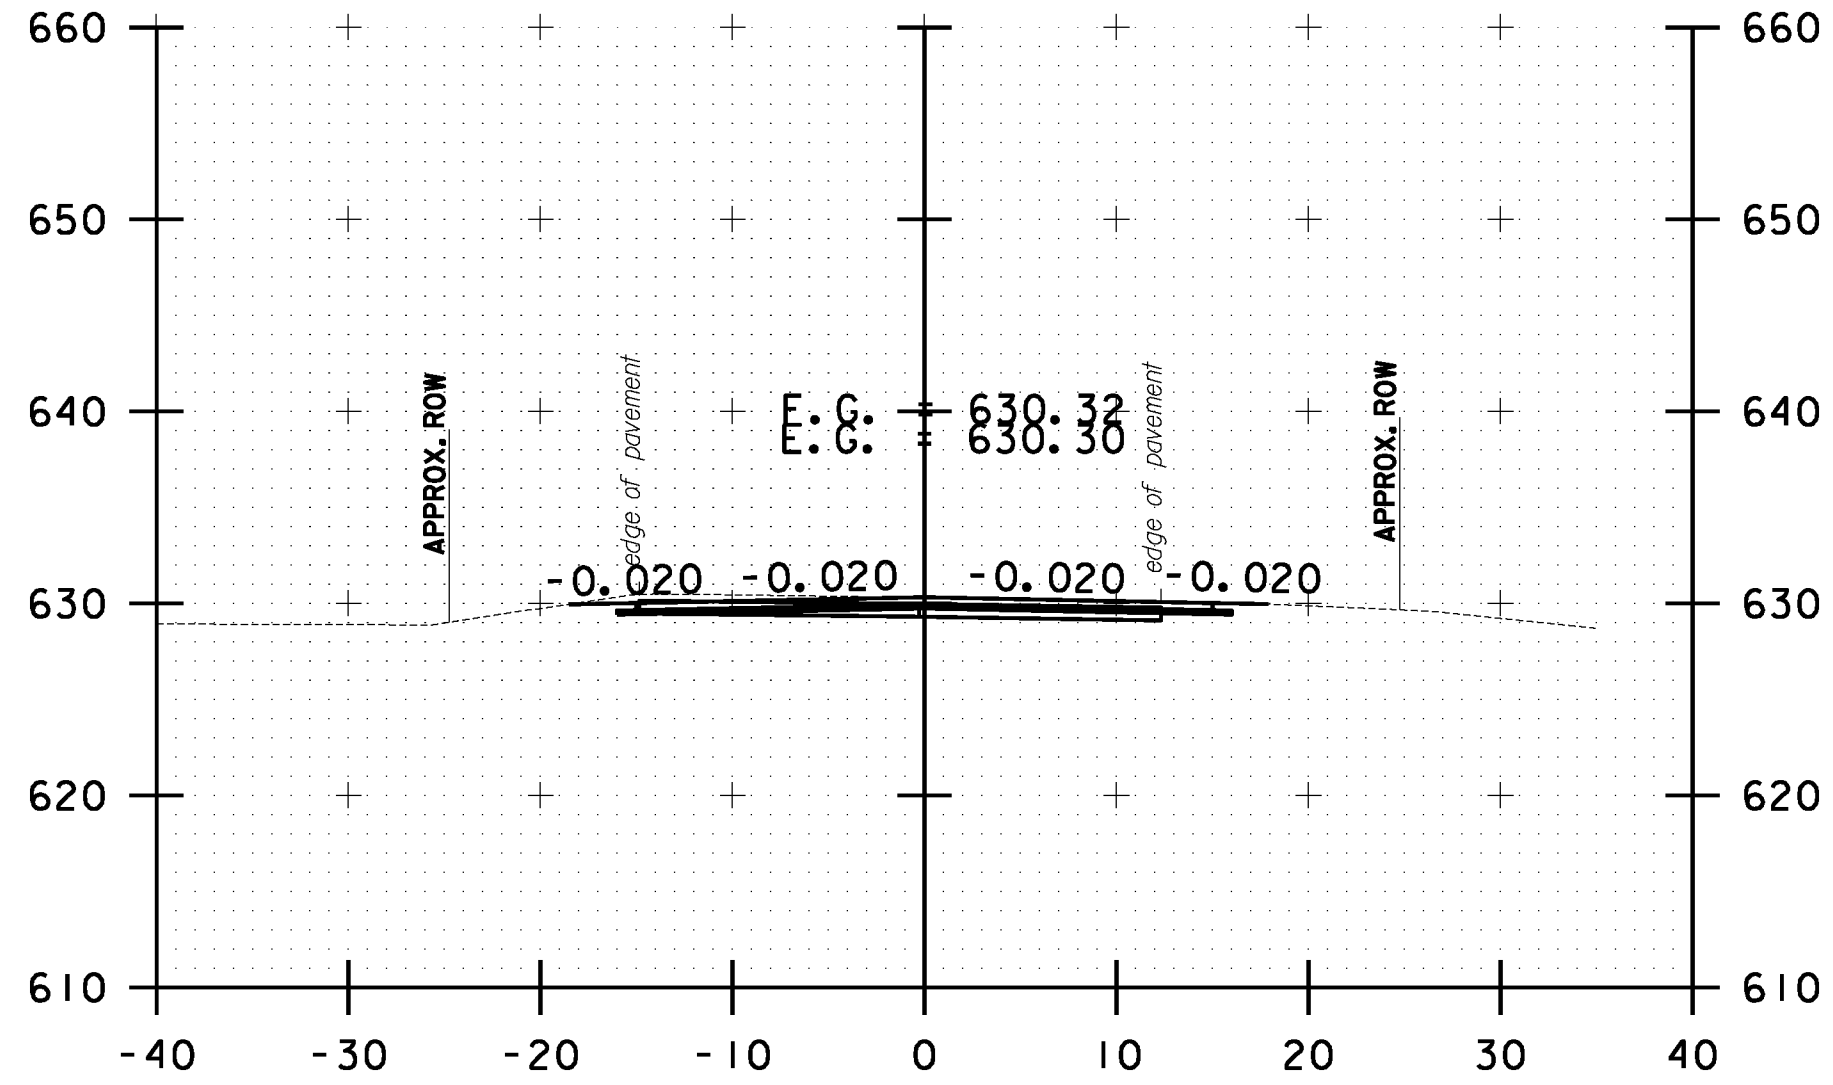


274+00.00

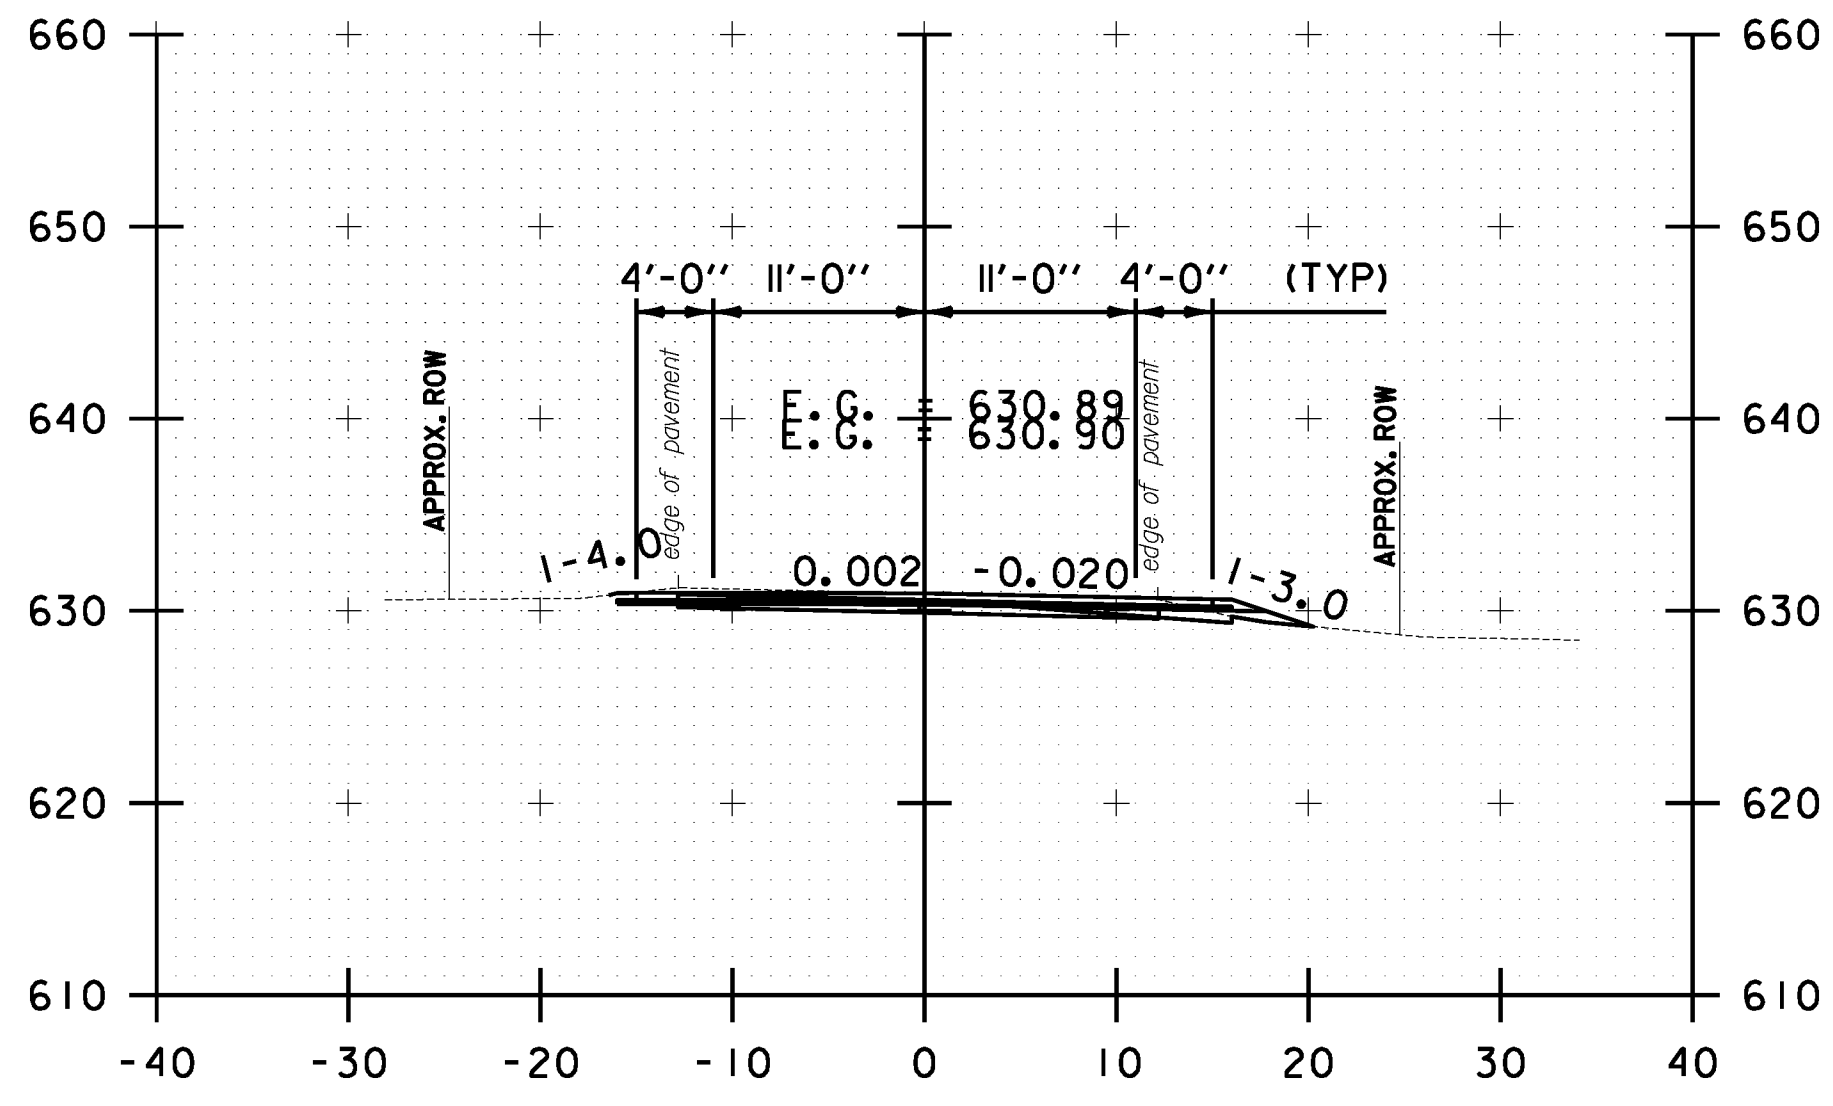


273+50.00

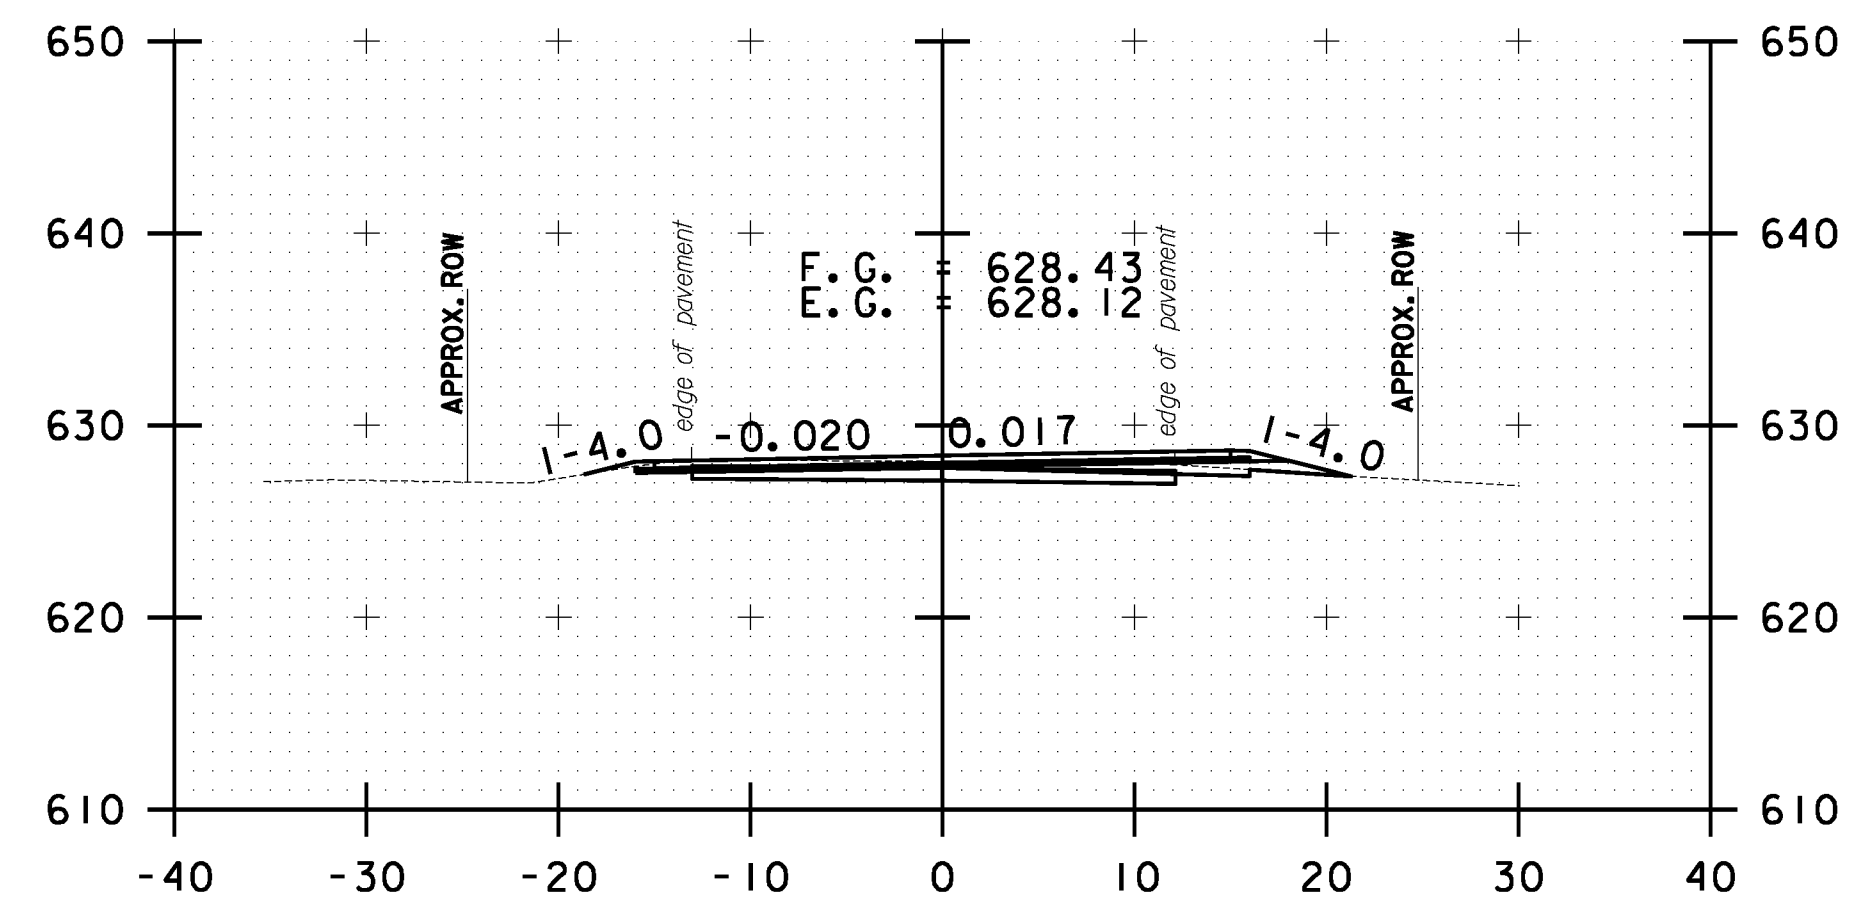


275+50.00

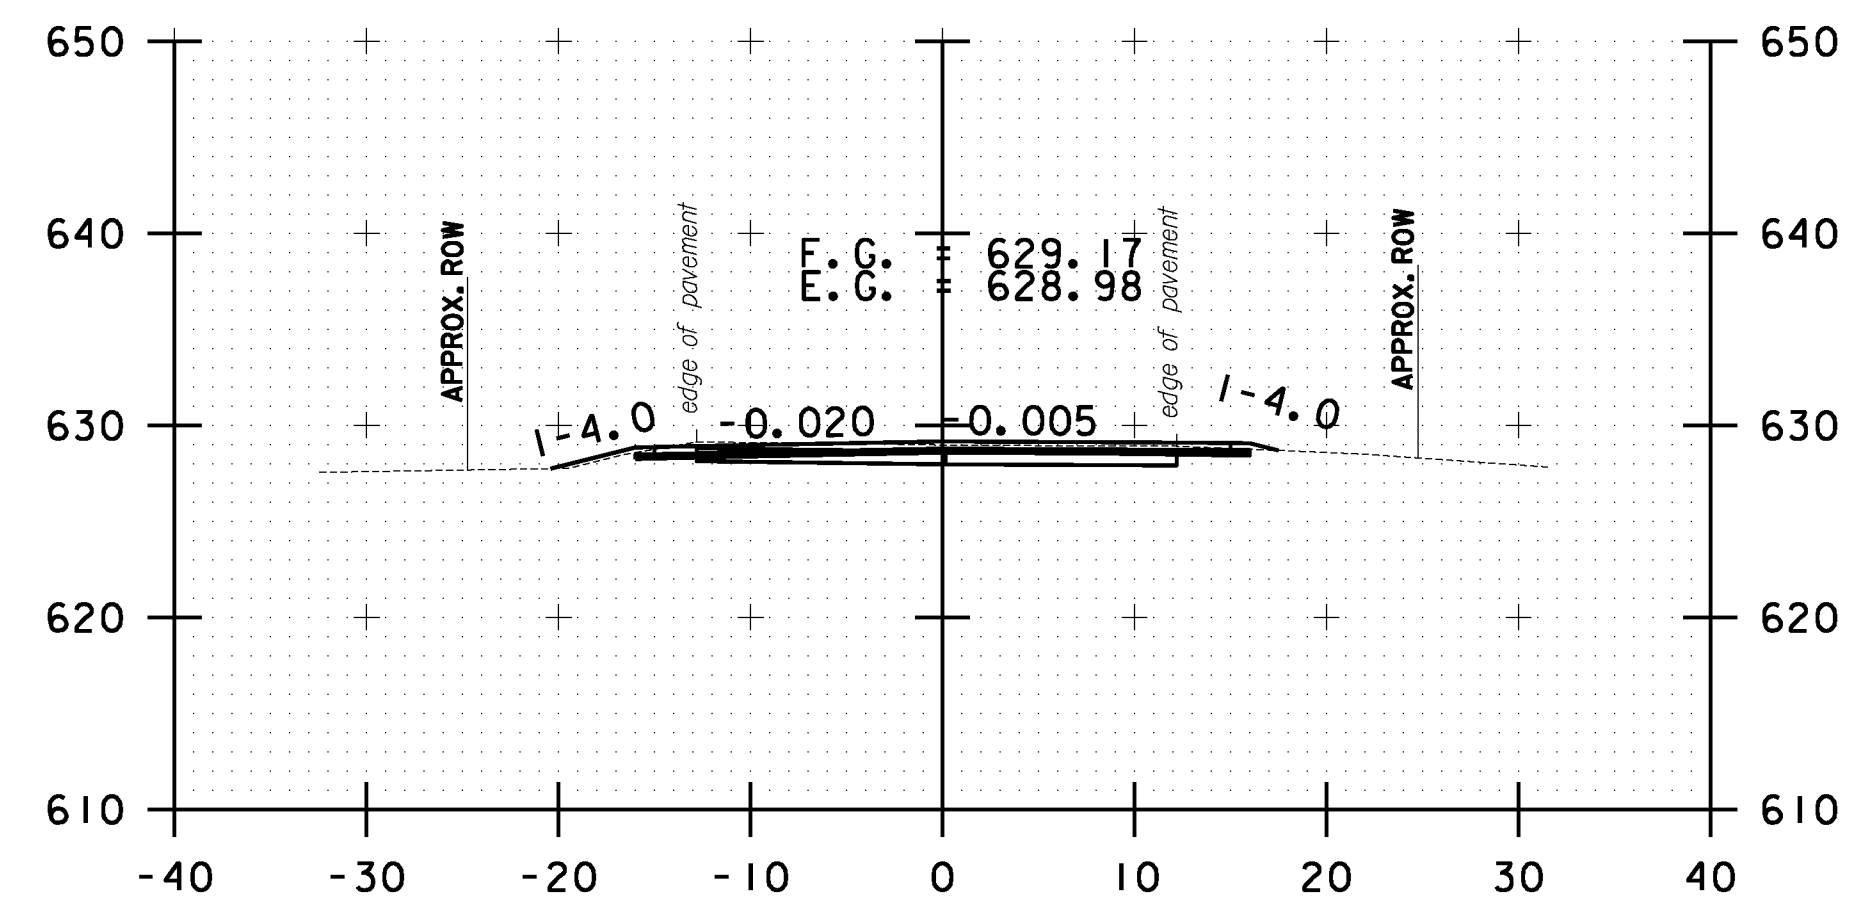


275+00.00

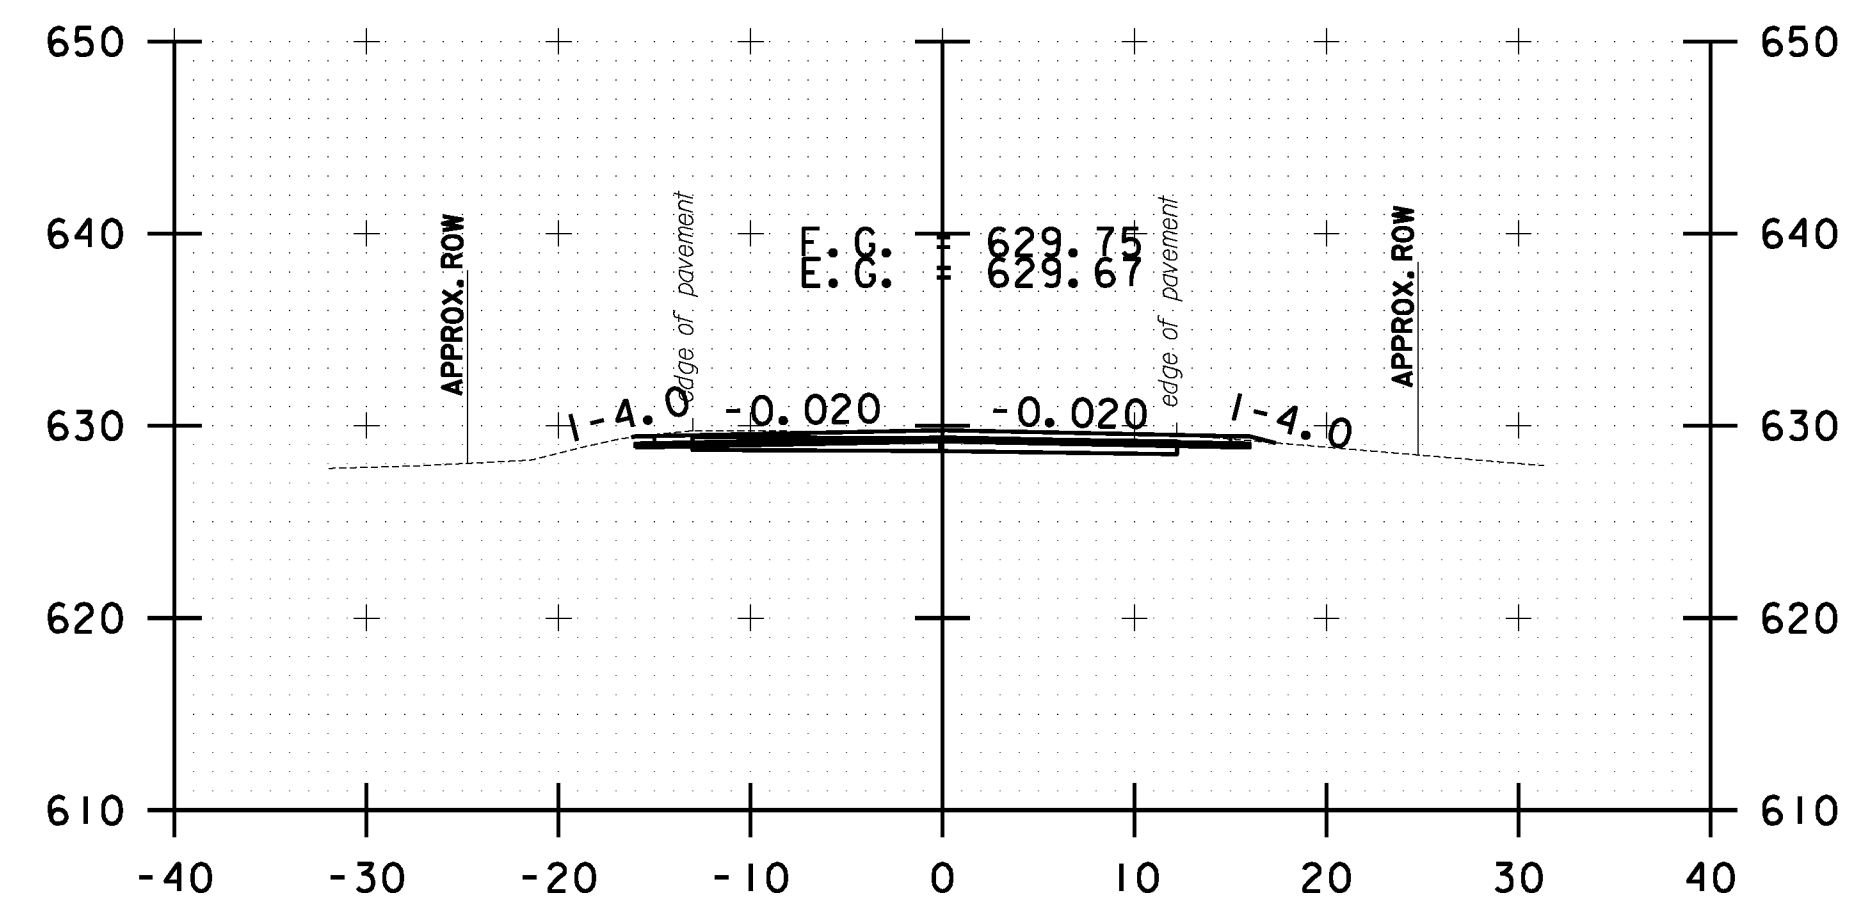


274+50.00

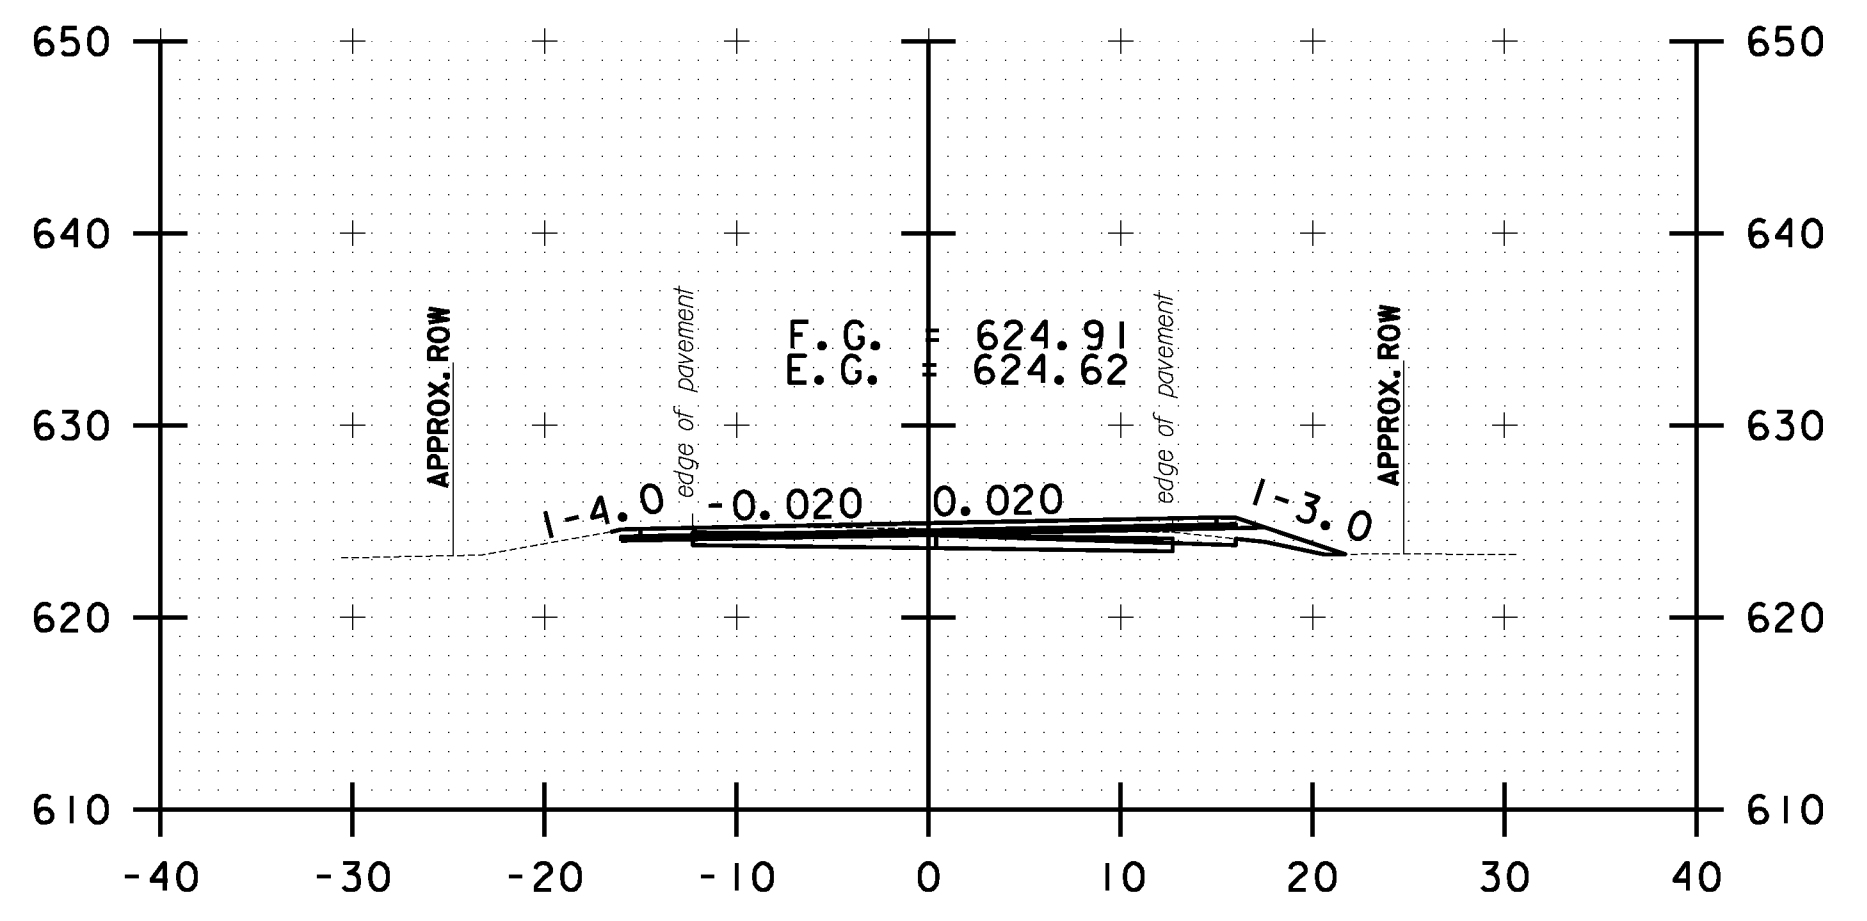


277+00.00

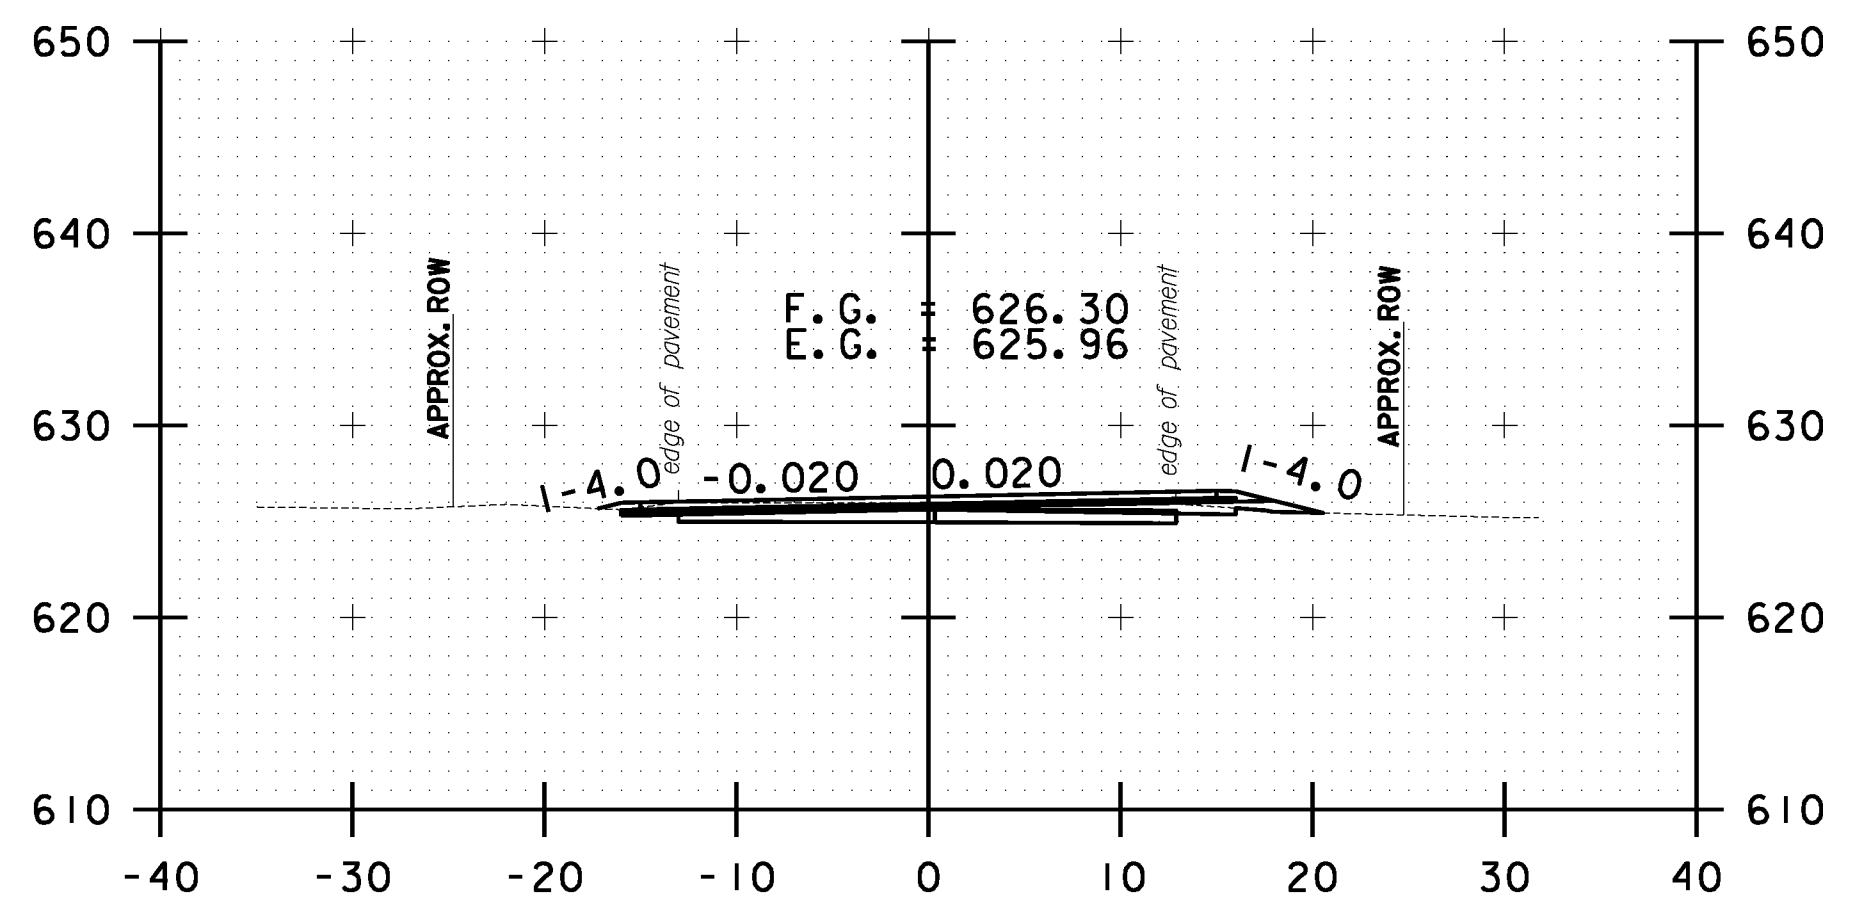

276+50.00

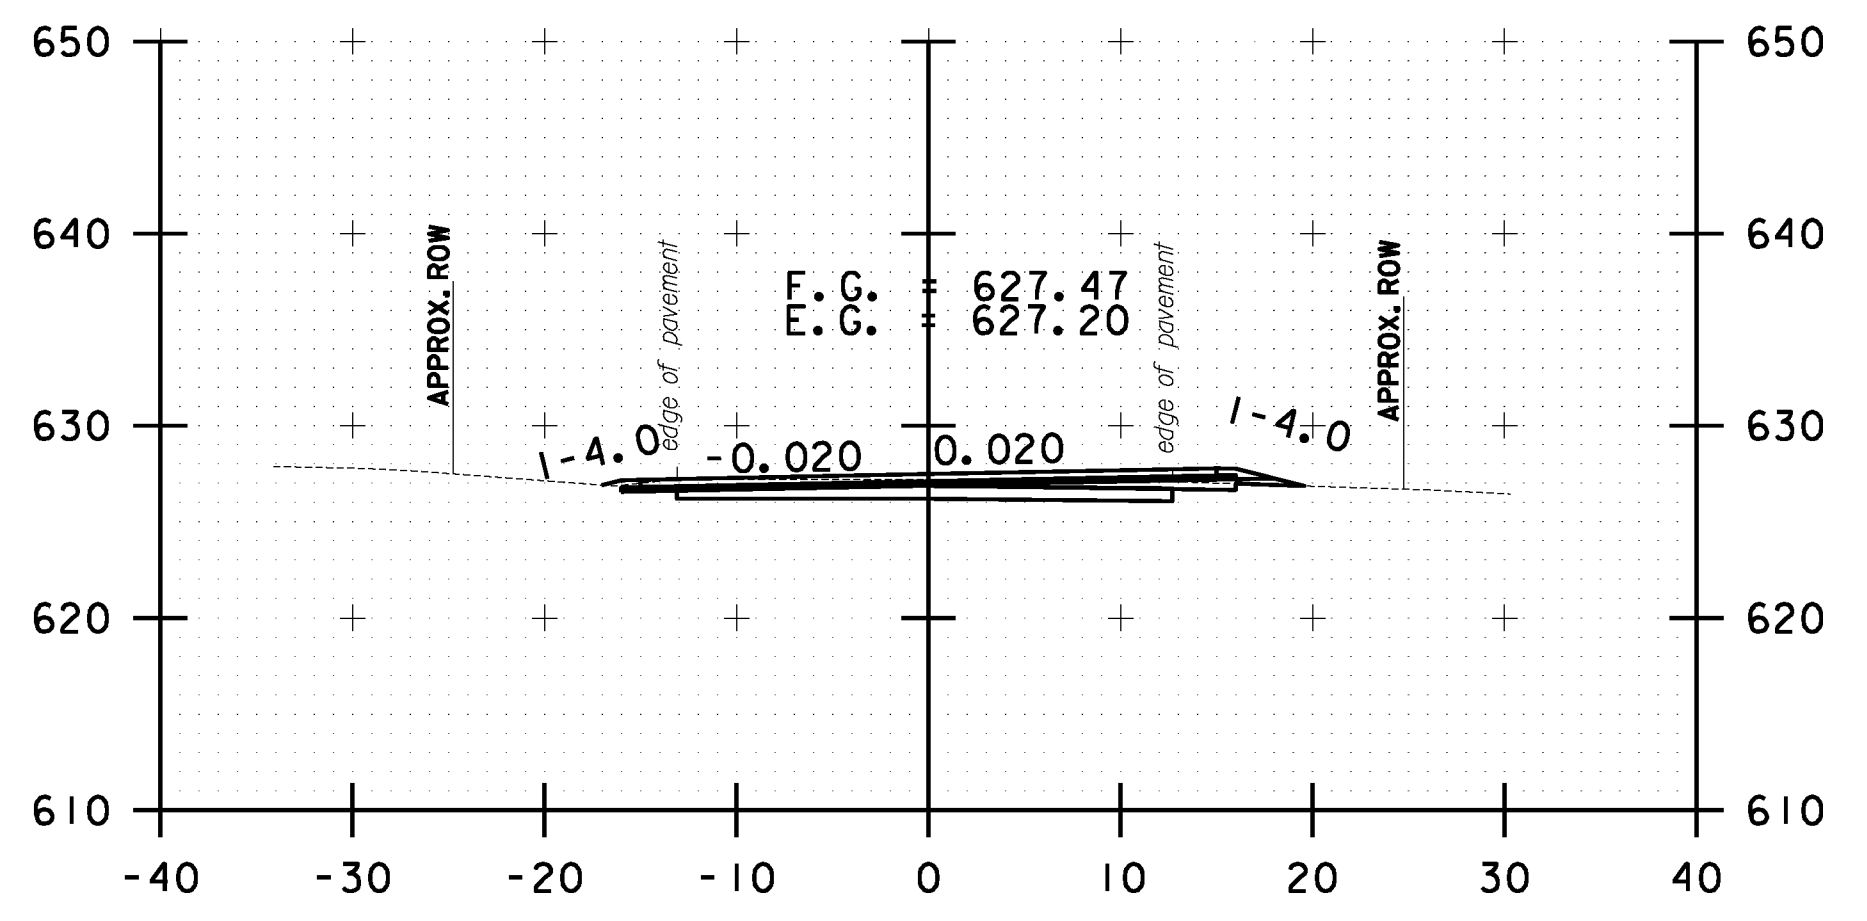

276+00.00

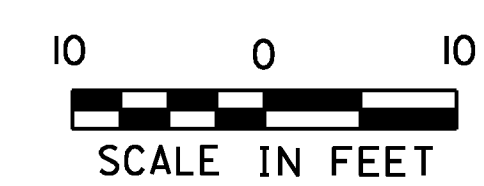

STOCKBRIDGE CROSS SECTION SHEET #86	PROJECT NAME: STOCKBRIDGE-BETHEL
	PROJECT NUMBER: STP 2910(1)
	FILE NAME: z10b214_stock.xc.dgn
	PLOT DATE: 3/17/2014
	DESIGNED BY: L.M.B.
	PROJECT LEADER: D.E.G.
	IPARM FILE: z10b214xs86.1
	CHECKED BY: J.P.S.
	DRAWN BY: W.G.P.
	SHEET 299 OF 397