




FILE NAME = Y:\P\c\ass\ANY\K2\22425\CADD\MSTN\10b214_stock.nc.dgn
 DATE/TIME = 3/17/2014
 USER = 4916

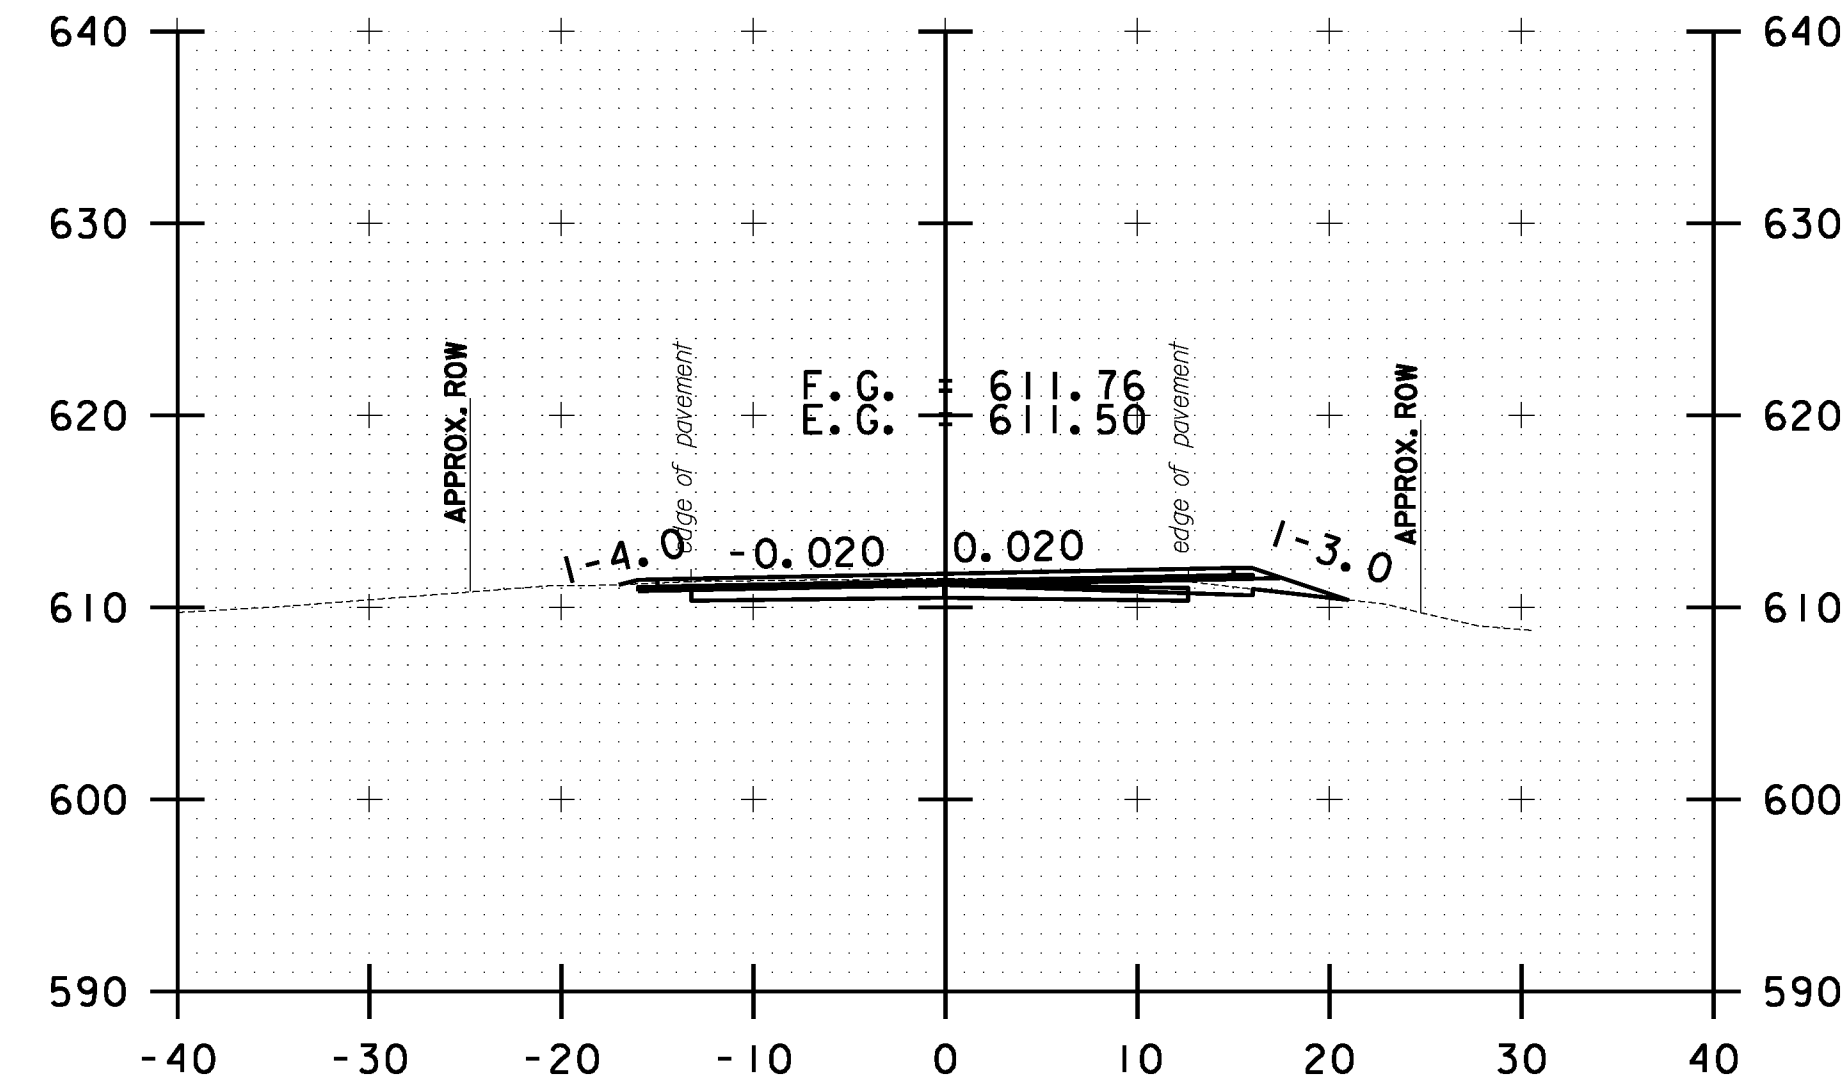


281+00.00

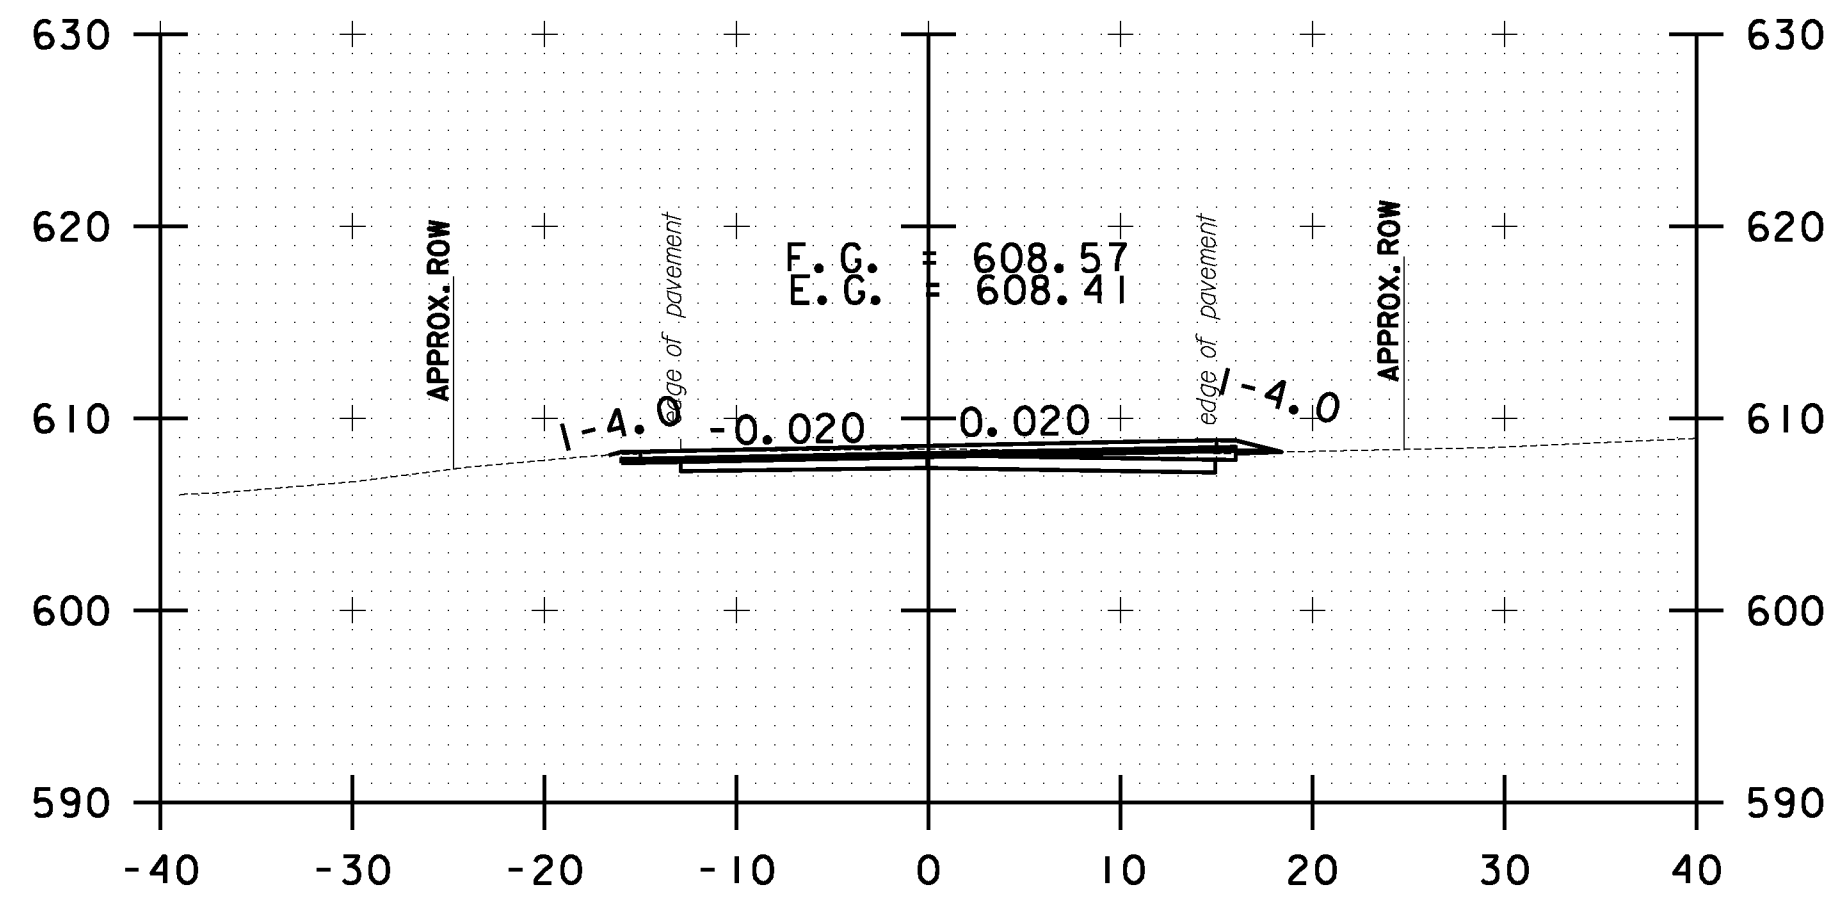


282+00.00

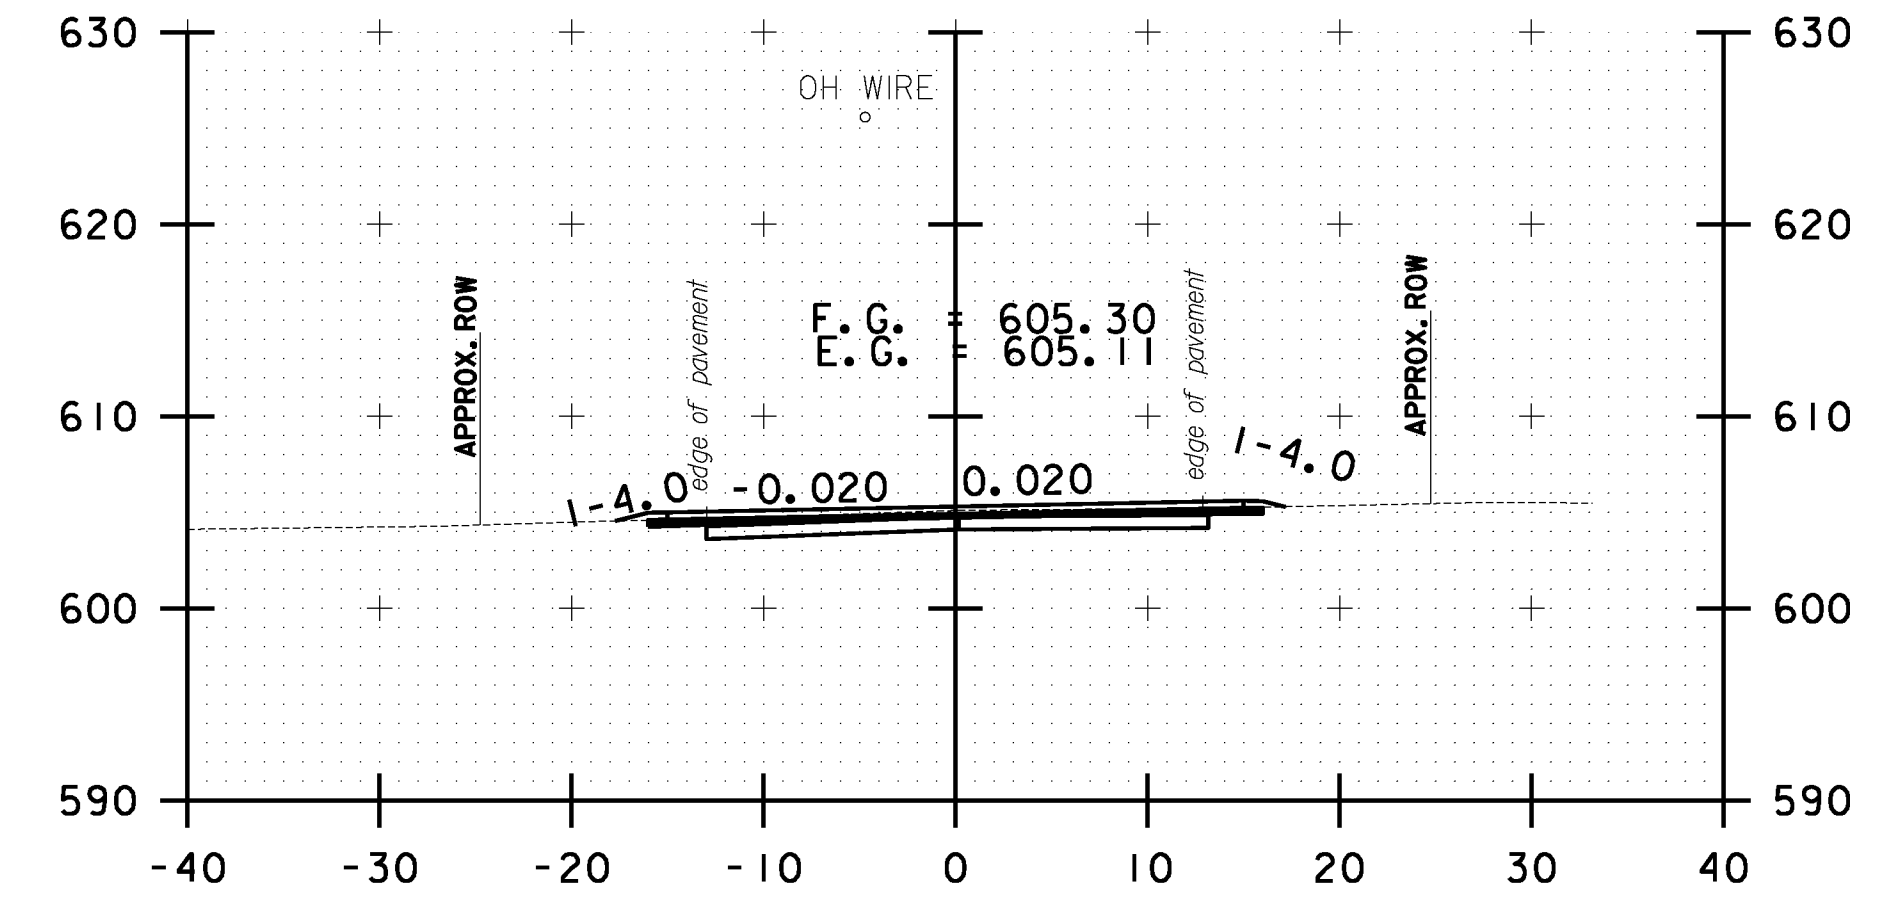


283+50.00

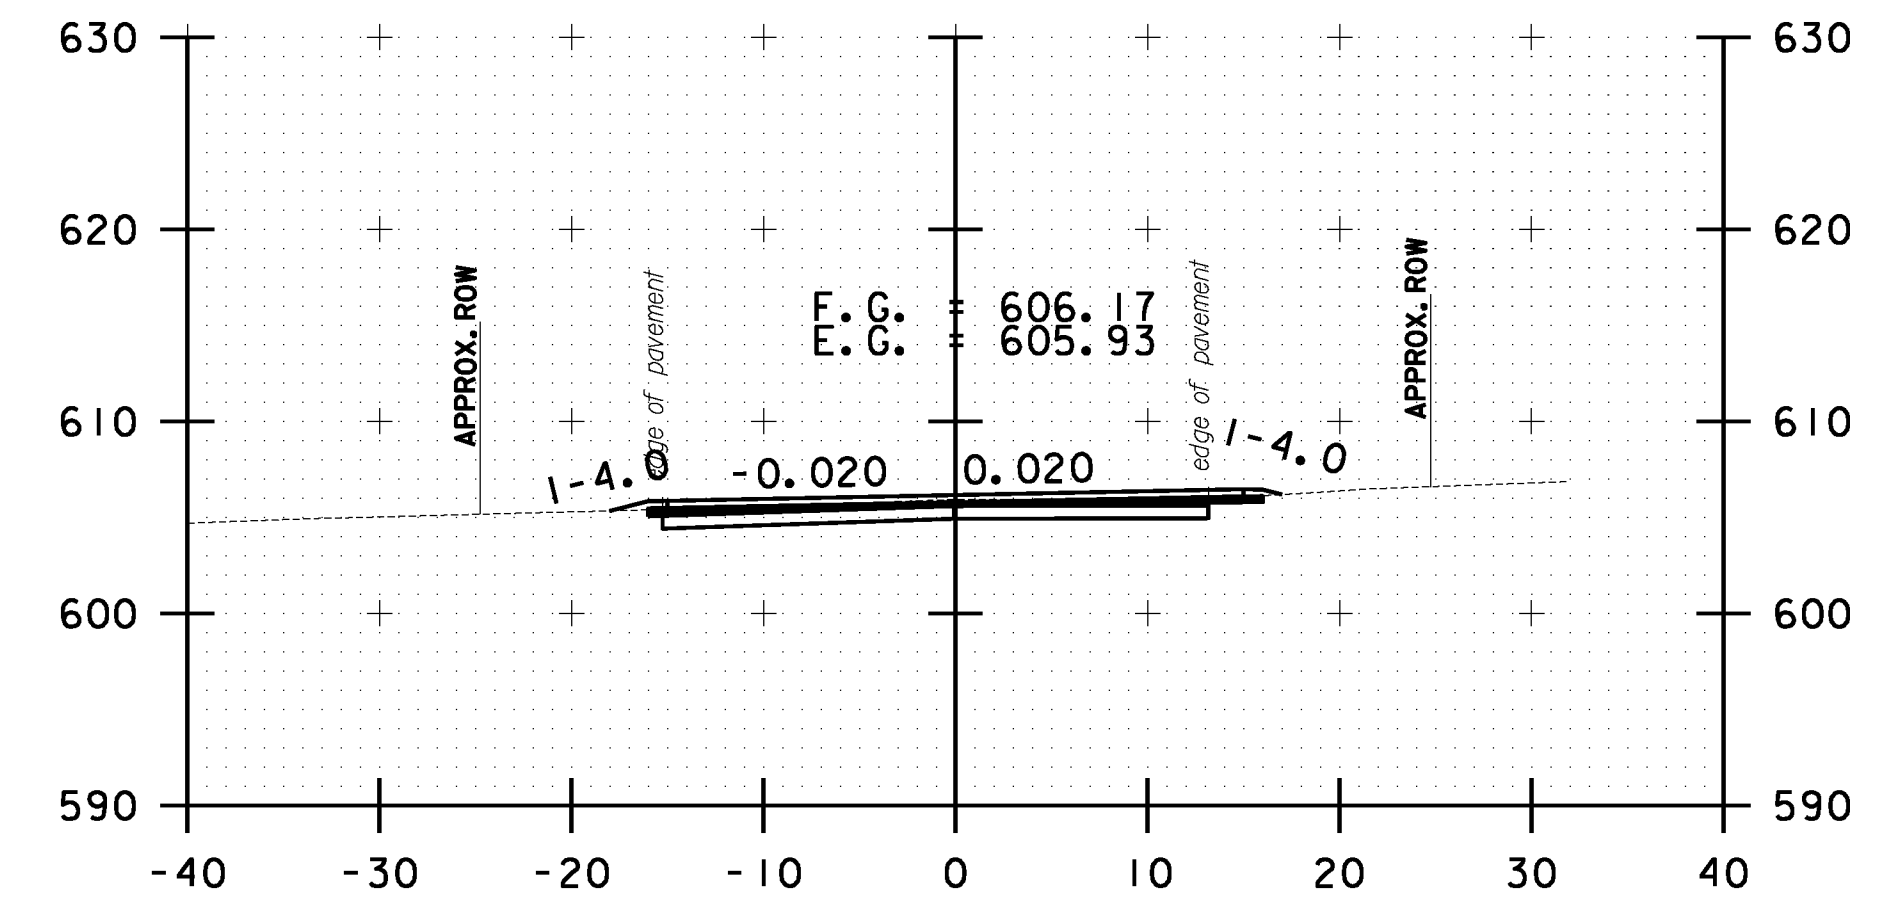


283+00.00

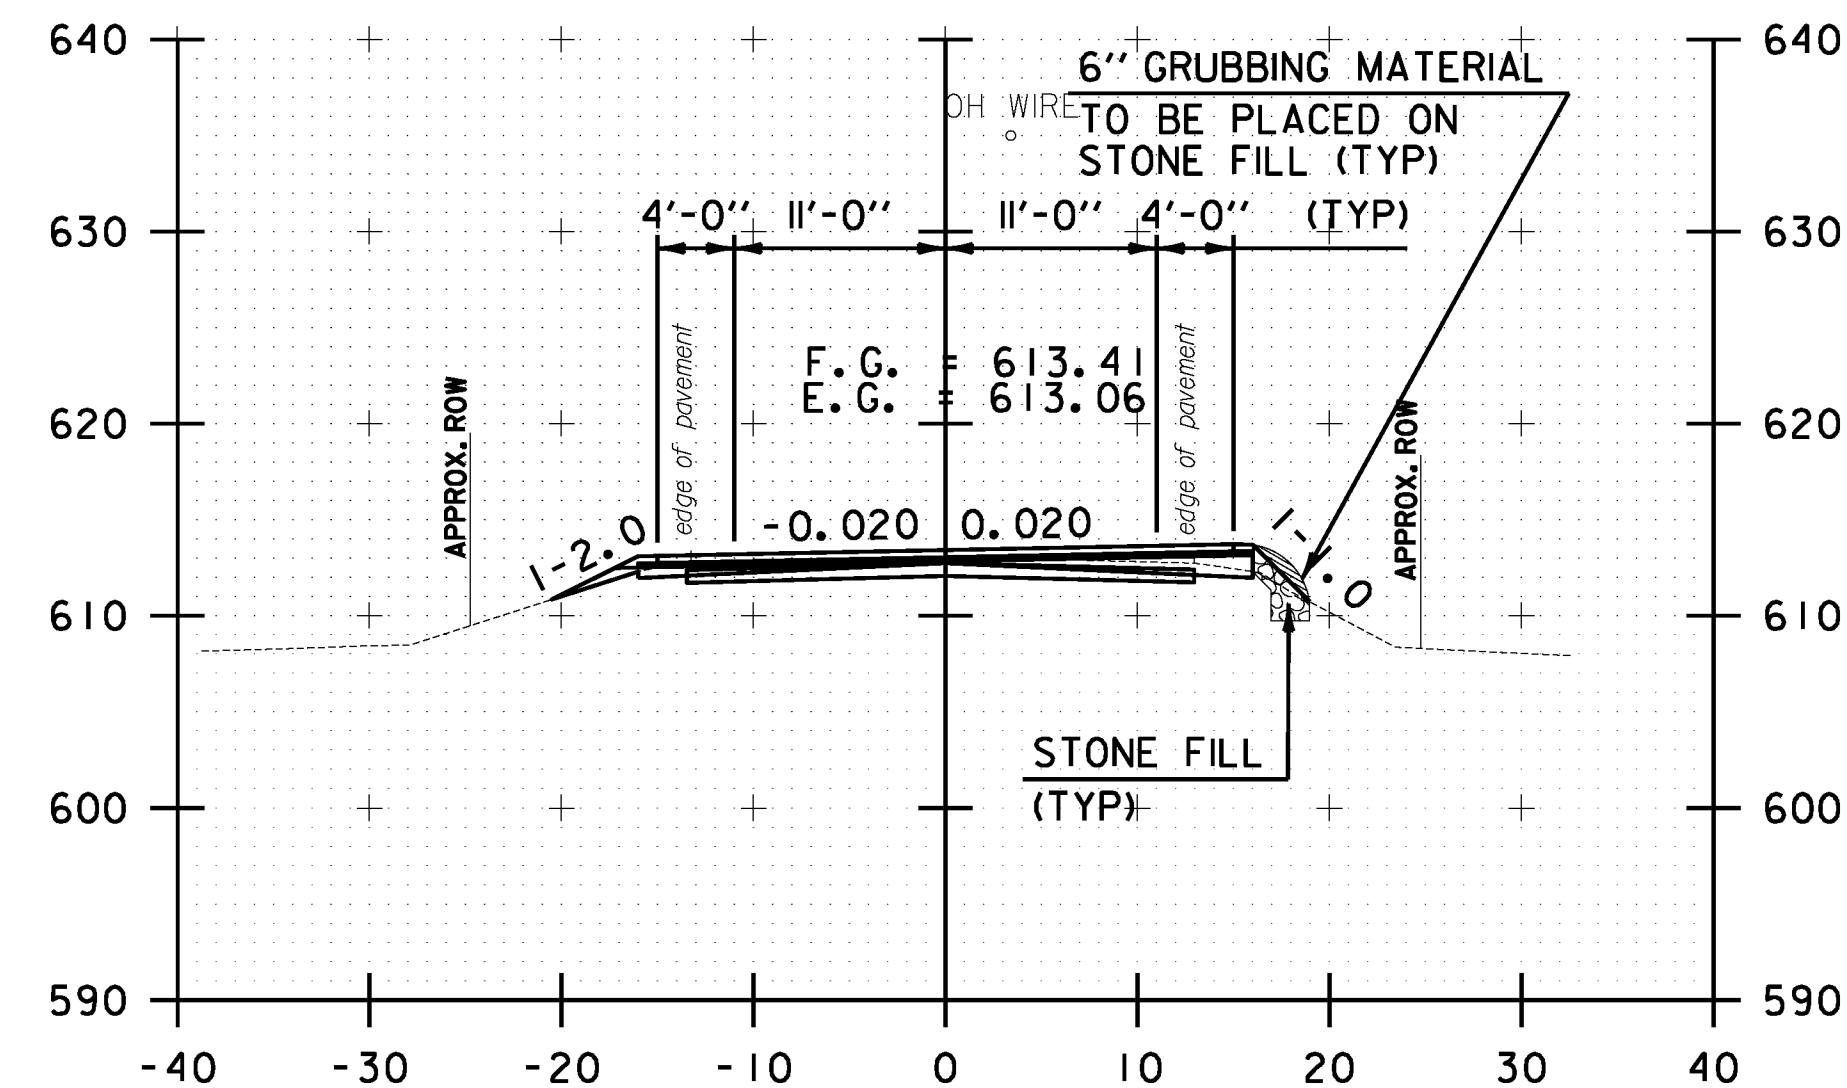

280+50.00

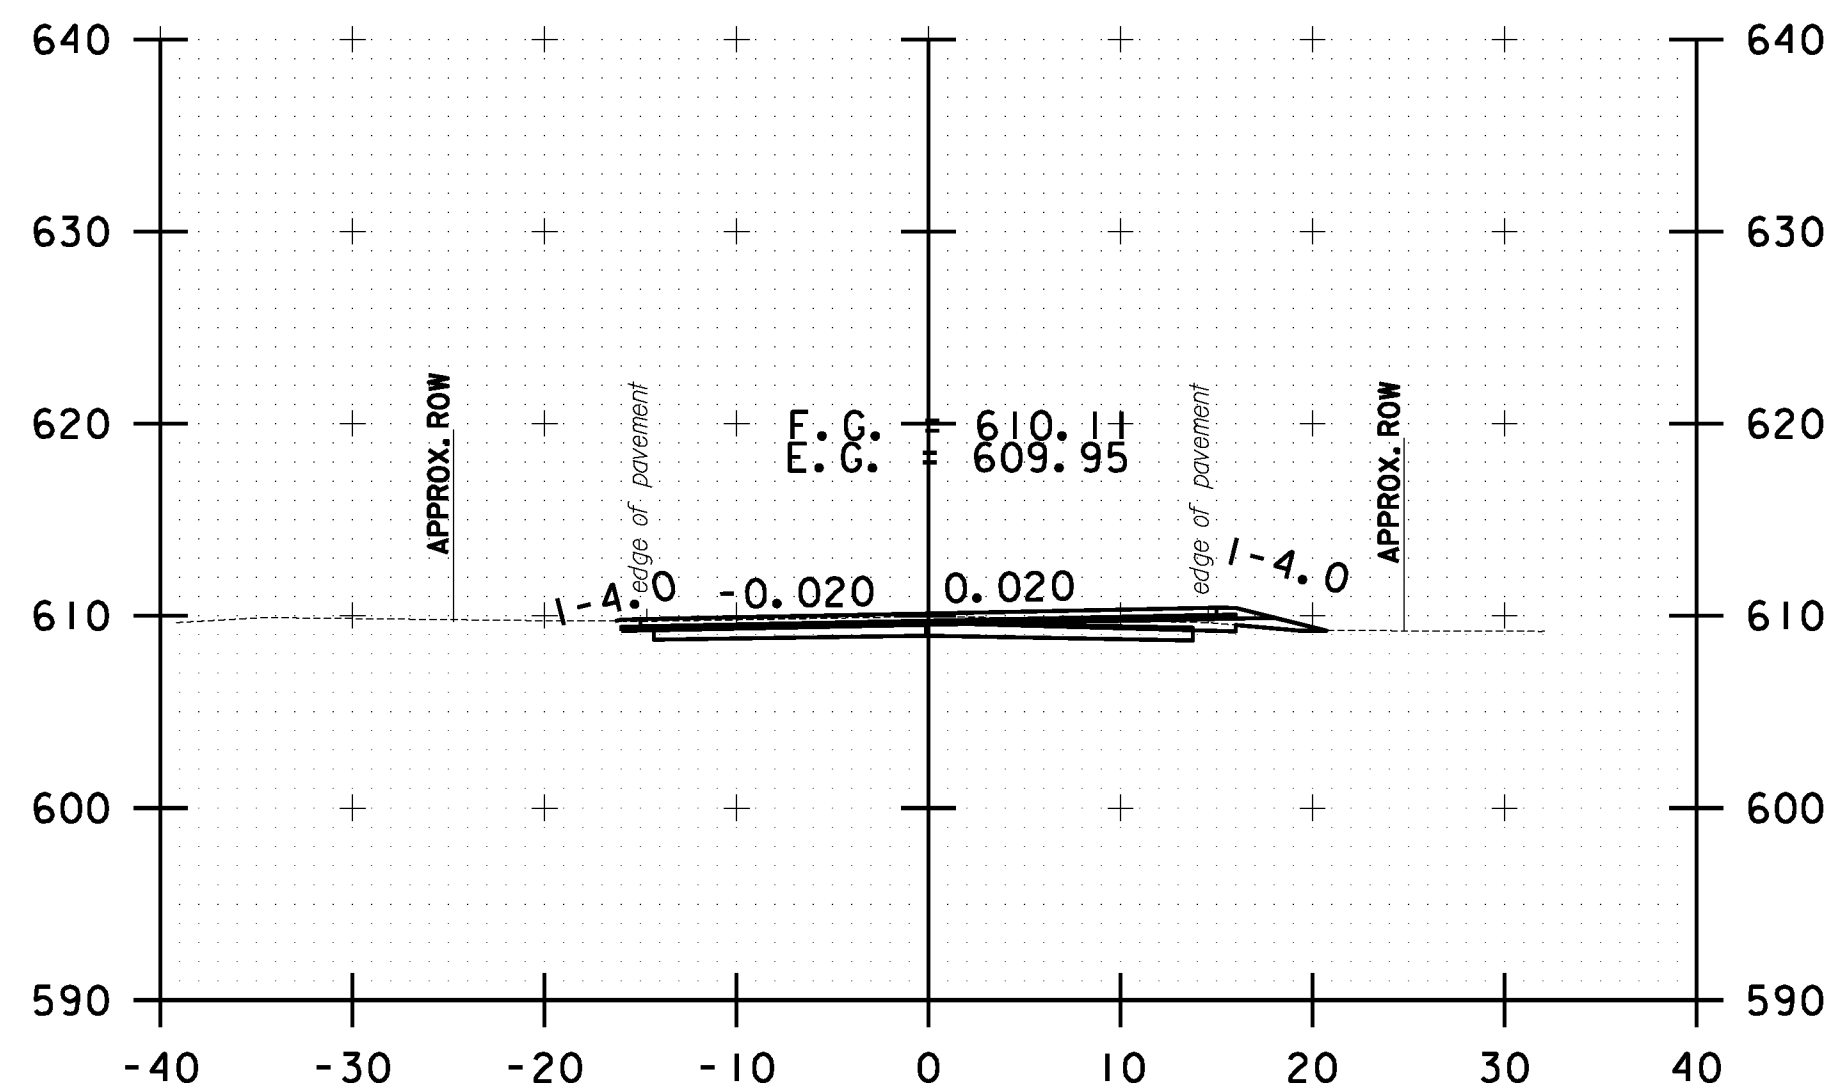

281+50.00

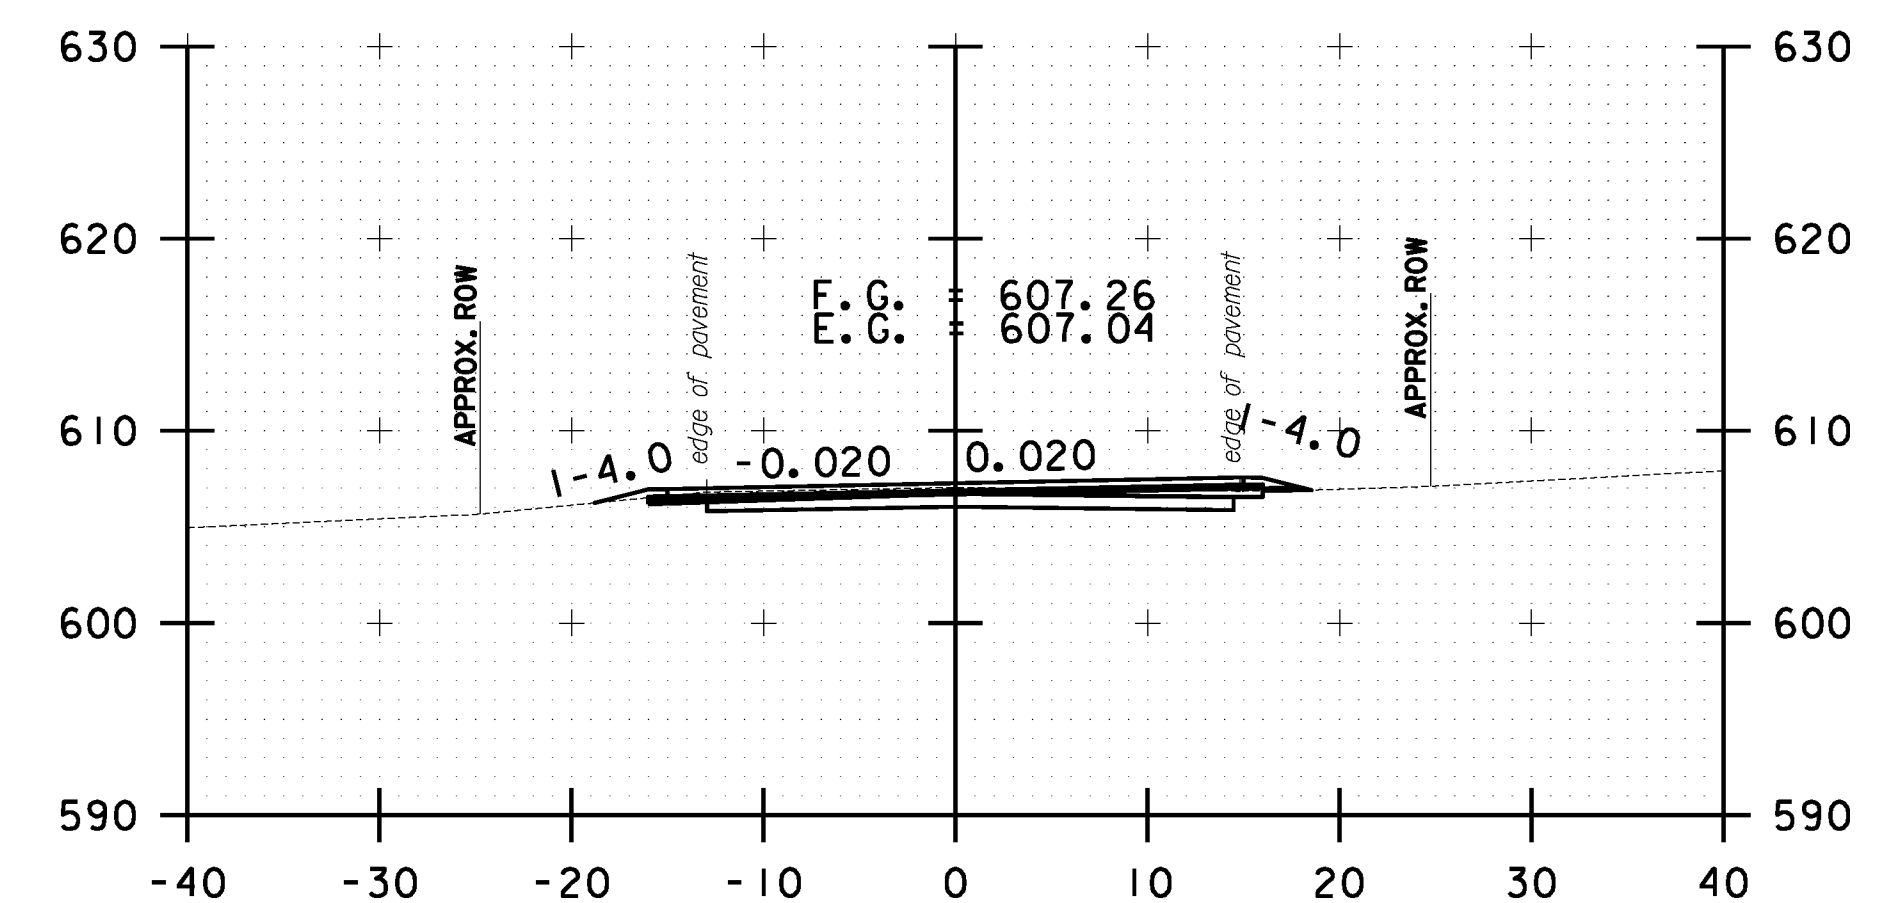

282+50.00



STOCKBRIDGE CROSS SECTION SHEET #88	PROJECT NAME: STOCKBRIDGE-BETHEL
	PROJECT NUMBER: STP 2910(1)
	FILE NAME: z10b214_stock.nc.dgn
	IPARM FILE: z10b214xs88.1
	PLOT DATE: 3/17/2014
	DRAWN BY: W.C.P.
	CHECKED BY: J.P.S.
	SHEET 301 OF 397