




FILE NAME = Y:\P\c\stok\ANY\X2\22425\CADD\MSTN10b214\_stock.nc.dgn  
 DATE/TIME = 3/17/2014  
 USER = 4916

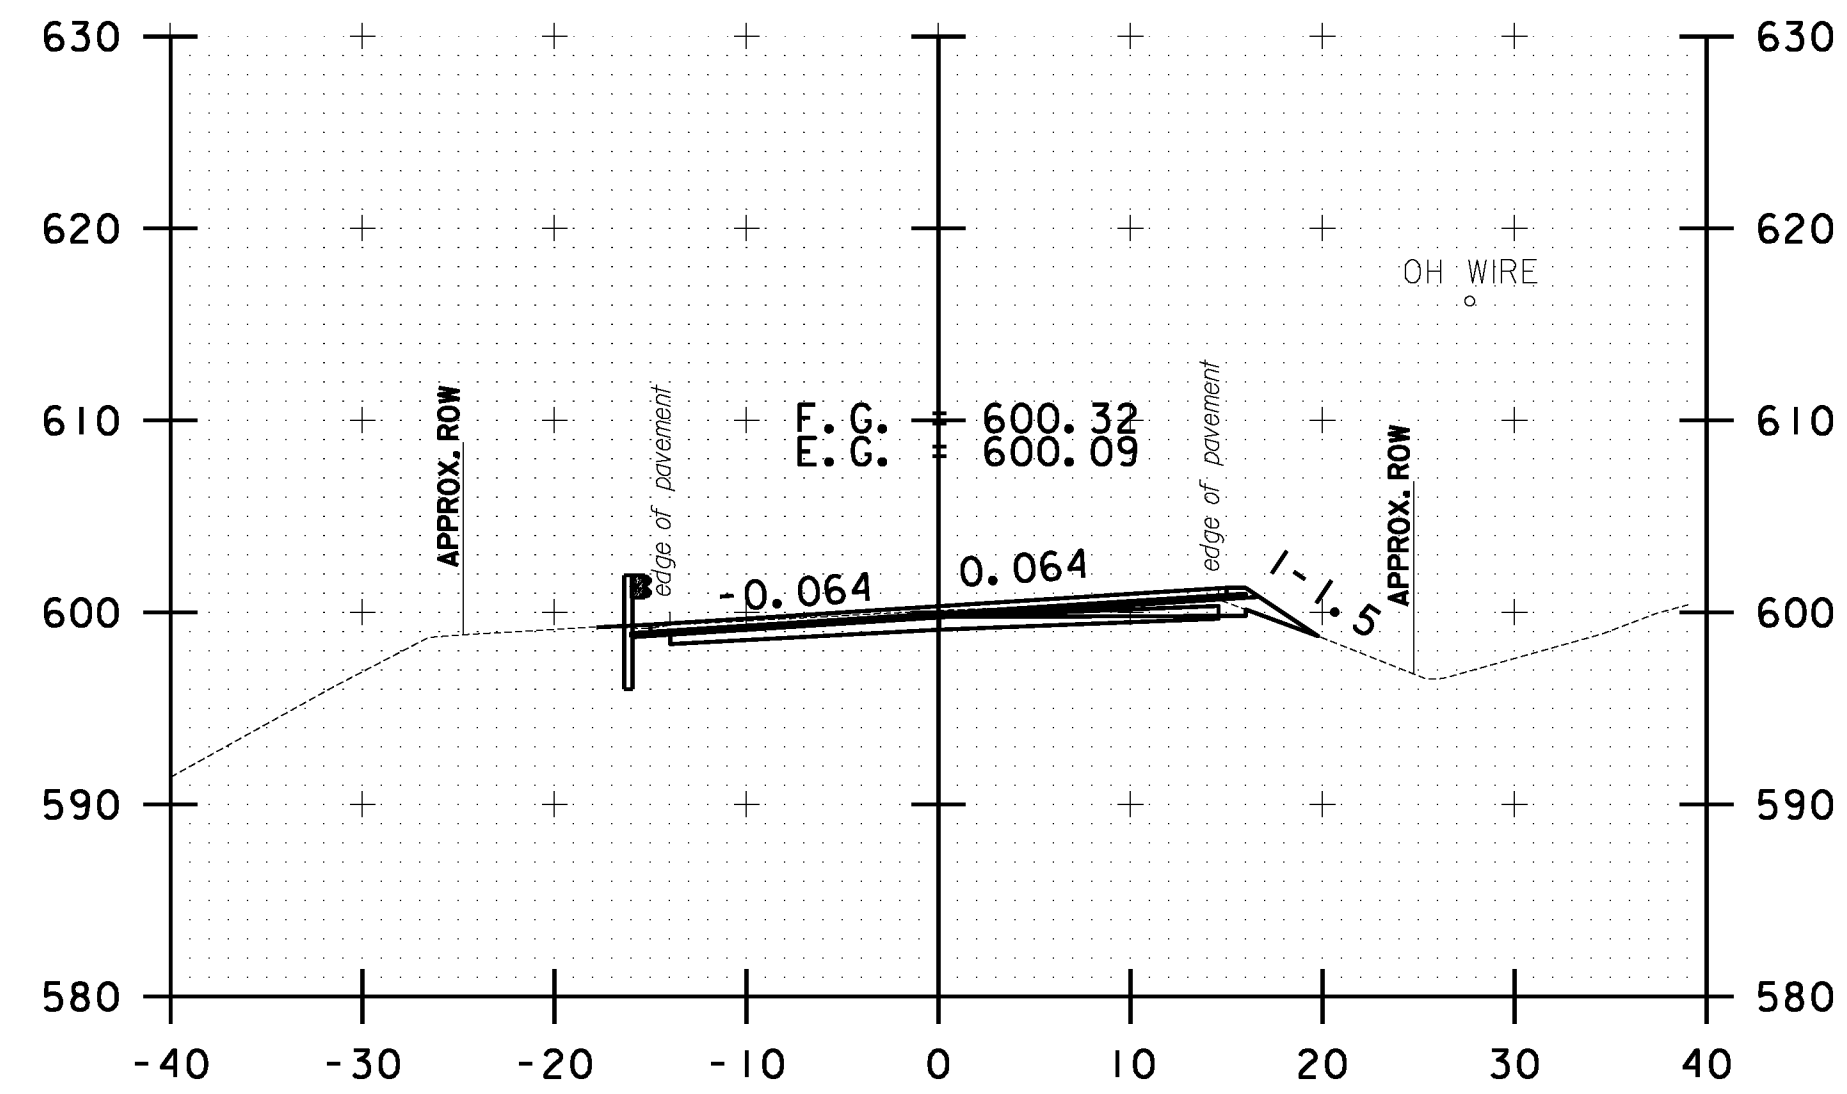


291+00.00

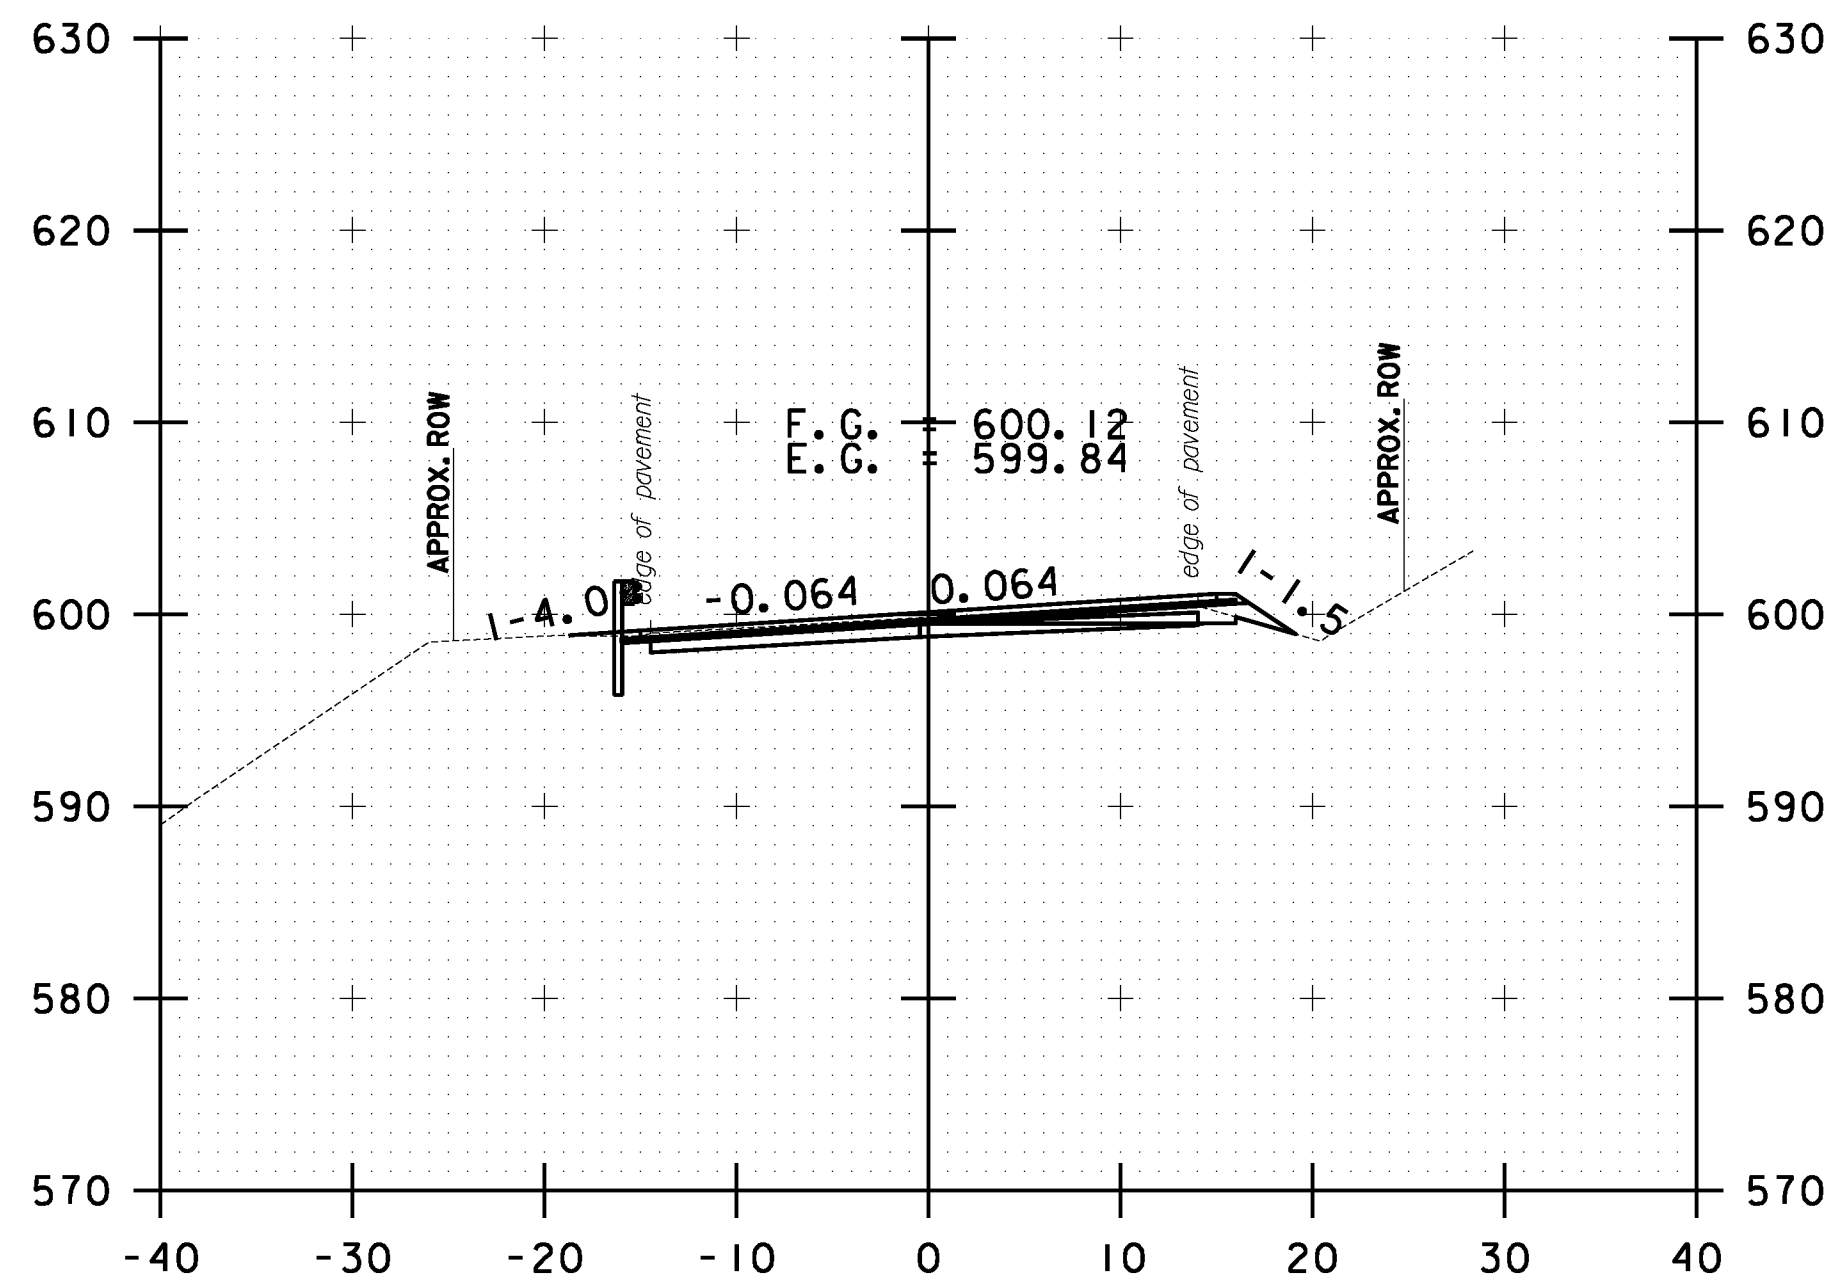


292+00.00

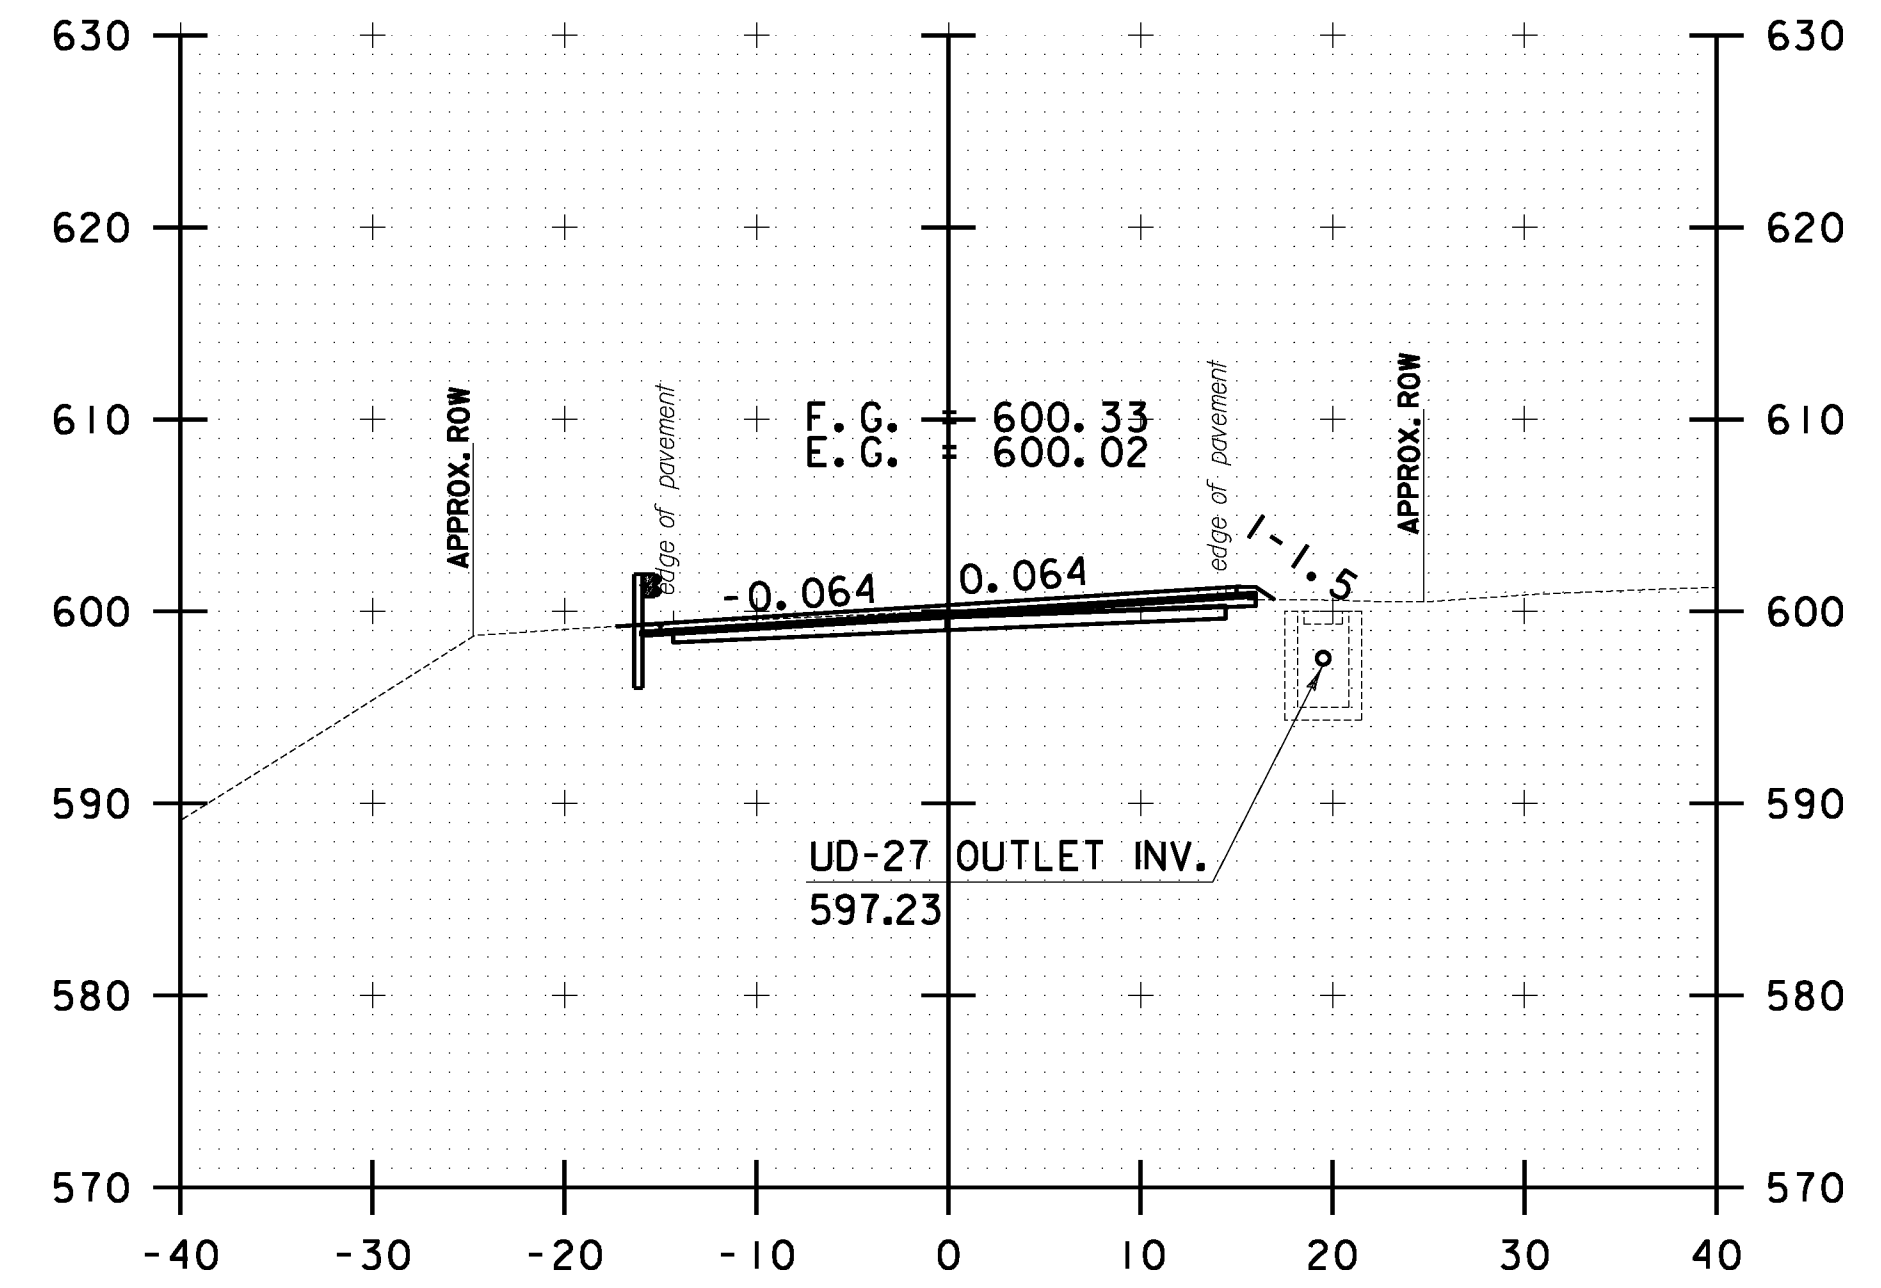


293+00.00

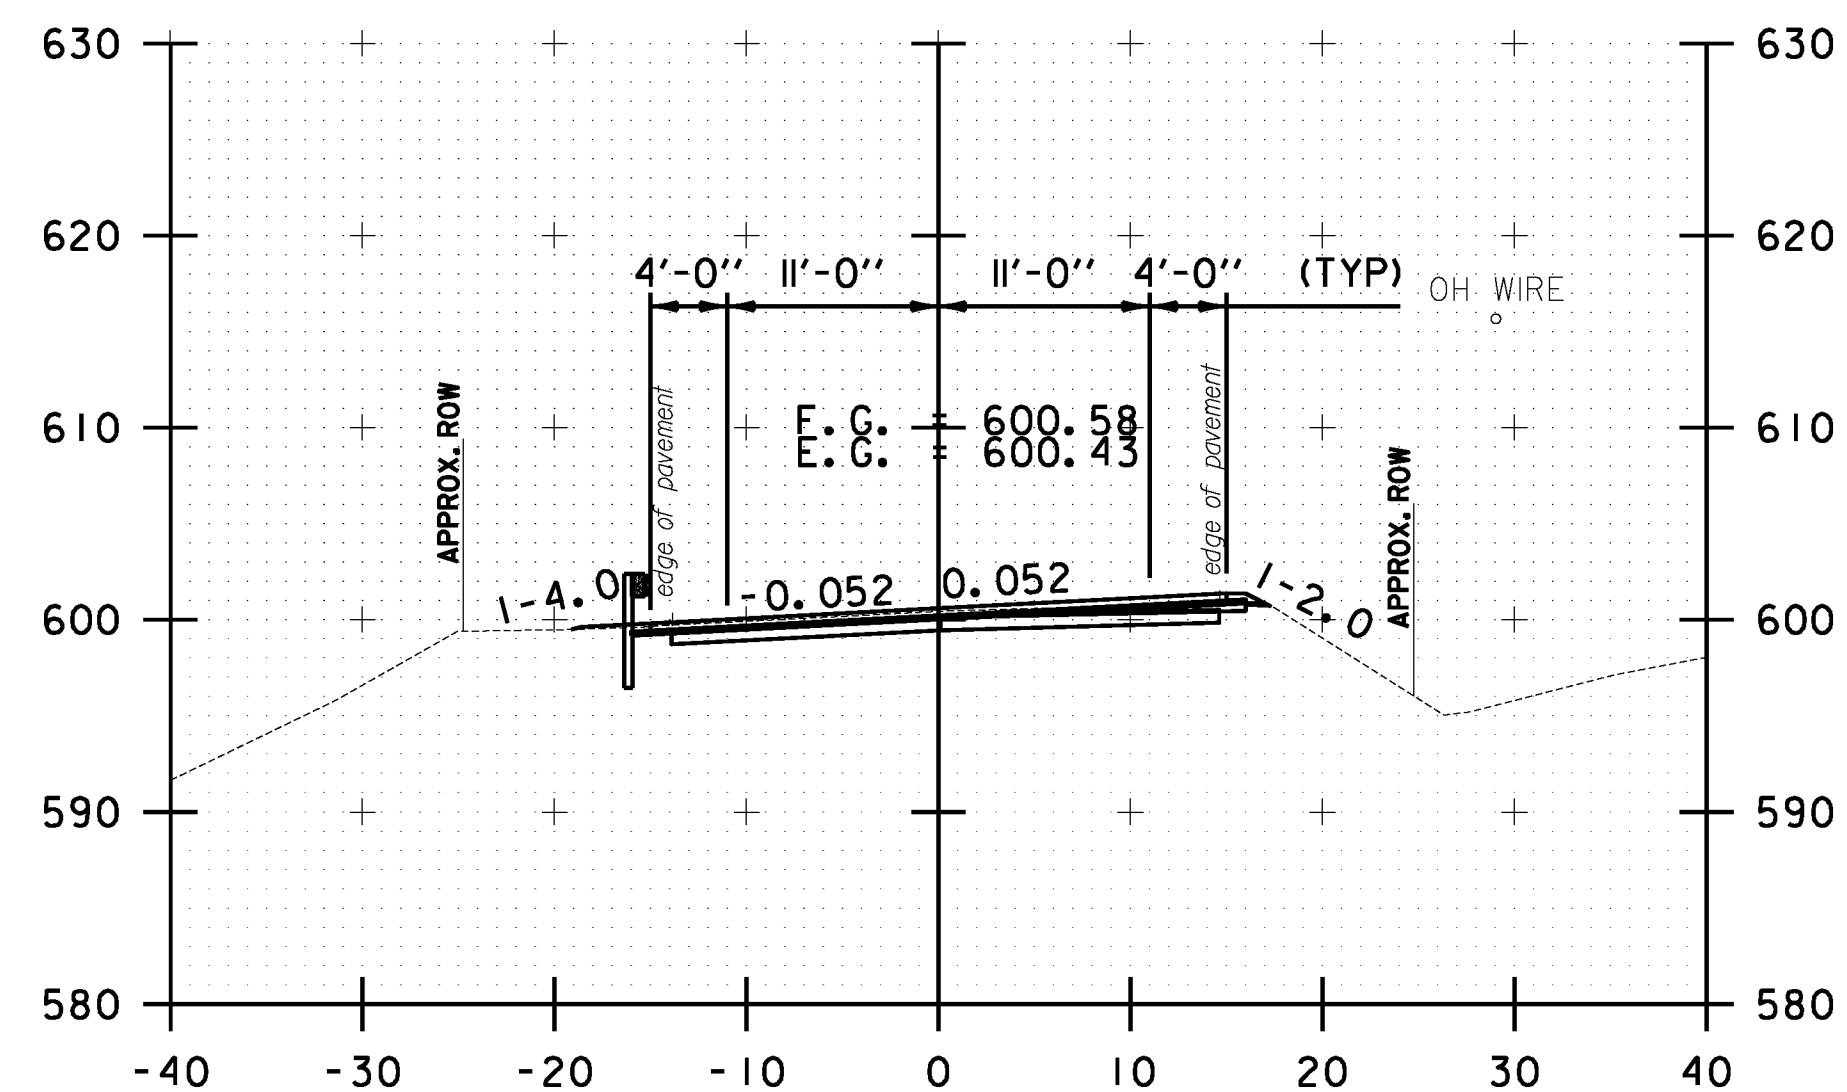


290+50.00

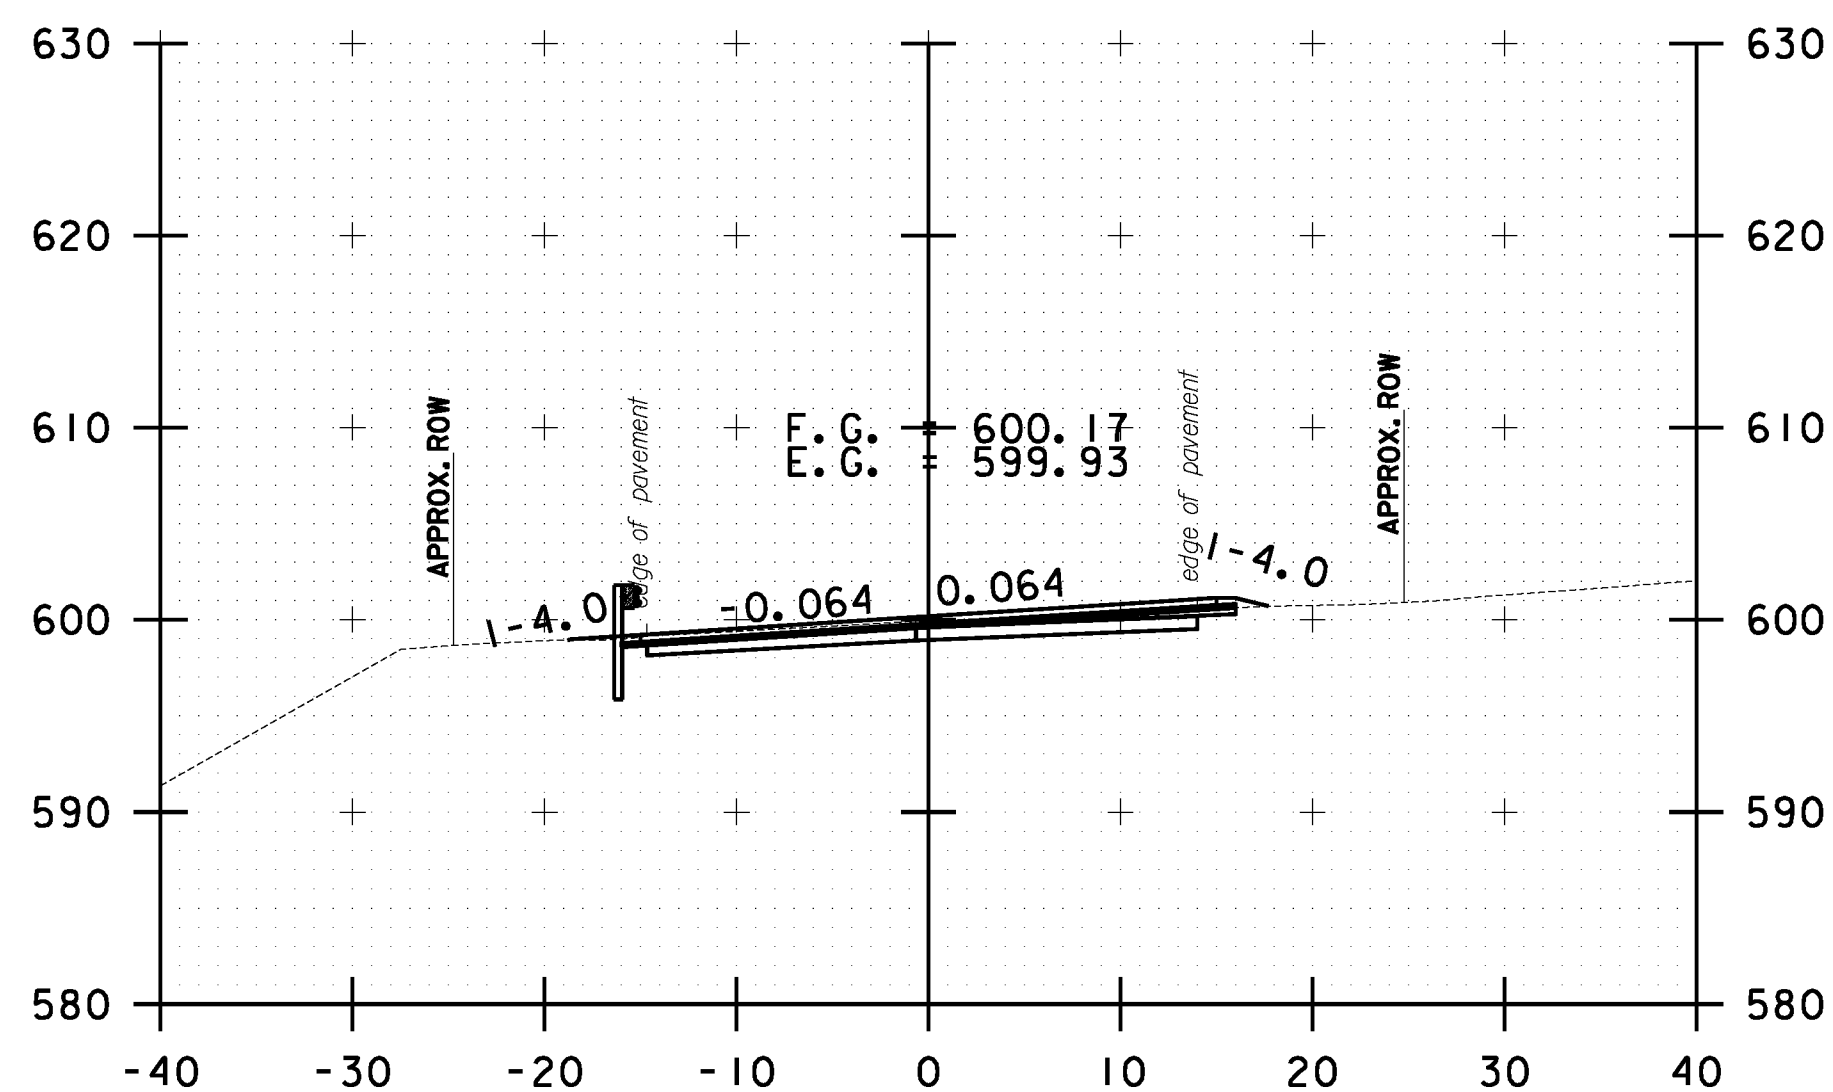

291+50.00

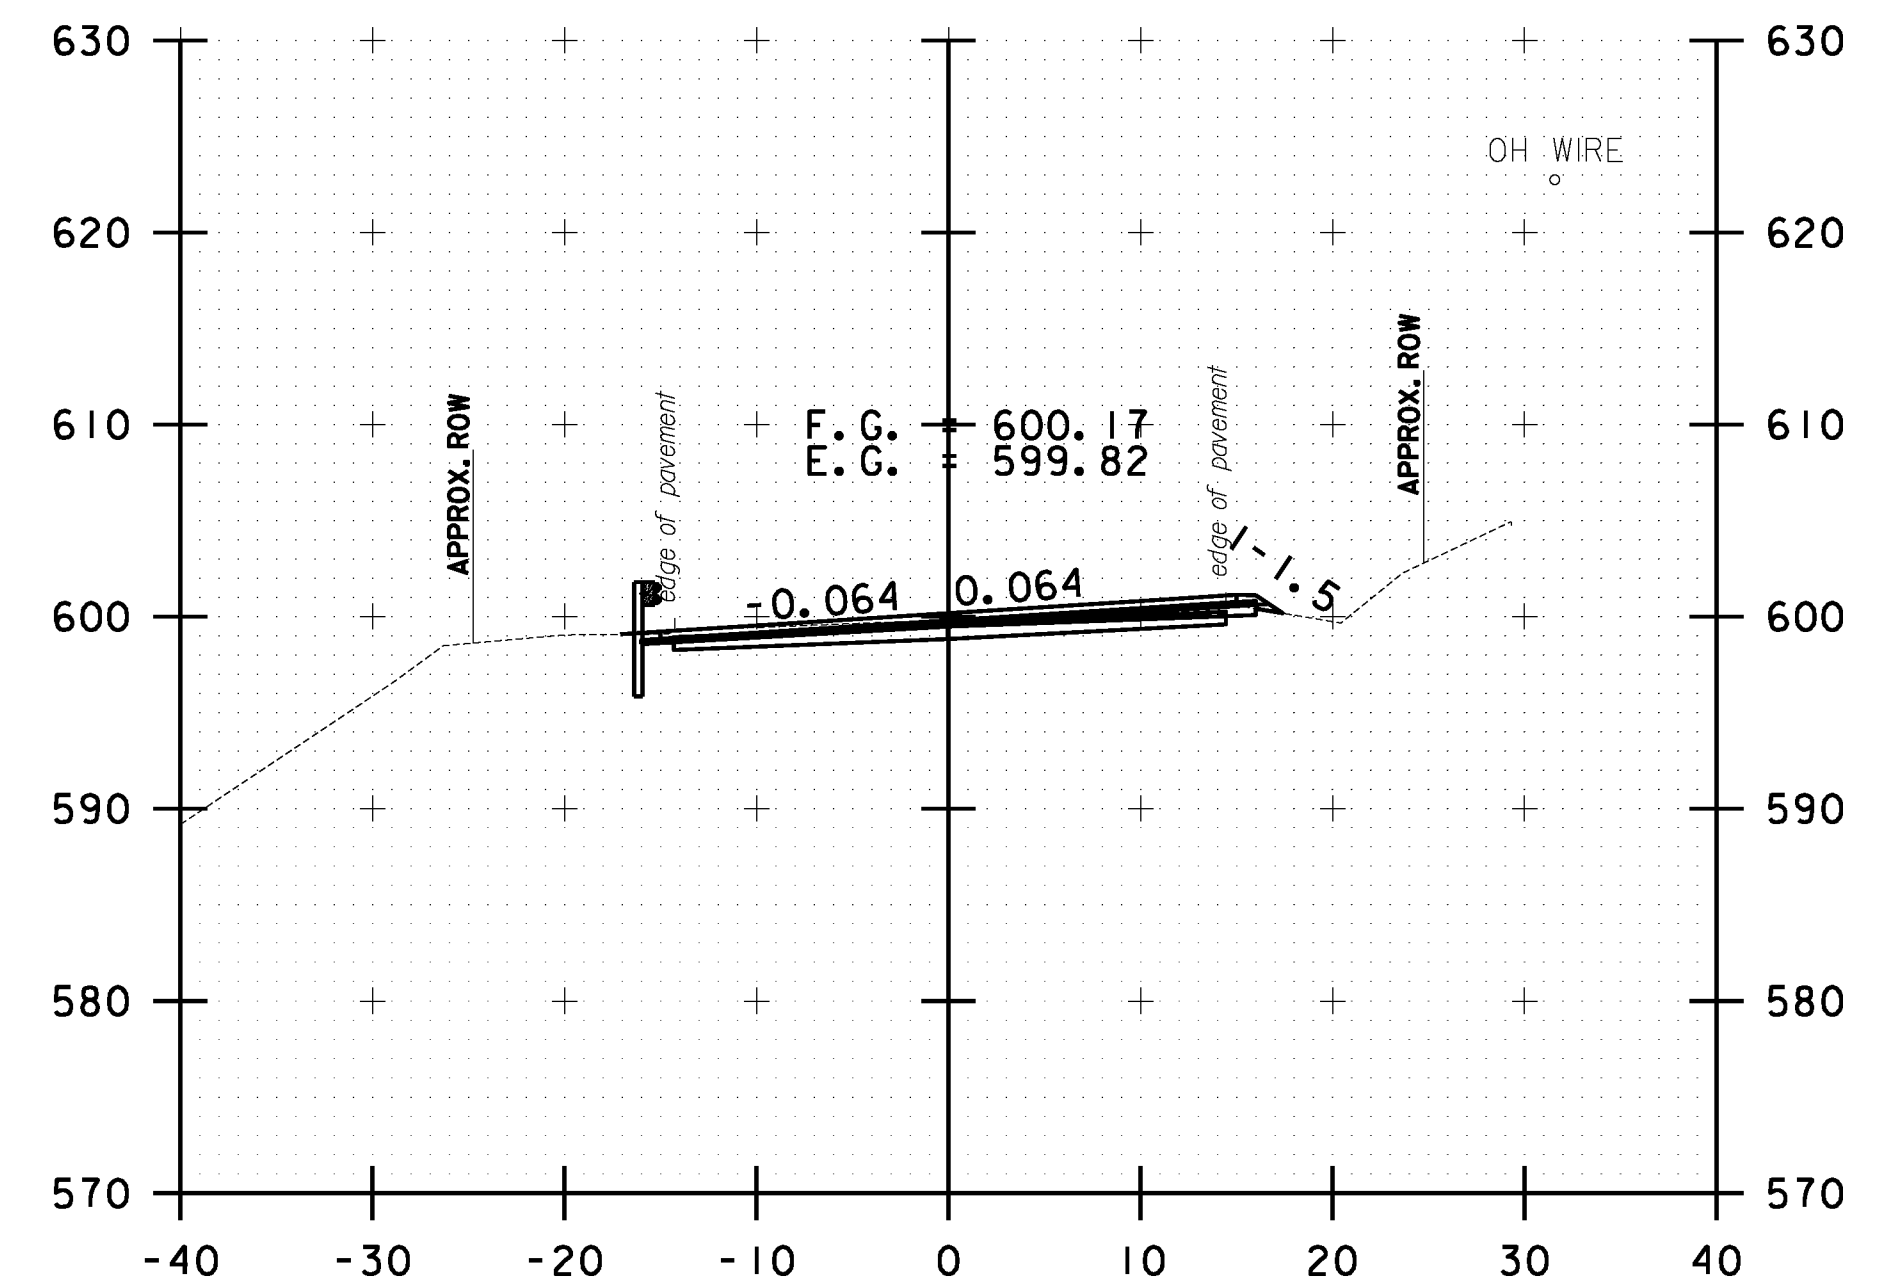

292+50.00

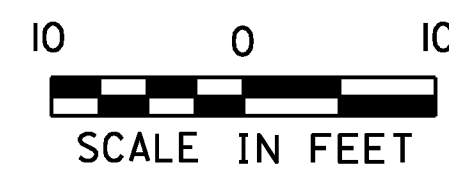

<b>STOCKBRIDGE CROSS SECTION SHEET #91</b>	PROJECT NAME: STOCKBRIDGE-BETHEL
	PROJECT NUMBER: STP 2910(1)
	FILE NAME: z10b214_stock.xc.dgn
	IPARM FILE: z10b214xs91.1
	PLOT DATE: 3/17/2014
	DRAWN BY: W.G.P.
	CHECKED BY: J.P.S.
	SHEET 304 OF 397