




FILE NAME = Y:\P\c\res\any\k2\22425\CADD\MSTN\10b214_stock_xc.dgn
 DATE/TIME = 3/17/2014
 USER = 4916

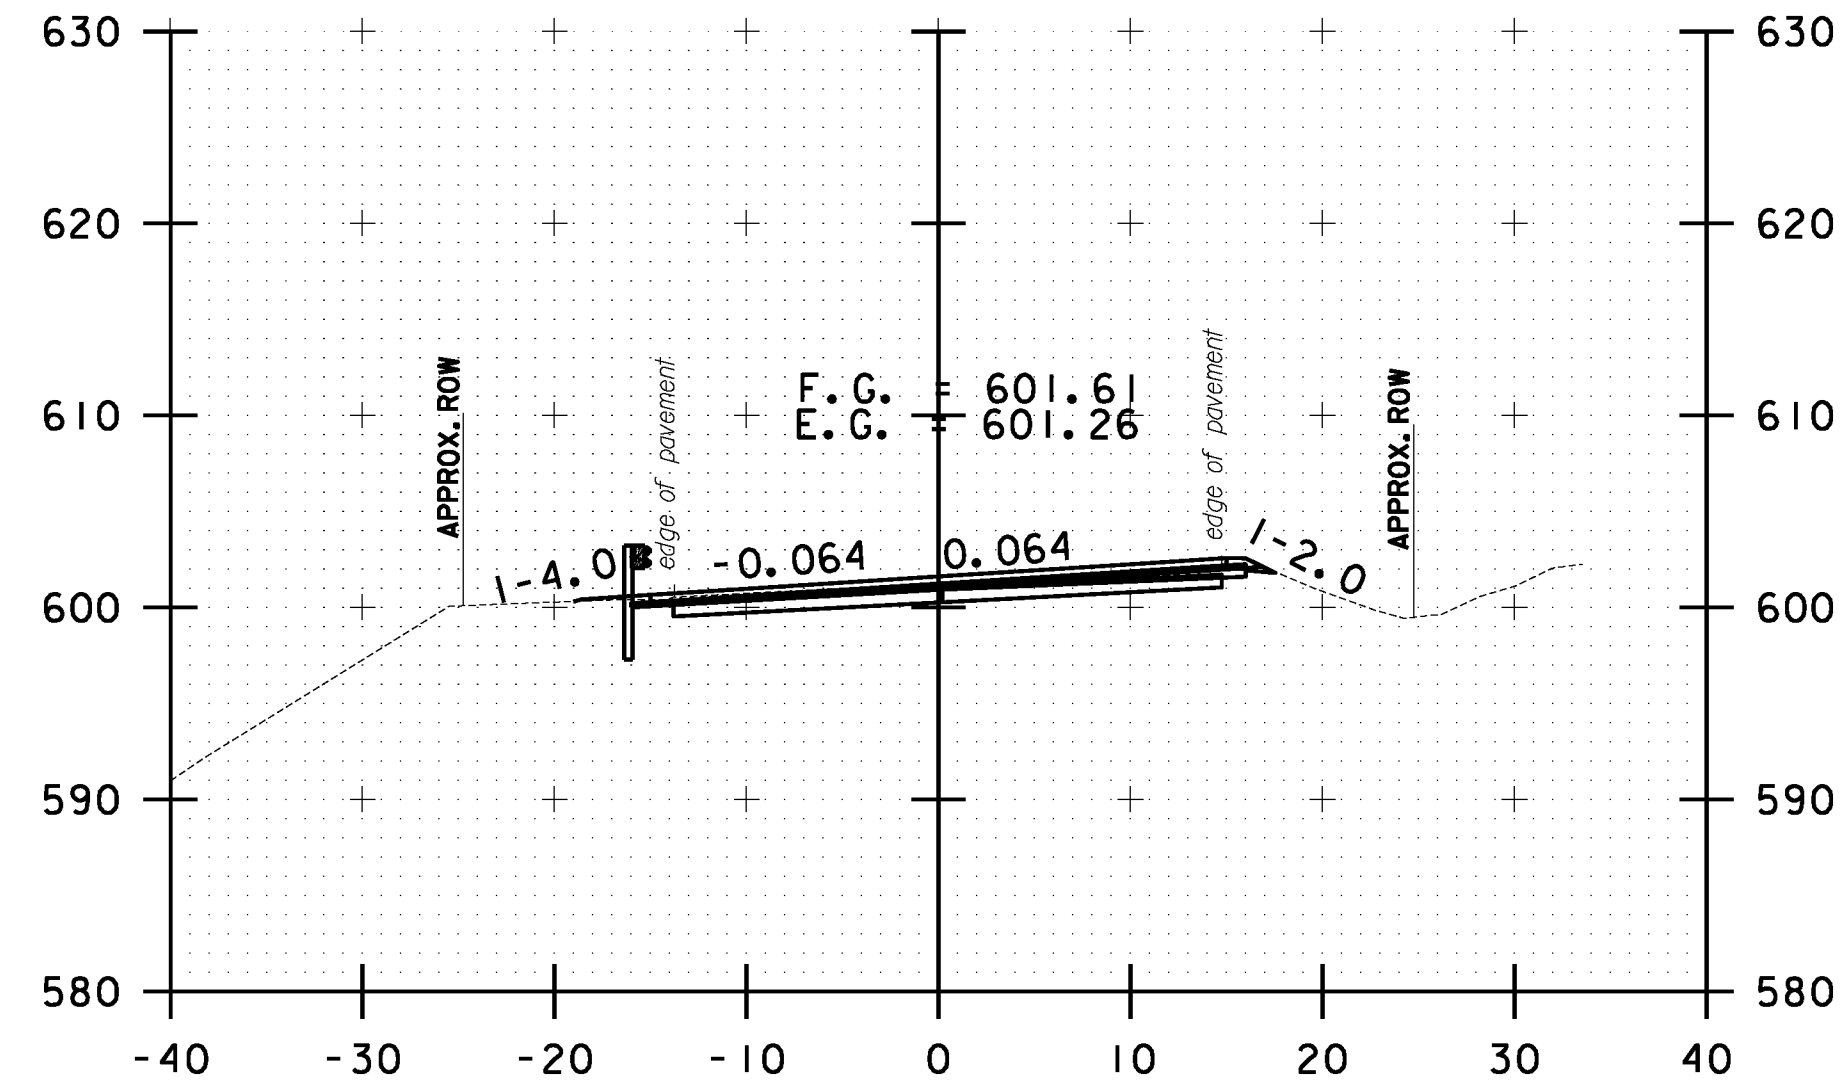


300+00.00

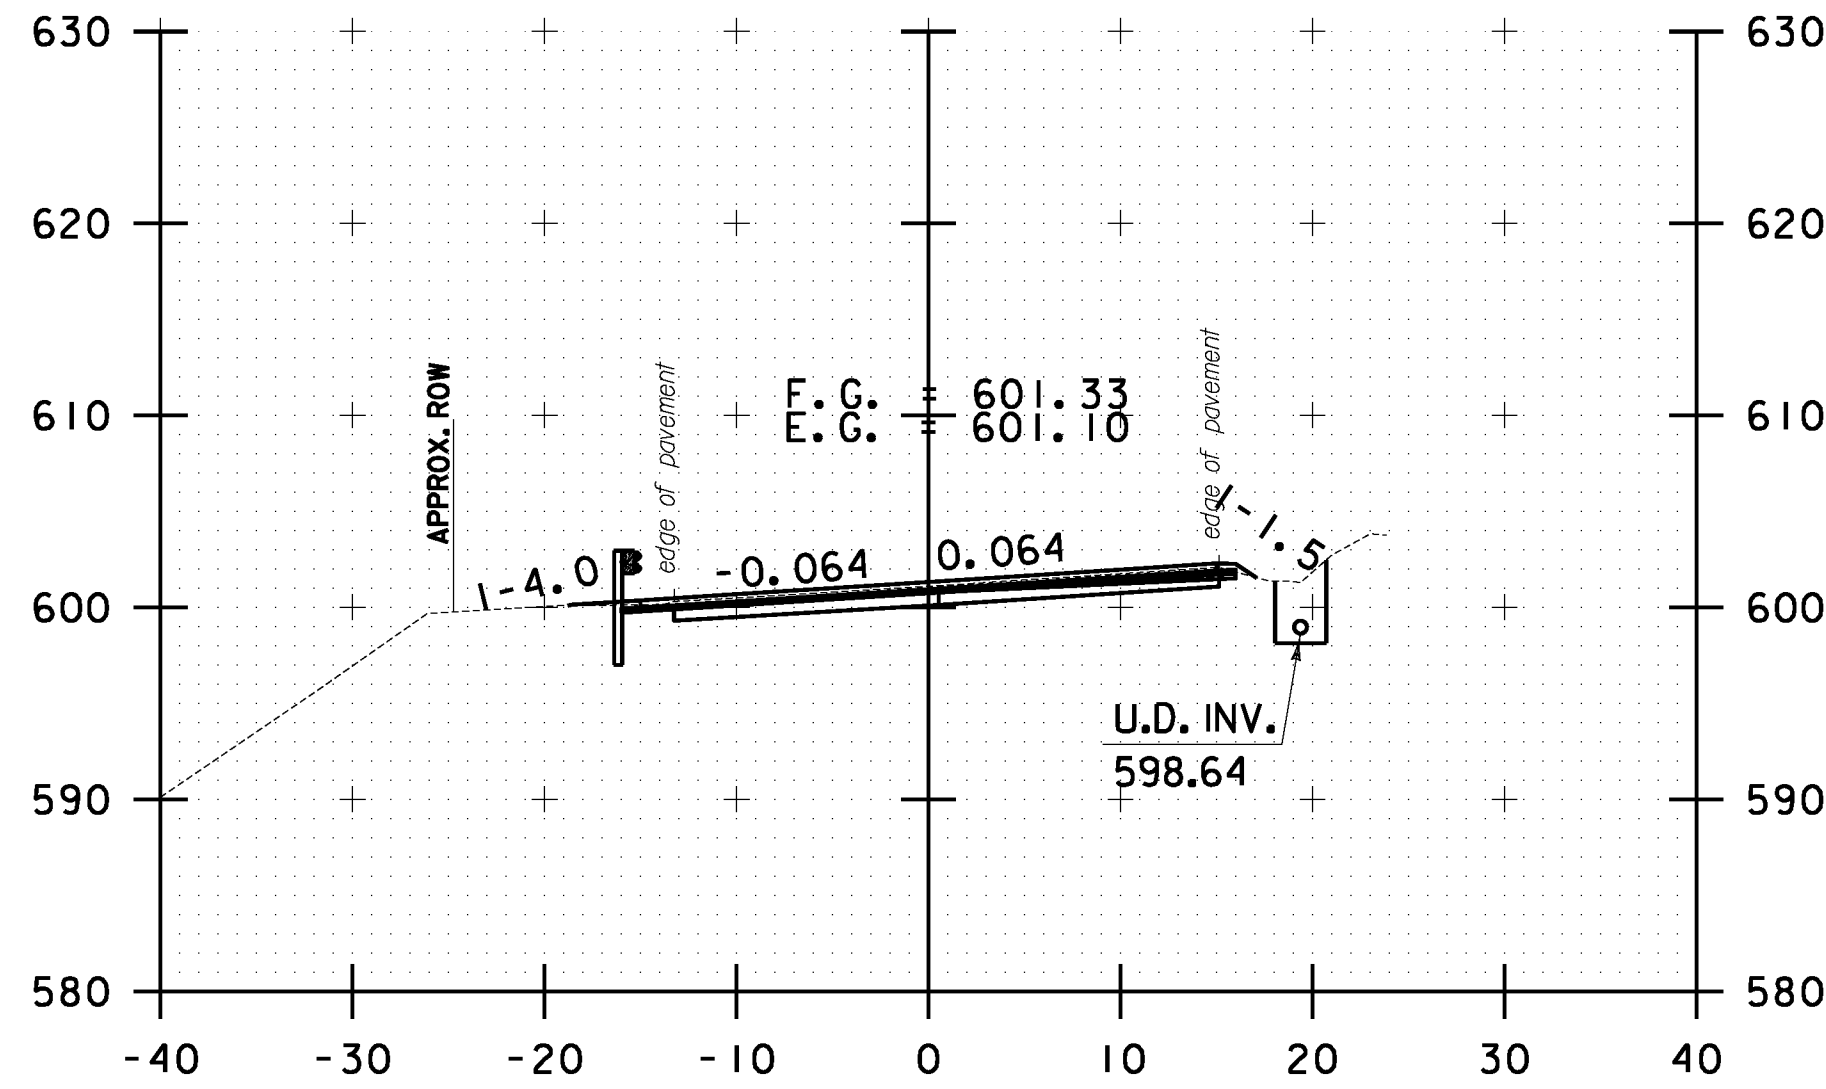


301+00.00

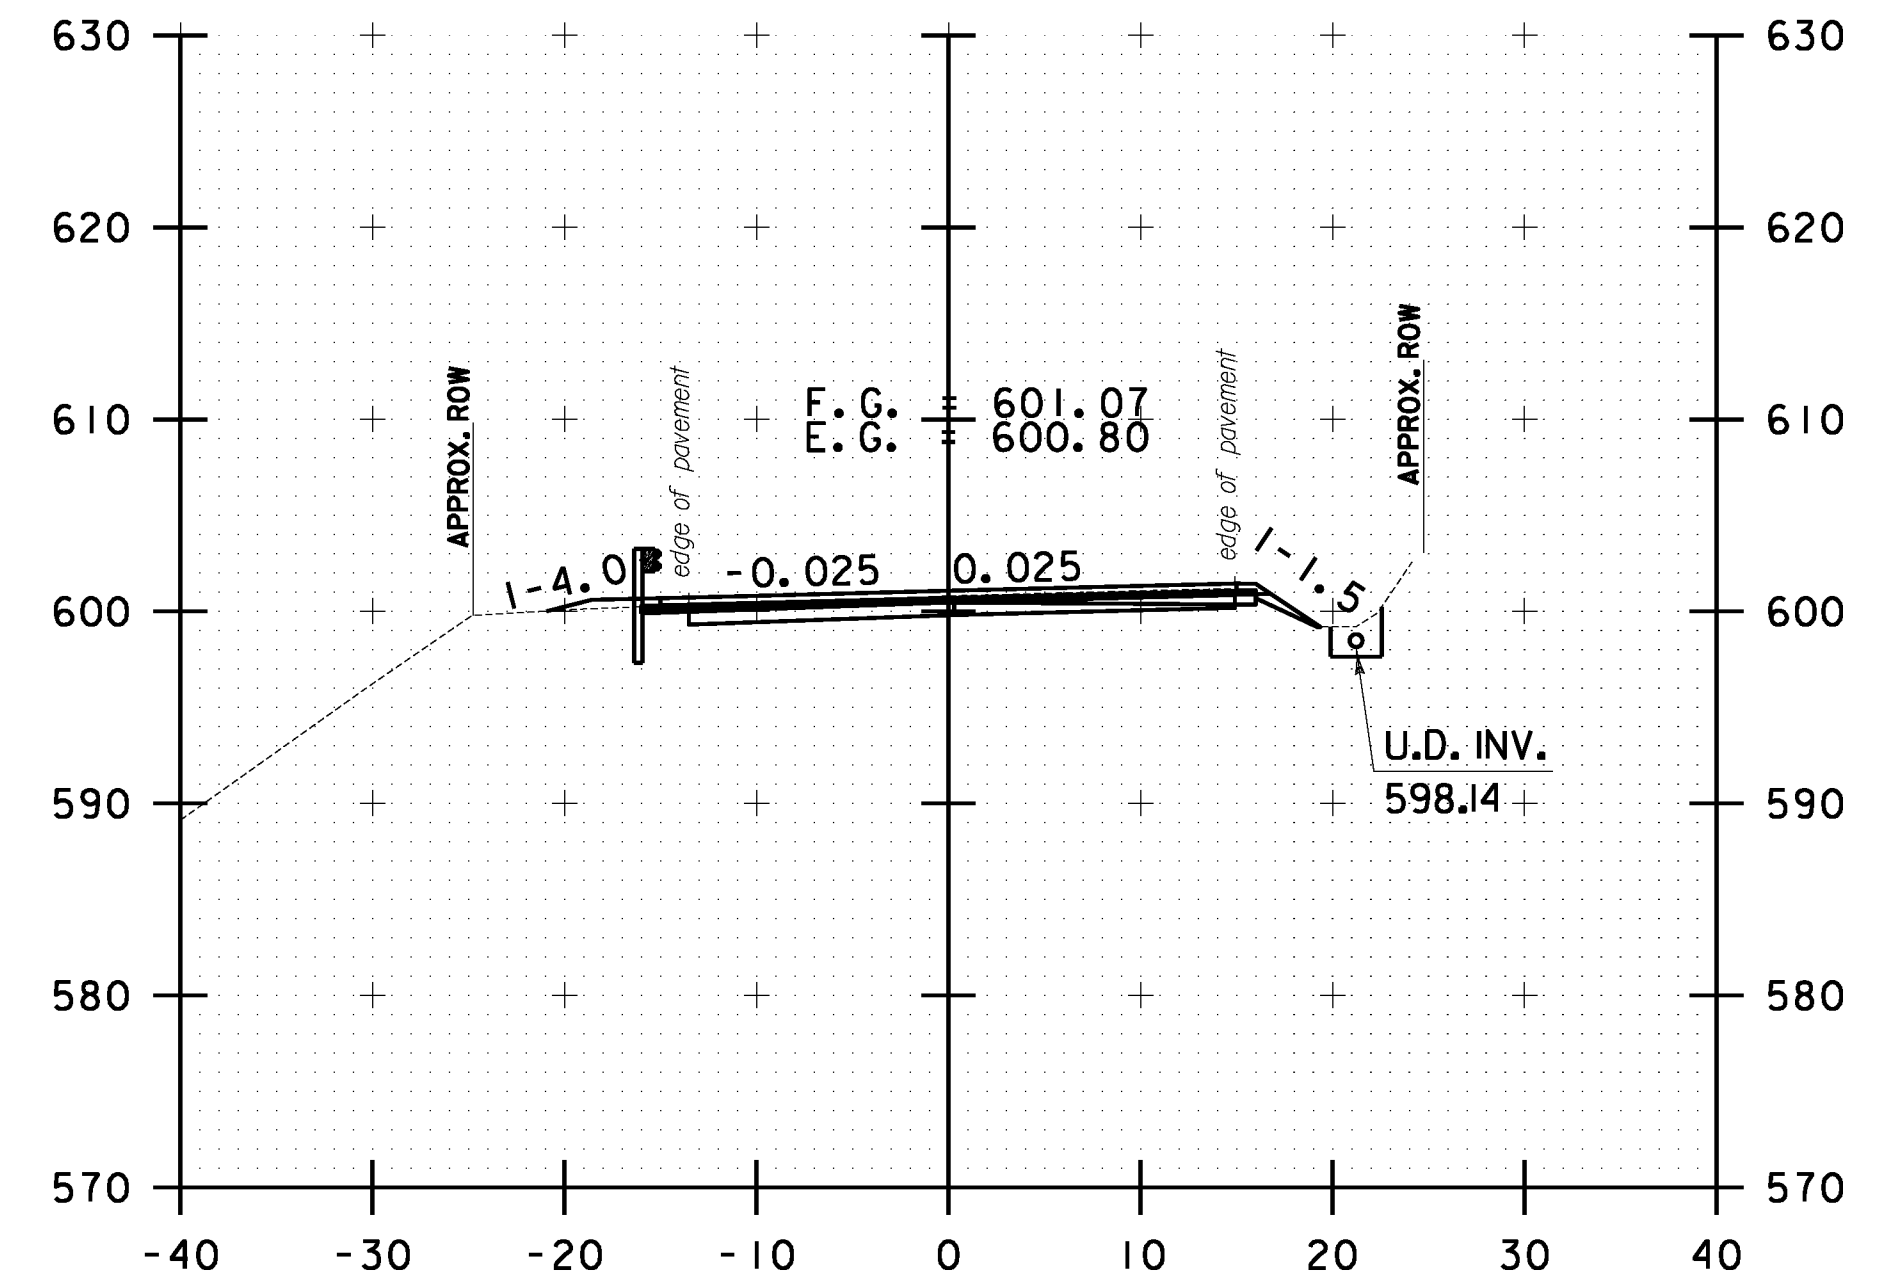


302+00.00

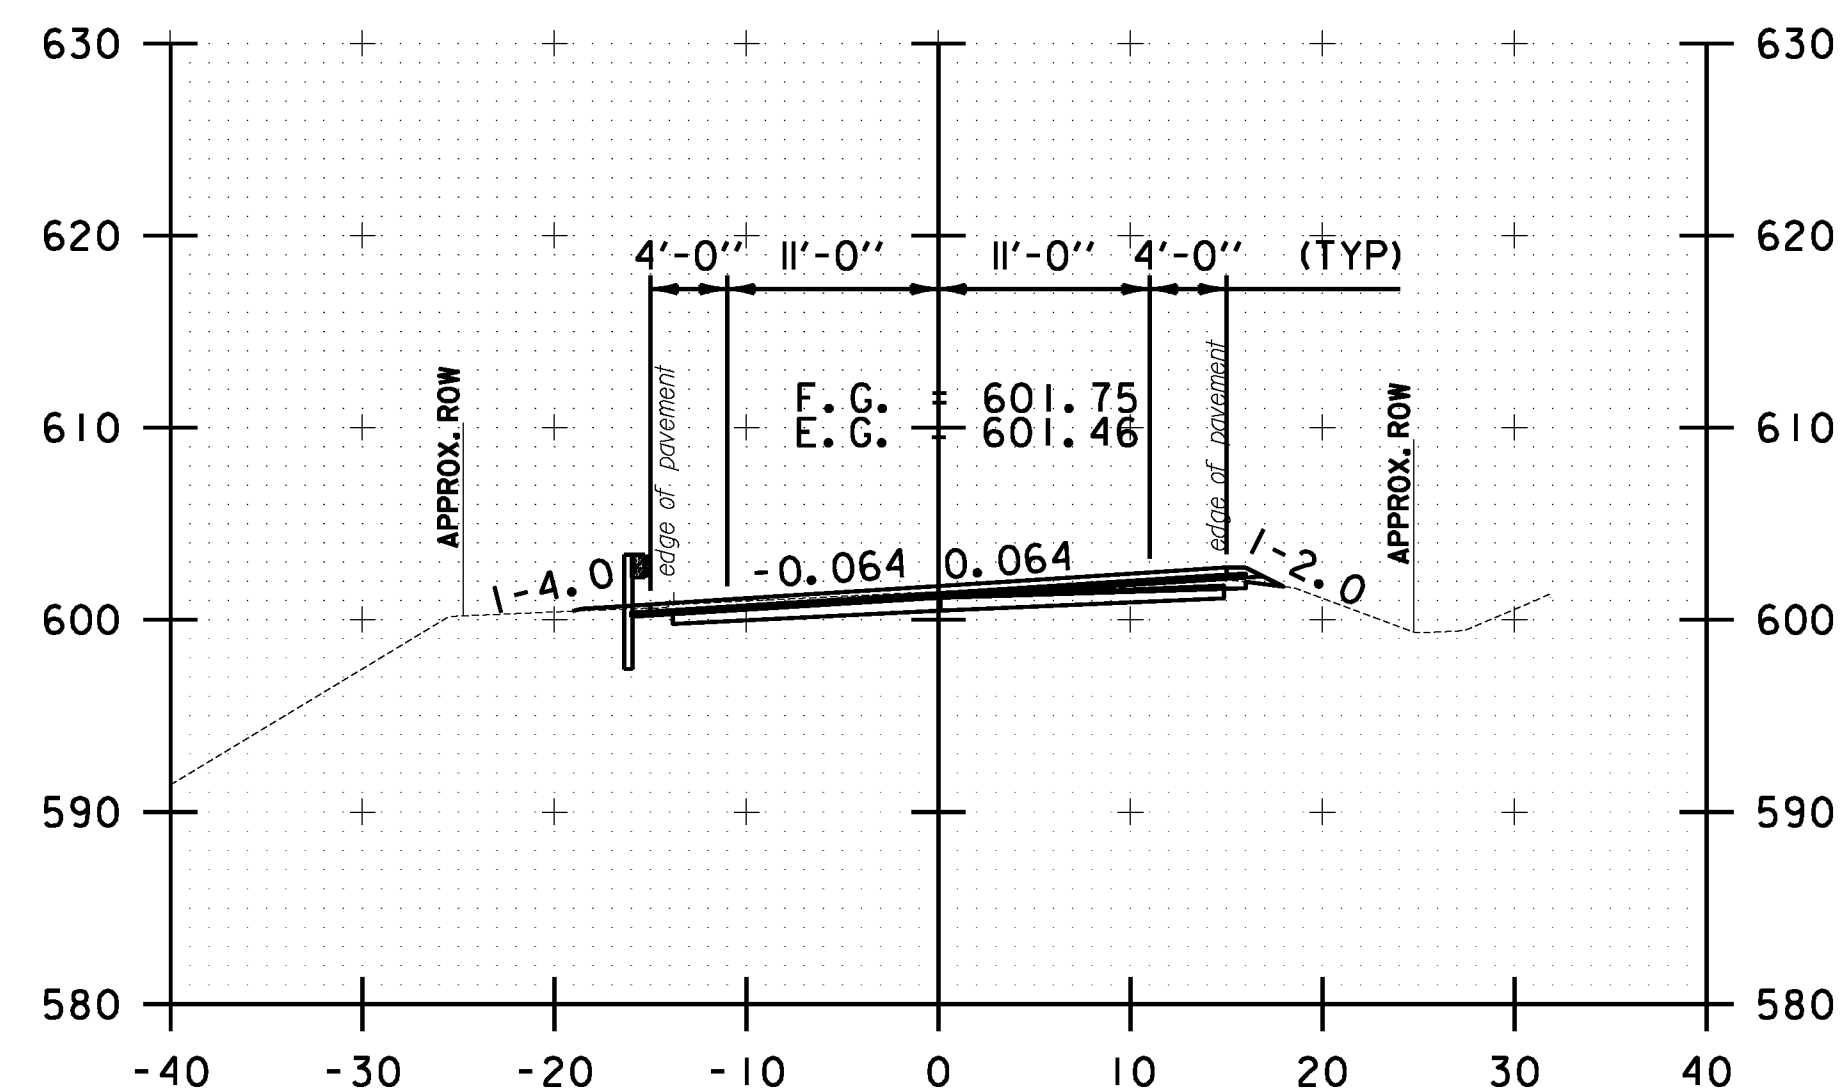


299+50.00

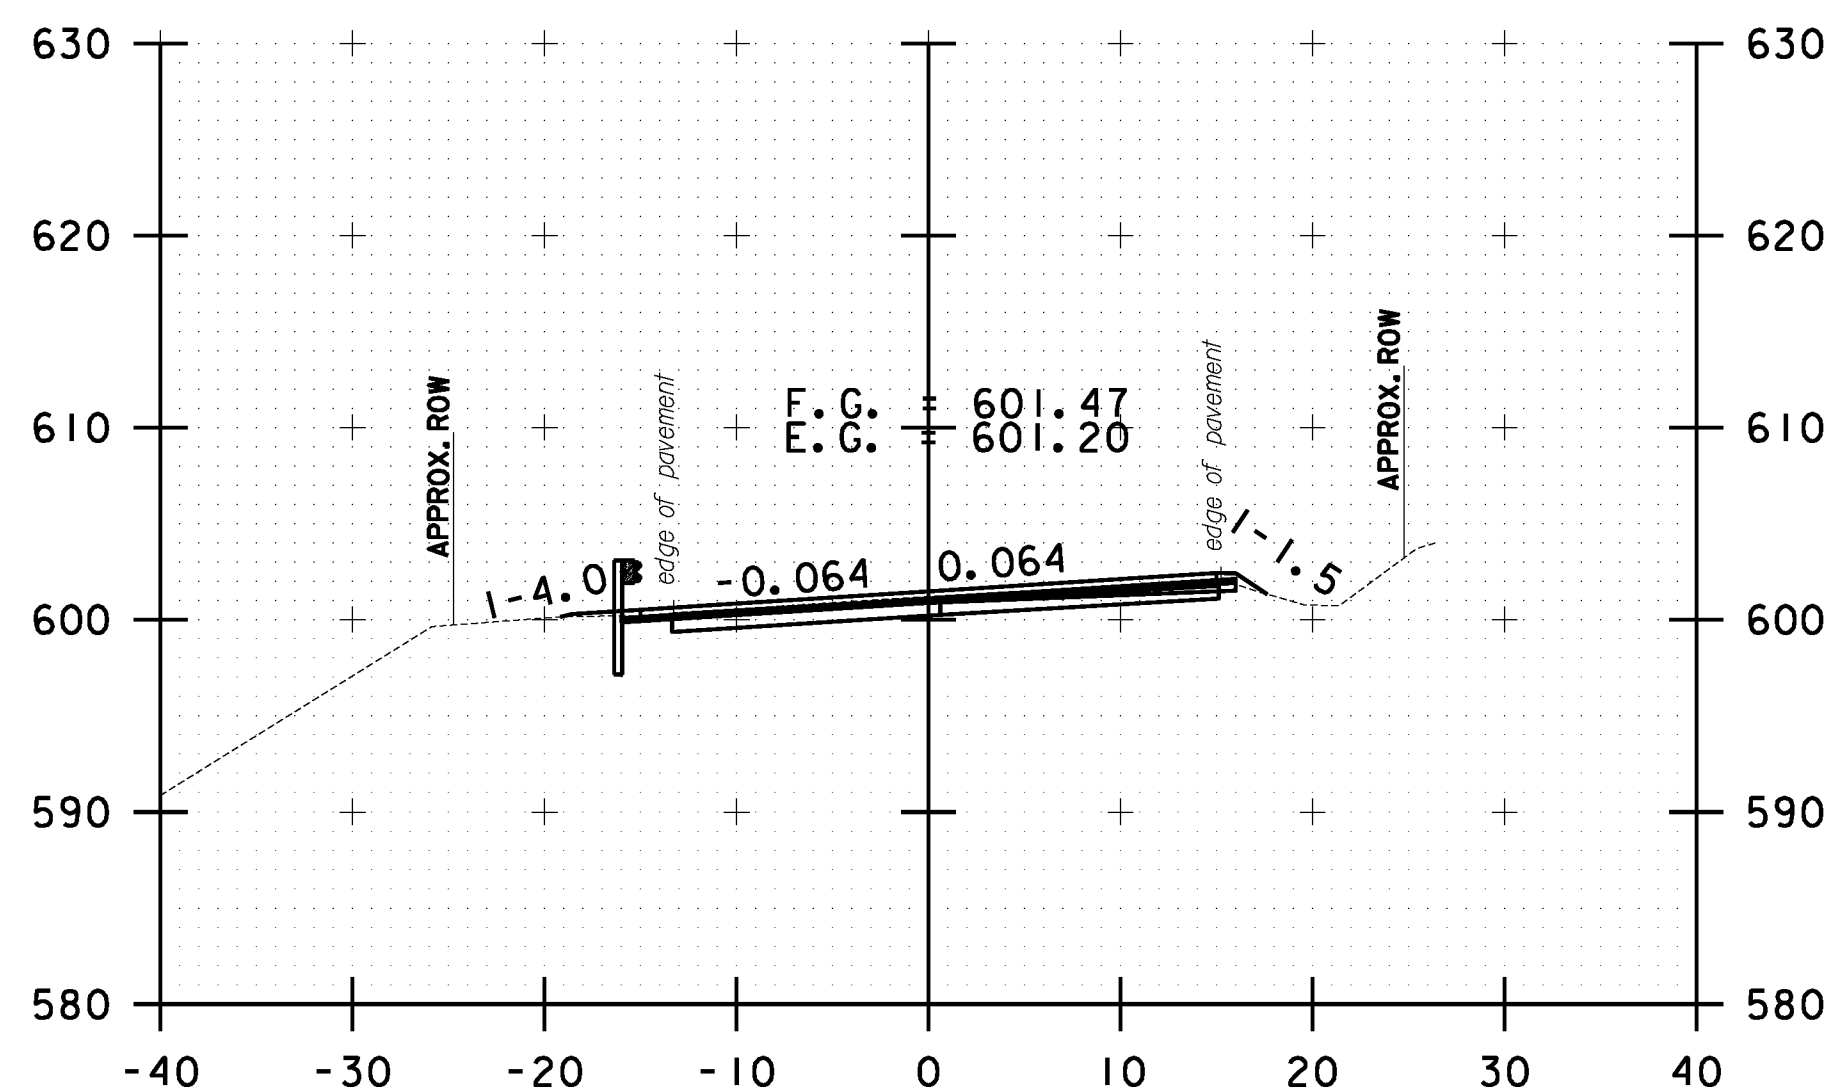

300+50.00

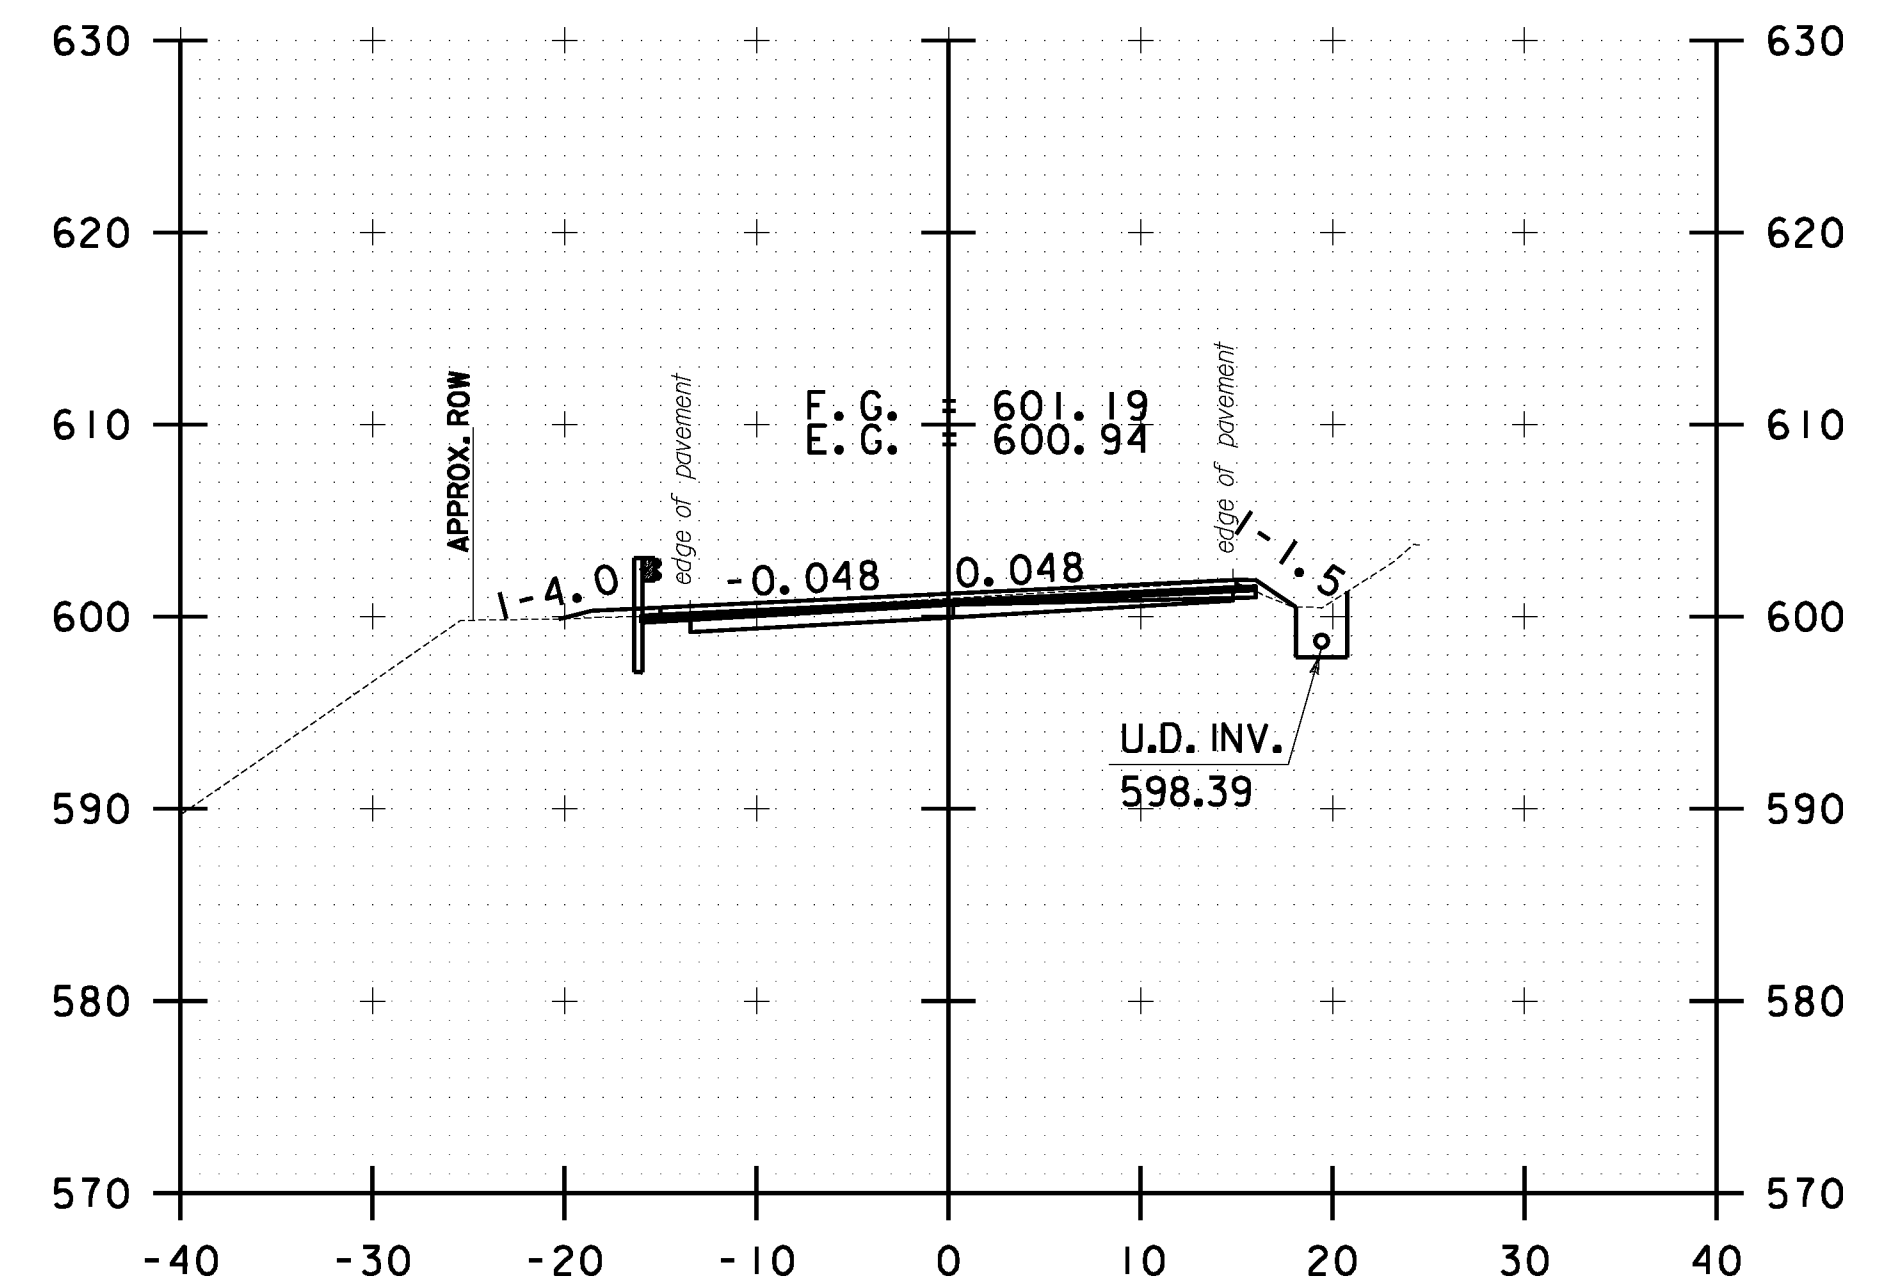

301+50.00

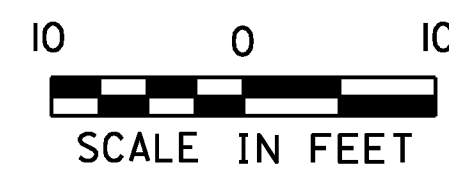

STOCKBRIDGE CROSS SECTION SHEET #94	PROJECT NAME: STOCKBRIDGE-BETHEL
	PROJECT NUMBER: STP 2910(I)
	FILE NAME: z10b214_stock_xc.dgn
	IPARM FILE: z10b214xs94.1
	PLOT DATE: 3/17/2014
	DRAWN BY: W.G.P.
	CHECKED BY: J.P.S.
	SHEET 307 OF 397