




FILE NAME = V:\P\c\projects\ANY\K2\22425\CADD\MSTN\10b214_stock_xc.dgn
 DATE/TIME = 3/17/2014
 USER = 4916

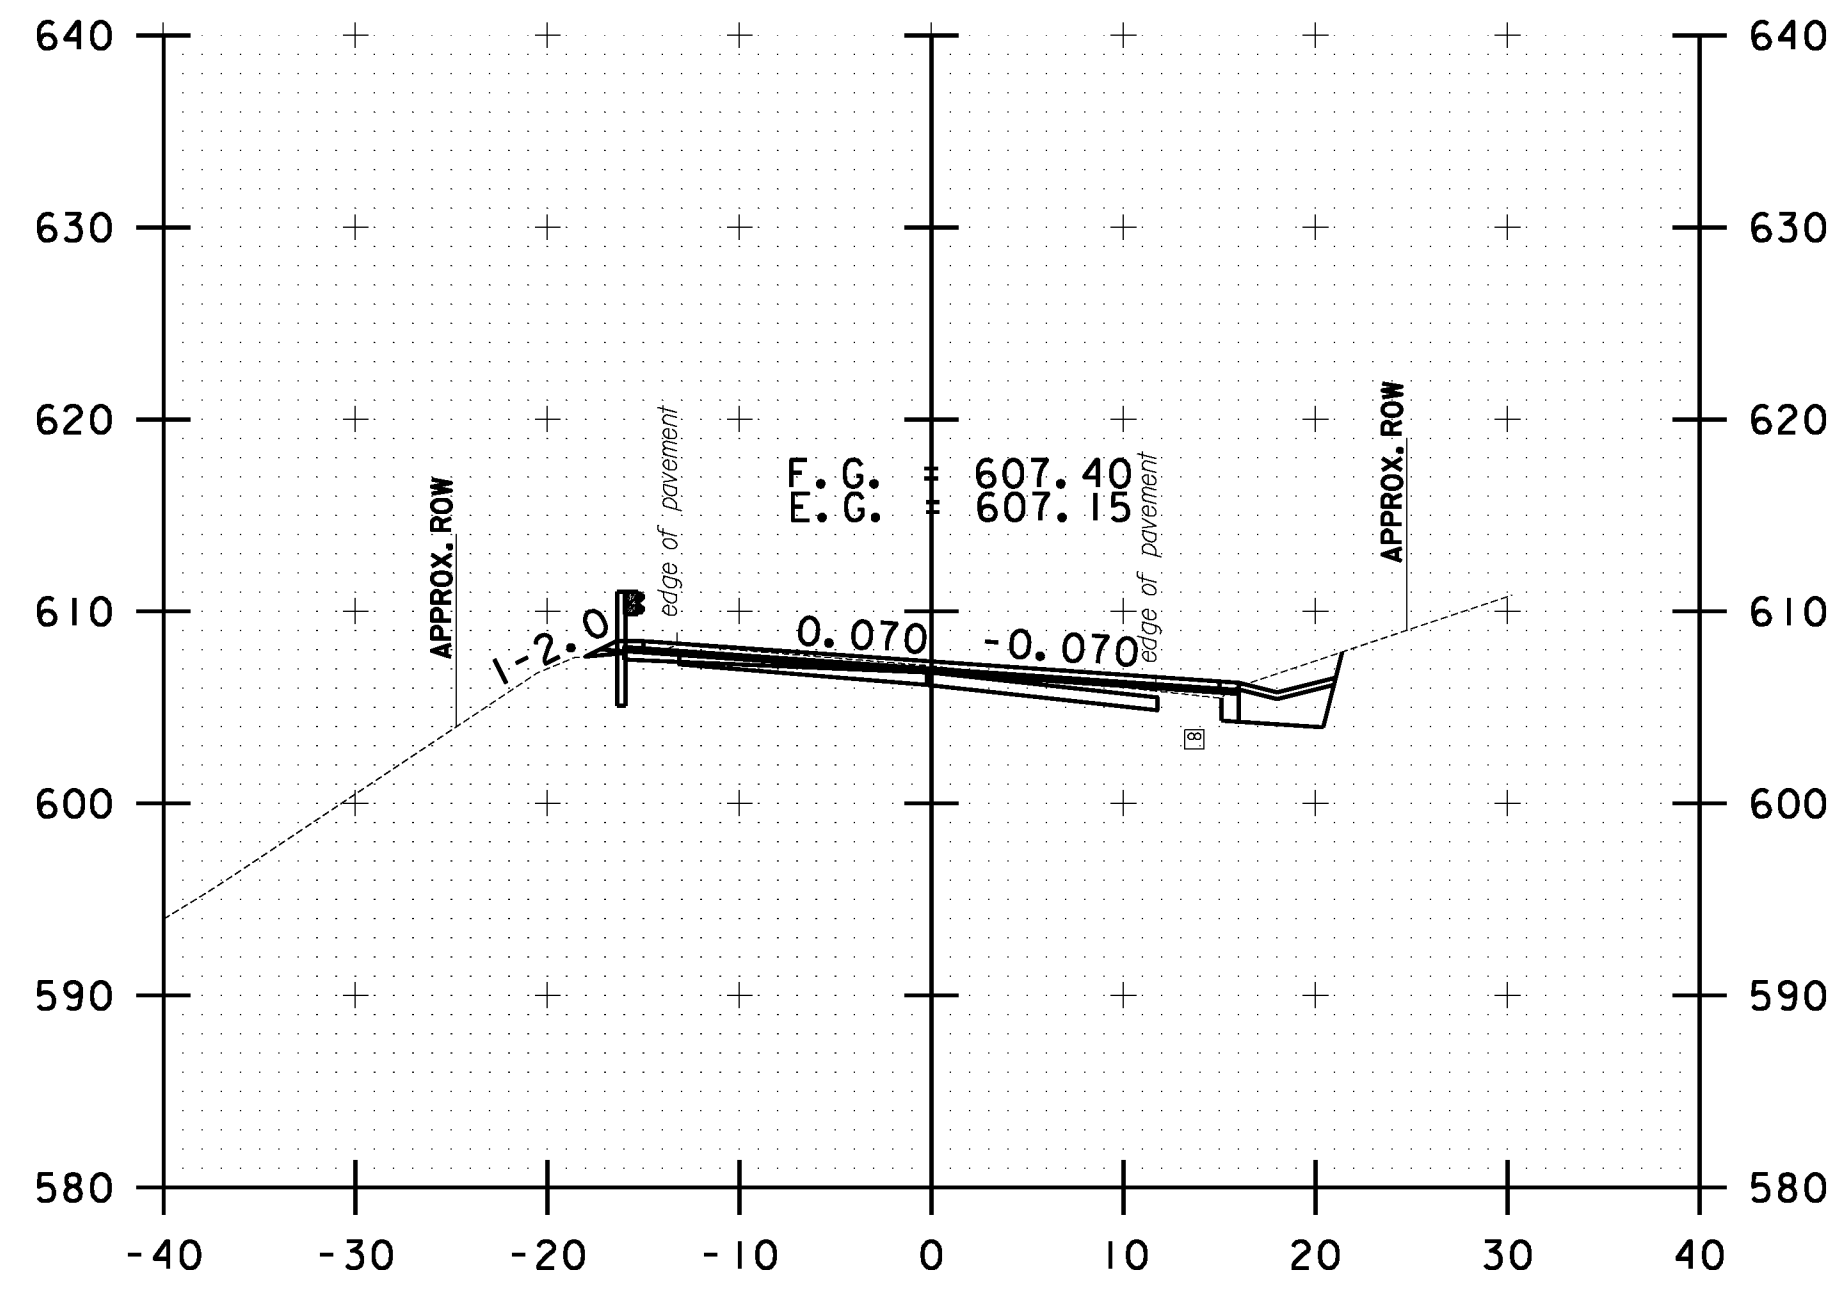


311+50.00

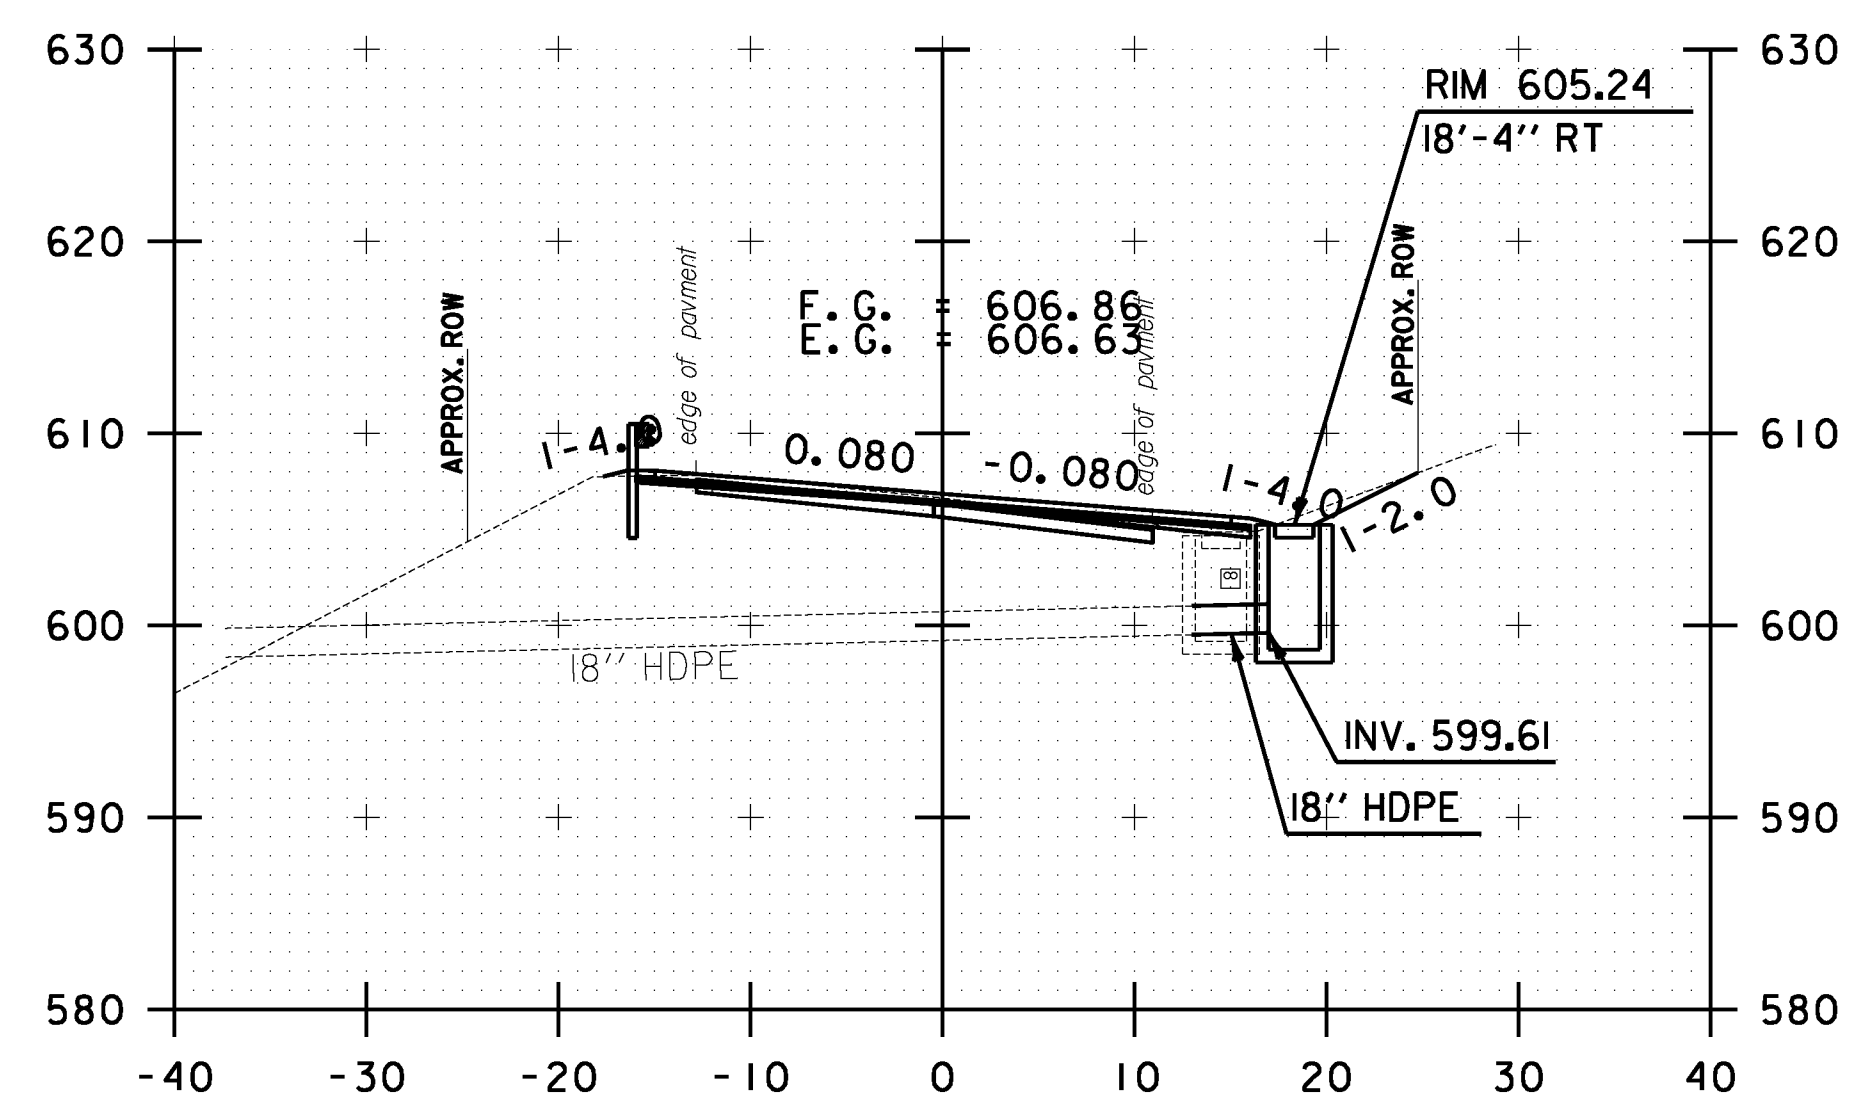


312+26.60

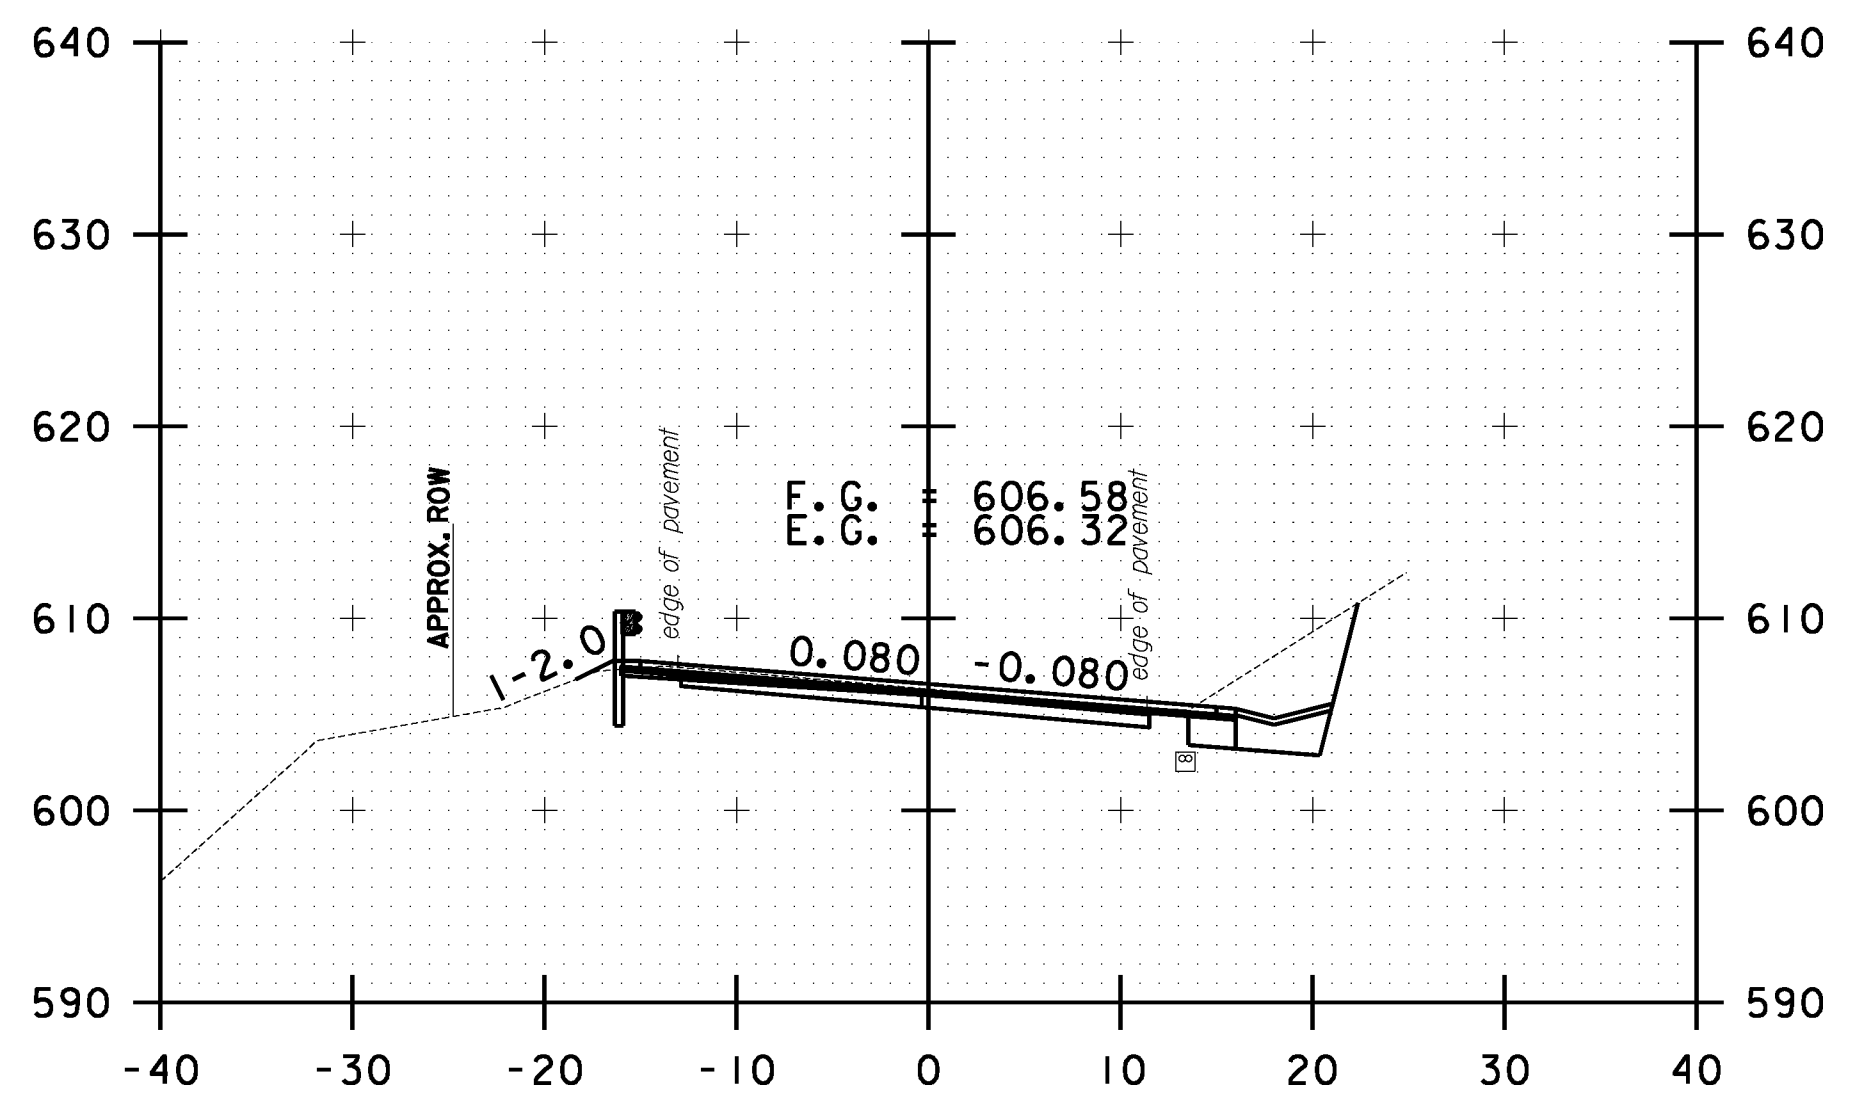


313+00.00

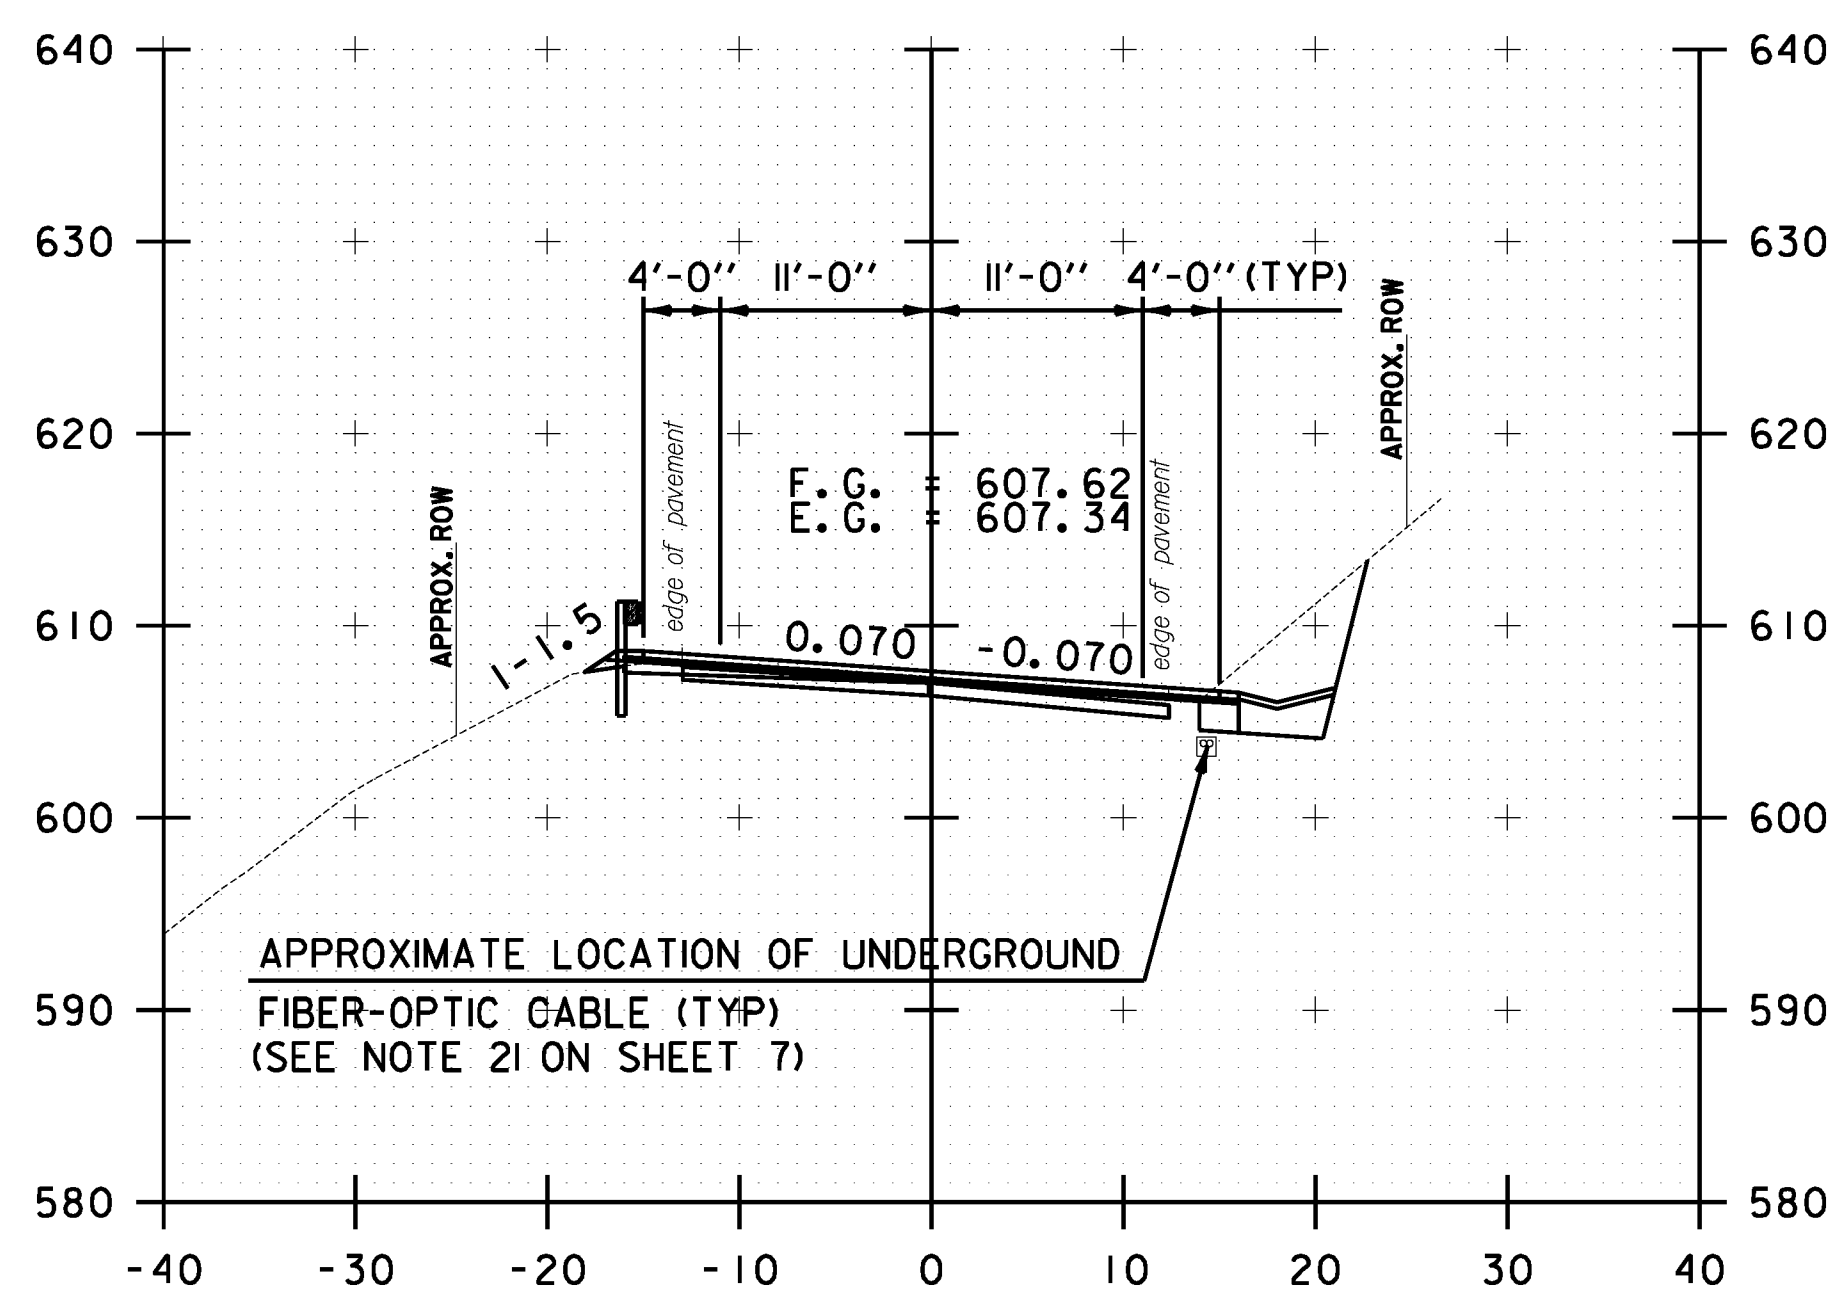


311+00.00

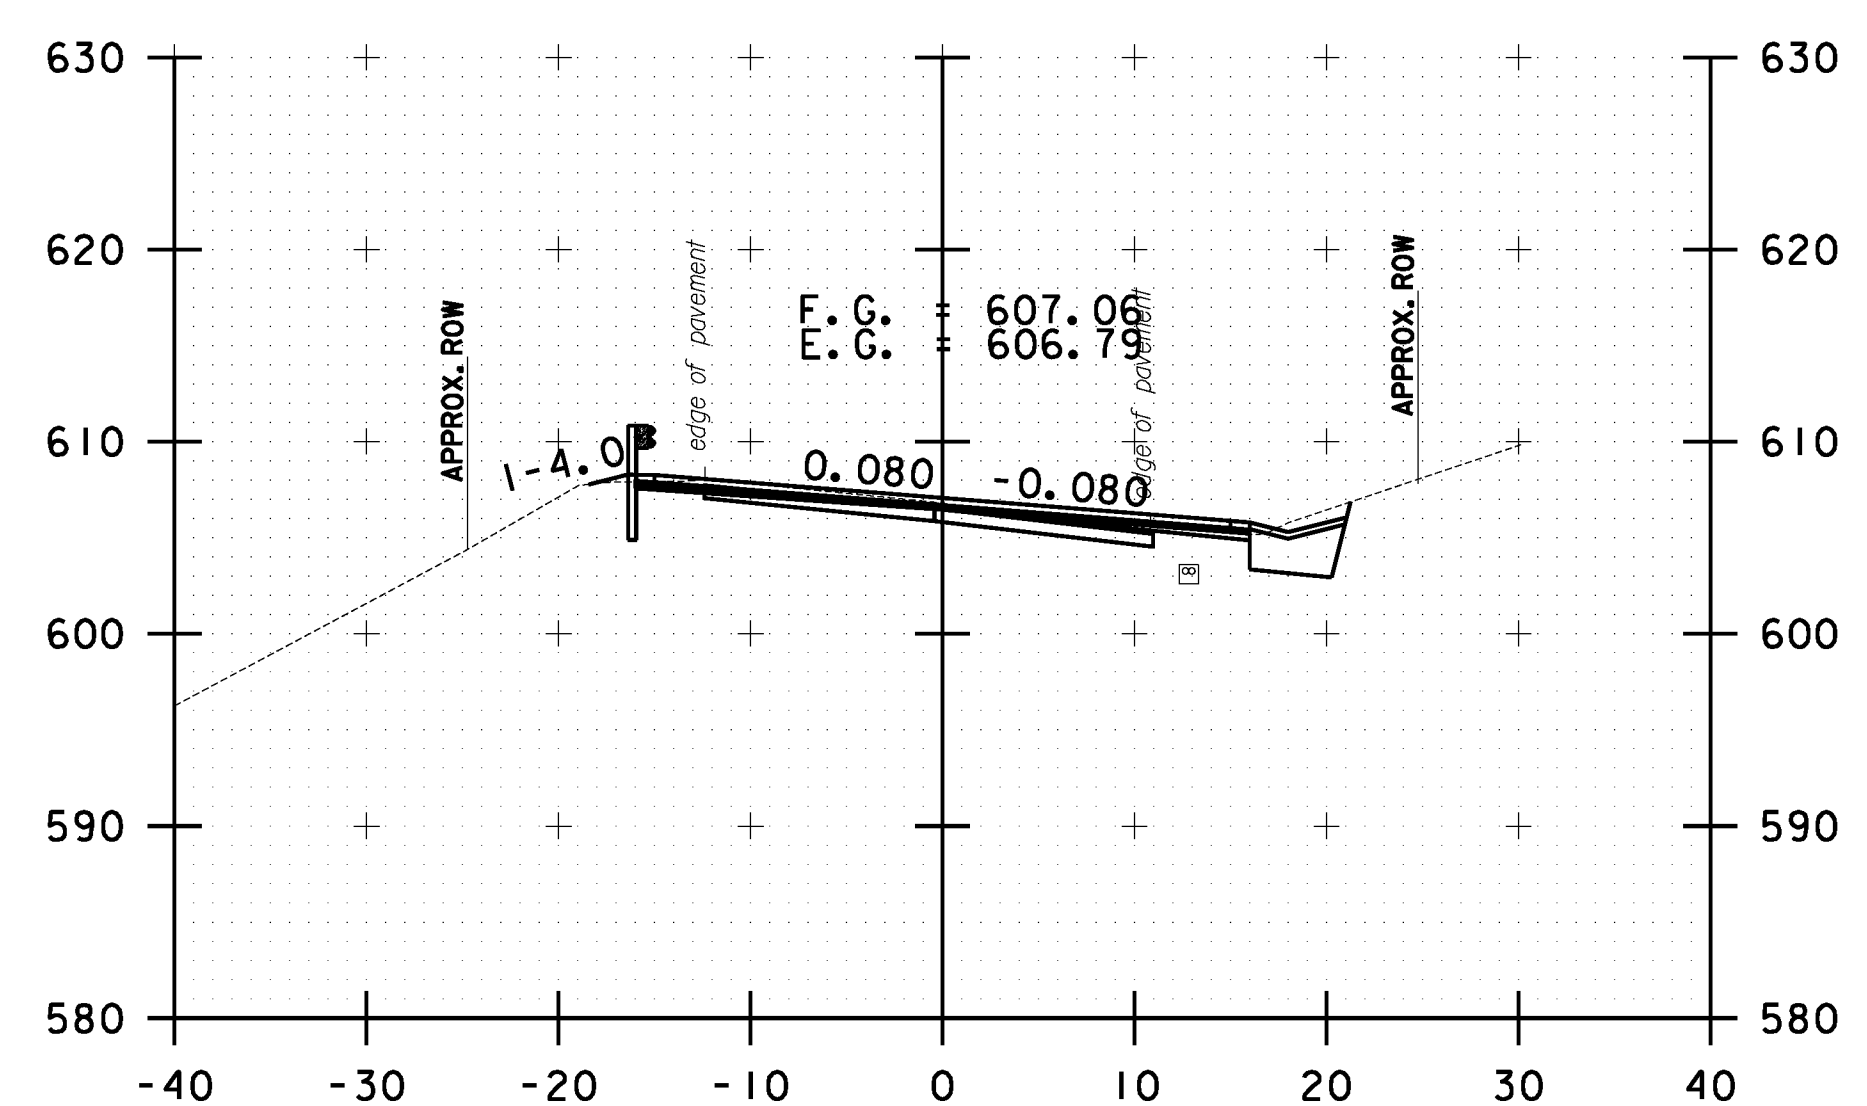

312+00.00

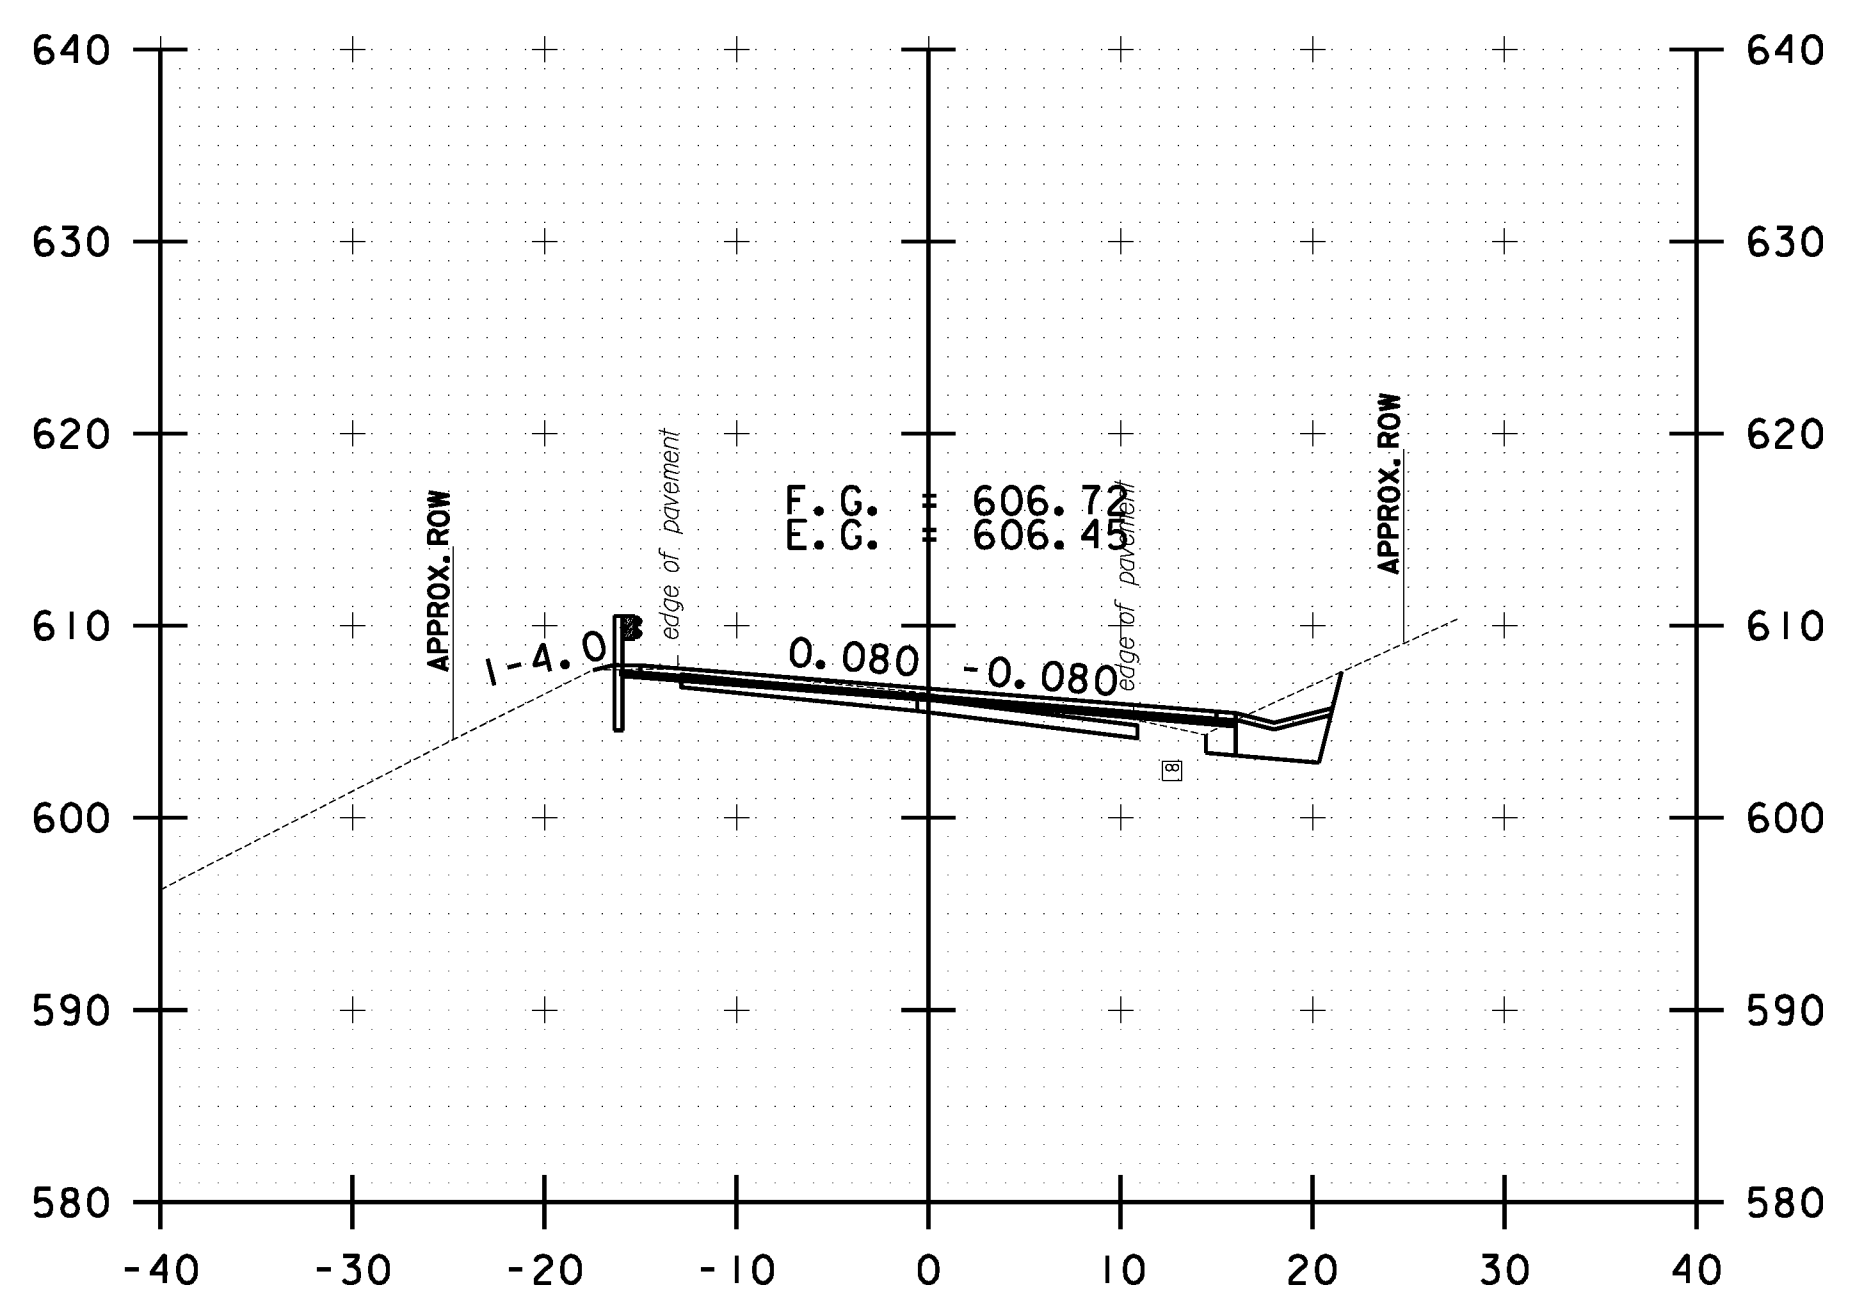

312+50.00

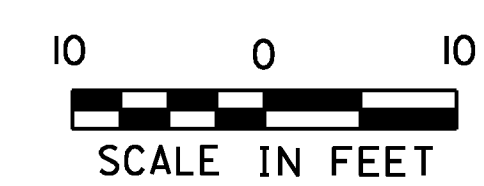

STOCKBRIDGE CROSS SECTION SHEET #98	PROJECT NAME: STOCKBRIDGE-BETHEL
	PROJECT NUMBER: STP 2910(1)
	FILE NAME: z10b214_stock_xc.dgn
	IPARM FILE: z10b214xs98.1
	PLOT DATE: 3/17/2014
	DRAWN BY: W.G.P.
	CHECKED BY: J.P.S.
	SHEET 311 OF 397