




FILE NAME = Y:\P\c\p\stock\ANY\X2\22426\CADD\MSTN\10b214_stock_xc.dgn
 DATE/TIME = 3/17/2014
 USER = 4916

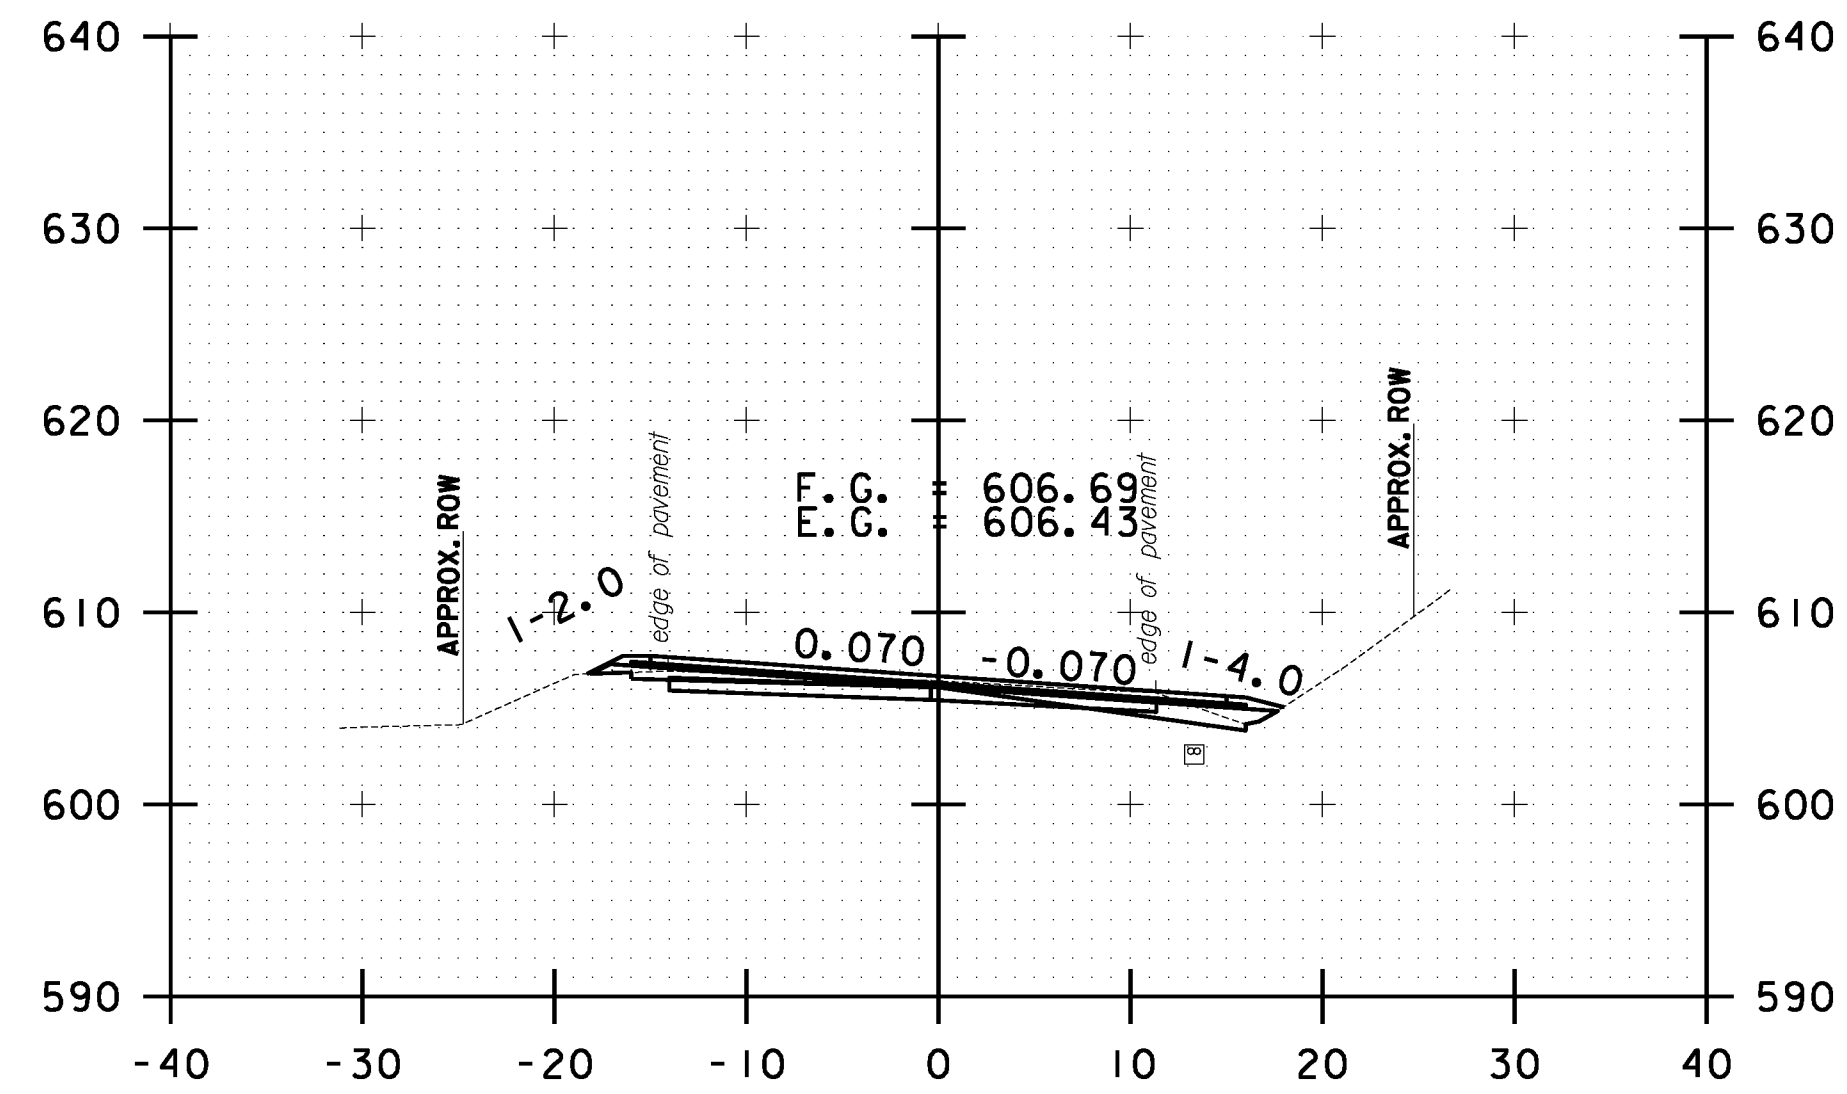


314+00.00

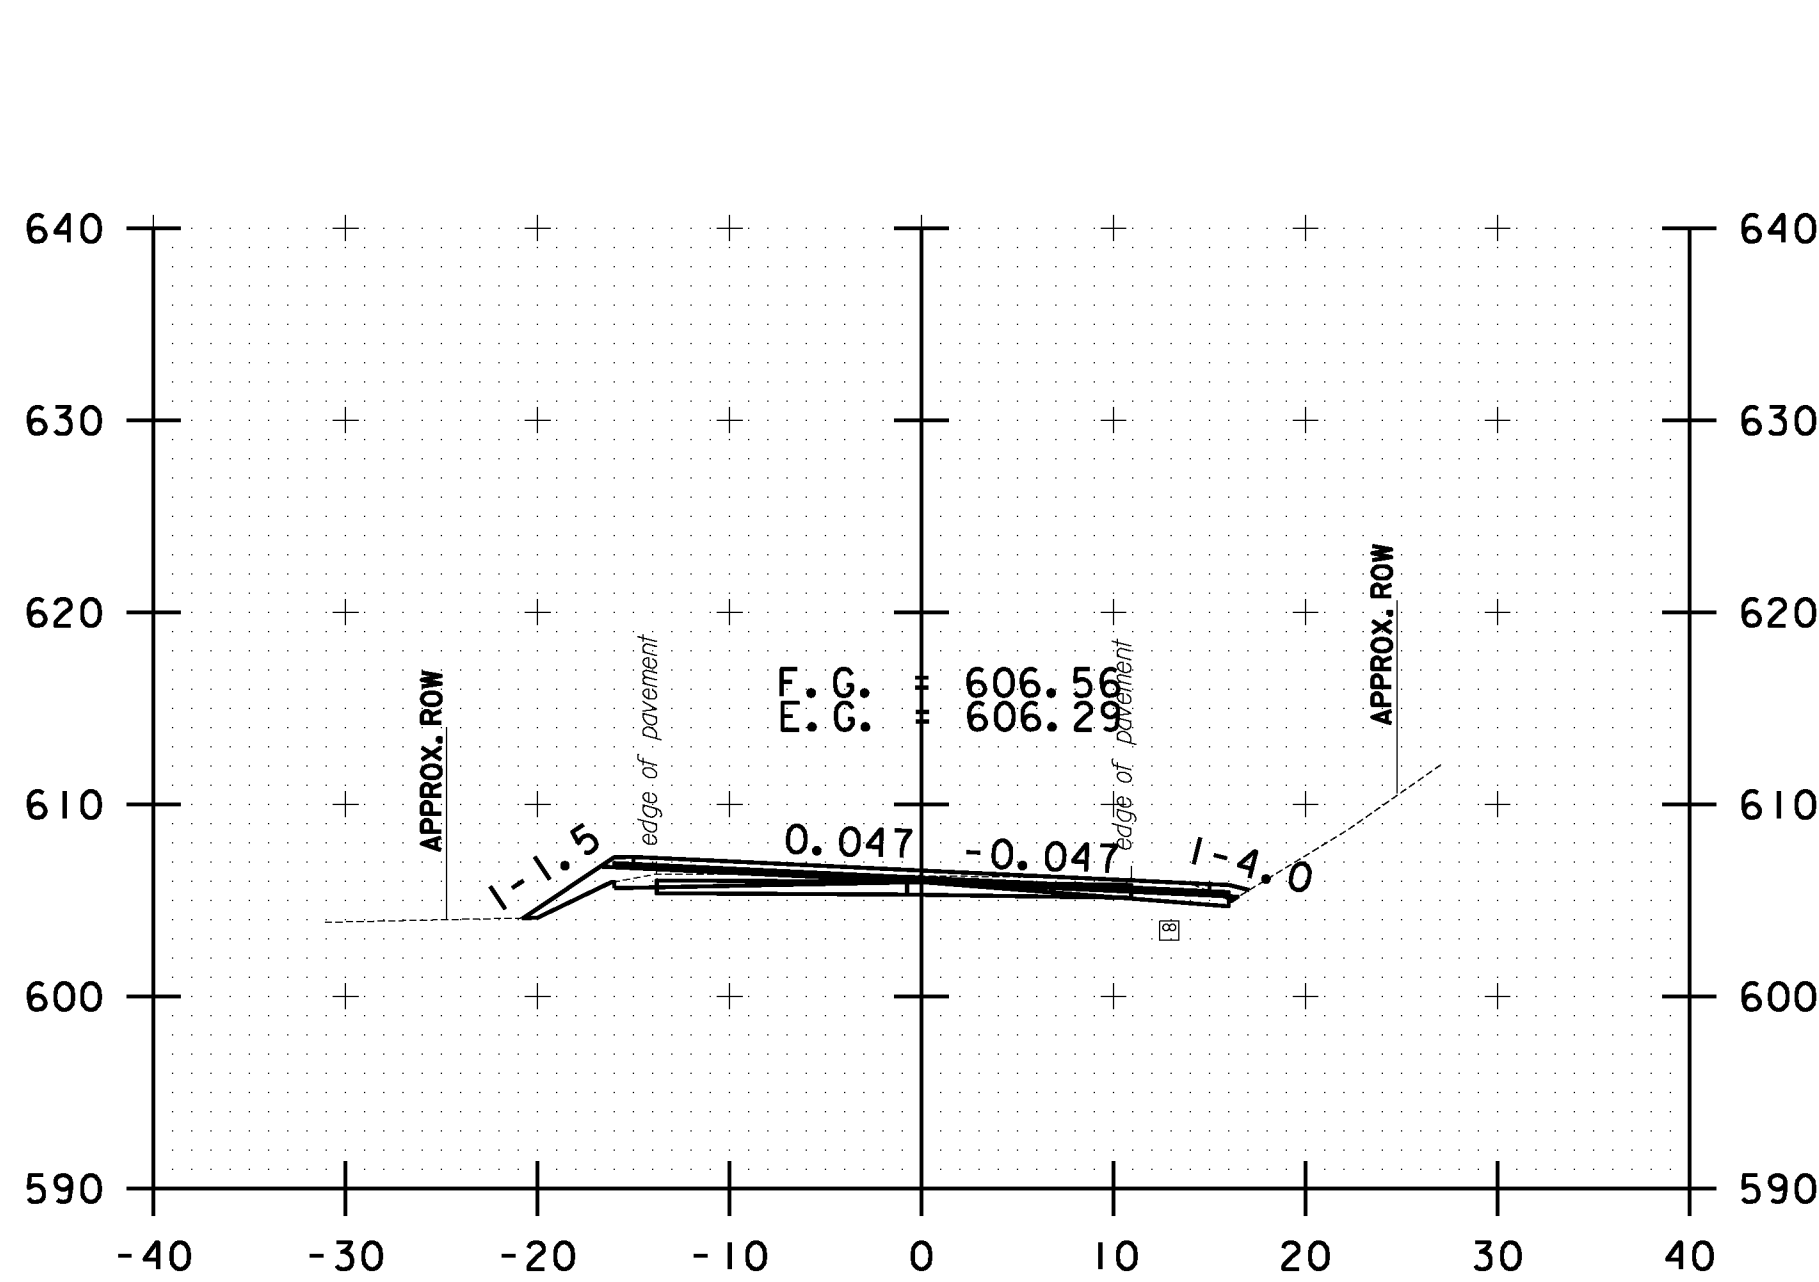


314+50.00

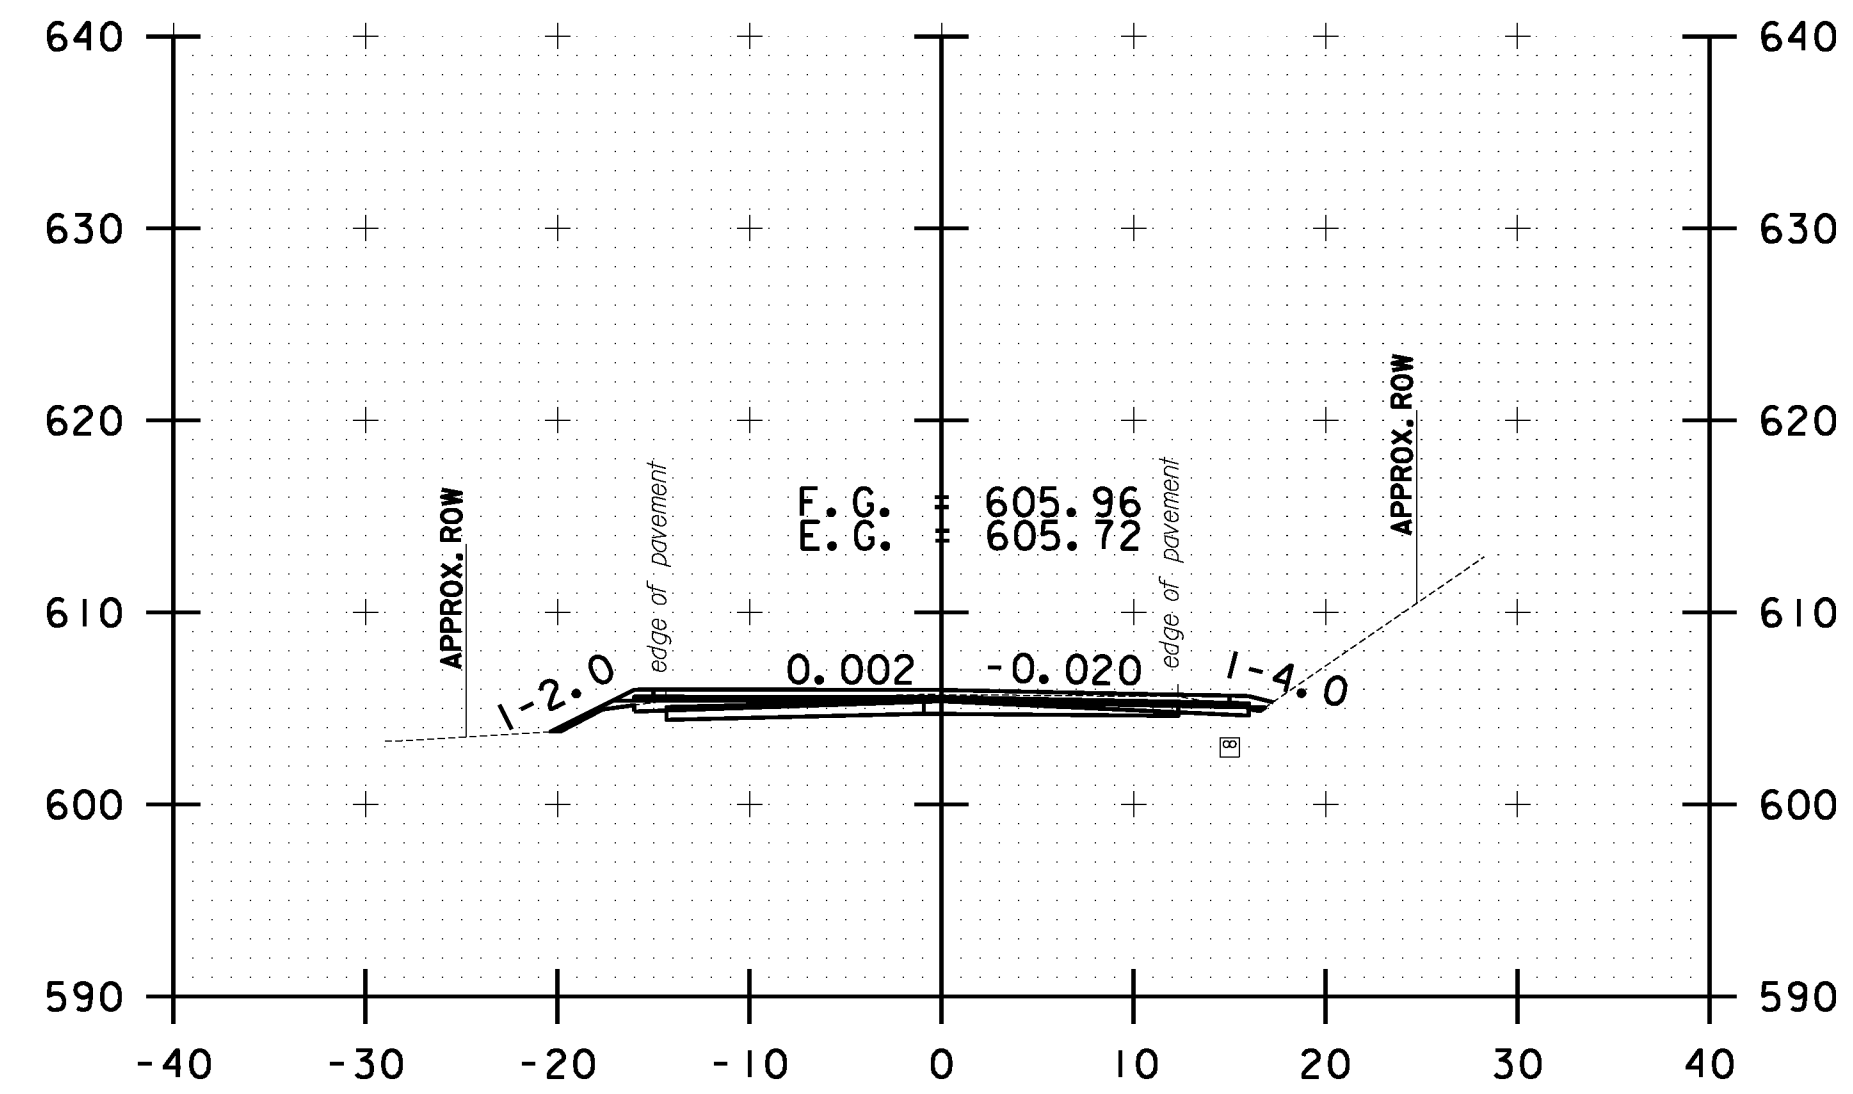


315+50.00

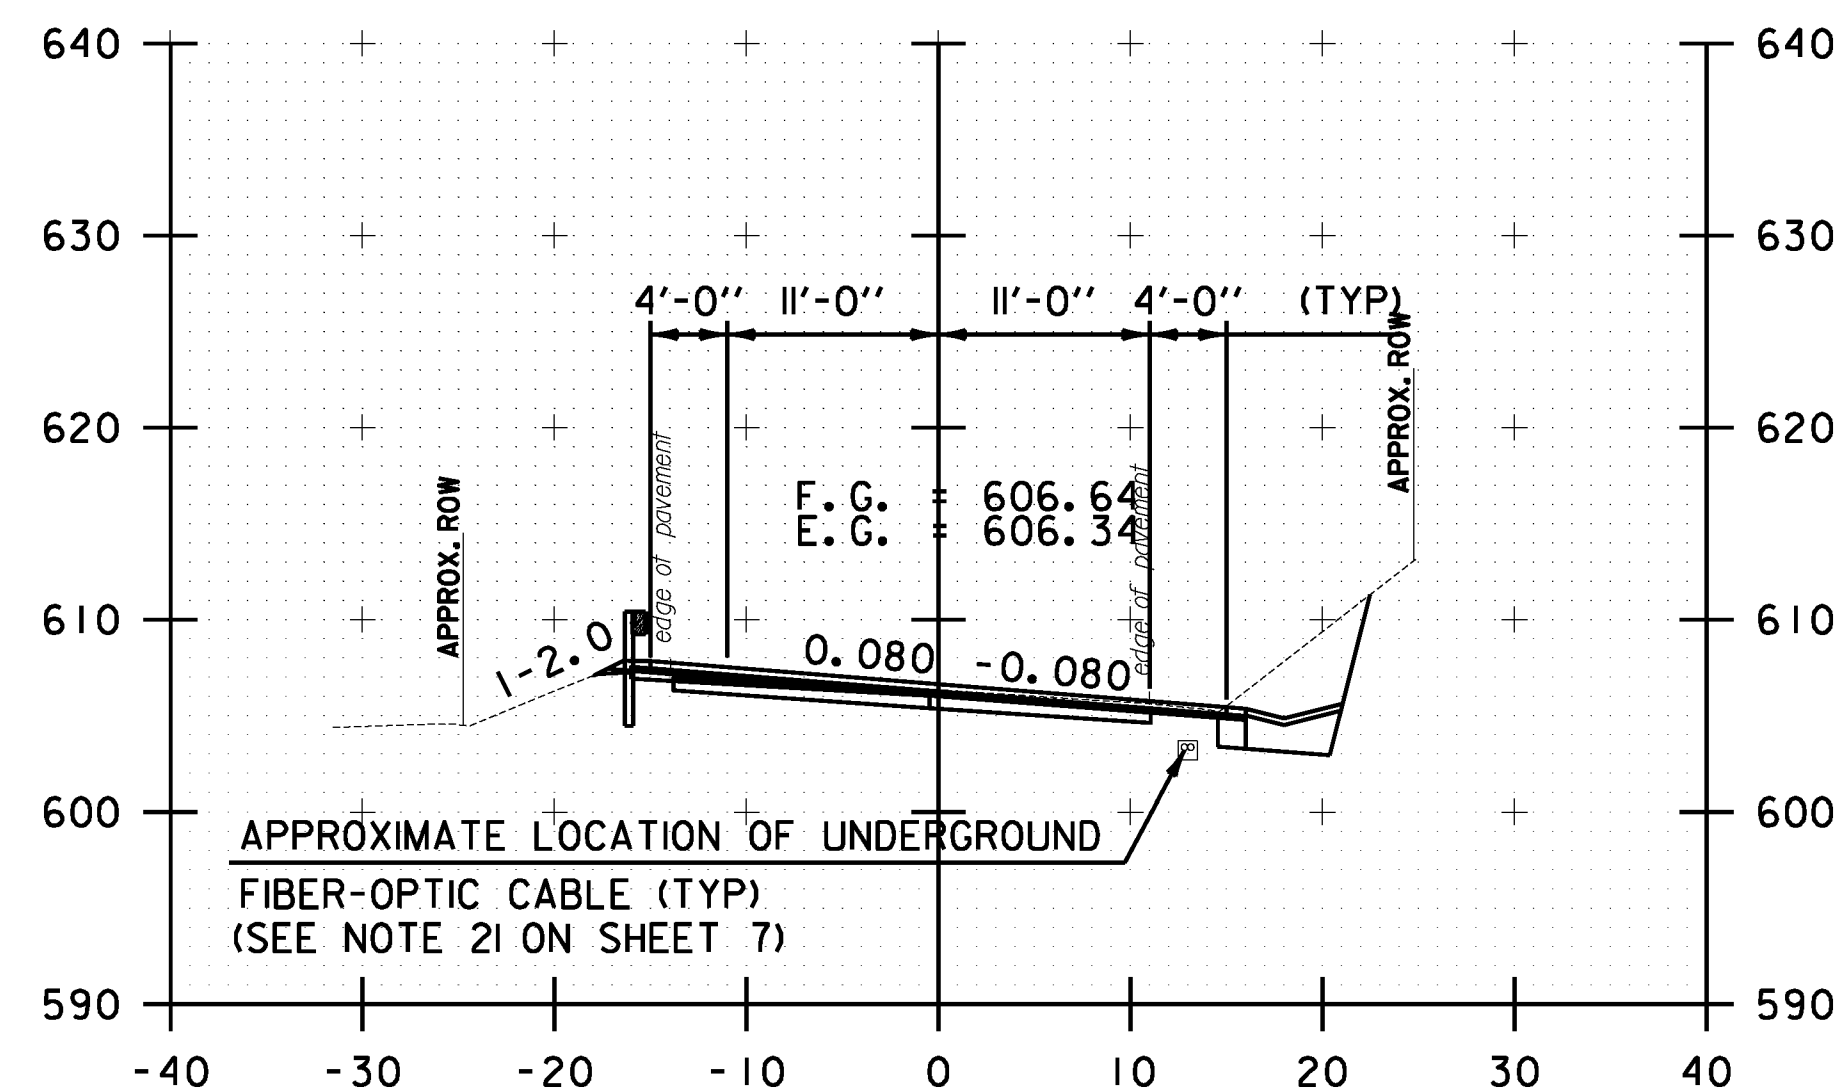


313+50.00

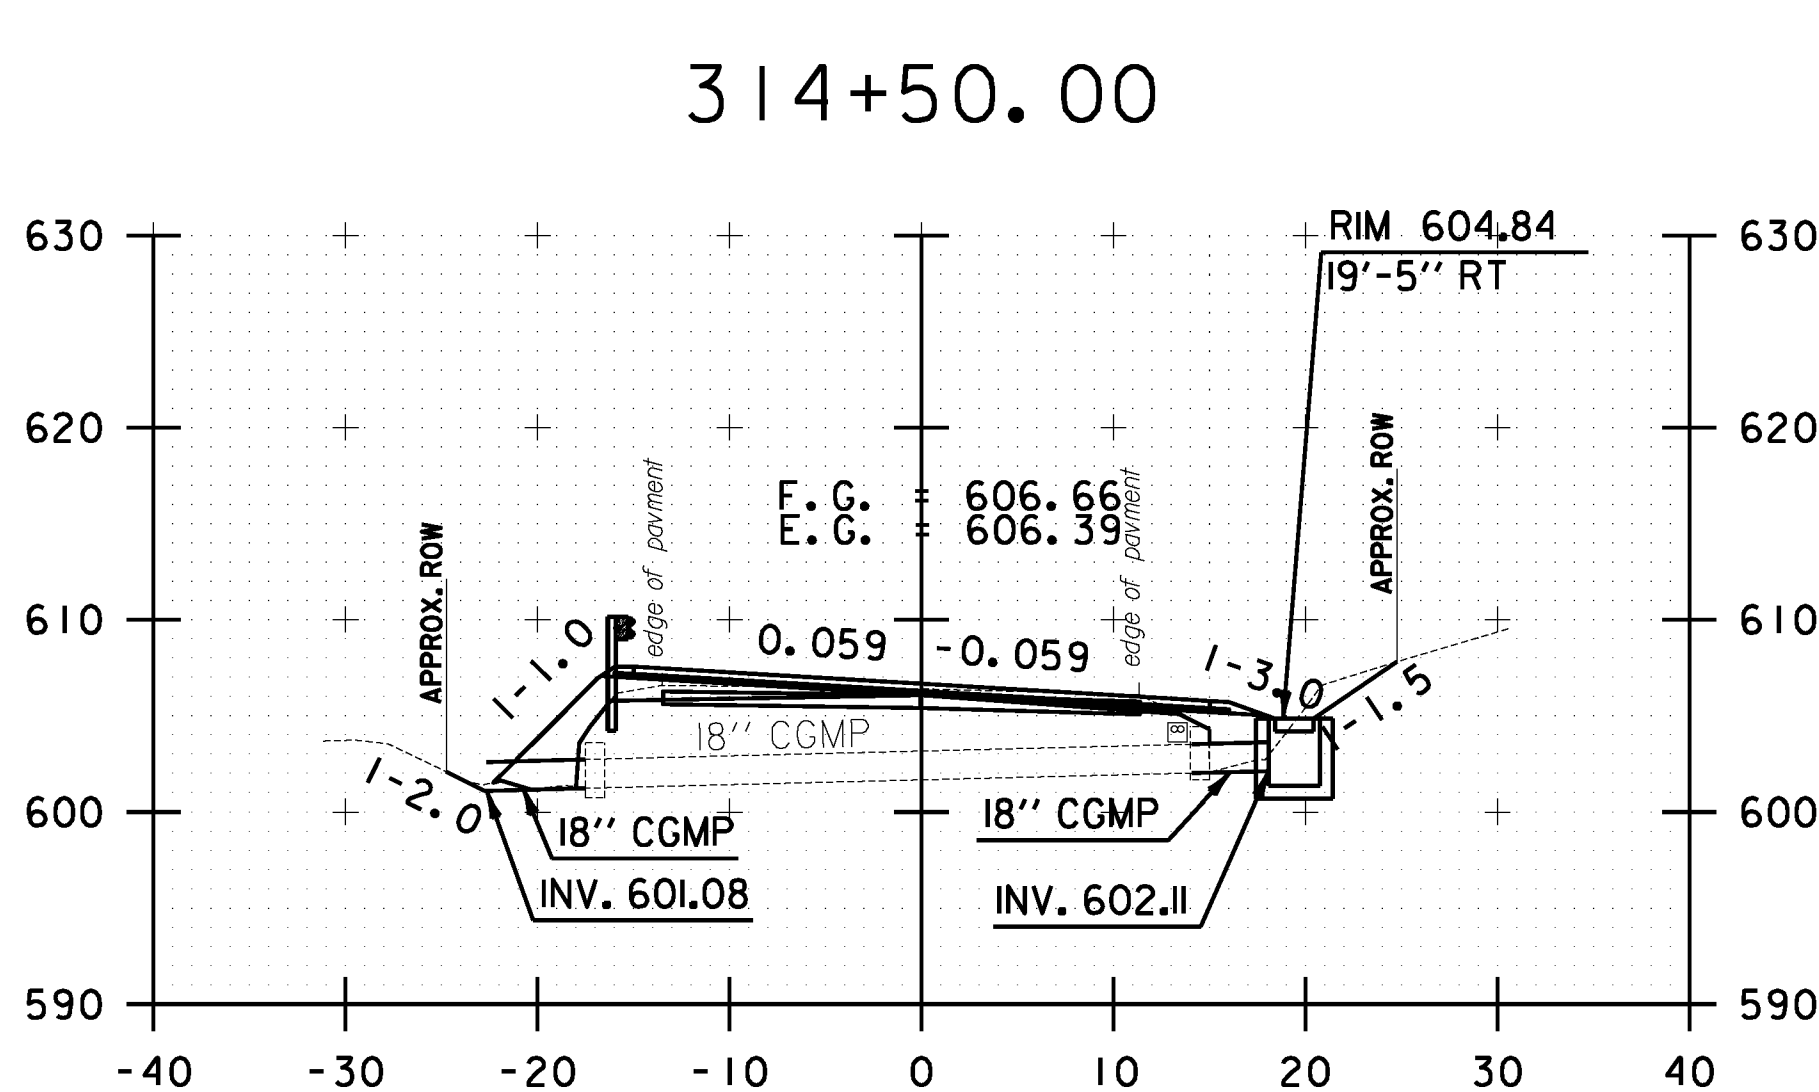

314+23.10

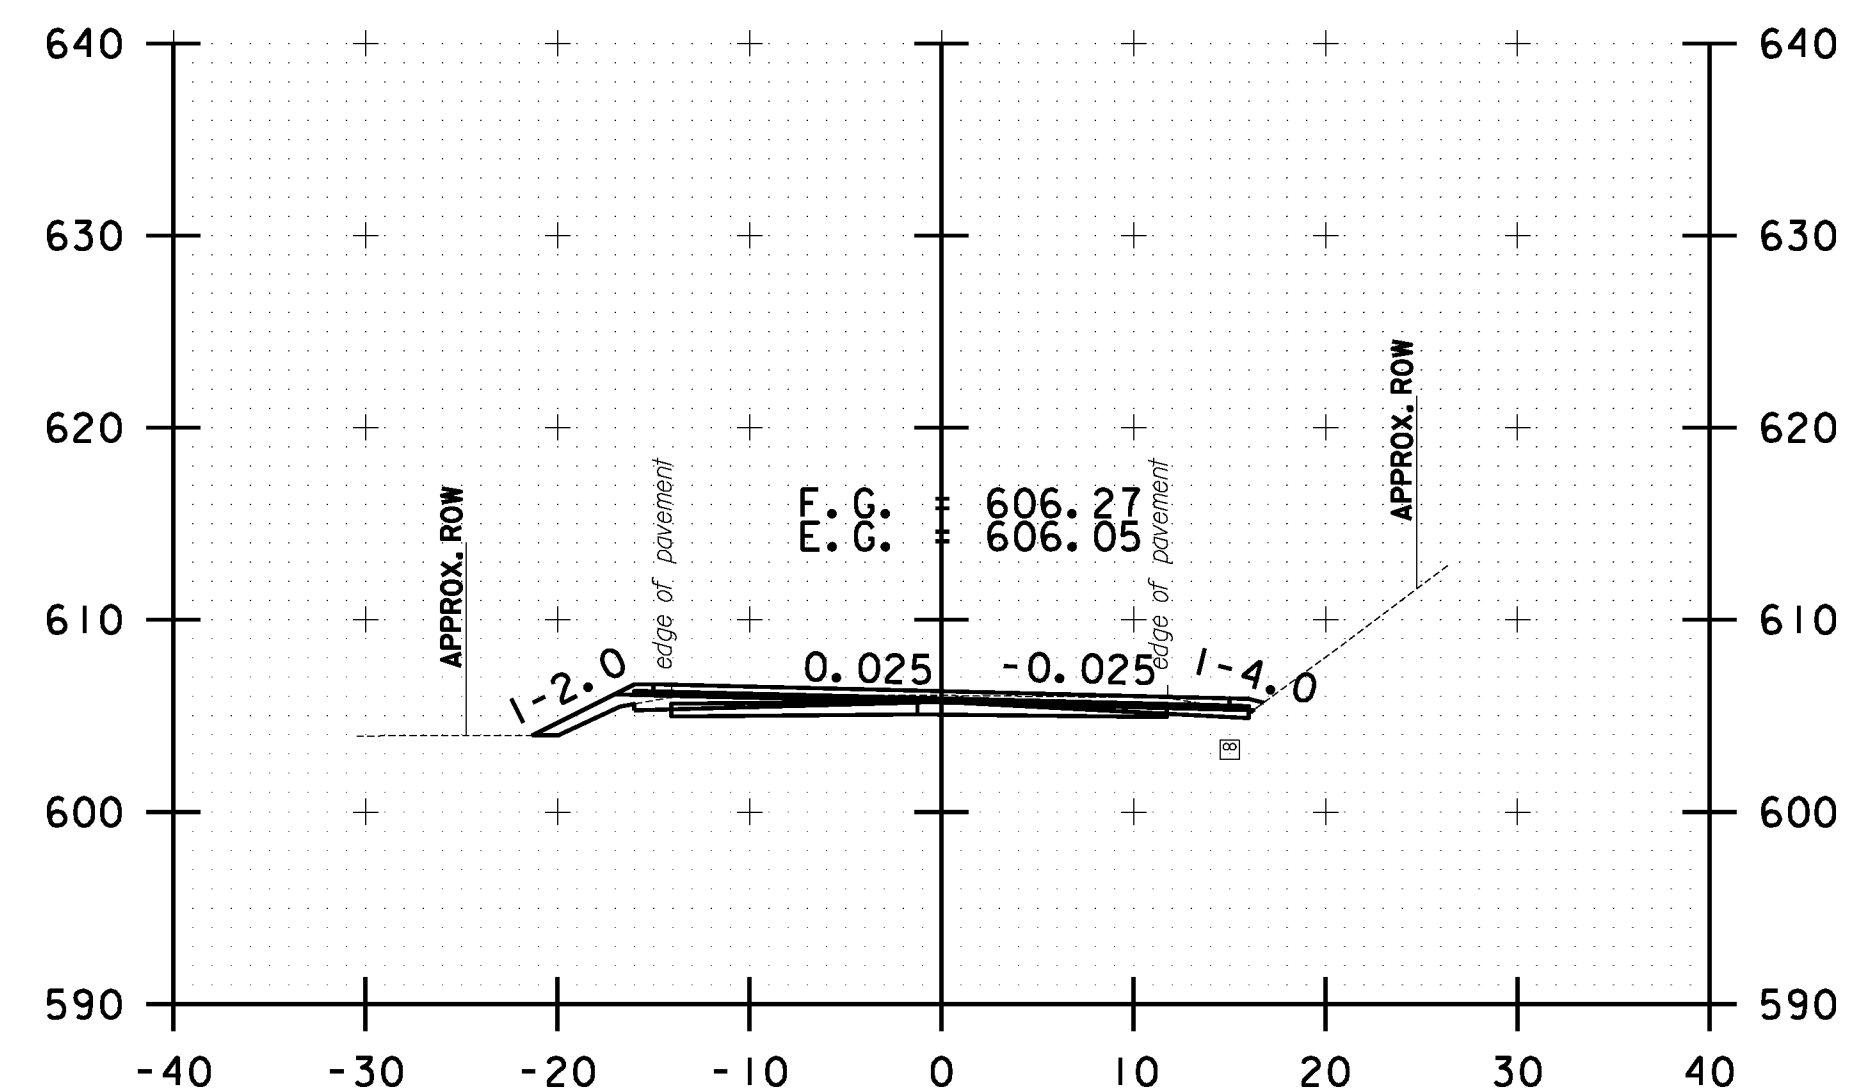

315+00.00

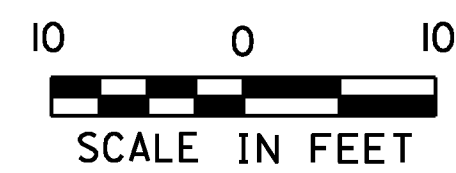

STOCKBRIDGE CROSS SECTION SHEET #99	PROJECT NAME: STOCKBRIDGE-BETHEL
	PROJECT NUMBER: STP 2910(1)
	FILE NAME: z10b214_stock_xc.dgn
	IPARM FILE: z10b214xs99.1
	PLOT DATE: 3/17/2014
	DRAWN BY: W.G.P.
	CHECKED BY: J.P.S.
	SHEET 312 OF 397