




FILE NAME = Y:\P\c\stok\ANY\X2\22426\CA001\MSTN10b214\_stock\_xc.dgn  
 DATE/TIME = 3/17/2014  
 USER = 4916

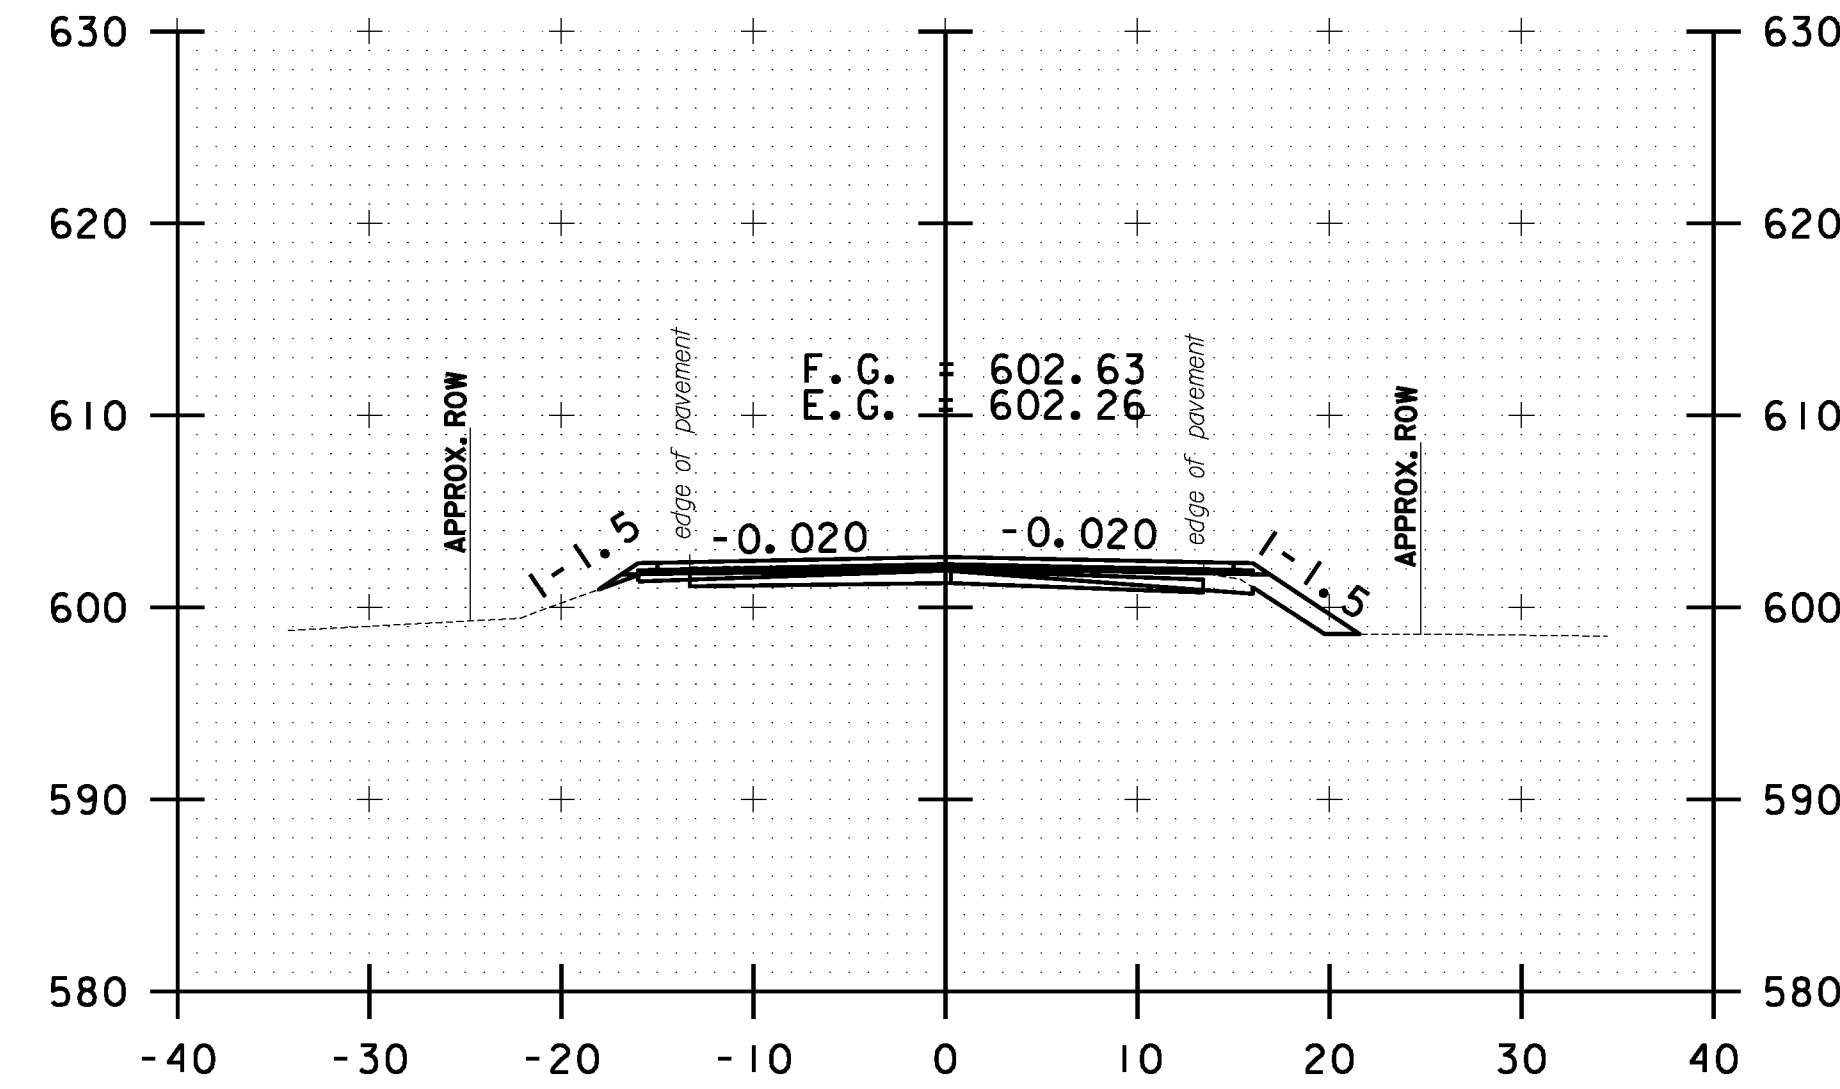


324+00.00

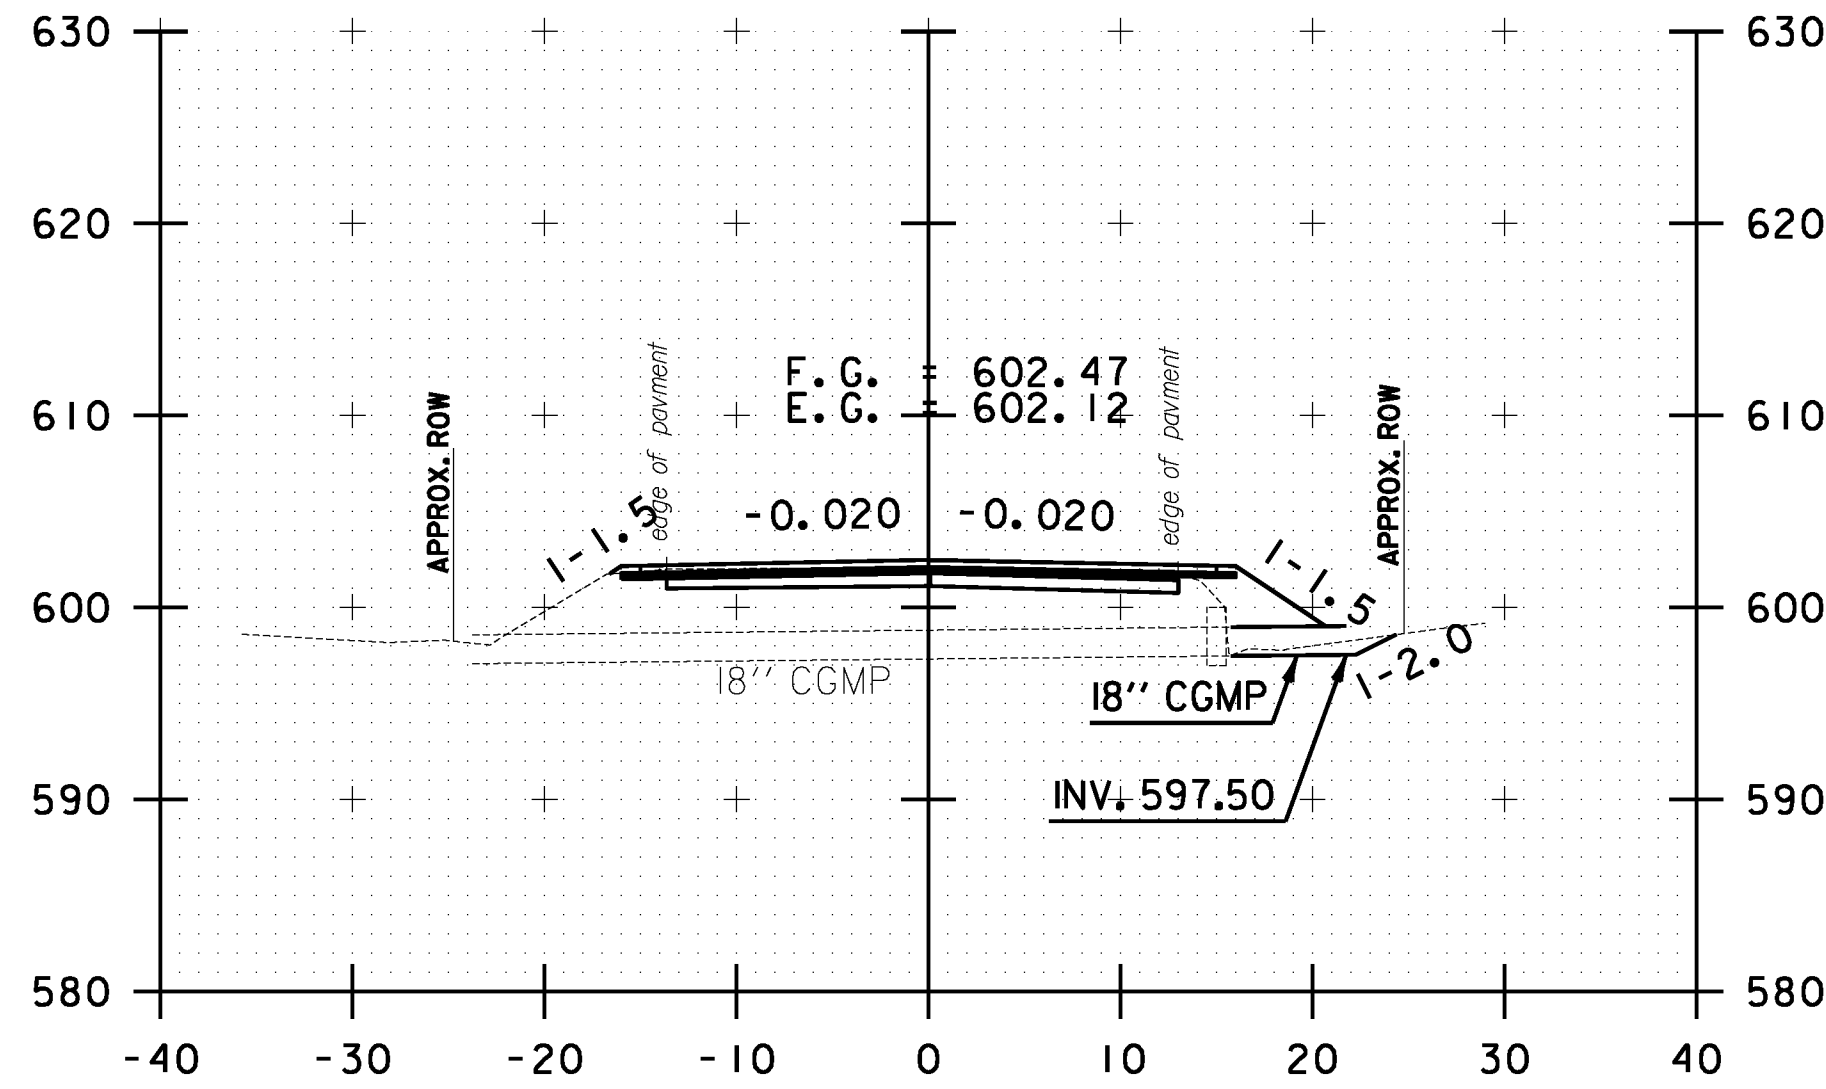


324+50.10

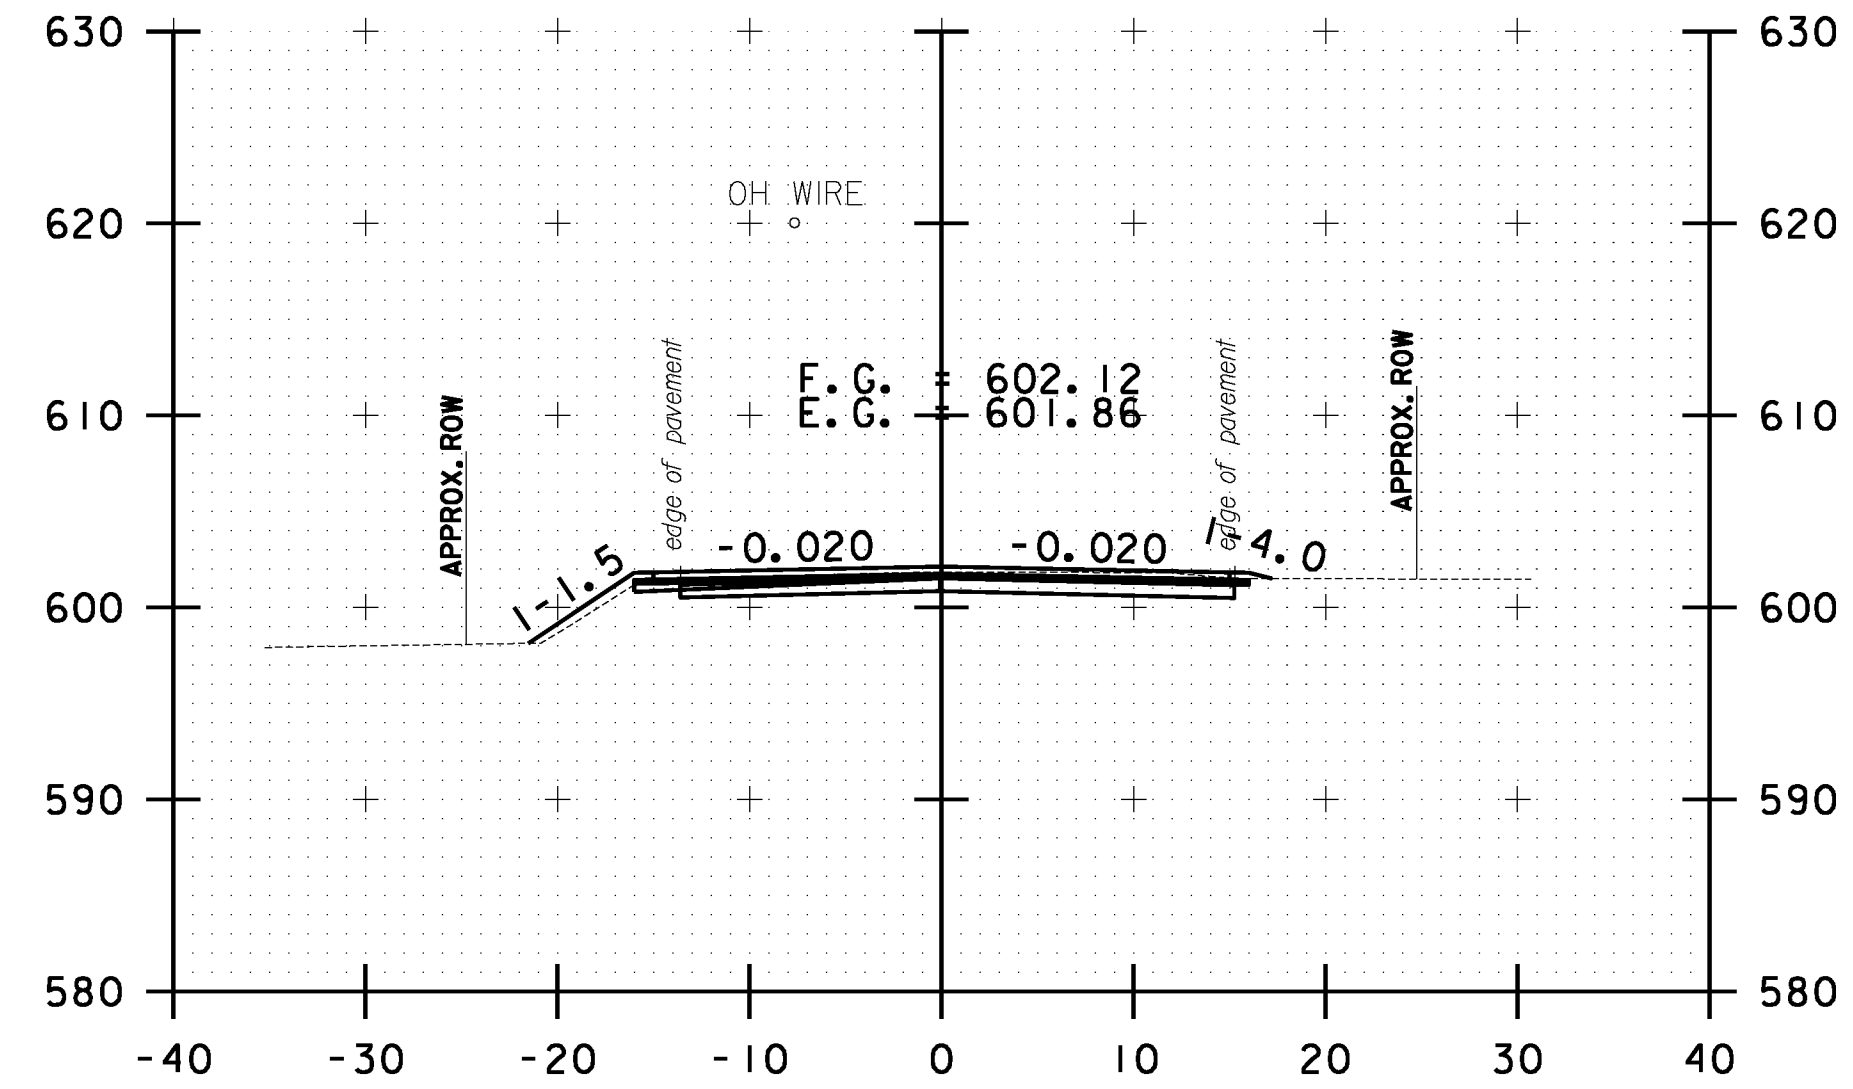


325+50.00

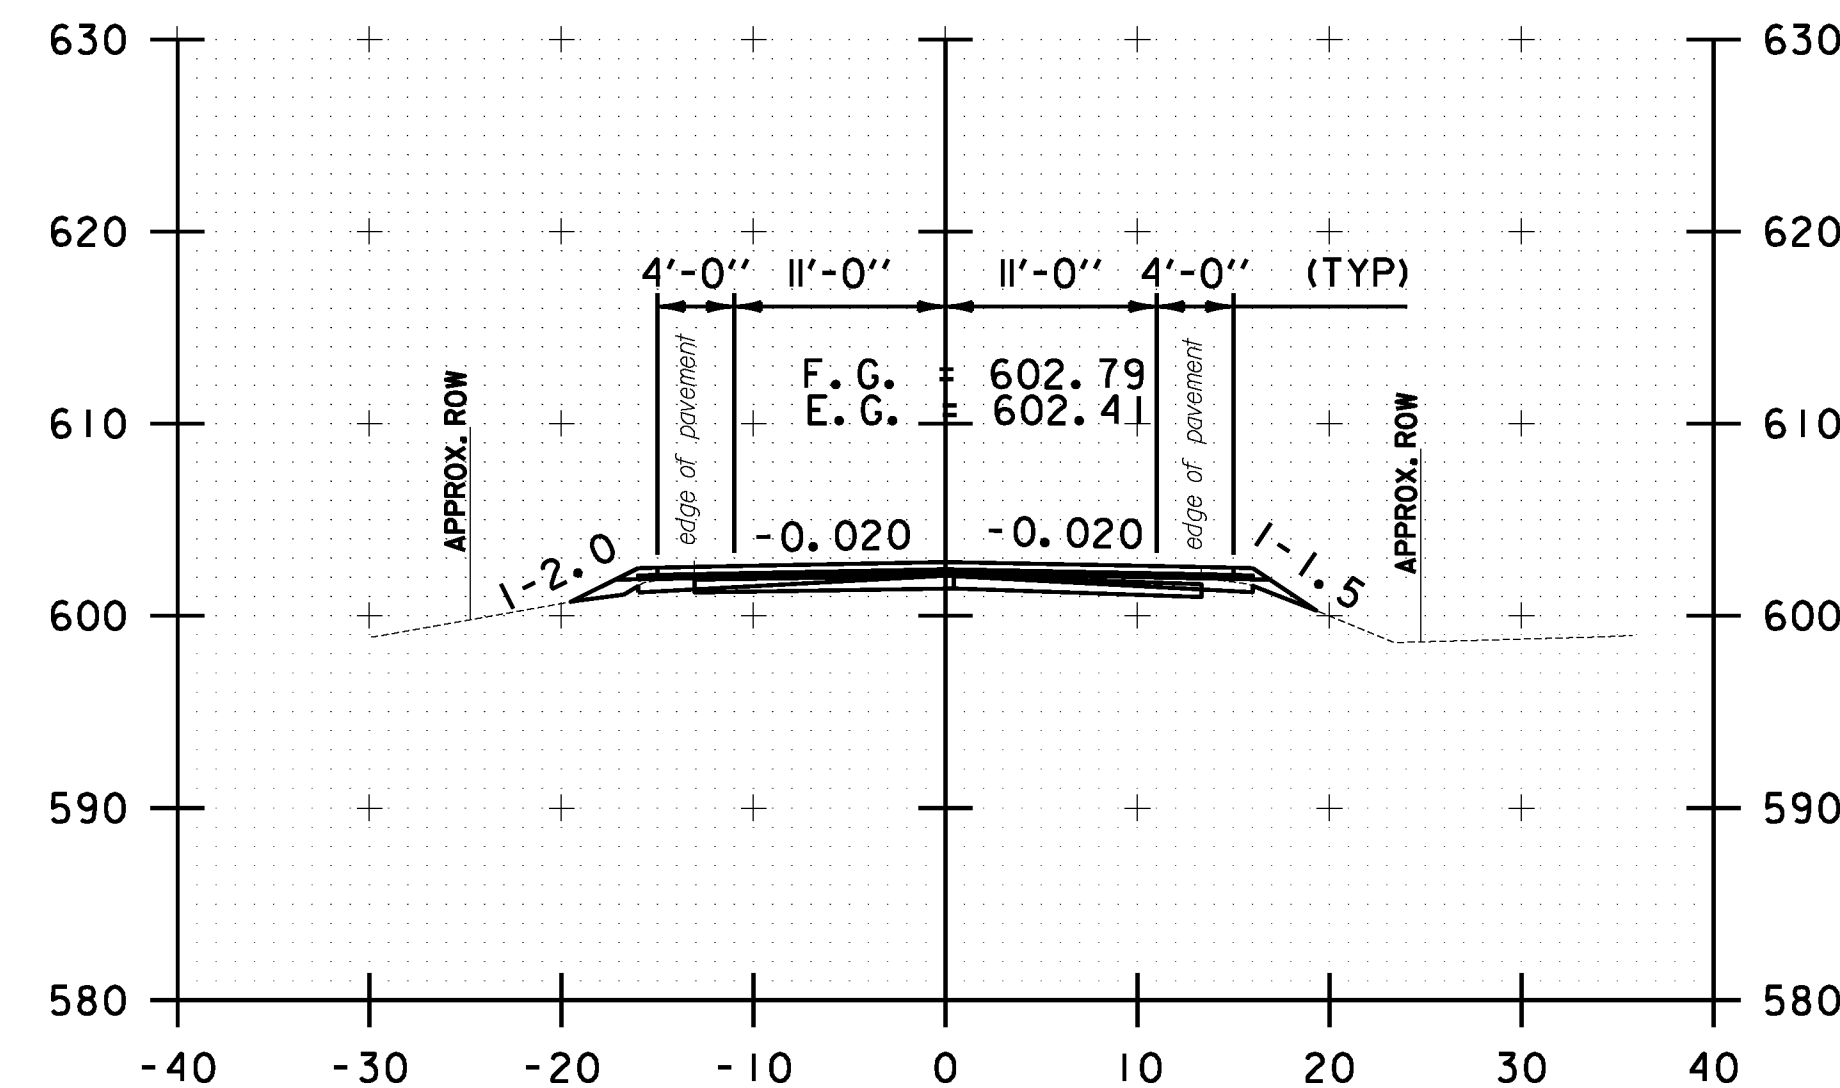

323+50.00

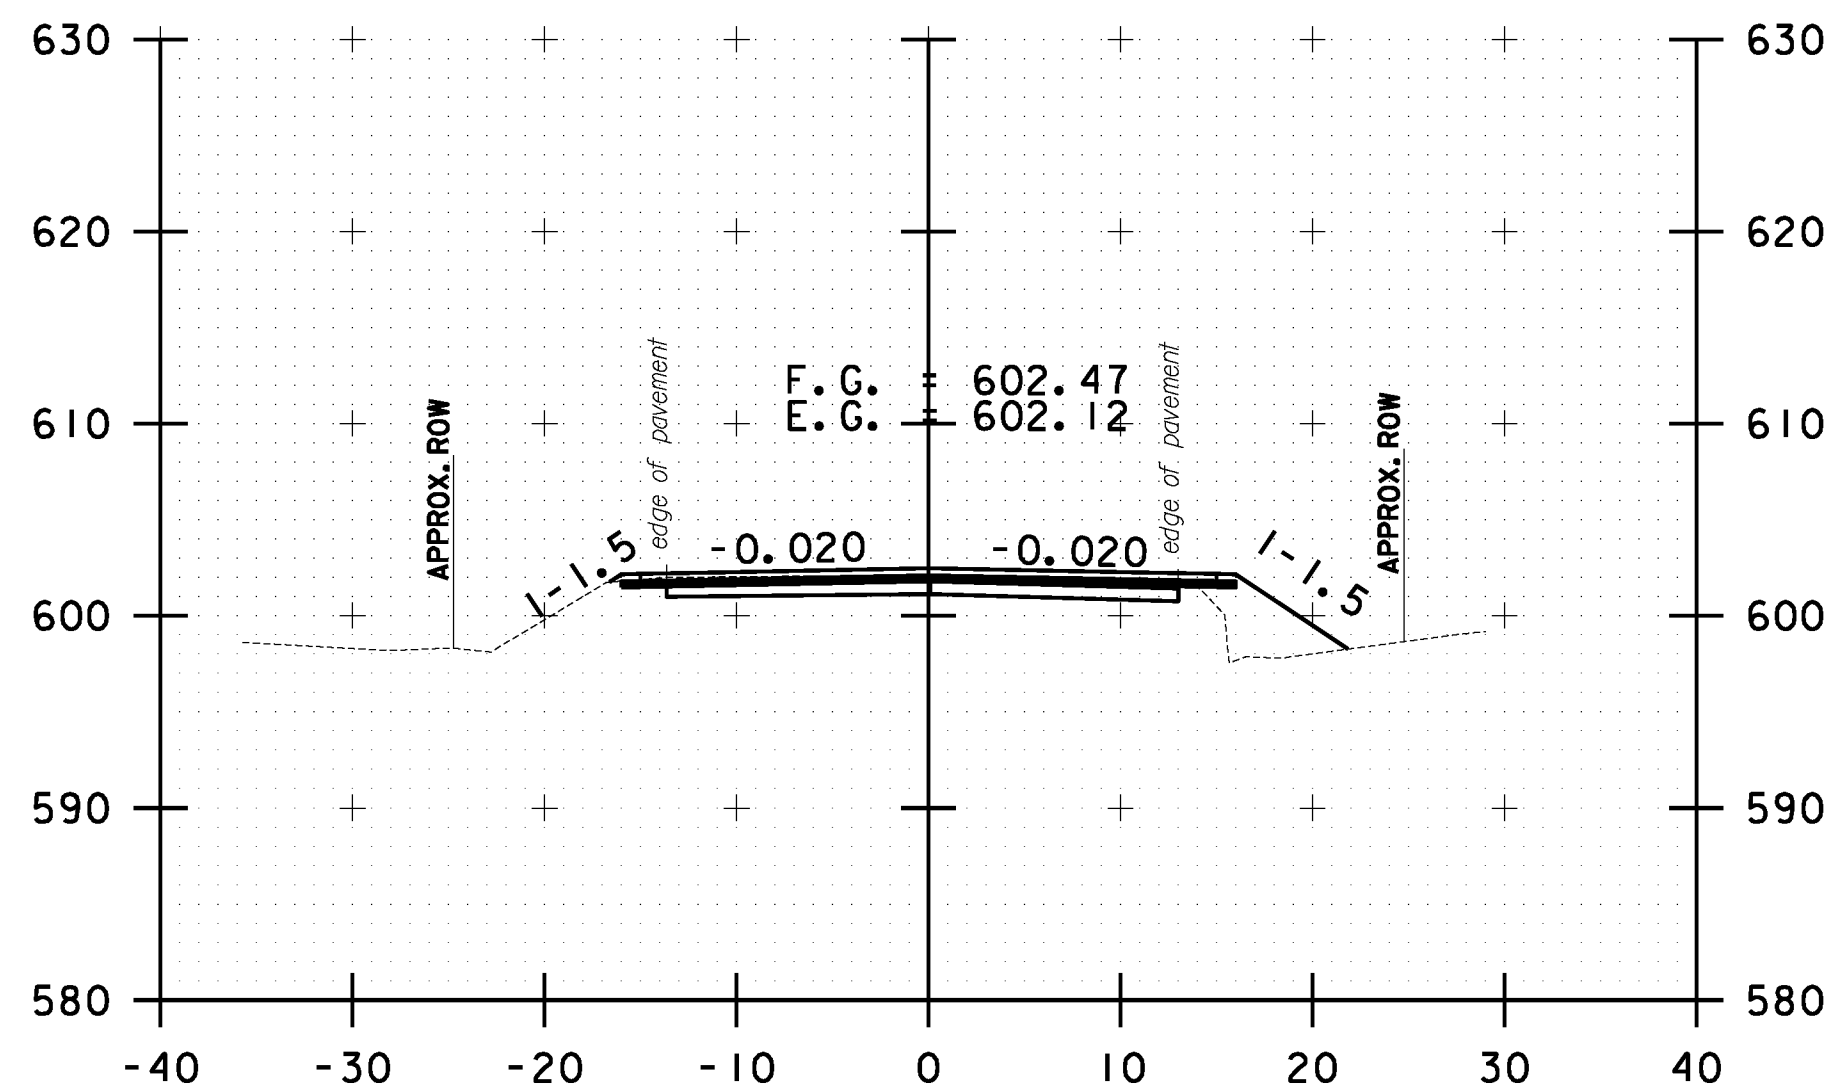

324+50.00

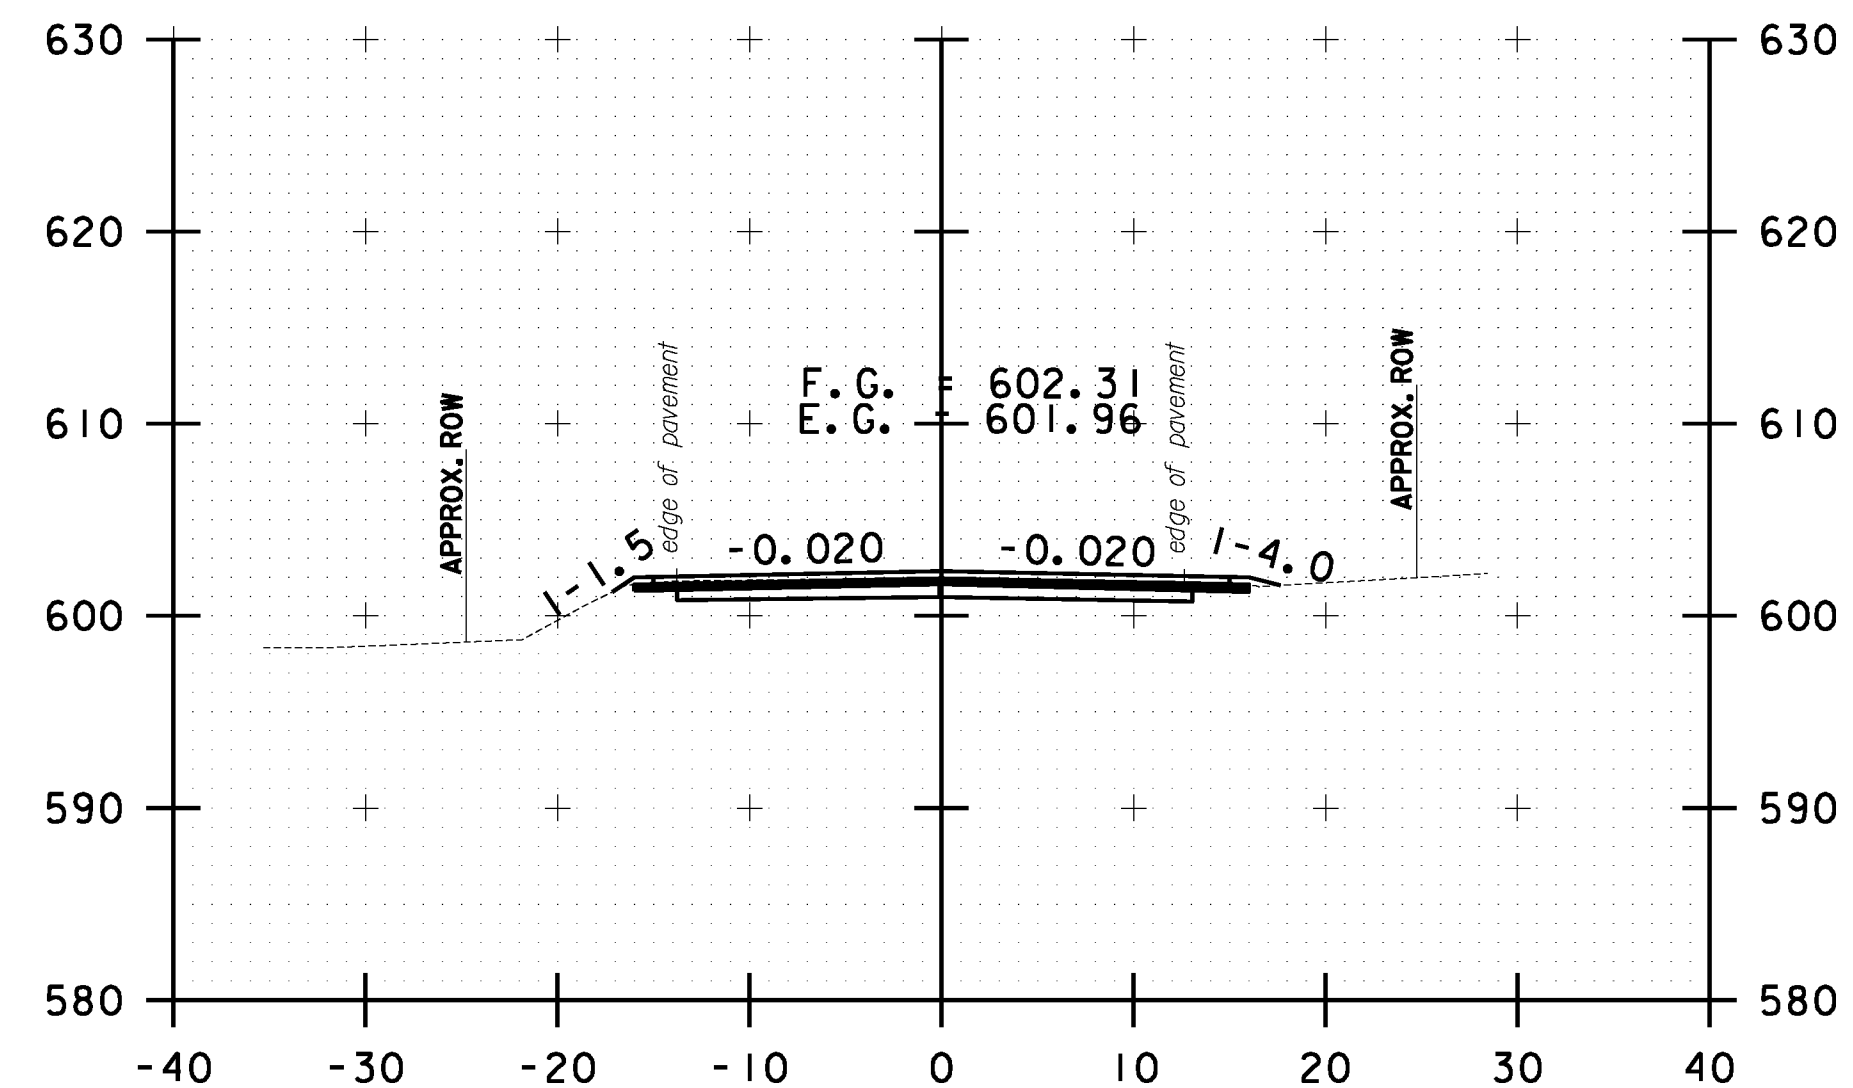

325+00.00



**STOCKBRIDGE  
 CROSS SECTION  
 SHEET #102**

PROJECT NAME: STOCKBRIDGE-BETHEL	
PROJECT NUMBER: STP 2910(1)	
FILE NAME: z10b214_stock_xc.dgn	PLOT DATE: 3/17/2014
PROJECT LEADER: D.E.G.	DRAWN BY: W.G.P.
DESIGNED BY: L.M.B.	CHECKED BY: J.P.S.
IPARM FILE: z10b214xs102.1	SHEET 315 OF 397