




FILE NAME = Y:\P\c\ass\ANY\X2\22426\CADD\MSTN\10b214_stock.nc.dgn
 DATE/TIME = 3/17/2014
 USER = 4916

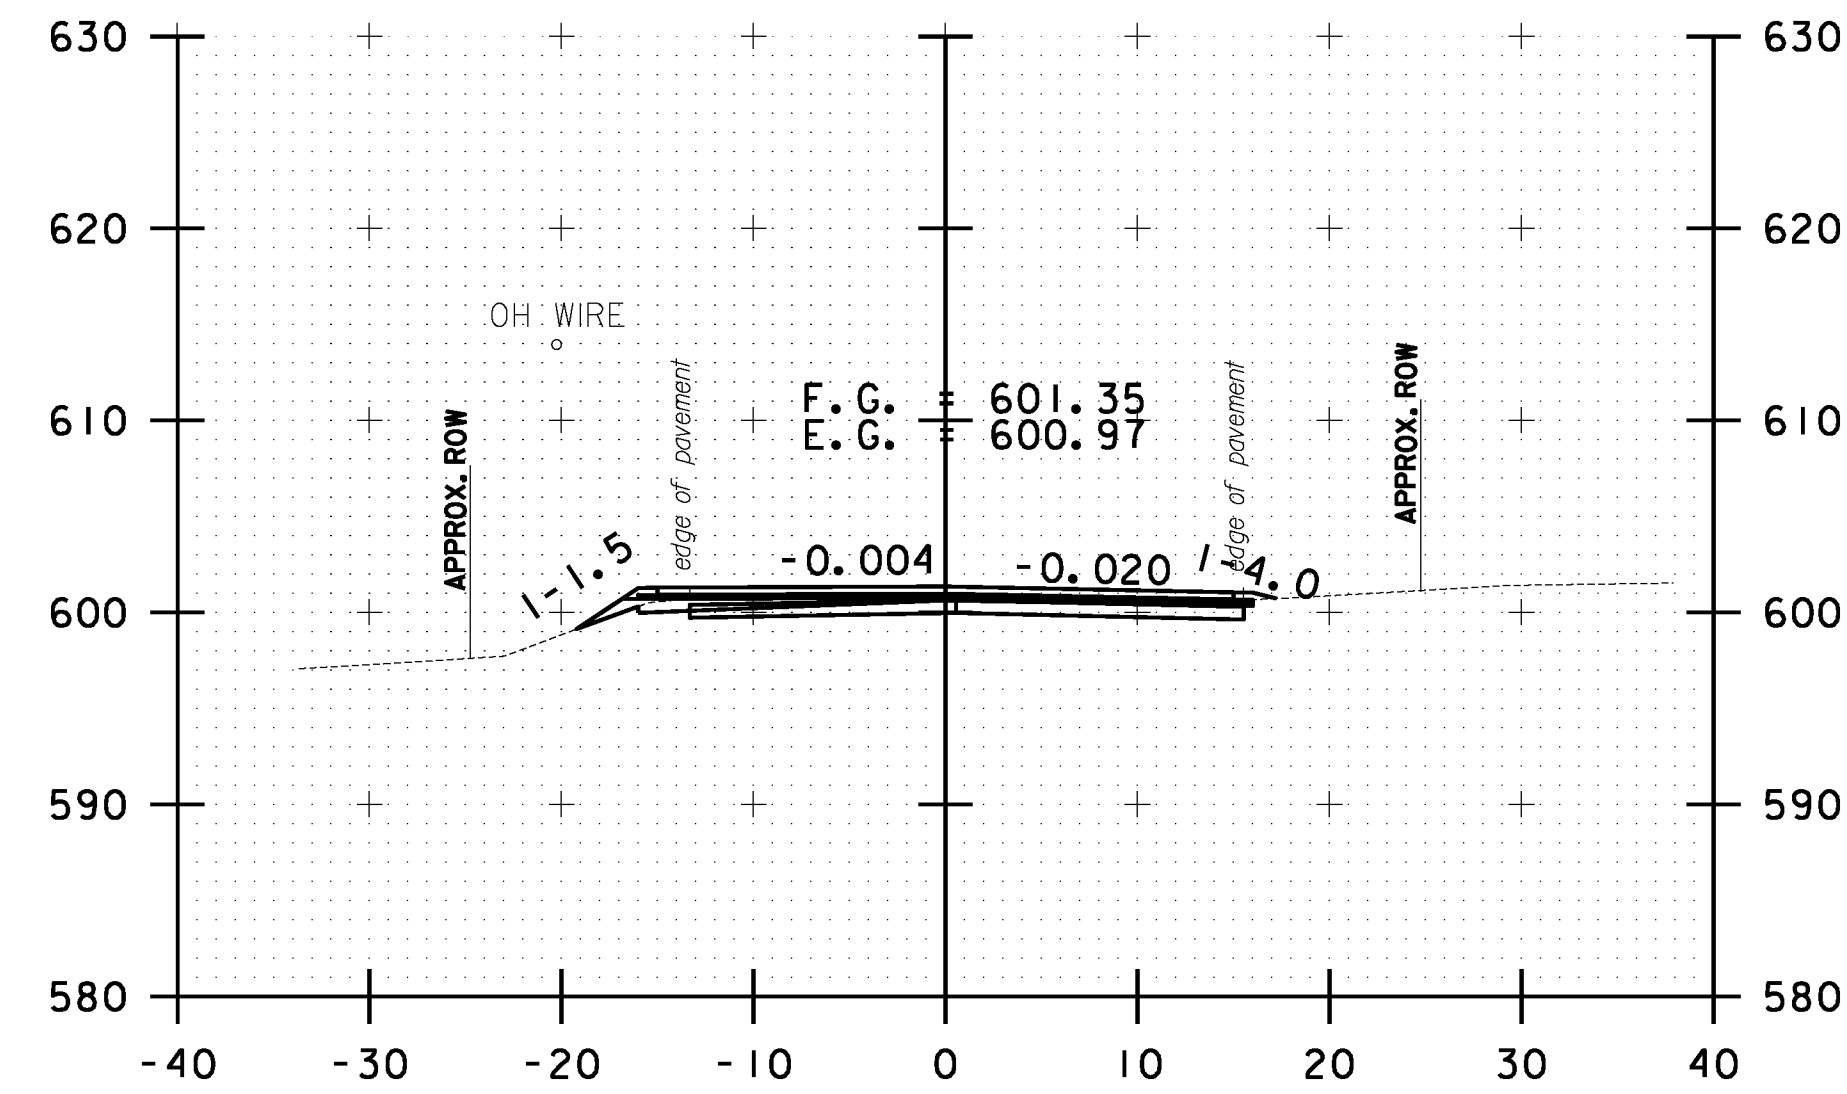


326+50.00

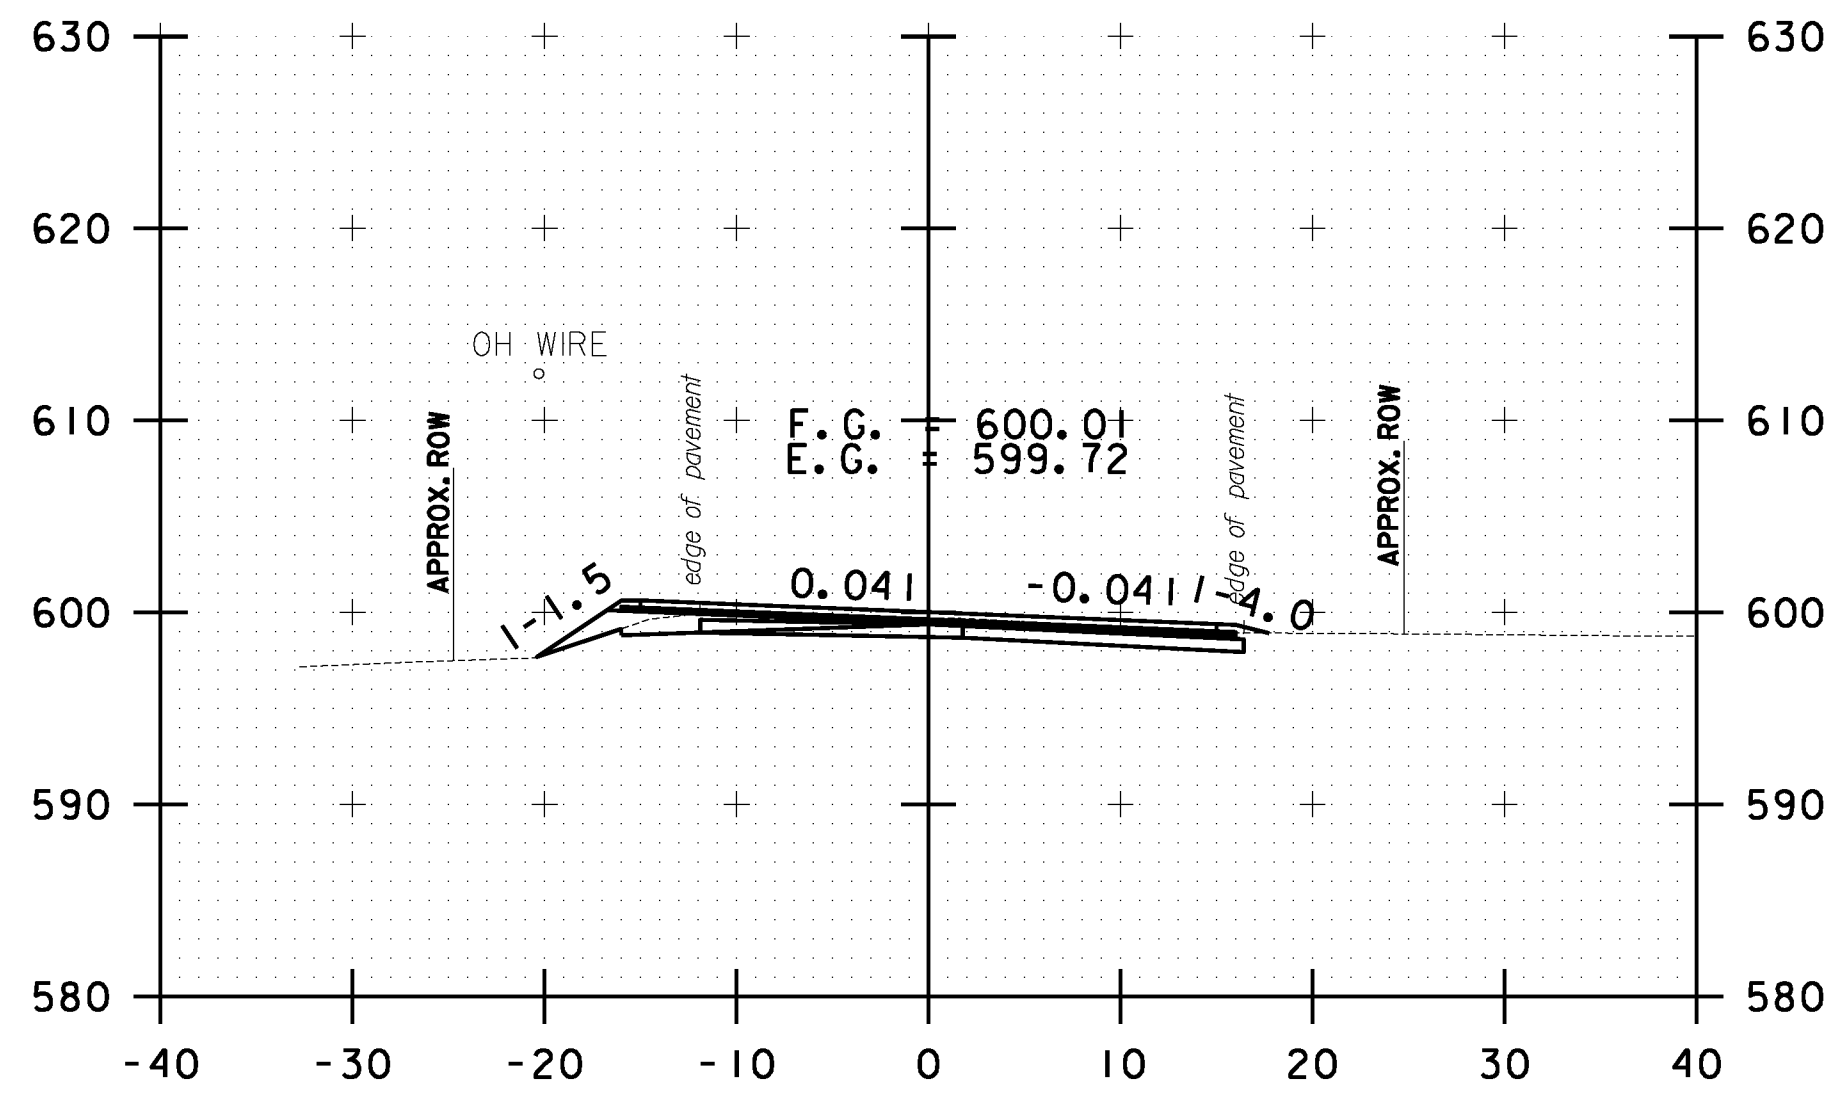


327+50.00

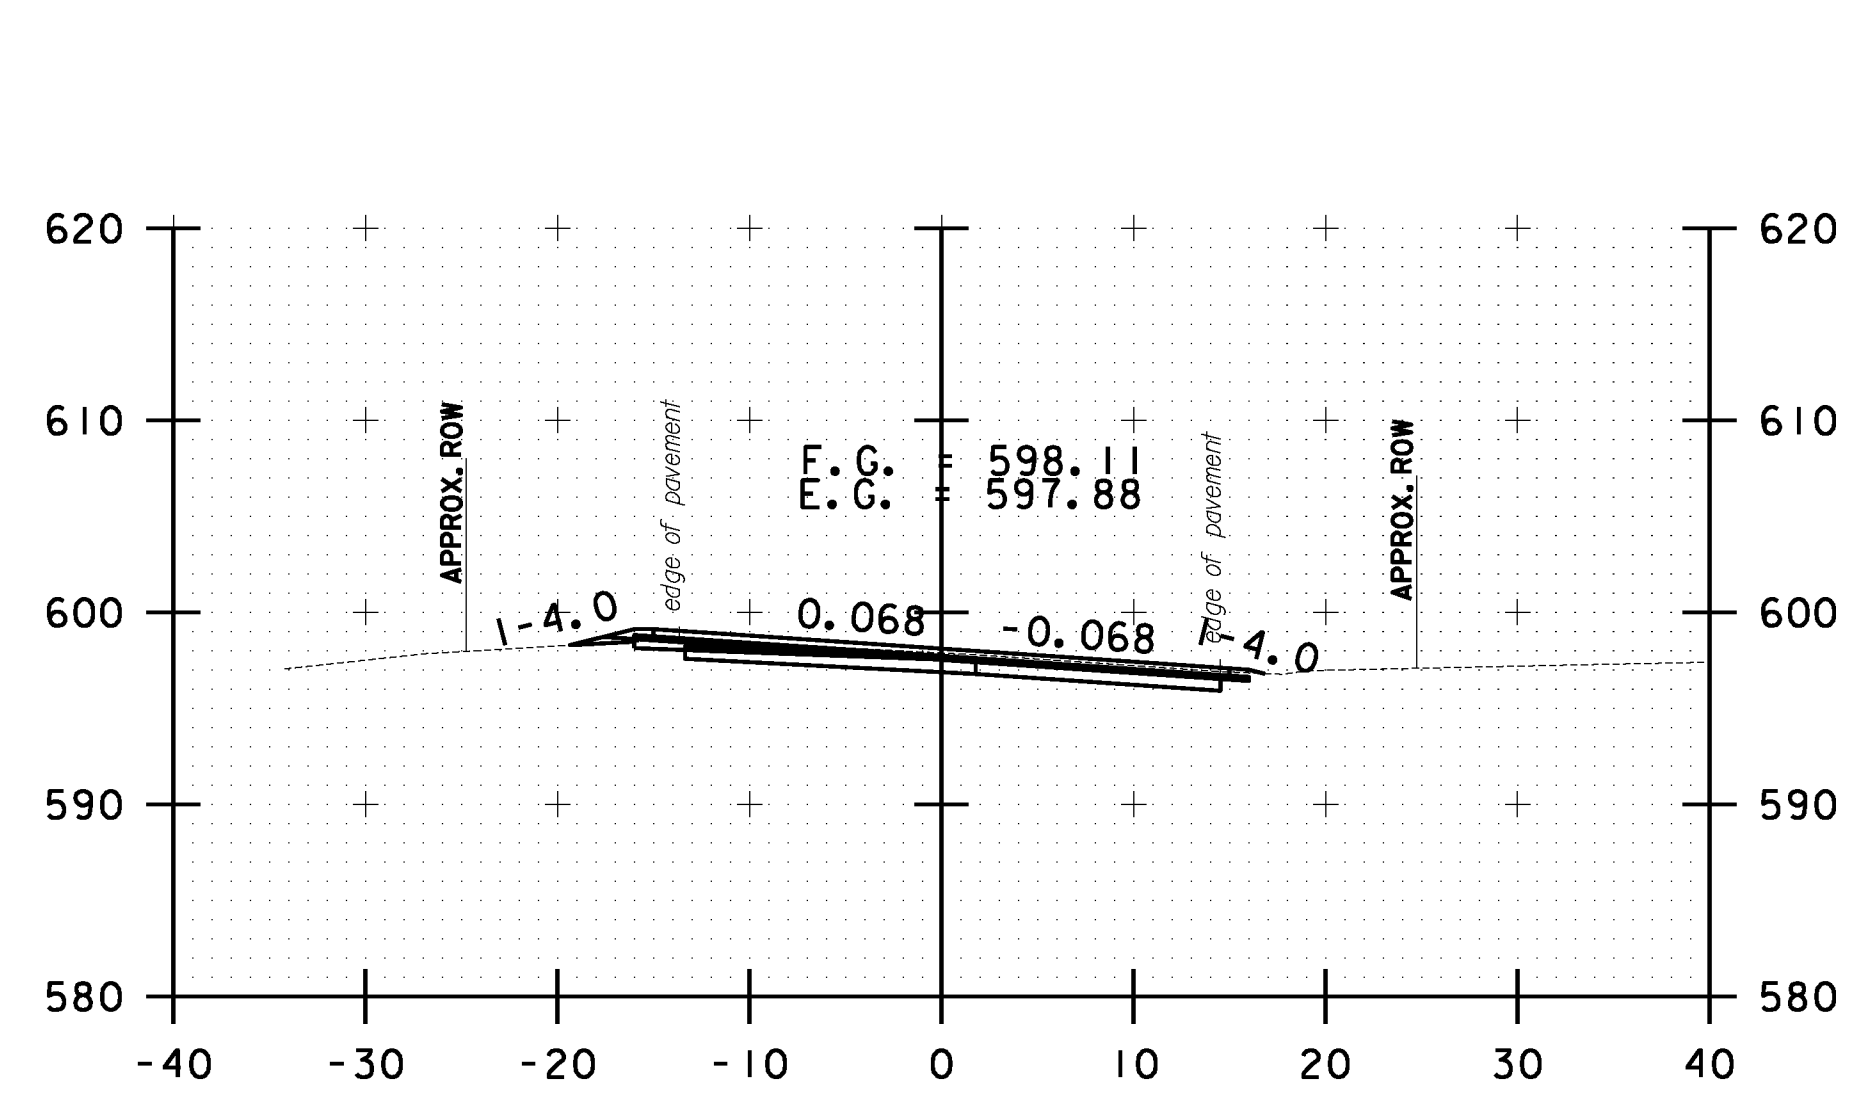


328+50.00

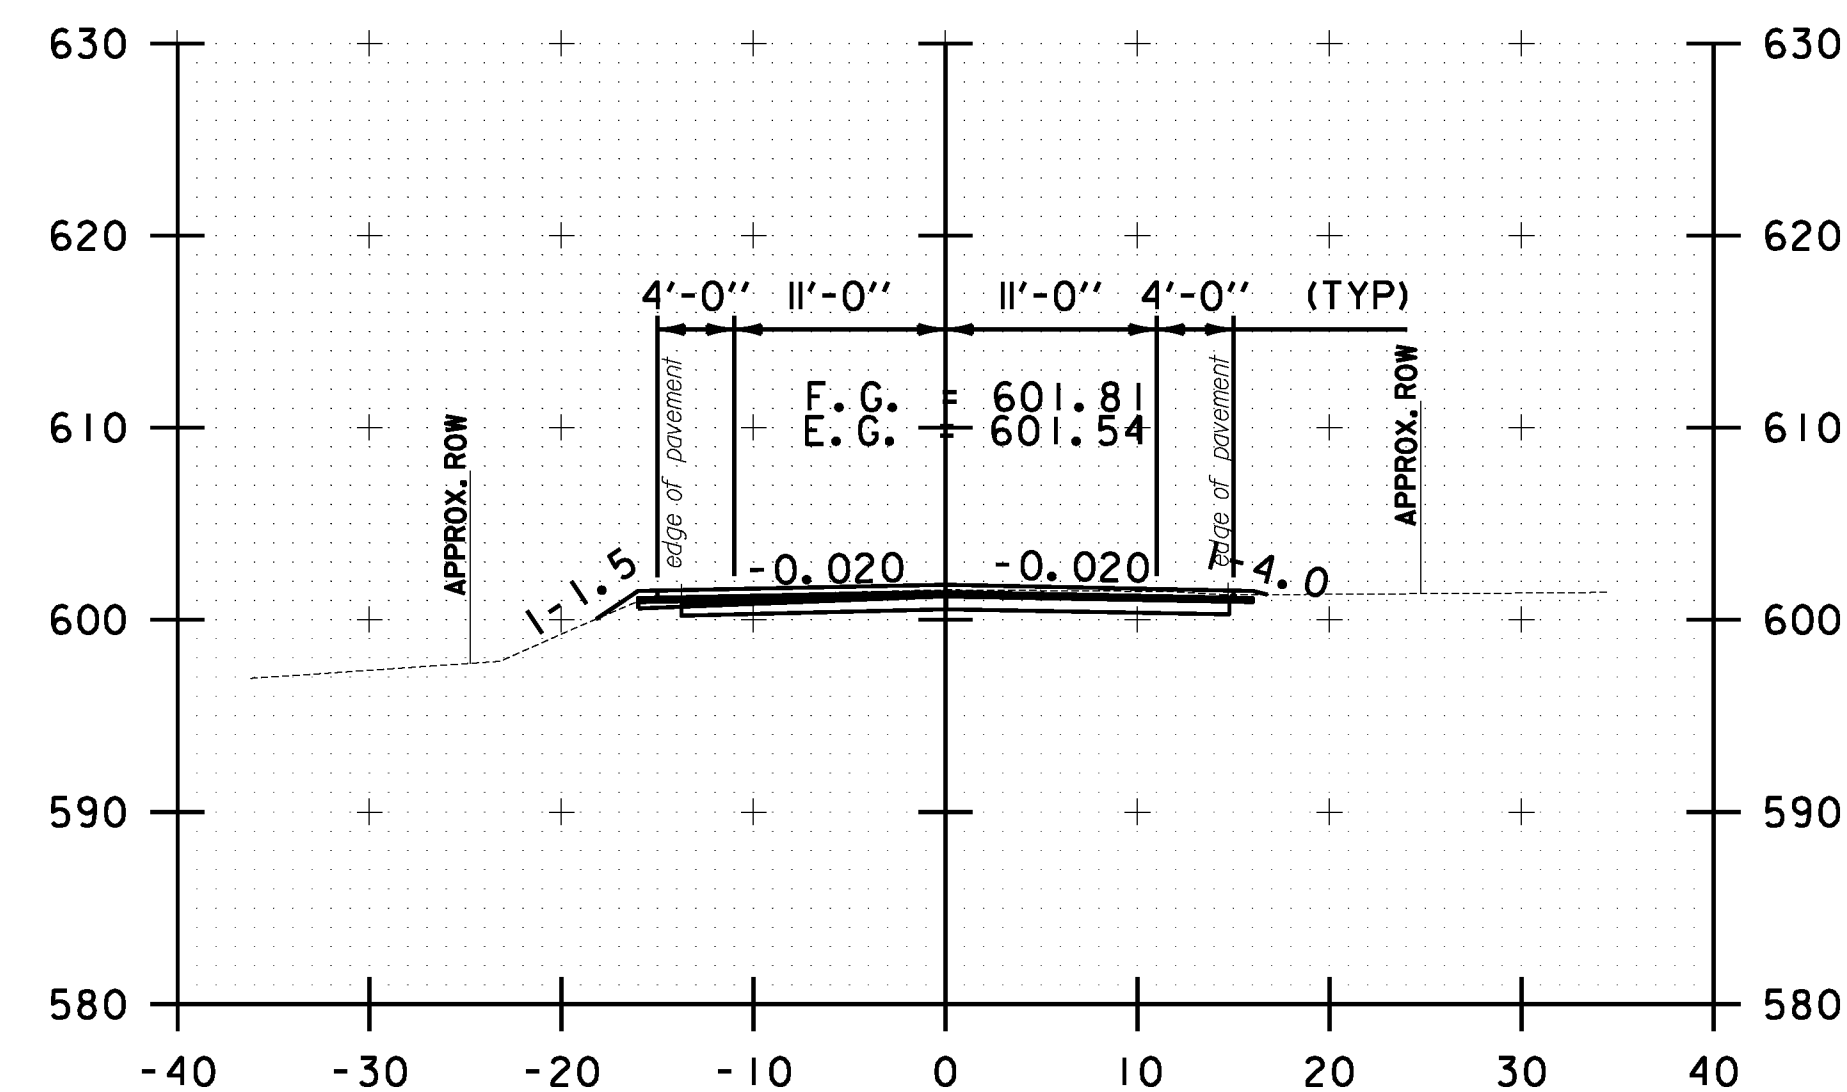

326+00.00

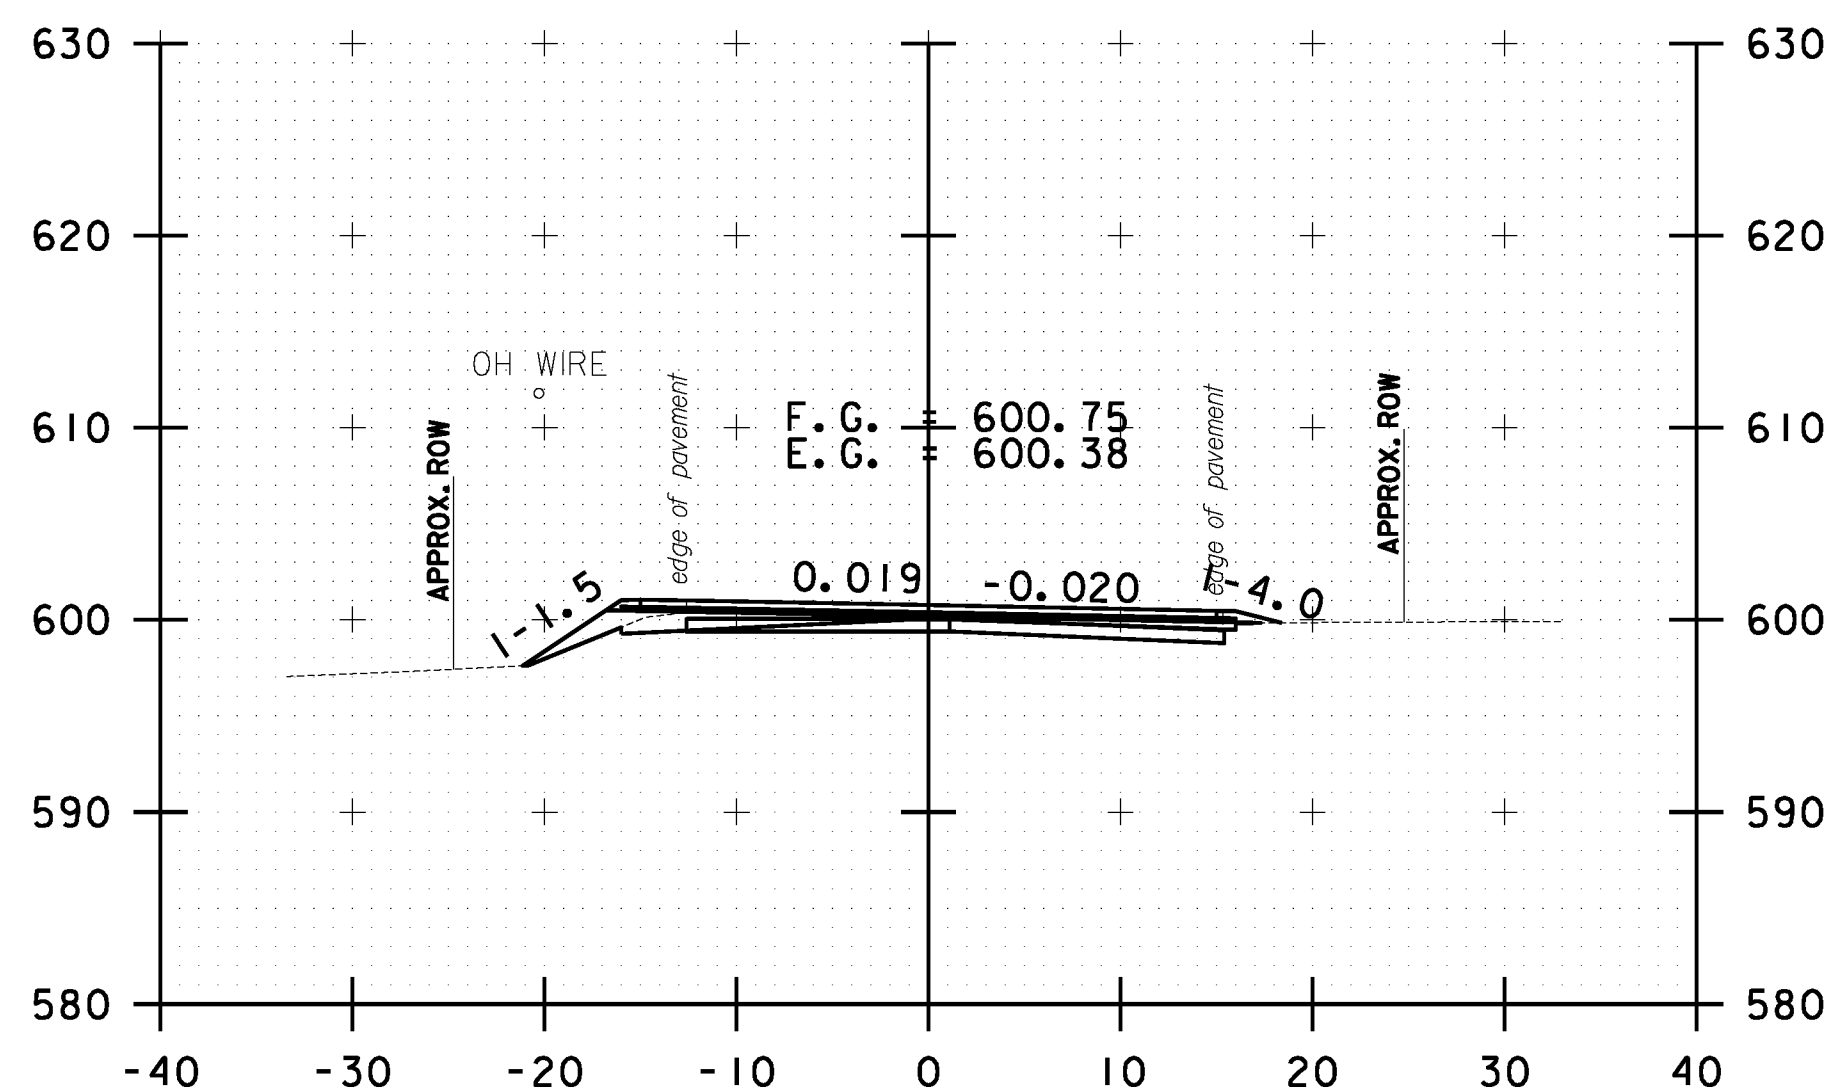

327+00.00

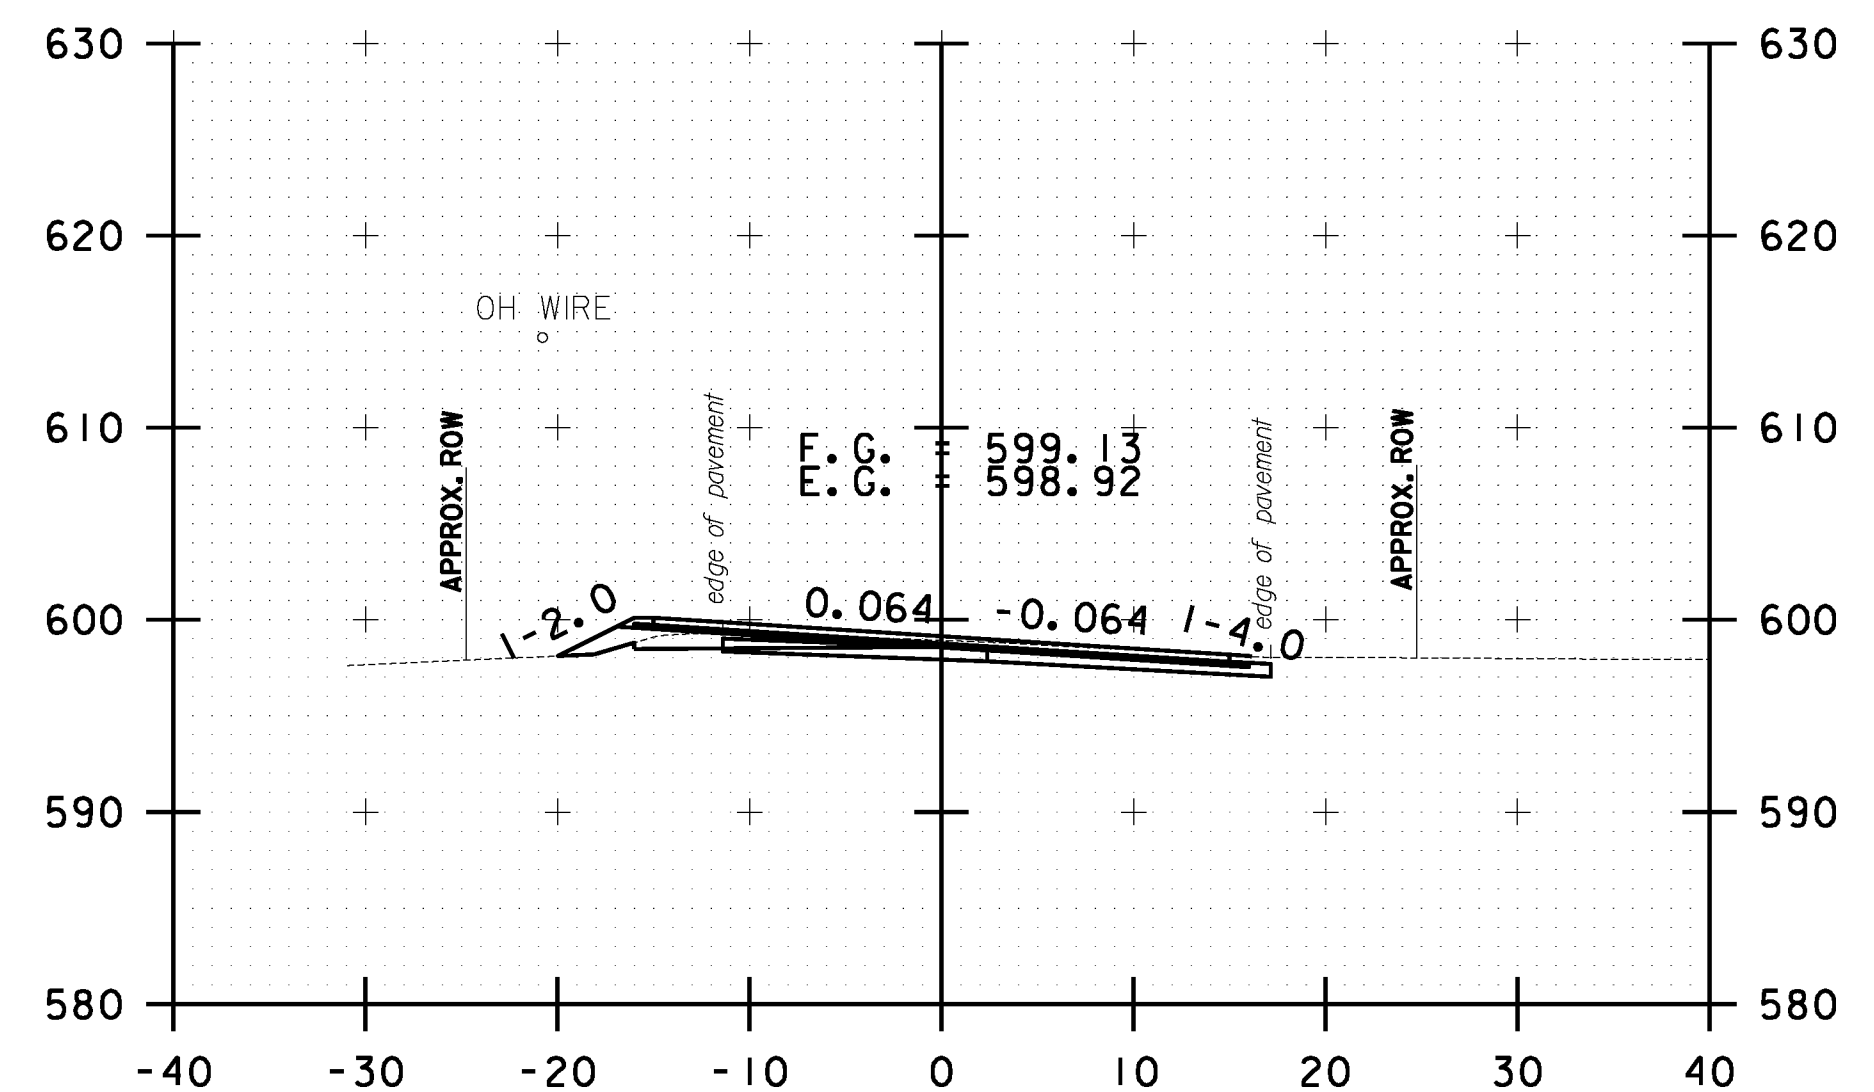

328+00.00



**STOCKBRIDGE
 CROSS SECTION
 SHEET #103**

PROJECT NAME: STOCKBRIDGE-BETHEL

PROJECT NUMBER: STP 2910(1)

FILE NAME: z10b214_stock.xc.dgn

PROJECT LEADER: D.E.G.

DESIGNED BY: L.M.B.

IPARM FILE: z10b214xs103.1

PLOT DATE: 3/17/2014

DRAWN BY: W.G.P.

CHECKED BY: J.P.S.

SHEET 316 OF 397