




FILE NAME = Y:\P\c\ass\ANY\K2\22425\CADD\MSTN\10b214_stock_xc.dgn
 DATE/TIME = 3/17/2014
 USER = 4916

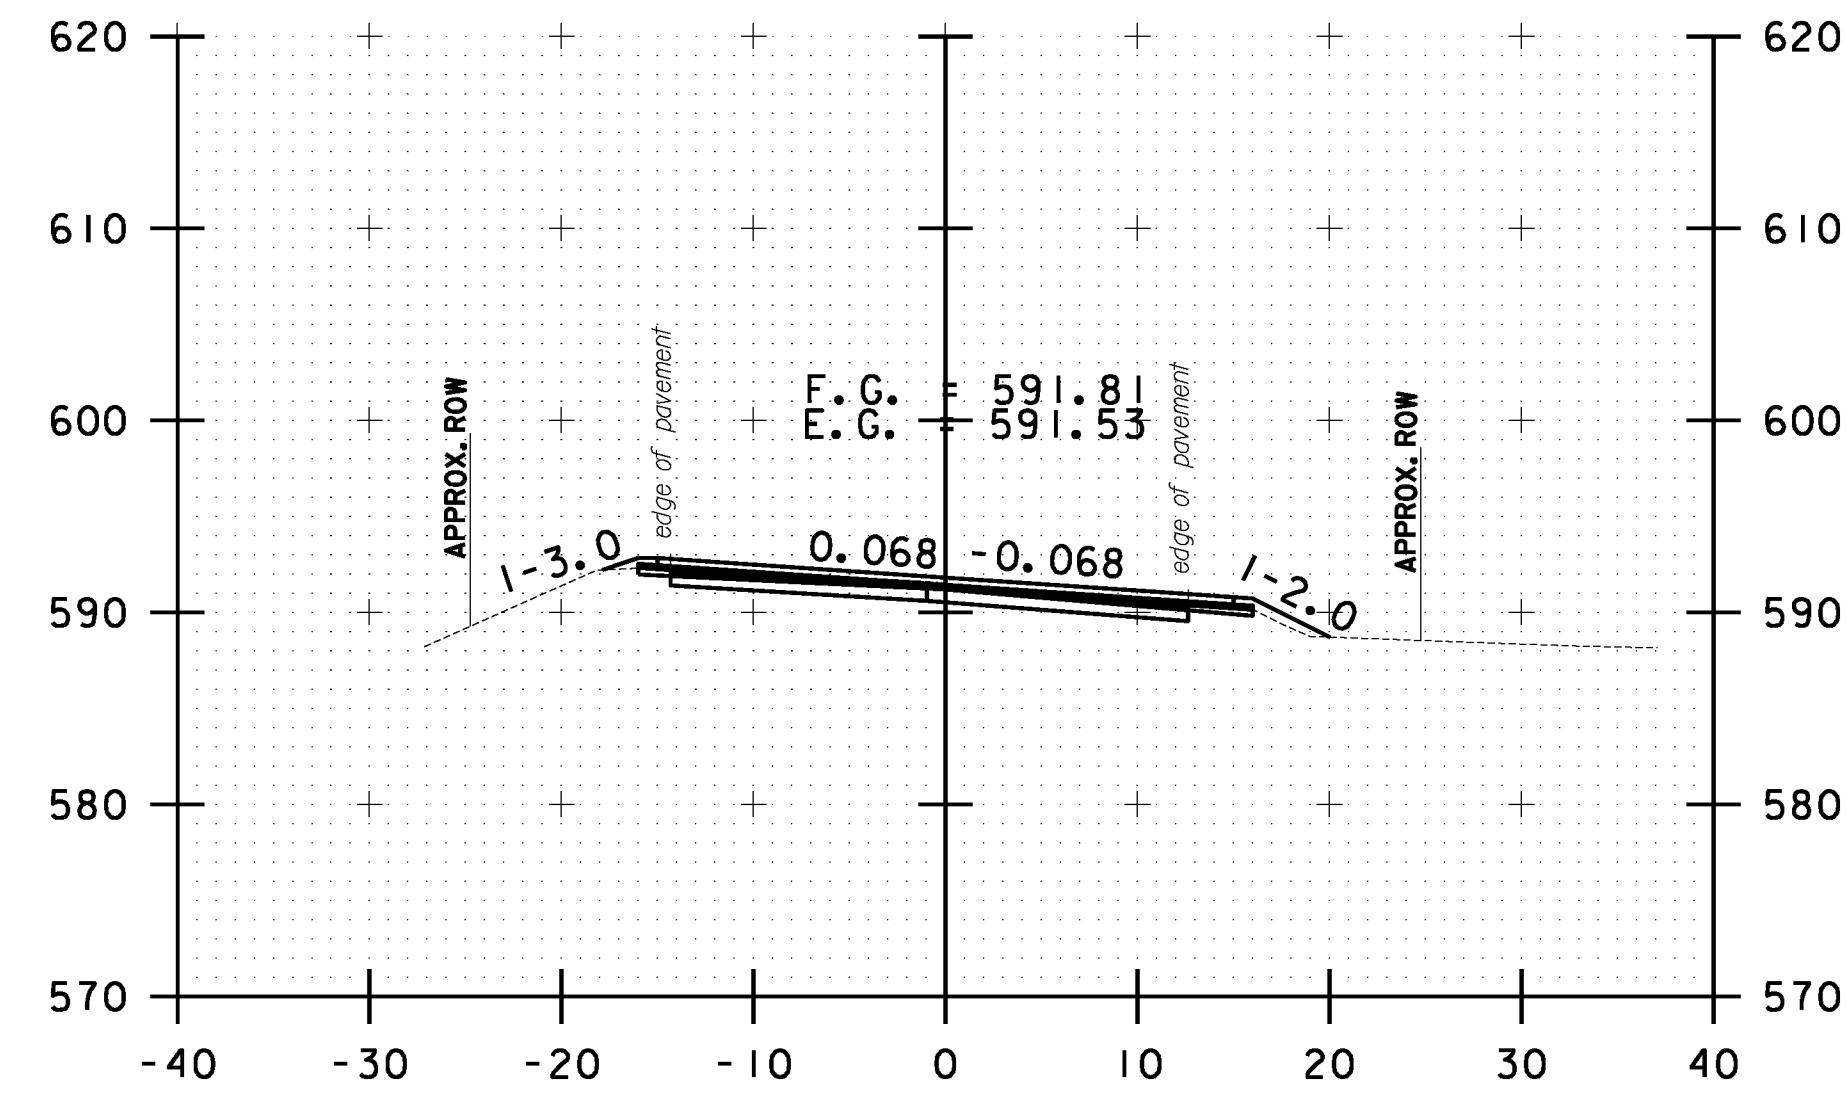


332+00.00

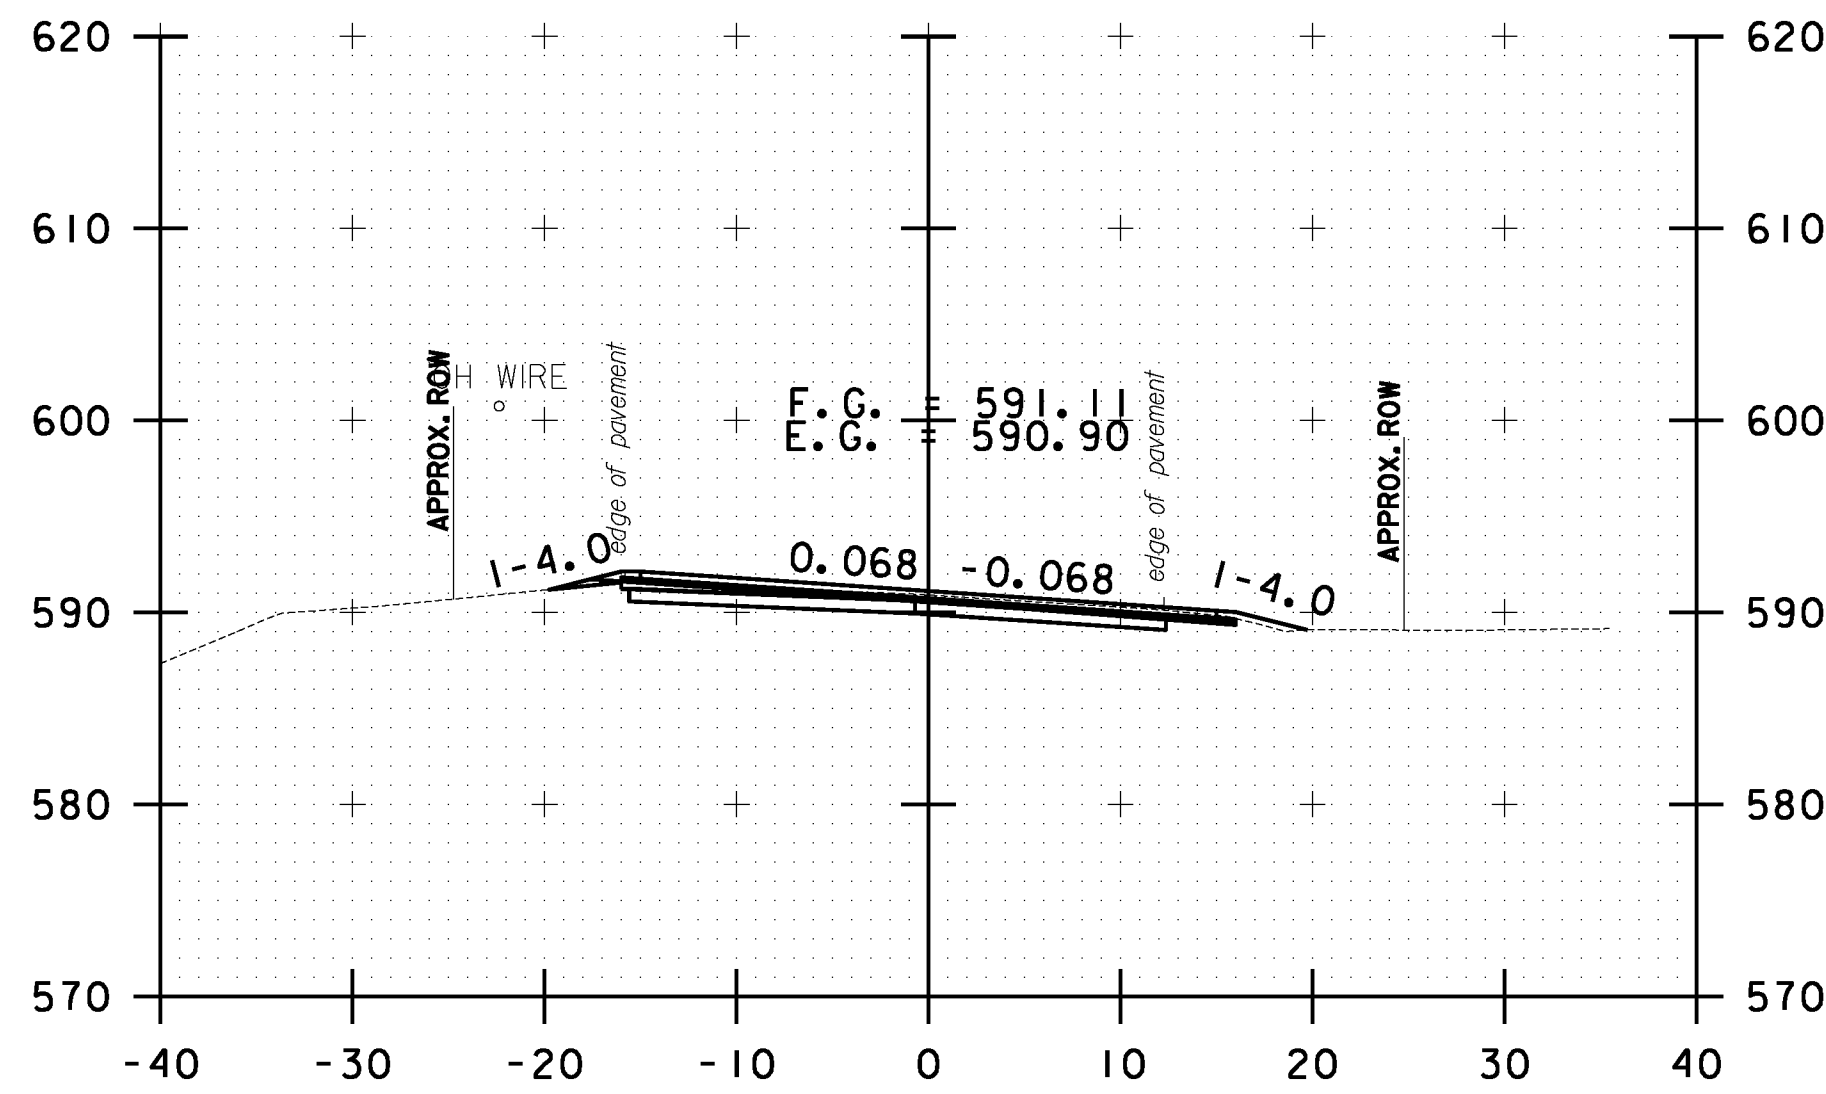


333+00.00

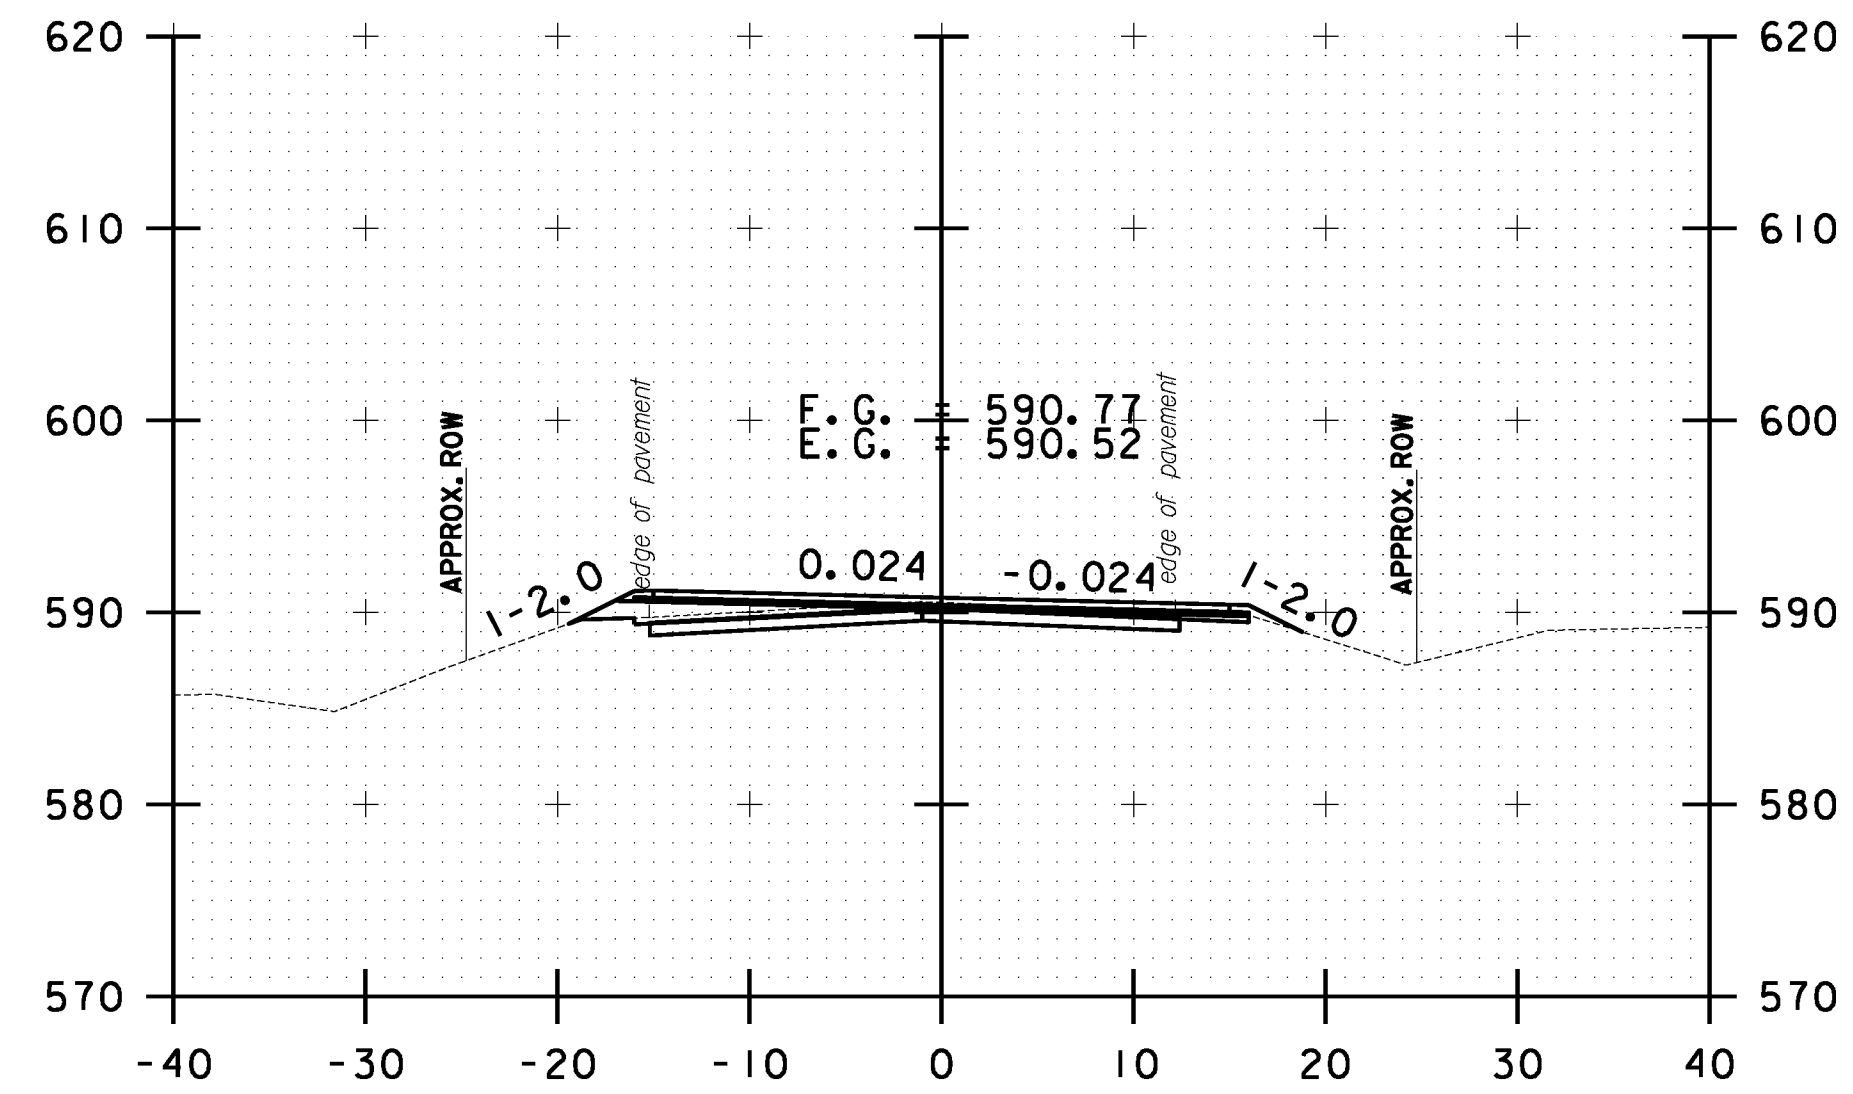


334+00.00

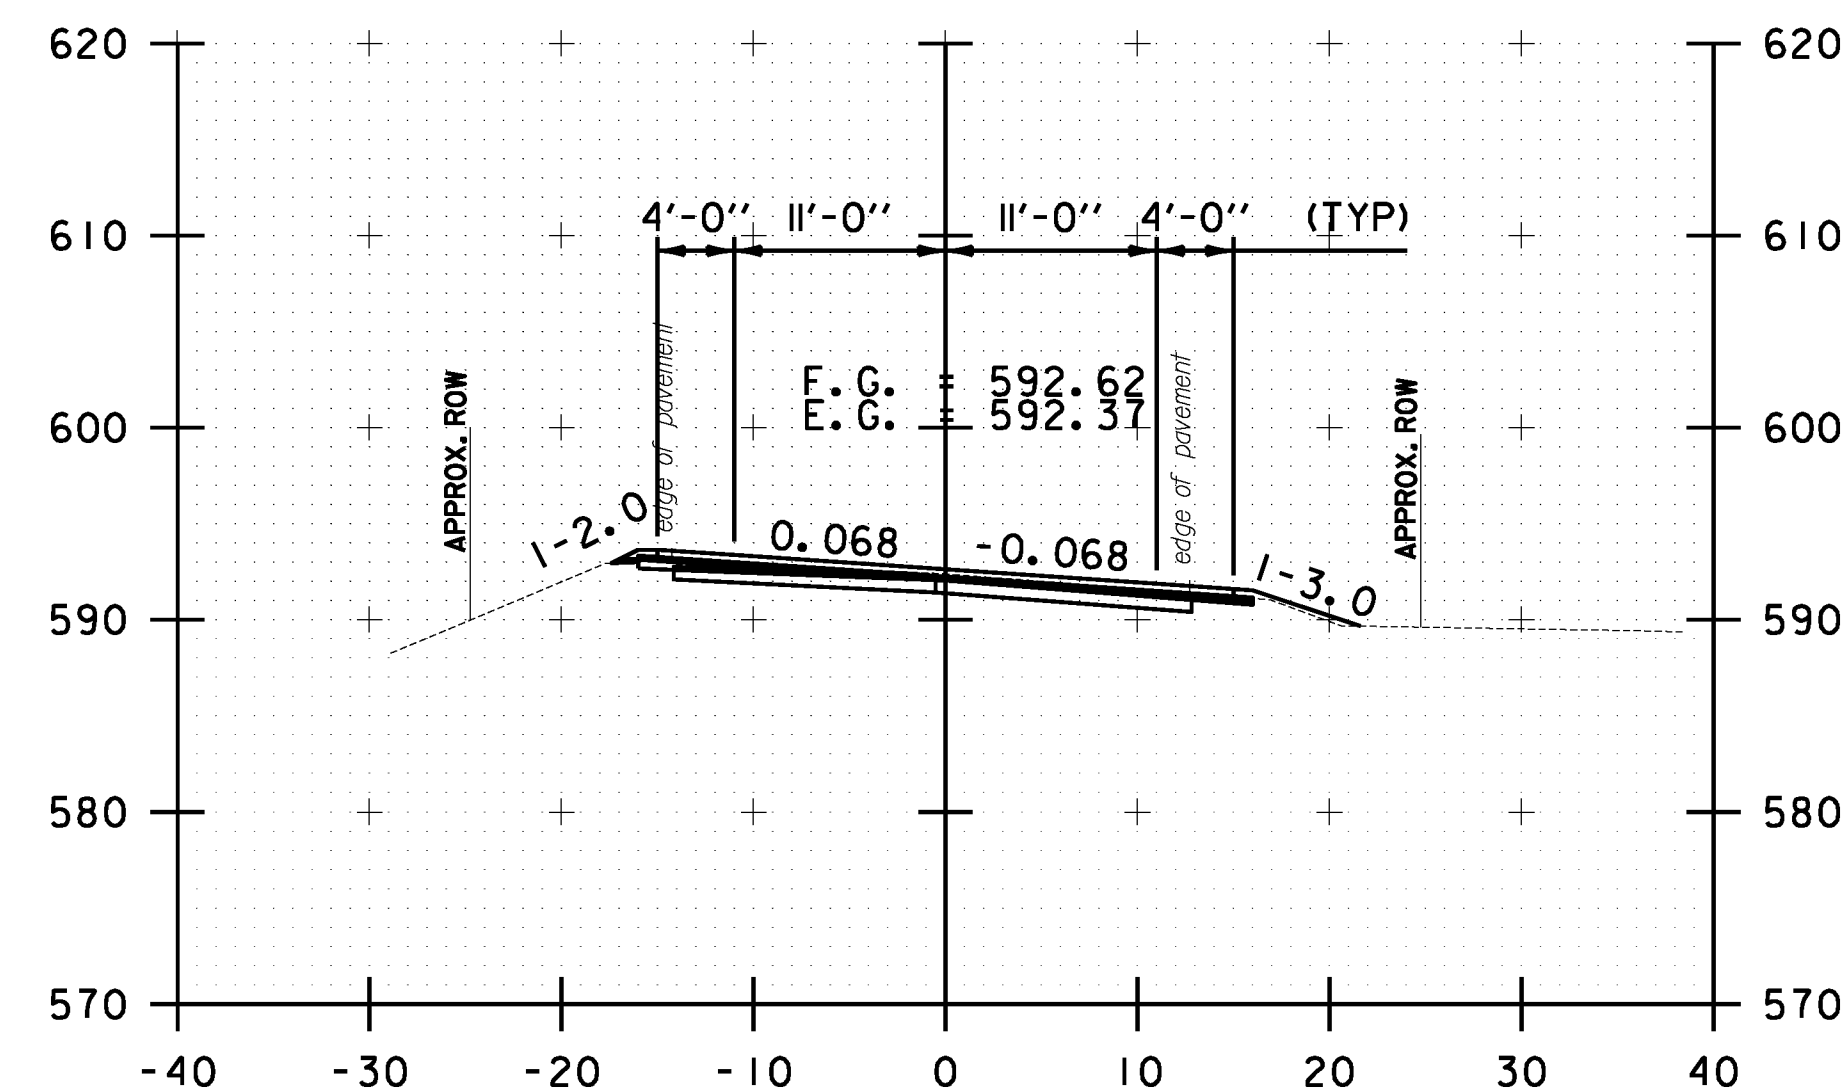

331+50.00

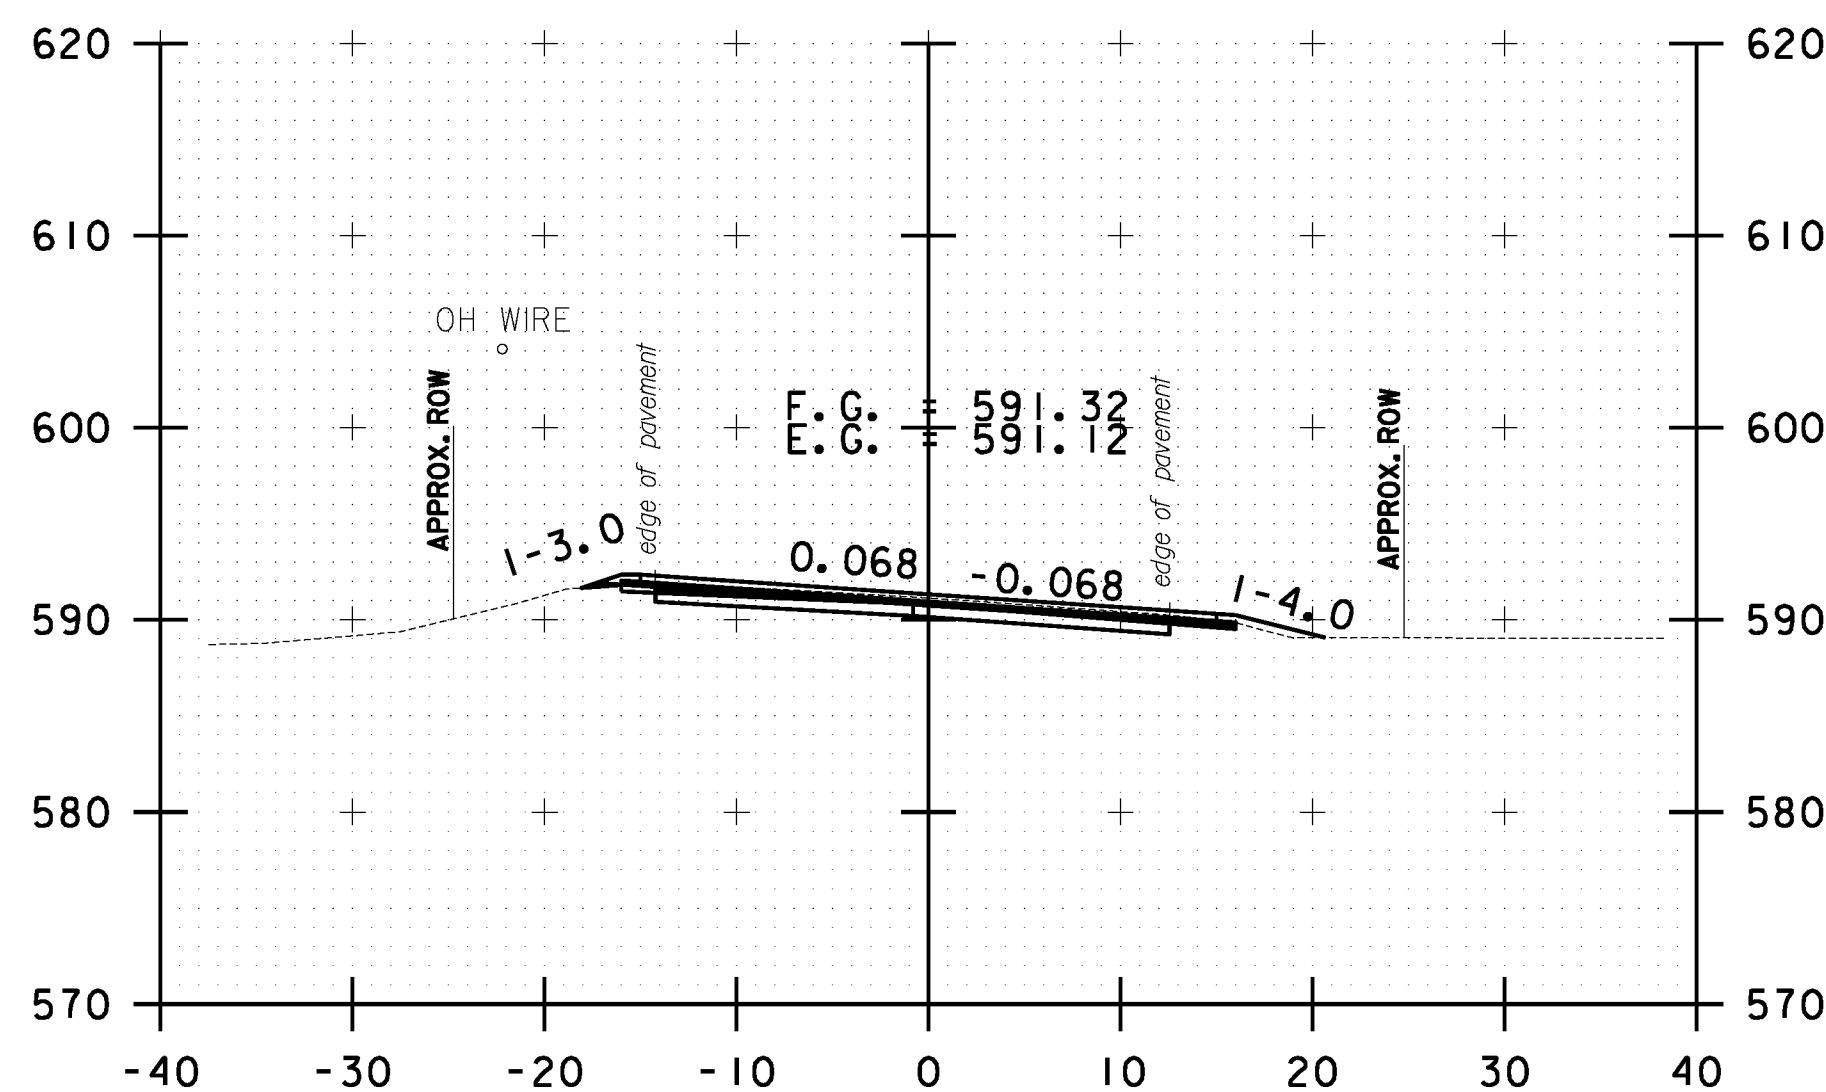

332+50.00

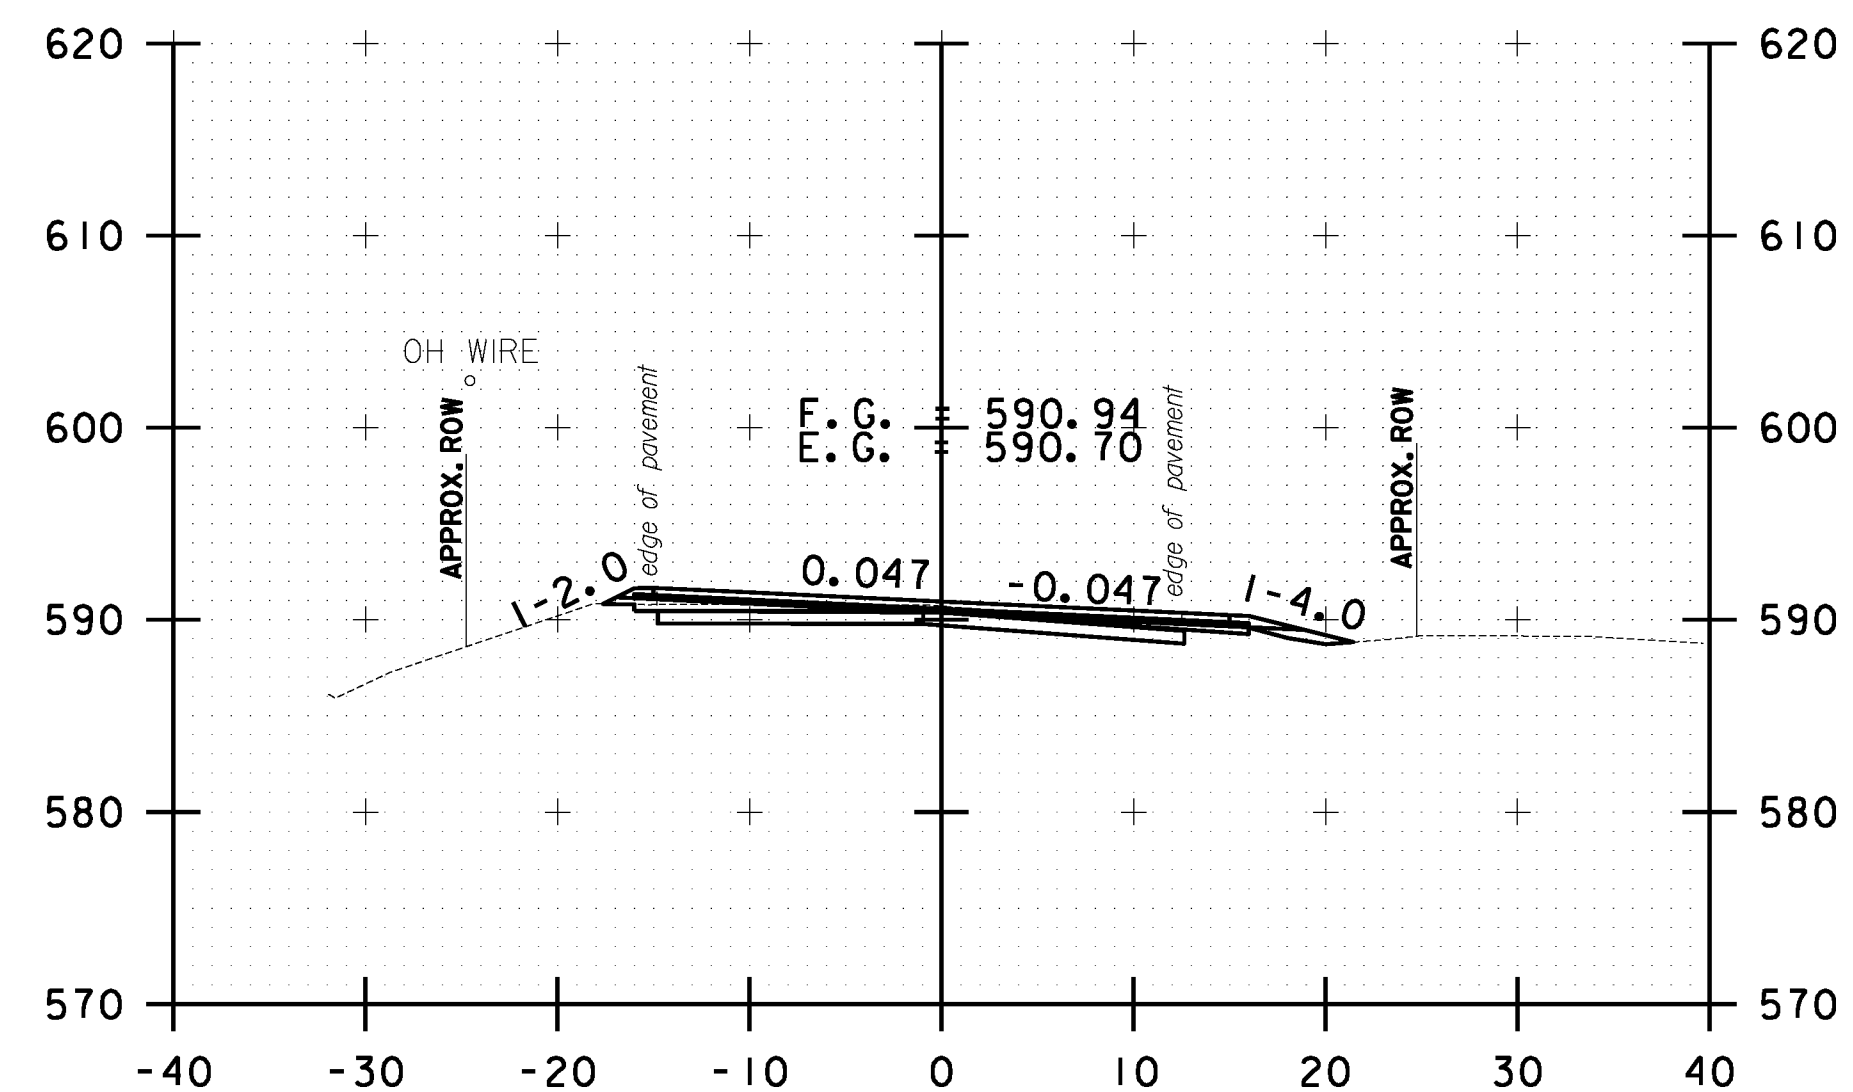

333+50.00



STOCKBRIDGE CROSS SECTION SHEET #105	PROJECT NAME: STOCKBRIDGE-BETHEL
	PROJECT NUMBER: STP 2910(1)
	FILE NAME: z10b214_stock_xc.dgn
DESIGNED BY: L.M.B.	PLOT DATE: 3/17/2014
IPARM FILE: z10b214xs105.1	DRAWN BY: W.G.P.
	CHECKED BY: J.P.S.
	SHEET 318 OF 397