




FILE NAME = Y:\P\c\res\any\k2\22425\CADD\MSTN\10b214_stock_xc.dgn
 DATE/TIME = 3/17/2014
 USER = 4916

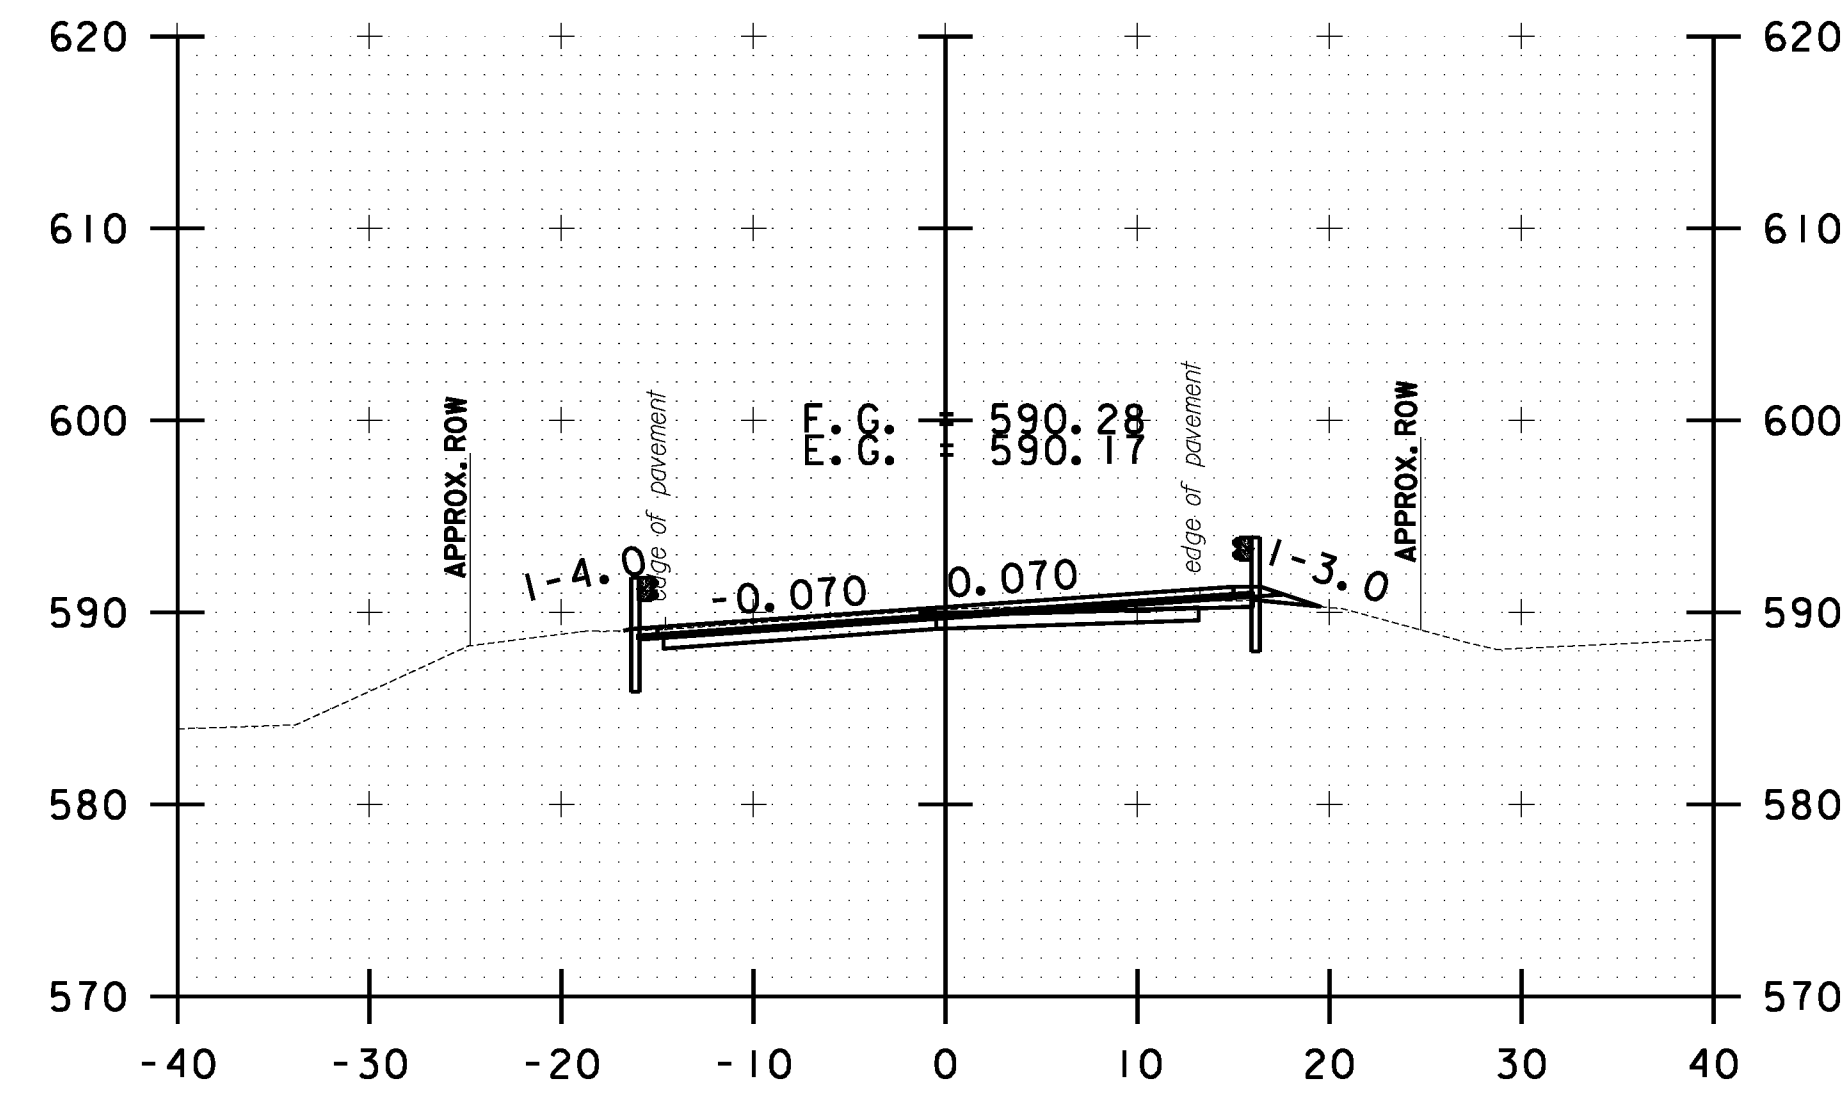


337+50.00

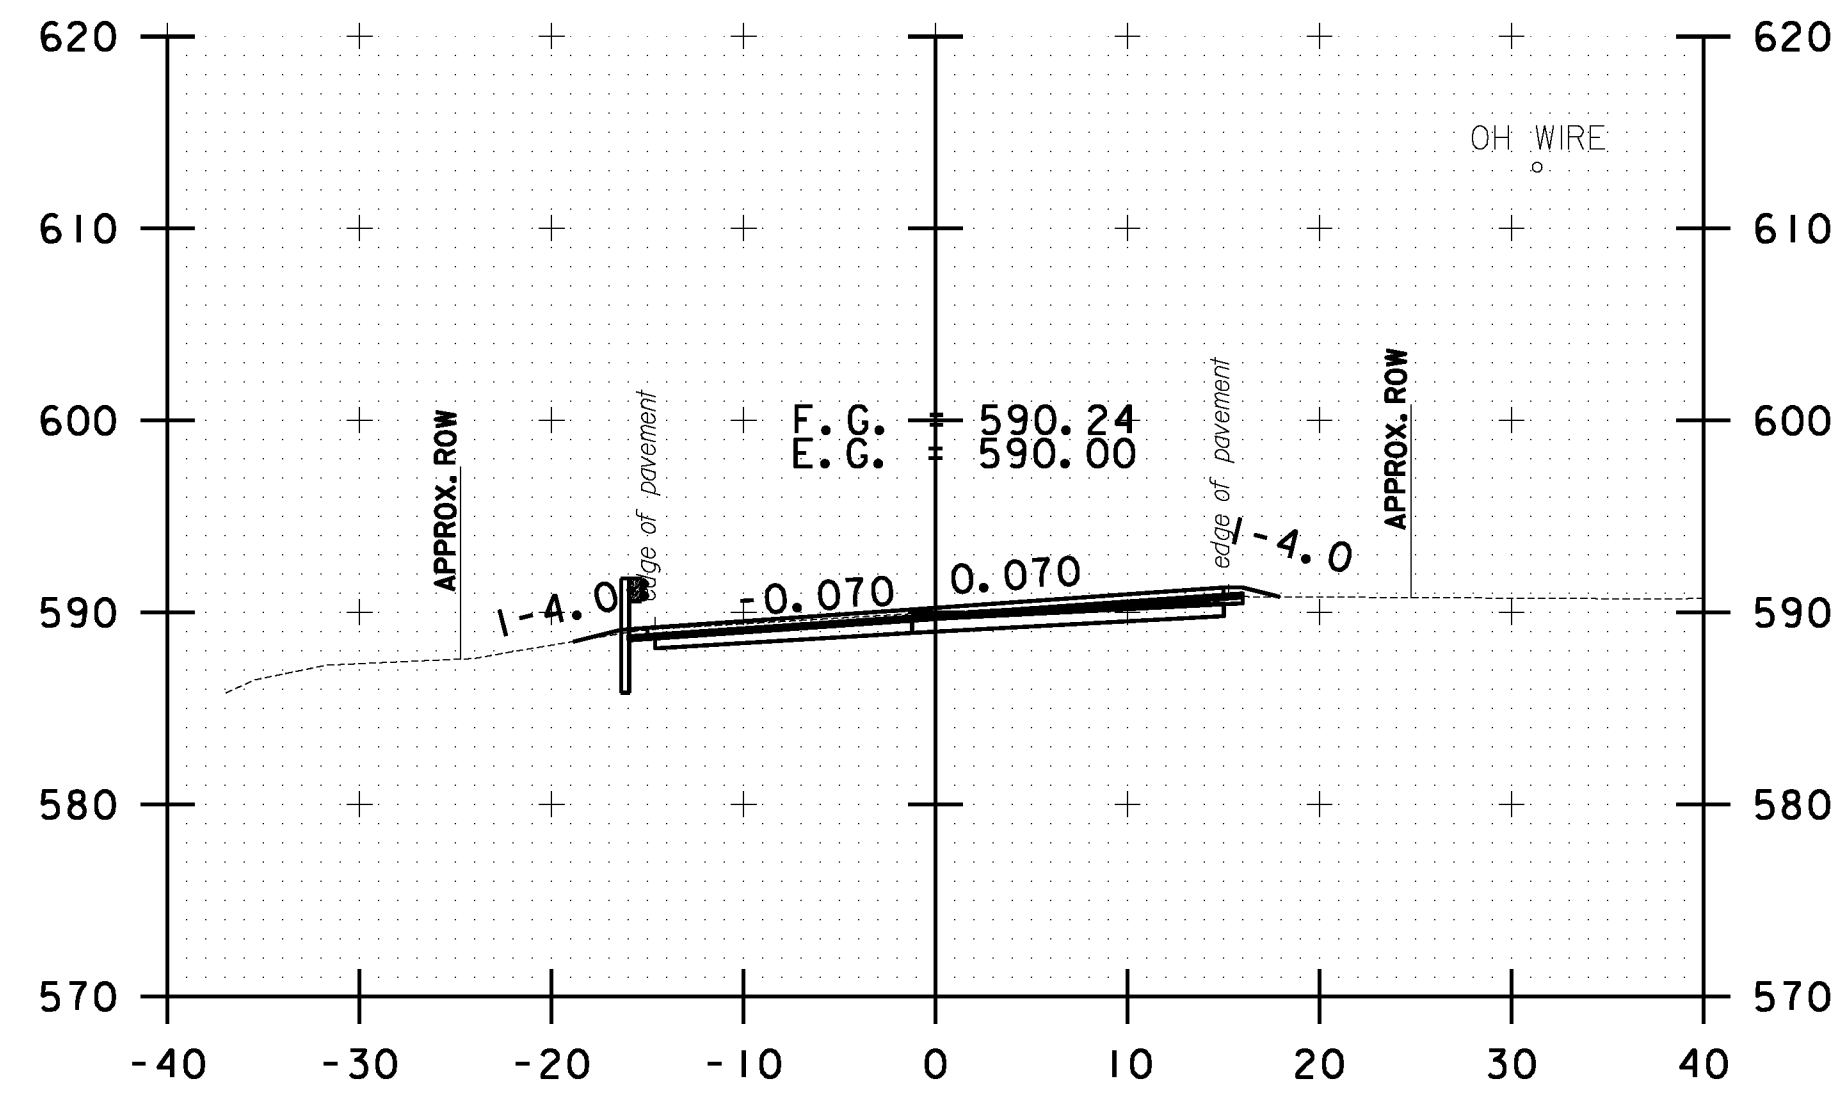


338+50.00

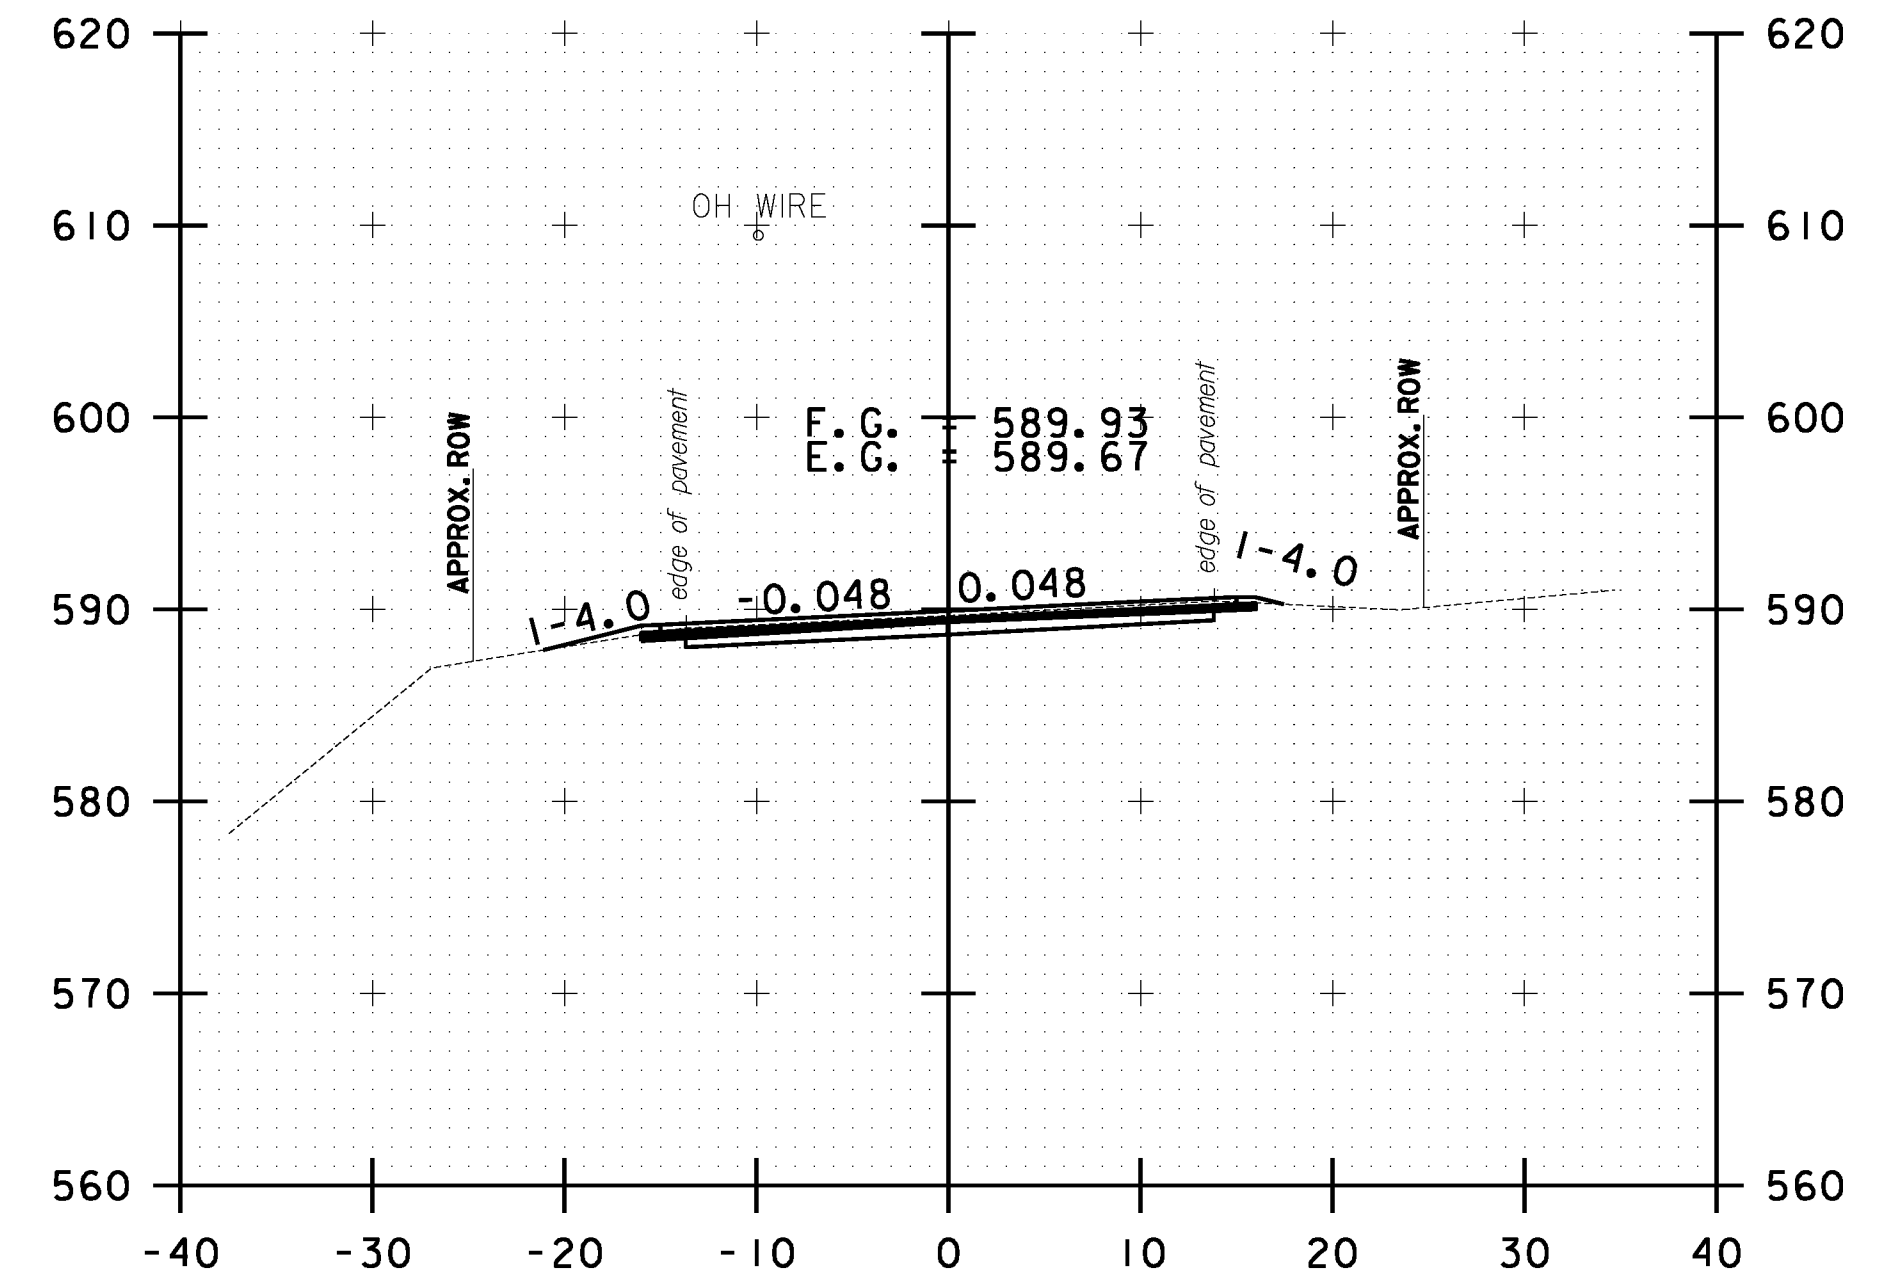


339+50.00

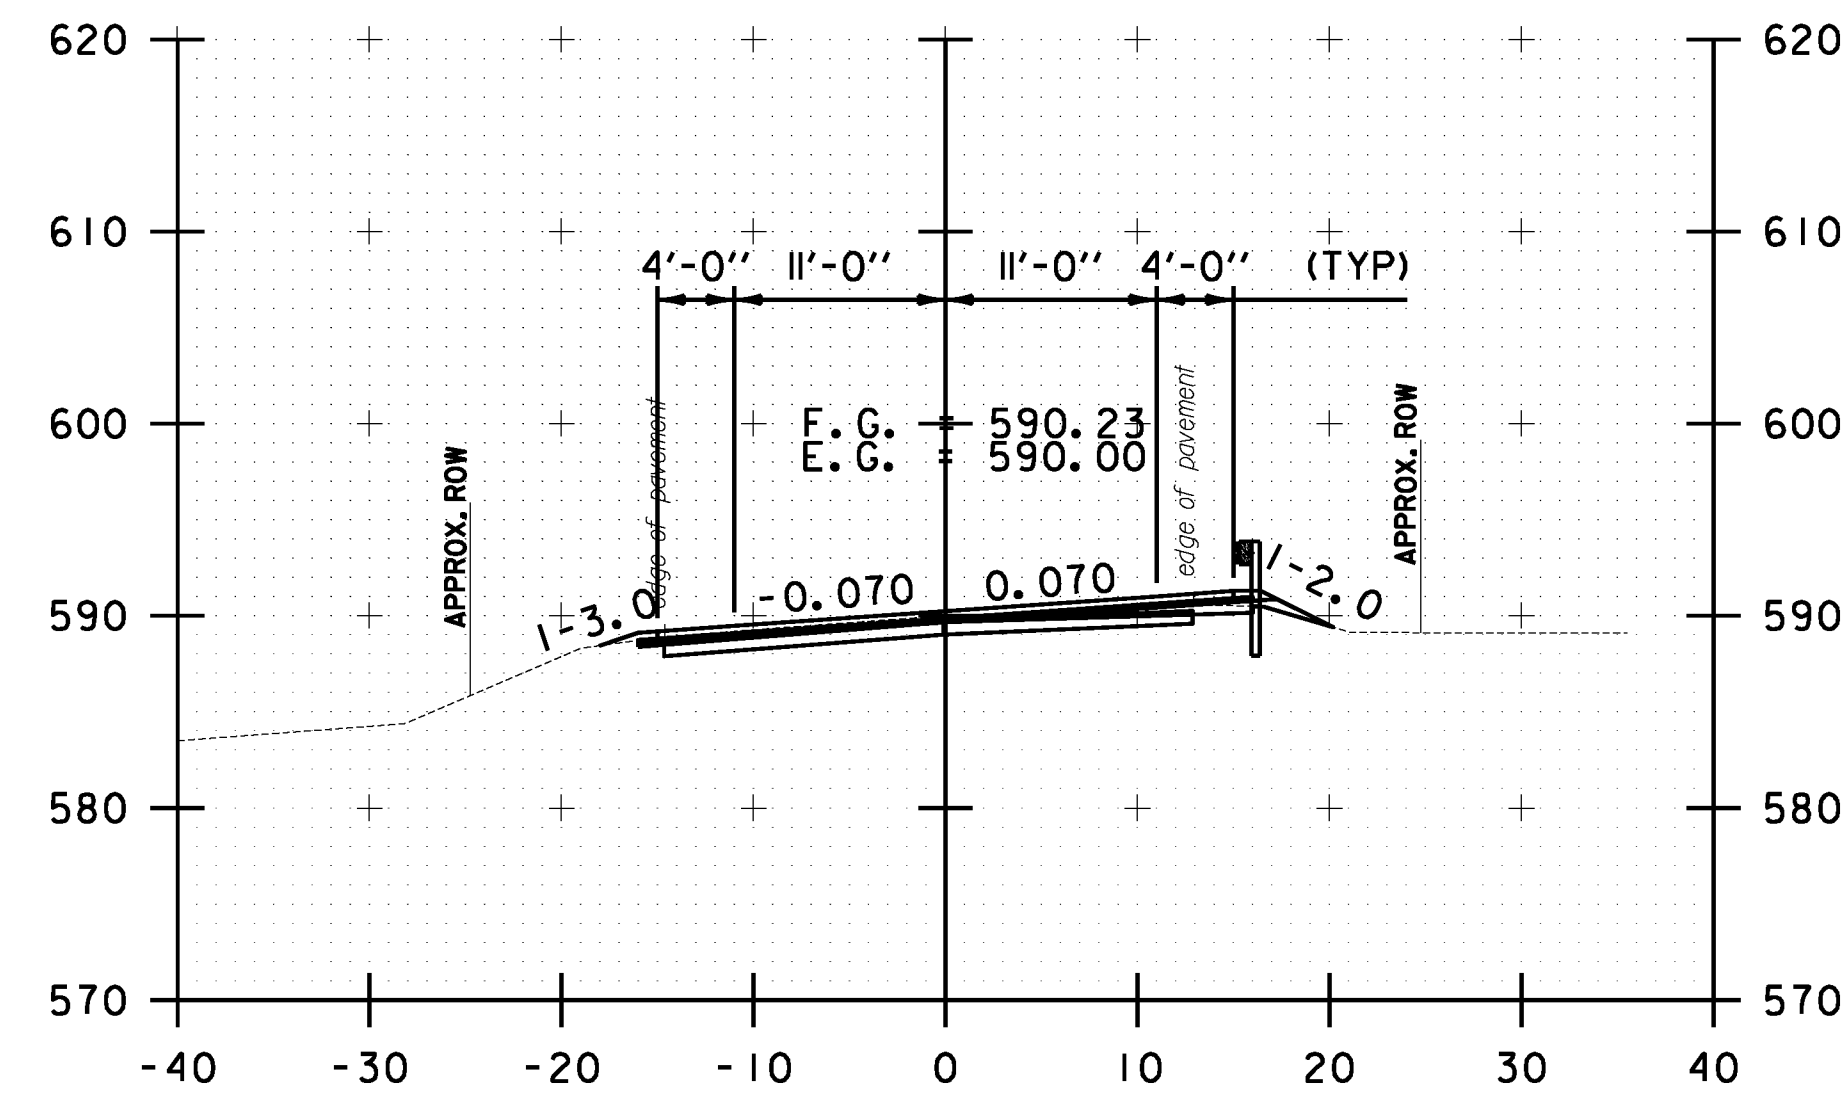

337+00.00

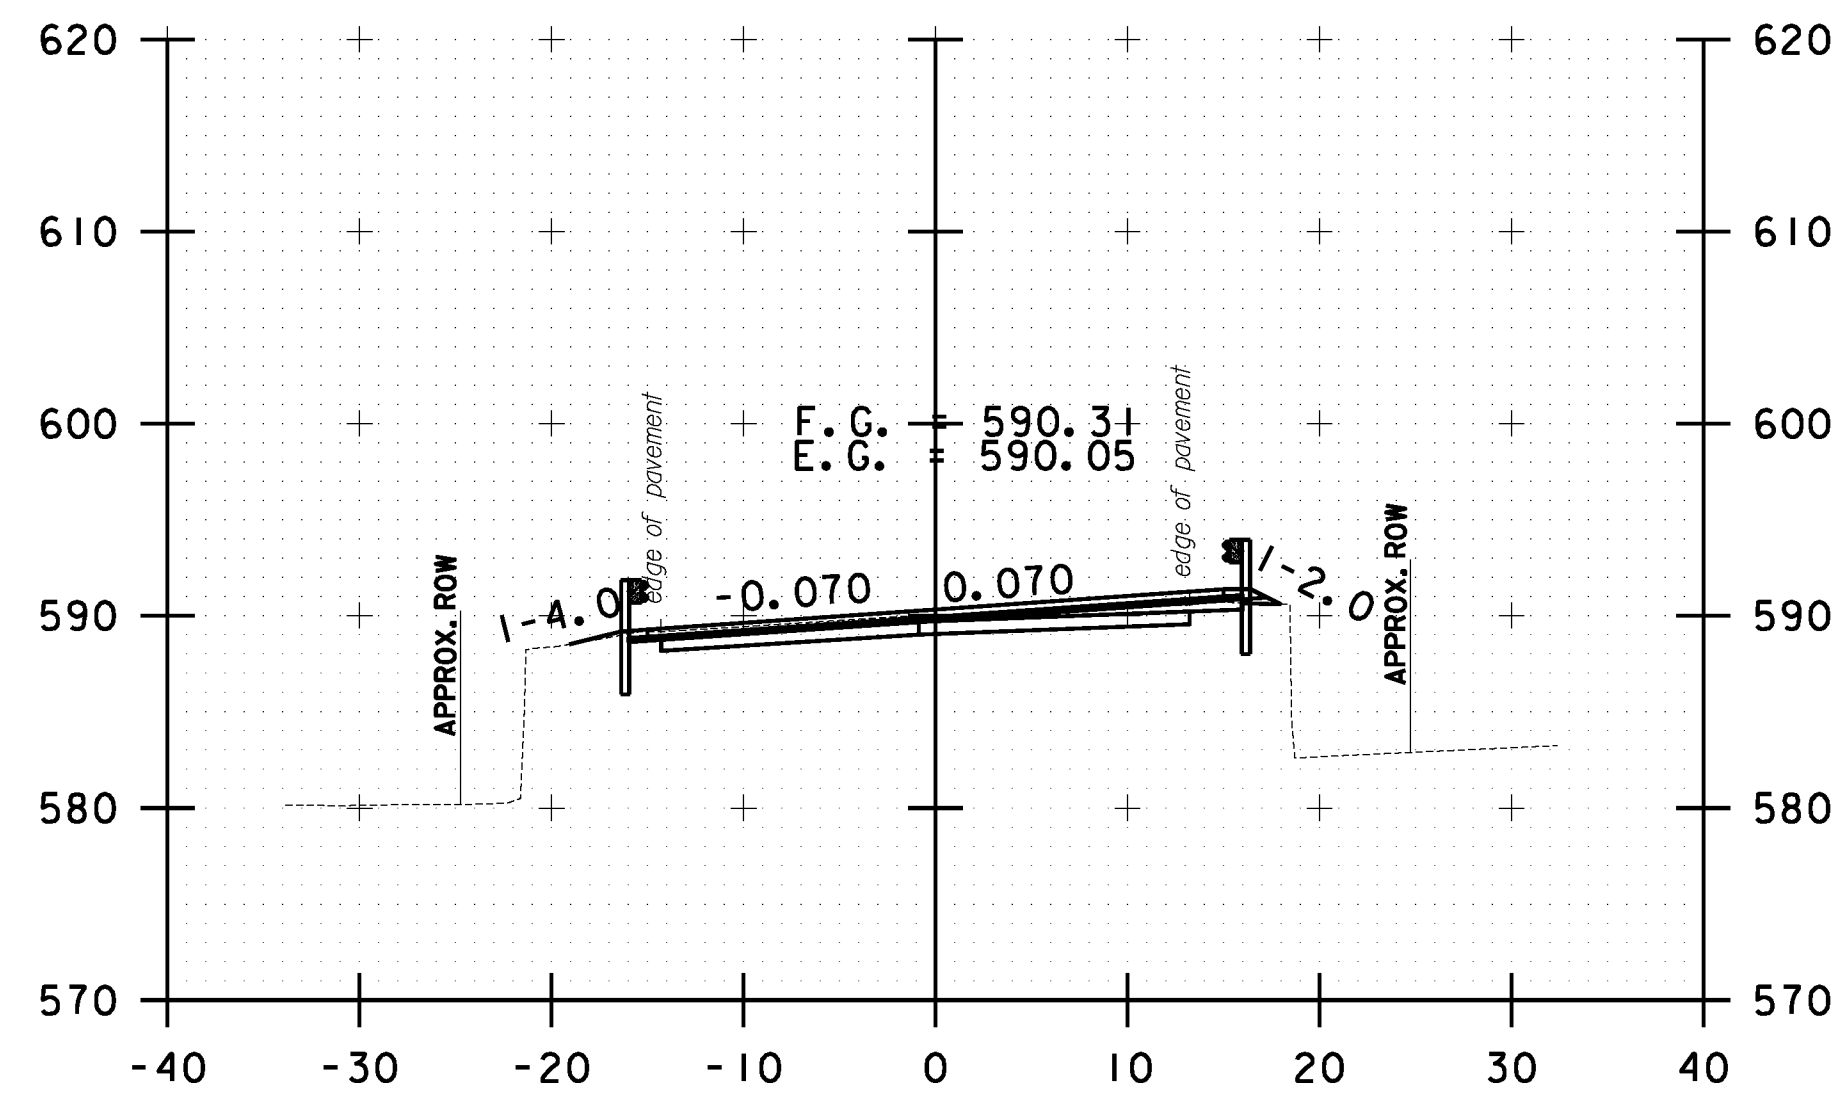

338+00.00

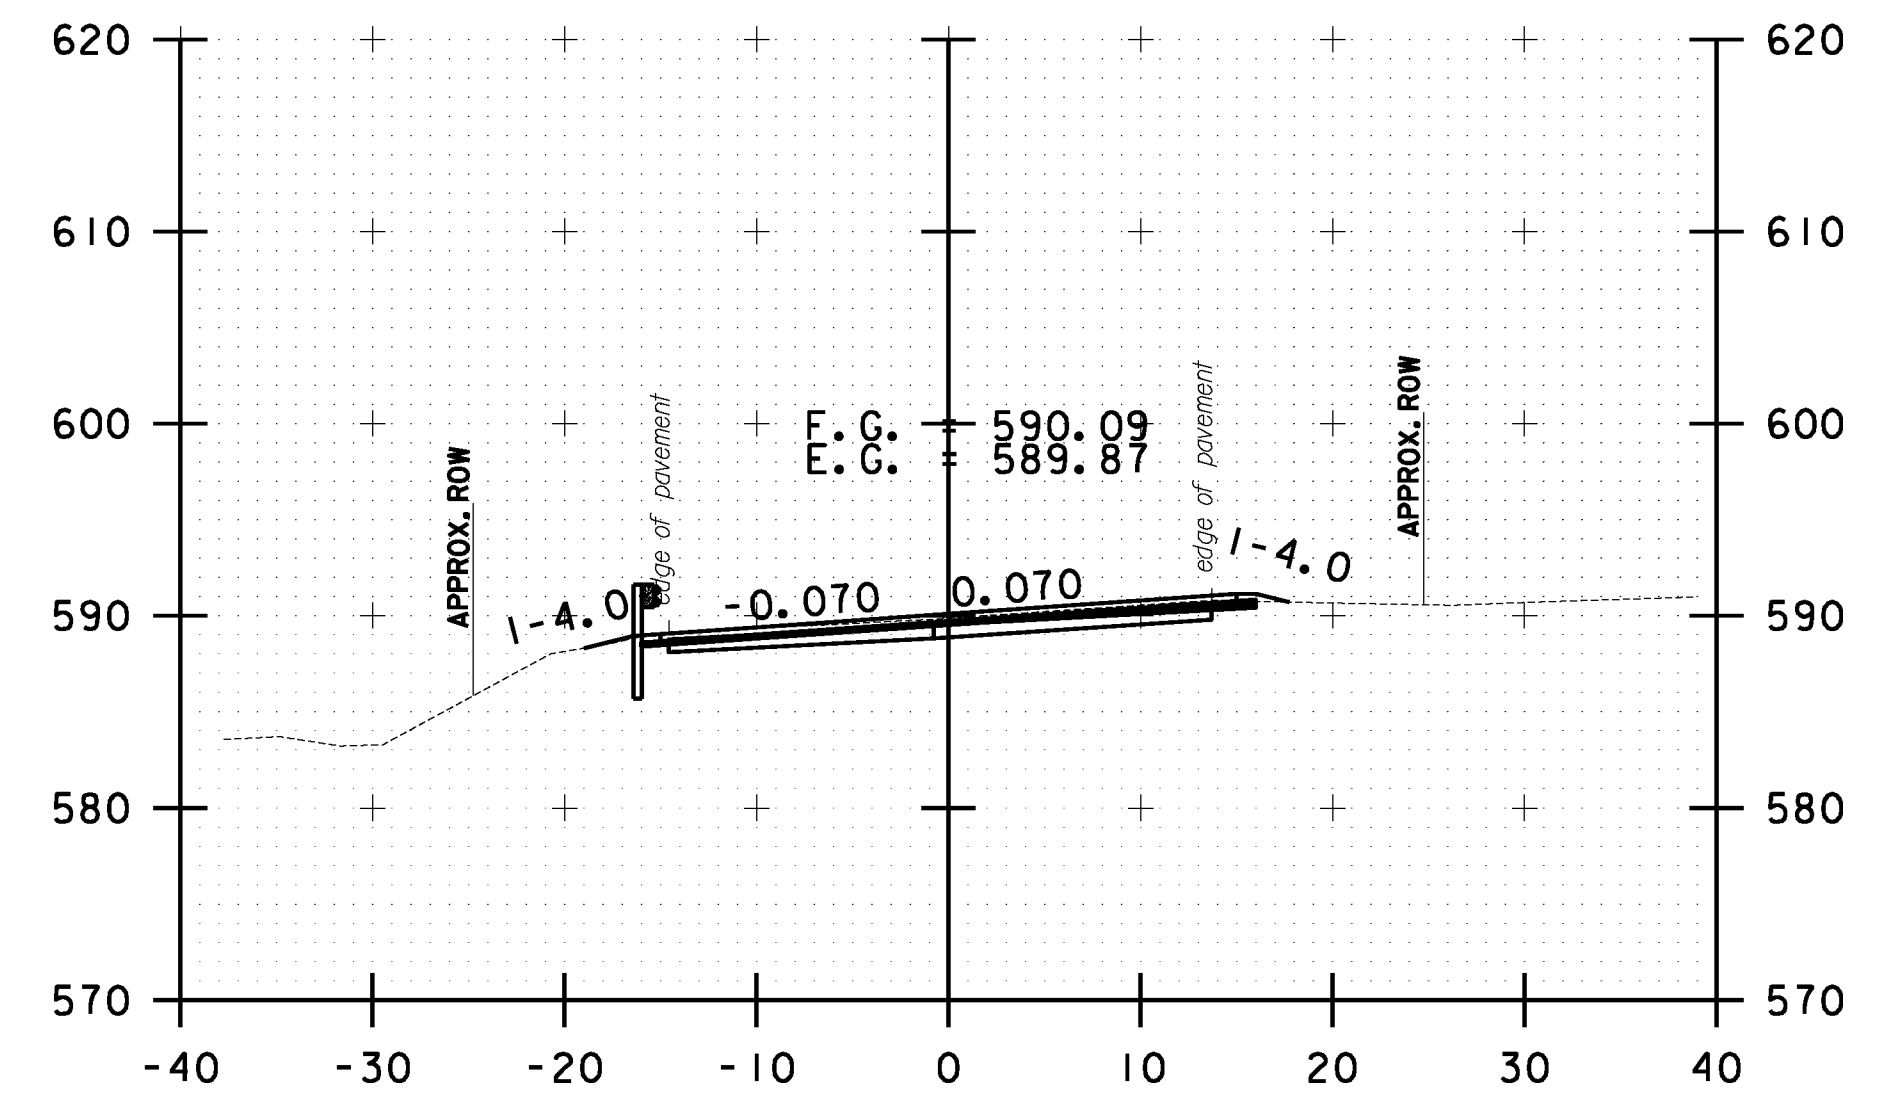

339+00.00



STOCKBRIDGE CROSS SECTION SHEET #107	PROJECT NAME: STOCKBRIDGE-BETHEL
	PROJECT NUMBER: STP 2910(1)
	FILE NAME: z10b214_stock_xc.dgn
	IPARM FILE: z10b214xs107.1
	PLOT DATE: 3/17/2014
	DRAWN BY: W.G.P.
	CHECKED BY: J.P.S.
	SHEET 320 OF 397