




FILE NAME = I:\Projects\141\14122426\CADD\141\14122426\14122426.dgn  
 DATE = 3/17/2014  
 USER = LMB

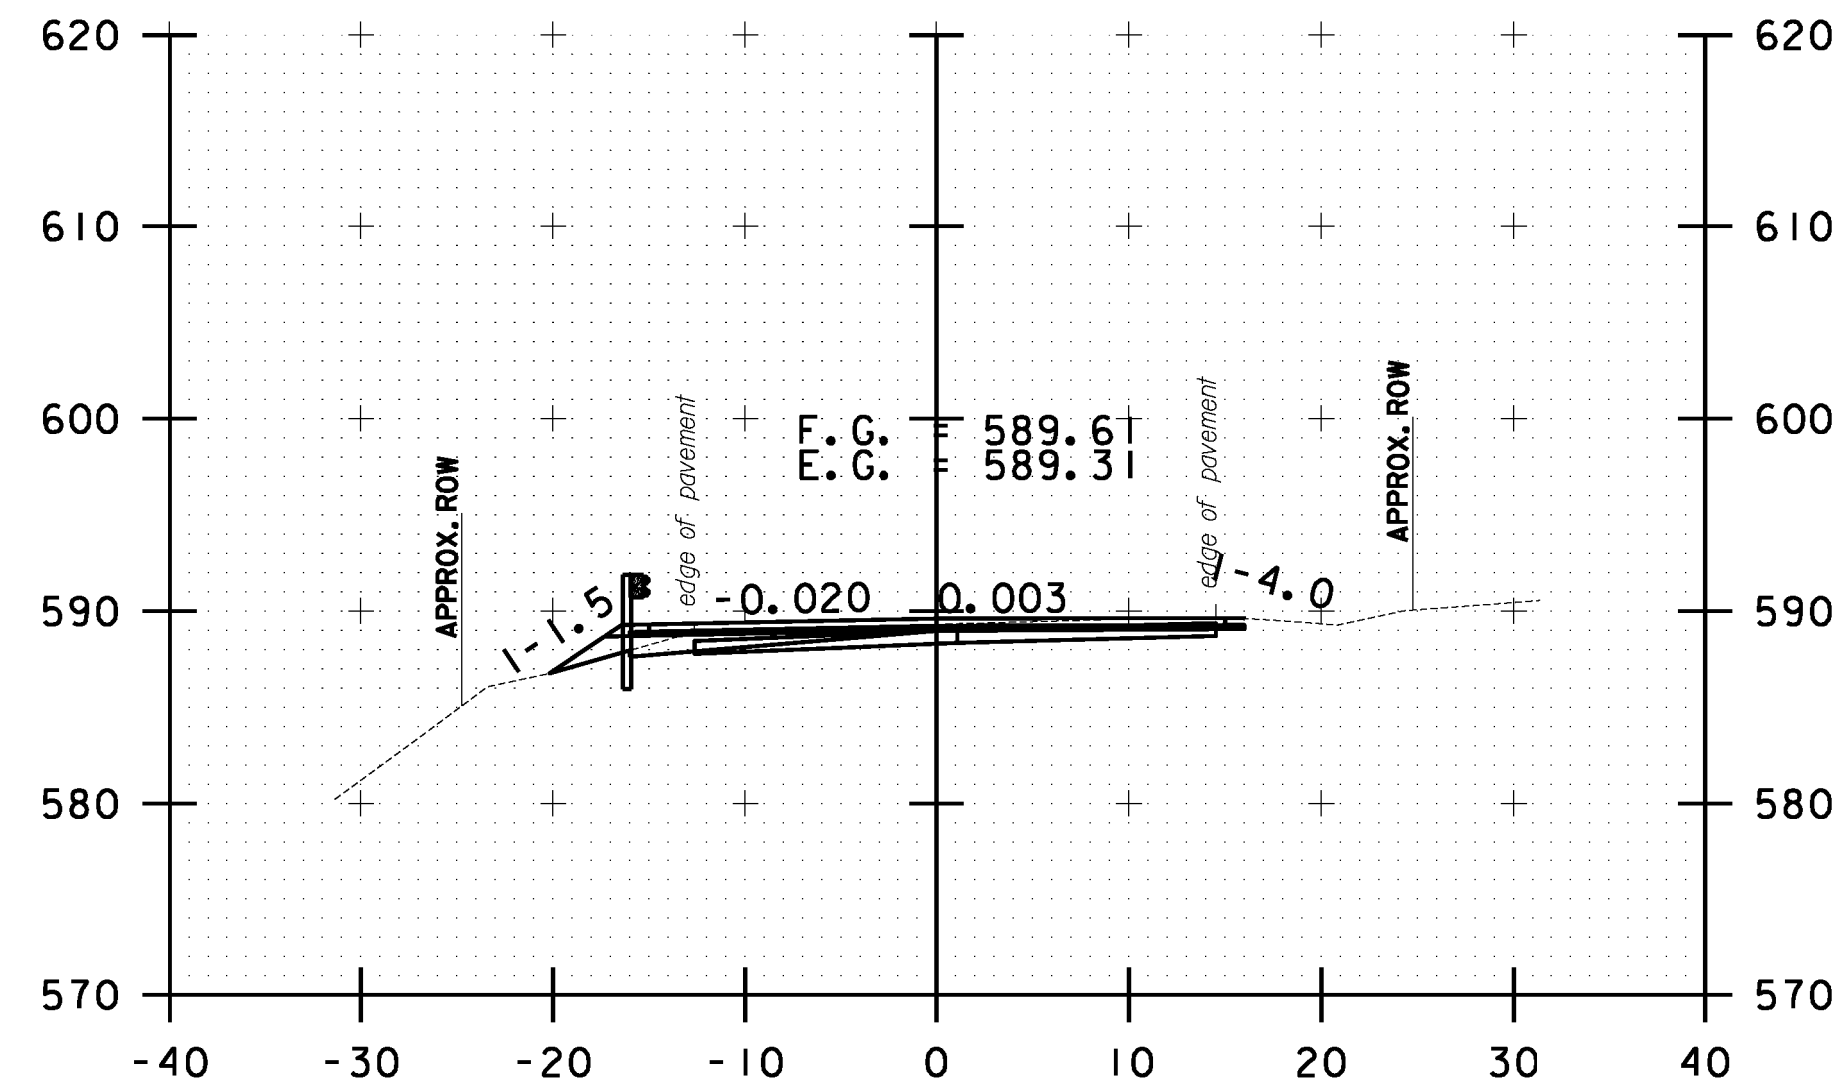


340+50.00

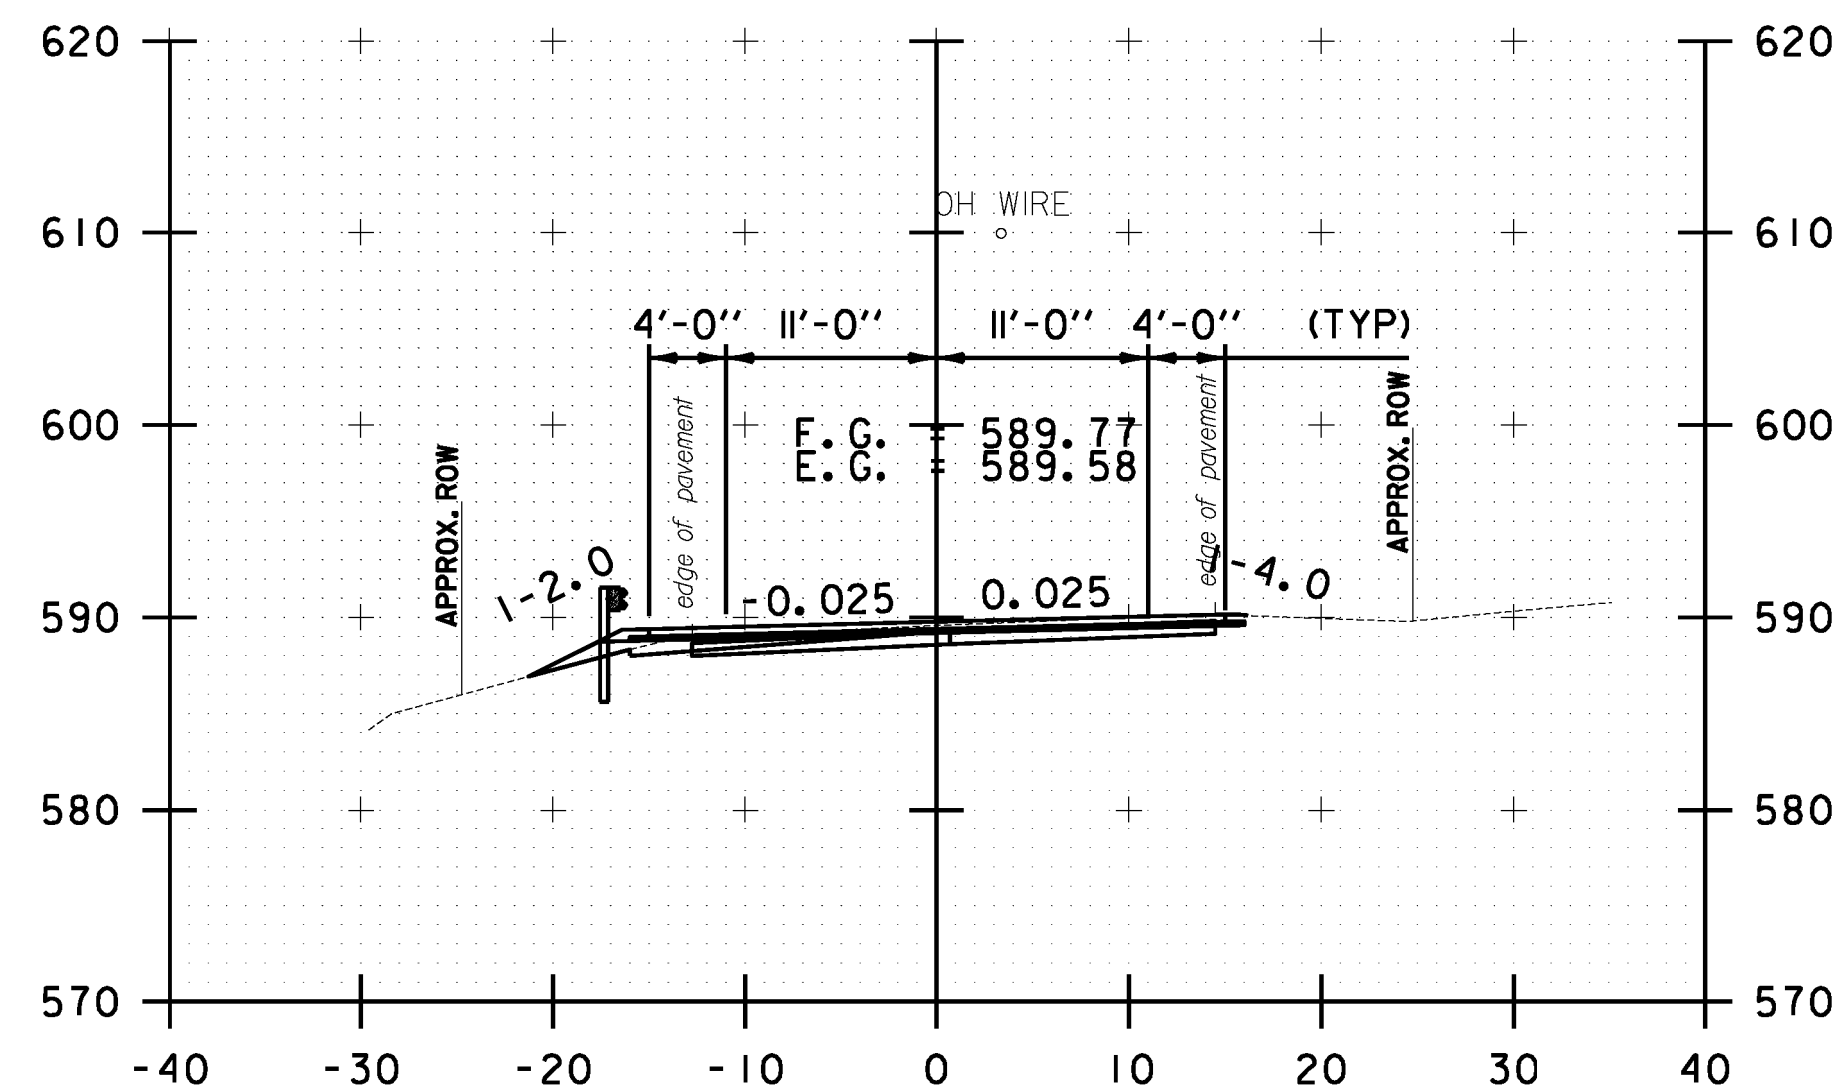


340+00.00

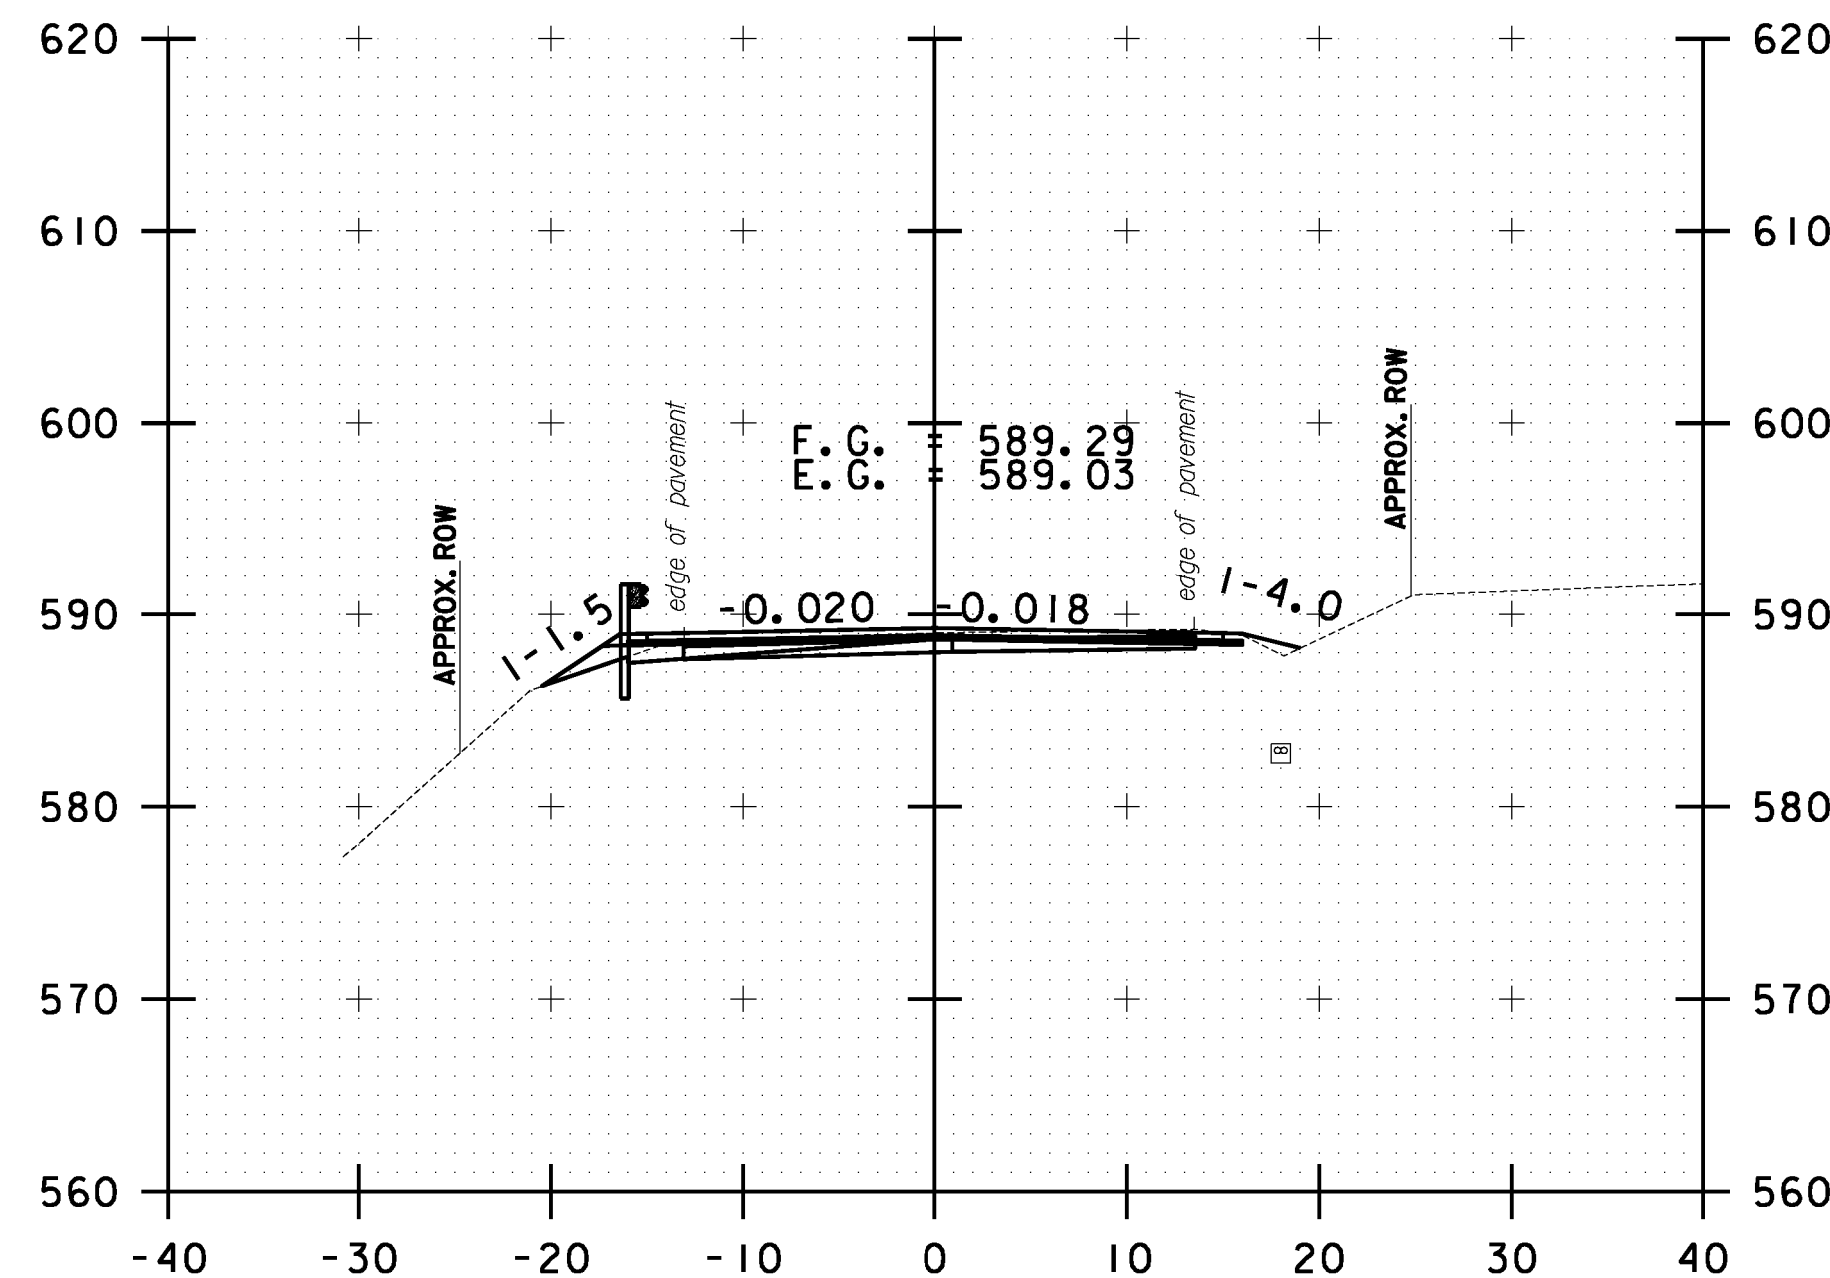


341+50.00

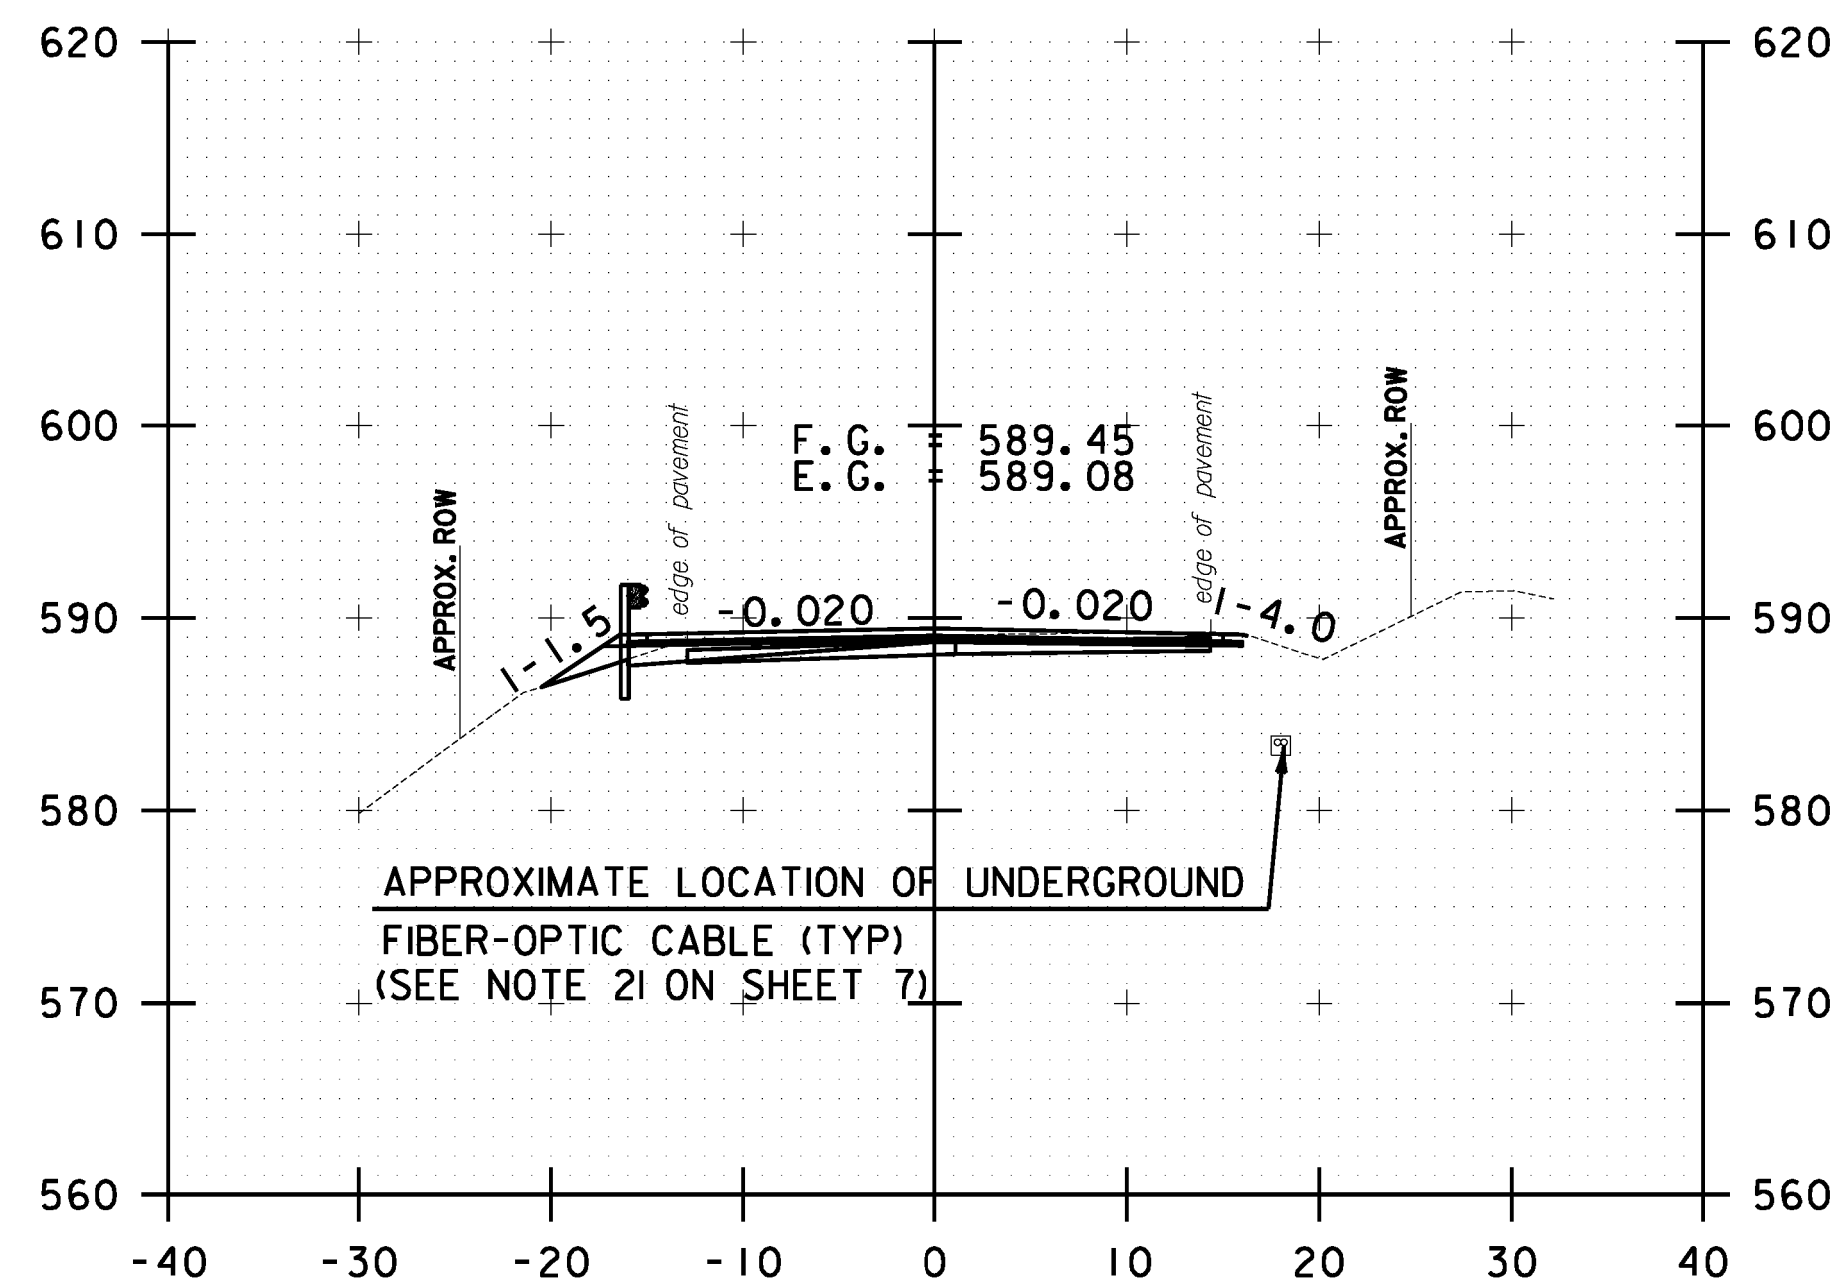


341+00.00

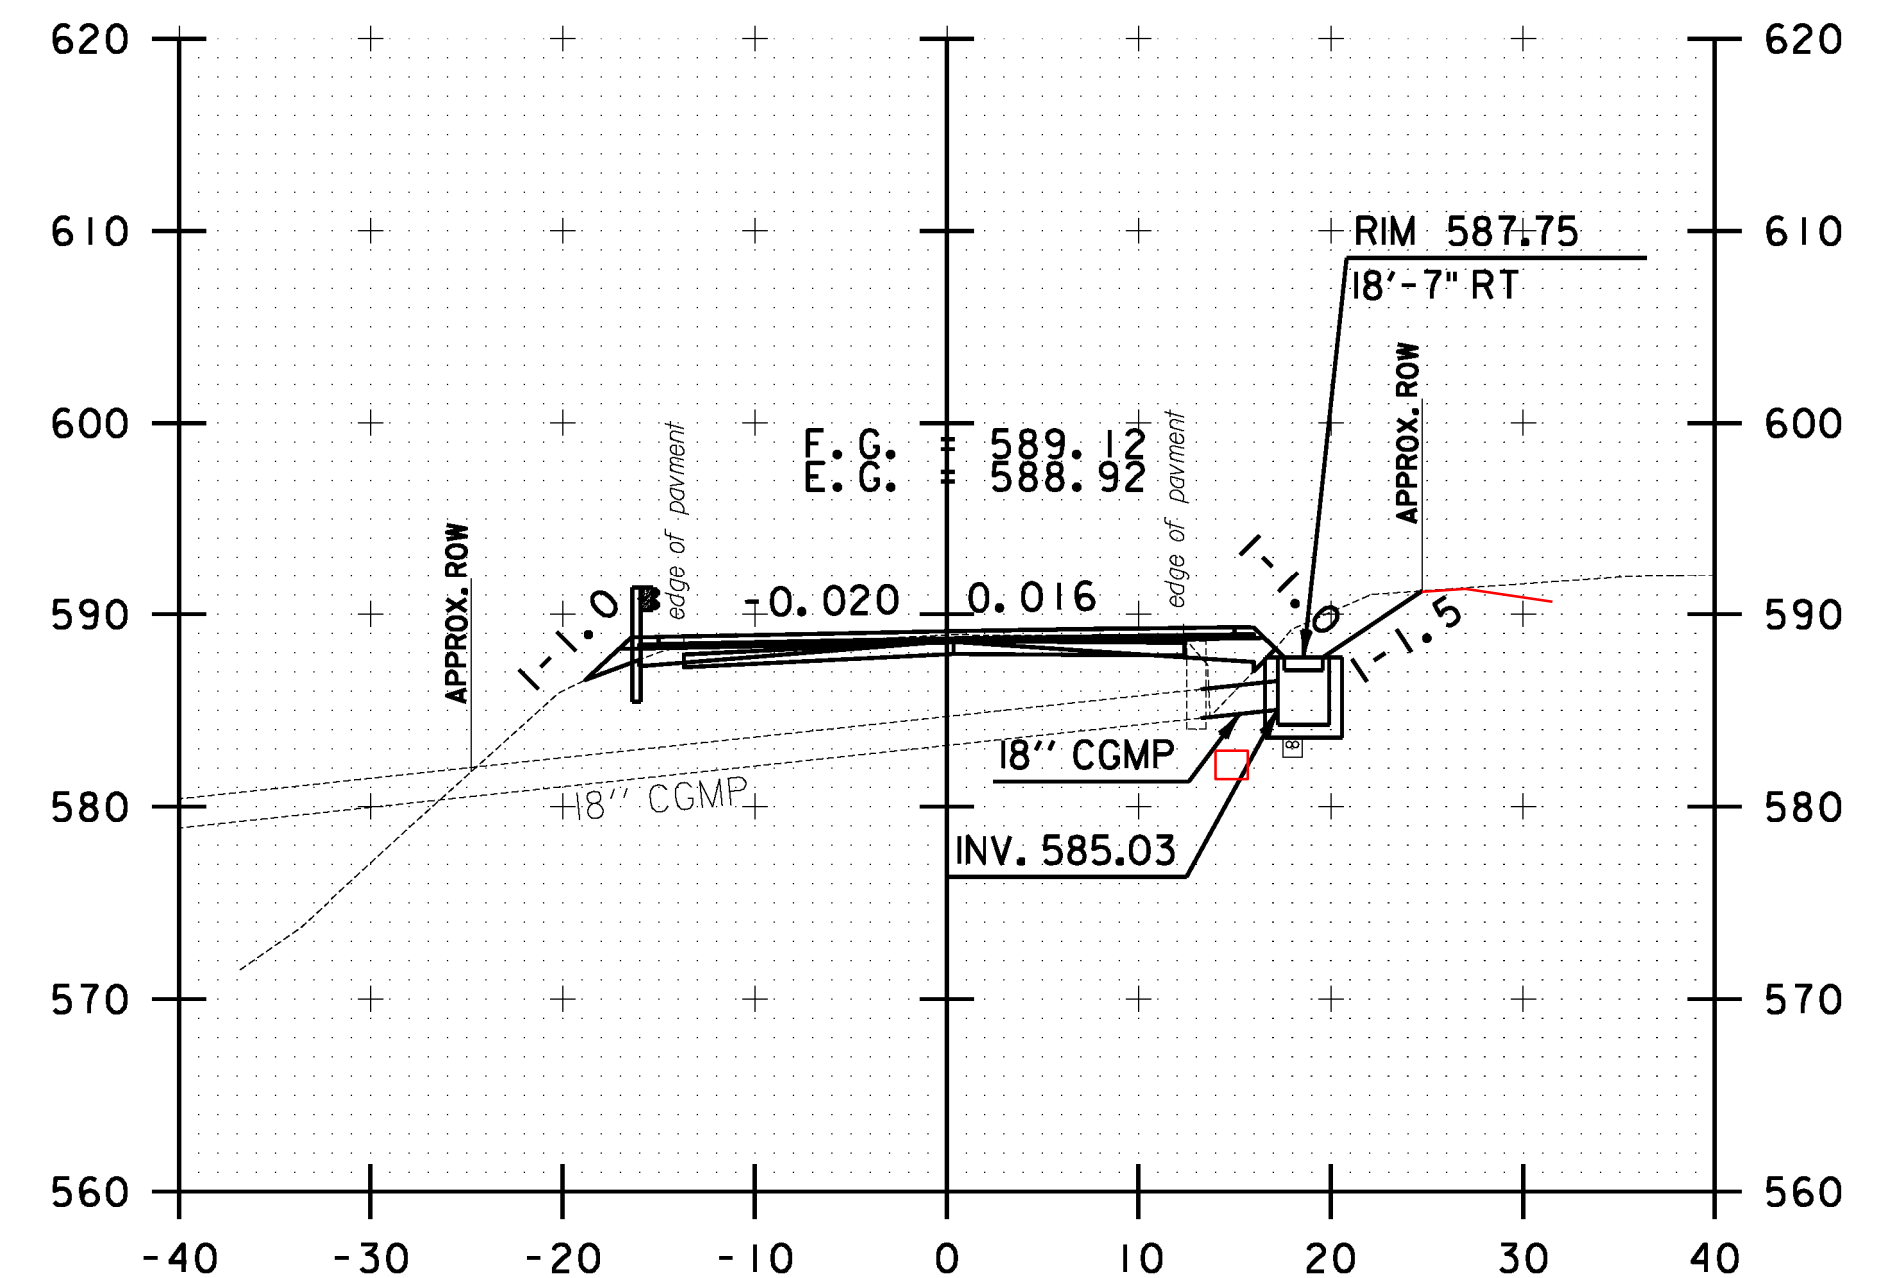

342+20.50

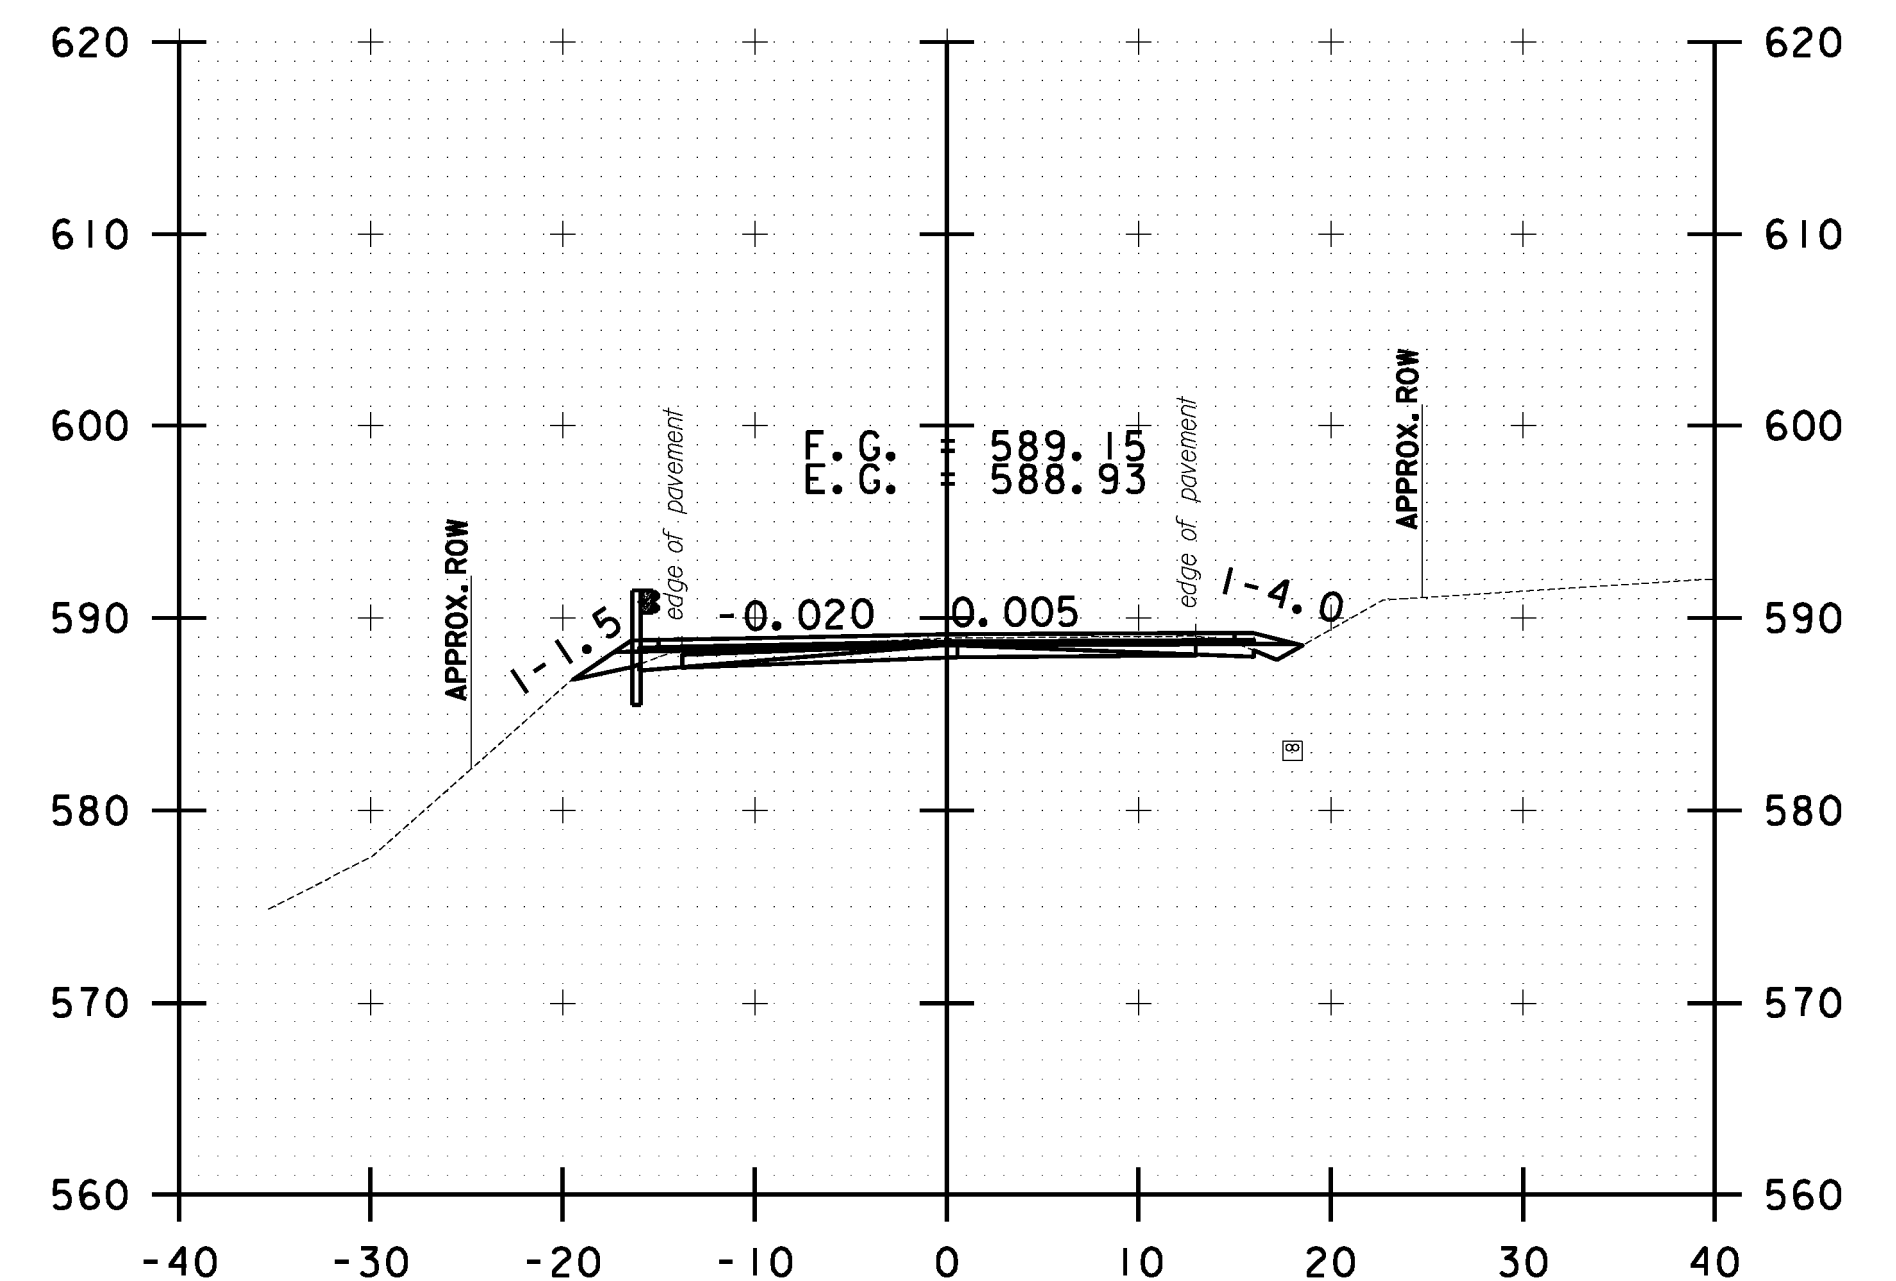

342+00.00

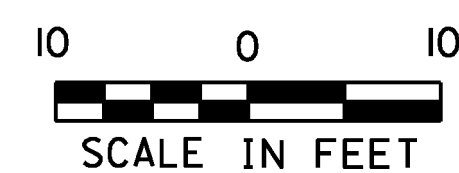

<b>STOCKBRIDGE CROSS SECTION SHEET #108</b>	PROJECT NAME: STOCKBRIDGE-BETHEL
	PROJECT NUMBER: STP 2910(1)
	FILE NAME: z10b214_stock_xc.dgn
	IPARM FILE: z10b214_xsi08.i
	PLOT DATE: 3/17/2014
	DRAWN BY: W.G.P.
	CHECKED BY: J.P.S.
	SHEET 321 OF 397