




FILE NAME = Y:\P\c\res\any\k2\22425\CA001\MSTN\10b214_stock.nc.dgn
 DATE/TIME = 3/17/2014
 USER = 4916

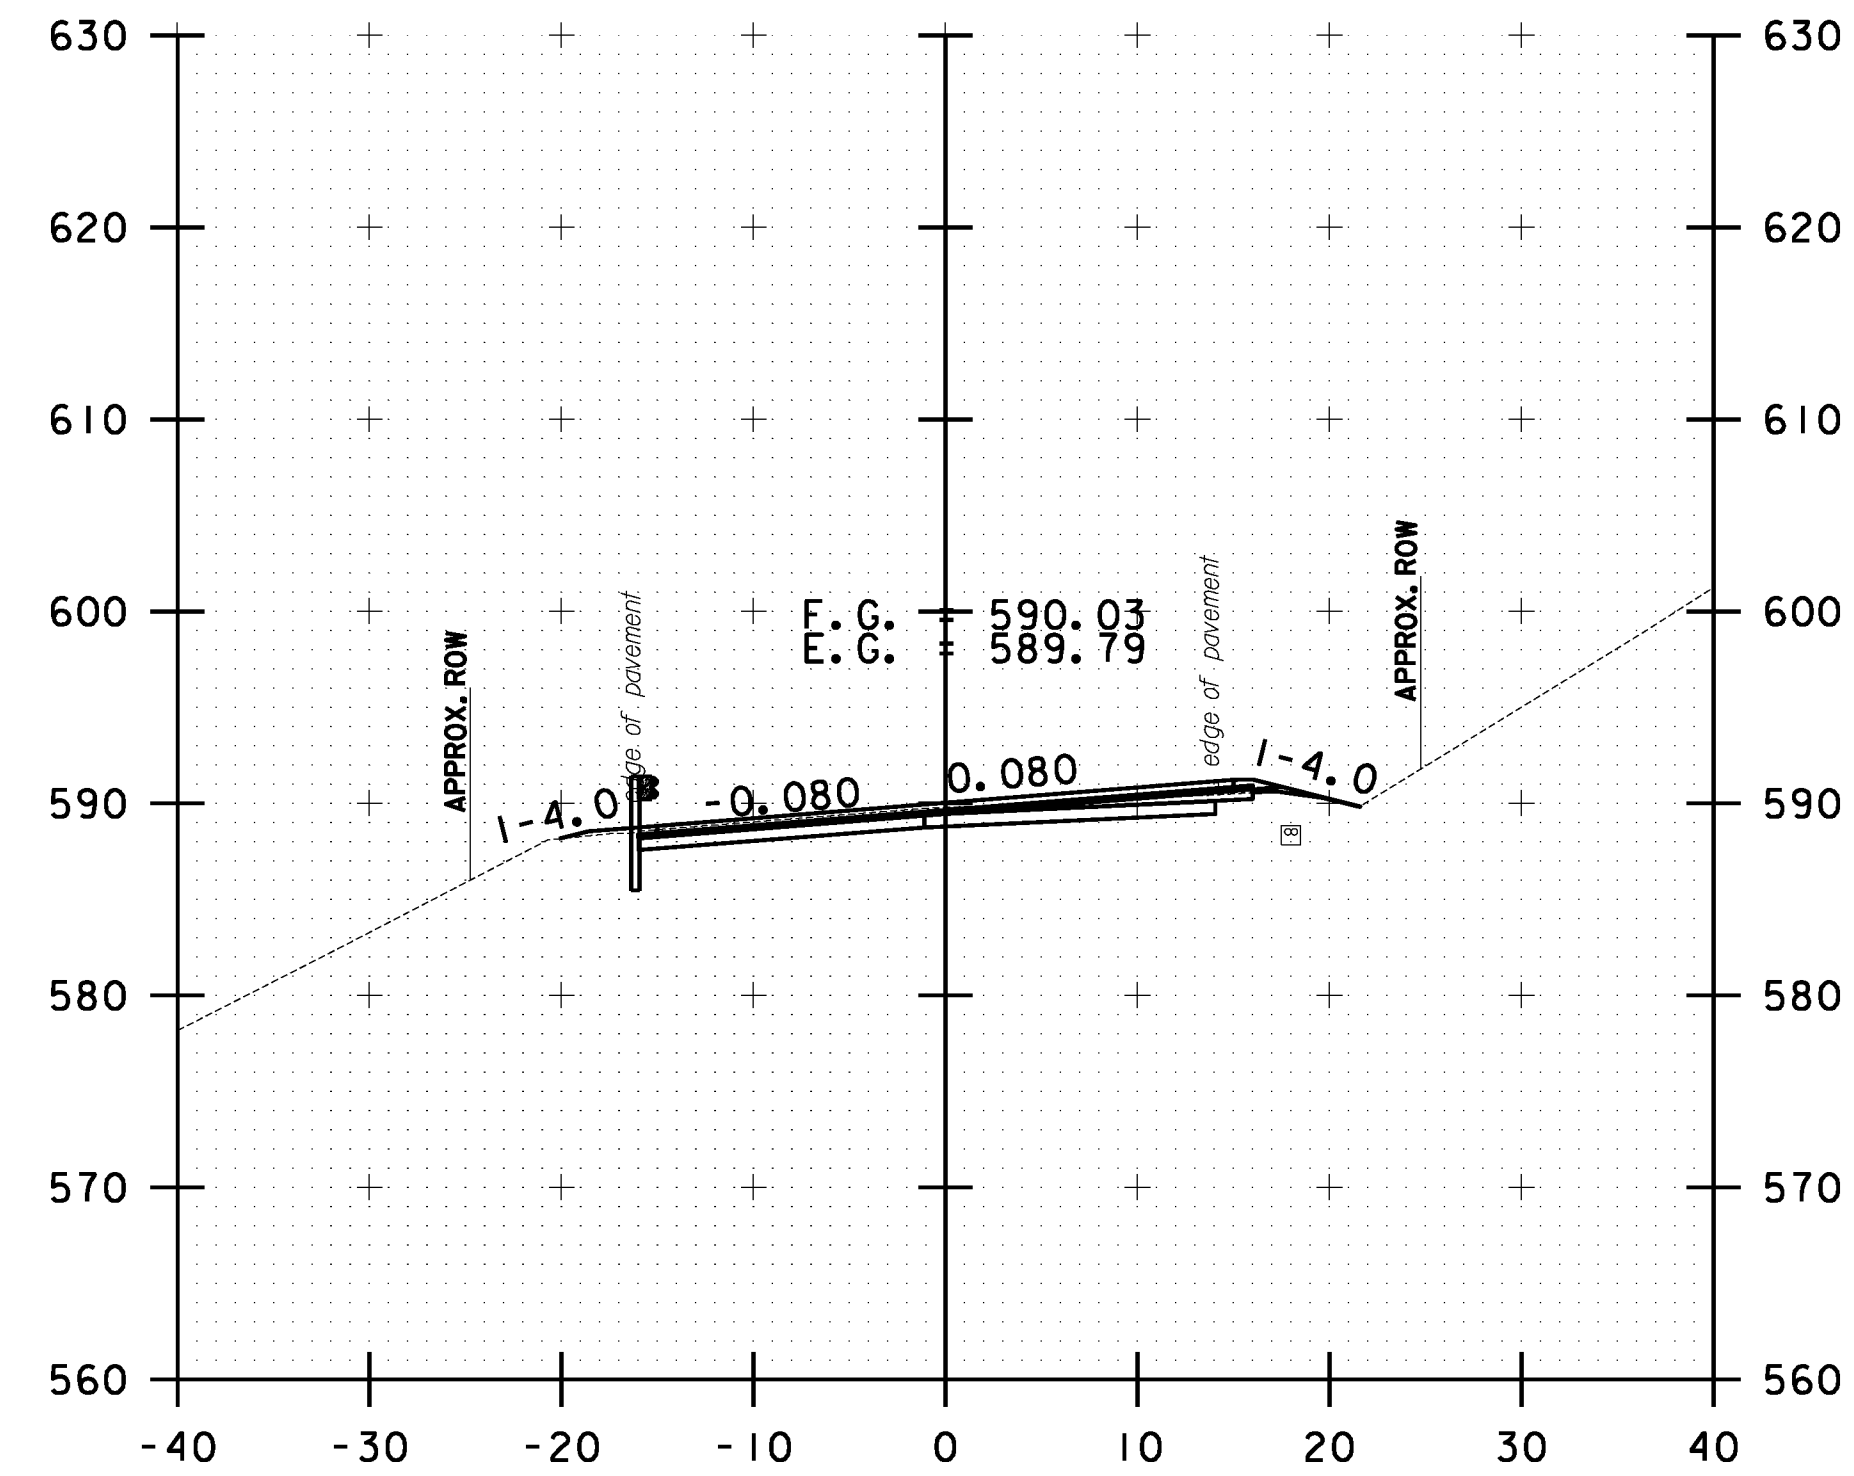


346+00.00

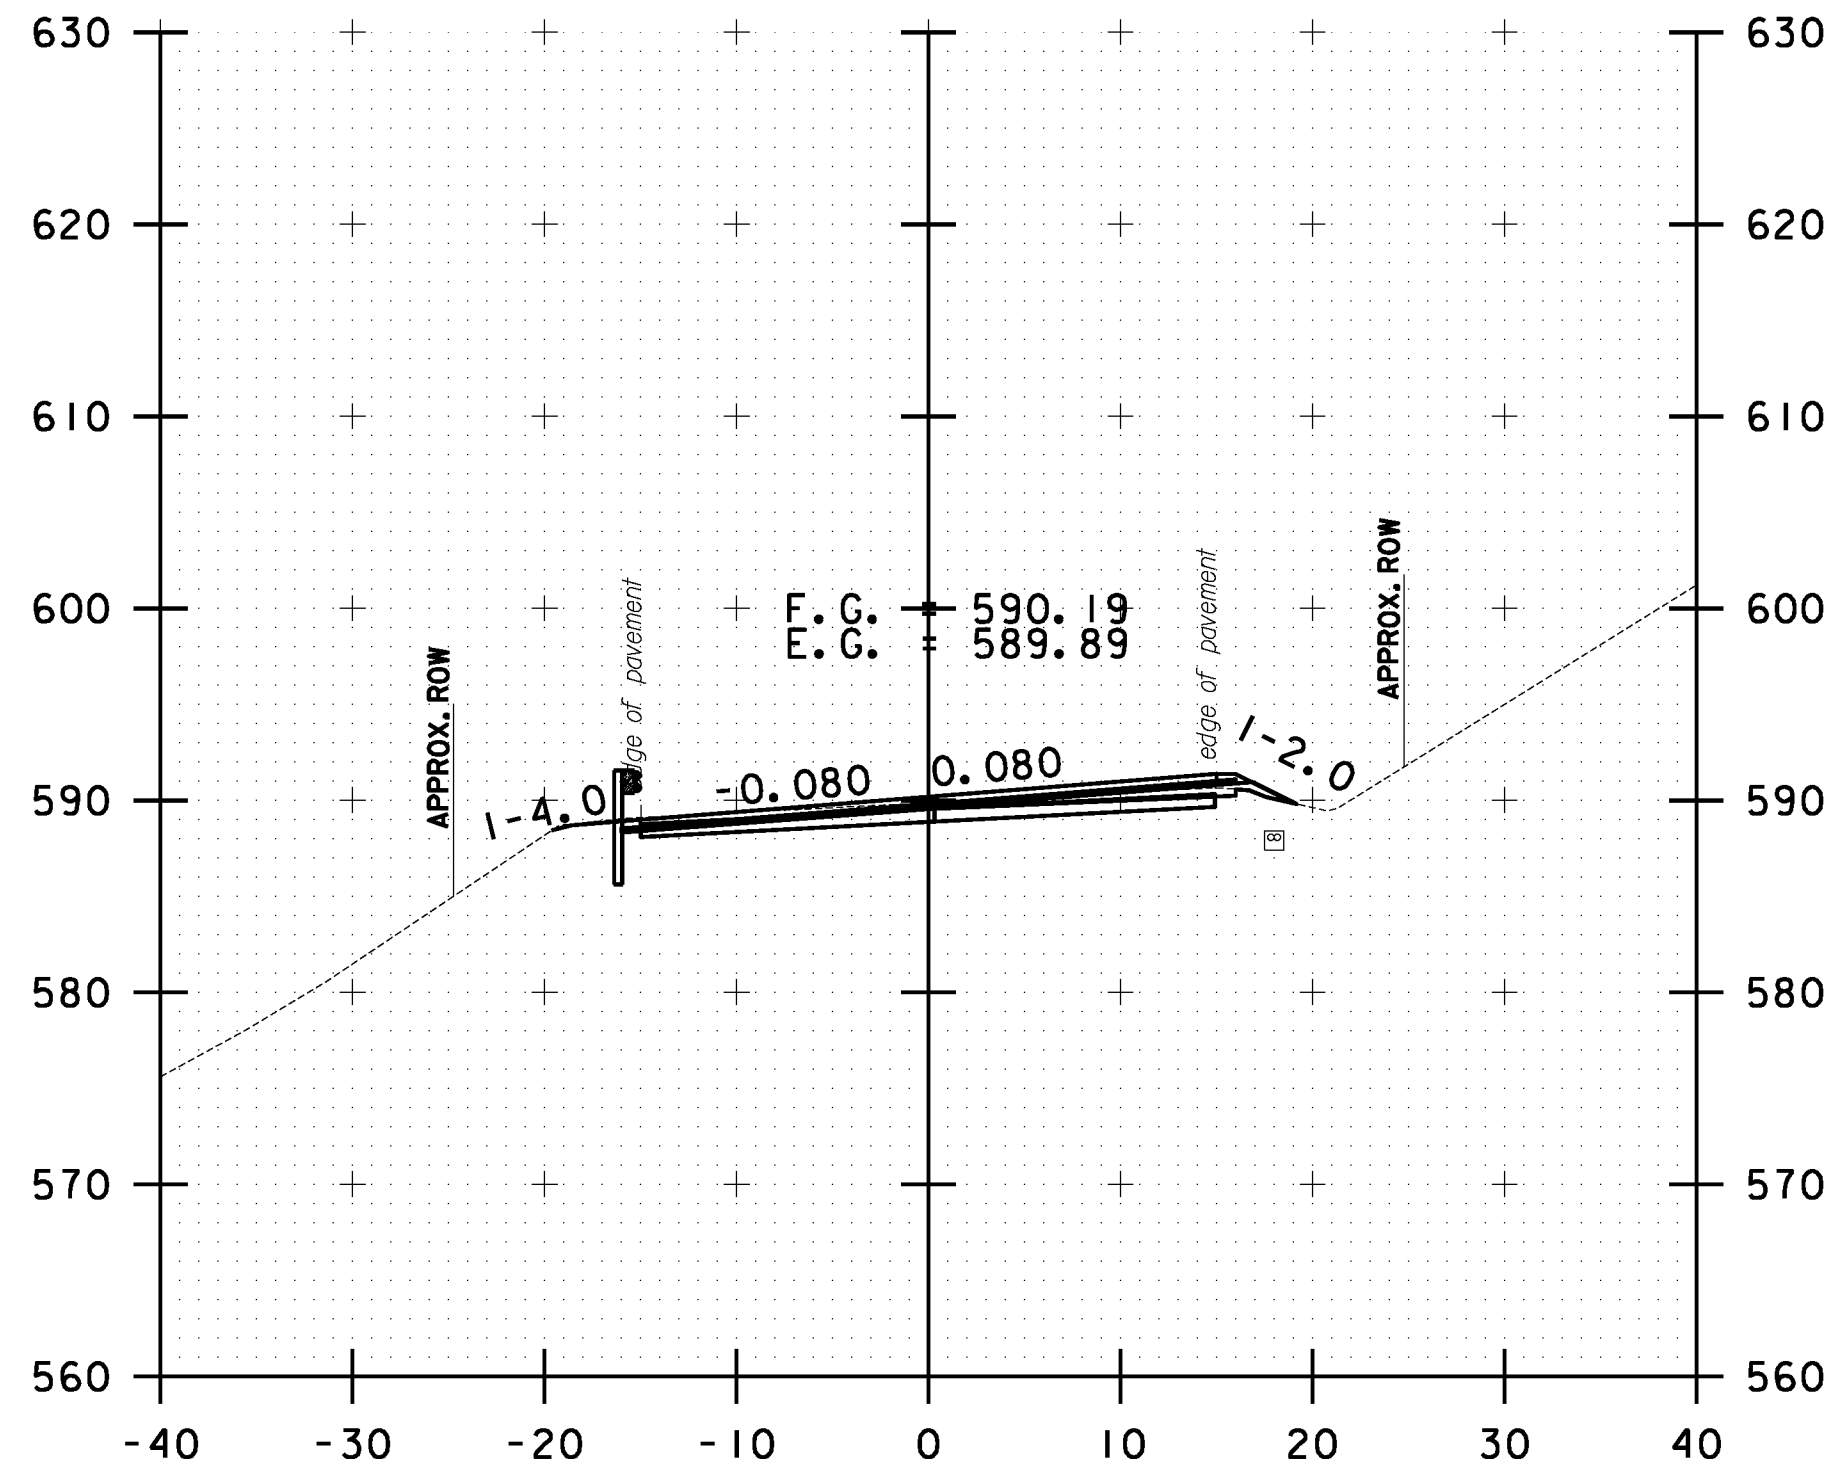


347+00.00

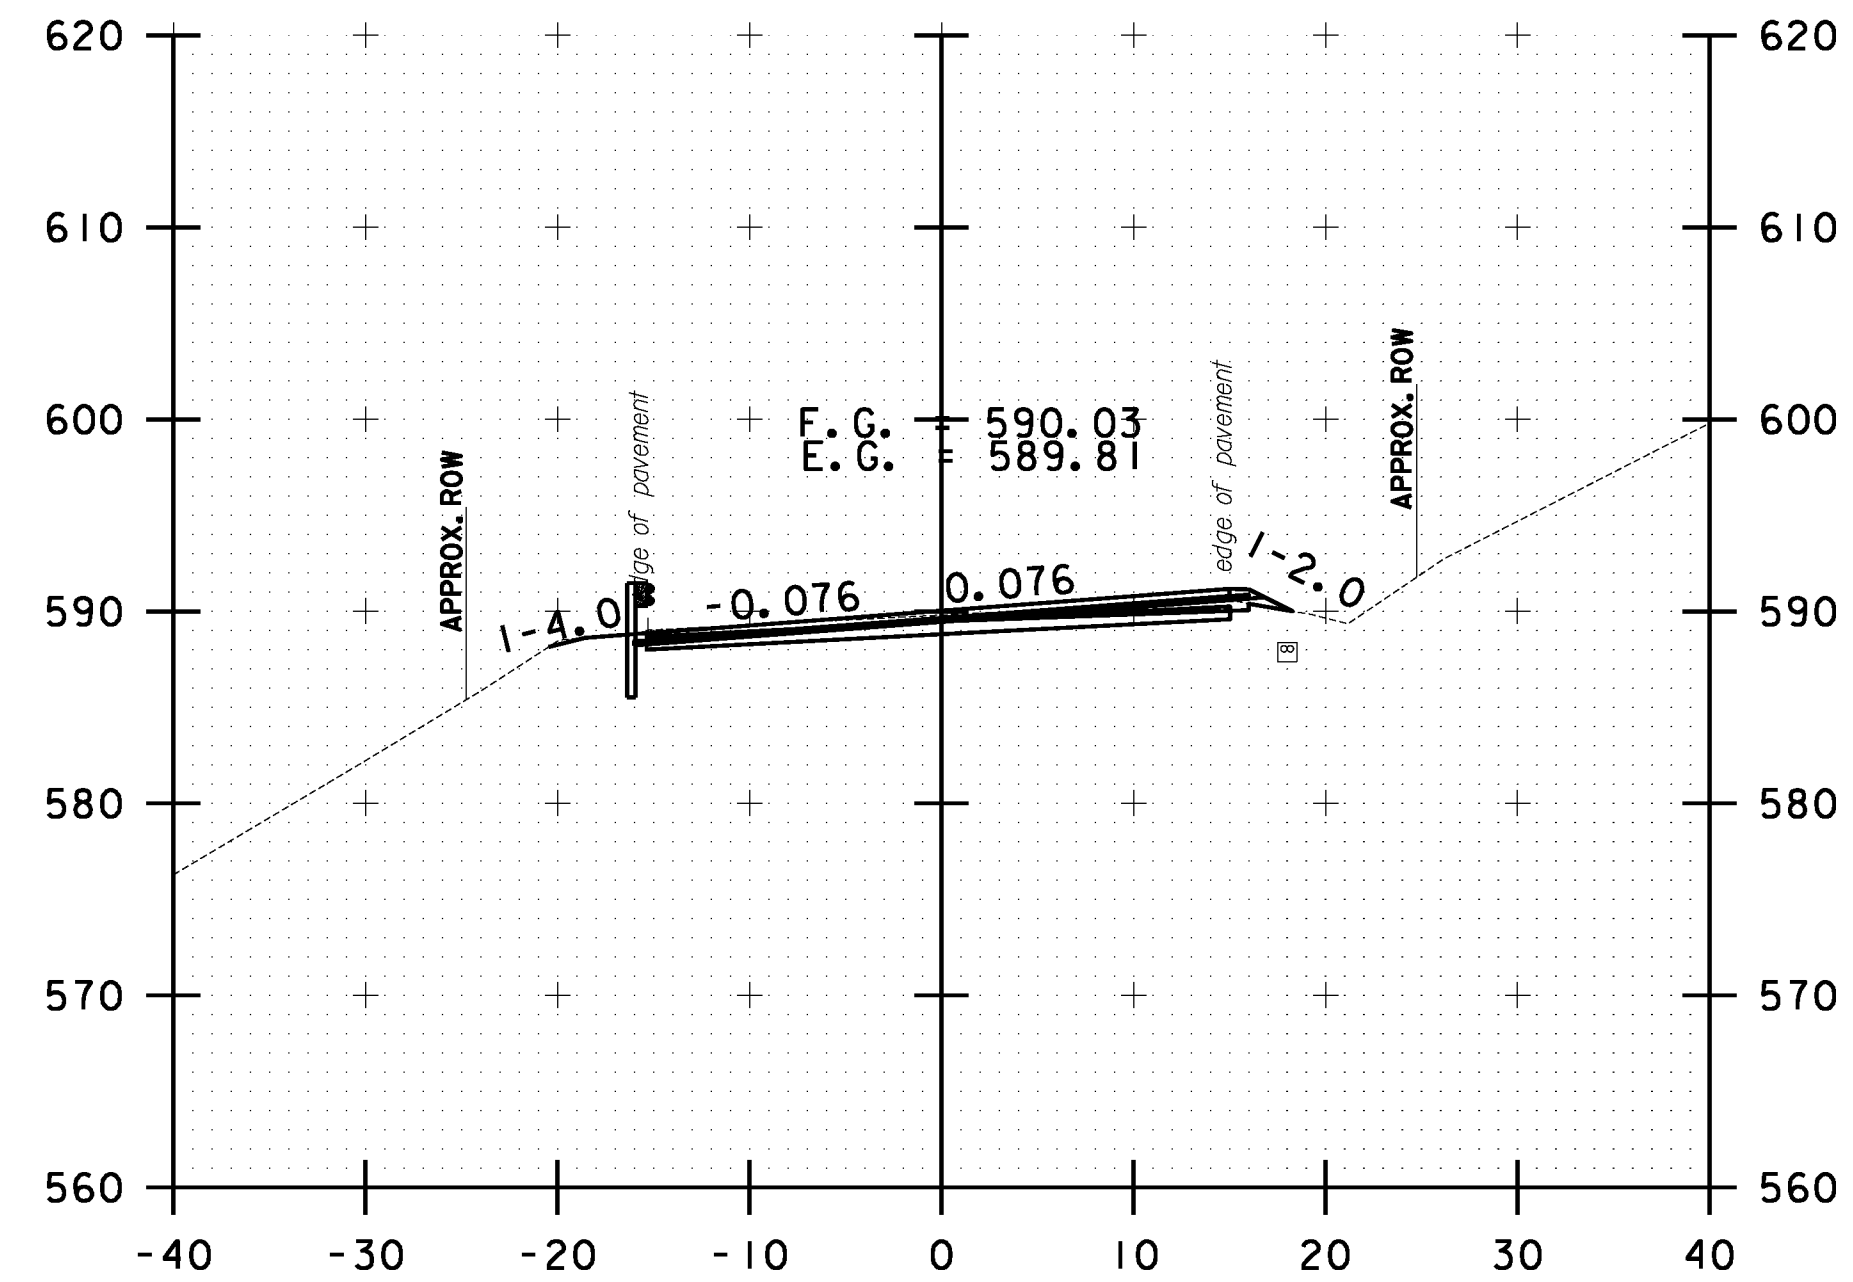


348+00.00

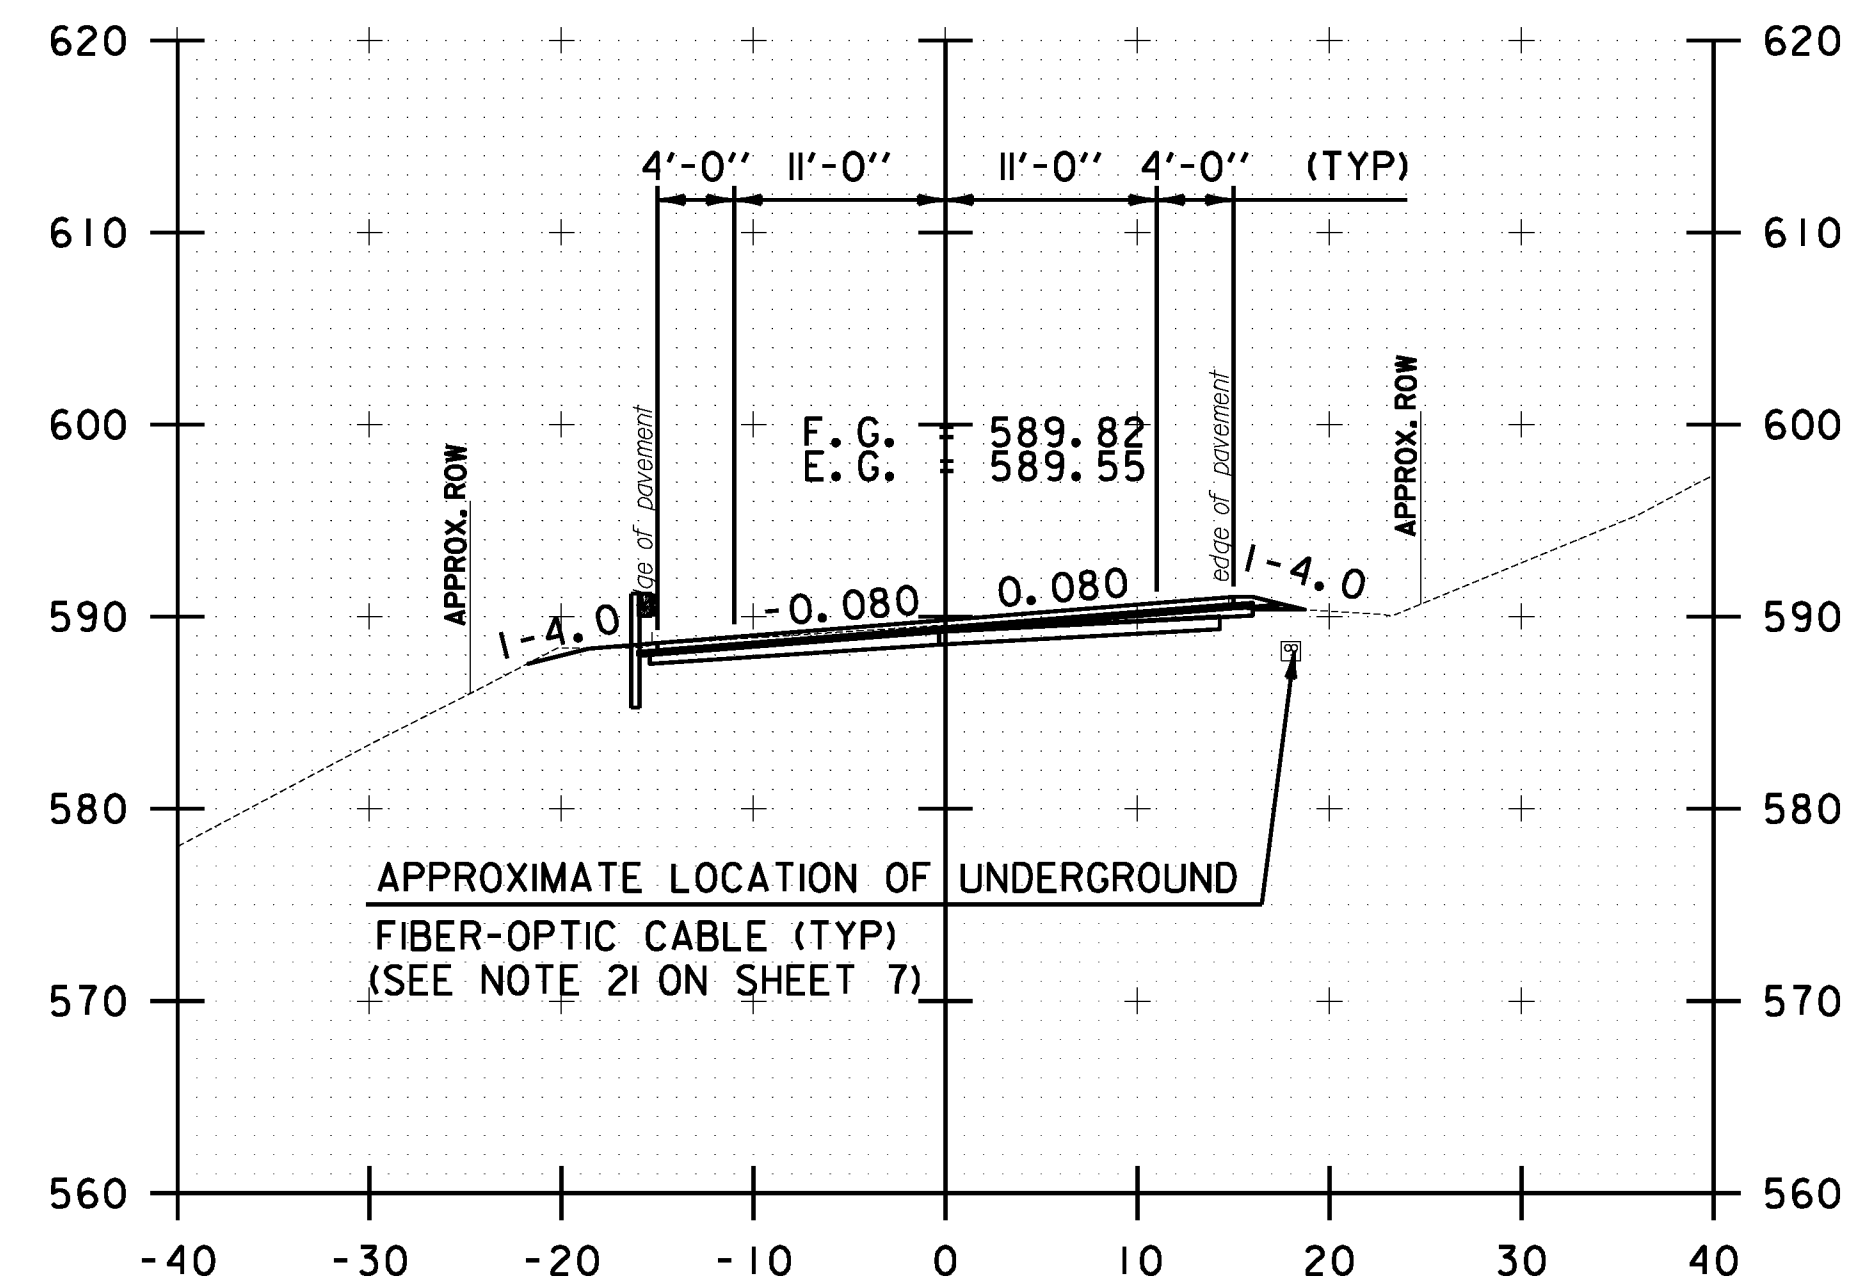

345+50.00

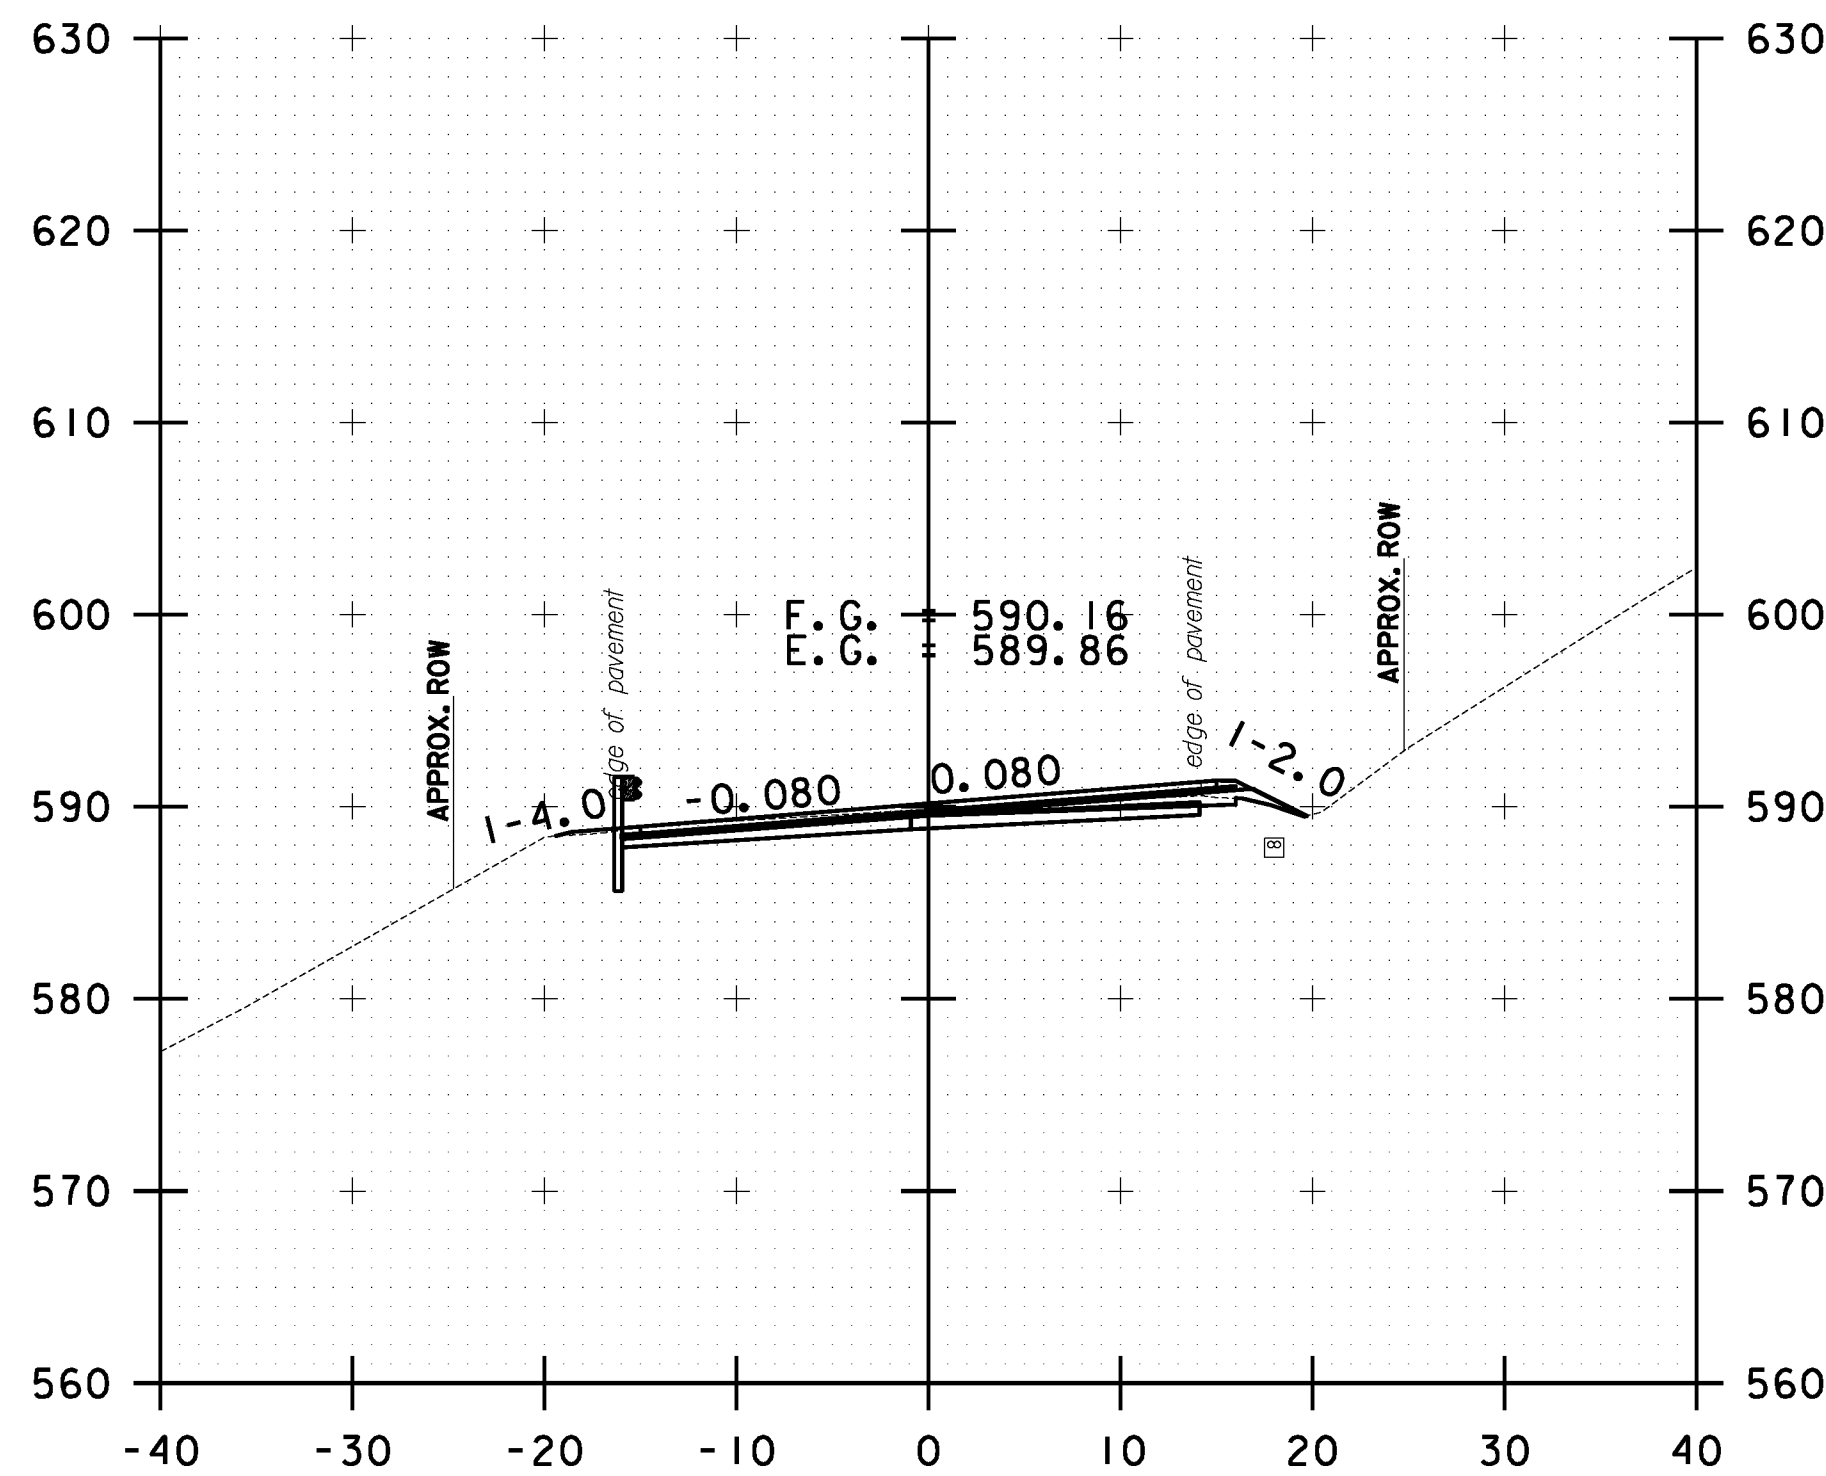

346+50.00

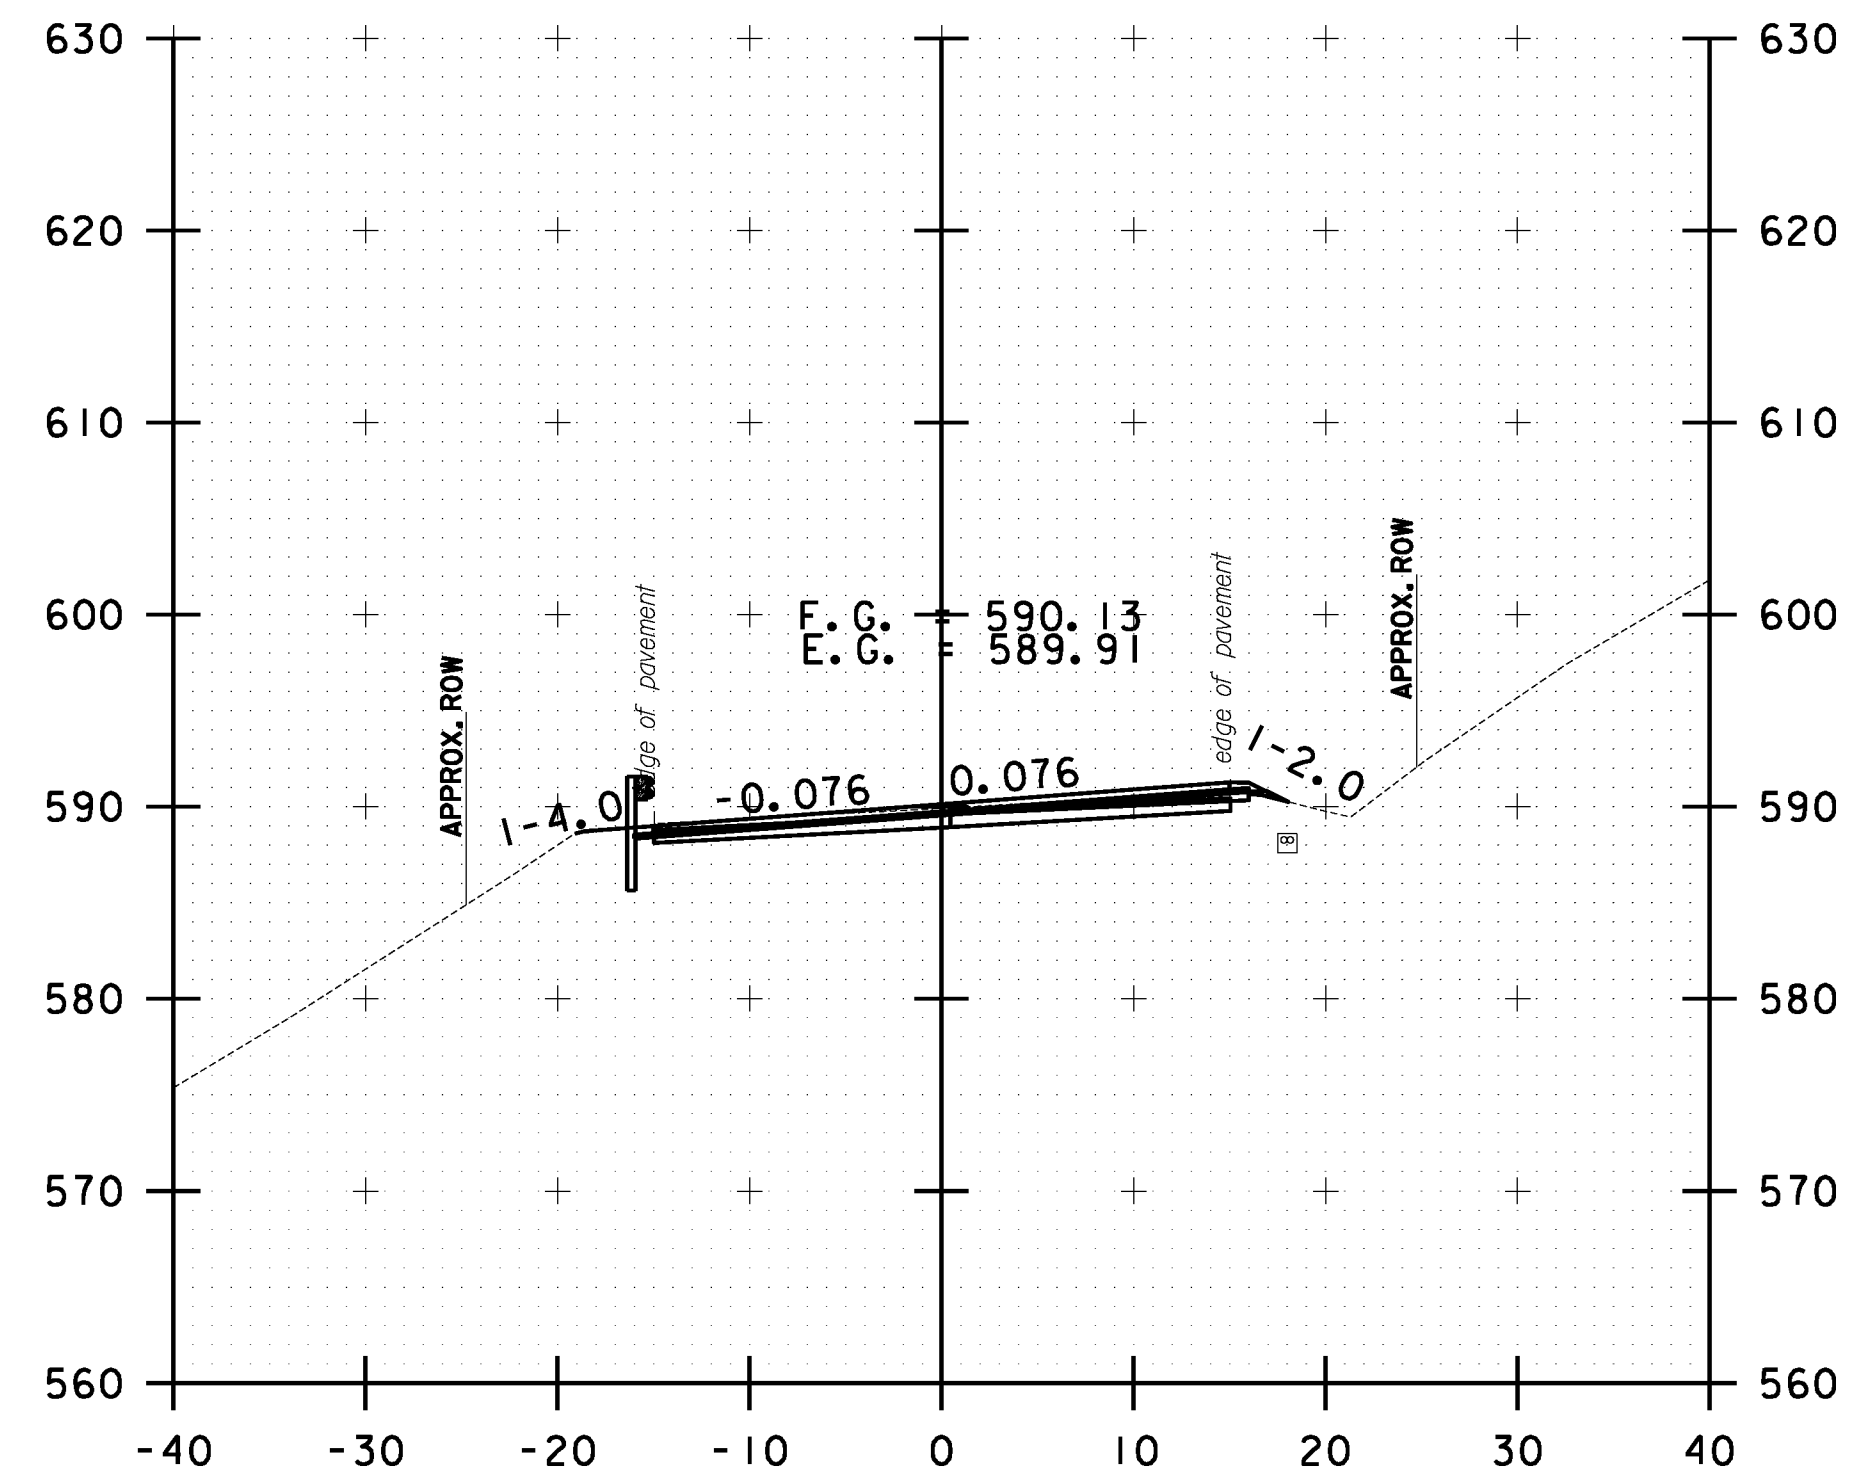

347+50.00



STOCKBRIDGE CROSS SECTION SHEET #110	PROJECT NAME: STOCKBRIDGE-BETHEL
	PROJECT NUMBER: STP 2910(1)
	FILE NAME: z10b214_stock.nc.dgn
	IPARM FILE: z10b214xs110.1
	PLOT DATE: 3/17/2014
	DRAWN BY: W.G.P.
	CHECKED BY: J.P.S.
	SHEET 323 OF 397