




FILE NAME = Y:\P\c\sect\ANY\K2\22425\CADD\MSTN\10b214_stock.nc.dgn
 DATE/TIME = 3/17/2014
 USER = 4916

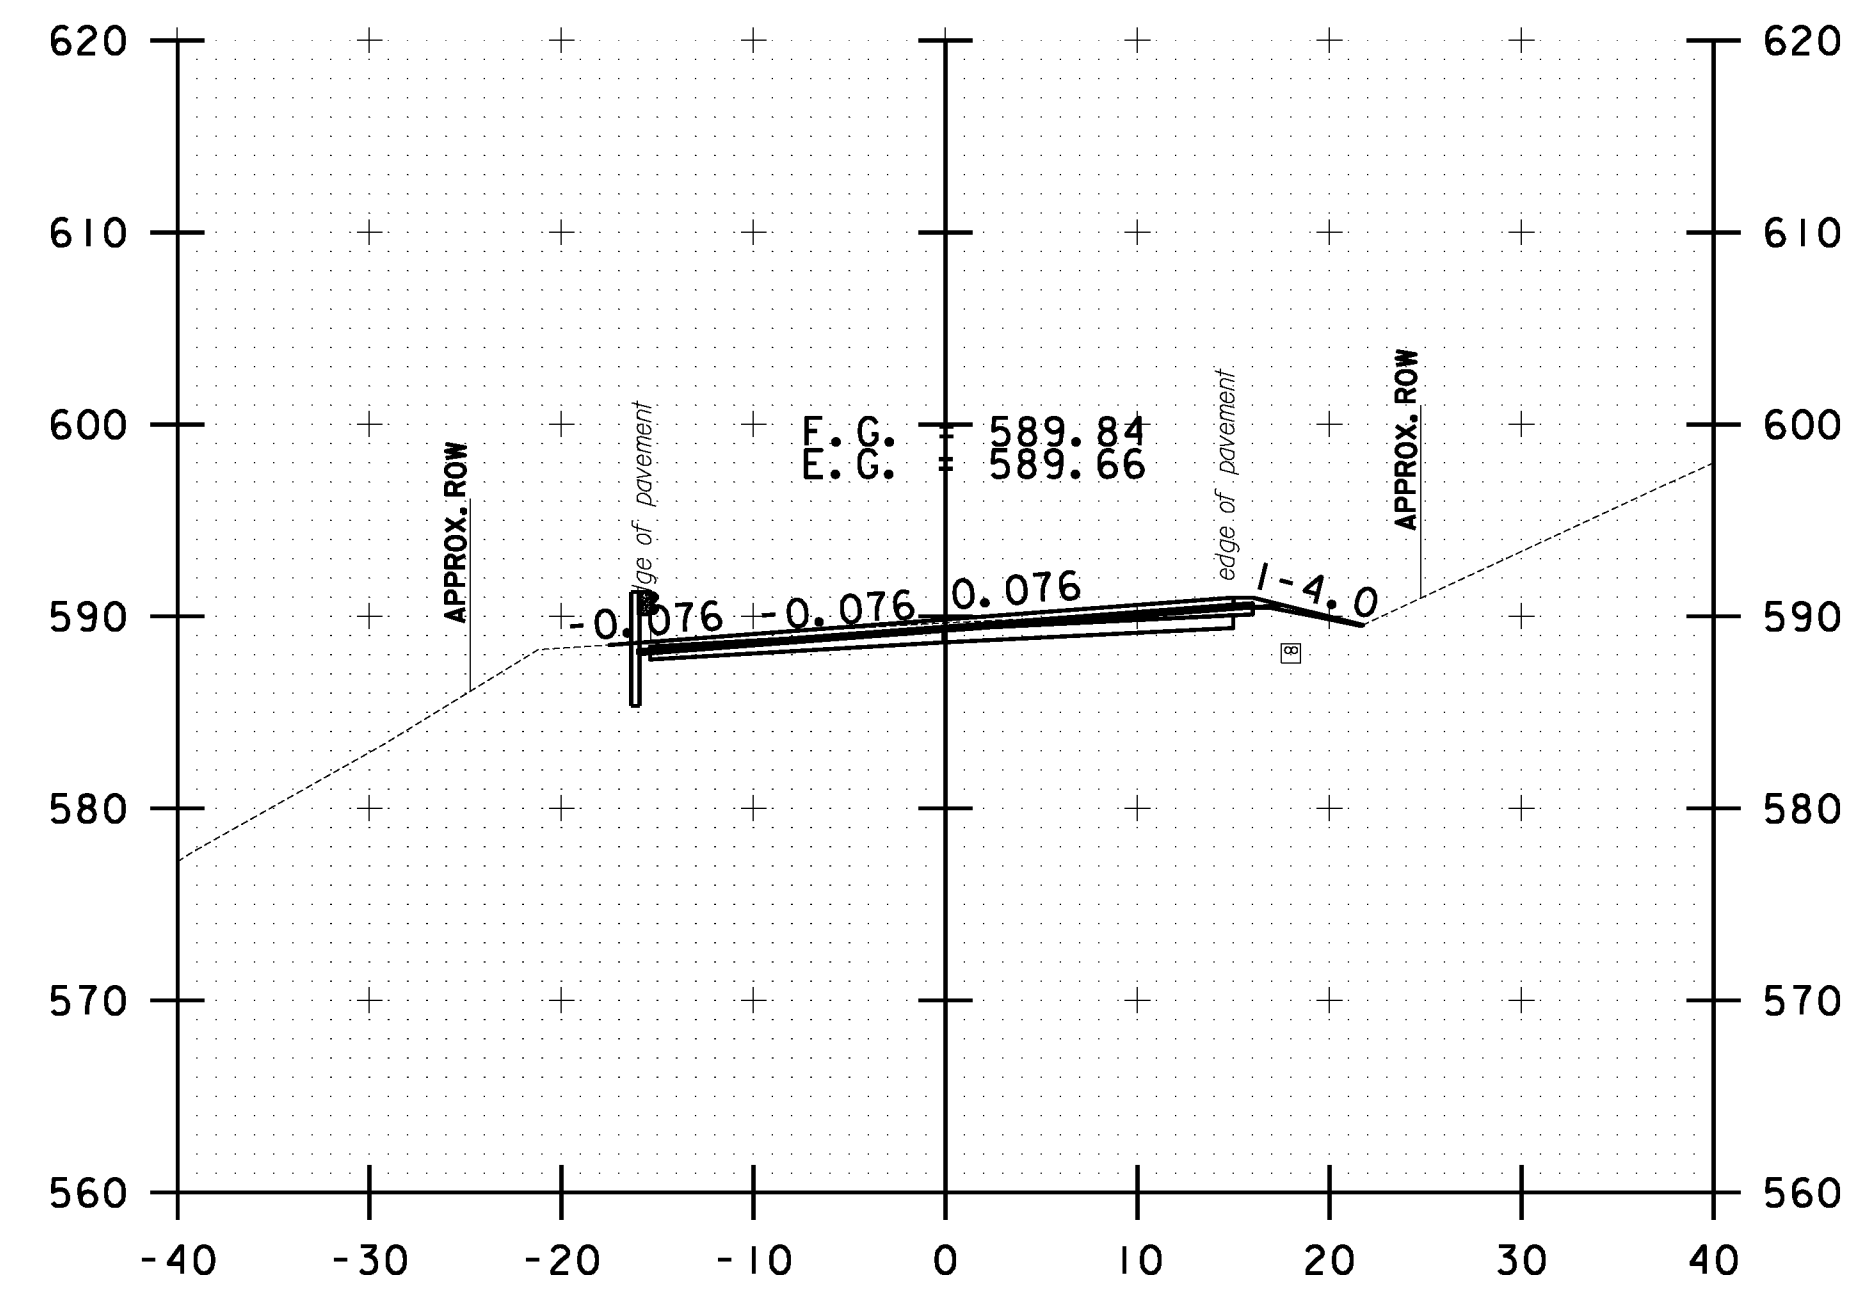


349+00.00

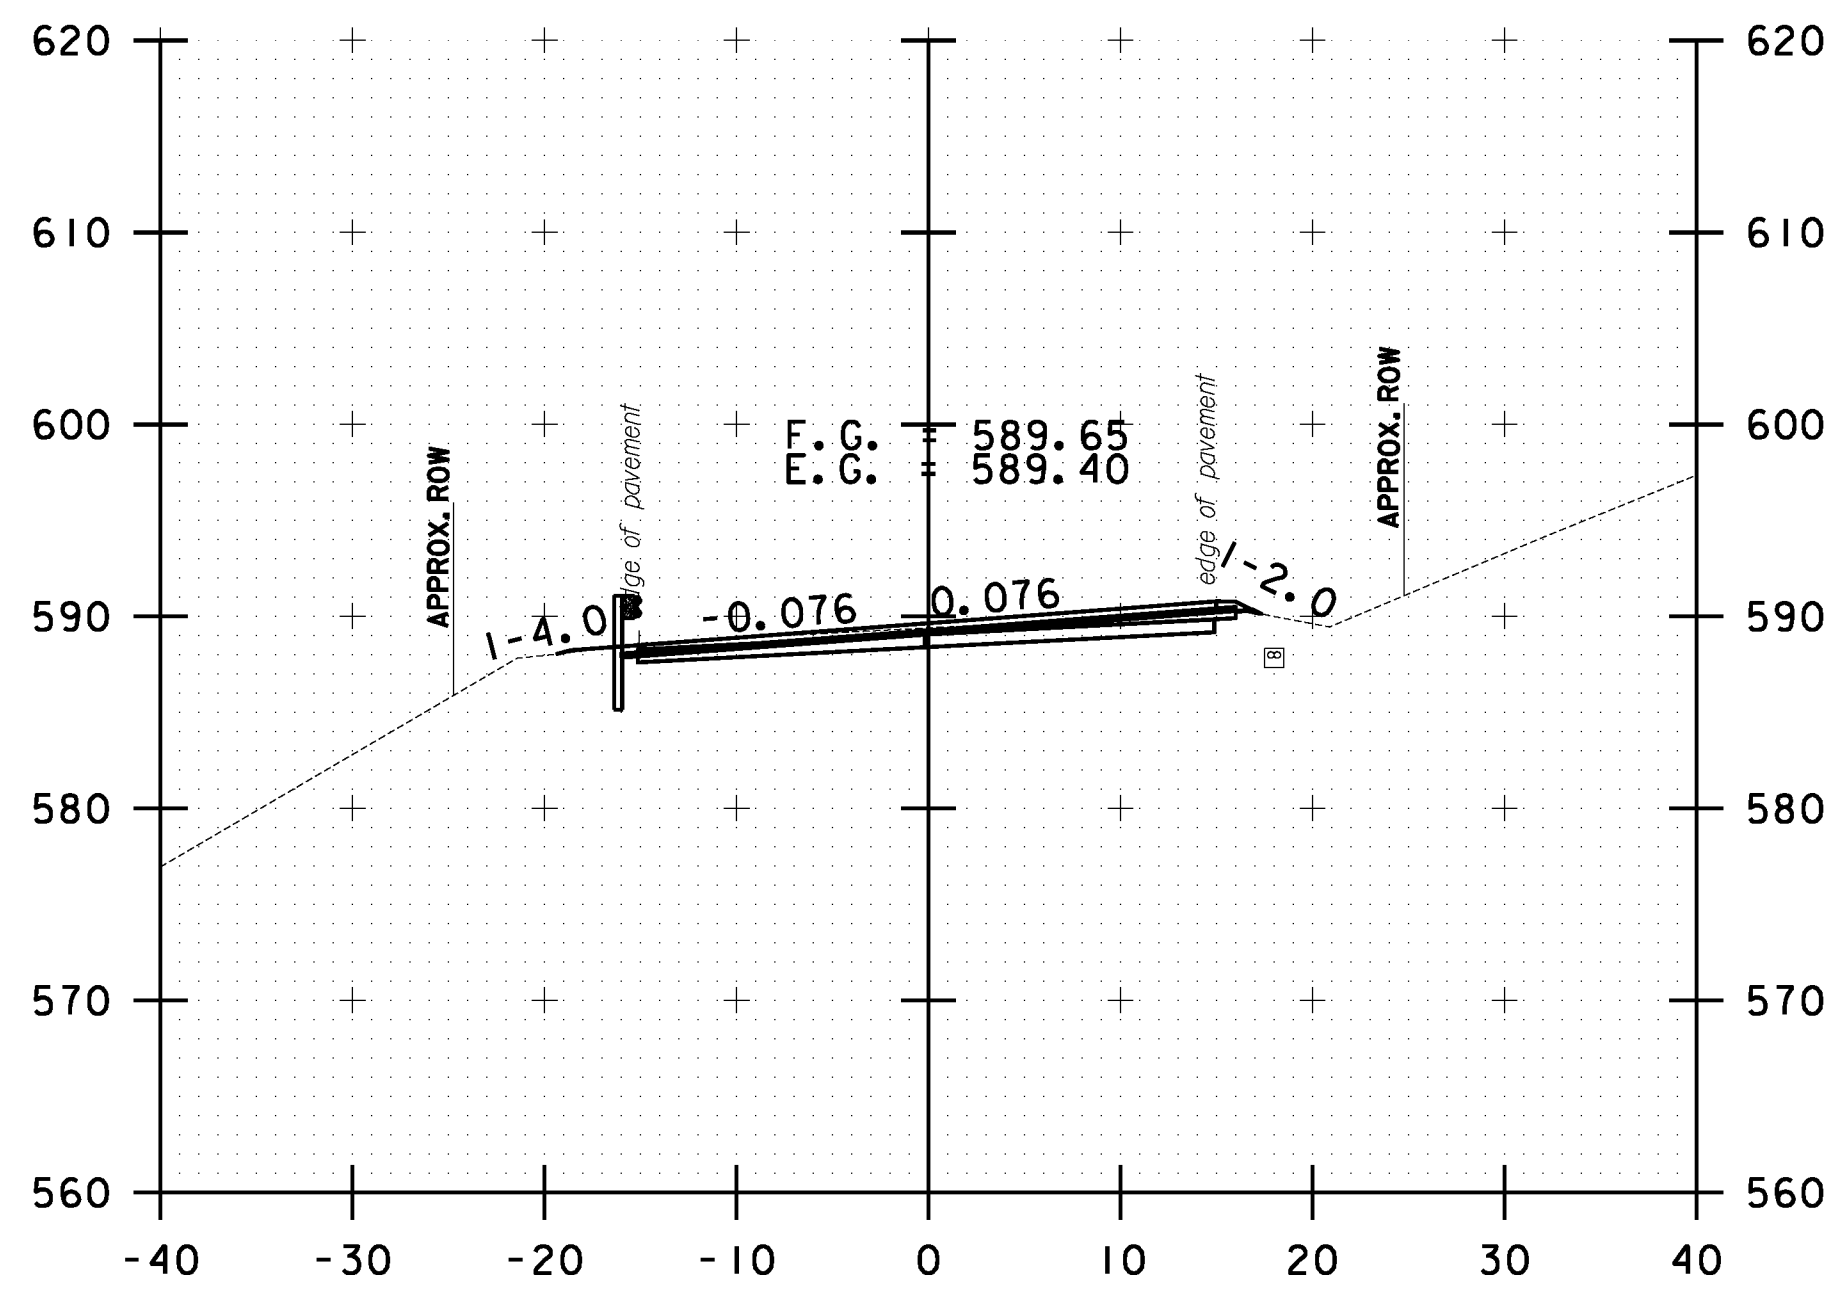


350+00.00

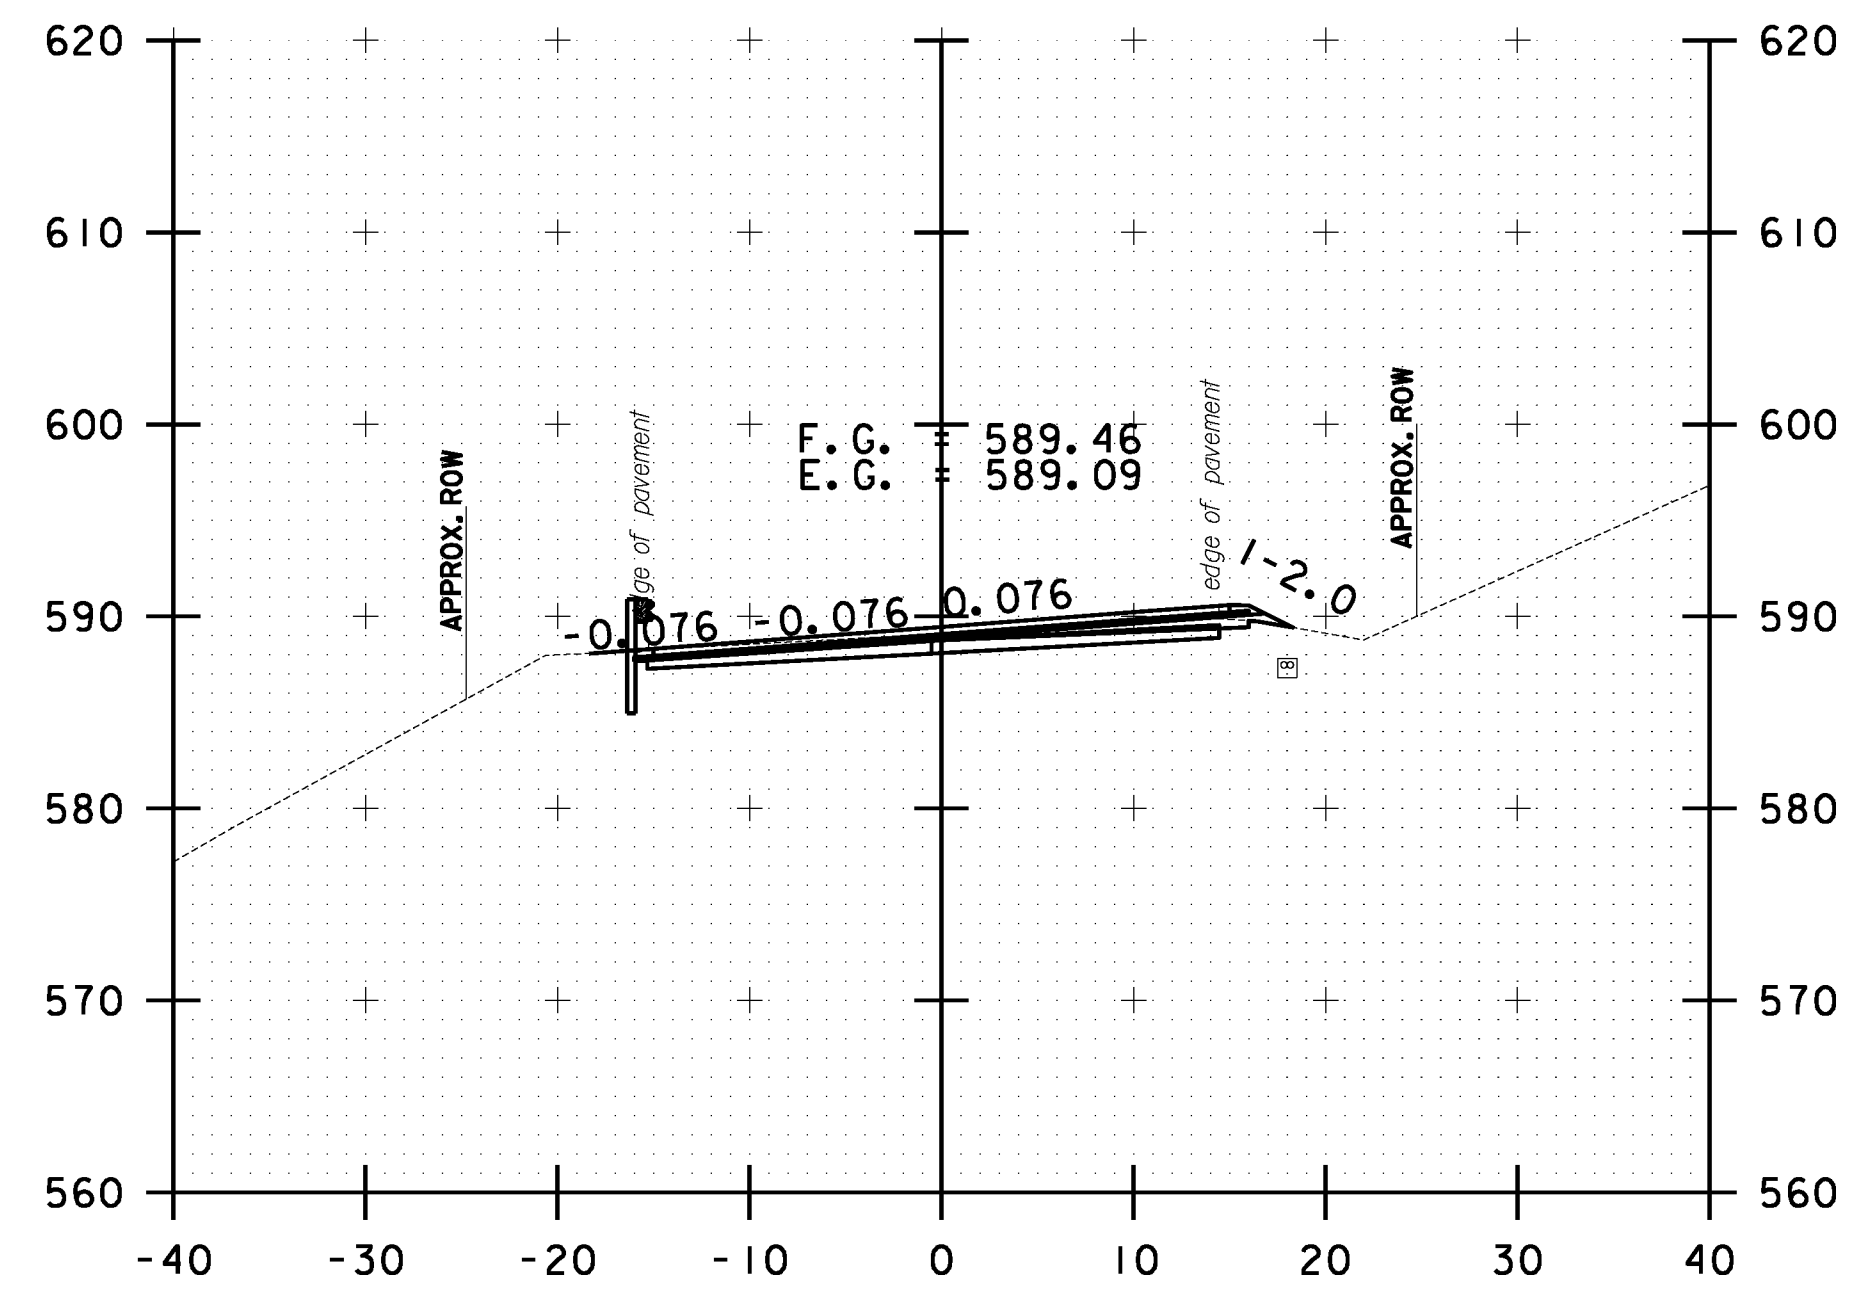


351+00.00

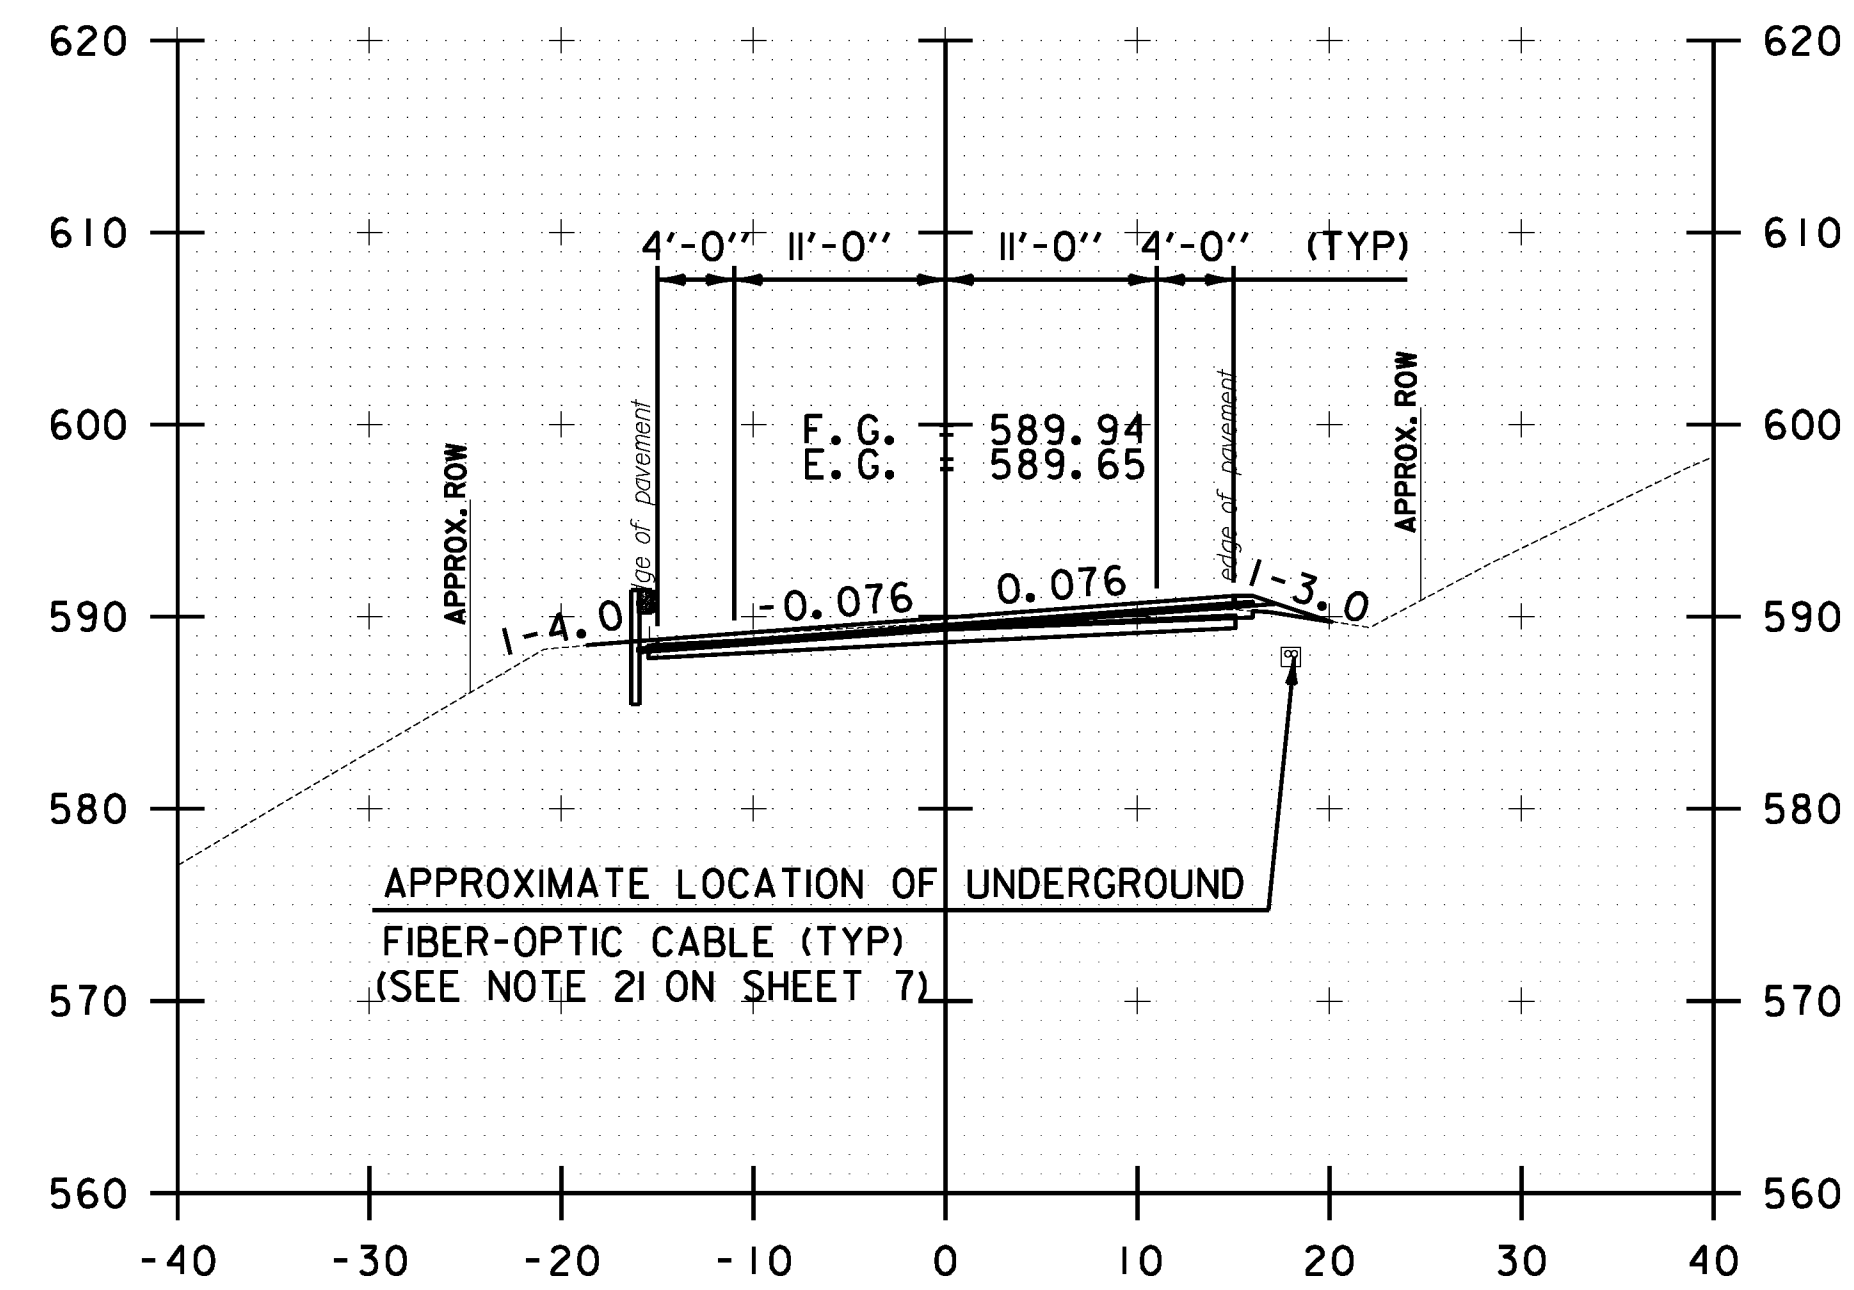

348+50.00

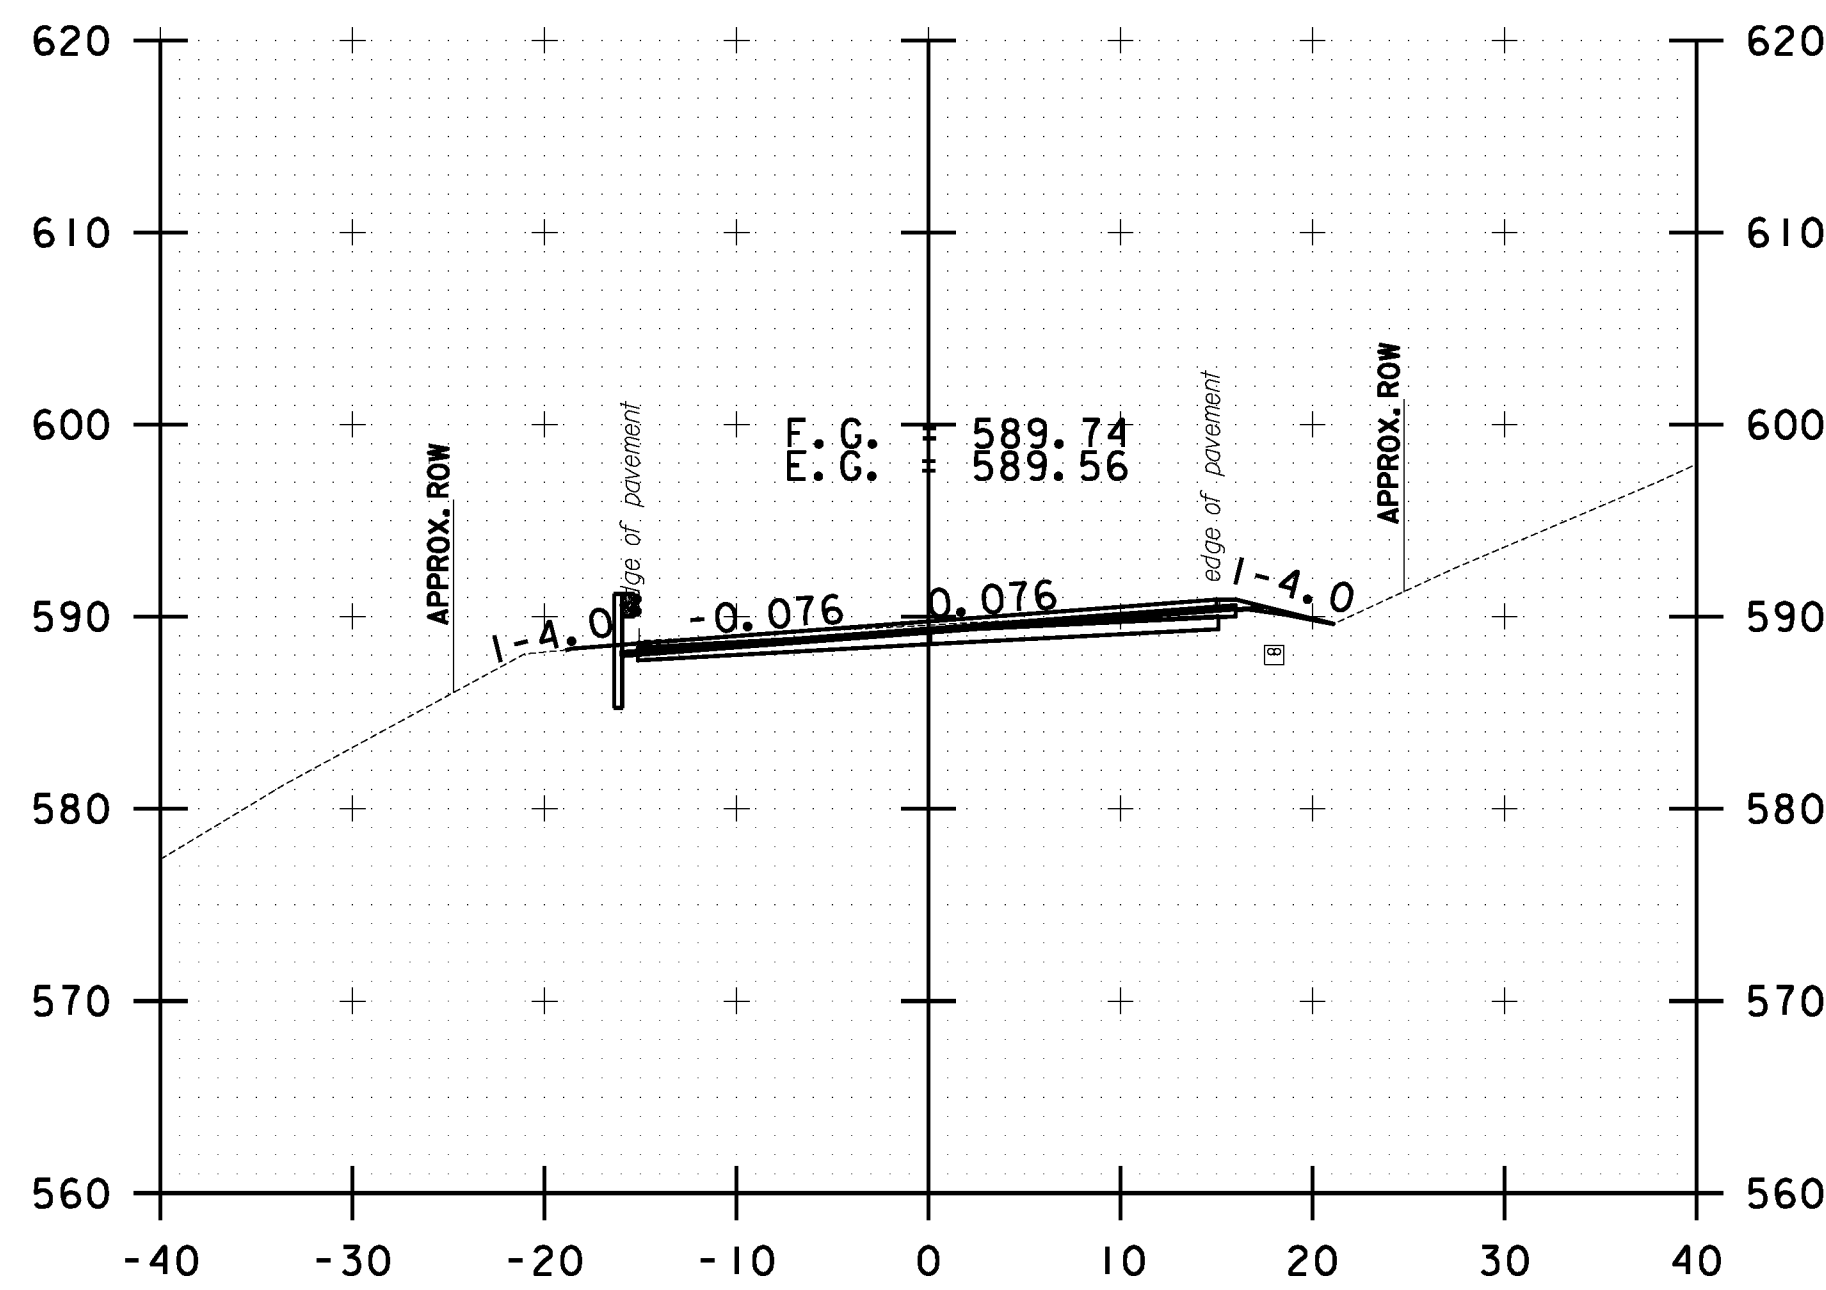

349+50.00

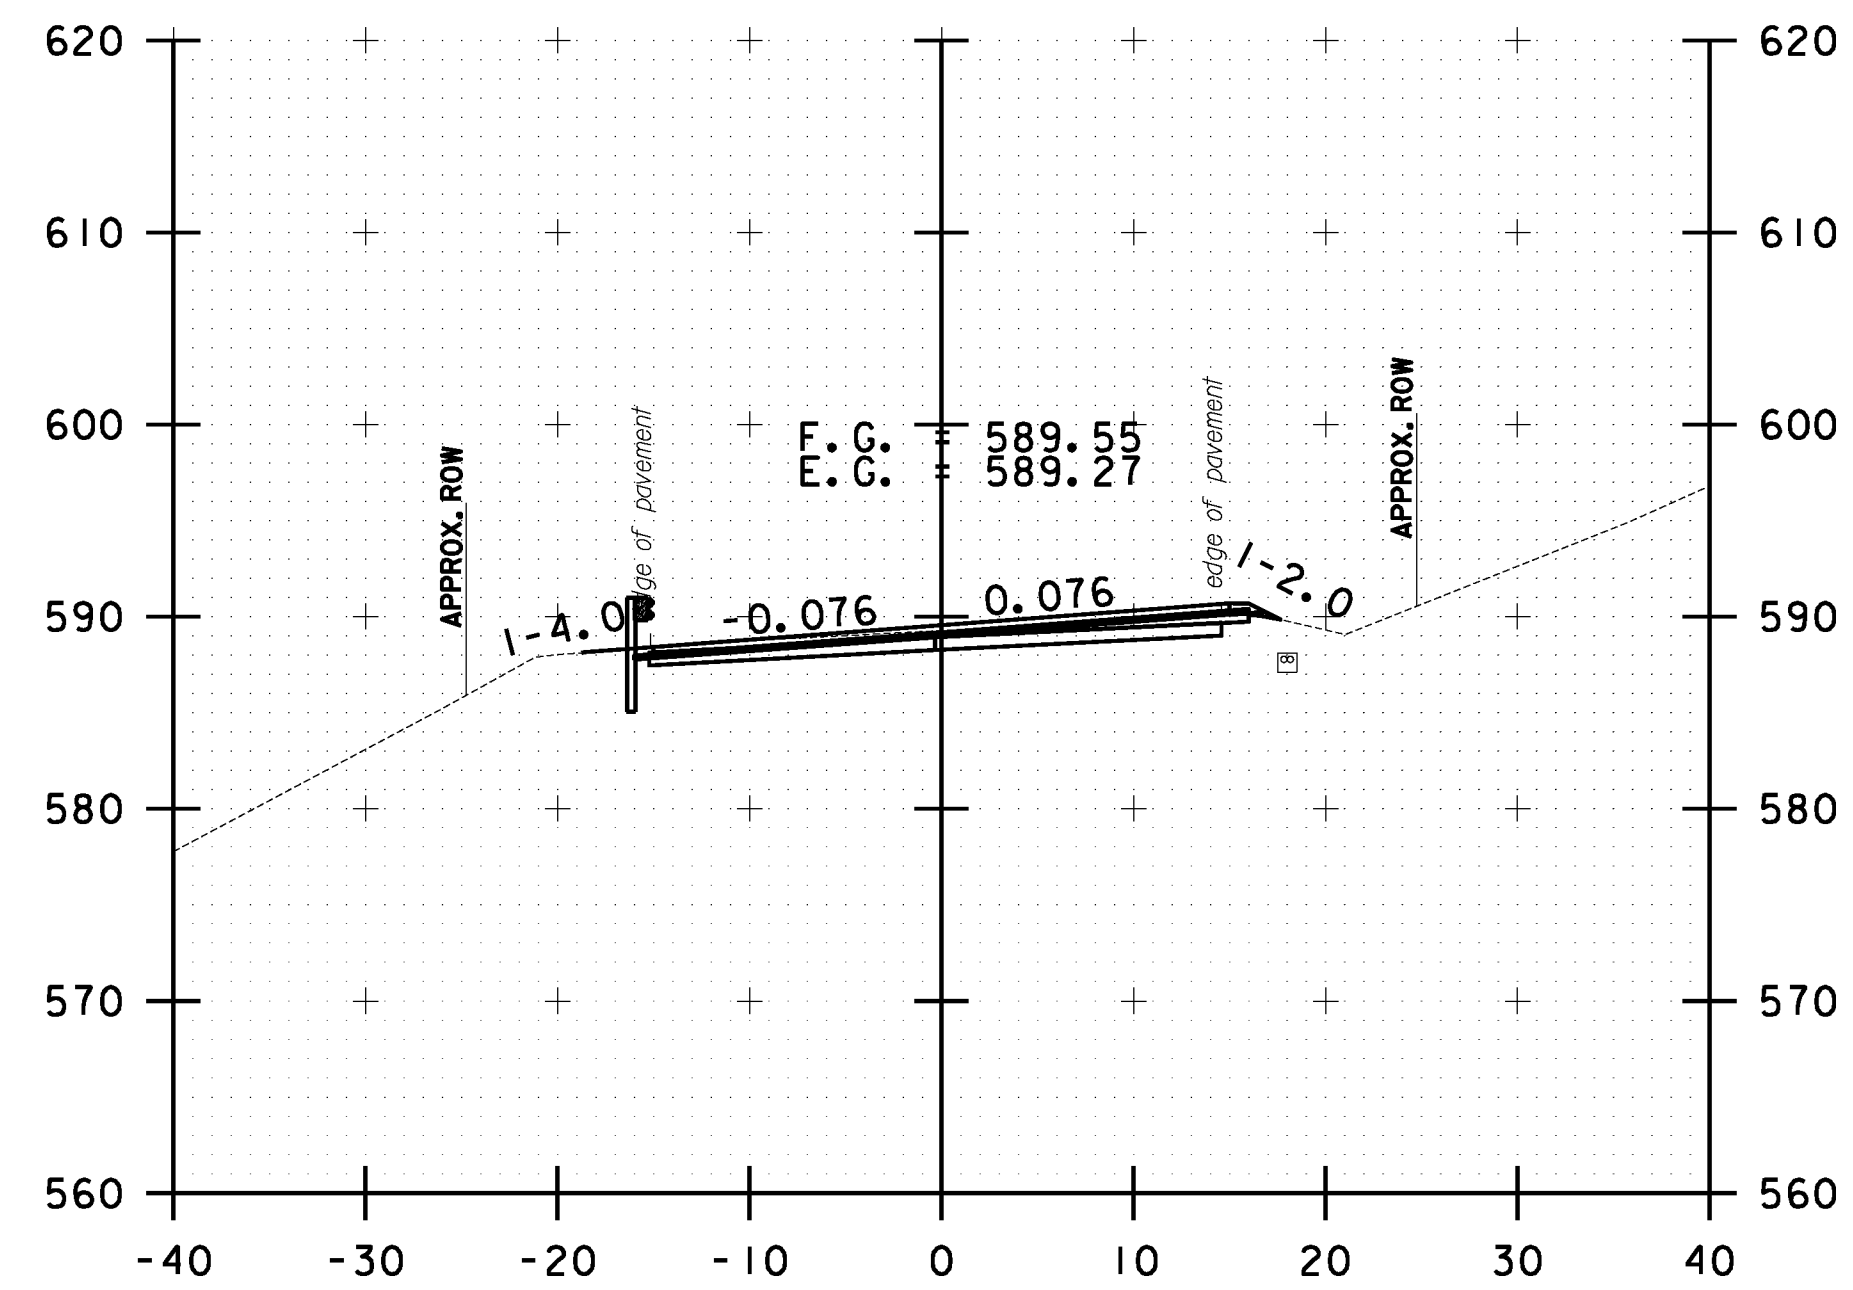

350+50.00



STOCKBRIDGE CROSS SECTION SHEET #111	PROJECT NAME: STOCKBRIDGE-BETHEL
	PROJECT NUMBER: STP 2910(1)
	FILE NAME: z10b214_stock.xc.dgn
	IPARM FILE: z10b214xs111.i
	PLOT DATE: 3/17/2014
	DRAWN BY: W.G.P.
	CHECKED BY: J.P.S.
	SHEET 324 OF 397