




FILE NAME = Y:\P\c\res\any\k2\22425\CADD\MSTN\10b214.bethel.xc.dgn  
 DATE/TIME = 3/17/2014  
 USER = 4916

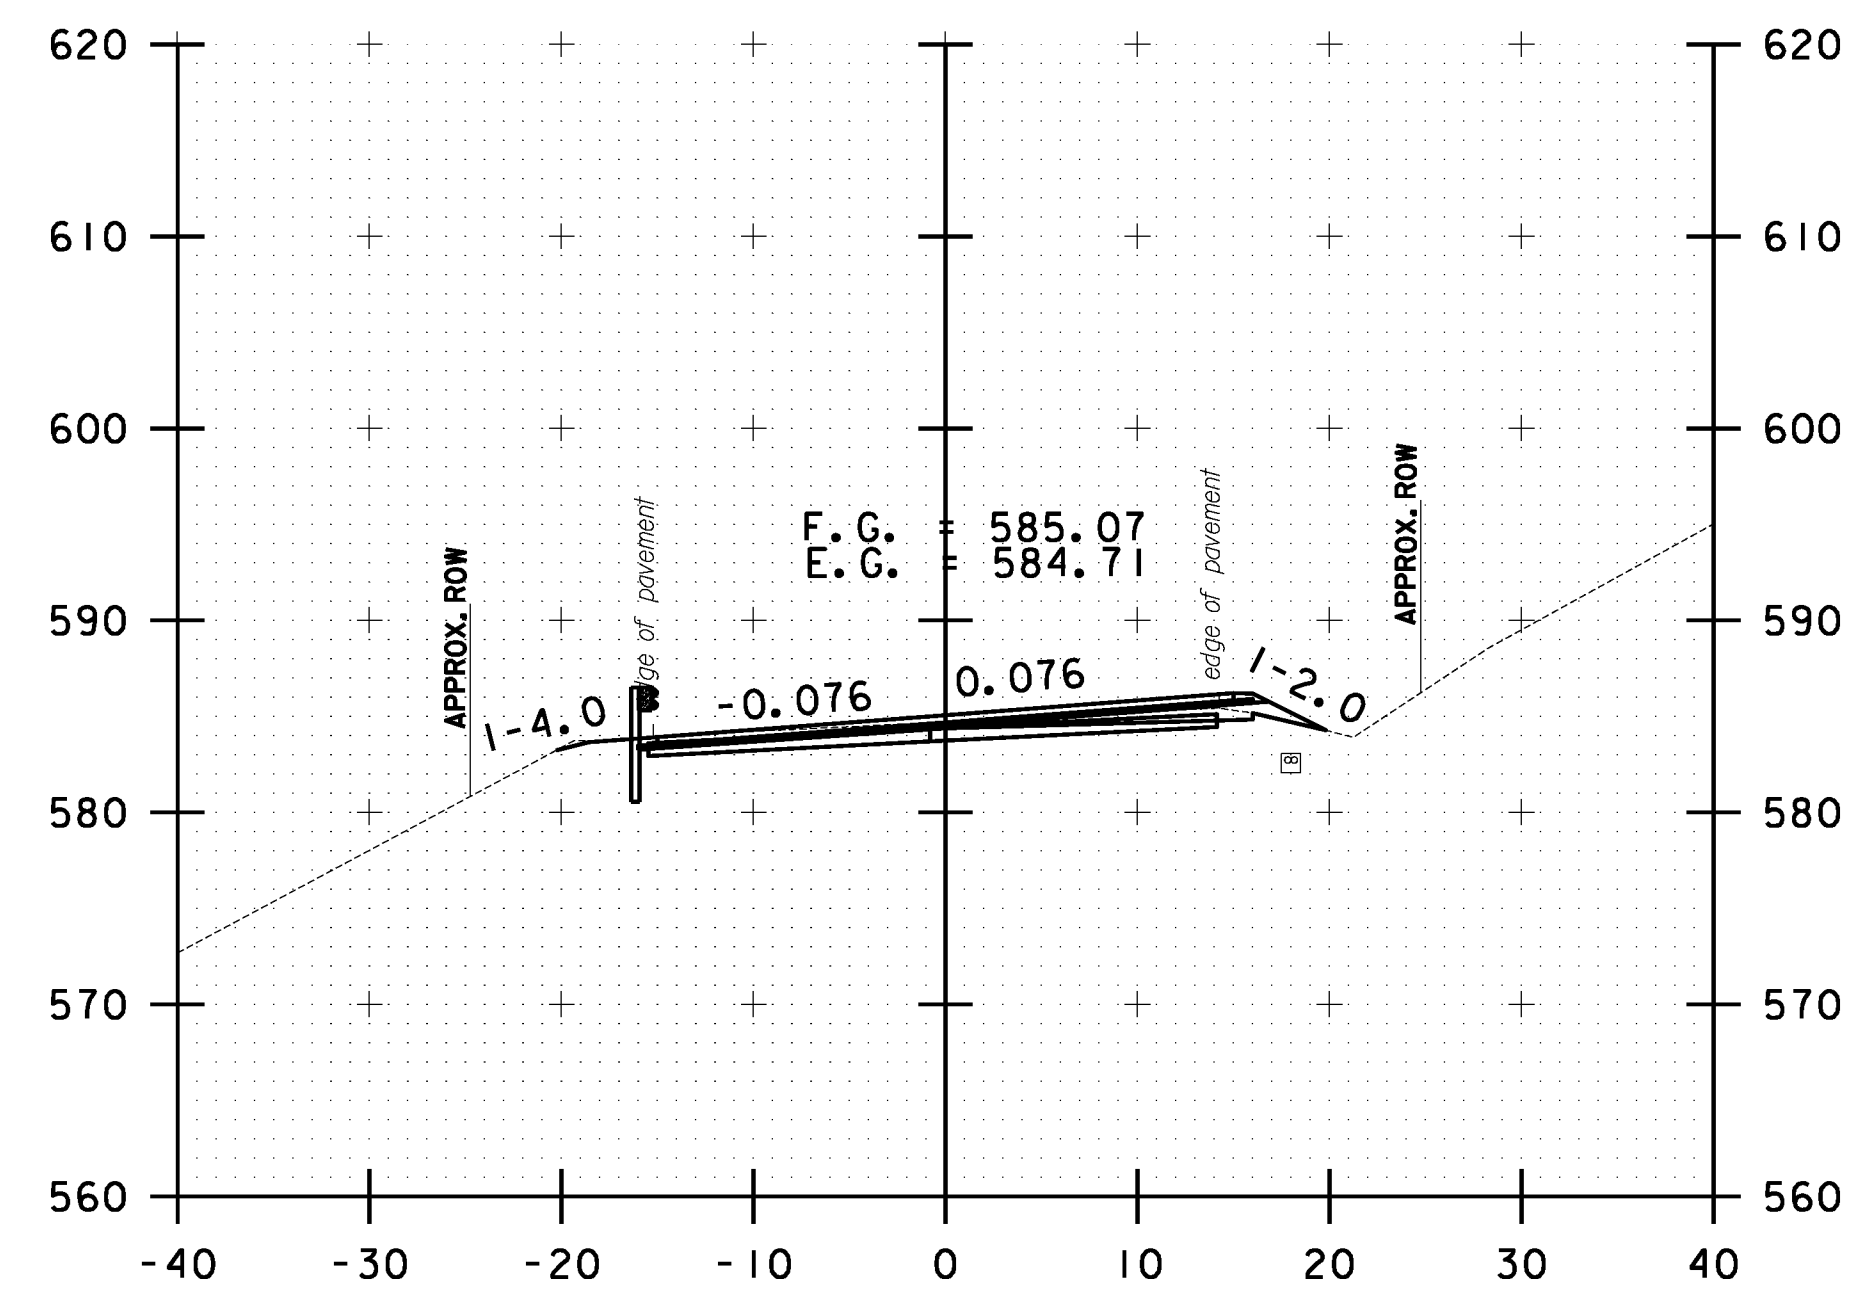


B 3+50.00

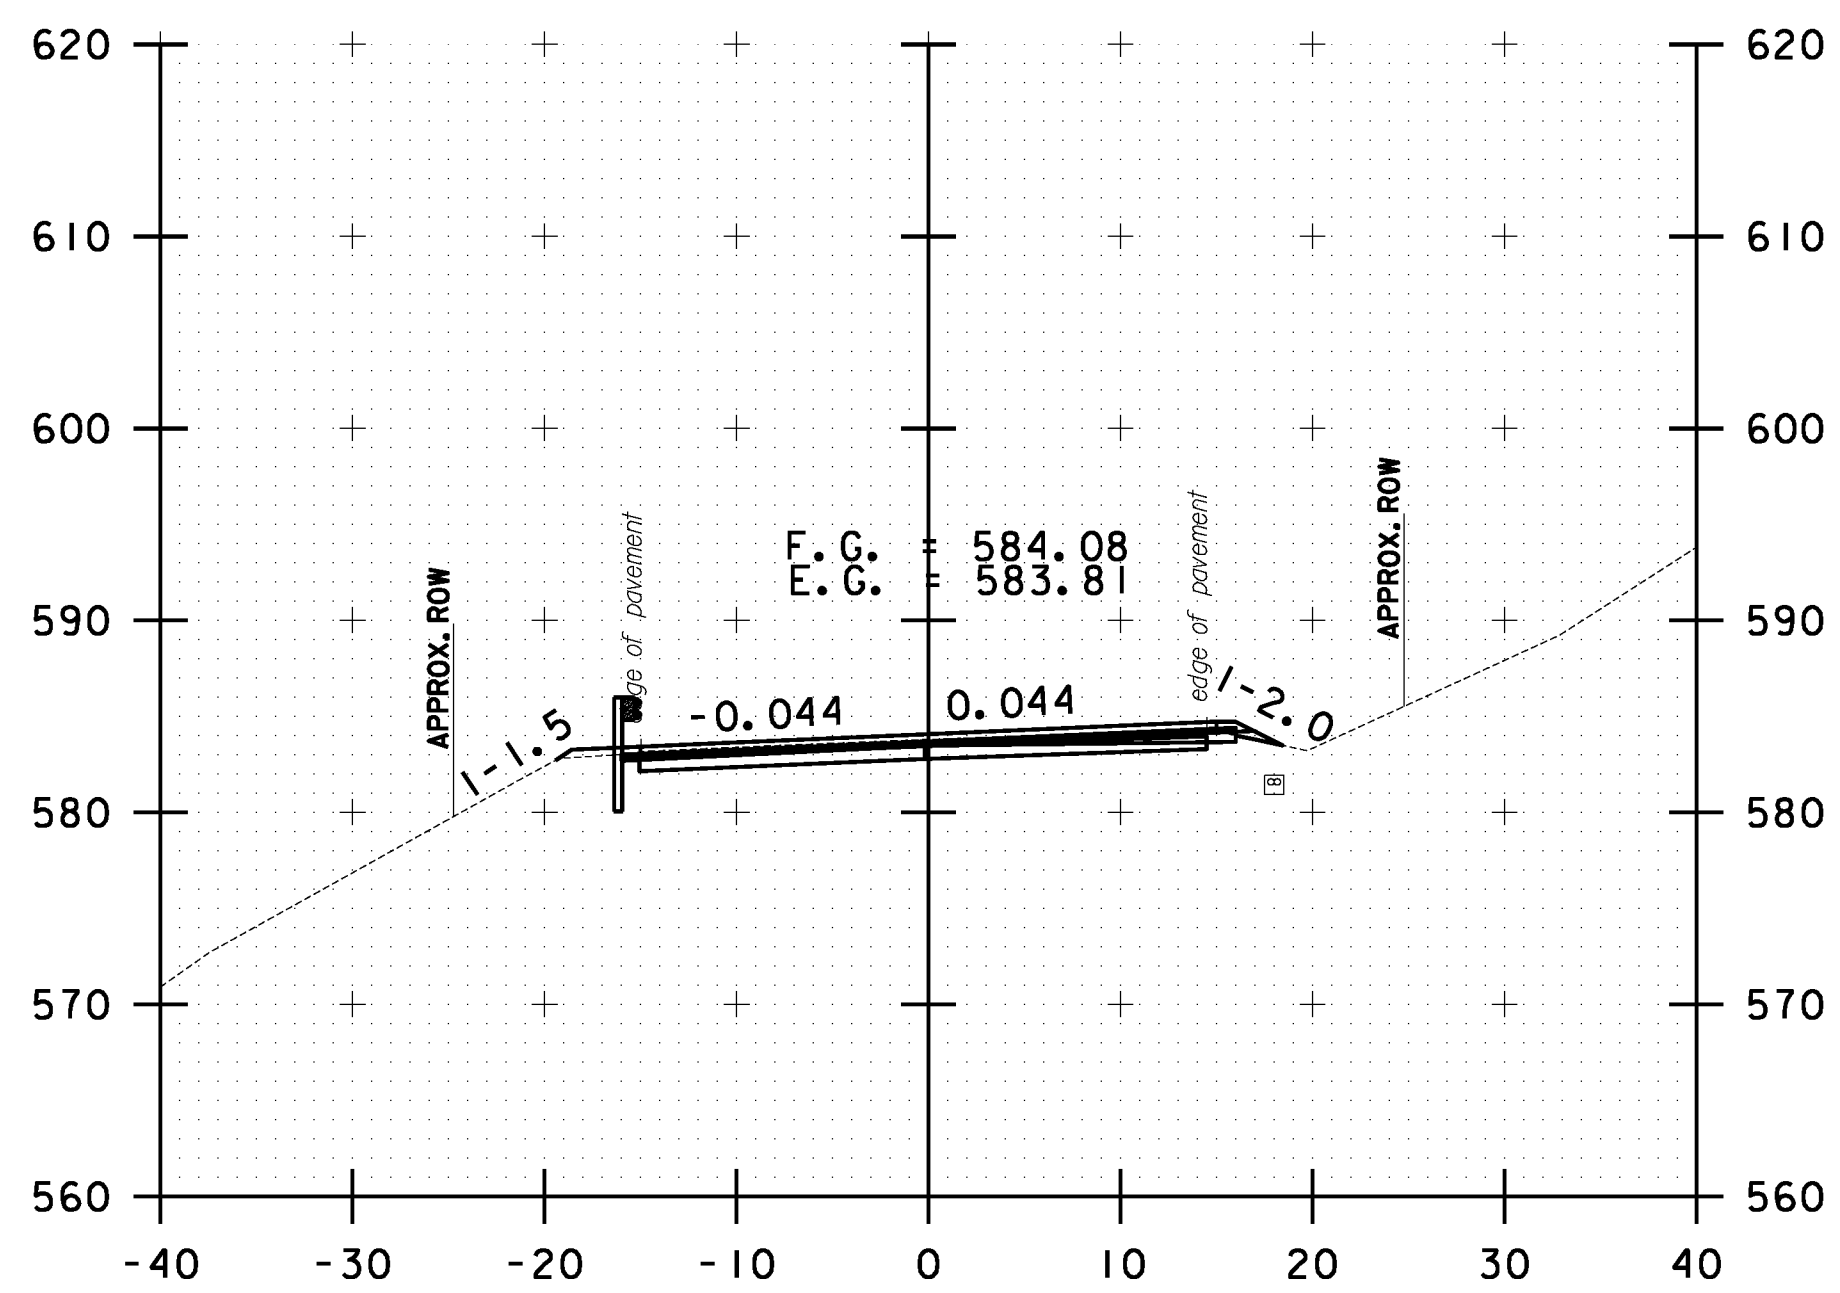


B 4+50.00

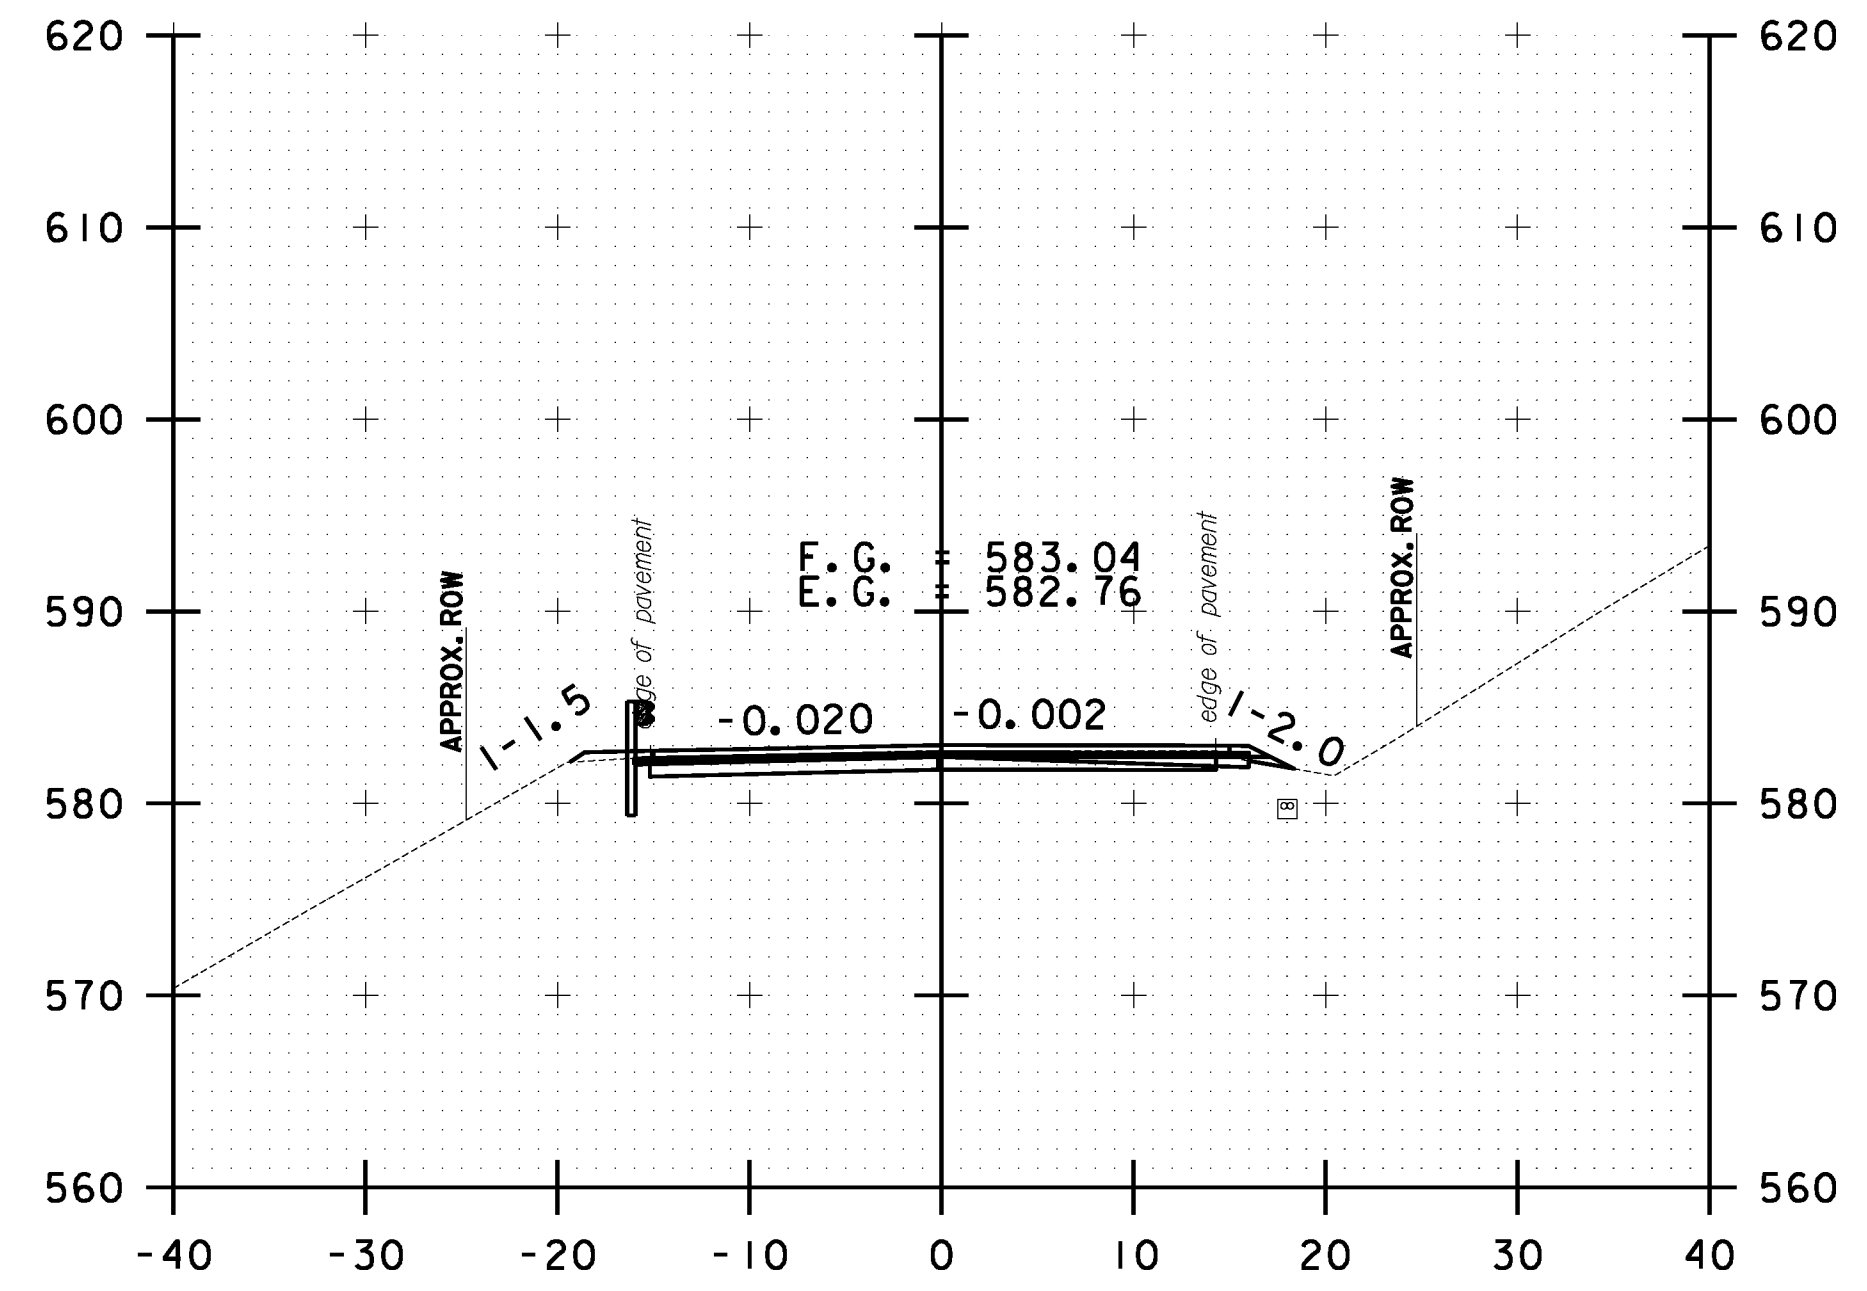


B 5+50.00

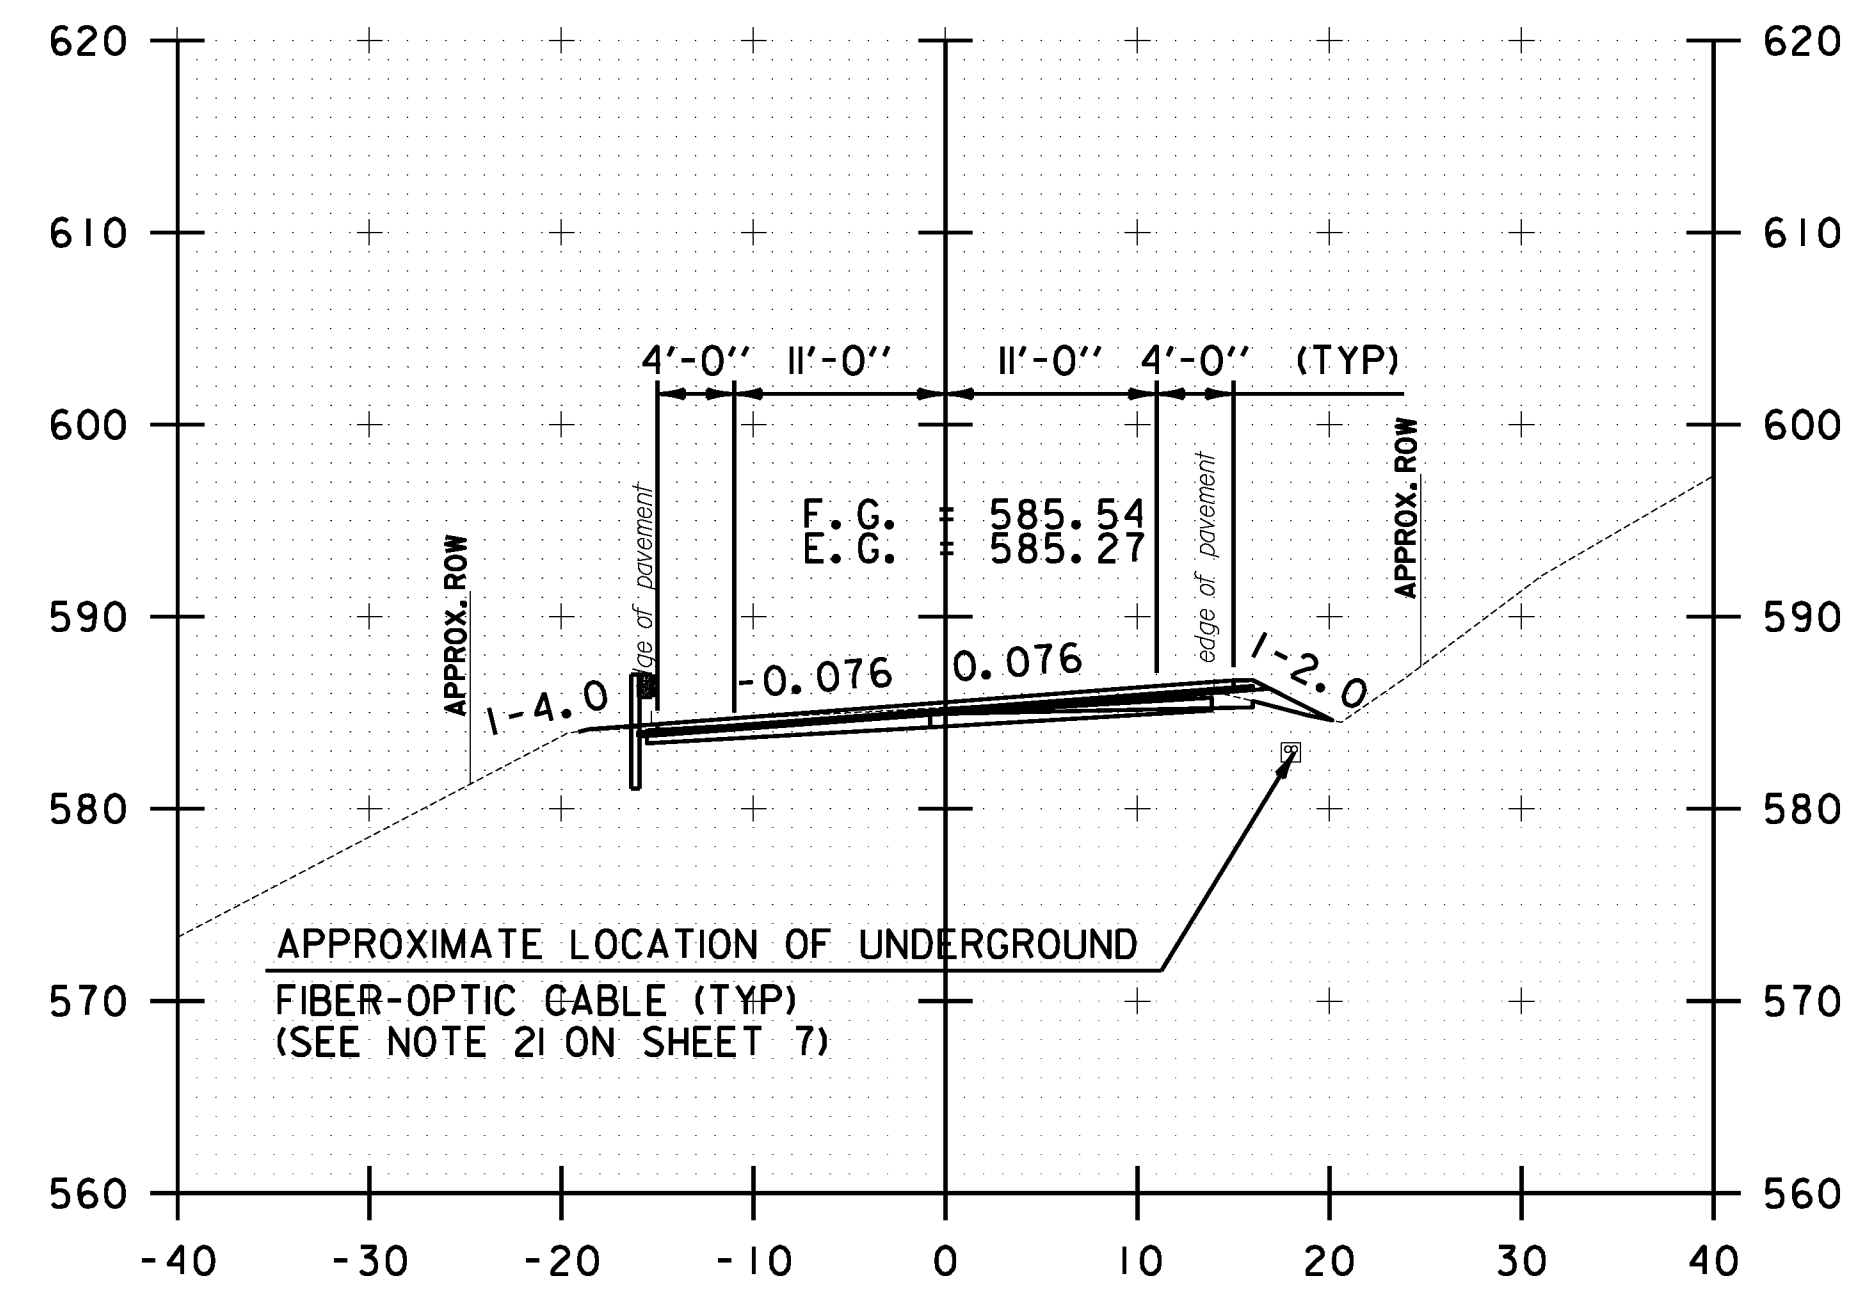


B 3+00.00

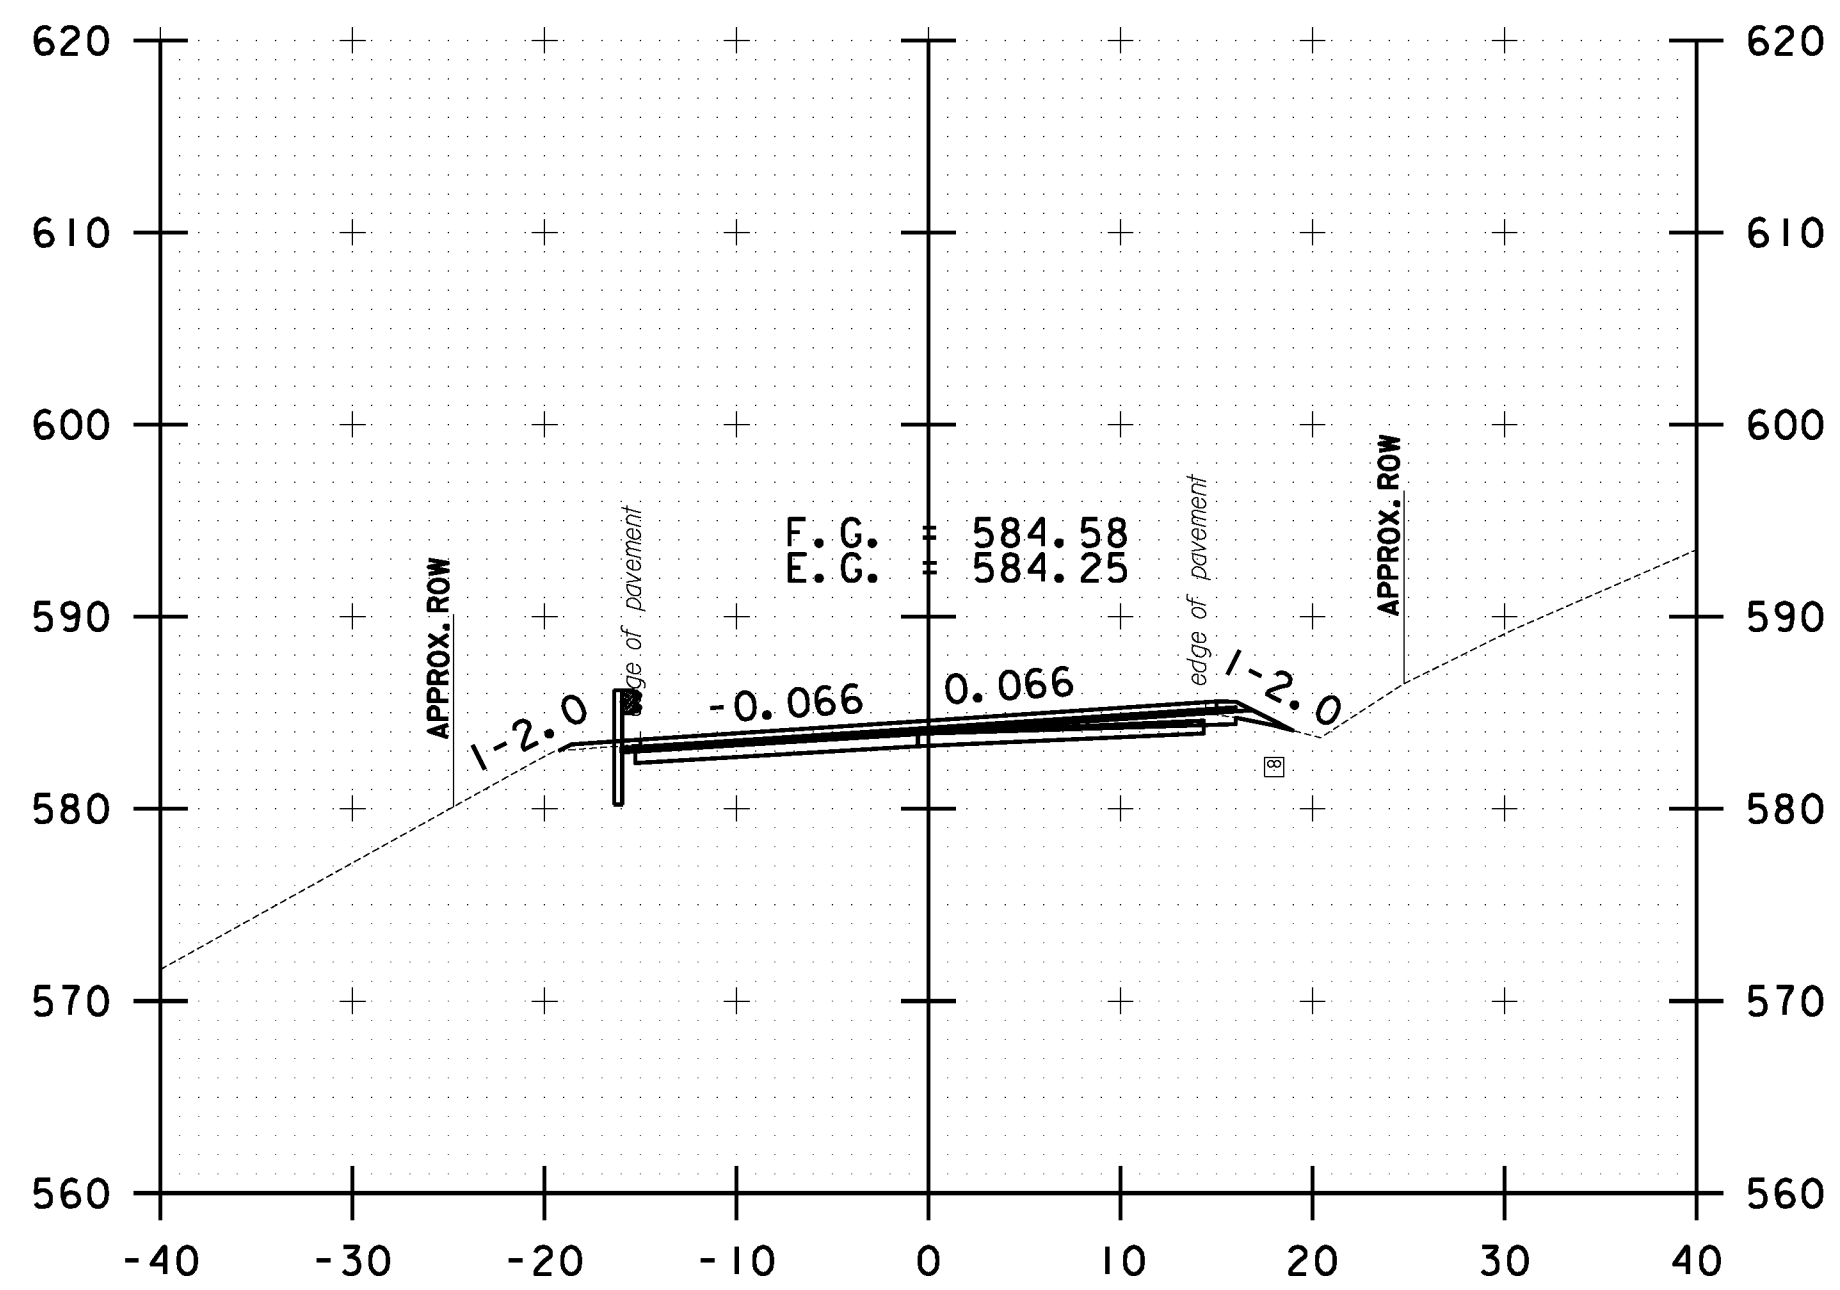

B 4+00.00

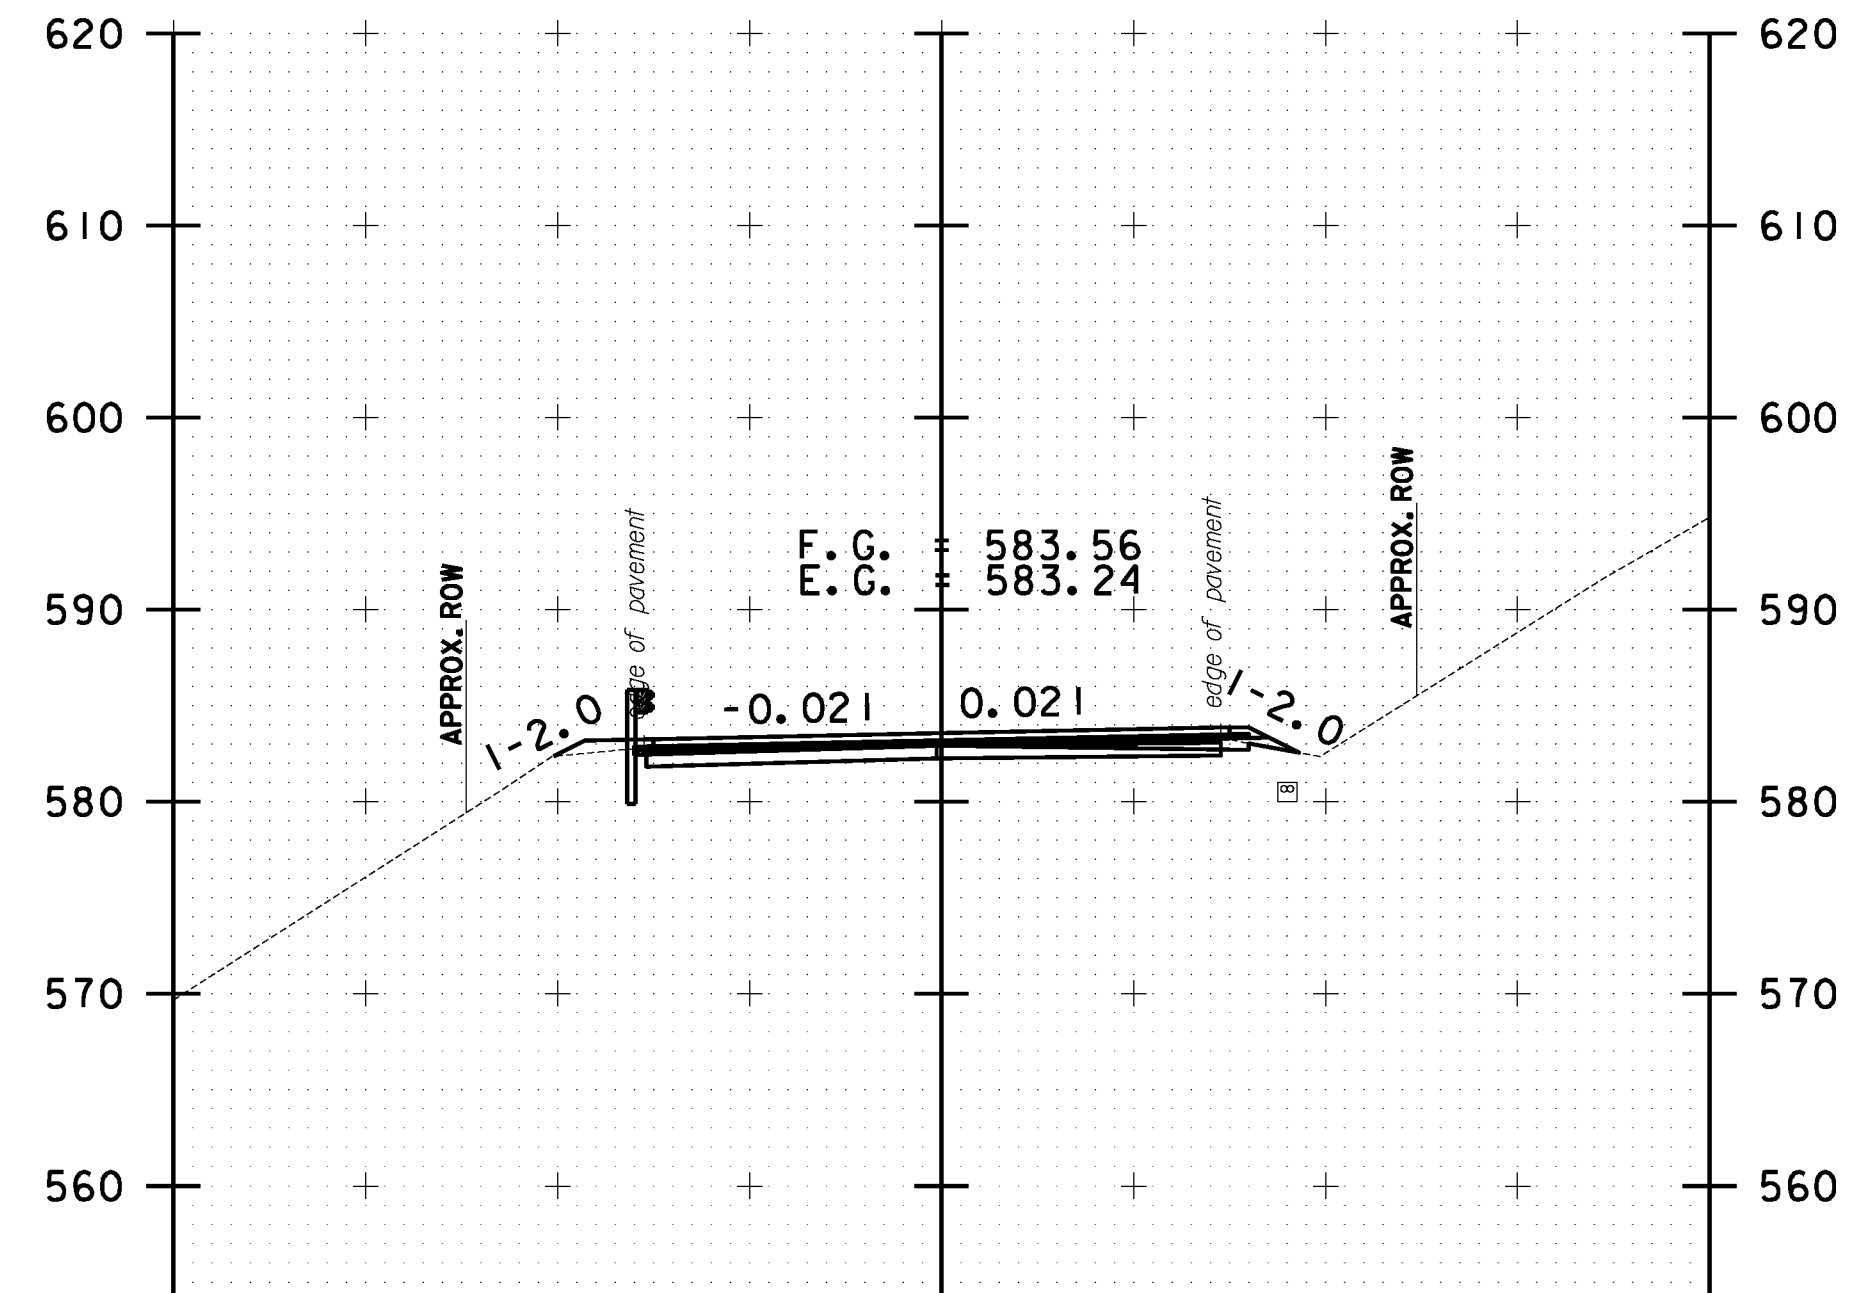

B 5+00.00

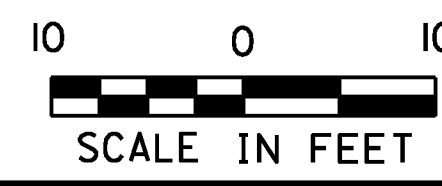

<b>BETHEL CROSS SECTION SHEET #2</b>	PROJECT NAME: STOCKBRIDGE-BETHEL
	PROJECT NUMBER: STP 2910(1)
	FILE NAME: z10b214.bethel.xc.dgn
	PLOT DATE: 3/17/2014
DESIGNED BY: L.M.B.	DRAWN BY: W.G.P.
IPARM FILE: z10b214xsl14.1	CHECKED BY: J.P.S.
	SHEET 327 OF 397