




B 6+50.00

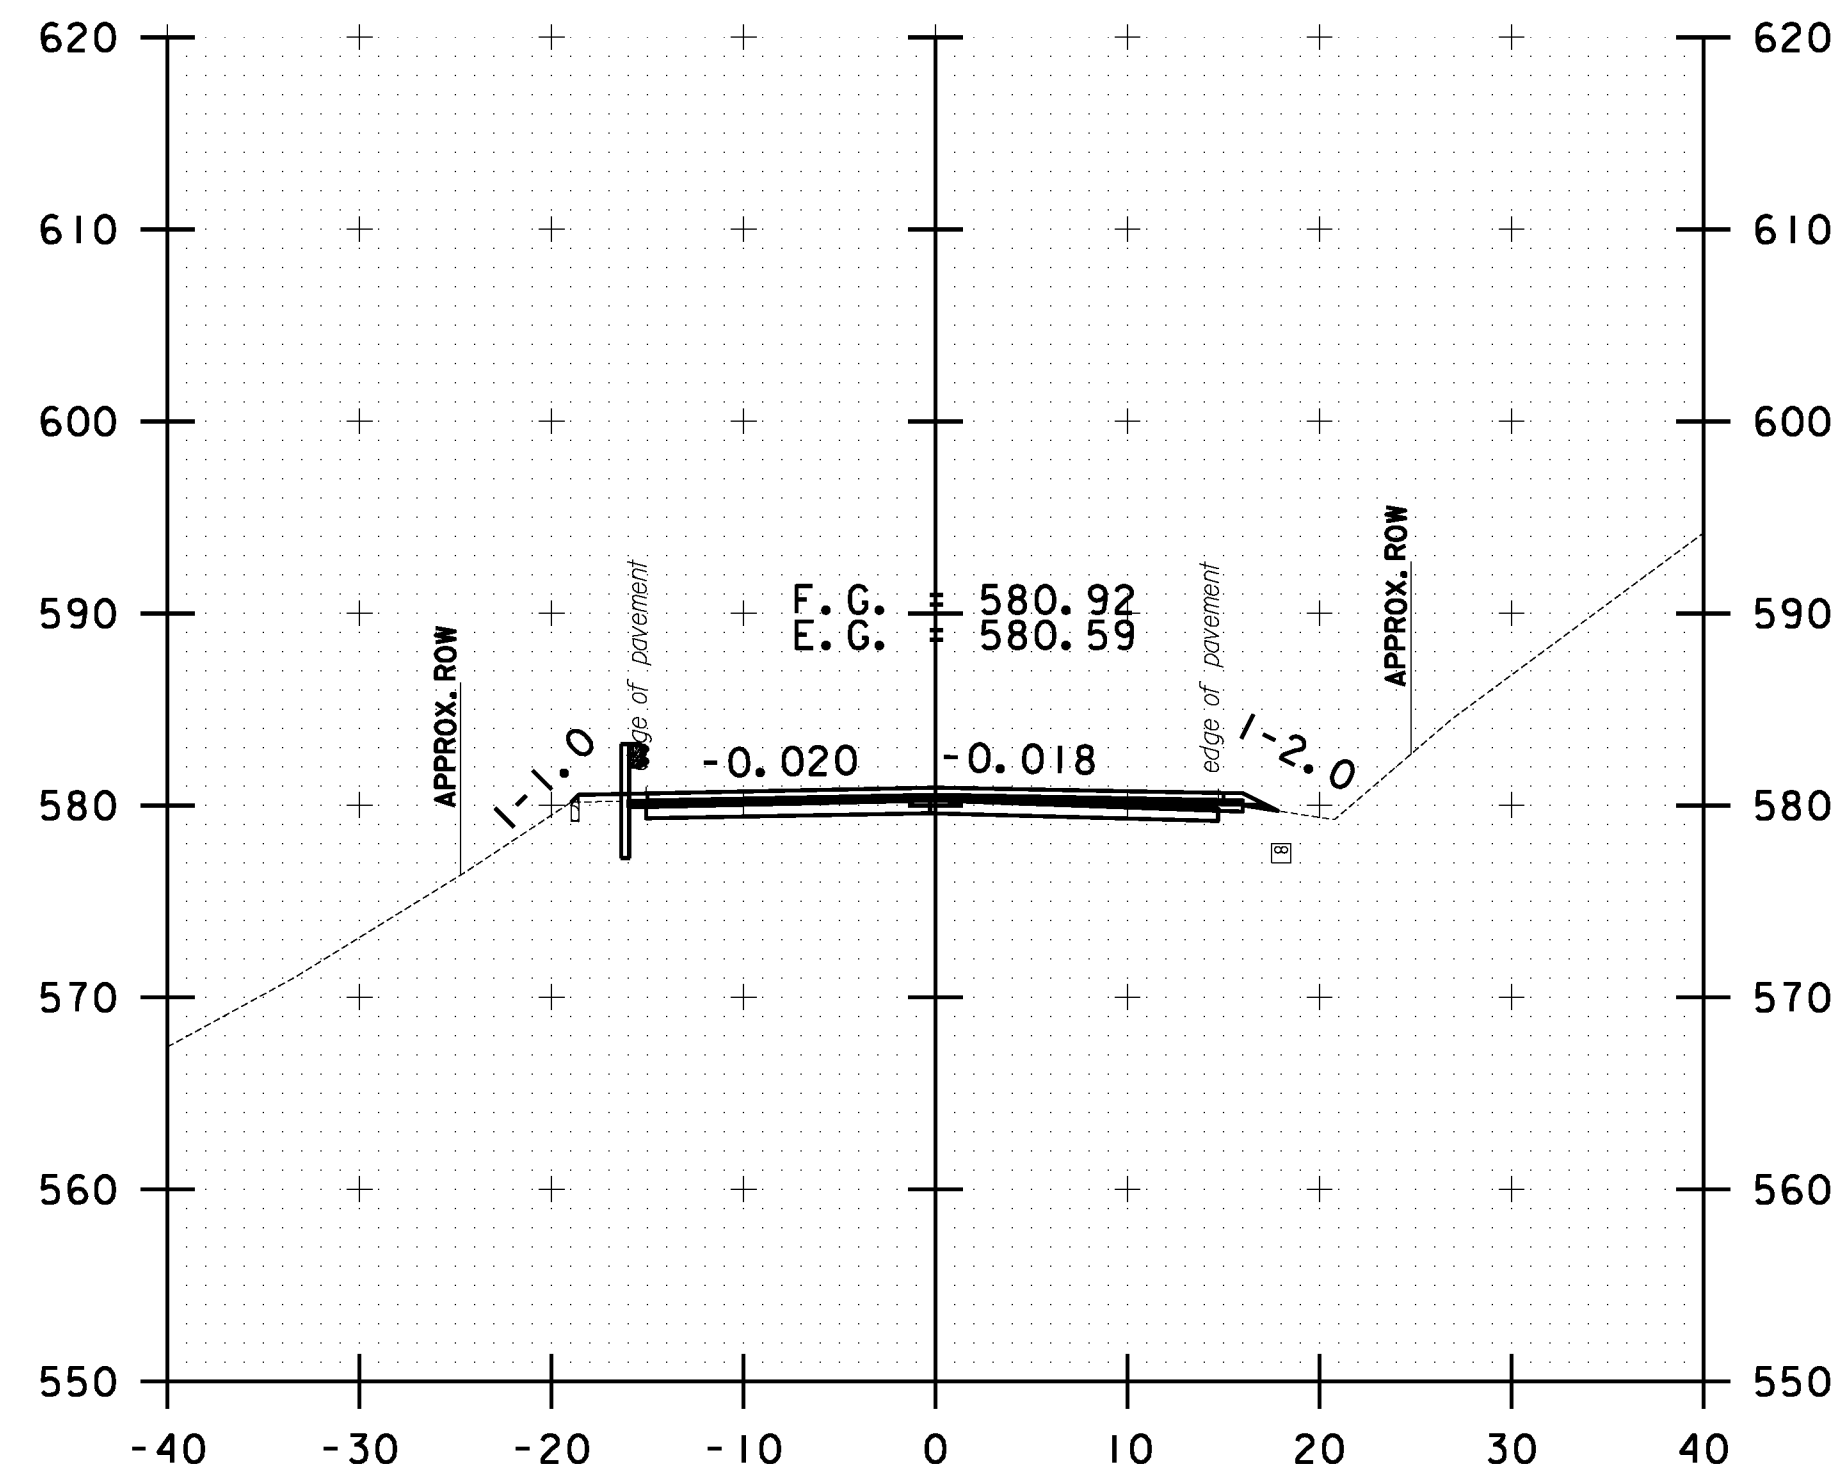


B 7+50.00

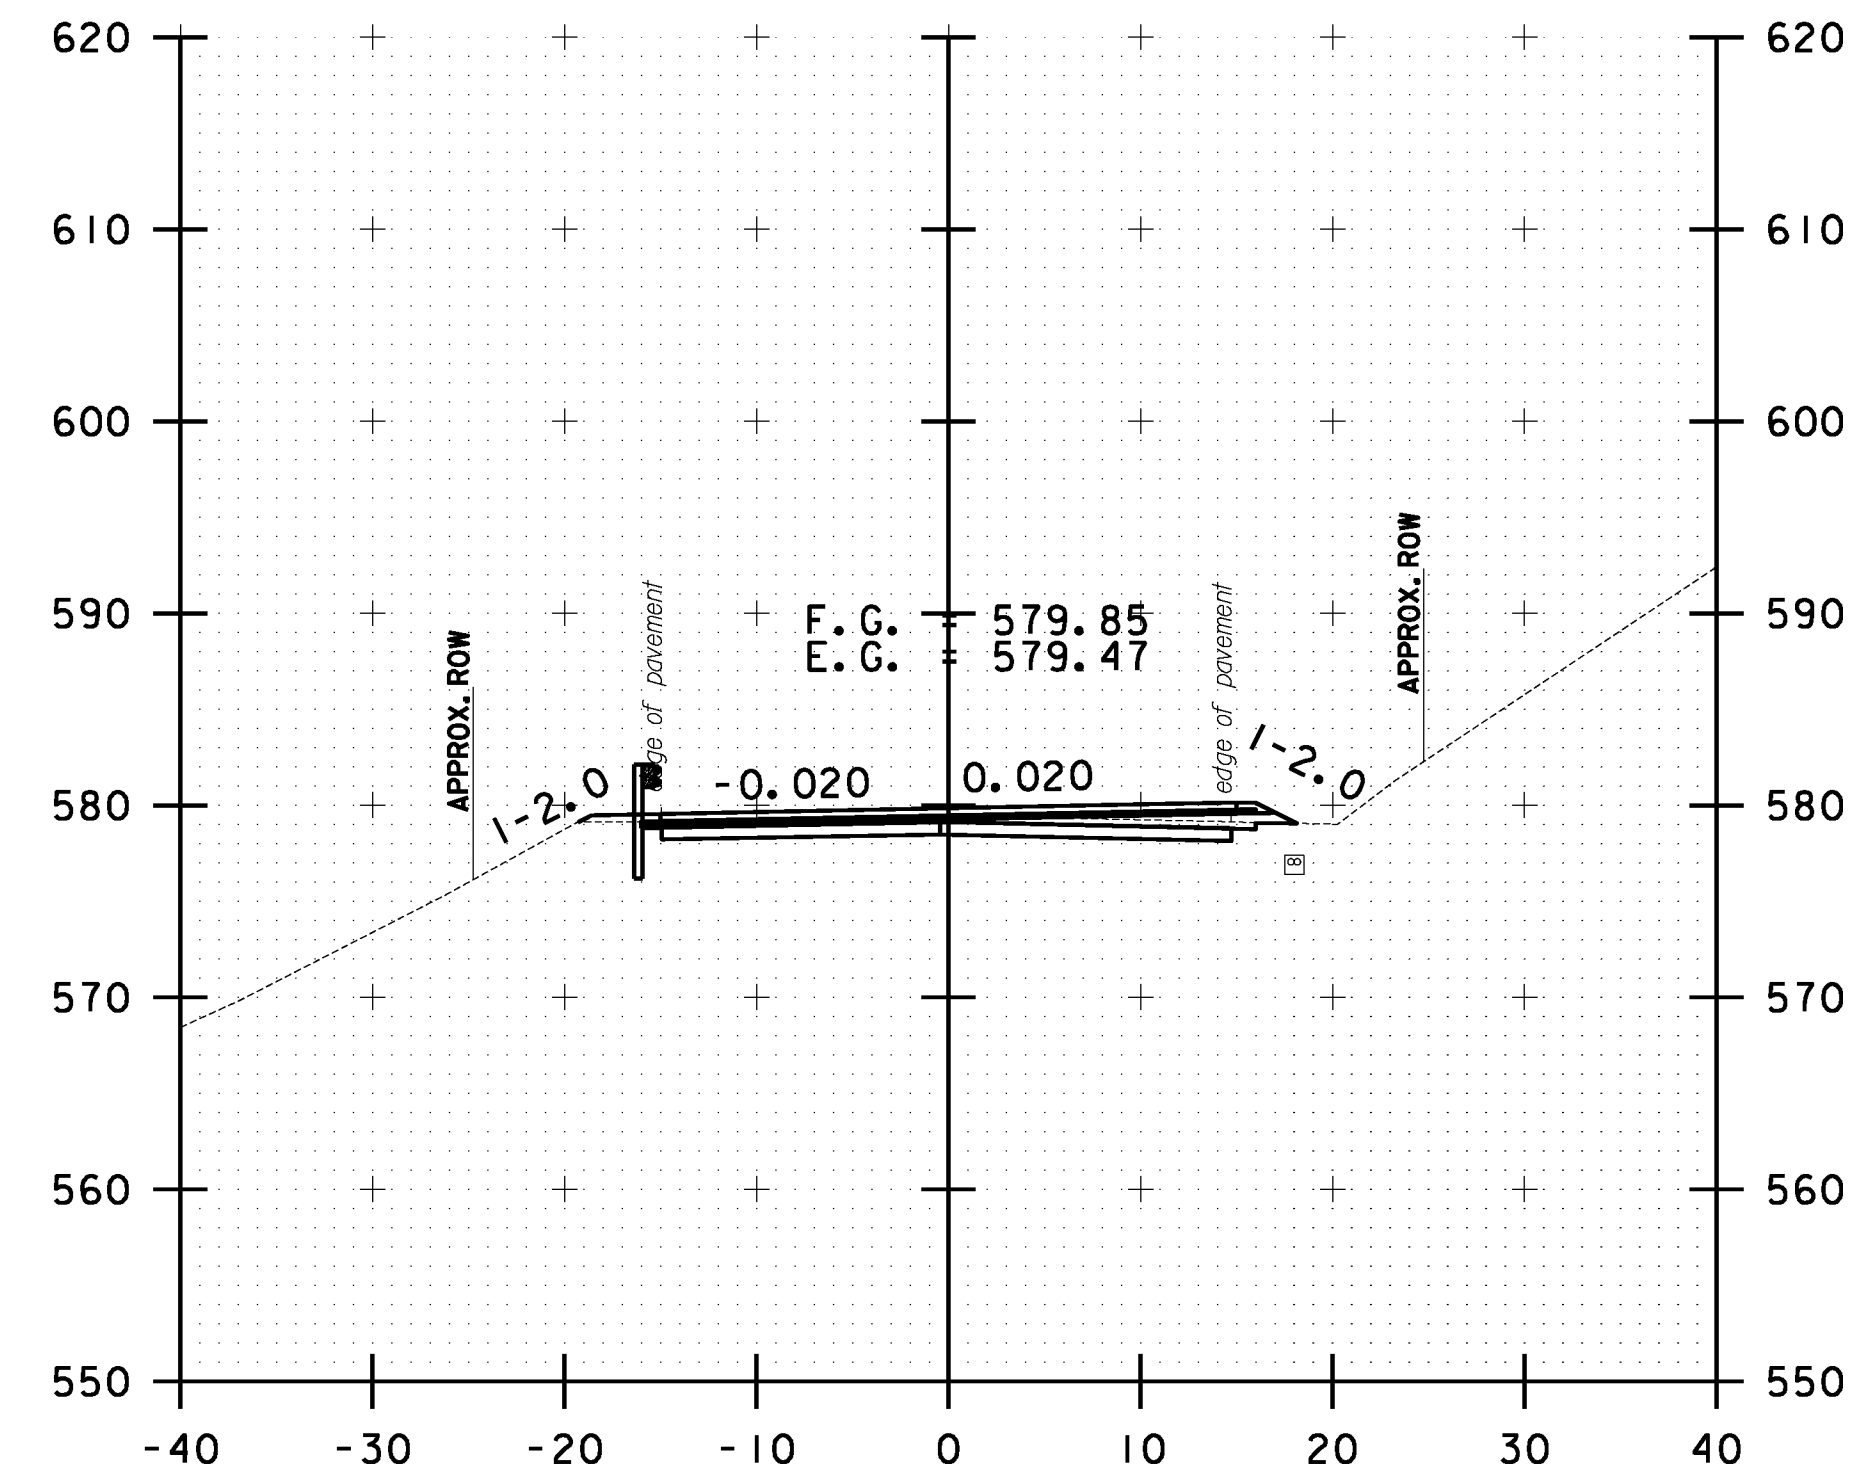


B 8+50.00

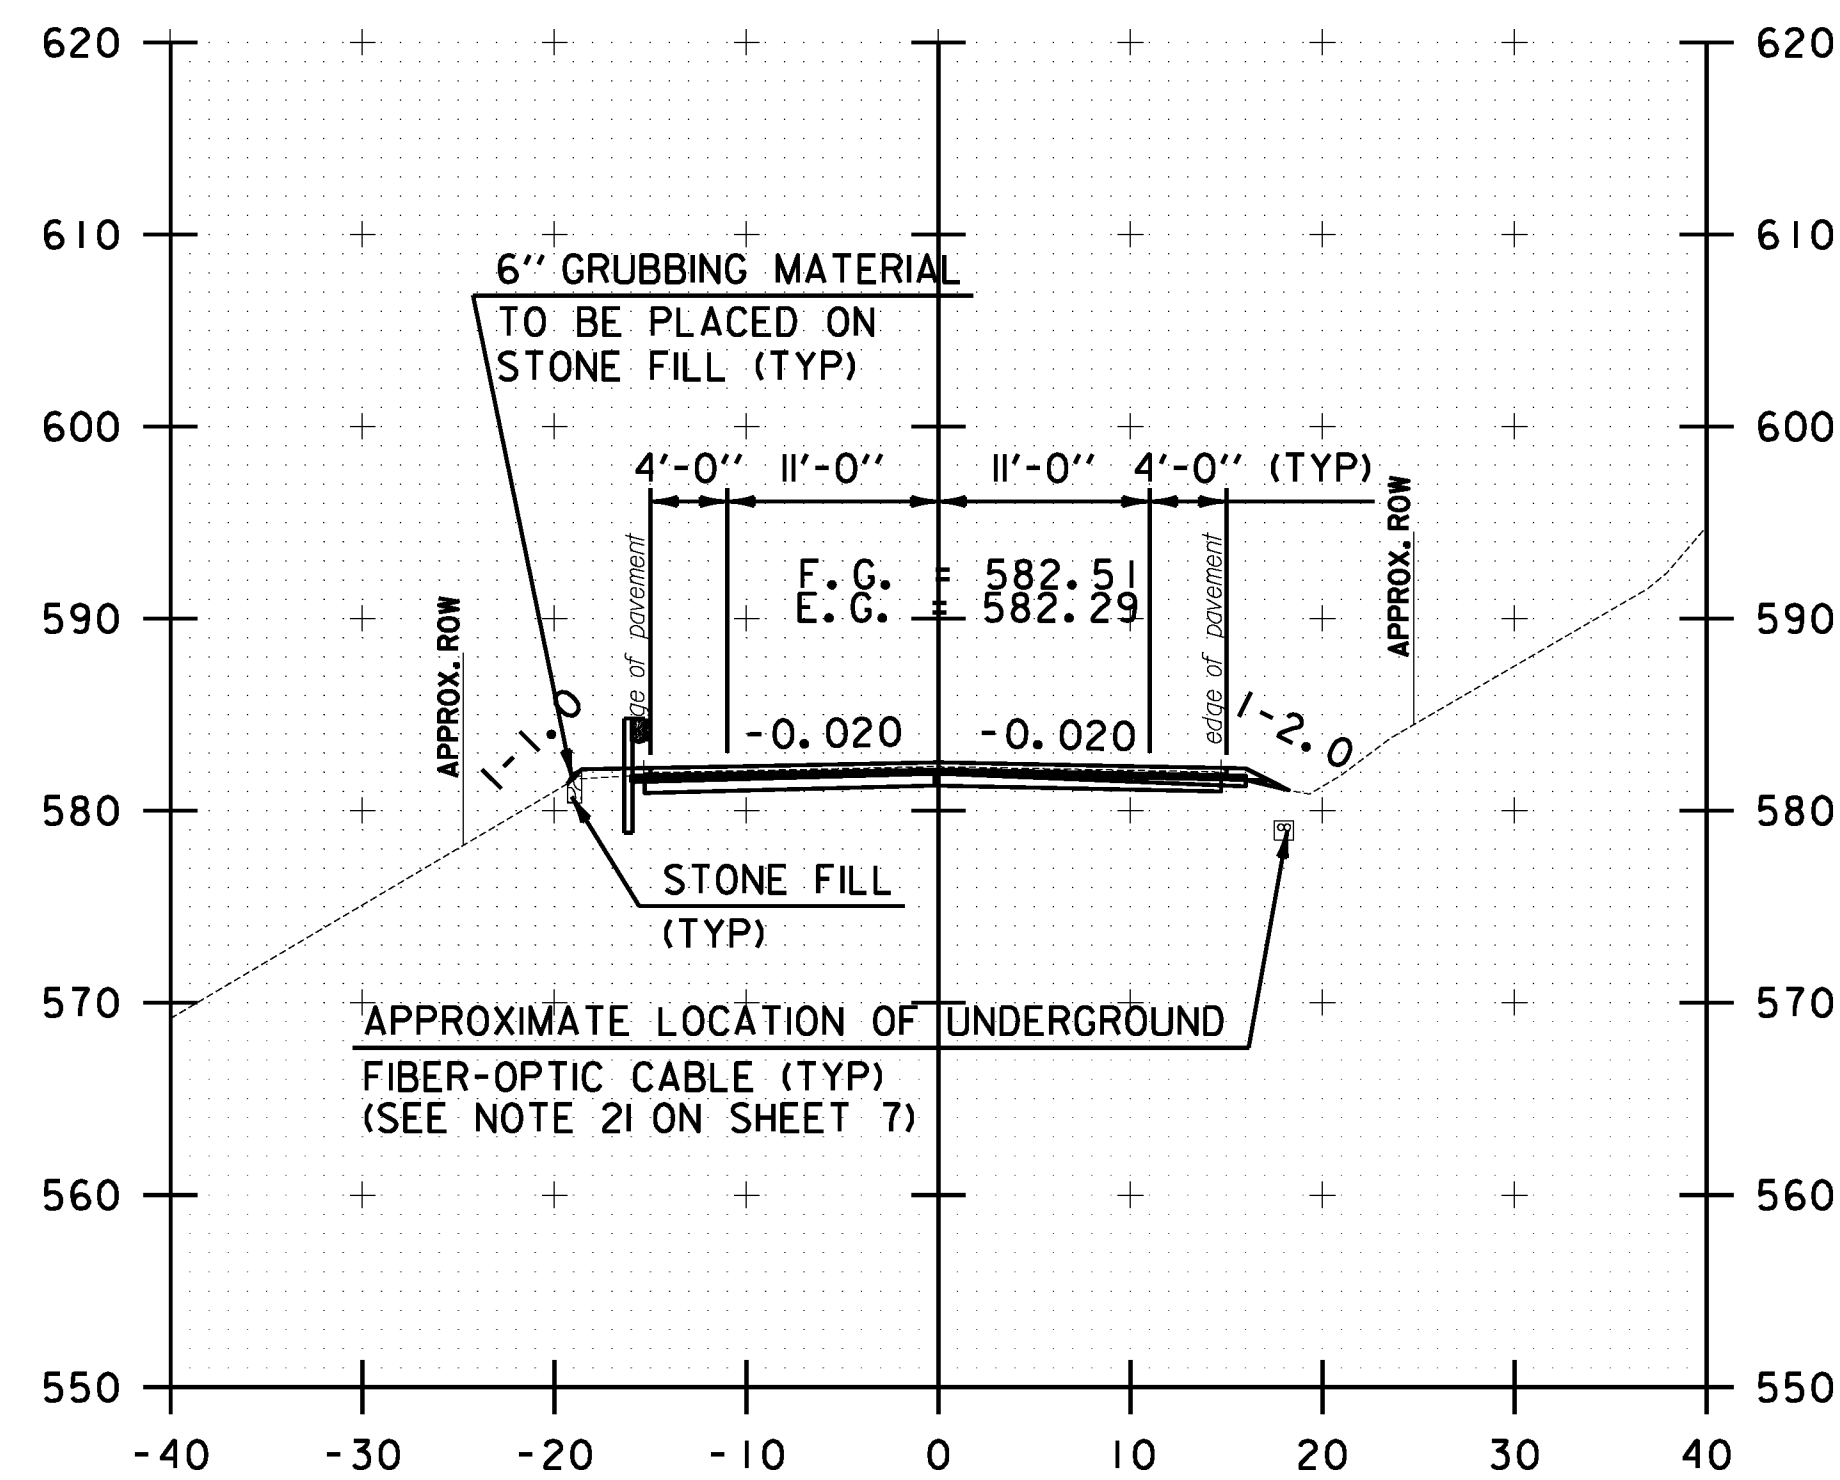

B 6+00.00

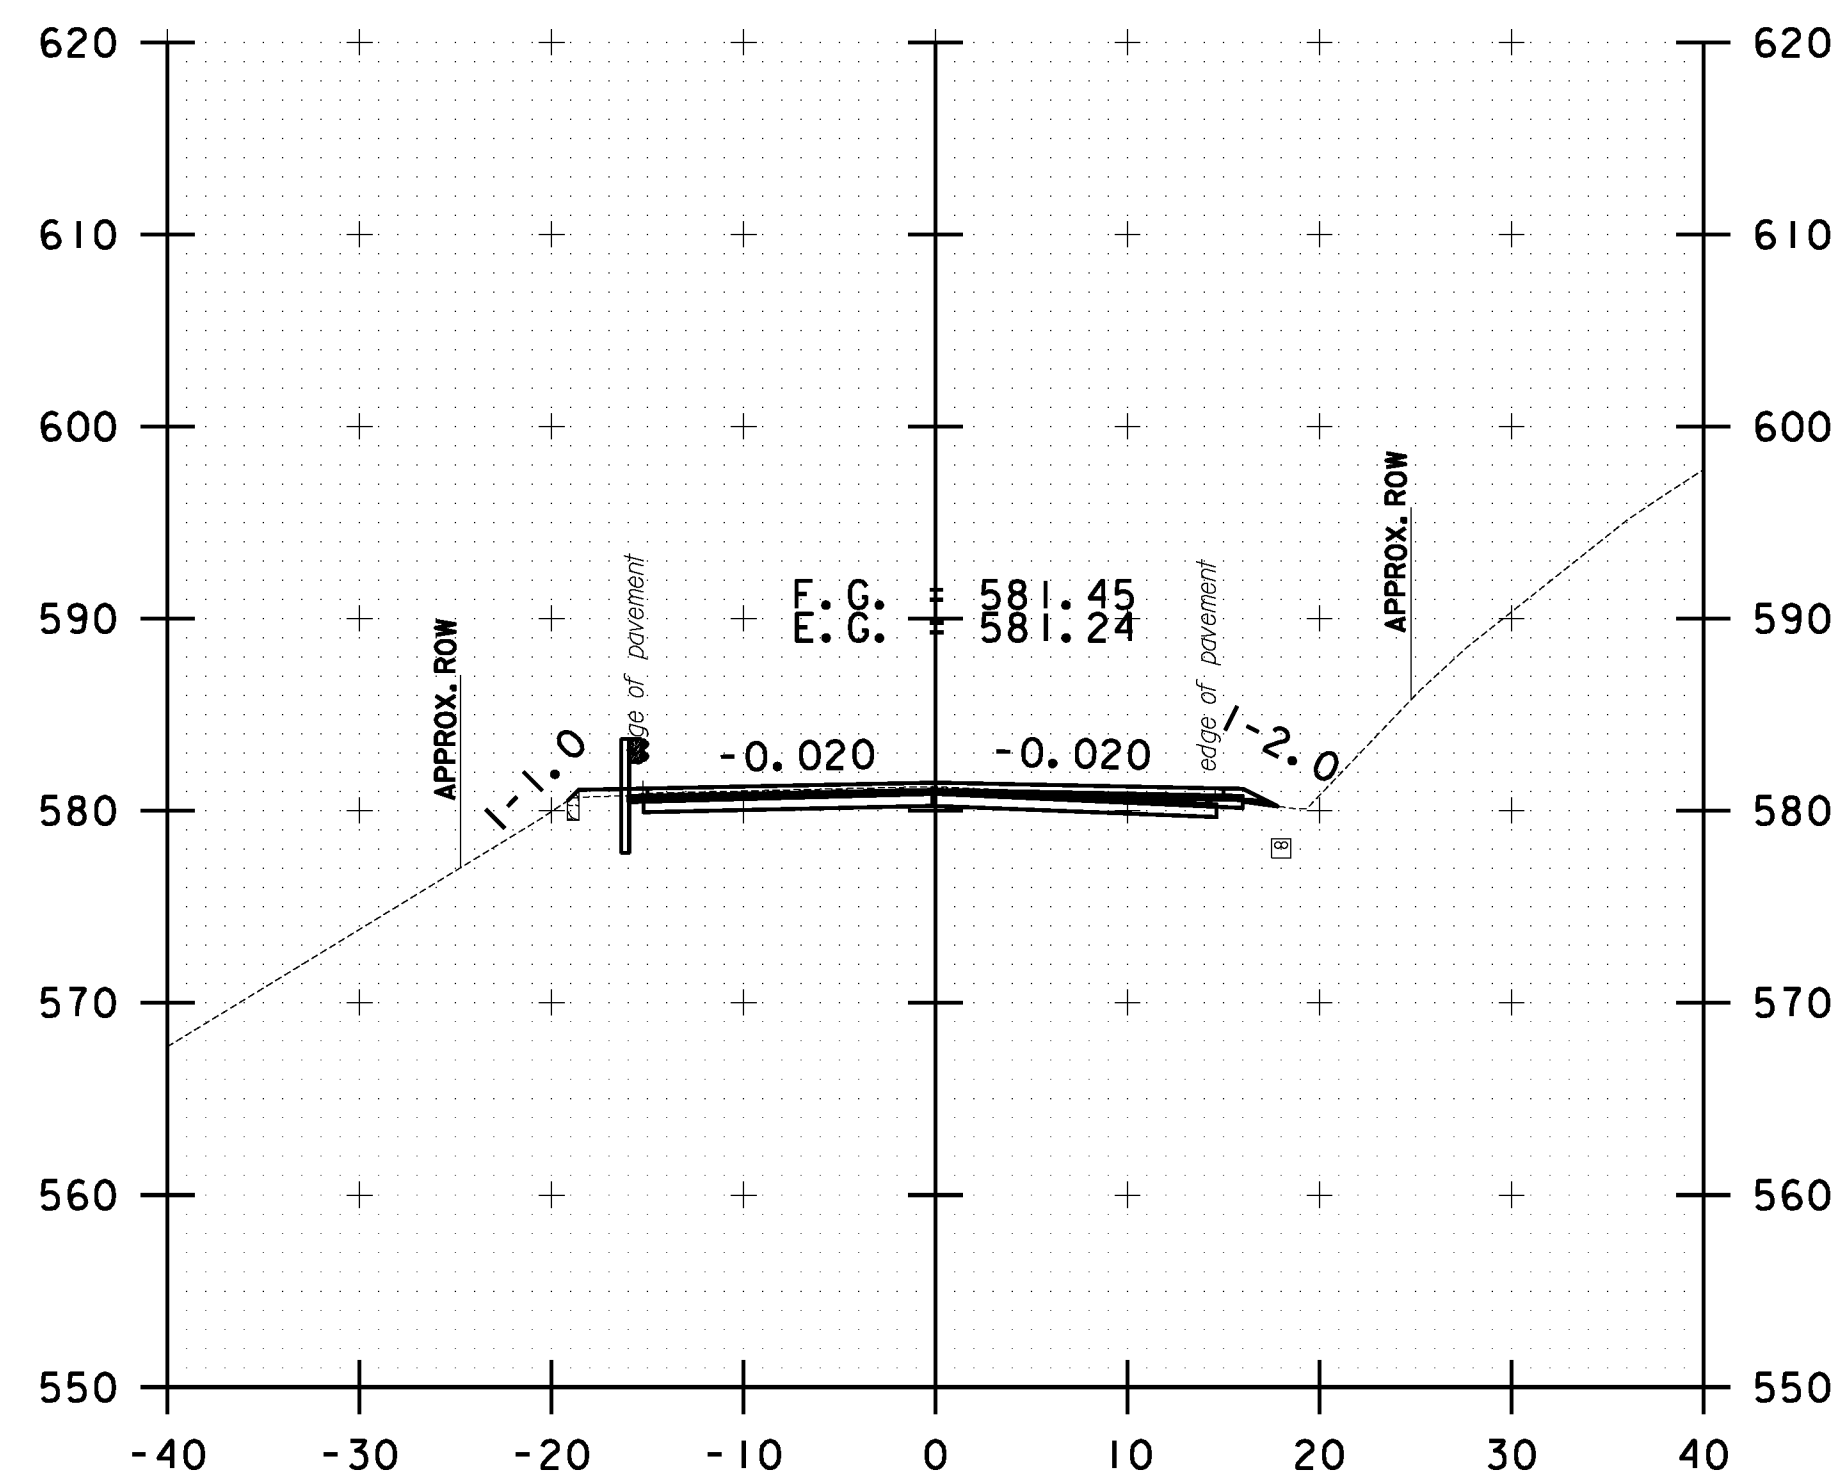


B 7+00.00

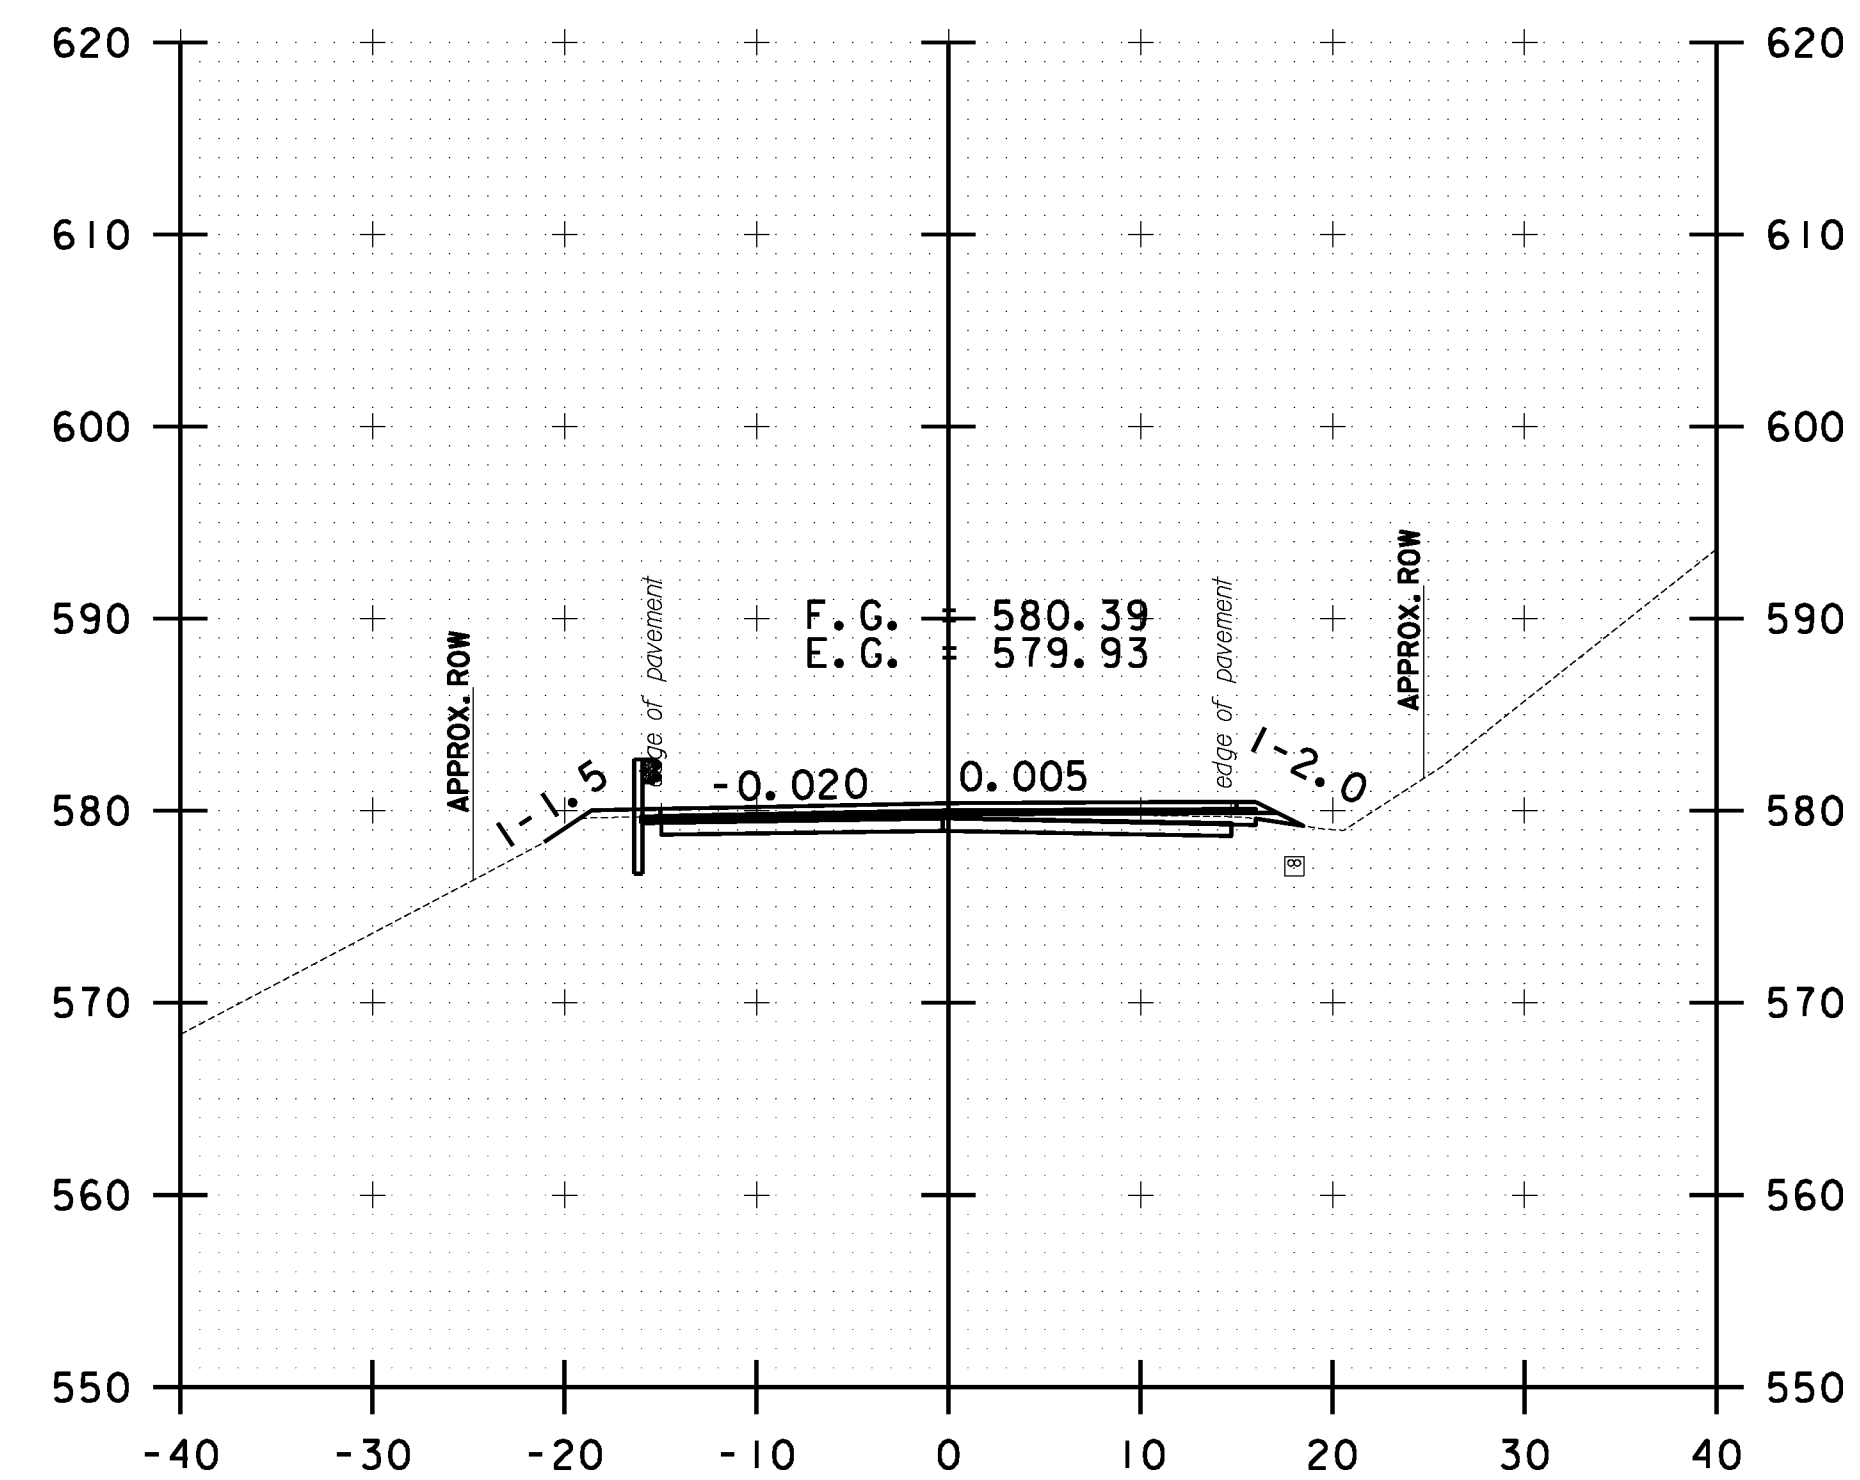

B 8+00.00

FILE NAME = V:\P\c\p\sc\any\k2\22425\CA001\MSTN\10b214\_bethel.xc.dgn  
 DATE/TIME = 3/17/2014  
 USER = 4916

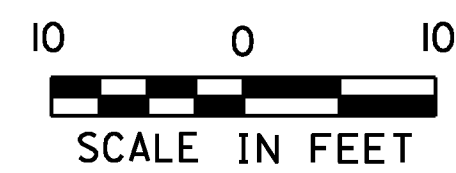

<b>BETHEL CROSS SECTION SHEET #3</b>	PROJECT NAME: STOCKBRIDGE-BETHEL
	PROJECT NUMBER: STP 2910(1)
	FILE NAME: z10b214.bethel.xc.dgn
	IPARM FILE: z10b214xsl15.1
	PLOT DATE: 3/17/2014
	DRAWN BY: W.G.P.
	CHECKED BY: J.P.S.
	SHEET 328 OF 397