




FILE NAME = Y:\P\c\res\any\k2\22425\CA001\MSTN\10b214.bethel.xc.dgn
 DATE/TIME = 3/17/2014
 USER = 4916

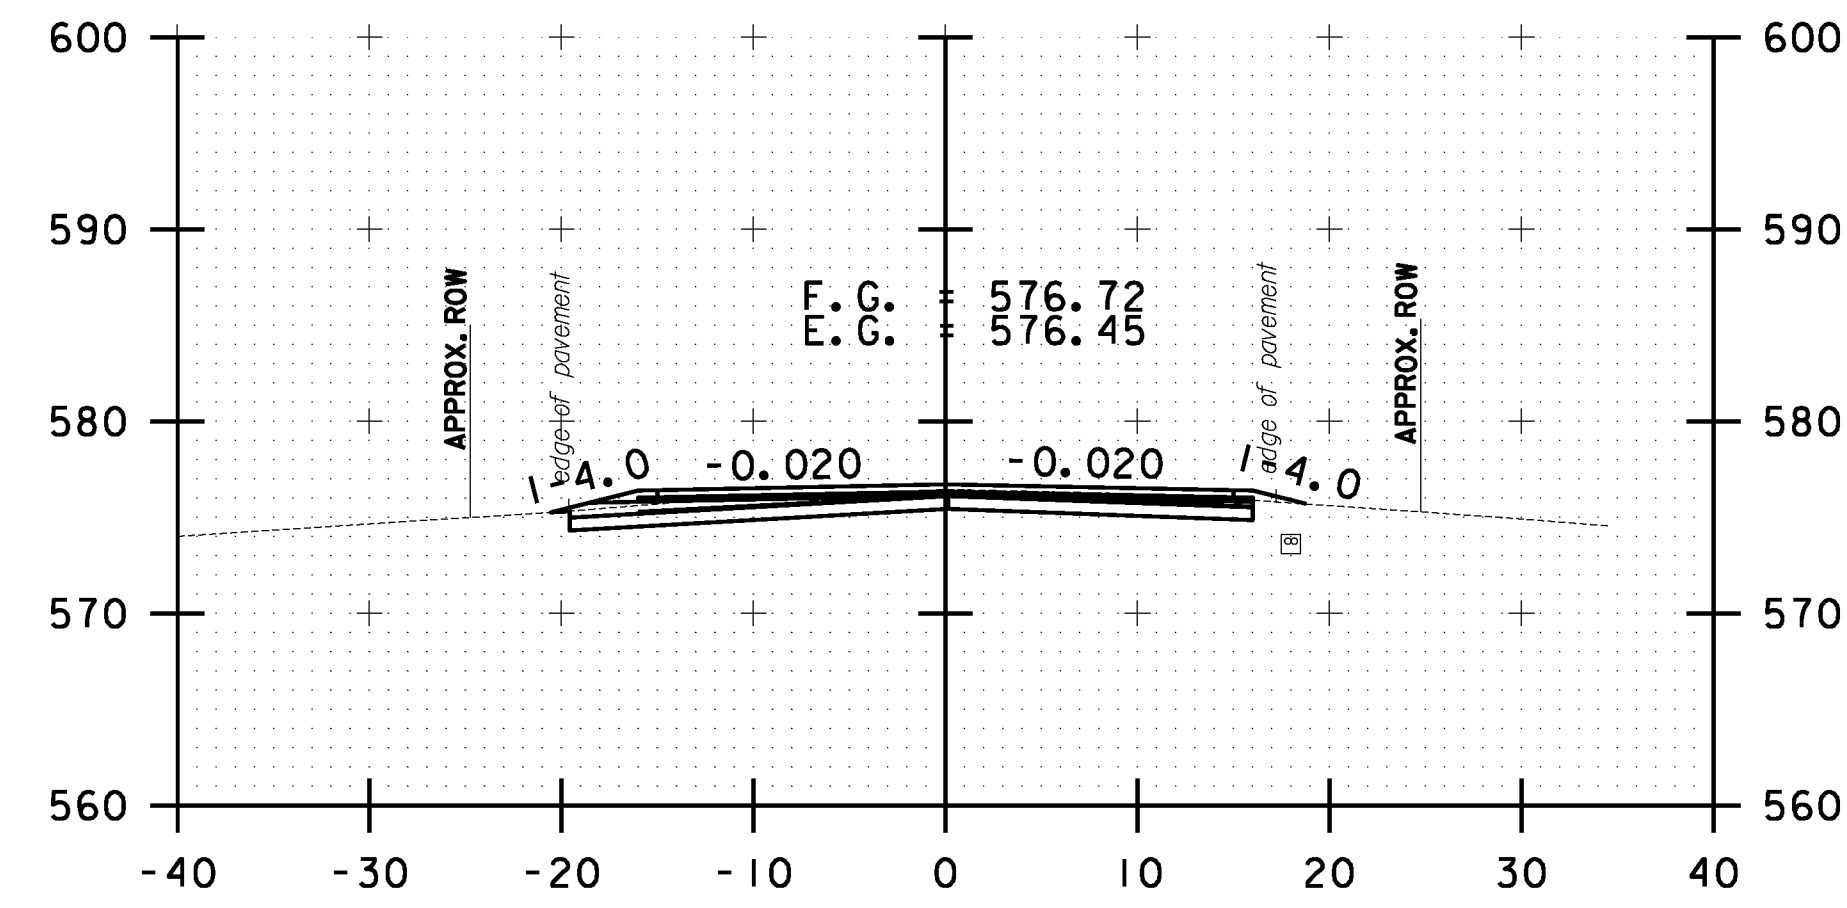


B 13+50.00

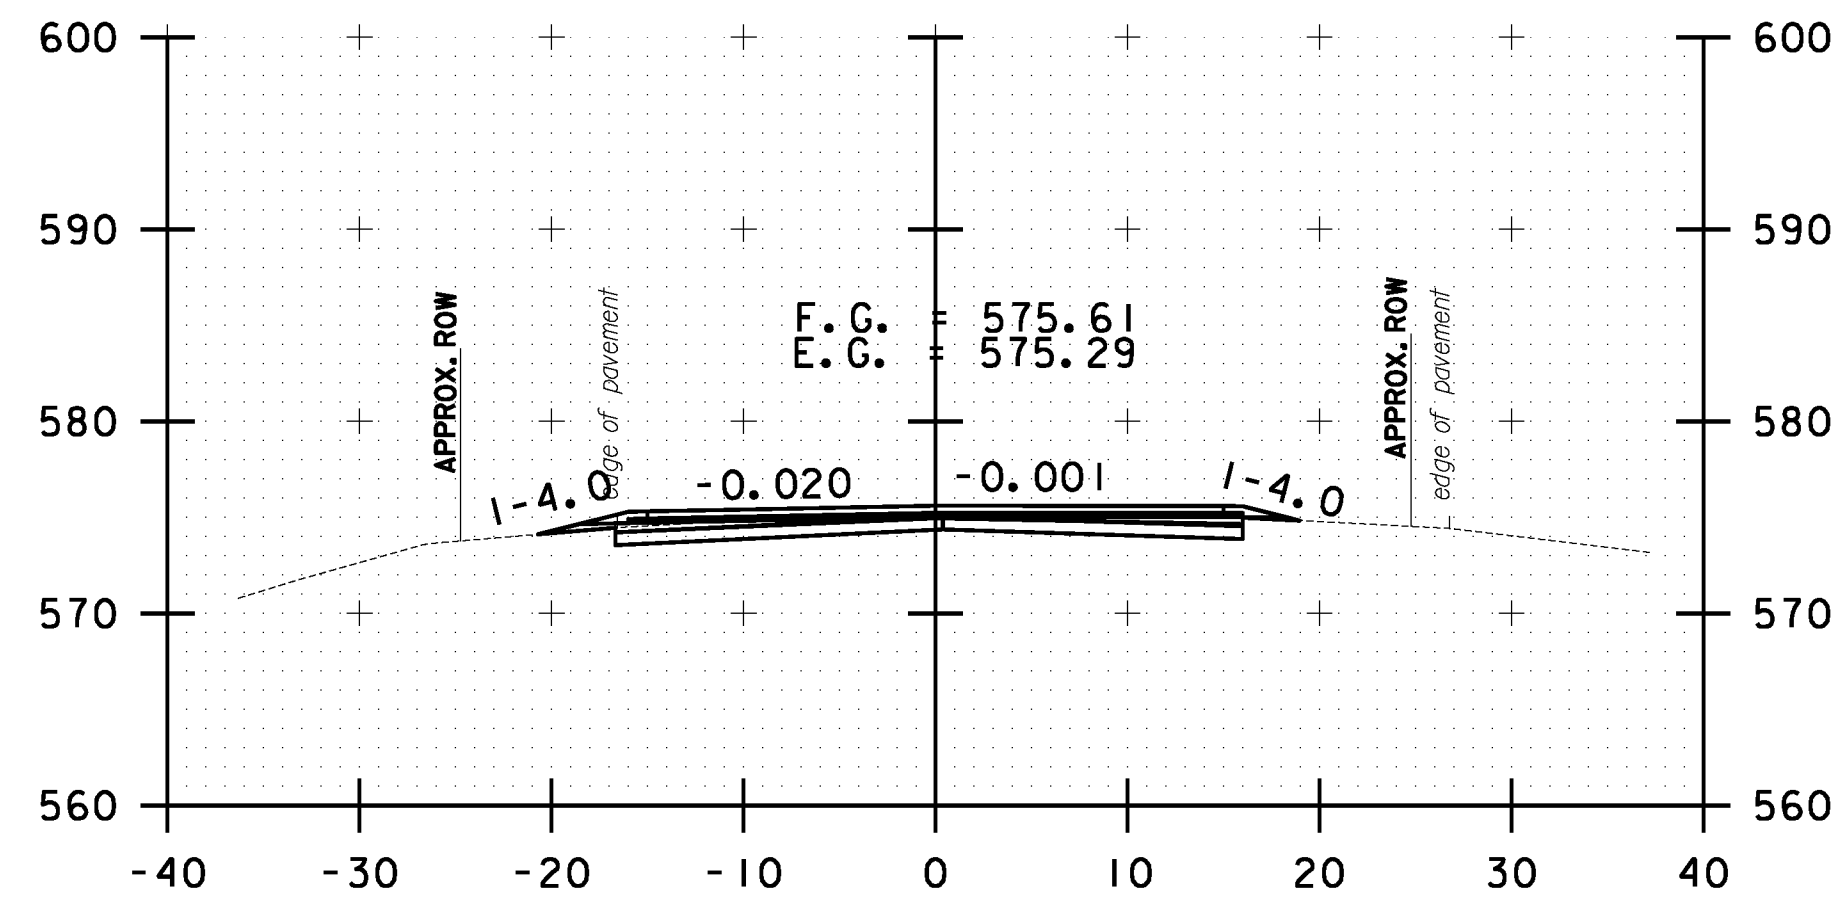


B 15+00.00

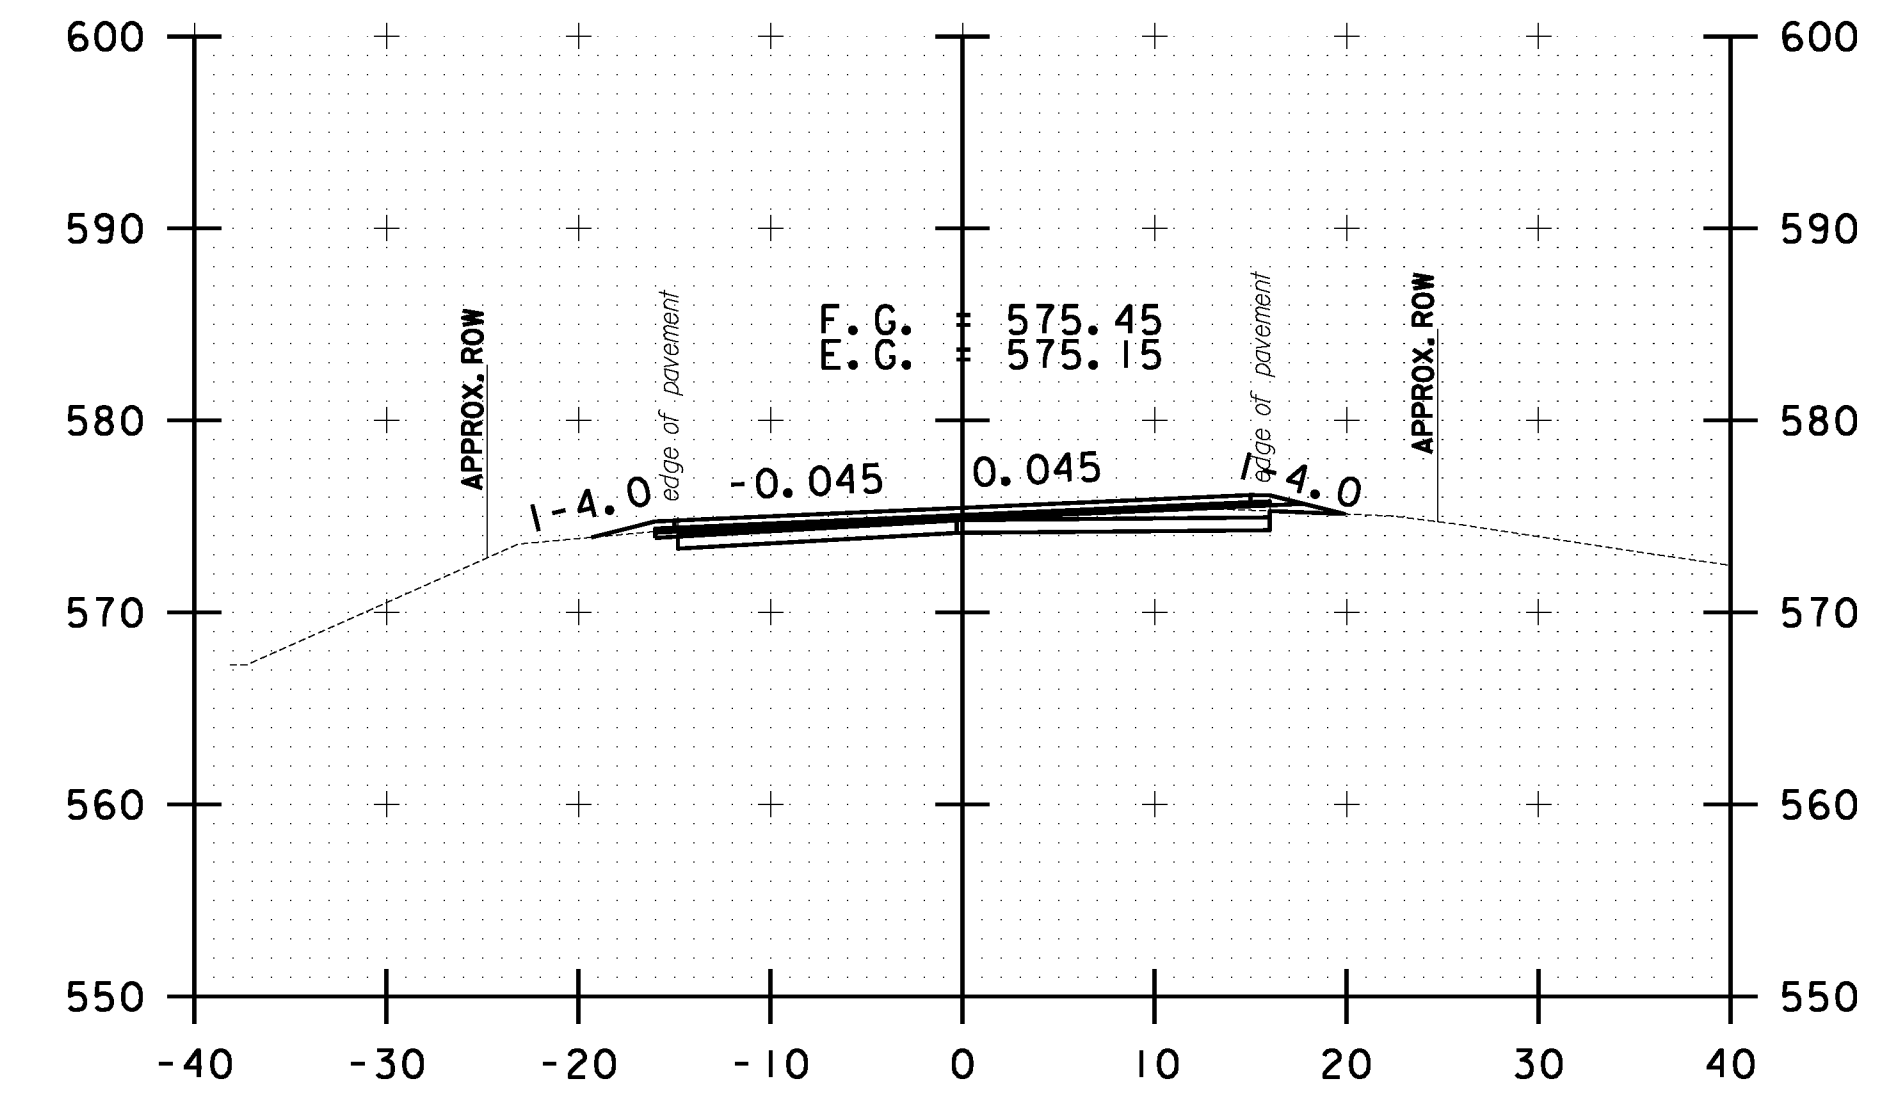


B 16+00.00

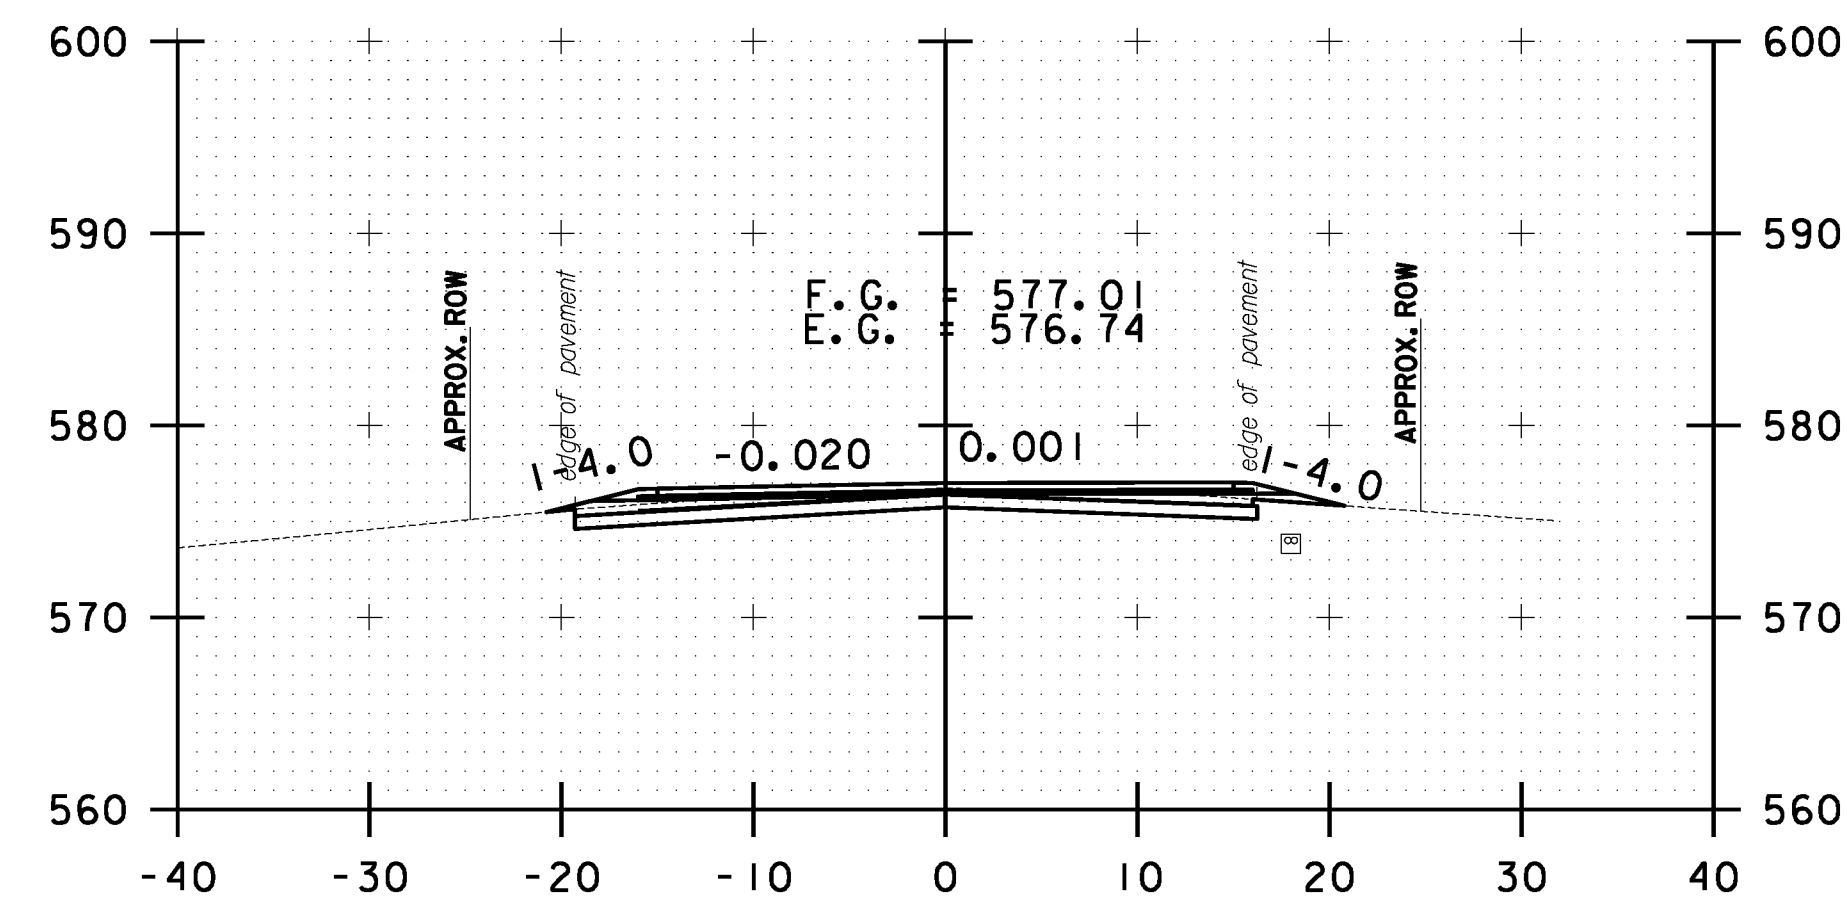


B 13+00.00

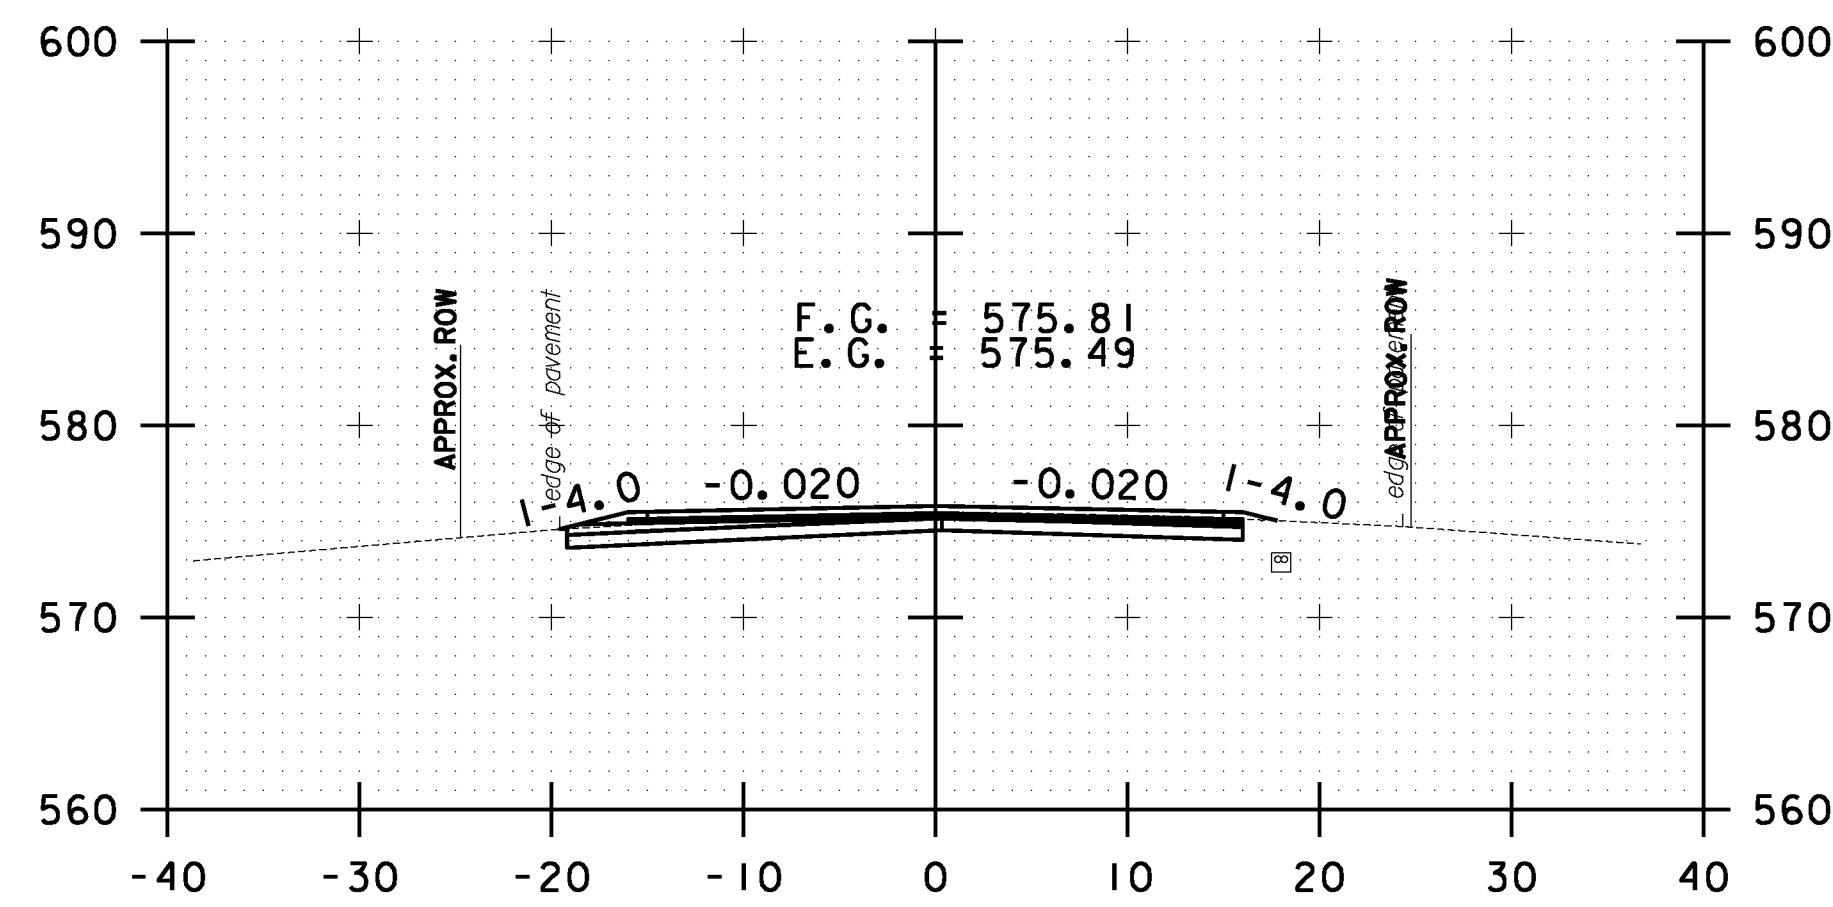


B 14+50.00

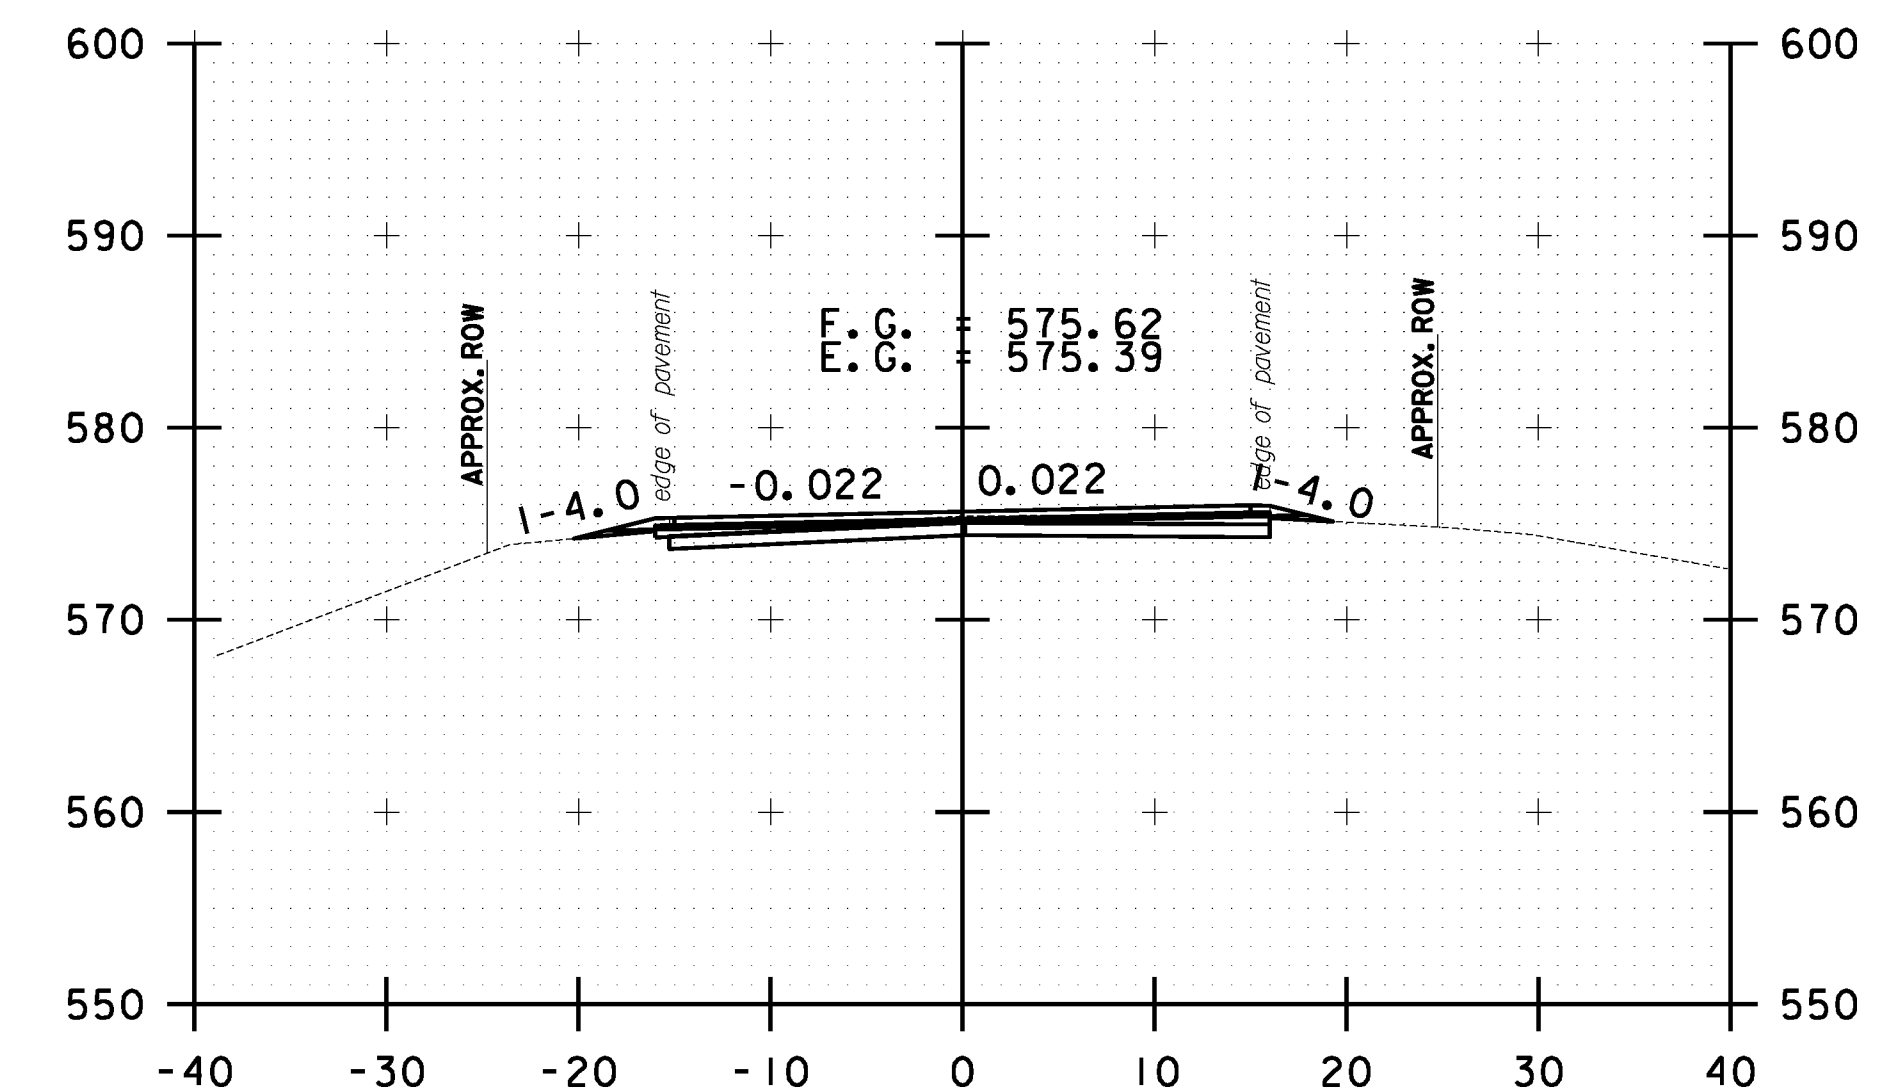


B 15+50.00

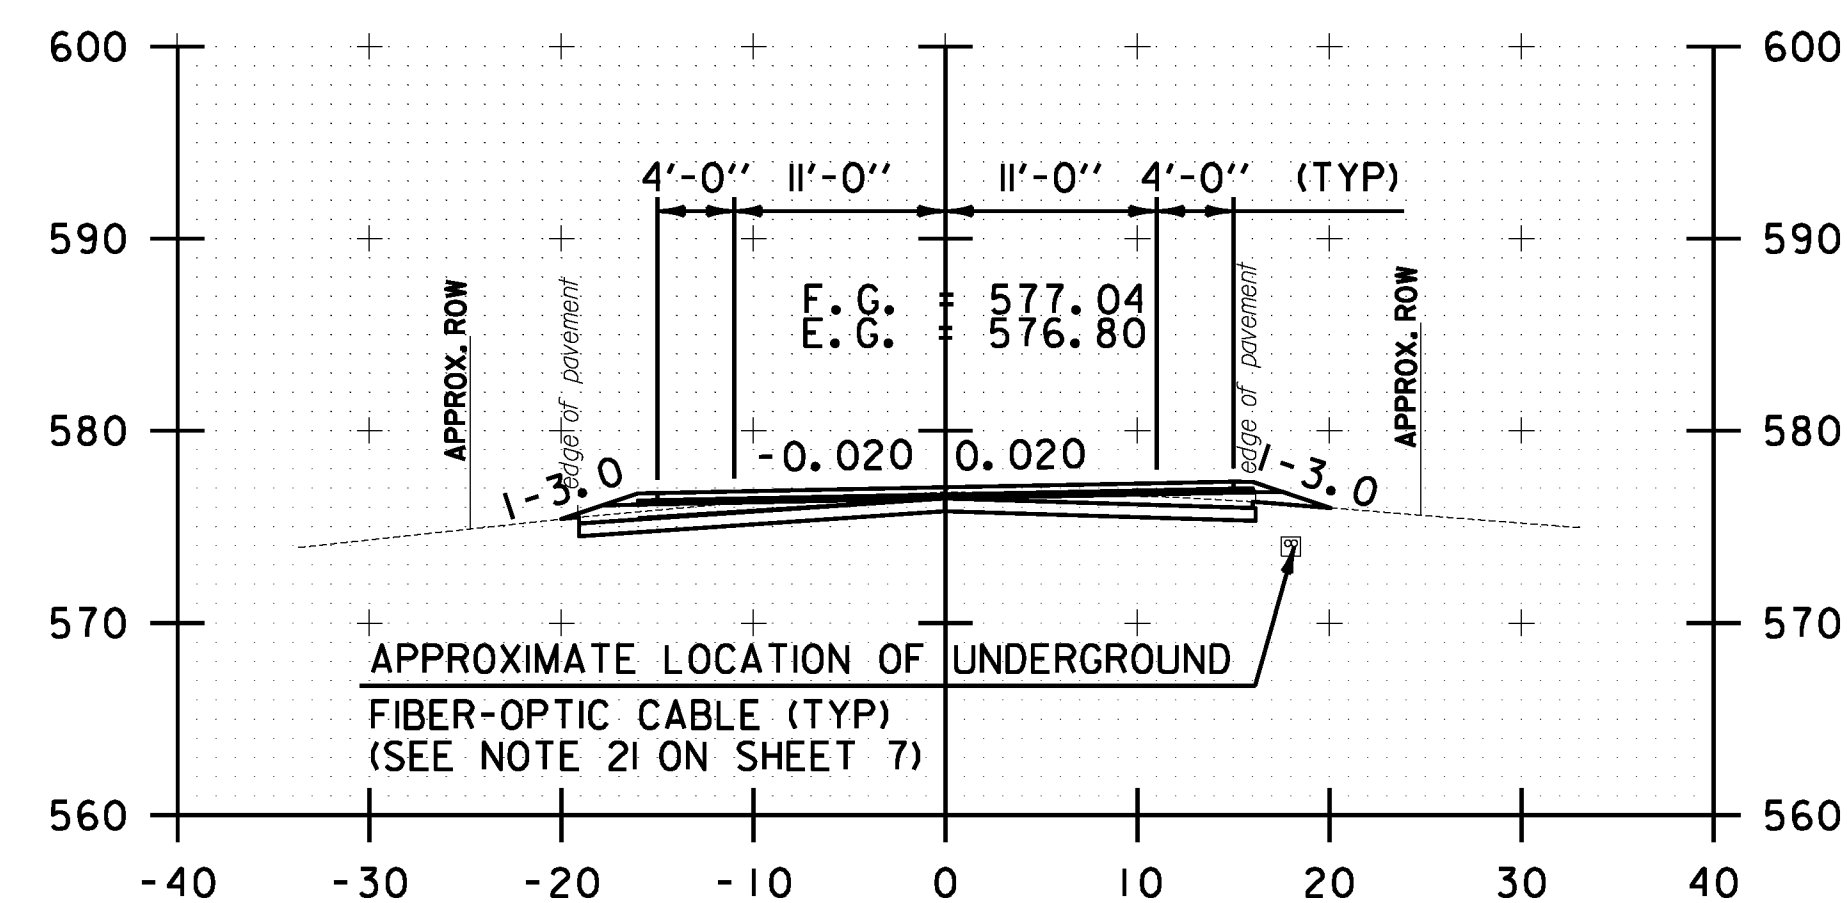

B 12+50.00

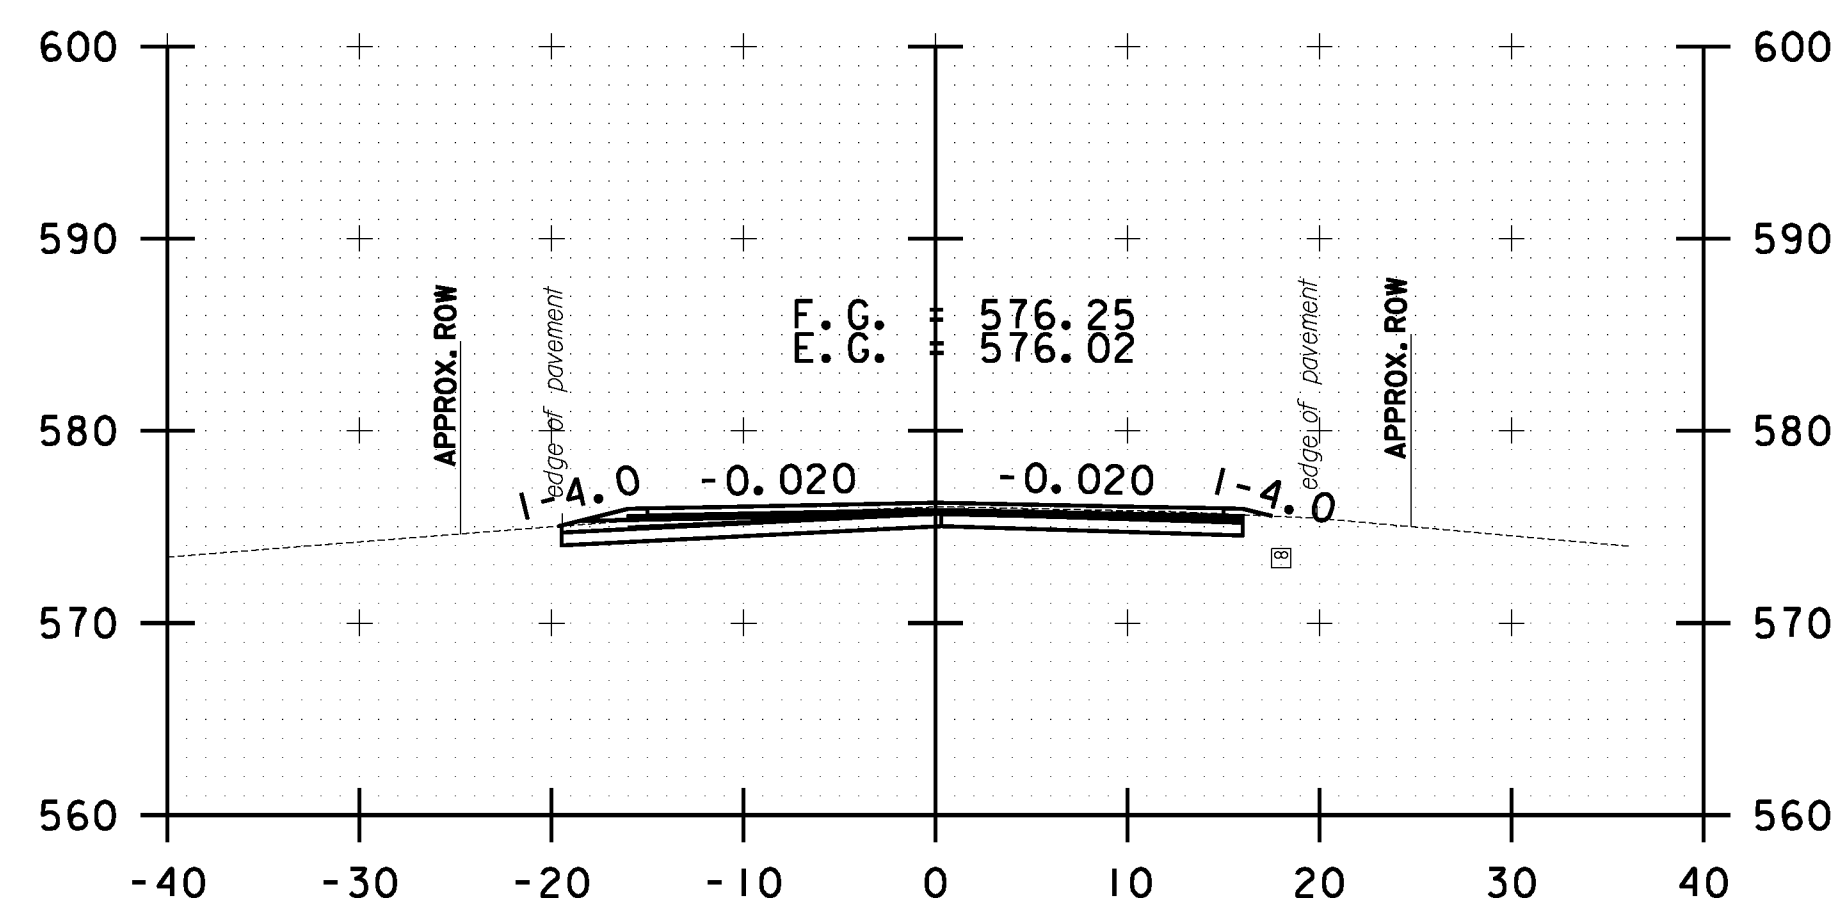

B 14+00.00

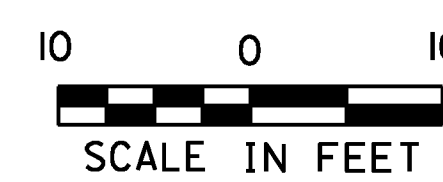

BETHEL CROSS SECTION SHEET #5	PROJECT NAME: STOCKBRIDGE-BETHEL
	PROJECT NUMBER: STP 2910(1)
	FILE NAME: z10b214.bethel.xc.dgn
DESIGNED BY: L.M.B.	PLOT DATE: 3/17/2014
IPARM FILE: z10b214xsl17.1	DRAWN BY: W.G.P.
	CHECKED BY: J.P.S.
	SHEET 330 OF 397