




FILE NAME = Y:\P\c\g\ss\any\k2\22425\CADD\MSTN\10b214.bethel.xc.dgn  
 DATE/TIME = 3/17/2014  
 USER = 4916

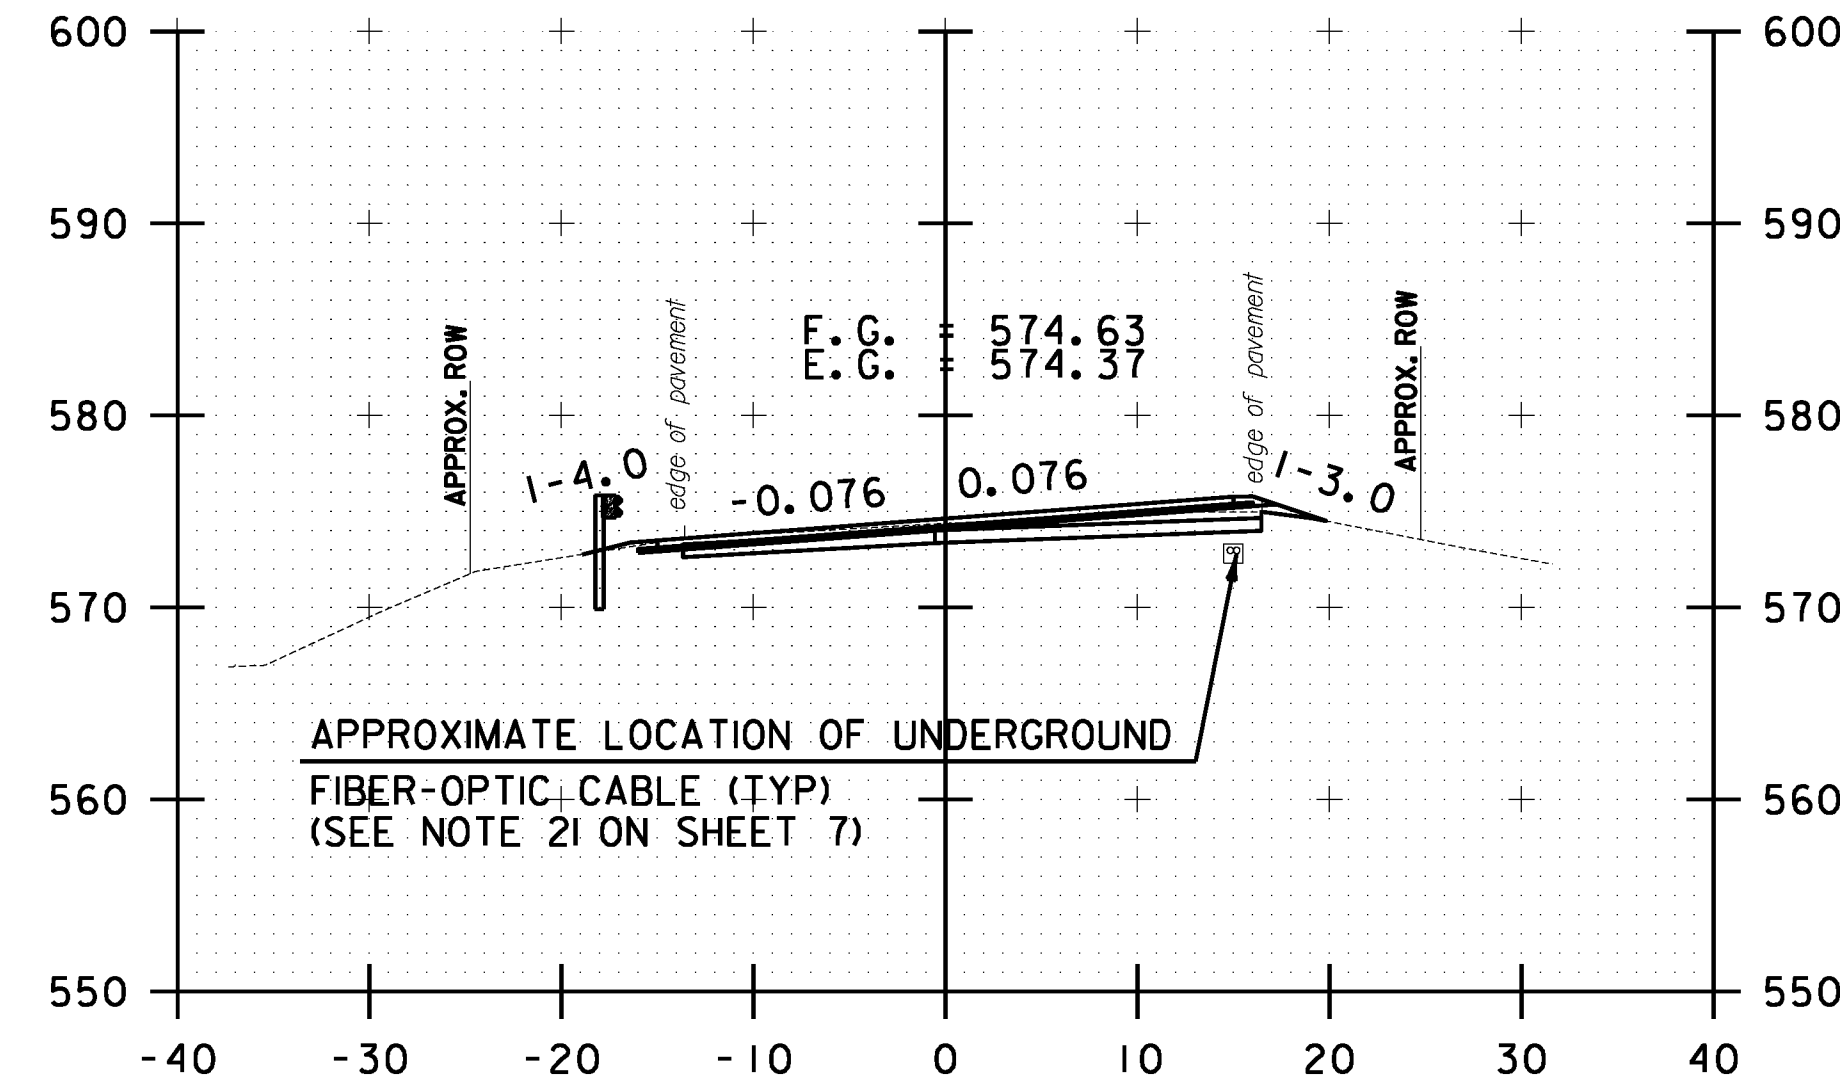


B 17+00.00

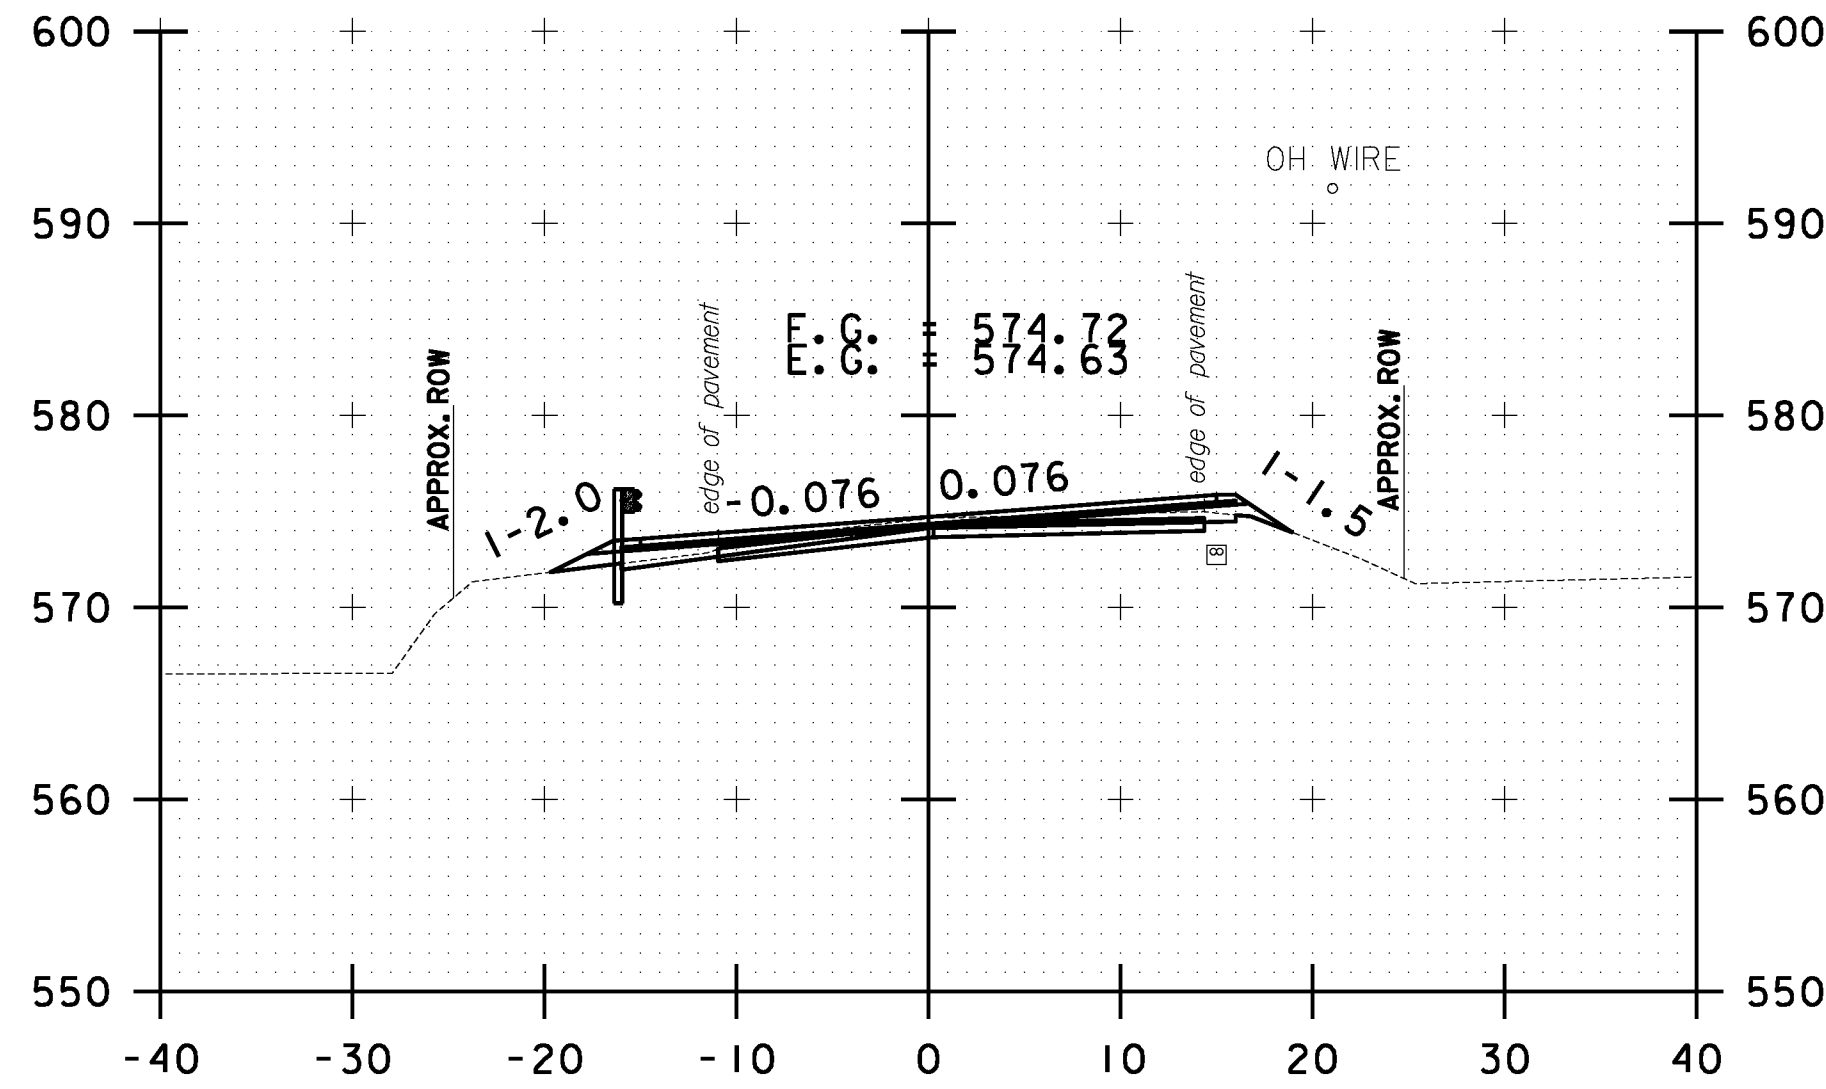


B 18+00.00

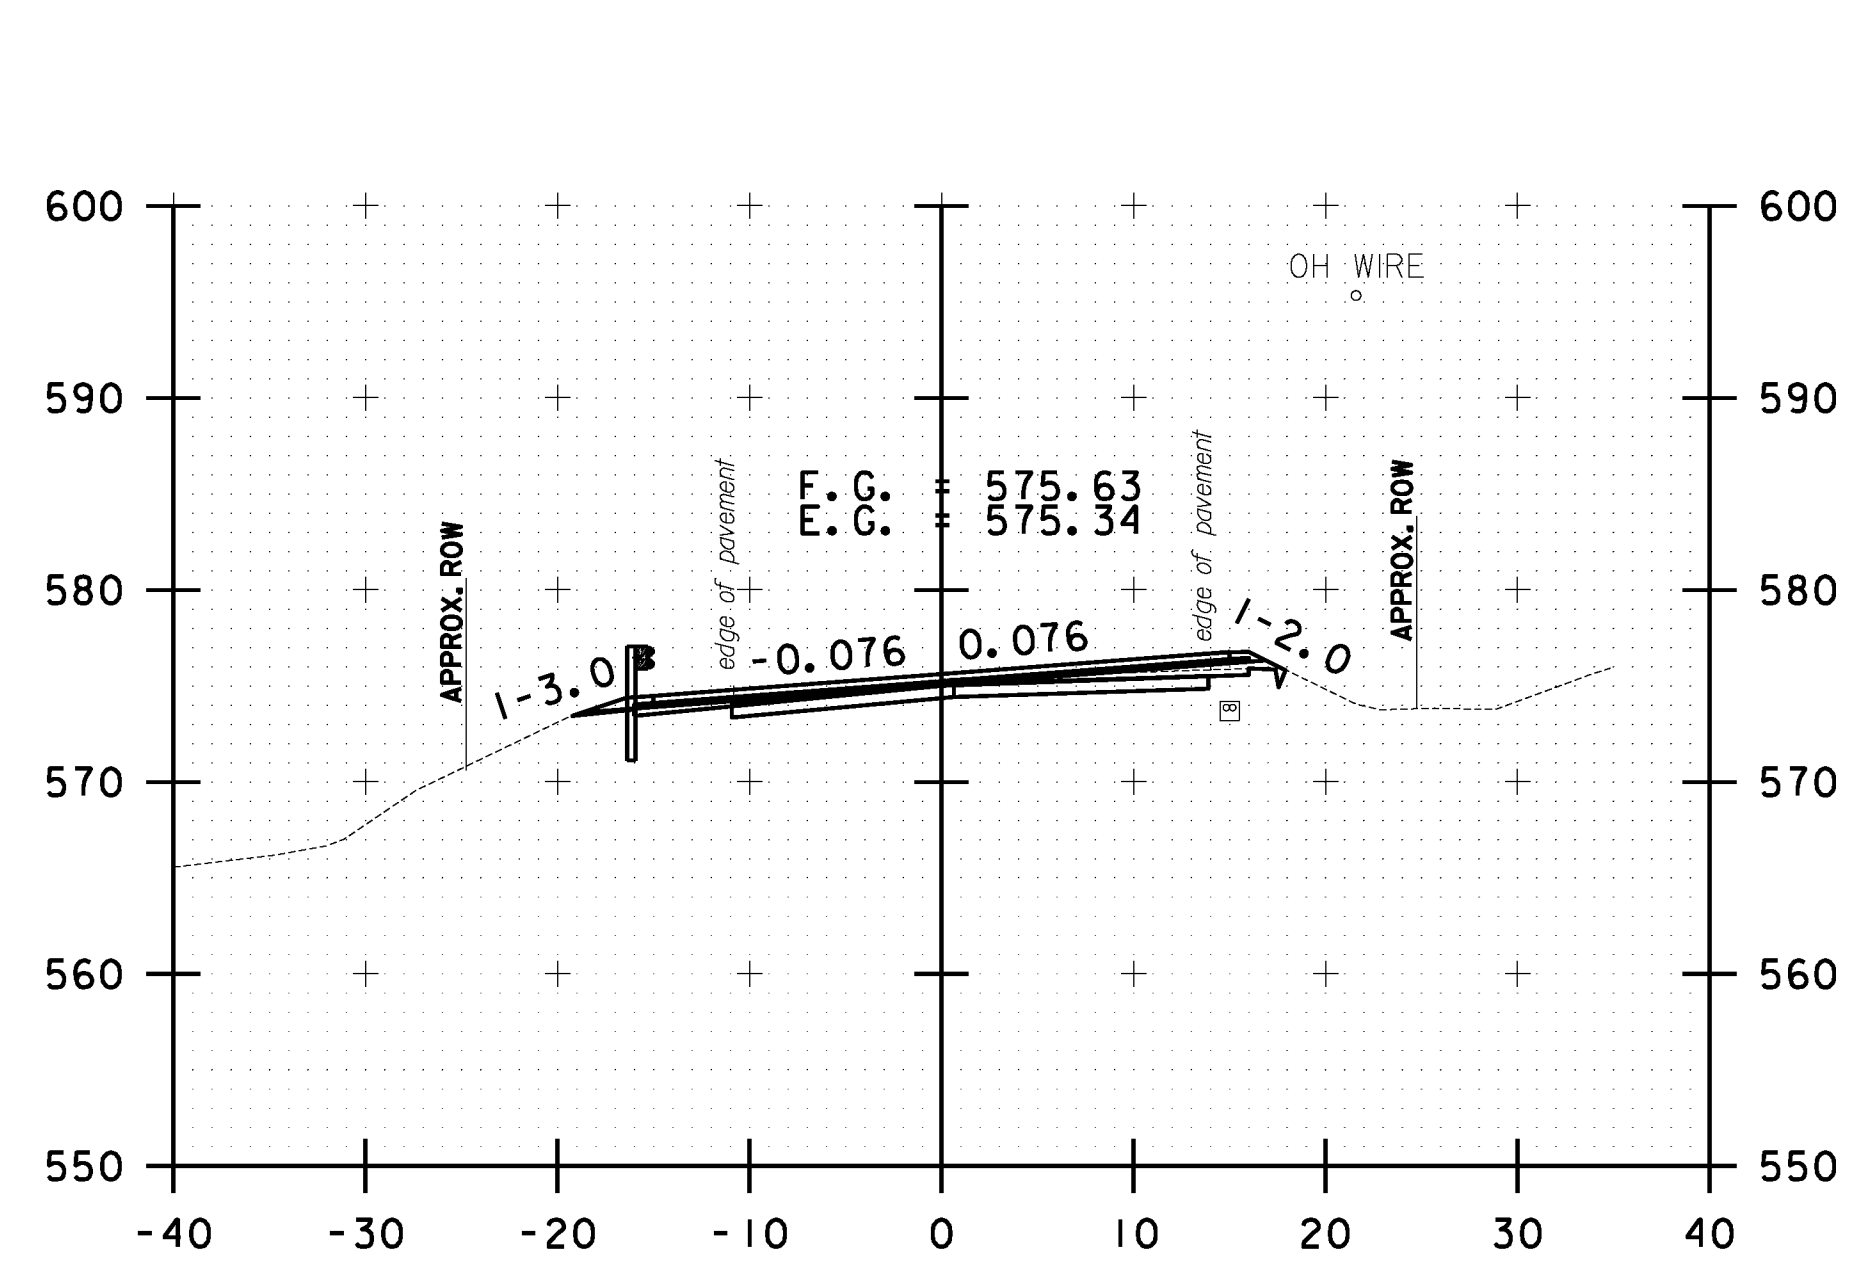


B 18+50.00

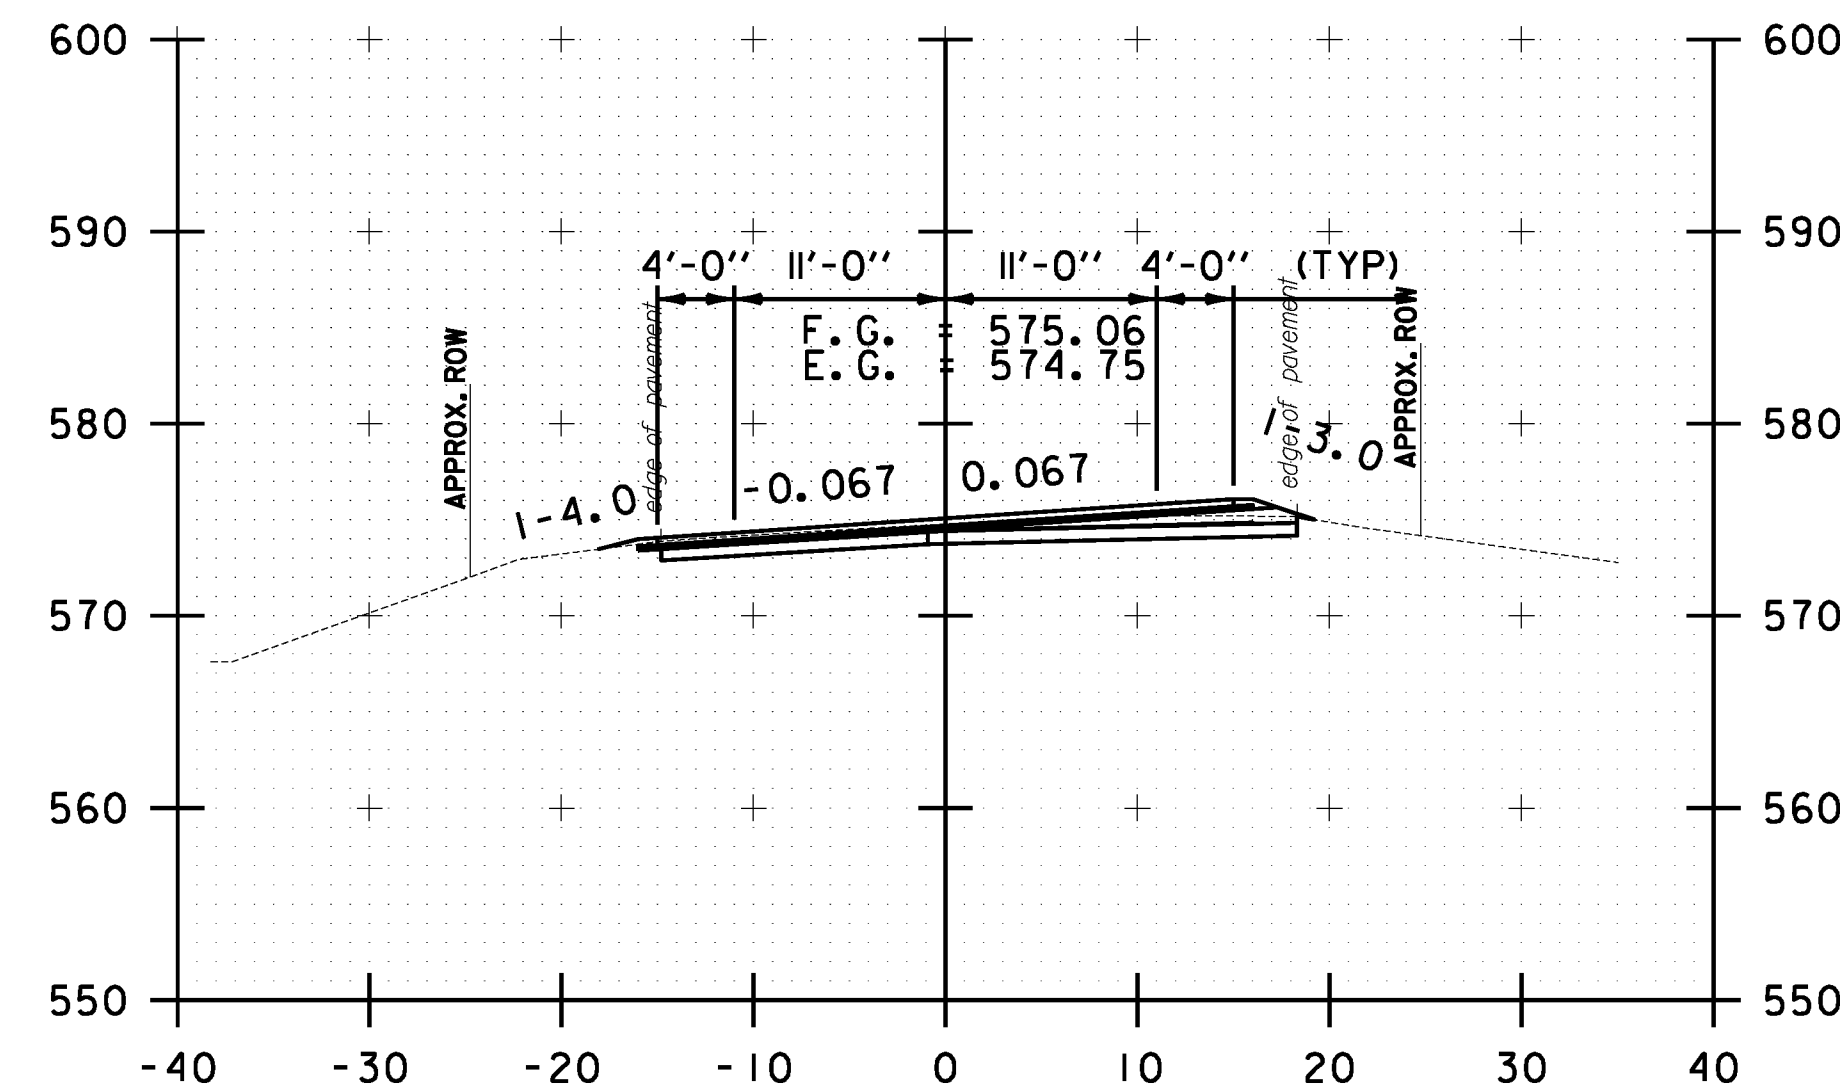


B 16+50.00

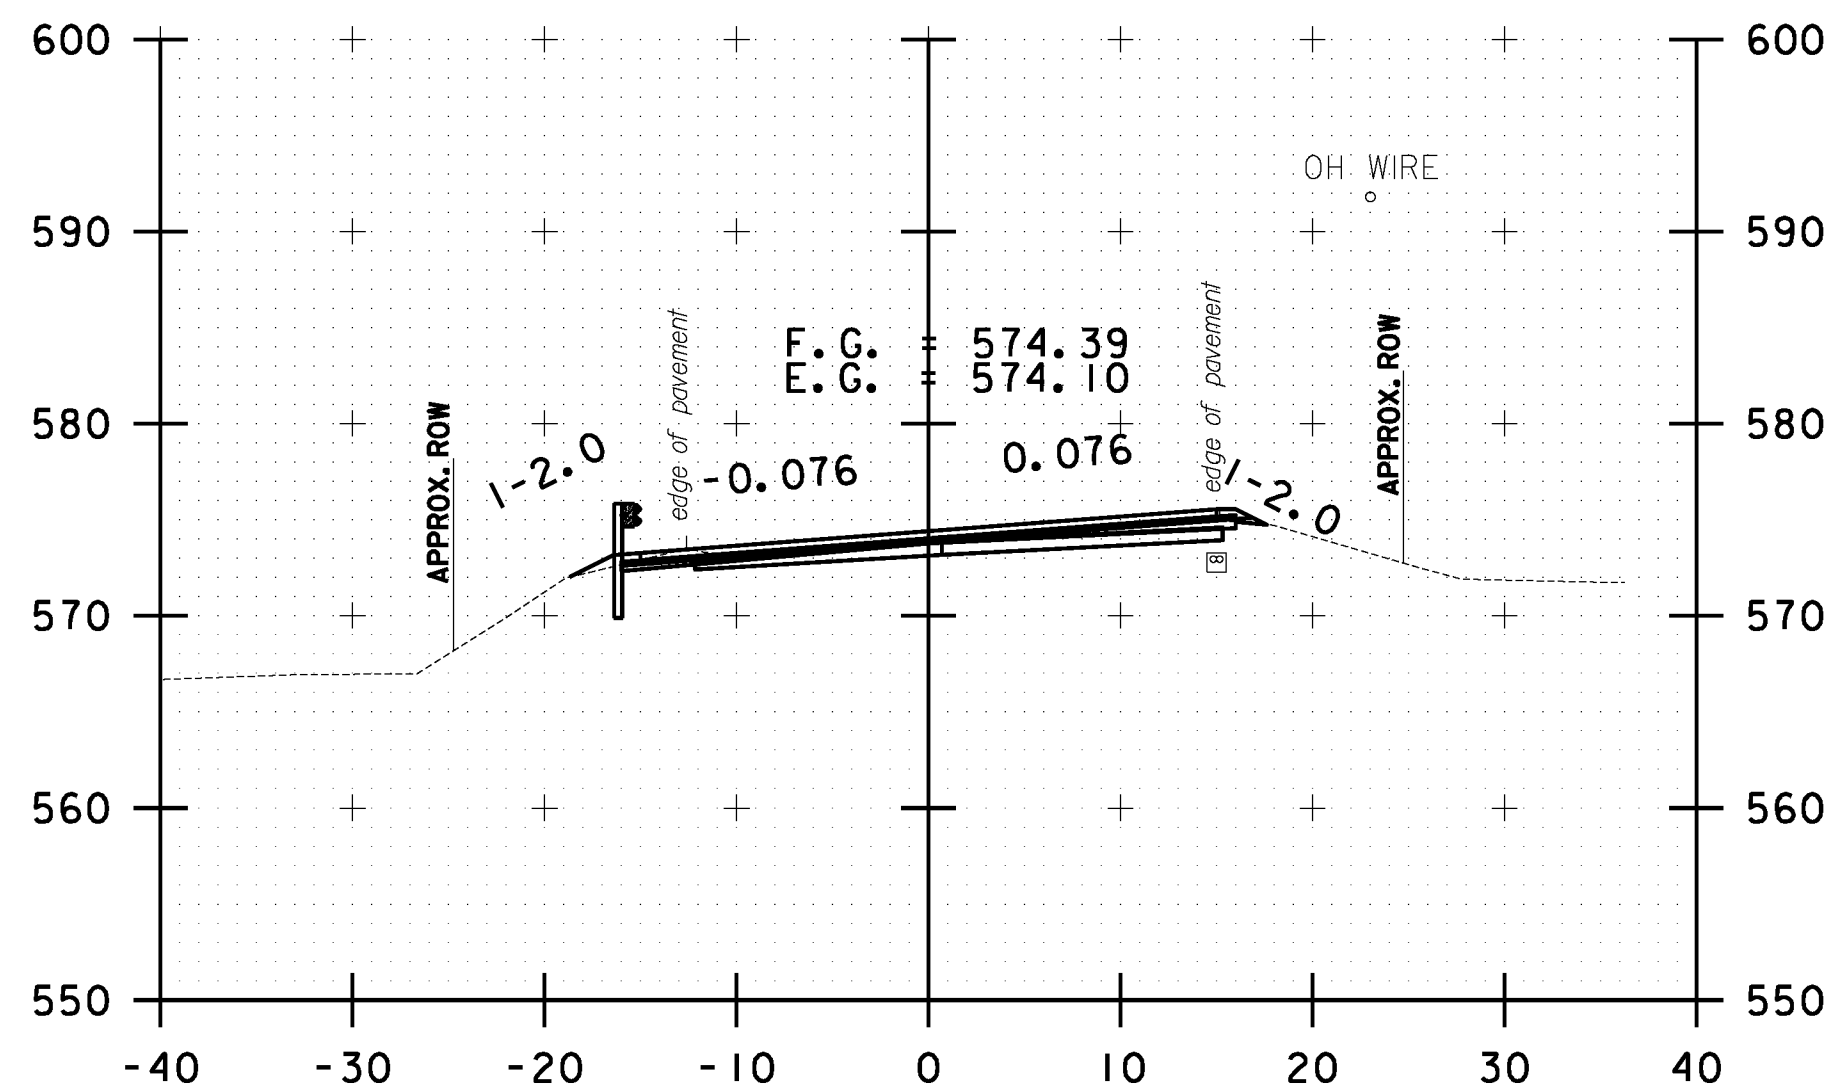

B 17+50.00

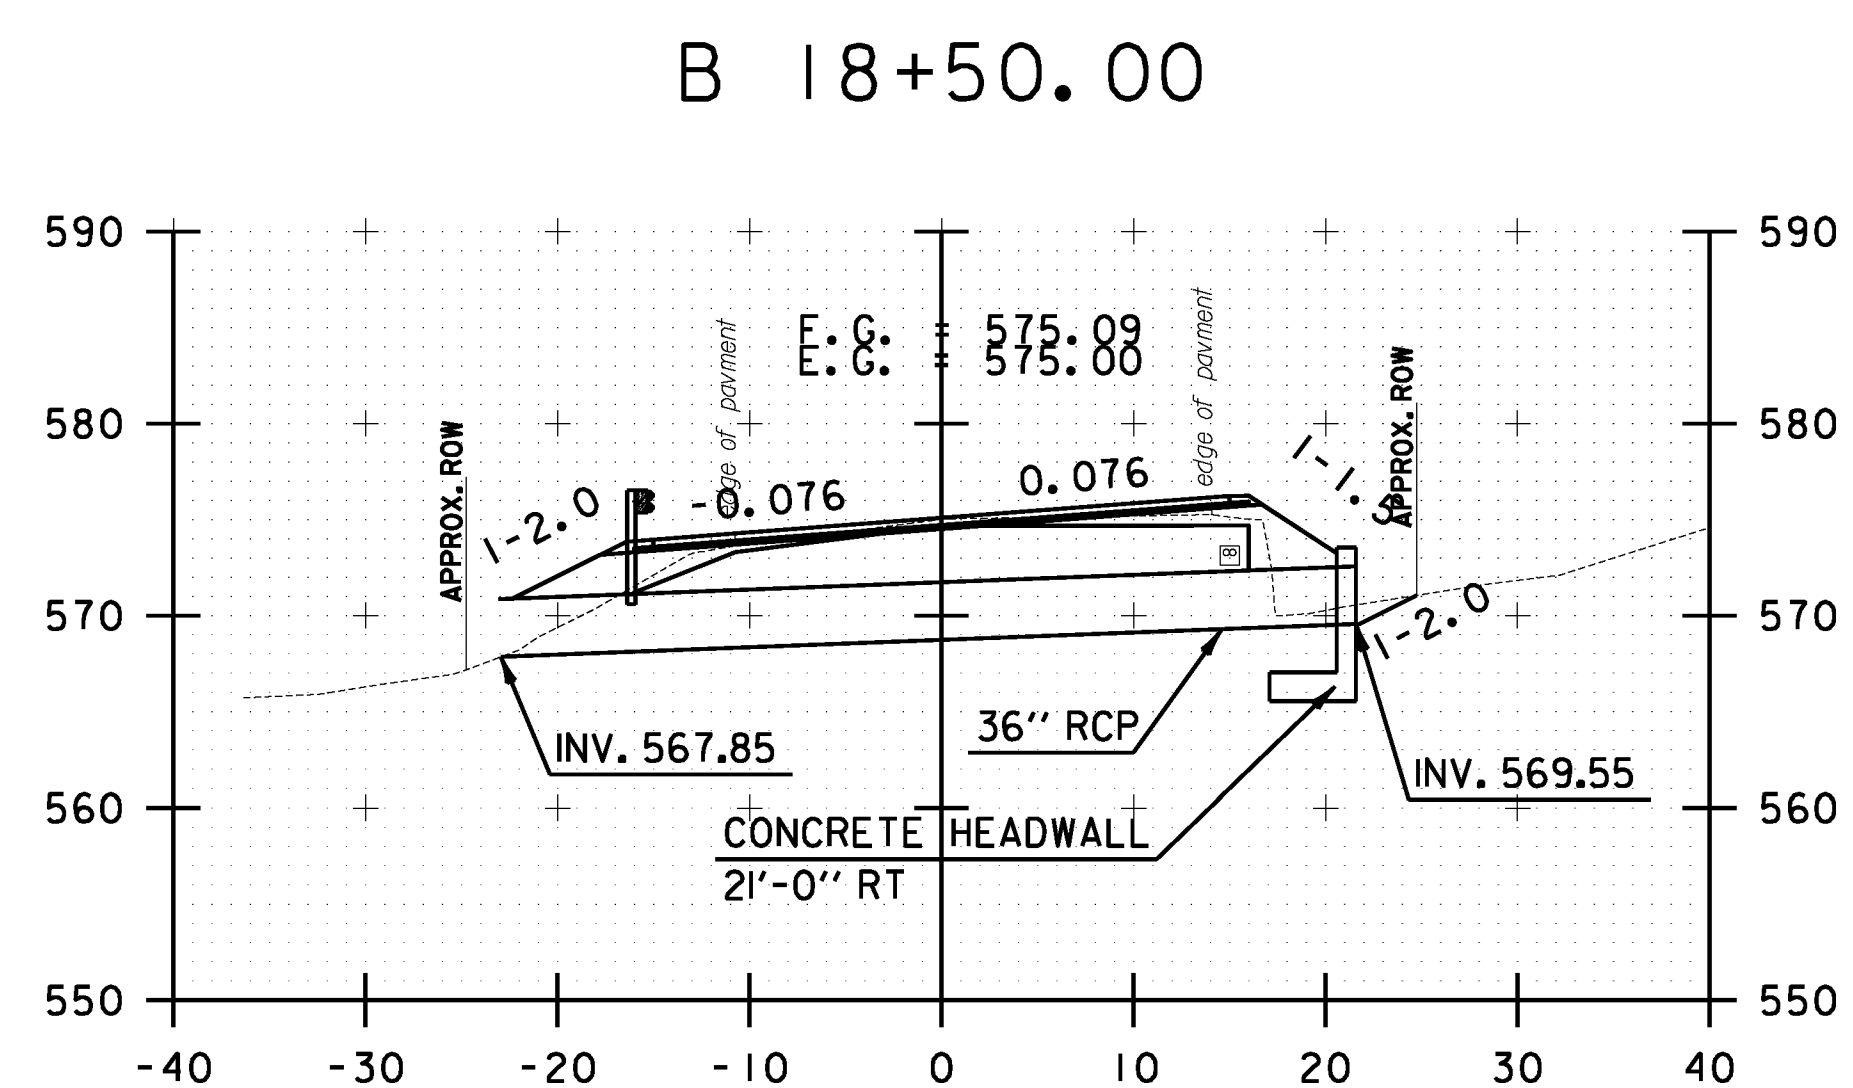

B 18+24.60

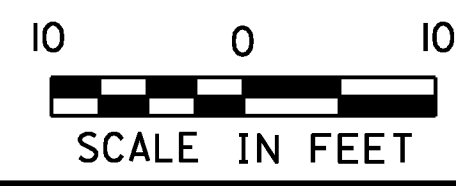

|  |                                  |
|--|----------------------------------|
| <b>BETHEL<br/>CROSS SECTION<br/>SHEET #6</b> | PROJECT NAME: STOCKBRIDGE-BETHEL |
|  | PROJECT NUMBER: STP 2910(I)      |
|  | FILE NAME: z10b214.bethel.xc.dgn |
|  | IPARM FILE: z10b214xsl18.1       |
|  | PLOT DATE: 3/17/2014             |
|  | DRAWN BY: W.G.P.                 |
|  | CHECKED BY: J.P.S.               |
|  | SHEET 331 OF 397                 |