




FILE NAME = Y:\P\c\g\sc\any\k2\22425\CADD\MSTN\10b214.bethel.xc.dgn
 DATE/TIME = 3/17/2014
 USER = 4916

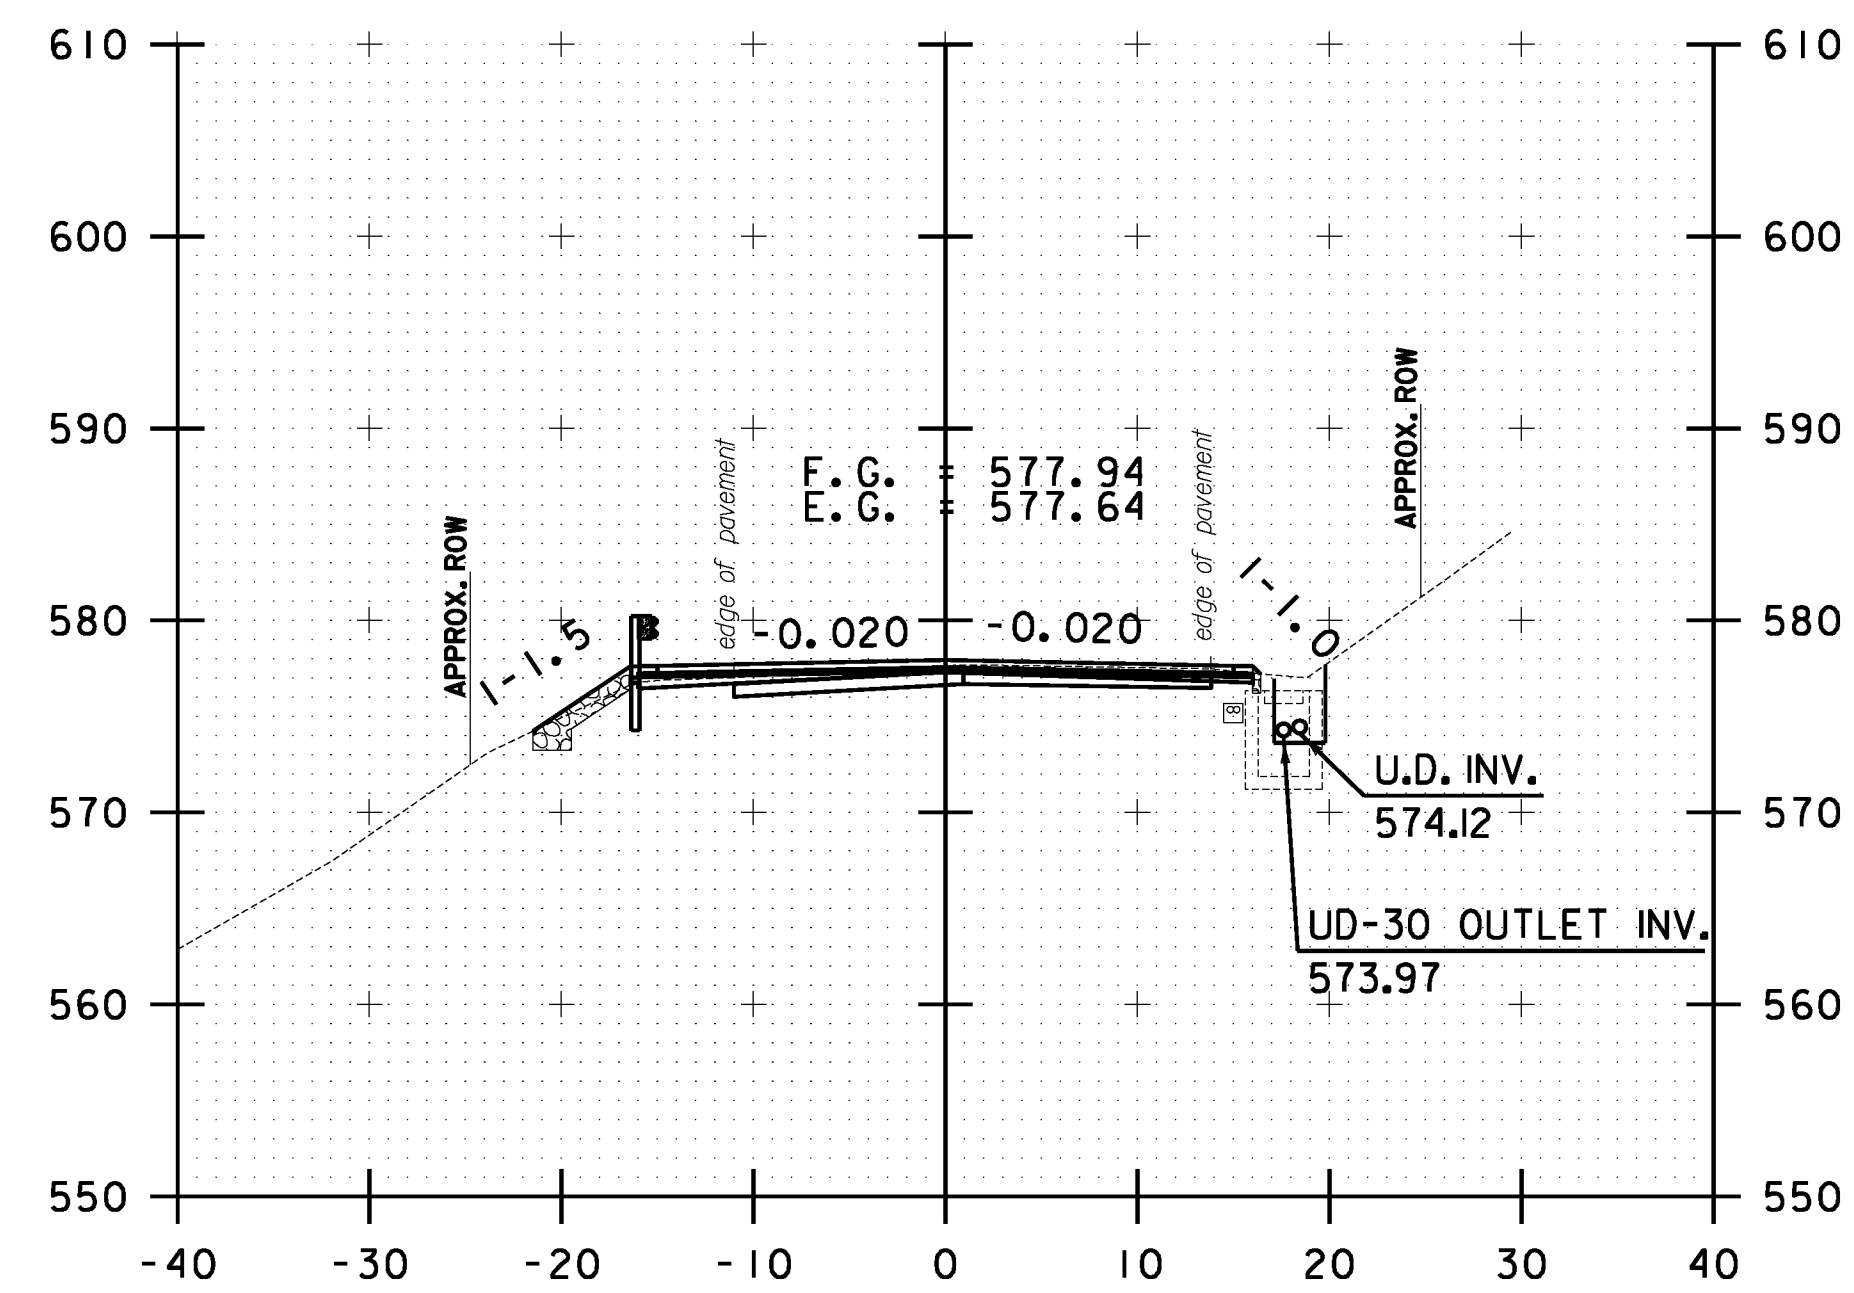


B 22+50.00

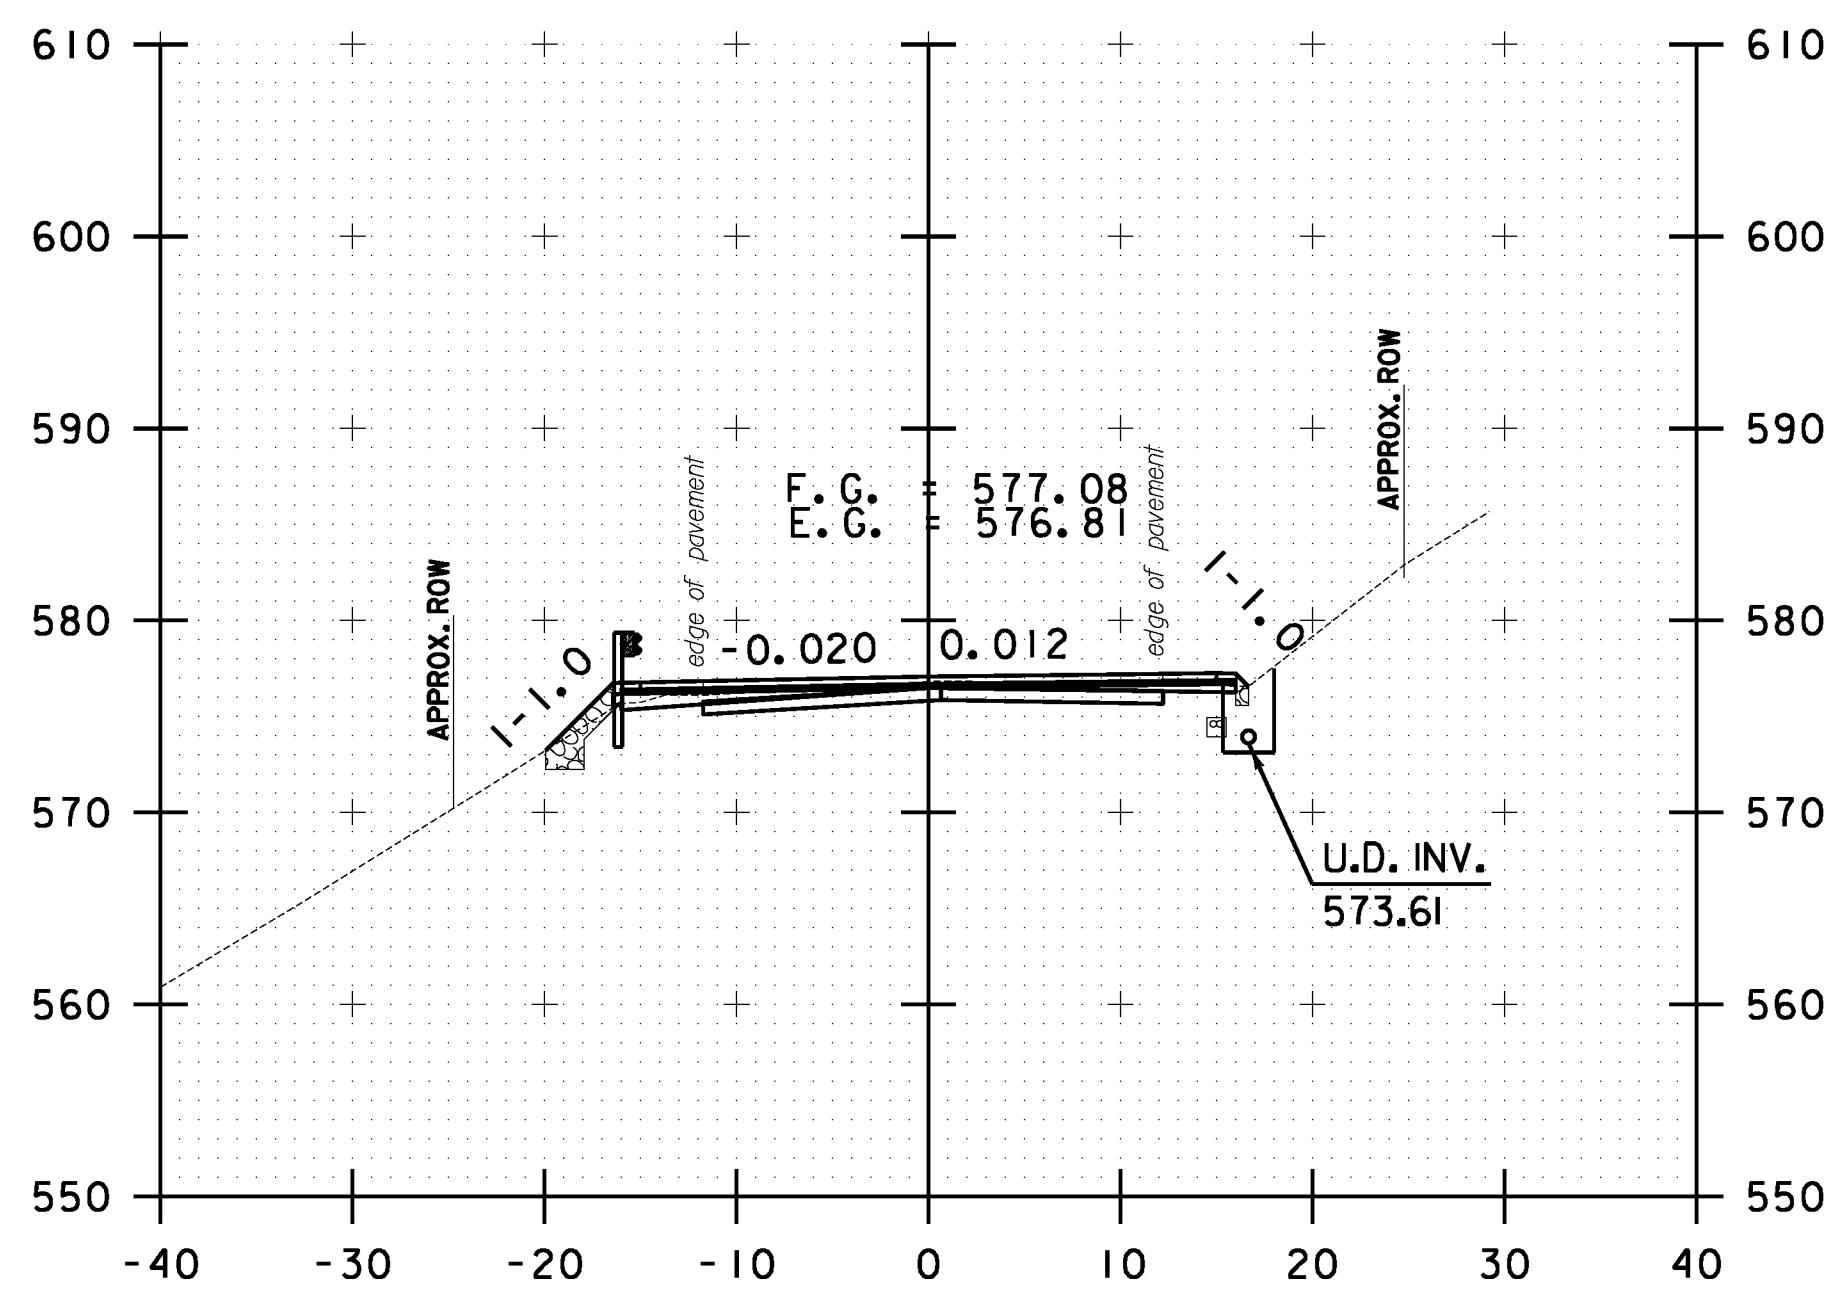


B 23+50.00

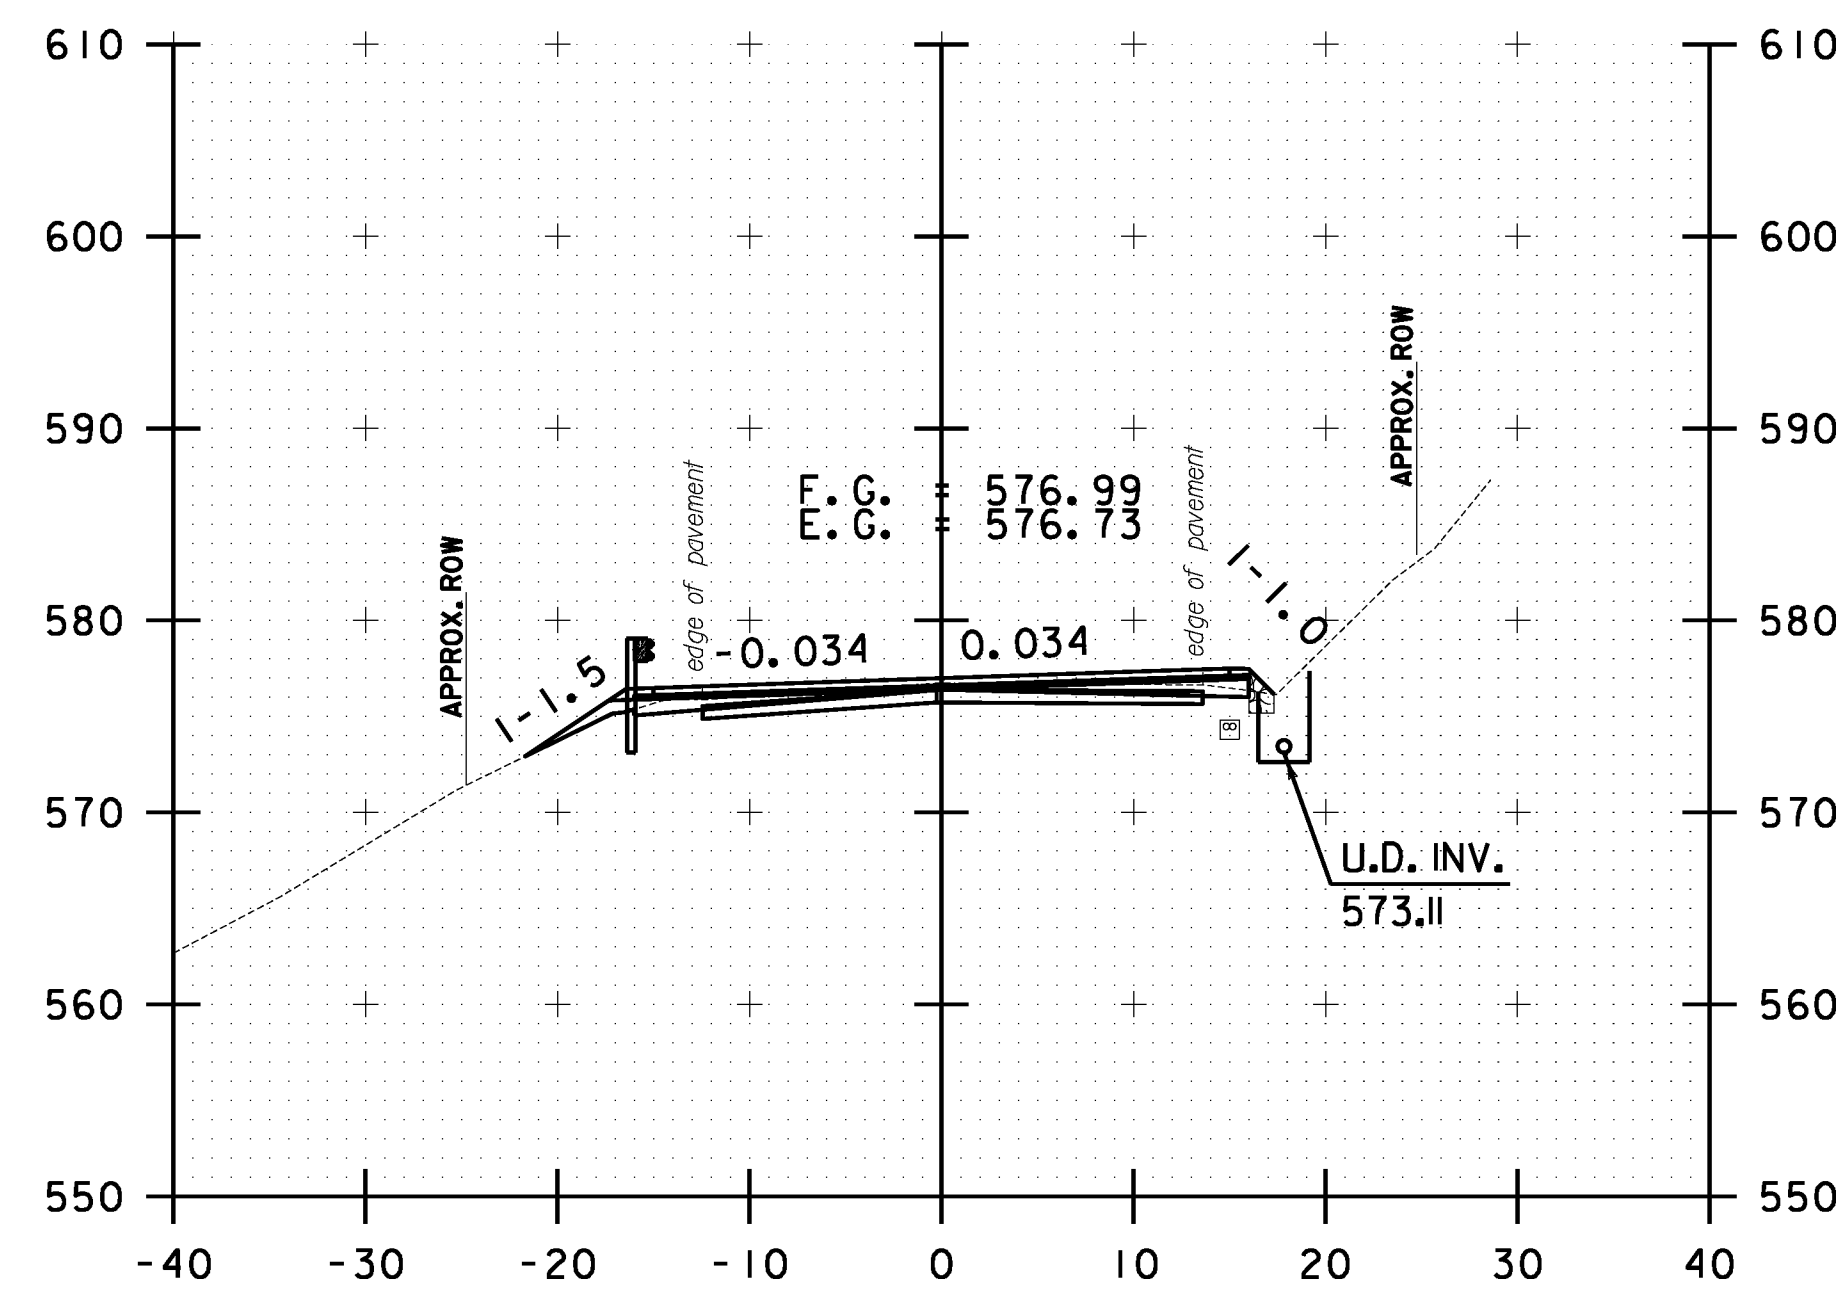


B 24+50.00

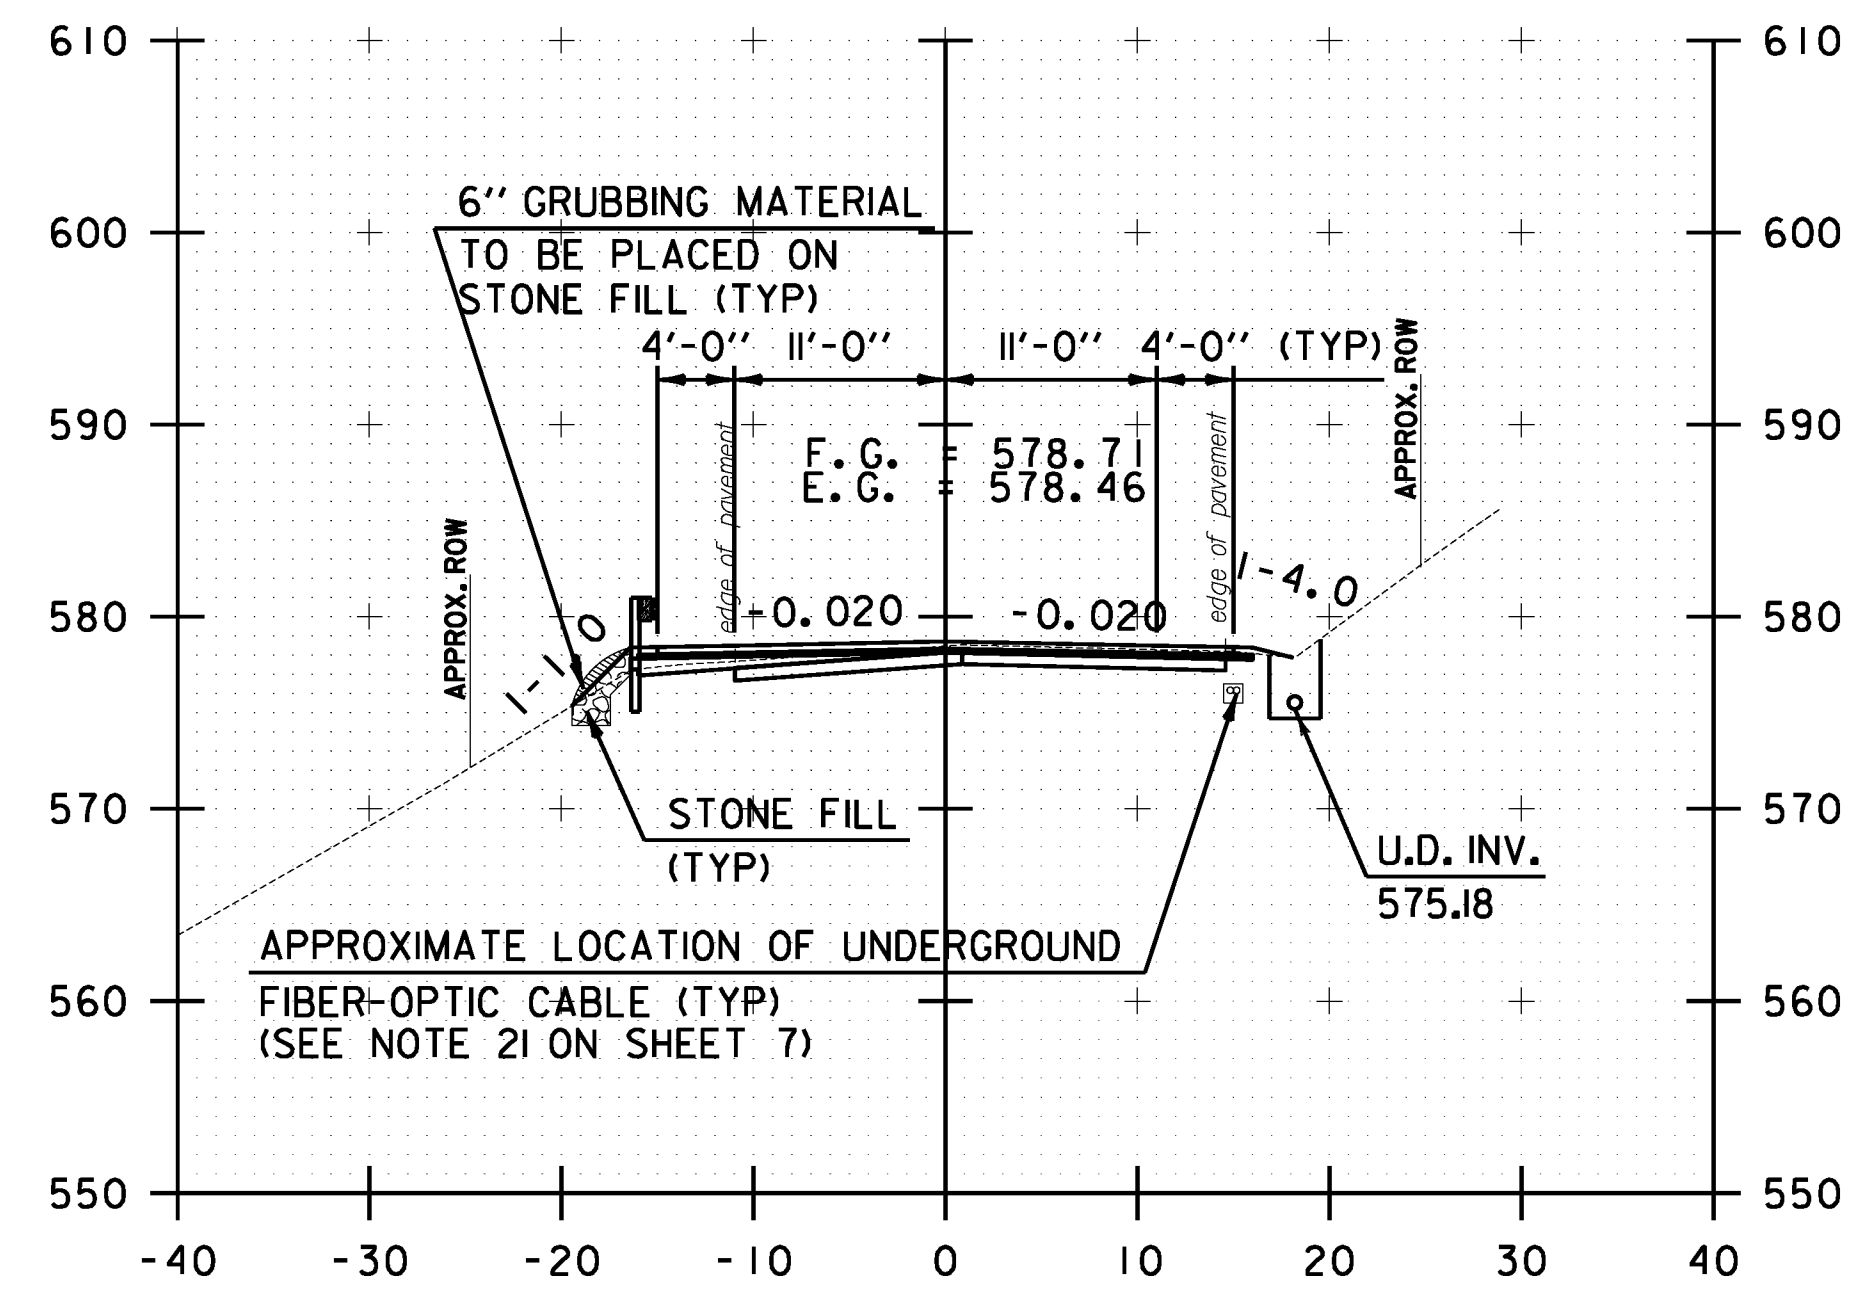


B 22+00.00

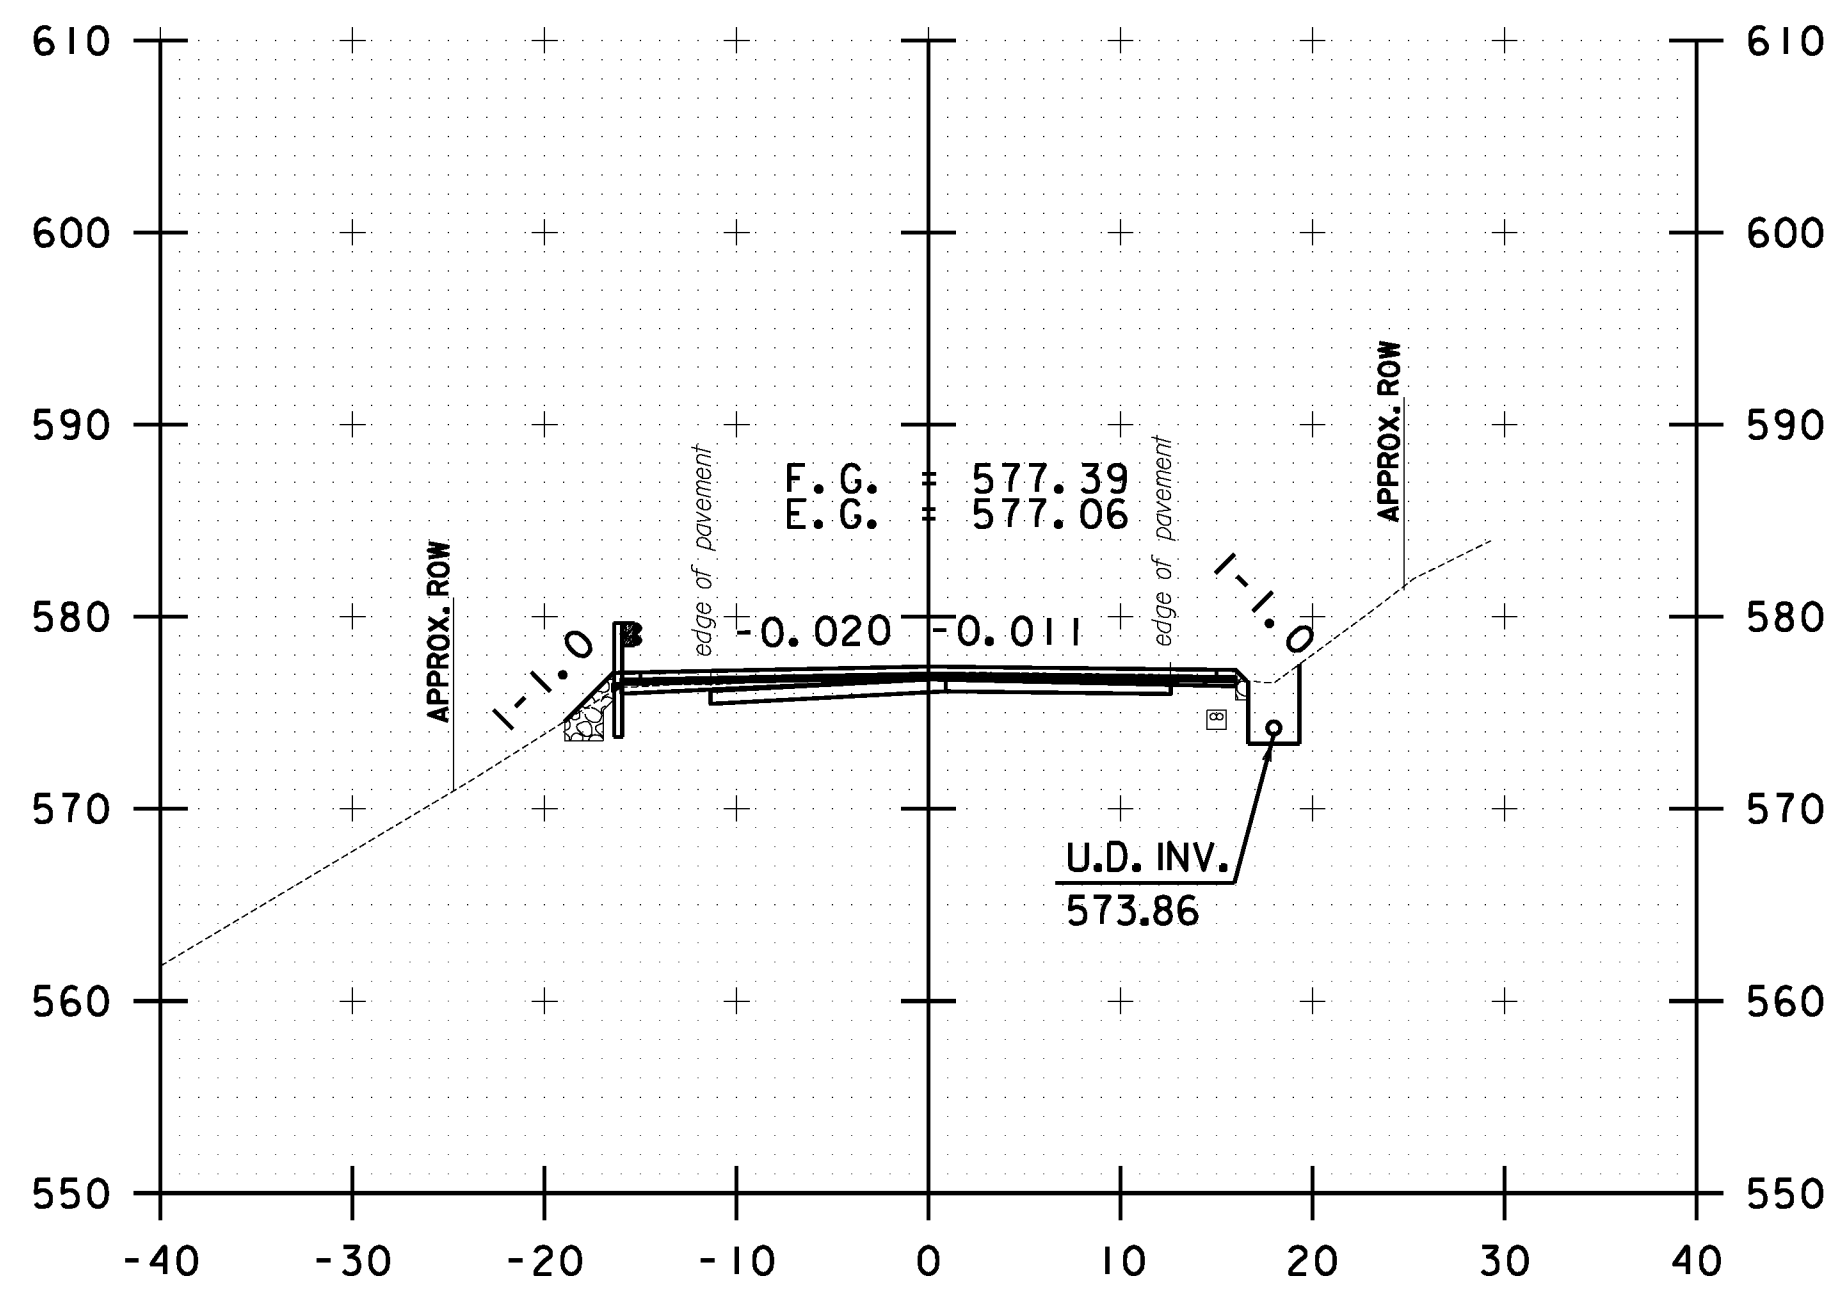

B 23+00.00

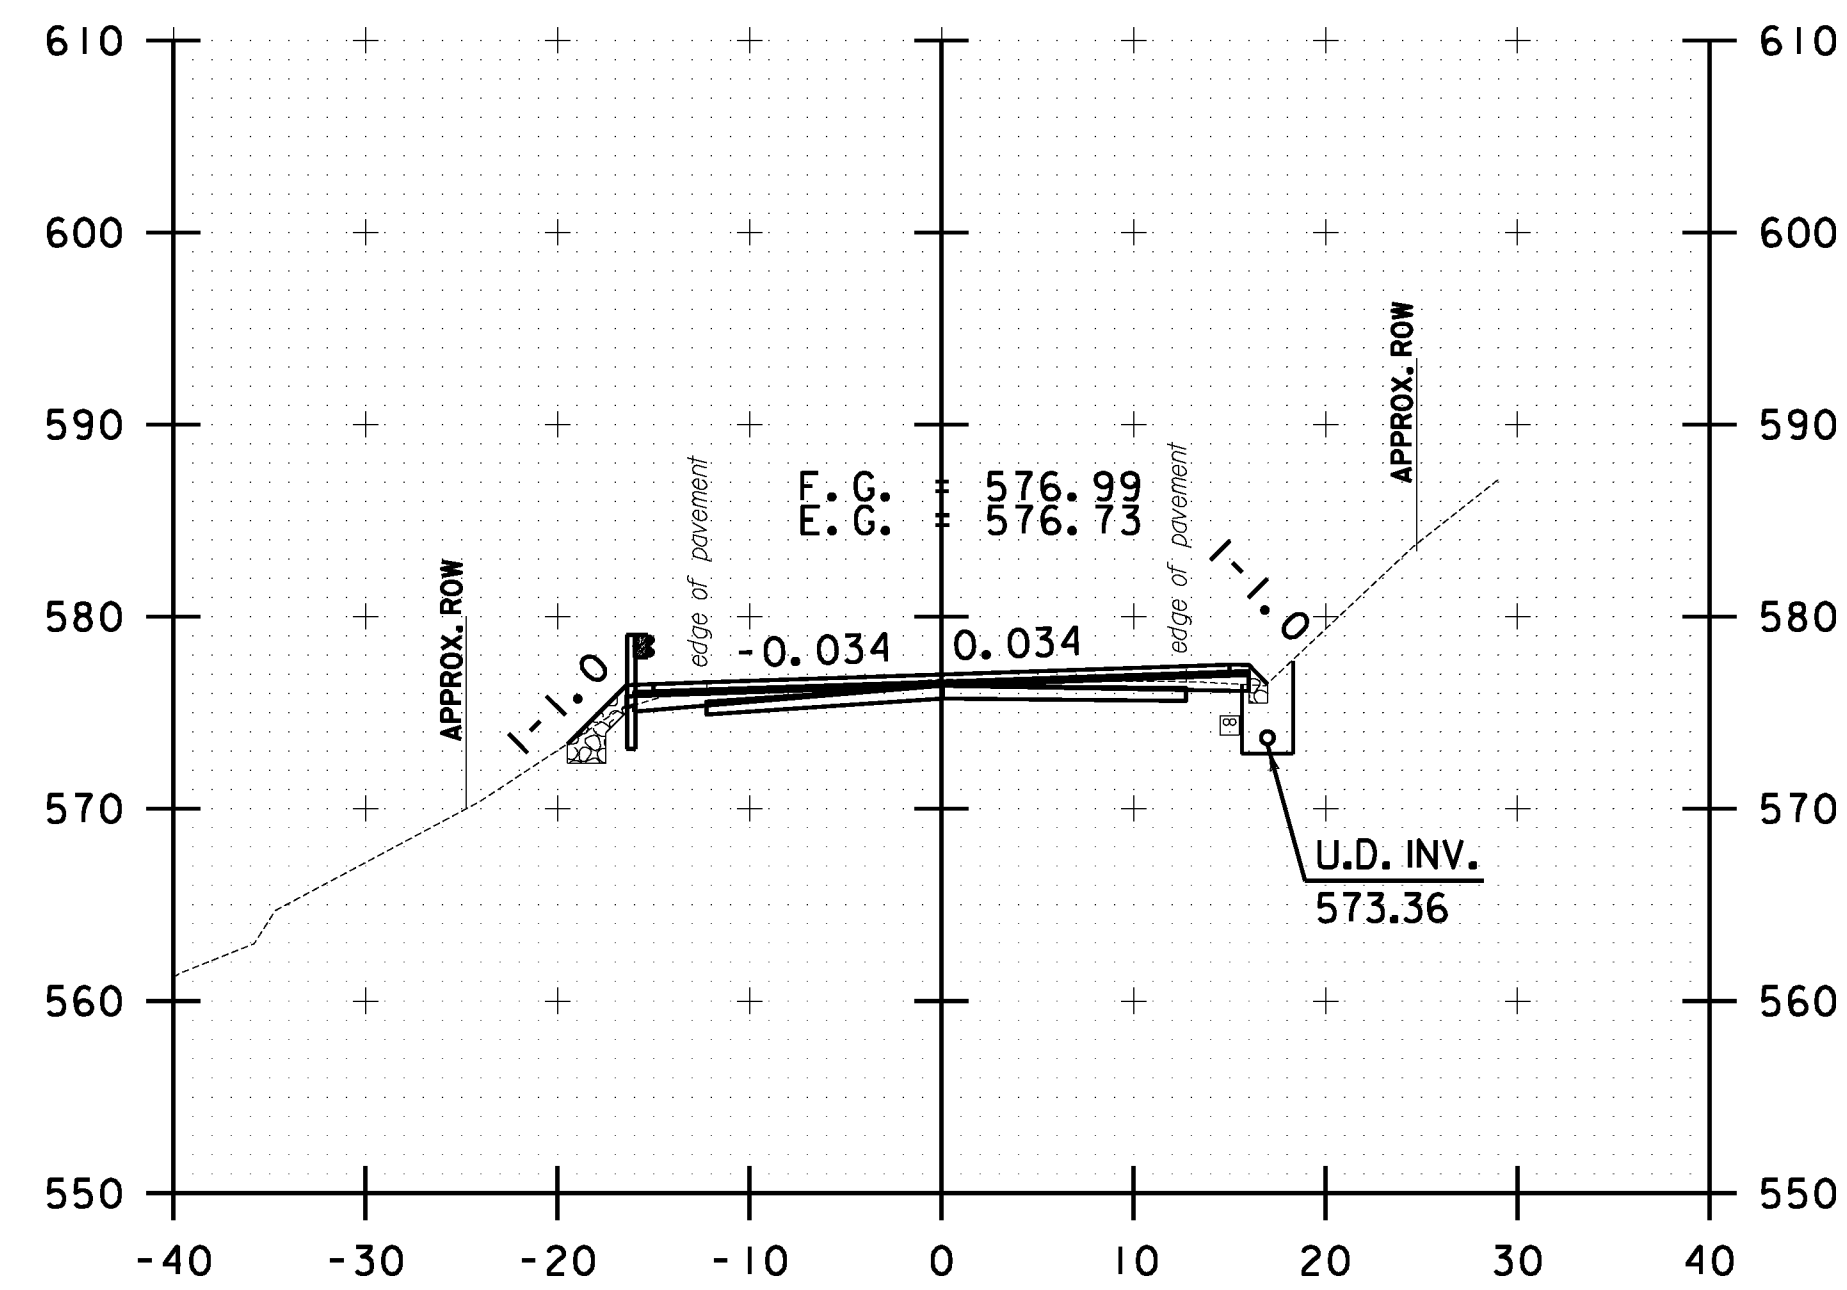

B 24+00.00

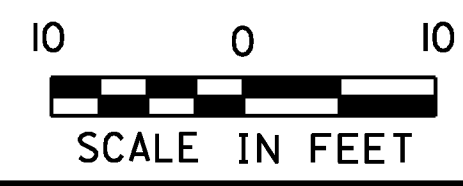

BETHEL CROSS SECTION SHEET #8	PROJECT NAME: STOCKBRIDGE-BETHEL
	PROJECT NUMBER: STP 2910(1)
	FILE NAME: z10b214.bethel.xc.dgn
	IPARM FILE: z10b214xs120.1
	PLOT DATE: 3/17/2014
	DRAWN BY: W.G.P.
	CHECKED BY: J.P.S.
	SHEET 333 OF 397