




FILE NAME = Y:\P\c\g\ss\ANY\K2\22425\CADD\MSTN\10b214.bethel.xc.dgn  
 DATE/TIME = 3/17/2014  
 USER = 4916

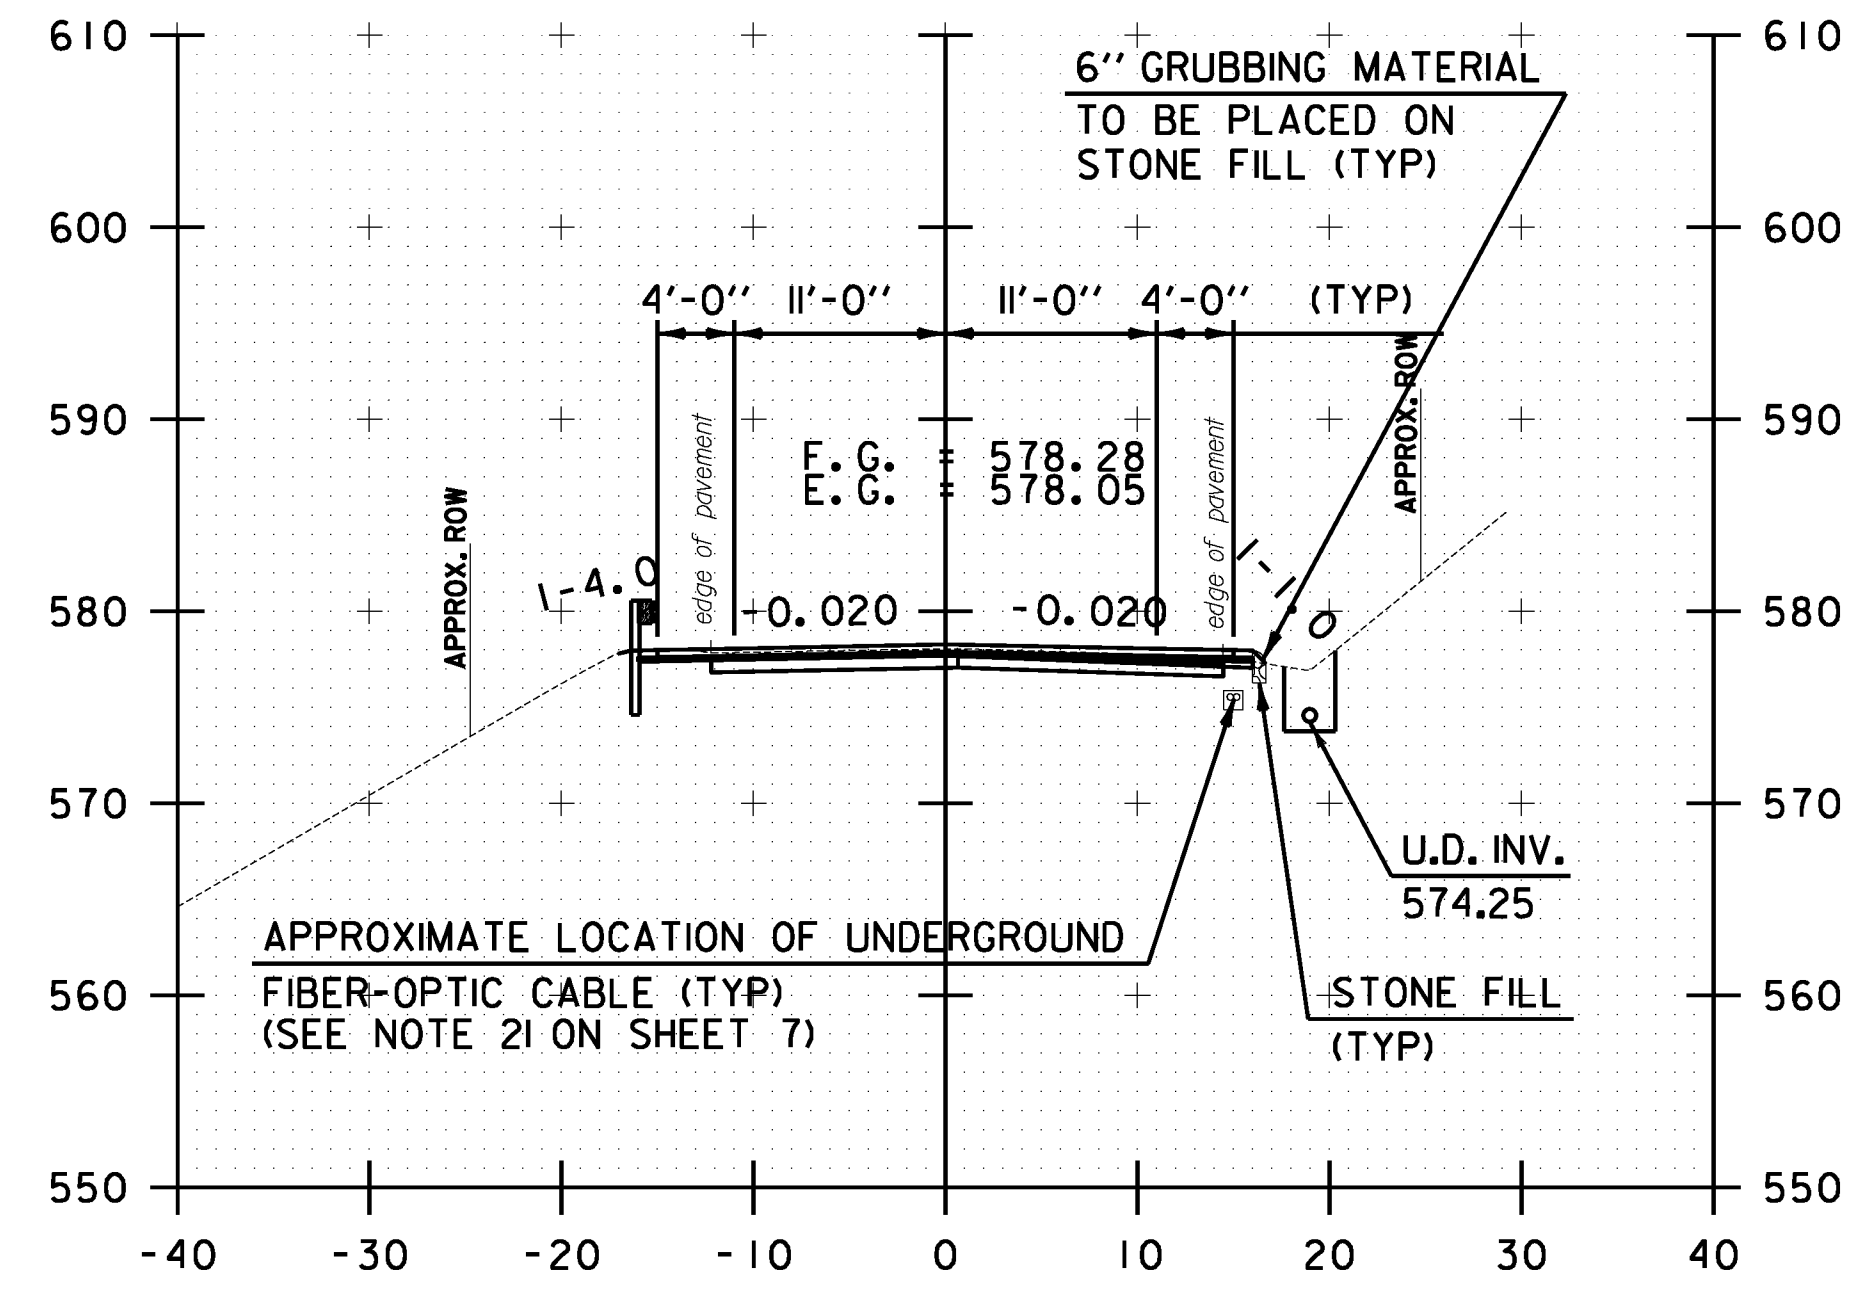


B 28+00.00

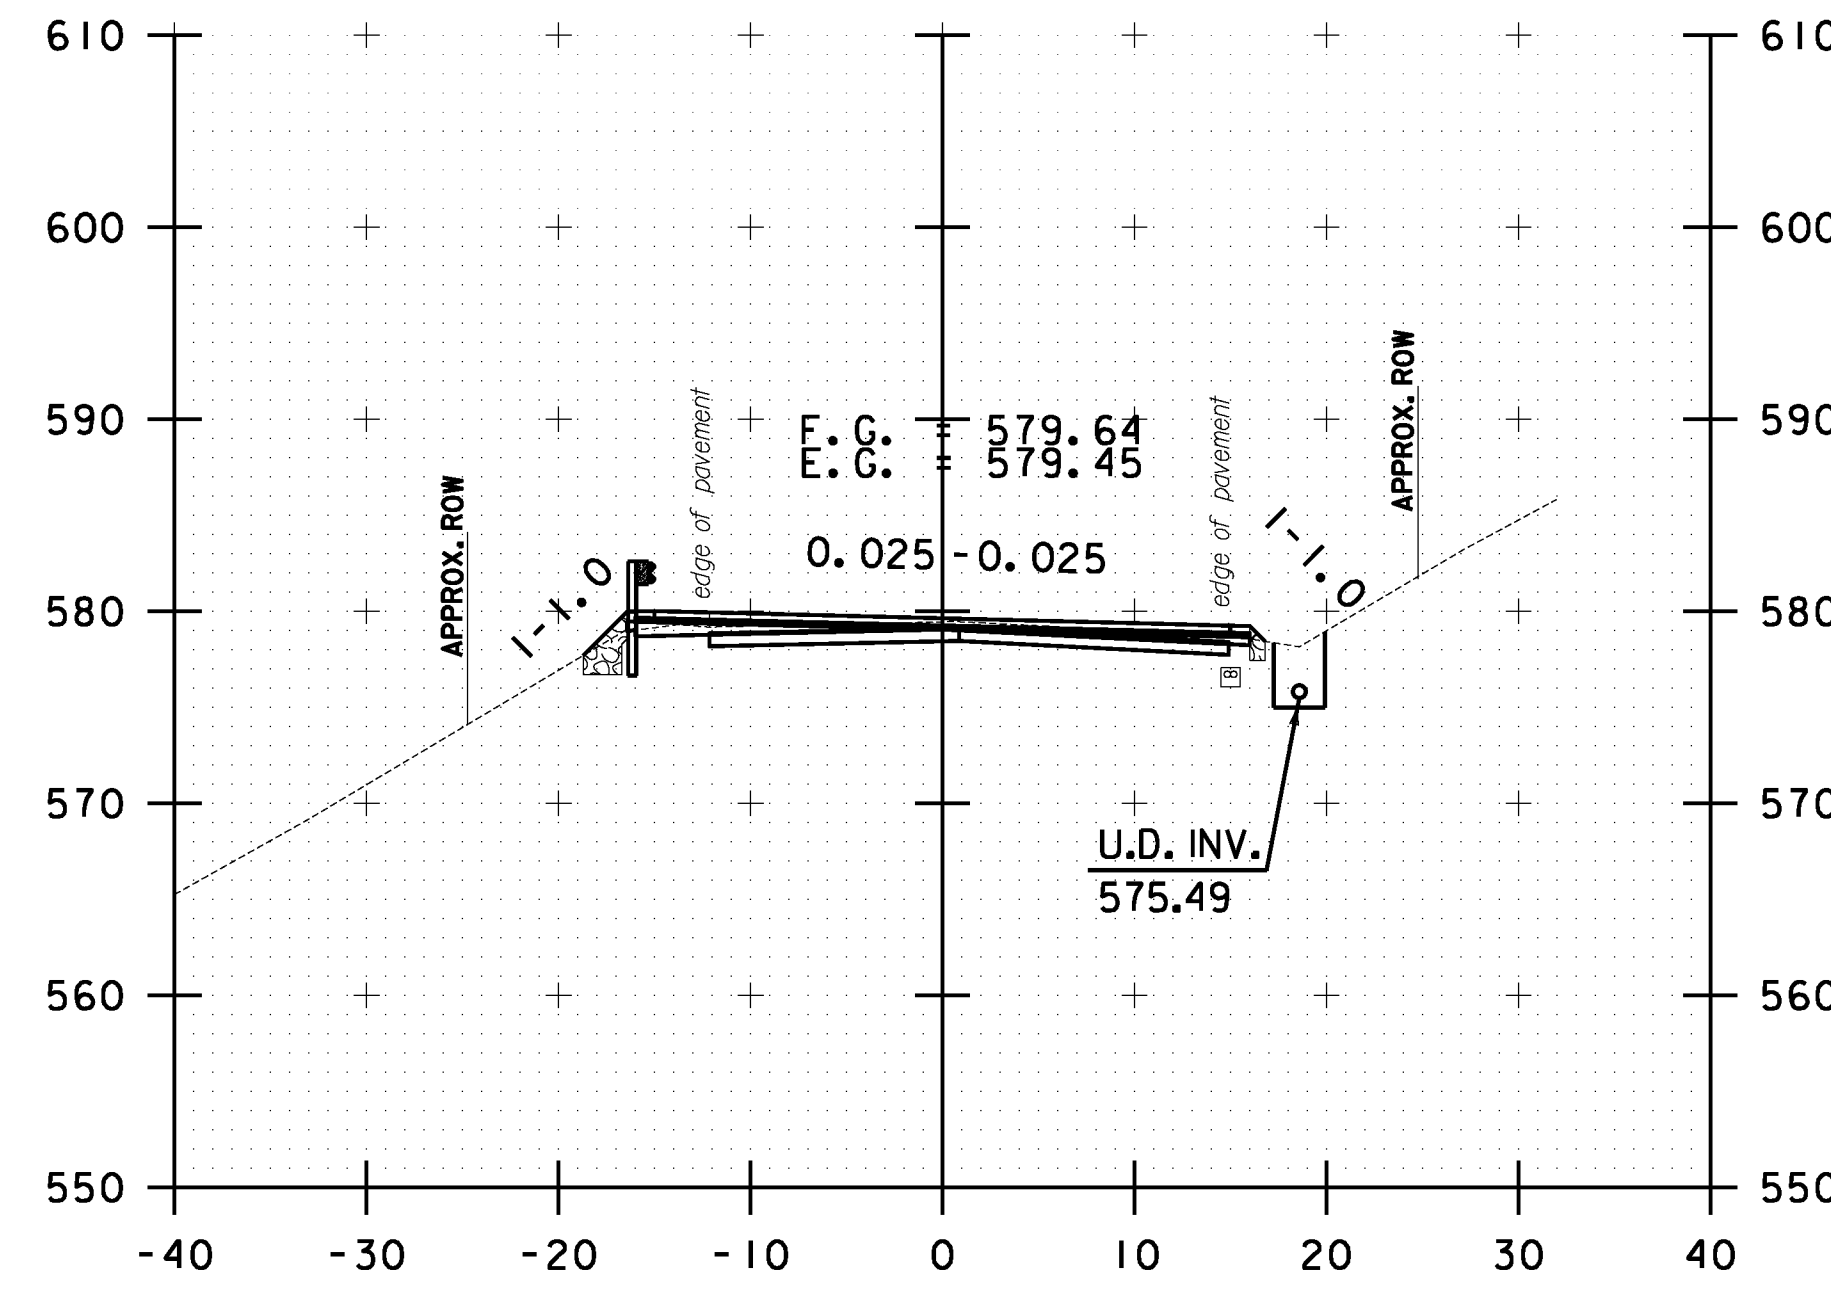


B 29+00.00

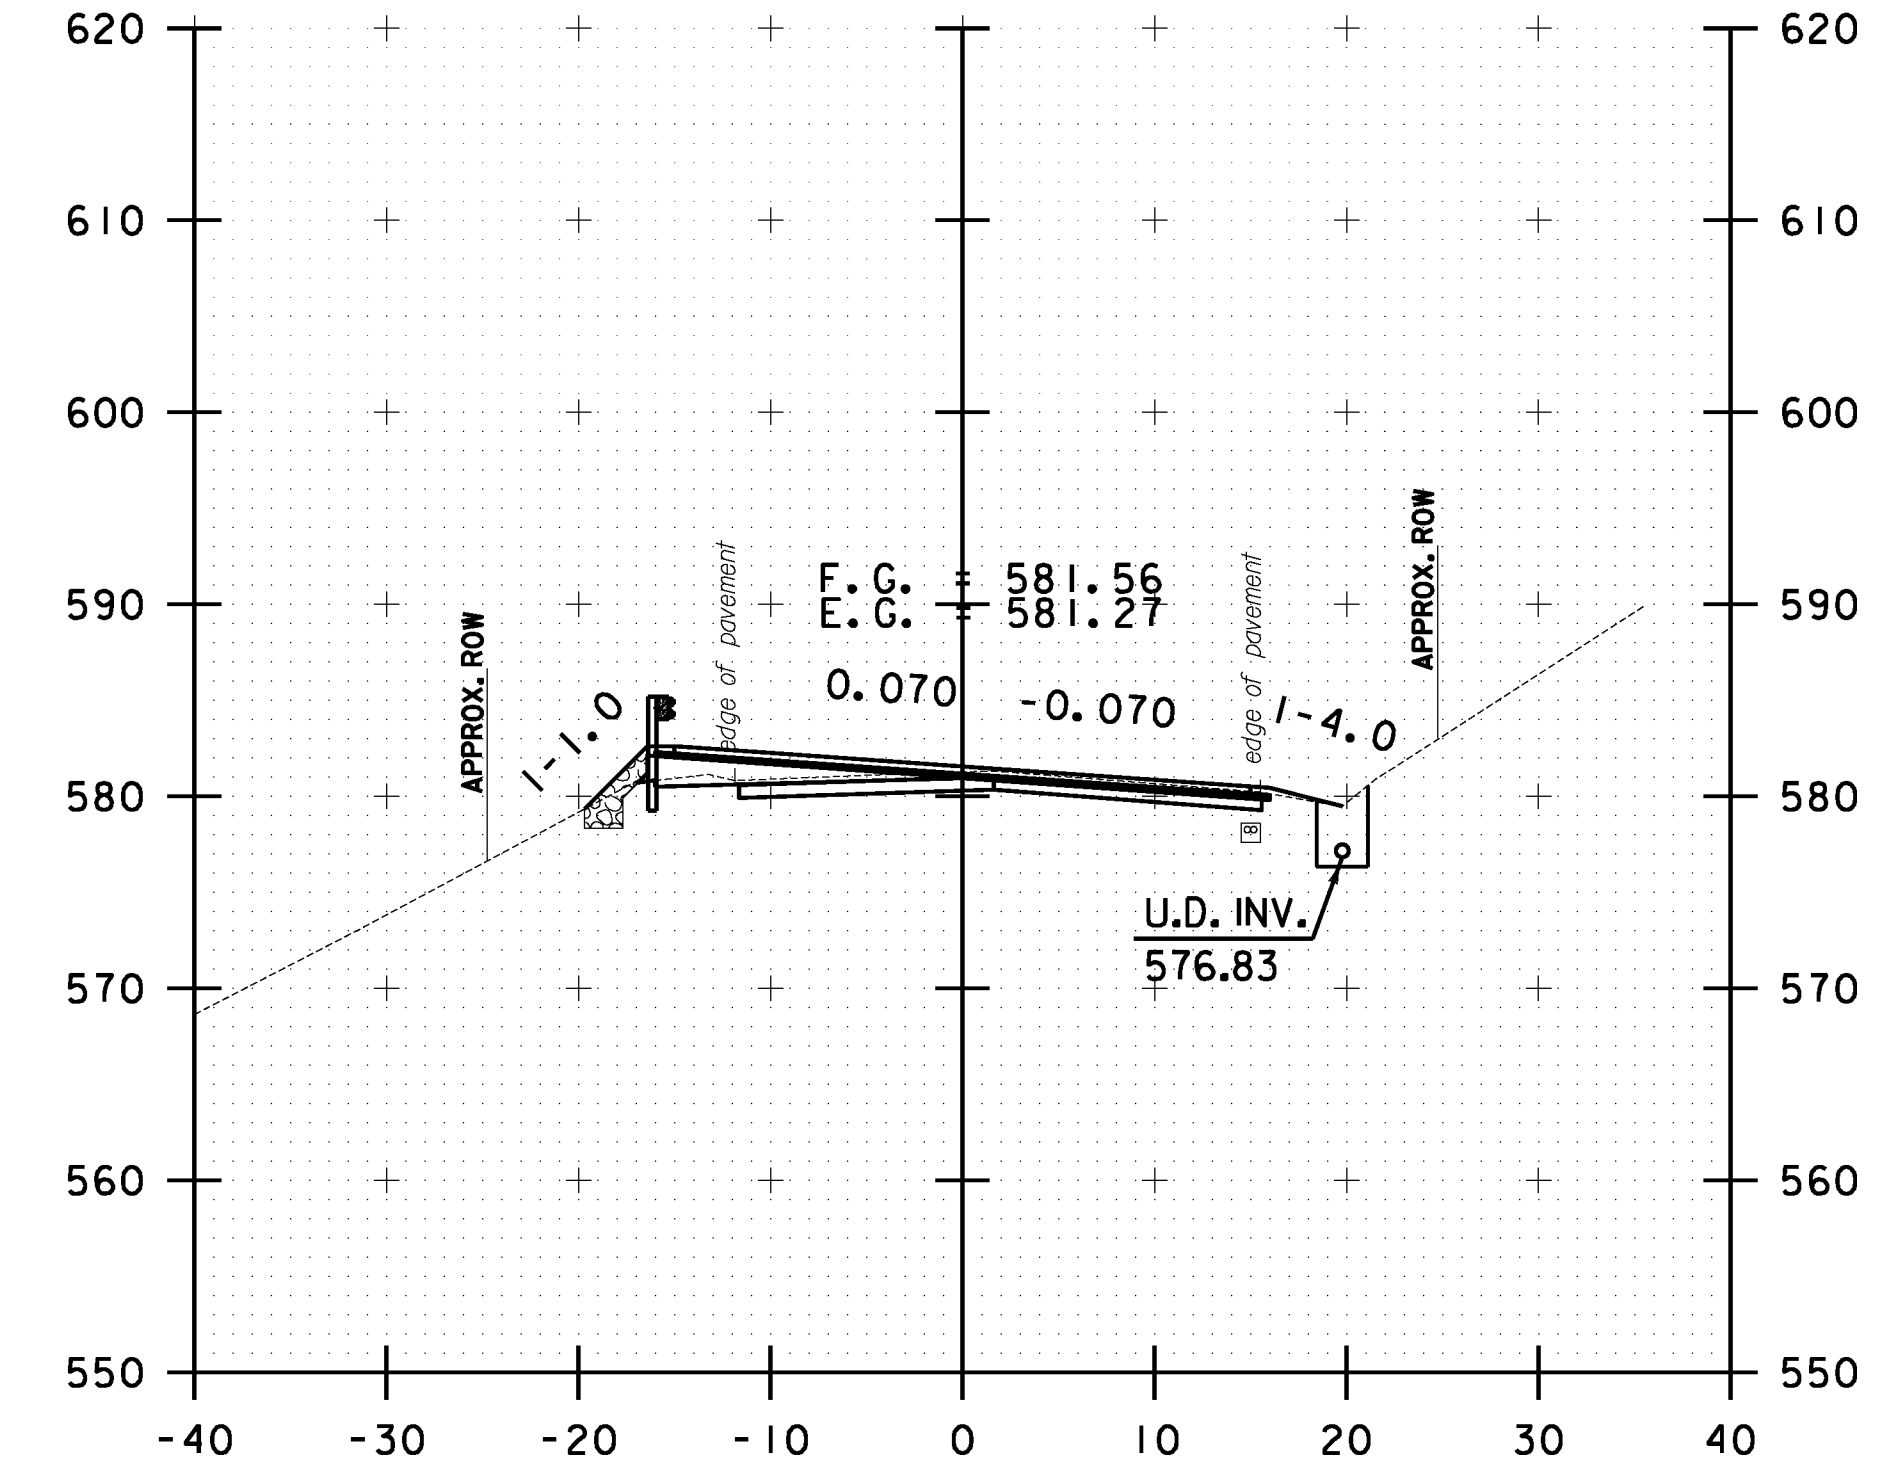


B 30+00.00

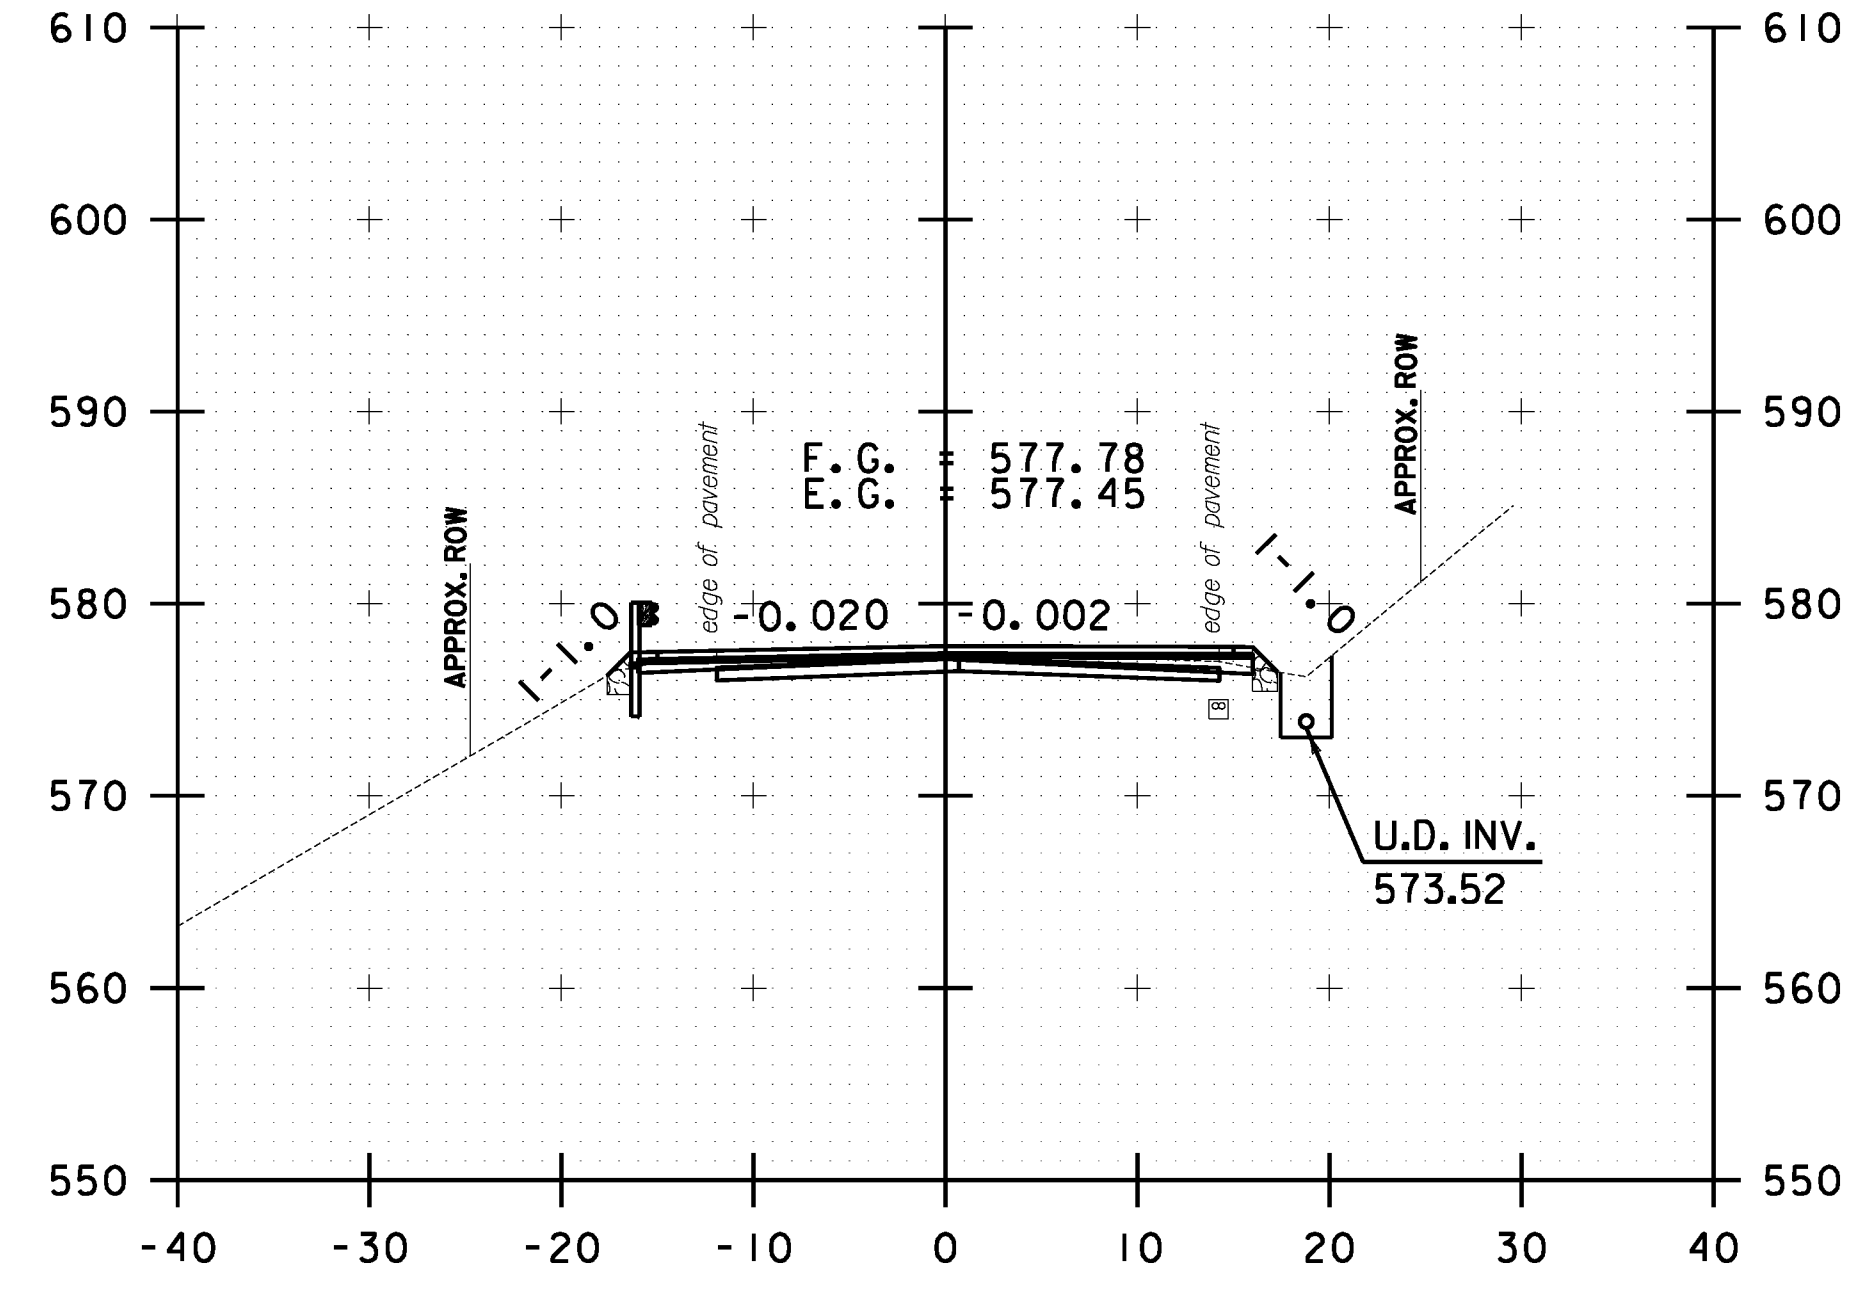


B 27+50.00

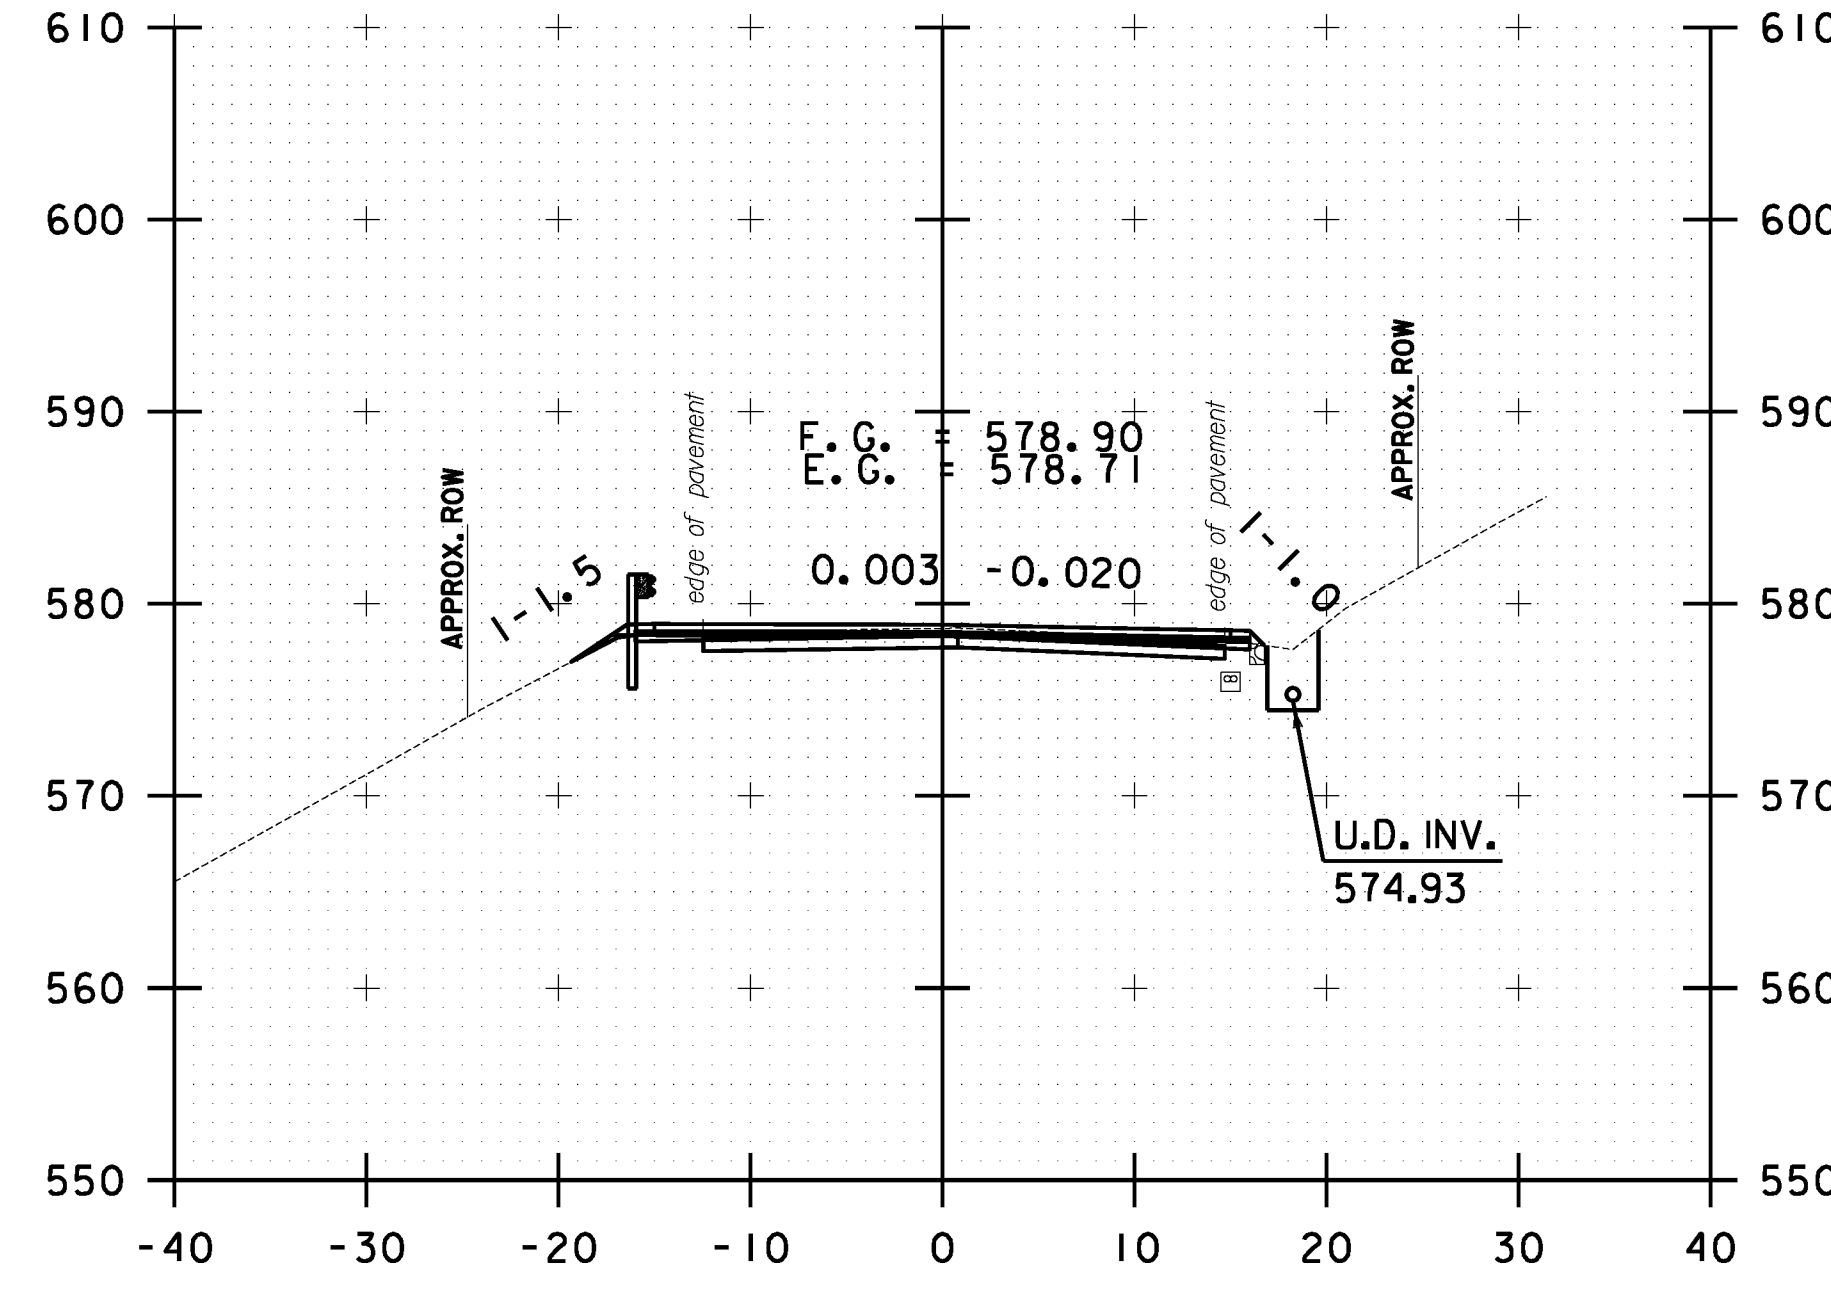

B 28+50.00

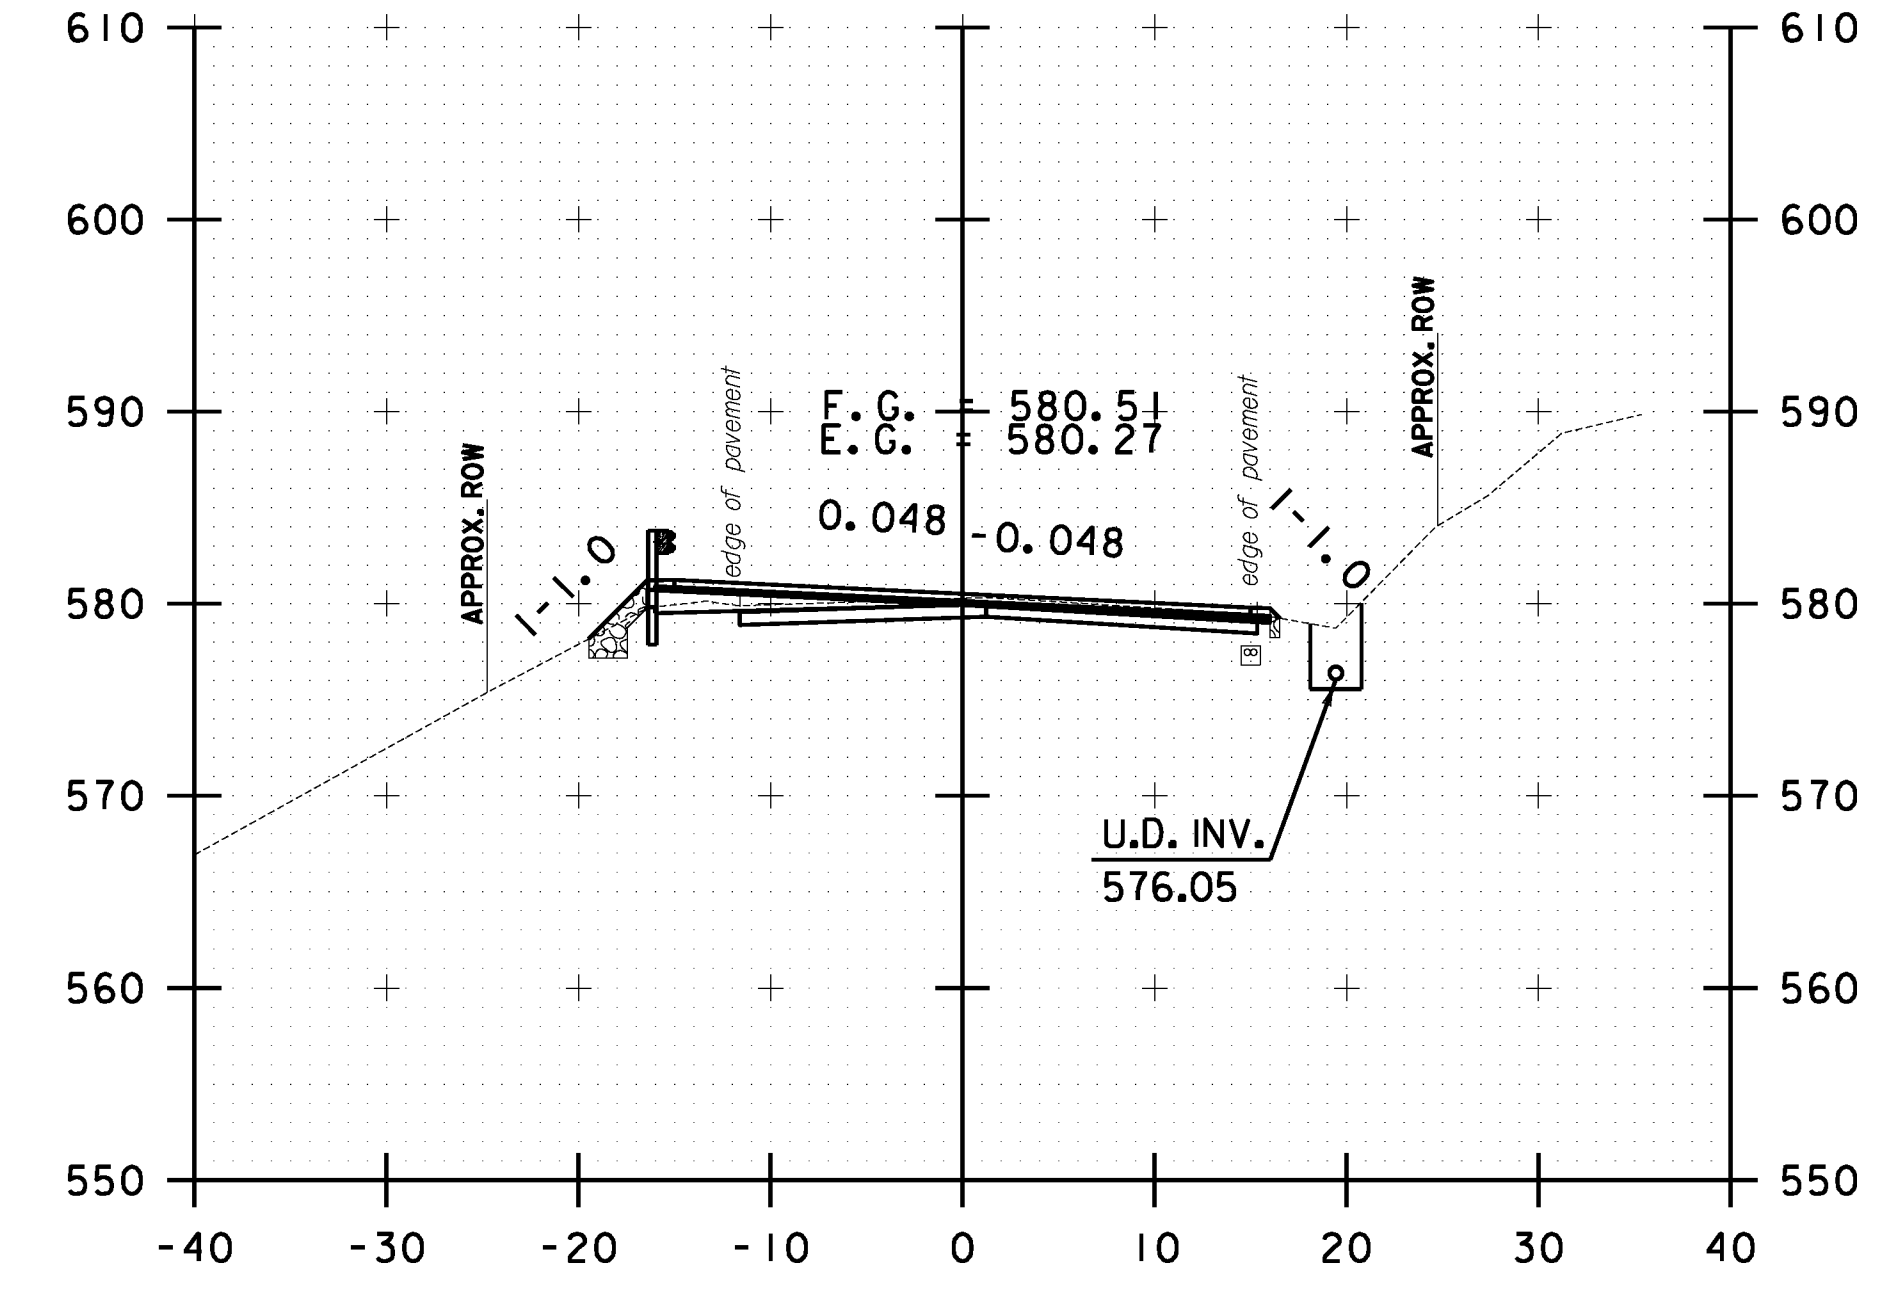

B 29+50.00

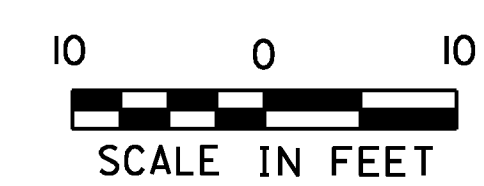

<b>BETHEL CROSS SECTION SHEET #10</b>	PROJECT NAME: STOCKBRIDGE-BETHEL
	PROJECT NUMBER: STP 2910(1)
	FILE NAME: z10b214.bethel.xc.dgn
	IPARM FILE: z10b214xs122.i
	PLOT DATE: 3/17/2014
	DRAWN BY: W.G.P.
	CHECKED BY: J.P.S.
	SHEET 335 OF 397