




FILE NAME = V:\P\c\as\1\ANY\K2\22425\CA001\MSTN\10b214.bethel.xc.dgn
 DATE/TIME = 3/17/2014
 USER = 4916

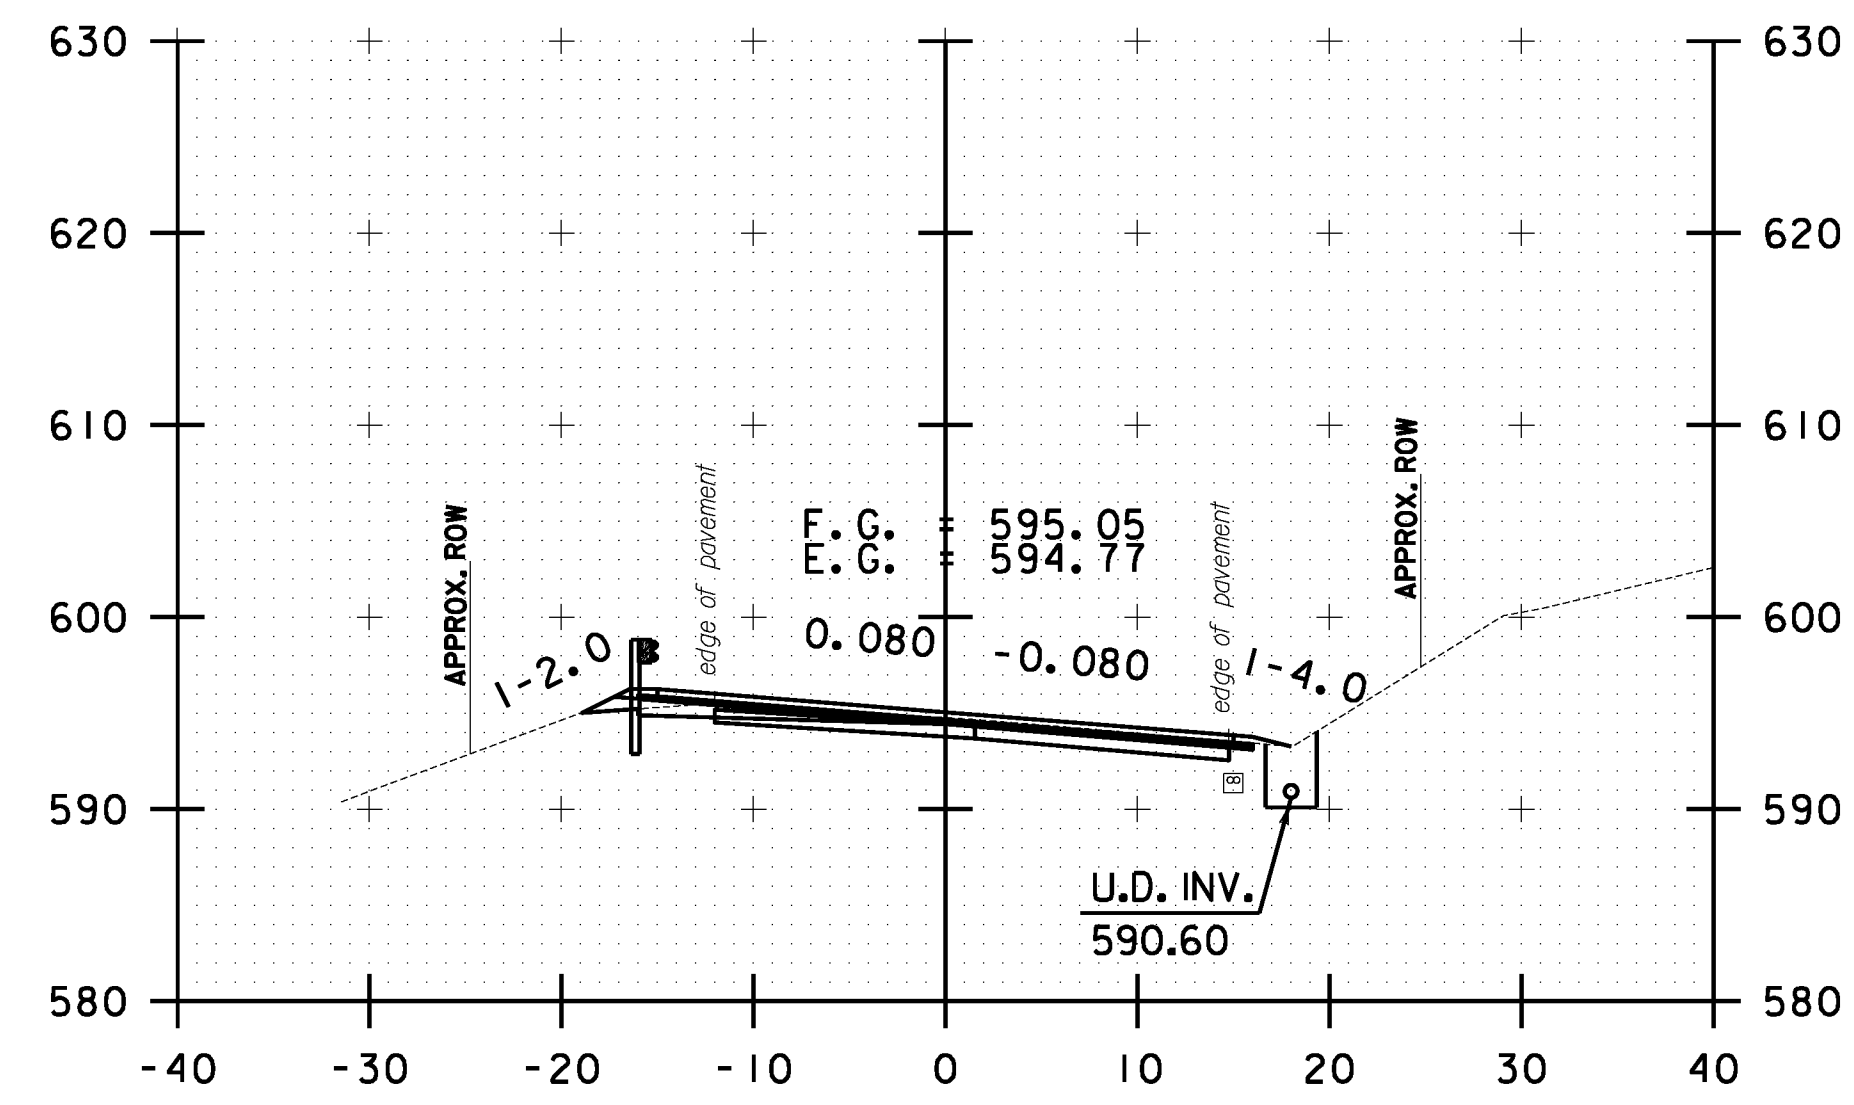


B 34+00.00

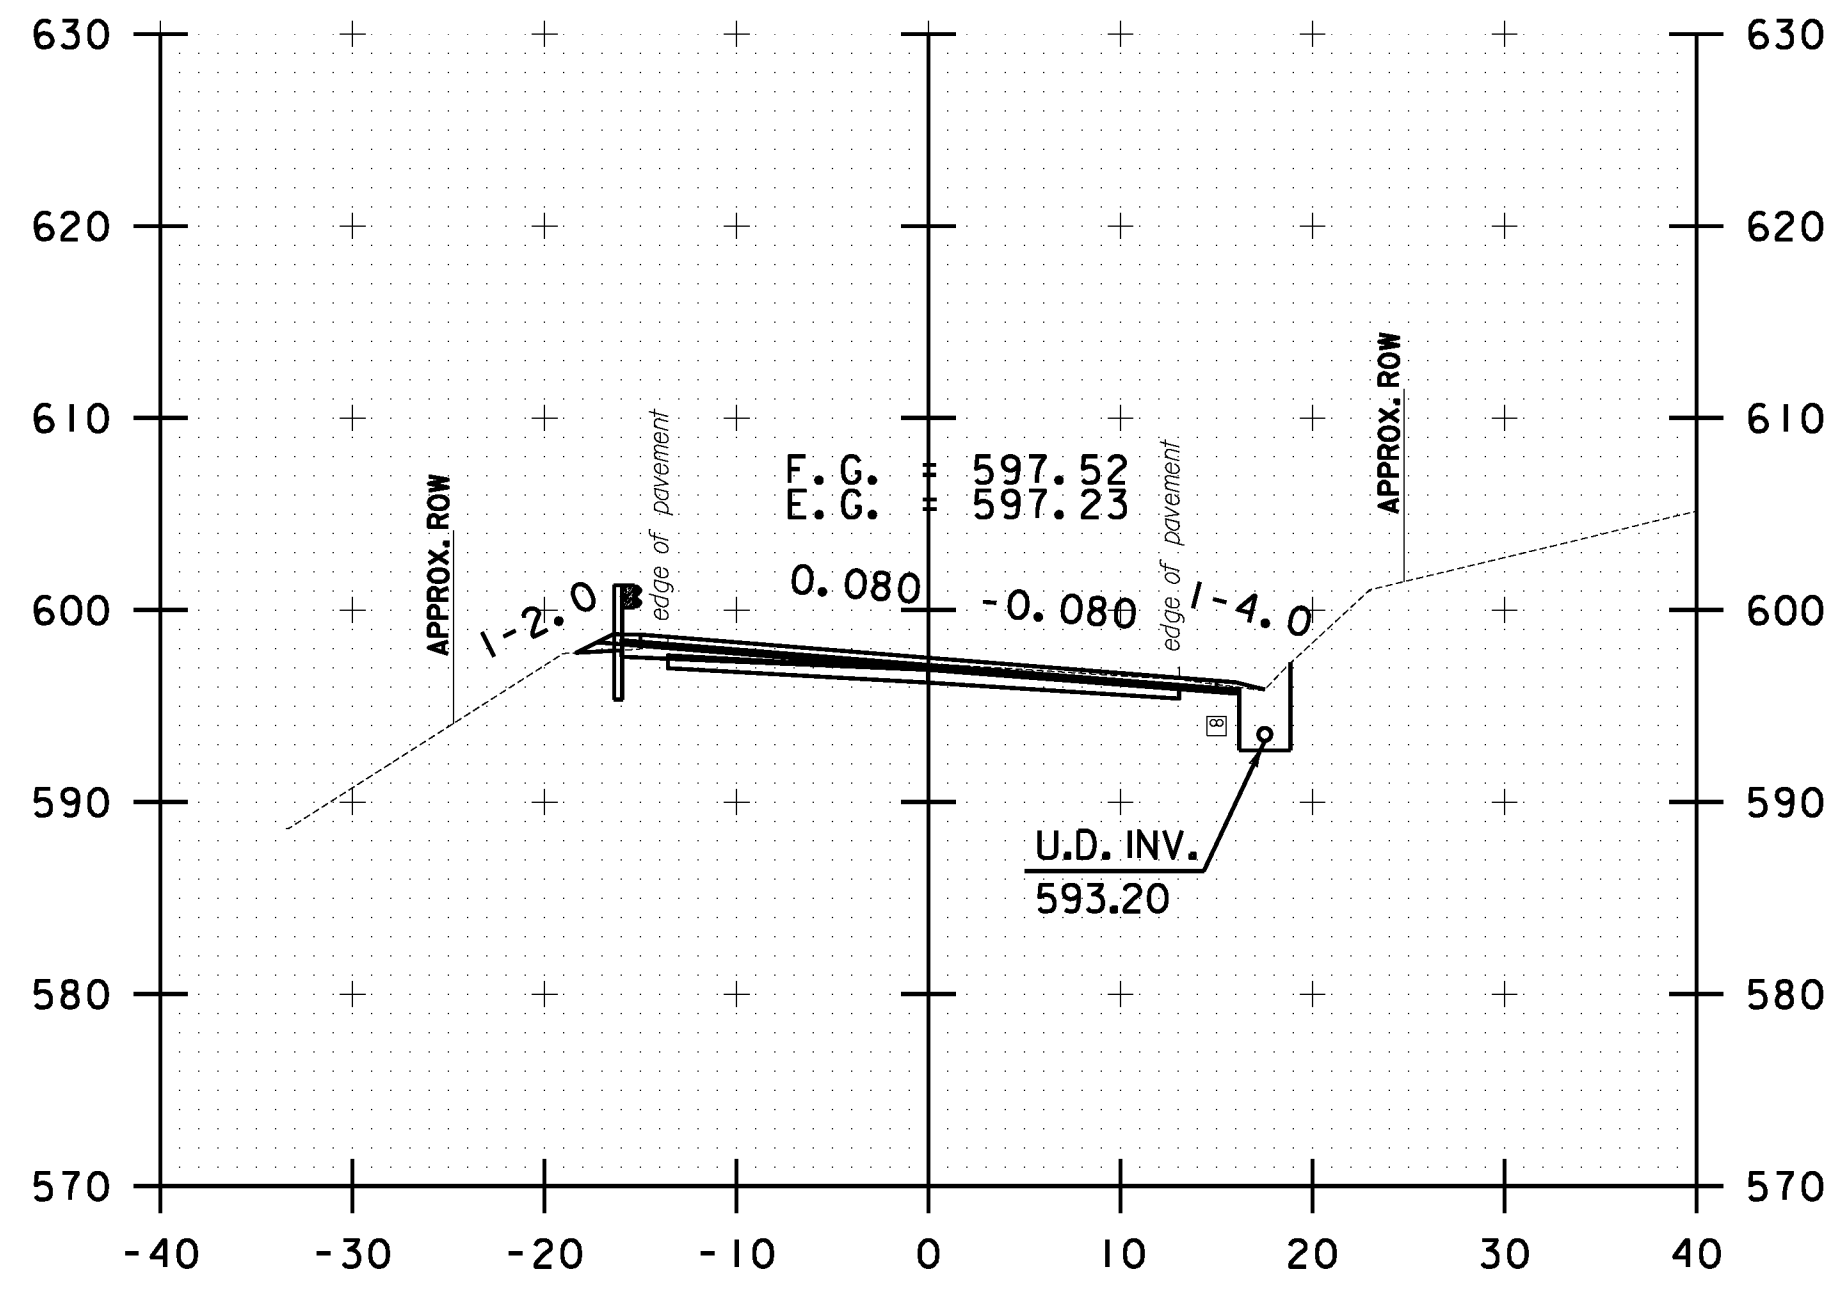


B 35+00.00

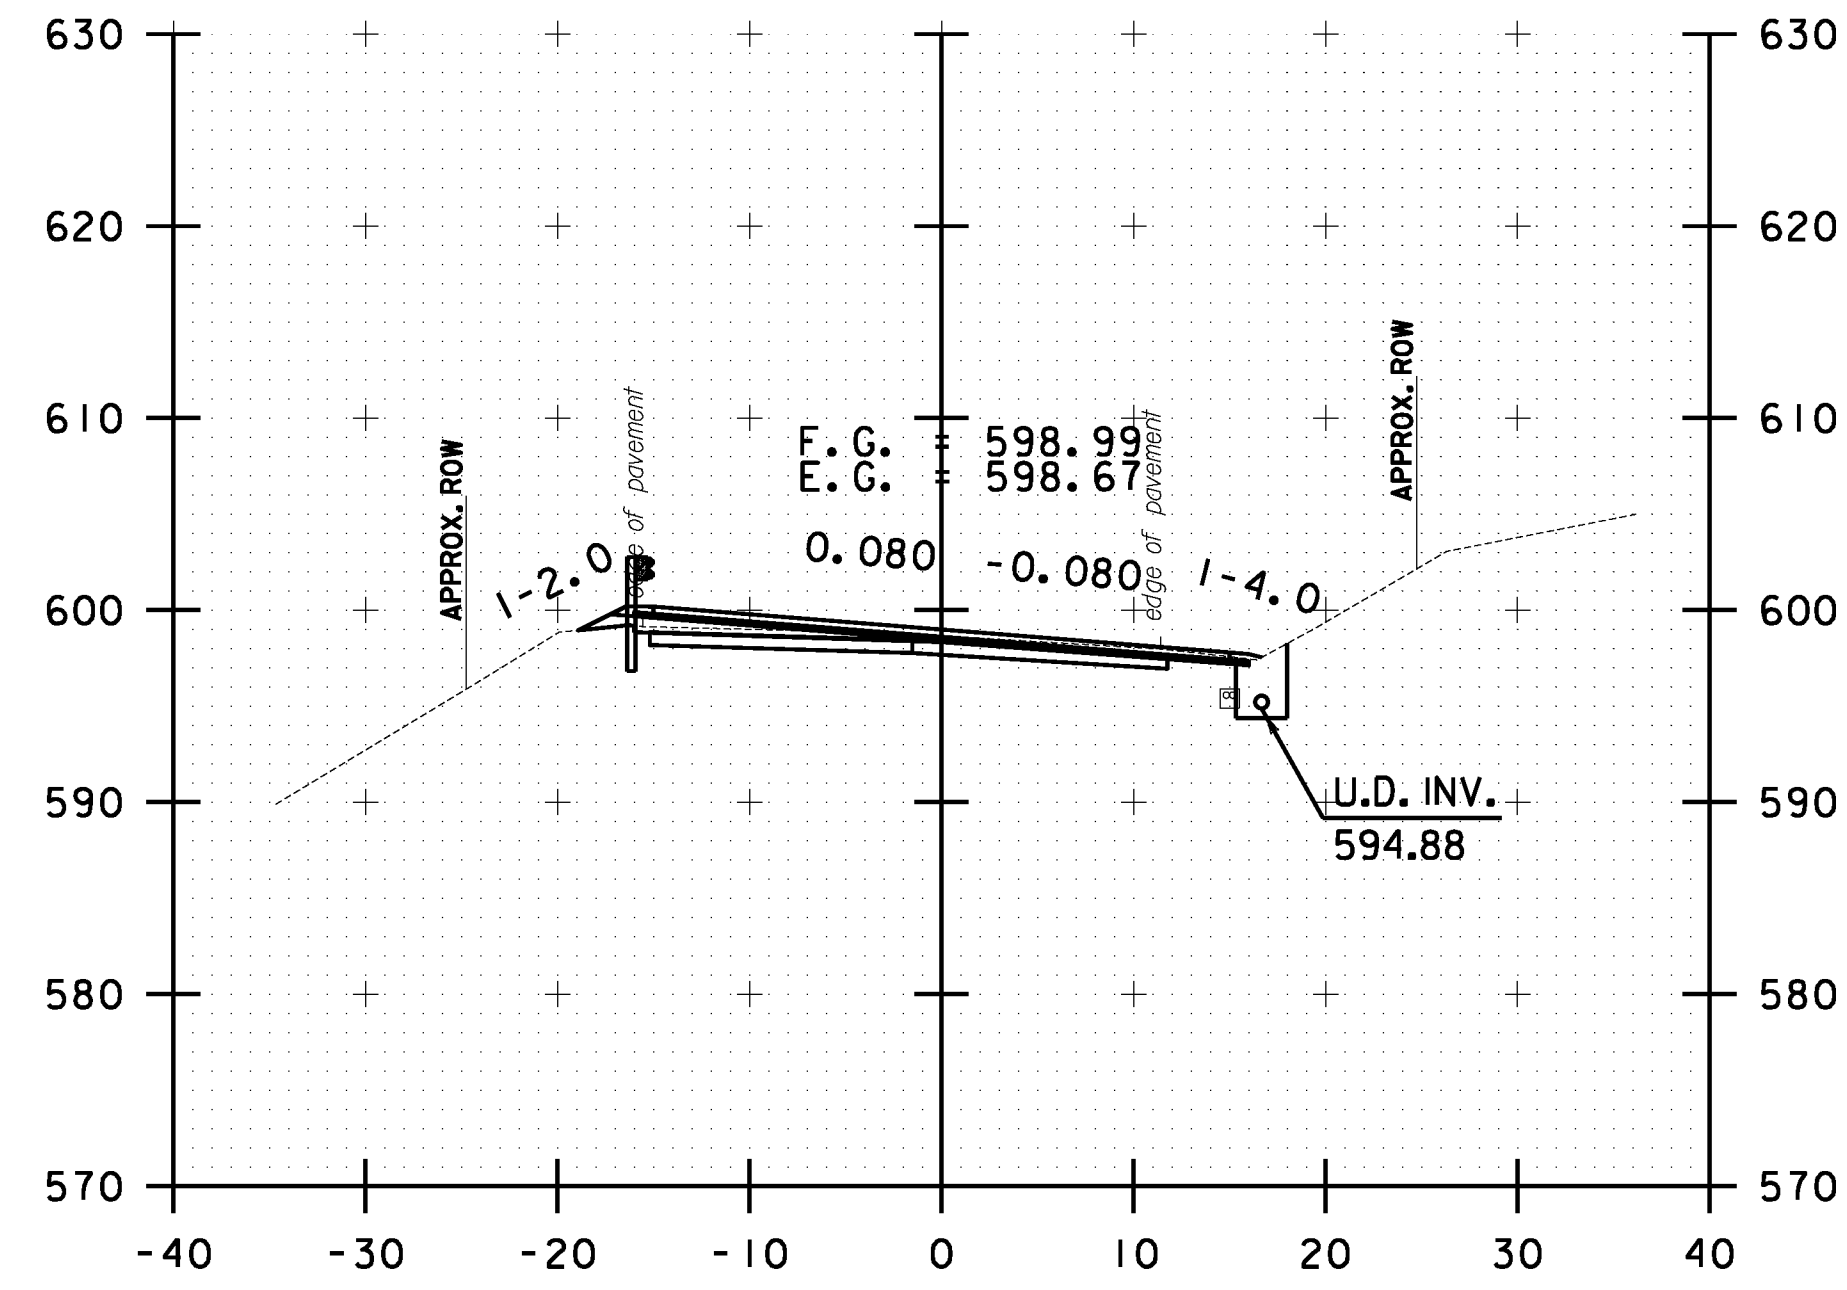


B 36+00.00

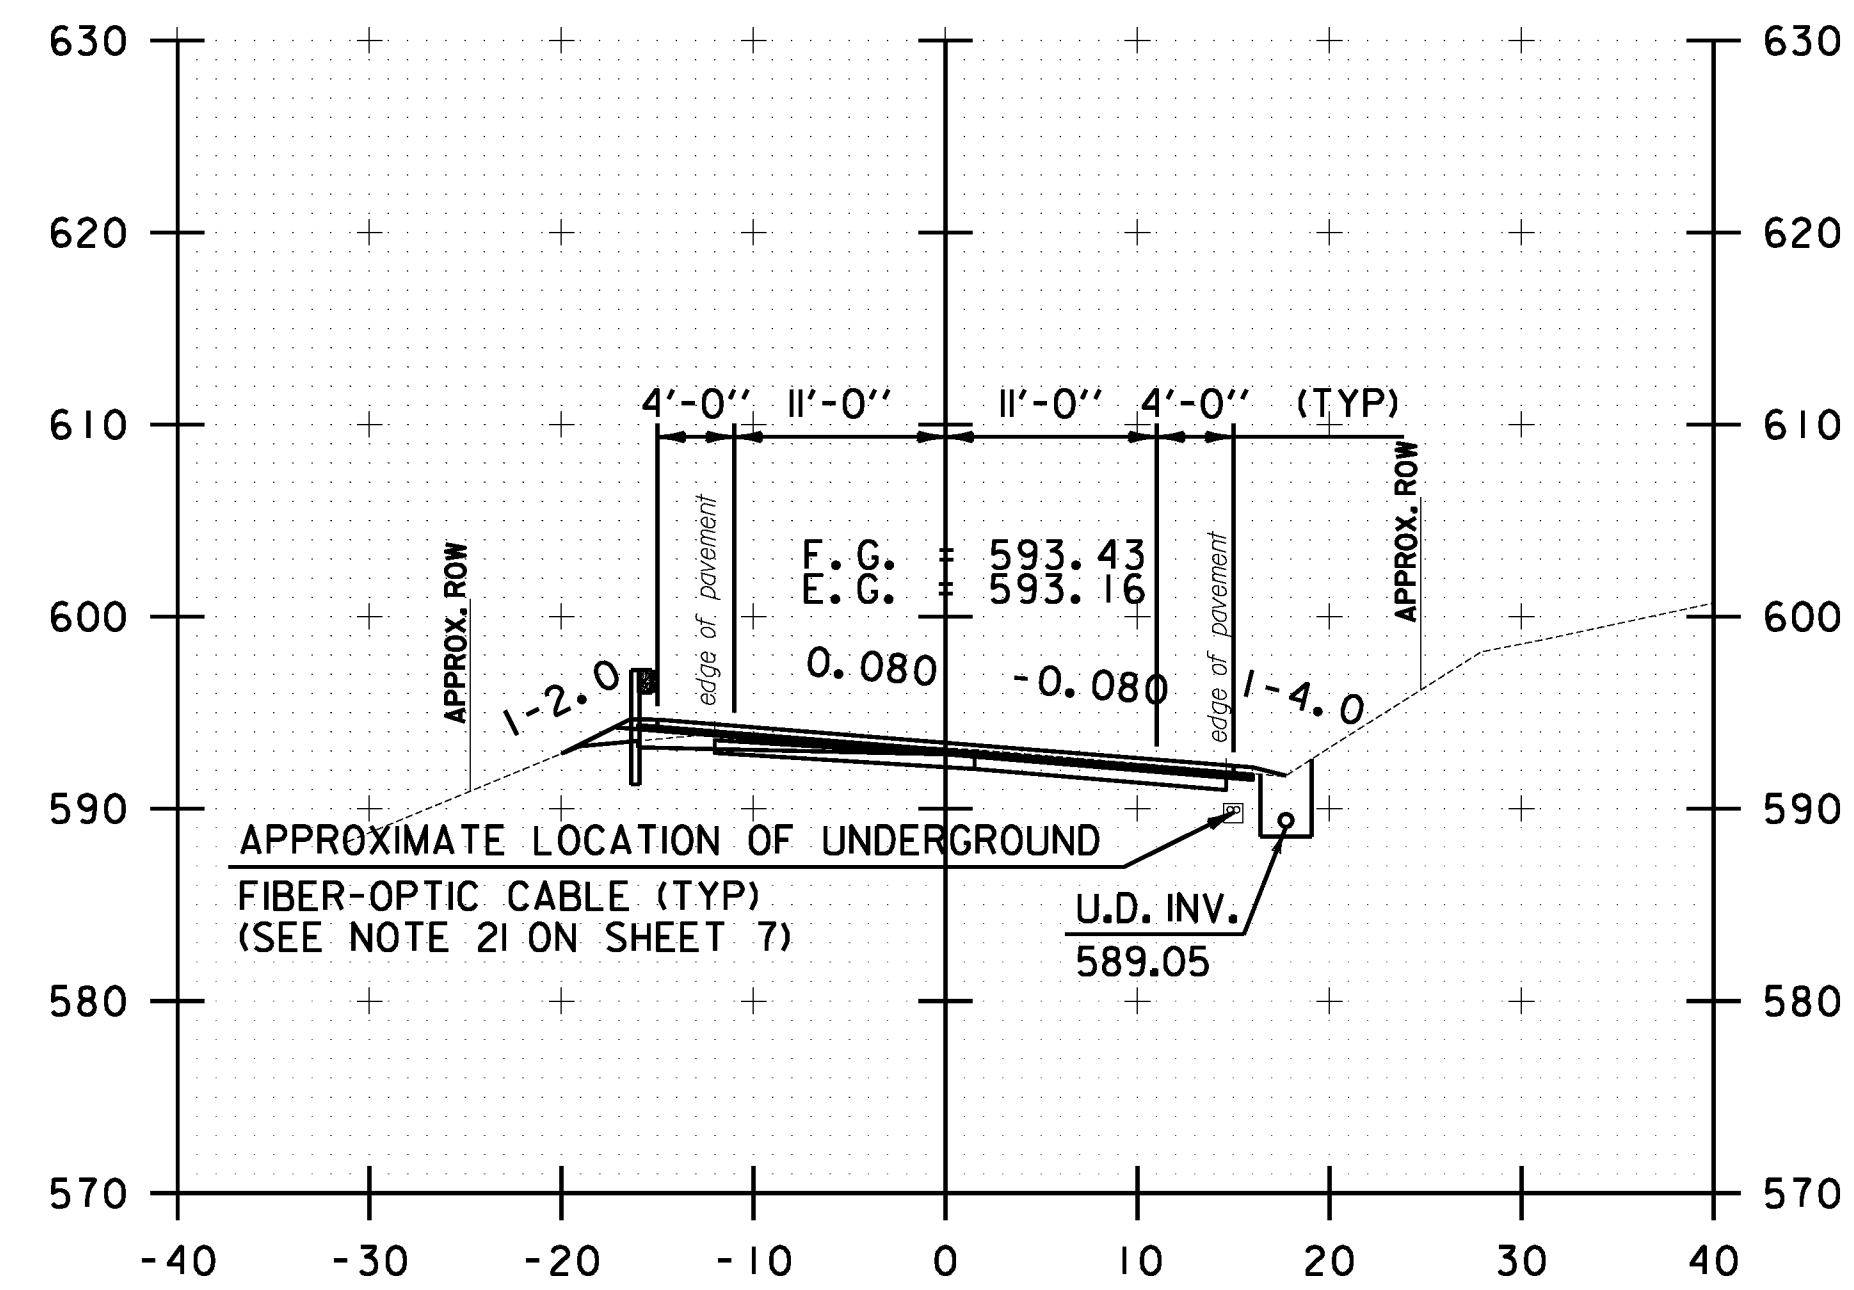


B 33+50.00

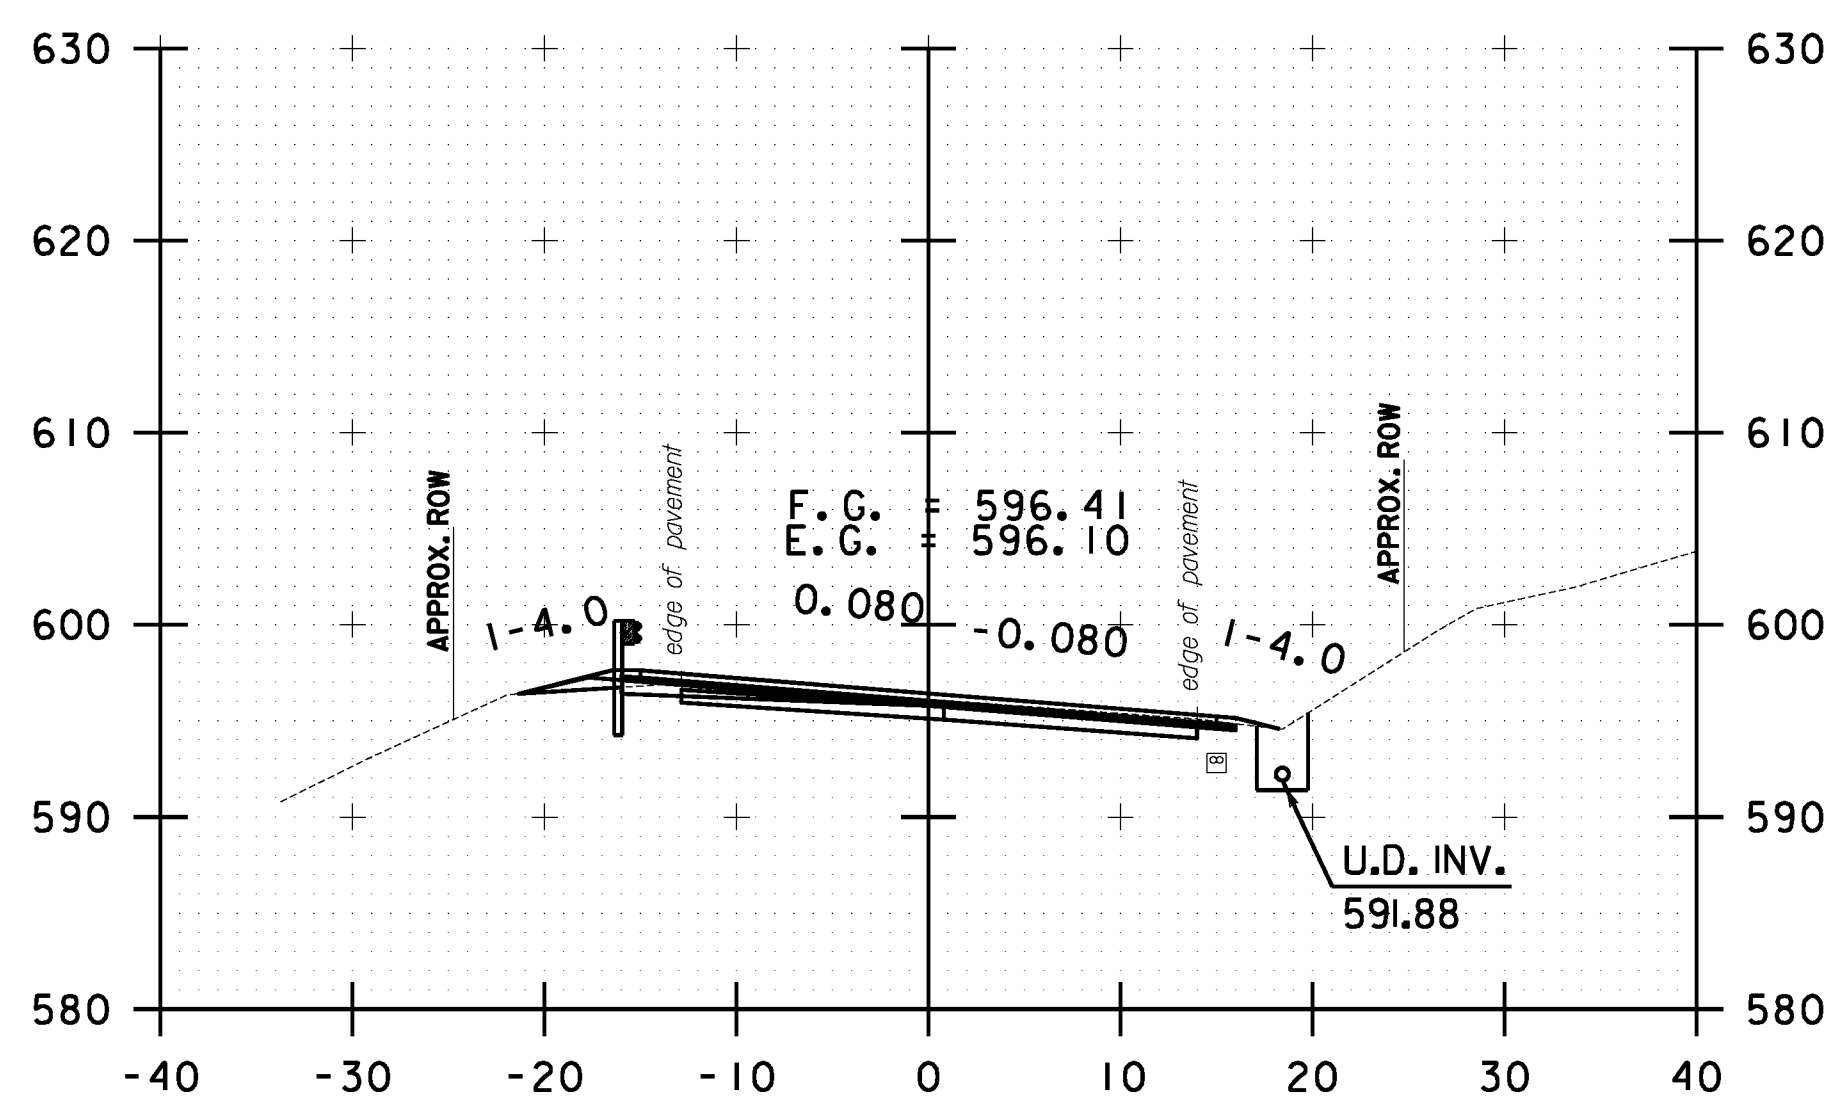

B 34+50.00

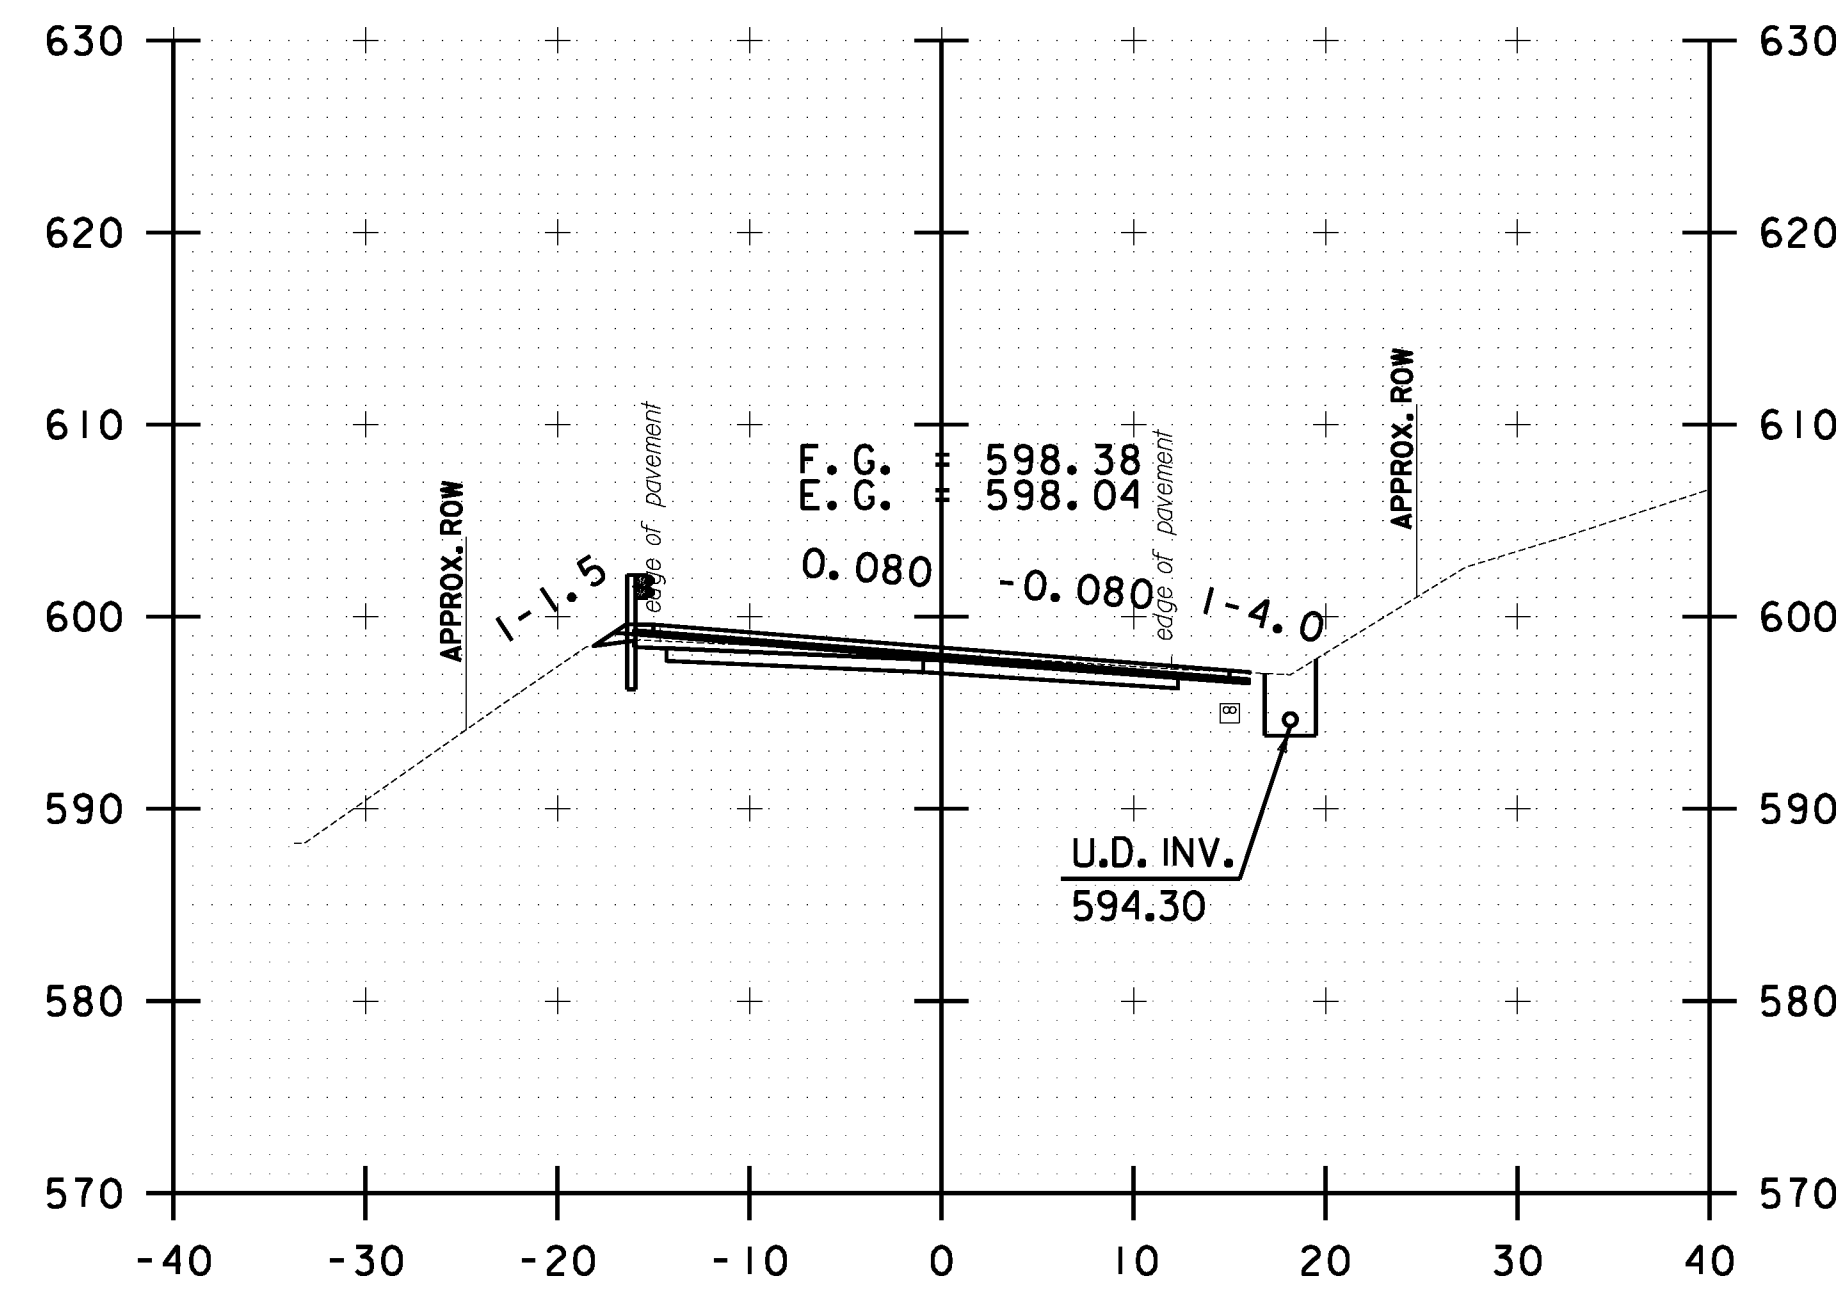

B 35+50.00

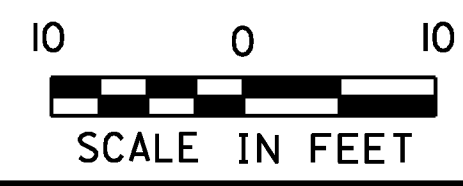

BETHEL CROSS SECTION SHEET #12	PROJECT NAME: STOCKBRIDGE-BETHEL
	PROJECT NUMBER: STP 2910(1)
	FILE NAME: z10b214.bethel.xc.dgn
DESIGNED BY: L.M.B.	PLOT DATE: 3/17/2014
IPARM FILE: z10b214xs124.1	DRAWN BY: W.G.P.
	CHECKED BY: J.P.S.
	SHEET 337 OF 397