




FILE NAME = Y:\P\c\0805\ANY\K2\22425\CADD\MSTN\10b214.bethel.xc.dgn
 DATE/TIME = 3/17/2014
 USER = 4916

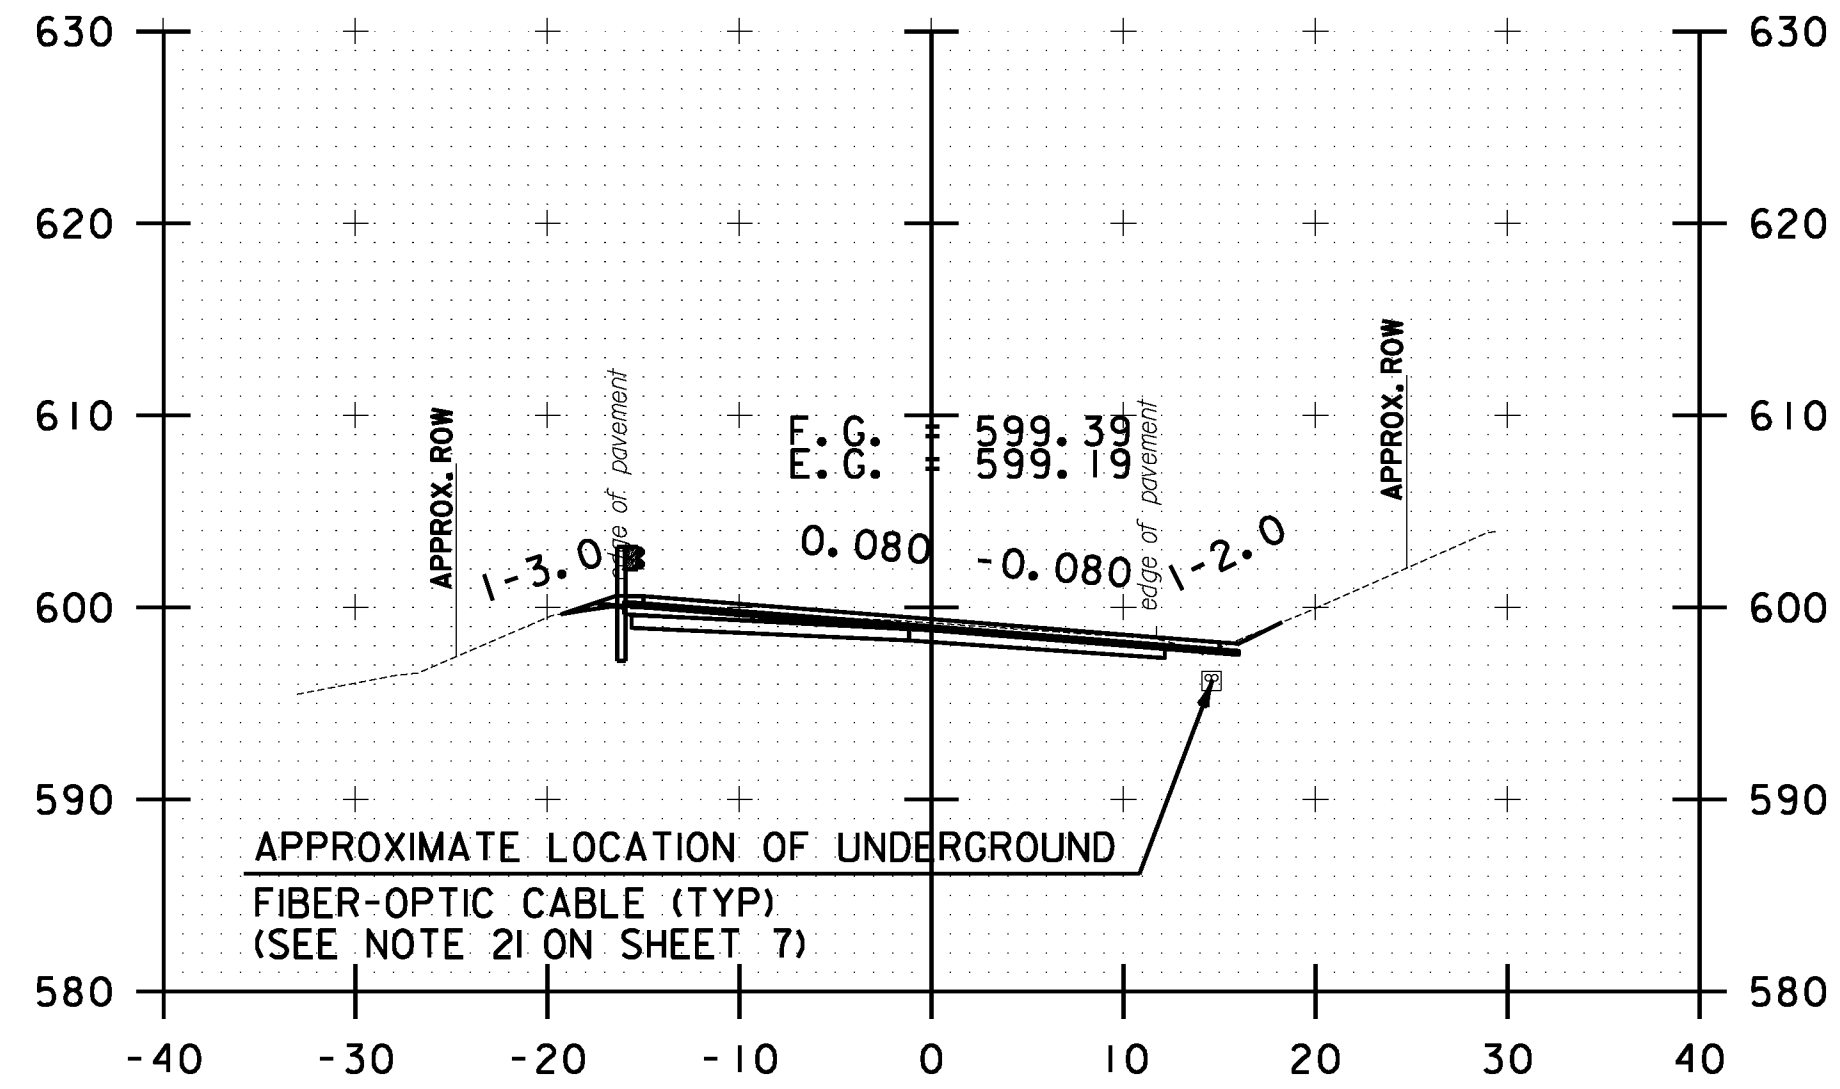


B 36+50.00

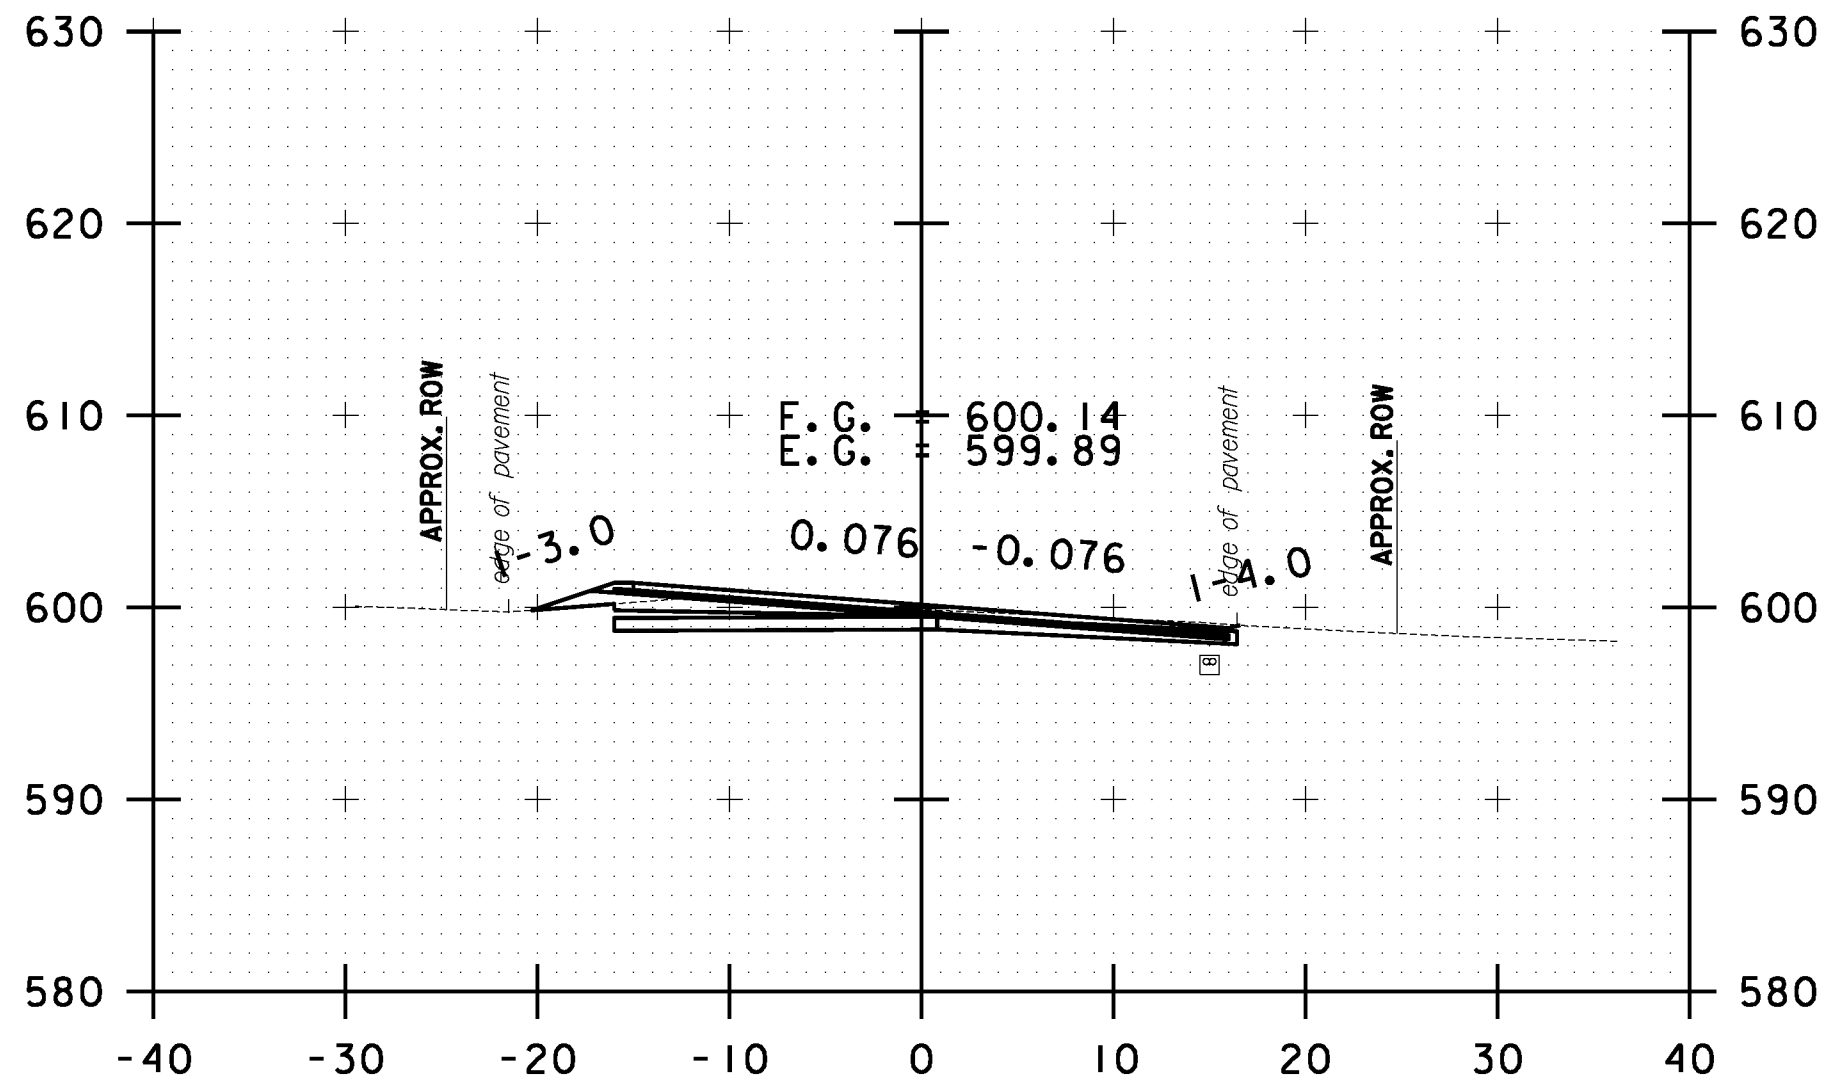


B 37+50.00

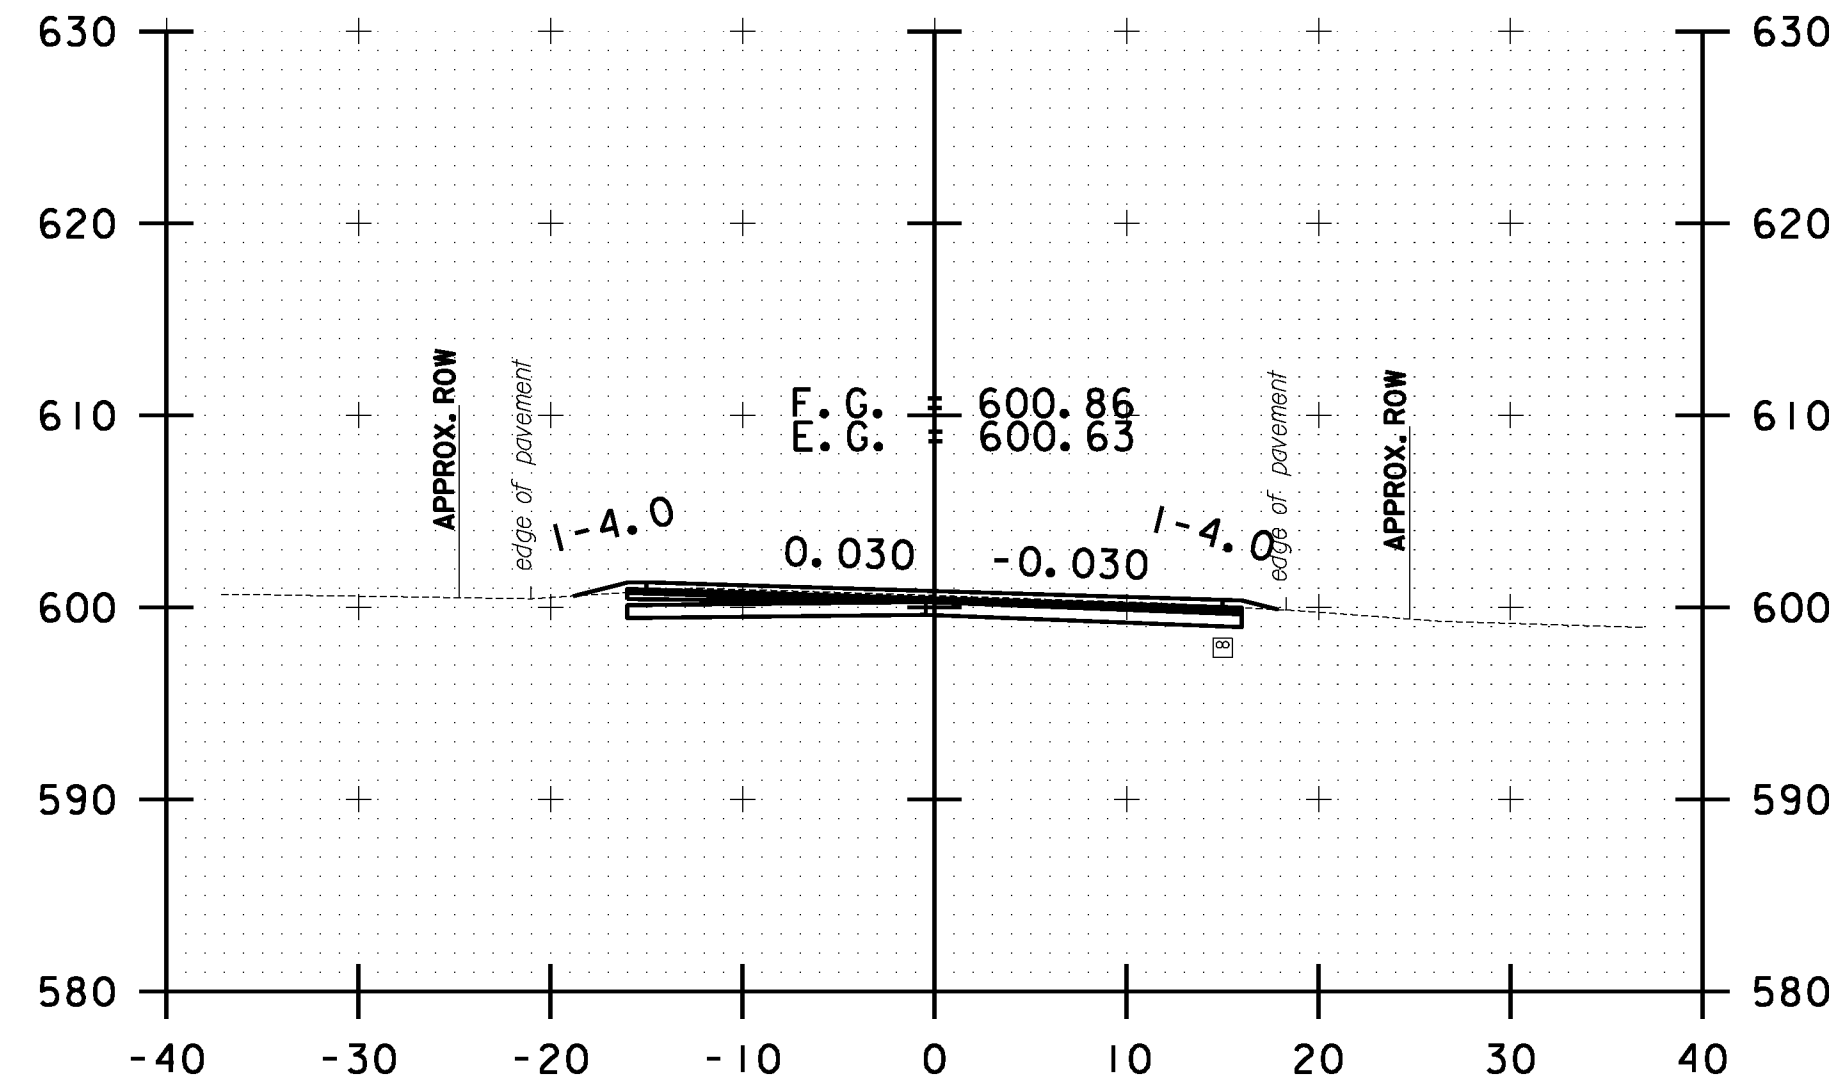


B 38+50.00

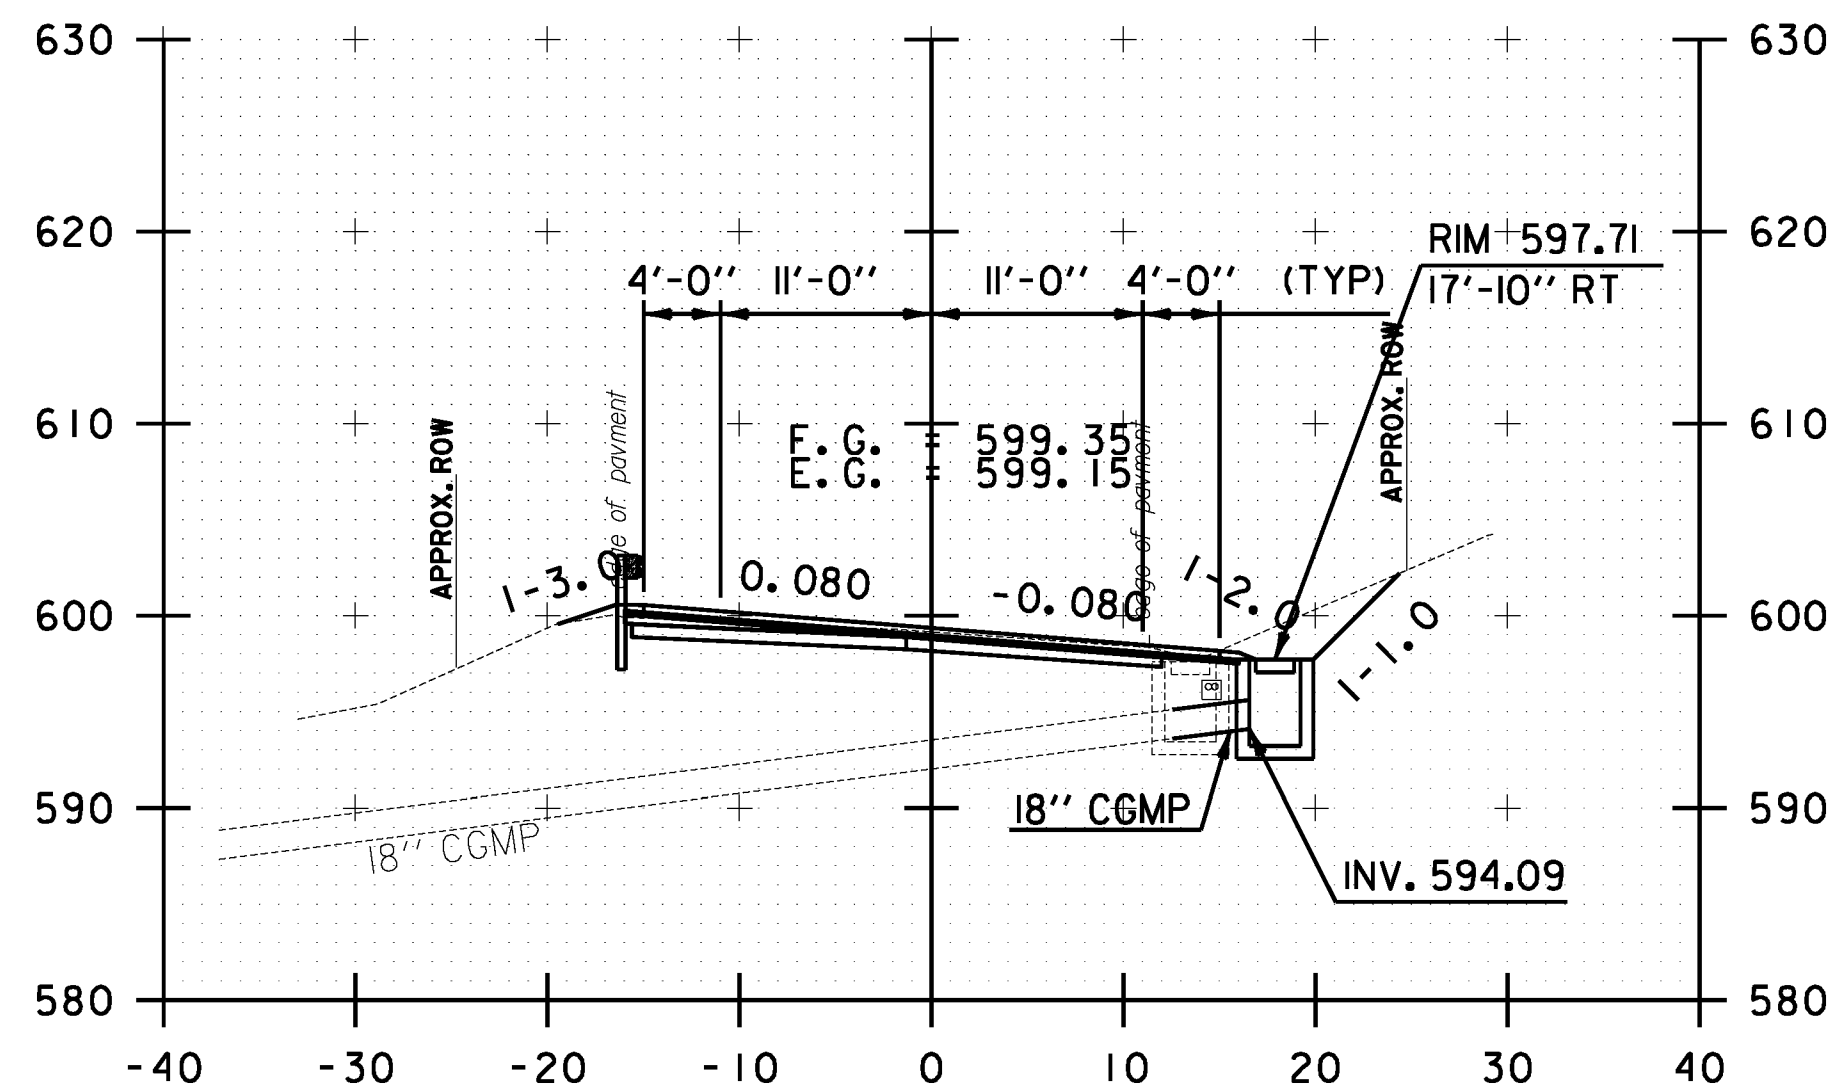

B 36+45.50

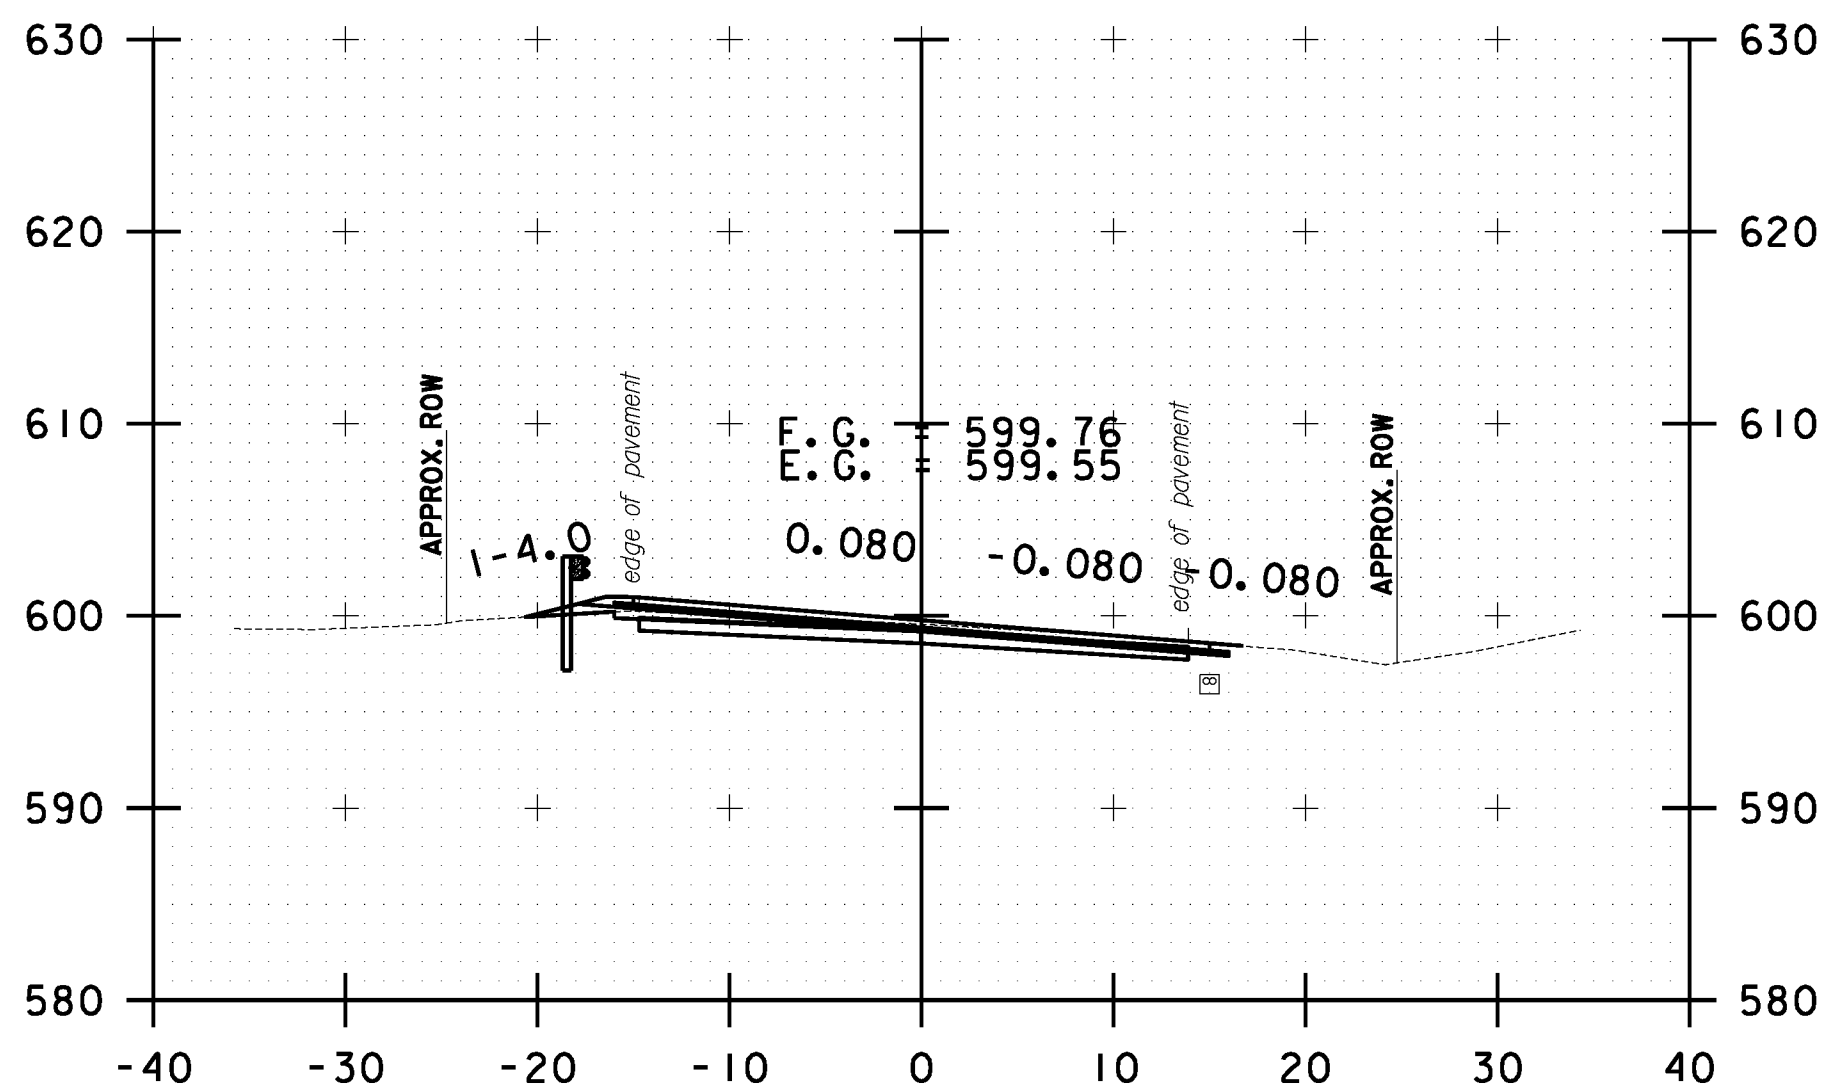

B 37+00.00

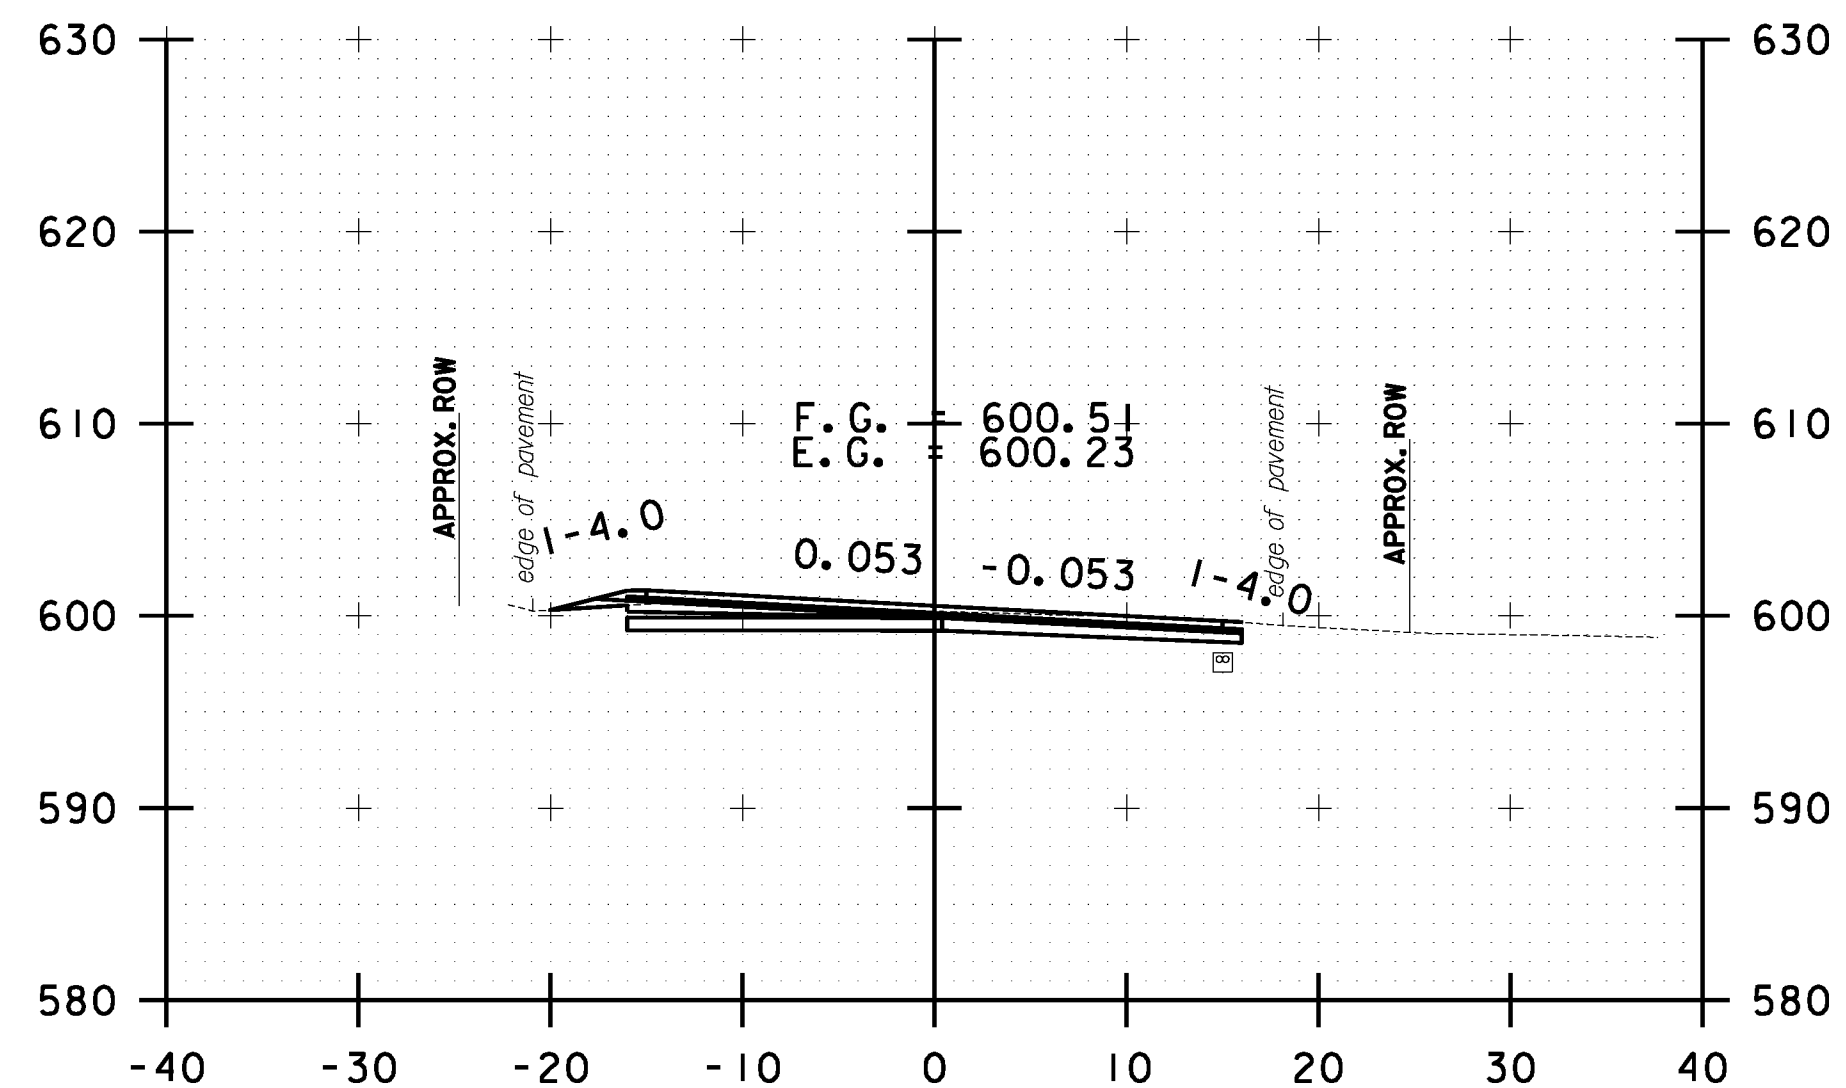

B 38+00.00



BETHEL CROSS SECTION SHEET #13	PROJECT NAME: STOCKBRIDGE-BETHEL
	PROJECT NUMBER: STP 2910(1)
	FILE NAME: z10b214.bethel.xc.dgn
DESIGNED BY: L.M.B.	PLOT DATE: 3/17/2014
CHECKED BY: J.P.S.	DRAWN BY: W.G.P.
IPARM FILE: z10b214.xs125.1	CHECKED BY: J.P.S.
	SHEET 338 OF 397